

CITY OF ALBUQUERQUE



February 5, 2016

Reza Afaghpour, PE
SBS Construction and Engineering, LLC
10209 Snowflake Ct NW
Albuquerque, NM 87114

**Re: 4 Unit Townhouse Development
1203 Griegos Rd NW
Request Permanent C.O. - Accepted
Engineer's Stamp dated: 3-22-15 (F14D070)
Certification dated: 2-3-16**

Dear Mr. Afaghpour,

PO Box 1293
Based on the Certification received 2/4/2016, the site is acceptable for release of Certificate of Occupancy by Hydrology.

Albuquerque
If you have any questions, you can contact me at 924-3686 or Totten Elliott at 924-3982.

New Mexico 87103

Sincerely,

www.cabq.gov

Abiel Carrillo, P.E.
Principal Engineer, Planning Department
Development and Review Services

TE/AC
C: email, Cordova, Camille C.; Miranda, Rachel; Sandoval, Darlene M.; Blocker, Lois

NOTICE TO CONTRACTORS

1. AN EXCAVATION/CONSTRUCTION PERMIT WILL BE REQUIRED BEFORE BEGINNING ANY WORK WITHIN CITY RIGHT-OF-WAY.
2. ALL WORK DETAILED ON THESE PLANS TO BE PERFORMED, EXCEPT AS OTHERWISE STATED OR PROVIDED HEREON, SHALL BE CONSTRUCTED IN ACCORDANCE WITH CITY OF ALBUQUERQUE INTERIM STANDARD SPECIFICATIONS FOR PUBLIC WORKS CONSTRUCTION, 1985.
3. TWO WORKING DAYS PRIOR TO ANY EXCAVATION, CONTRACTOR MUST CONTACT NEW MEXICO ONE CALL FOR LOCATING SERVICE, 260-1990 OR "811", FOR LOCATION OF EXISTING UTILITIES.
4. PRIOR TO CONSTRUCTION, THE CONTRACTOR SHALL EXCAVATE AND VERIFY THE HORIZONTAL AND VERTICAL LOCATIONS OF ALL CONSTRUCTIONS. SHOULD A CONFLICT EXIST, THE CONTRACTOR SHALL NOTIFY THE ENGINEER SO THAT THE CONFLICT CAN BE RESOLVED WITH A MINIMUM AMOUNT OF DELAY.
5. BACKFILL COMPACTION SHALL BE ACCORDING TO TRAFFIC/STREET USE.
6. MAINTENANCE OF THESE FACILITIES SHALL BE THE RESPONSIBILITY OF THE OWNER OF THE PROPERTY SERVED.
7. WORK ON ARTERIAL STREETS SHALL BE PERFORMED ON A 24-HOUR BASIS.

APPROVALS	NAME	DATE
INSPECTOR		

Location
Lots 3 and 4, Block 2, Sandia Plaza, contains +/- 0.3519 acres and is located at 203 Griegos Rd. N.W. See attached portion of the Vicinity Map for exact location.

Purpose
The purpose of this drainage report is to present a grading and drainage solution to replace existing improvements with this new building.

Existing Drainage Conditions
This site is fairly flat, and it drains to Griegos Road and 12th Street N.W. No off-site runoff enters the site. Based on the FIRM Map 35001C0119G (revised September 26, 2008) the site does not fall within a 100-year floodplain.

Proposed Conditions and On-Site Drainage Management Plan
The runoff generated from this site will be retained on-site. Several Ponds (A through D) are designed to hold nearly twice the volume of the 100-yr/6-day volume under the proposed conditions minus 100-yr/6-day volume under the historical conditions. Then when the ponds exceed their capacity the runoff will overflow into the parking lot and then to public street via sidewalk culverts. The allowable discharge in the Valley is 2.75 cfs/acre meaning a retention volume requirement of 0.50 inches times the area (638.74 cfs). The 90th Percentile/First Flush ponding requirement is 0.34 inches times the impervious area (282.32 cfs). Total retention volume provided (2,052.23 cfs) far exceeds the ponding requirement in the Valley (638.74 cfs) and First Flush (282.32 cfs).

Calculations
City of Albuquerque, Development Process Manual, Section 22.2, Hydrology Section, was used for runoff calculations. See this plan for AHYMO input and Summary output files.

* ZONE 2

* 100-YEAR, 6-HR STORM (UNDER EXISTING CONDITIONS) *

START TIME=0.0
RAINFALL TYPE=1 RAIN QUARTER=0.0 IN
RAIN ONE=2.01 IN RAIN SIX=2.35 IN
RAIN DAY=2.75 IN DT=0.03333 HR
* ON-SITE
COMPUTE NM HYD ID=1 HYD NO=100.0 AREA=0.000550 SQ MI
PER A=0.00 PER B=100.00 PER C=0.00 PER D=0.00
TP=0.1333 HR MASS RAINFALL=-1

* 10-YEAR, 6-HR STORM (UNDER EXISTING CONDITIONS) *

START TIME=0.0
RAINFALL TYPE=1 RAIN QUARTER=0.0 IN
RAIN ONE=1.34 IN RAIN SIX=1.57 IN
RAIN DAY=1.83 IN DT=0.03333 HR
* ON-SITE
COMPUTE NM HYD ID=1 HYD NO=110.0 AREA=0.000550 SQ MI
PER A=0.00 PER B=100.00 PER C=0.00 PER D=0.00
TP=0.1333 HR MASS RAINFALL=-1

* 100-YEAR, 6-HR STORM (UNDER PROPOSED CONDITIONS) *

START TIME=0.0
RAINFALL TYPE=1 RAIN QUARTER=0.0 IN
RAIN ONE=2.01 IN RAIN SIX=2.35 IN
RAIN DAY=2.75 IN DT=0.03333 HR
* ON-SITE
COMPUTE NM HYD ID=1 HYD NO=100.1 AREA=0.000550 SQ MI
PER A=0.00 PER B=10.00 PER C=15.00 PER D=65.00
TP=0.1333 HR MASS RAINFALL=-1

* 10-YEAR, 6-HR STORM (UNDER PROPOSED CONDITIONS) *

START TIME=0.0
RAINFALL TYPE=1 RAIN QUARTER=0.0 IN
RAIN ONE=1.34 IN RAIN SIX=1.57 IN
RAIN DAY=1.83 IN DT=0.03333 HR
* ON-SITE
COMPUTE NM HYD ID=1 HYD NO=110.1 AREA=0.000550 SQ MI
PER A=0.00 PER B=10.00 PER C=15.00 PER D=65.00
TP=0.1333 HR MASS RAINFALL=-1

FINISH


AHYMO PROGRAM SUMMARY TABLE (AHYMO_97) -
INPUT FILE = 12th.txt

DRAINAGE CERTIFICATION

I, REZA AFAGHPOUR, NMPE 11814, OF SBS CONSTRUCTION AND ENGINEERING, LLC, HEREBY CERTIFY THAT THIS PROJECT HAS BEEN GRADED AND WILL DRAIN IN SUBSTANTIAL COMPLIANCE WITH AND IN ACCORDANCE WITH THE DESIGN INTENT OF THE APPROVED PLAN DATED 03-22-2015. THE RECORD INFORMATION EDITED ONTO THE ORIGINAL DESIGN DOCUMENT HAS BEEN OBTAINED BY NMPS 9801, OF SBS CONSTRUCTION AND ENGINEERING, LLC, I FURTHER CERTIFY THAT I HAVE PERSONALLY VISITED THE PROJECT SITE ON AND HAVE DETERMINED BY VISUAL INSPECTION THAT THE SURVEY DATA PROVIDED IS REPRESENTATIVE OF ACTUAL SITE CONDITIONS AND IS TRUE AND CORRECT TO THE BEST OF MY KNOWLEDGE AND BELIEF. THIS CERTIFICATION IS SUBMITTED IN SUPPORT OF A REQUEST FOR FINAL CERTIFICATE OF OCCUPANCY.

THE RECORD INFORMATION PRESENTED HEREON IS NOT NECESSARILY COMPLETE AND INTENDED ONLY TO VERIFY SUBSTANTIAL COMPLIANCE OF THE GRADING AND DRAINAGE ASPECTS OF THIS PROJECT. THOSE RELYING ON THIS RECORD DOCUMENT ARE ADVISED TO OBTAIN INDEPENDENT VERIFICATION OF ITS ACCURACY BEFORE USING IT FOR ANY OTHER PURPOSE.

REZA AFAGHPOUR, NMPE 11814
DATE 02/03/2016
REZA AFAGHPOUR, NMPE 11814
DATE 02/03/2016

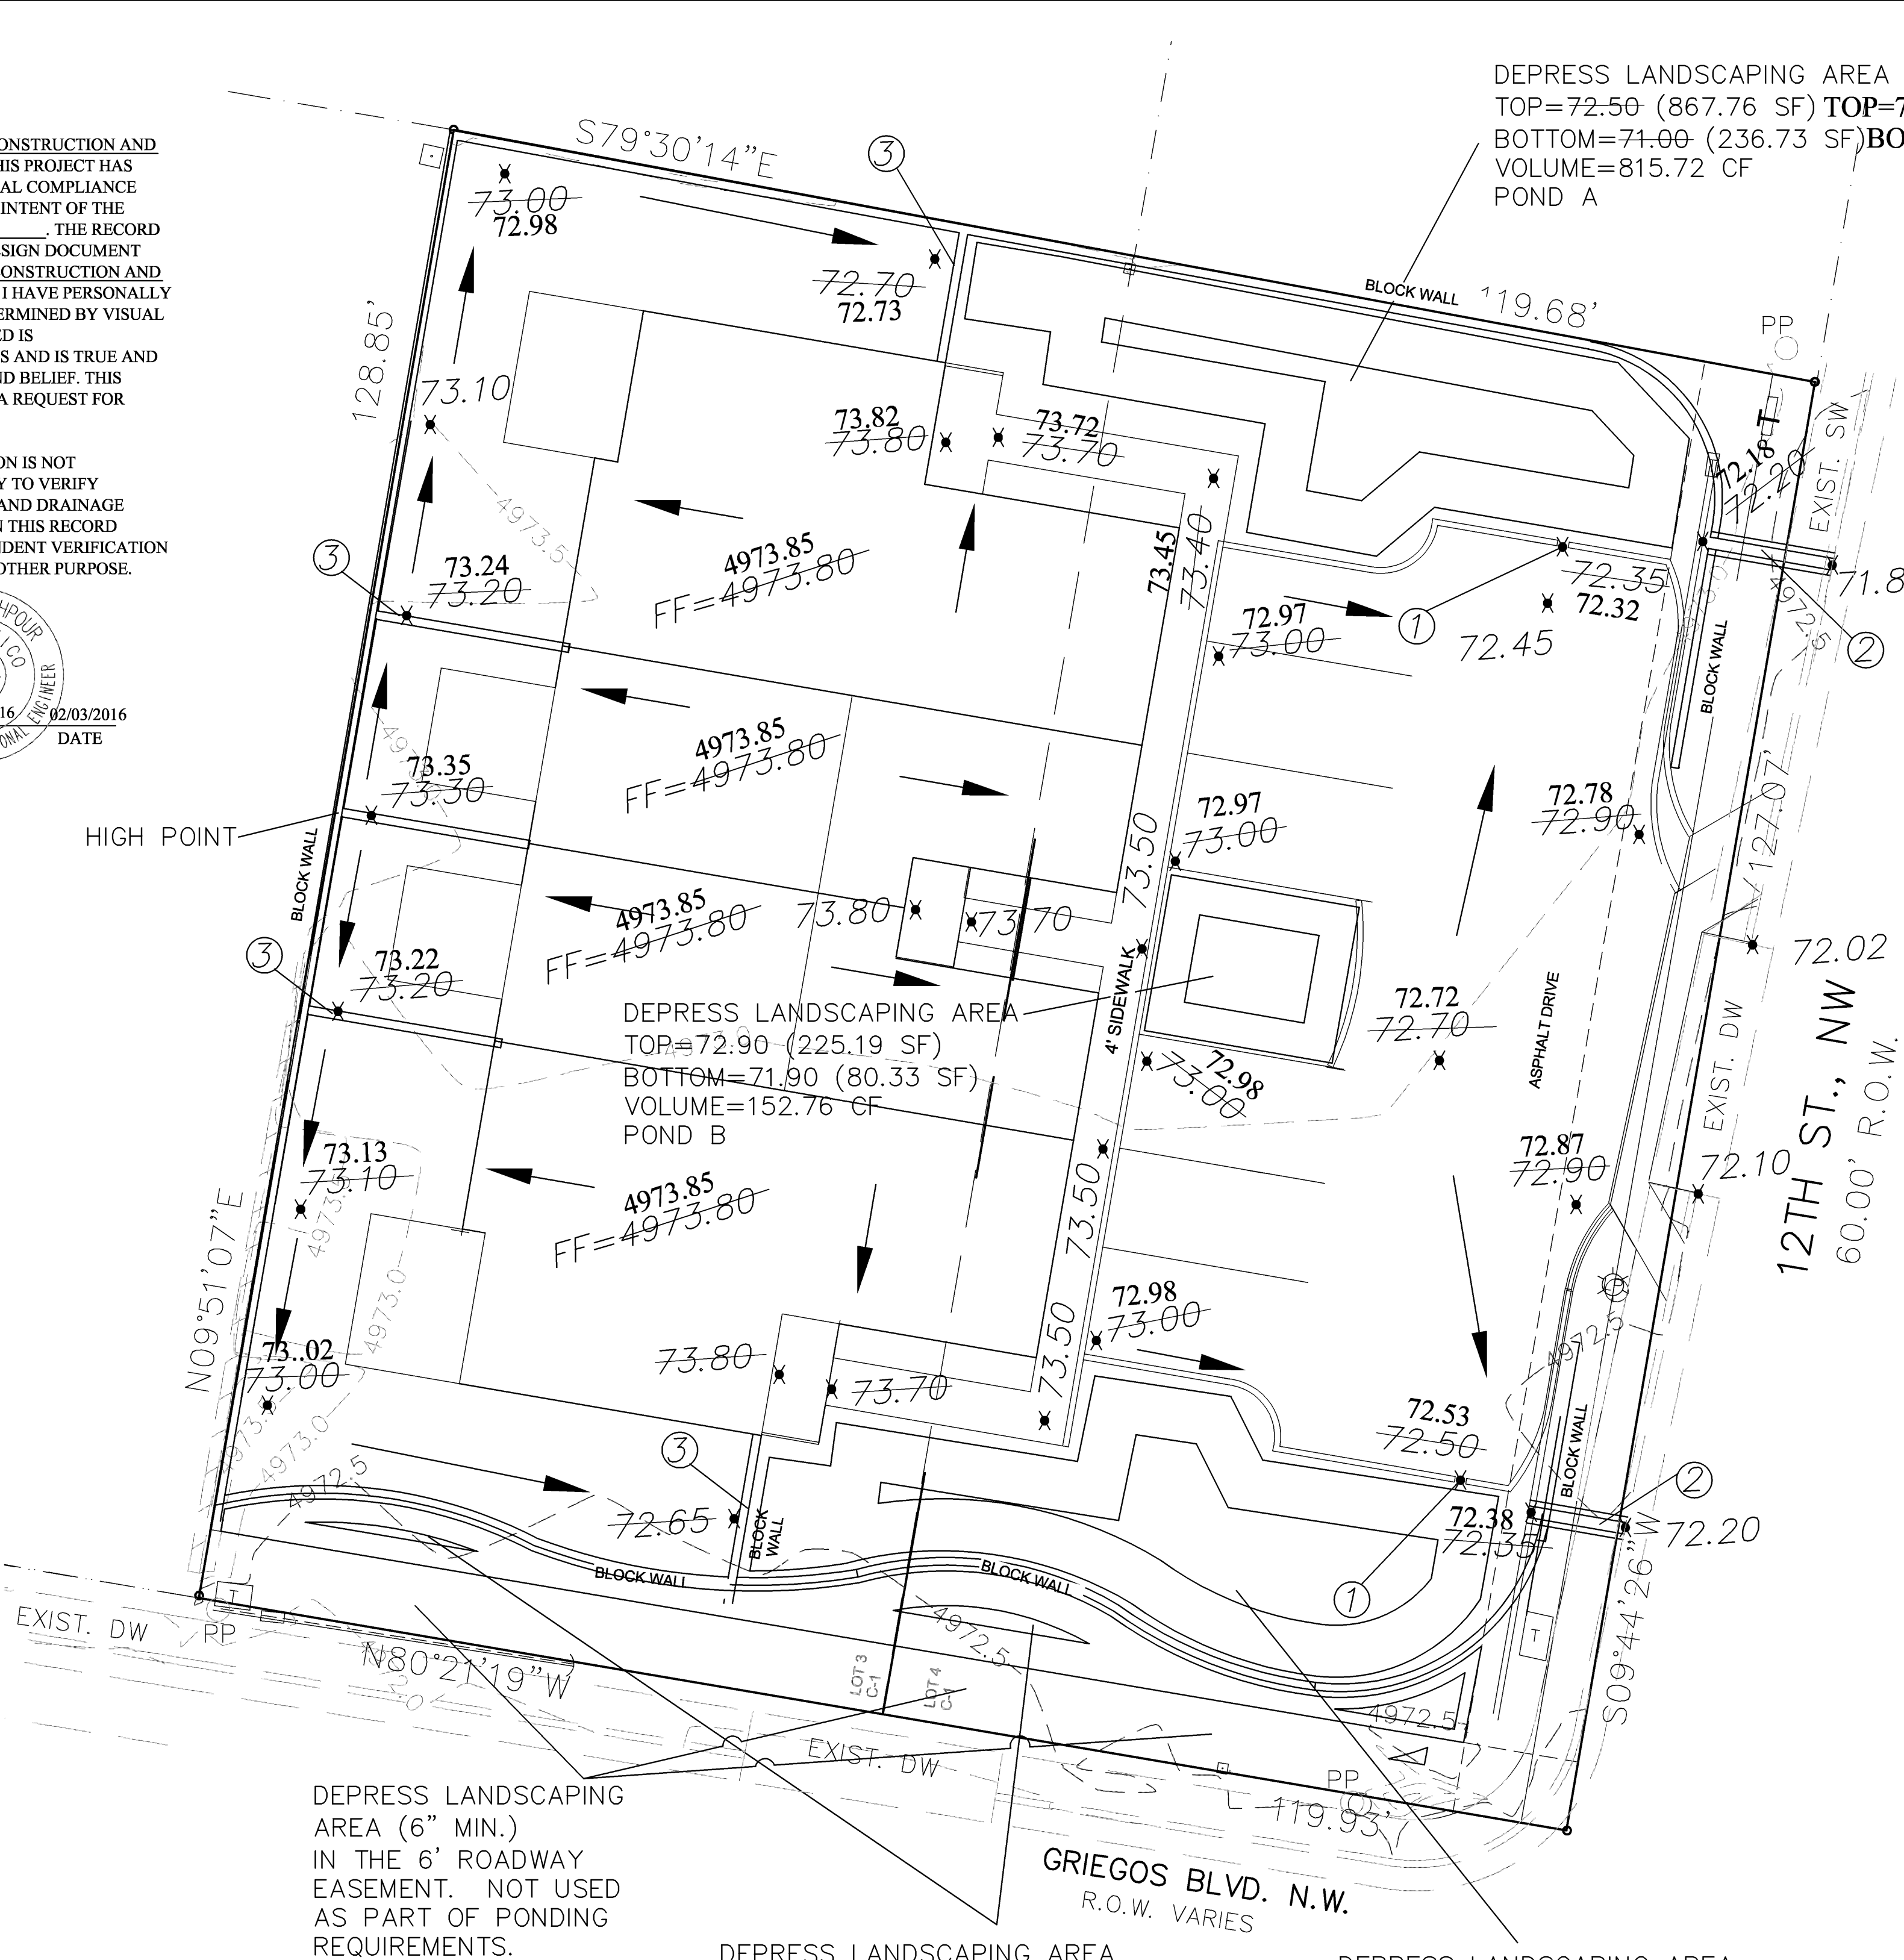

DEPRESS LANDSCAPING AREA
TOP=72.50 (436.96 SF) TOP=72.45
BOTTOM=71.50 (25.37 SF) BOT=71.58
VOLUME=231.17 CF
POND C


DEPRESS LANDSCAPING AREA
TOP=72.60 (893.48 SF) TOP=72.63
BOTTOM=71.10 (243.30 SF) BOT=71.05
VOLUME=852.59 CF
POND D

NOTES:

1. PROVIDE 12" CURB OPENING
2. 12" SIDEWALK CULRVET PER CITY STD DWG 2236 (TACK WELD PLATE AT THE BOLT)
3. 6" WALL OPENING (OR TURN TWO BLOCKS) BUILD #4 REBAR AT 3" ON CENTER

POND CALCULATION

TOTAL POND AREA PROVIDED = POND A + B + C + D = 2,052.23 CF
TOTAL PONDING VOLUME REQUIRED = VOL. PROPOSED CONDITIONS - VOL. EXISTING CONDITIONS
= 0.053 - 0.023 = 0.03 AC-FT = 1,306.80 CF
TOTAL PONDING VOLUME REQUIRED (VALLEY) = 0.5 INCHES x AREA = (0.5/12 x 15,329.81) = 638.74 CF
TOTAL PONDING VOLUME REQUIRED (90TH PERCENTILE/FIRST FLUSH) = 0.34 INCHES x IMPERVIOUS AREA = (0.34/12 x 9,964.38) = 282.32 CF

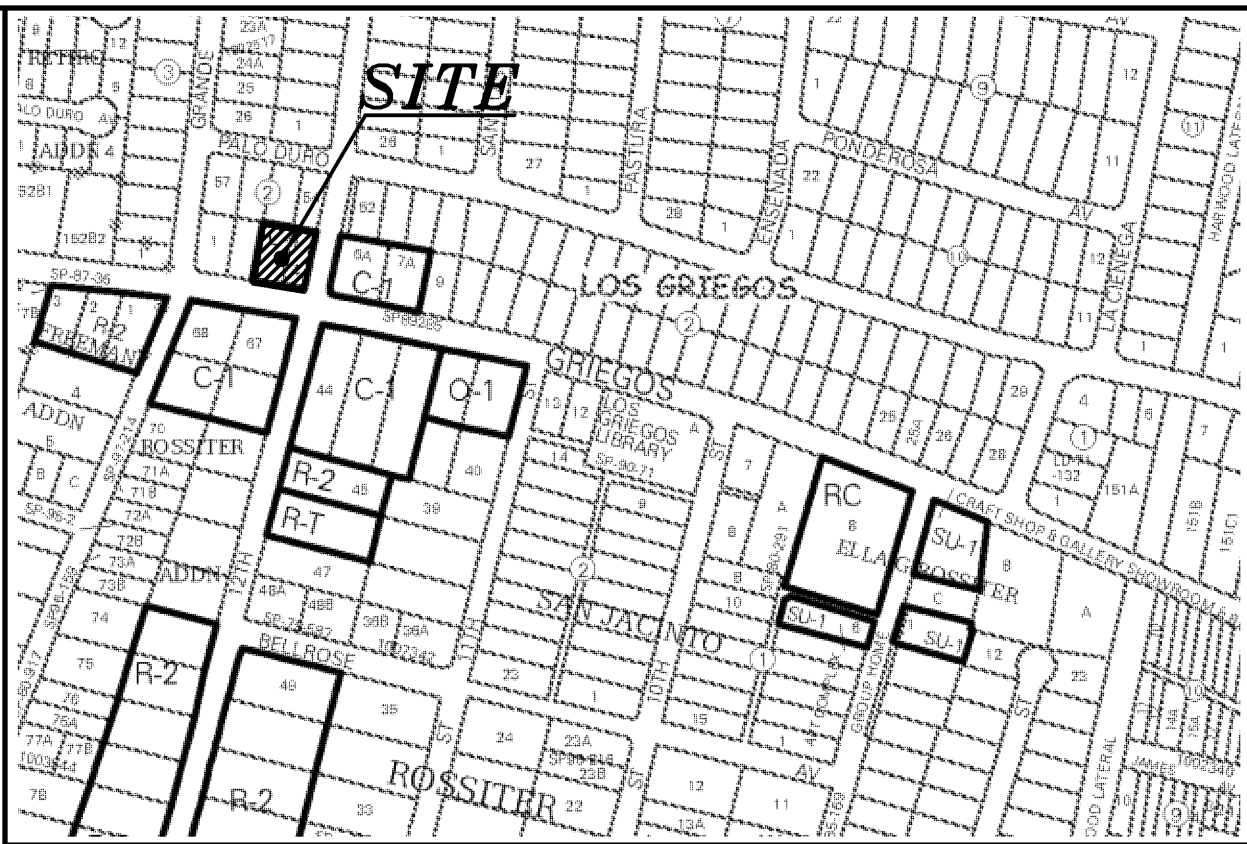

VICINITY MAP: F-14-Z

LEGAL DESCRIPTION:
LOTS 3 AND 4, BLOCK 2, SANDIA PLAZA
CONTAINING 15,329.81 S.F. (0.3519 ACRE)
ZONING: C-1 USES

ADDRESS:
203 GRIEGOS ROAD N.W.

- GENERAL NOTES:**
- 1: CONTOUR INTERVAL IS HALF (0.50) FOOT.
 - 2: ELEVATIONS ARE BASED ON CITY OF ALBUQUERQUE CONTROL STATION LSS_206, HAVING AN ELEVATION OF 4976.652 FEET ABOVE SEA LEVEL.
 - 3: UTILITIES SHOWN HEREON ARE IN THEIR APPROXIMATE LOCATION BASED ONLY ON ABOVE GROUND EVIDENCE FOUND IN THE FIELD AND AS-BUILT INFORMATION PROVIDED BY THE CLIENT. UTILITIES SHOWN HEREON, WHETHER INDICATED AS ABANDONED OR NOT, SHALL BE VERIFIED BY OTHERS FOR EXACT LOCATION AND/ OR DEPTH PRIOR TO EXCAVATION OR DESIGN CONSIDERATIONS.
 - 4: THIS IS NOT A BOUNDARY SURVEY, BEARINGS ARE ASSUMED, DISTANCES AND FOUND PROPERTY CORNERS ARE FOR INFORMATIONAL PURPOSES ONLY.
 - 5: SLOPES ARE AT 3:1 MAXIMUM.

NOTICE TO CONTRACTORS

1. AN EXCAVATION/CONSTRUCTION PERMIT WILL BE REQUIRED BEFORE BEGINNING ANY WORK WITHIN CITY RIGHT-OF-WAY.
2. ALL WORK DETAILED ON THESE PLANS TO BE PERFORMED, EXCEPT AS OTHERWISE STATED OR PROVIDED HEREON, SHALL BE CONSTRUCTED IN ACCORDANCE WITH CITY OF ALBUQUERQUE INTERIM STANDARD SPECIFICATIONS FOR PUBLIC WORKS CONSTRUCTION, 1985.
3. TWO WORKING DAYS PRIOR TO ANY EXCAVATION, CONTRACTOR MUST CONTACT LINE LOCATING SERVICE, 765-1234, FOR LOCATION OF EXISTING UTILITIES.
4. PRIOR TO CONSTRUCTION, THE CONTRACTOR SHALL EXCAVATE AND VERIFY THE HORIZONTAL AND VERTICAL LOCATIONS OF ALL CONSTRUCTIONS. SHOULD A CONFLICT EXIST, THE CONTRACTOR SHALL NOTIFY THE ENGINEER SO THAT THE CONFLICT CAN BE RESOLVED WITH A MINIMUM AMOUNT OF DELAY.
5. BACKFILL COMPACTION SHALL BE ACCORDING TO TRAFFIC/STREET USE.
6. MAINTENANCE OF THESE FACILITIES SHALL BE THE RESPONSIBILITY OF THE OWNER OF THE PROPERTY SERVED.
7. WORK ON ARTERIAL STREETS SHALL BE PERFORMED ON A 24-HOUR BASIS.

LEGEND

- 5100--- EXISTING CONTOUR (MAJOR)
- 5102--- EXISTING CONTOUR (MINOR)
- BOUNDARY LINE
- x 85.46 PROPOSED SPOT ELEVATION
- x 5265.16 EXISTING GRADE
- x 5284.43 EXISTING FLOWLINE ELEVATION
- FL
- BC=89.08 BOTTOM OF CHANEL
- TRW=91.50 TOP OF RETAINING WALL
- TF=88.00 TOP OF FOOTING
- HP HIGH POINT
- 86.65 AS-BUILT GRADES
- 85.47

REZA AFAGHPOUR
P.E. #11814


SBS CONSTRUCTION
AND ENGINEERING, LLC

10209 SNOWFLAKE CT., NW
ALBUQUERQUE, NEW MEXICO 87114
(505)899-3570

4 UNIT TOWNHOUSE DEVELOPMENT
GRADING AND DRAINAGE PLAN

DRAWING:	DRAWN BY:	DATE:	SHEET #
201418-GR.DWG	SH-B	12-22-2014	

GRAPHIC SCALE

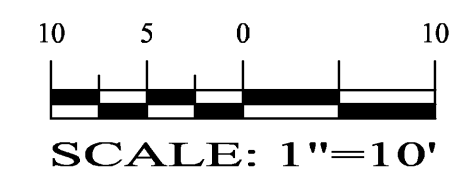

LAST REVISION: 02/22/2015