

~~F-16-014~~
709082

**PRIVATE FACILITY
DRAINAGE COVENANT**

#1

This Drainage Covenant ("Covenant"), between -STATE EMPLOYEES CREDIT UNION, ("Owner"), whose address is 813 SAINT MICHAELS DRIVE, SANTA FE, NM 87505, and the City of Albuquerque, a New Mexico municipal corporation ("City") whose address is P.O. Box 1293, Albuquerque, New Mexico 87103, is made in Albuquerque, Bernalillo County, New Mexico and is entered into as of the date Owner signs this Covenant.

1. Recital. The Owner is the current owner of the following described real property located at LOT G2A1 MONTGOMERY COMPLEX (FILED 1/12/17- DOCUMENT#2017003071) in Bernalillo County, New Mexico (the "Property").

Pursuant to City ordinances, regulations and other applicable laws, the Owner is required to construct and maintain certain drainage facilities on the Property, and the parties wish to enter into this Covenant to establish the obligations and responsibilities of the parties.

2. Description and Construction of Drainage Facility. The Owner shall construct the following "Drainage Facility" within the Property at the at the Owner's sole expense in accordance with the standards, plans and specifications approved by the City:
DETENION/RETENTION POND AS SHOWN APPROVED GRADING PLAN FILE F16/D001

The Drainage Facility is more particularly described in Exhibit A attached hereto and made a part hereof.

3. Maintenance of Drainage Facility. The Owner shall maintain the Drainage Facility at Owner's sole cost in accordance with the approved Drainage Report and plans.

4. Benefit to Property. The Owner acknowledges and understands that the Drainage Facility required herein to be constructed on the Owner's property is for the private benefit and protection of the Owner's property and that failure to maintain such facility could result in damage or loss to the Property.

5. Inspection of Drainage Facility. The City shall have no duty or obligation whatsoever to perform any inspection, maintenance or repair of the Drainage Facility, it being the duty of the Owner, its heirs, successors and assigns to construct and maintain the facility in accordance with approved plans and specifications.

6. Liability of City. The Owner understands and agrees that the City shall not be liable to the Owner, its heirs, successors or assigns, or to any third parties for any damages resulting from the Owner's failure to construct, maintain or repair the Drainage Facility.

7. Indemnification. The Owner owns and controls the Drainage Facility and shall not permit the Drainage Facility to constitute a hazard to the health or safety of the general public. The Owner agrees to indemnify, defend and hold harmless the City, its officials, agents

and employees, from any claims, actions, suits or other proceedings arising from or out of the negligent acts or omissions of the Owner, its agents, representatives, contractors or subcontractors or arising from the failure of the Owner, its agents, representatives, contractors or subcontractors to perform any act or duty required of the Developer or Owner herein; provided, however, to the extent, if at all, Section 56-7-1 NMSA 1978 is applicable to this Covenant, this Covenant to indemnify will not extend to liability, claims, damages, losses or expenses, including attorneys' fees, arising out of (1) the preparation or approval of maps, drawings, opinions, reports, surveys, change orders, designs or specifications by the respective indemnitee, or the agents or employees of the respective indemnitee; or (2) the giving of or the failure to give direction or instructions by the respective indemnitee, where such giving or failure to give directions or instructions is the primary cause of bodily injury to persons or damage to property.

8. Assessment. Nothing in this Covenant shall be construed to relieve the Owner, its heirs, assigns and successors from an assessment against the Owner's property for improvements to the property under a duly authorized and approved Special Assessment District. The parties specifically agree that the value of the Drainage Facility will not reduce the amount assessed by the City.

9. Binding on Owner's Property. The covenants and obligations of the Owner set forth herein shall be binding on the Owner, its heirs, assigns and successors and on the Owner's property and constitute covenants running with the Owner's property until released by the City. This Covenant can only be released by the City's Chief Administrative Officer with concurrence of the City Engineer.

10. Entire Covenant. This Covenant contains the entire agreement of the parties and supersedes any and all other agreements or understandings, oral or written, whether previous to the execution hereof or contemporaneous herewith.

11. Changes to Covenant. Changes to this Covenant are not binding unless made in writing, signed by both parties.

12. Effective Date of Covenant. This Covenant shall be effective as of the date of signature of the Owner.

ACCEPTED: CITY OF ALBUQUERQUE

OWNER: State Employees Credit Union

By: [Signature]
Robert J. Perry
Chief Administrative Officer
Dated: 6/21/17

By: [Signature]
[print name] Harold V. Dixon
Title: President/CEO
Dated: 6-1-2017

RECOMMENDED:
By: [Signature]
Shahab Biazar, P.E. City Engineer

CITY'S ACKNOWLEDGMENT

STATE OF NEW MEXICO)
)ss
COUNTY OF BERNALILLO)

This instrument was acknowledged before me on this 21st day of June 2017, by Robert J. Perry, Chief Administrative Officer of the City of Albuquerque, a New Mexico municipal corporation, on behalf of the corporation.

(Notary Seal)


[Signature]
Notary Public
My Commission Expires: 03/27/21



OWNER'S ACKNOWLEDGMENT

STATE OF NEW MEXICO)
)ss
COUNTY OF BERNALILLO)

This instrument was acknowledged before me on this 1 day of June 2017, by Harold Dixon (name of person signing), President/CEO (title of person signing), on behalf of State Employees Credit Union (name of company).

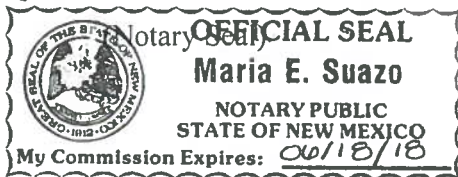


[Signature]
Notary Public
My Commission Expires: 06/18/18

(EXHIBIT A ATTACHED)

EROSION CONTROL NOTES:

1. CONTRACTOR IS RESPONSIBLE FOR OBTAINING A TOPSOIL DISTURBANCE PERMIT PRIOR TO BEGINNING WORK.
2. CONTRACTOR IS RESPONSIBLE FOR MAINTAINING RUN-OFF ON SITE DURING CONSTRUCTION.
3. CONTRACTOR IS RESPONSIBLE FOR CLEANING ALL SEDIMENT THAT GETS INTO EXISTING RIGHT-OF-WAY.
4. REPAIR OF DAMAGED FACILITIES AND CLEANUP OF SEDIMENT ACCUMULATED ON ADJACENT PROPERTIES AND IN PUBLIC FACILITIES IS THE RESPONSIBILITY OF THE CONTRACTOR.
5. ALL EXPOSED EARTH SURFACES MUST BE PROTECTED FROM WIND AND WATER EROSION PRIOR TO FINAL ACCEPTANCE OF ANY PROJECT.

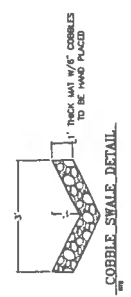

I David Seale, NFFE 14522, of the firm RAC GRADE ENGINEERING, hereby certify that this project has been graded and will obtain substantial compliance with and in accordance with the requirements of the Montgomery County Ordinance No. 10-18-16, as amended, and that the information contained in this report is true and correct to the best of my knowledge and belief. The as-built survey was provided by RAC GRADE ENGINEERING, NFFE 14522. The certification is submitted in support of a request for PERMANENT CERTIFICATE OF OCCUPANCY. The record information presented herein is not necessarily complete and intended only to rely on this record document are advised to obtain independent verification of its accuracy before using it for any other purpose.


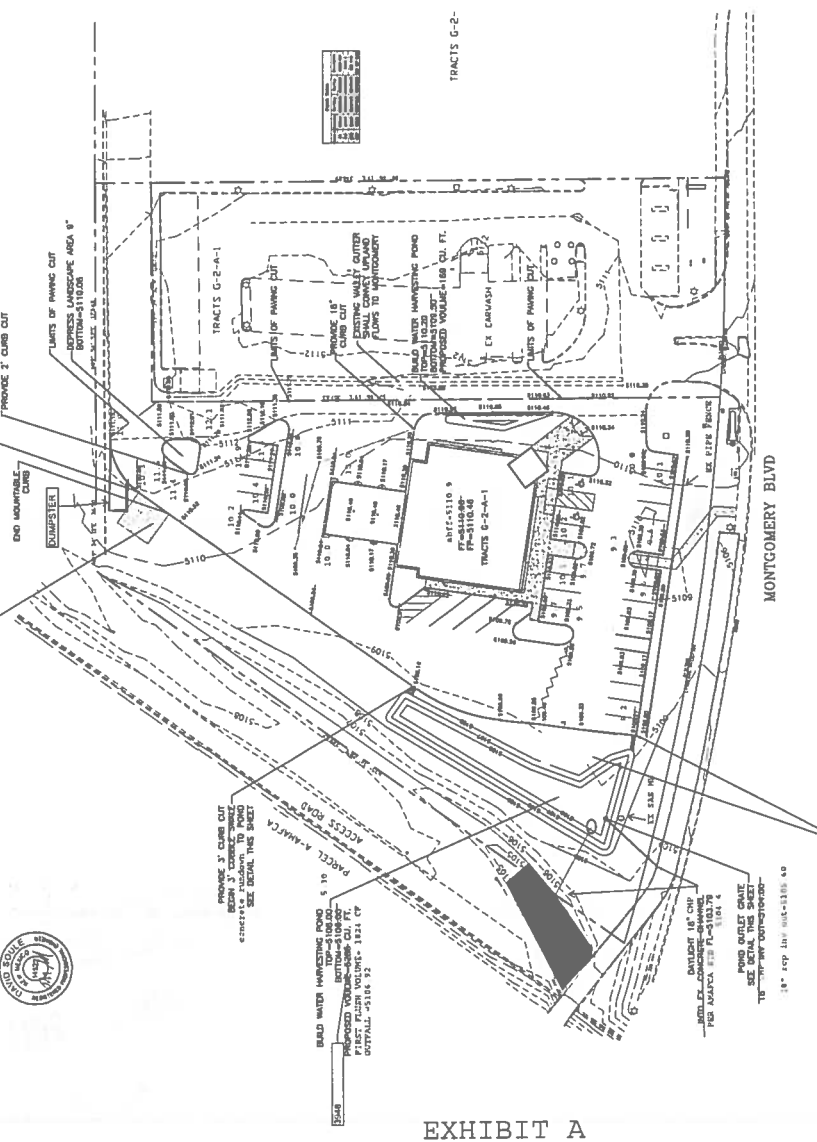


EXHIBIT A

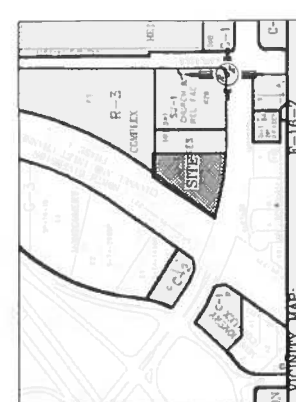



PERM MAP: FMS5001C0130H
LEGAL DESCRIPTION: TRACTS G-2-A-1, MONTGOMERY COMPLEX

NOTES:
ALL SPOT ELEVATIONS REPRESENT FLOOR/ELEVATION UNLESS OTHERWISE NOTED.

LEGEND

- EXISTING CONTOUR
- EXISTING INDEX CONTOUR
- PROPOSED CONTOUR
- PROPOSED INDEX CONTOUR
- 3:1 SLOPE THE MAX.
- EXISTING SPOT ELEVATION
- PROPOSED SPOT ELEVATION
- BOUNDARY
- PROPOSED LOT LINE
- RIGHT-OF-WAY
- PROPOSED CURB AND GUTTER
- EXISTING CURB
- PROPOSED SCREEN WALL
- PROPOSED RETAINING WALL
- DESIGN BY OTHERS

DESIGNER'S SEAL	STATE EMPLOYEE FEDERAL CREDIT UNION
DATE: 10-18-16	GRADING AND DRAINAGE PLAN
10-18-16	PROJECT: RAC GRADE ENGINEERING
SHEET 4	DATE: 10-18-16
JOB # 21422	P.L. # 14522

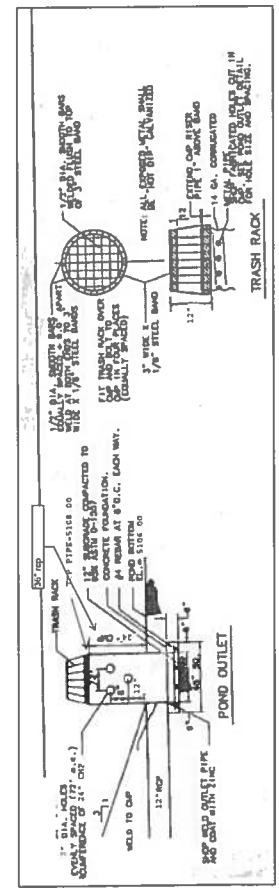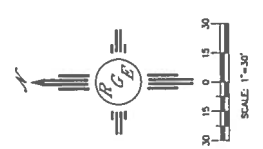

CAUTION:
DIMENSIONS ARE NOT SHOWN. IT SHALL BE THE SOLE RESPONSIBILITY OF THE CONTRACTOR TO OBTAIN NECESSARY FIELD INVESTIGATIONS PRIOR TO CONSTRUCTION OF UTILITIES & OTHER IMPROVEMENTS.