


RECEIVED
FEB 14 2001
HYDROLOGY SECTION

RECEIVED
FEB 14 2001
HYDROLOGY SECTION

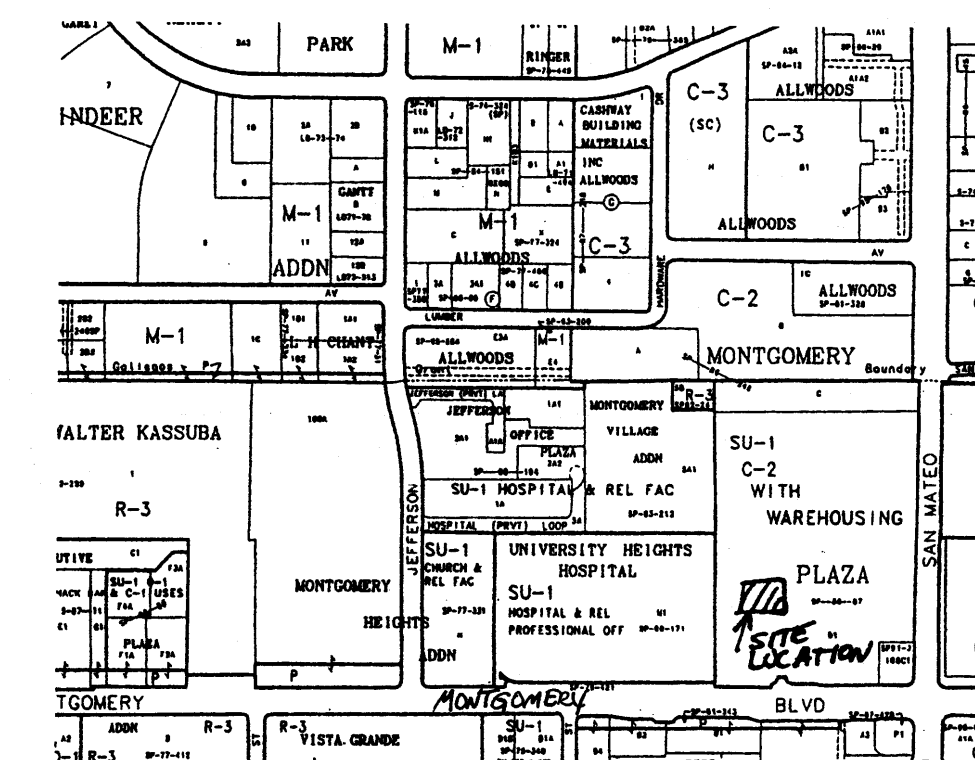

VICINITY MAP ZONE MAP: F-17

ACS BENCHMARK


ACS 9-F18
X= 399264.65 Y= 1504295.63
ELEV.= 5209.56

LEGAL DESCRIPTION

TRCT D-1, MONTGOMERY O\PLAZA

LEGEND



- 93.82 TC PROPOSED TOP OF CONCRETE ELEVATION
- 93.82 TA PROPOSED TOP OF ASPHALT ELEVATION
- LOW POINT
- 1.0% SLOPE
- EXIST. TOP OF CURB ELEVATION
EXIST. FLOWLINE ELEVATION
- EXIST. SPOT ELEVATION

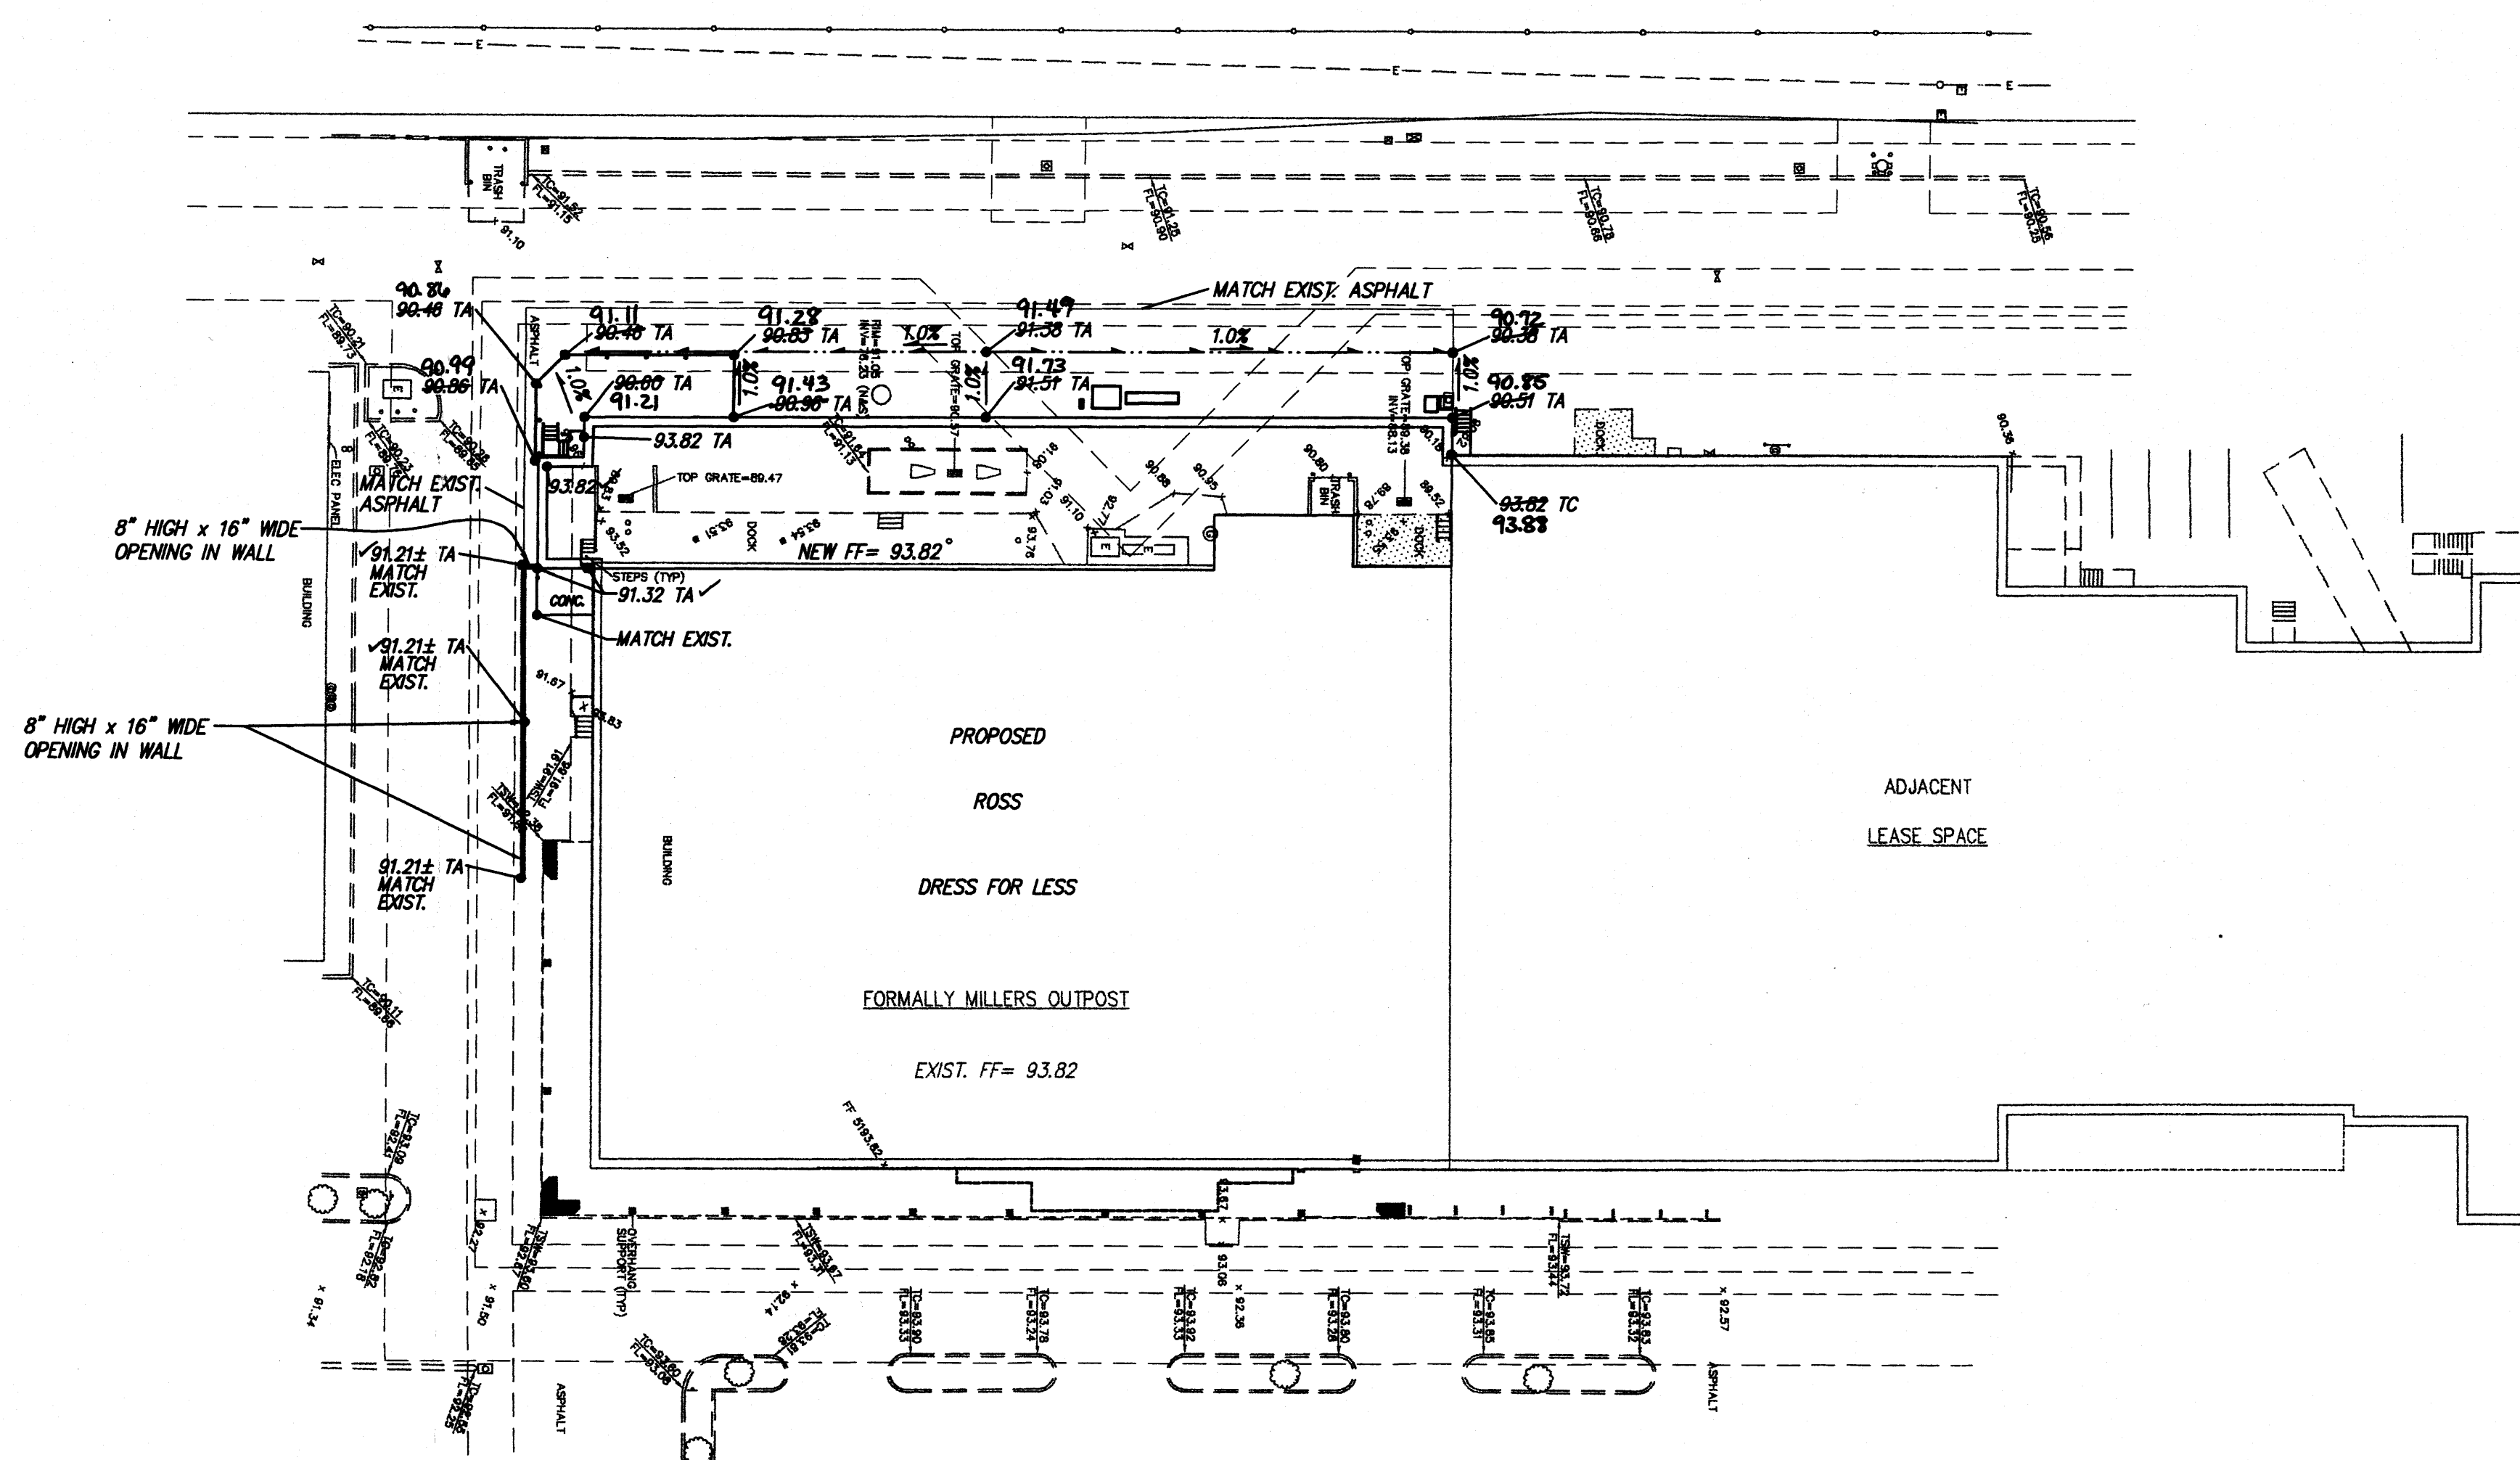

RECORD DRAWING

I hereby certify that the information contained on this drawing has been revised in accordance with information furnished by the contractor, Hart Construction, and by the surveyor, David Evans & Associates, and reflects the construction as actually accomplished. This plan as constructed is in substantial compliance with the Approved Plan.

Mark Goodwin
NMPE 8948

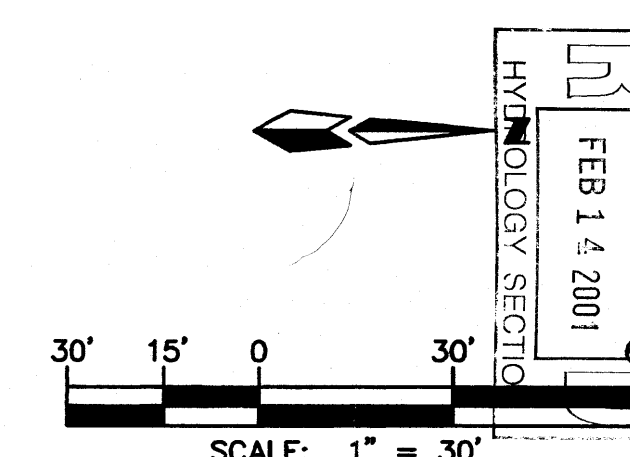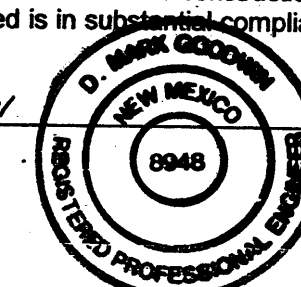

MONTGOMERY PLAZA GRADING AND DRAINAGE PLAN


dmg MARK GOODWIN & ASSOCIATES, P.A.
CONSULTING ENGINEERS
P.O. BOX 90606
ALBUQUERQUE, NEW MEXICO 87199
(505)828-2200, FAX (505)797-9539

Designed: ALD Drawn: KJS Checked: DMG Sheet 1 of 1
Scale: 1" = 30' Date: 7/00 Job: A0073

RECEIVED
FEB 14 2001
HYDROLOGY SECTION

RECEIVED
FEB 14 2001
HYDROLOGY SECTION

RECEIVED
FEB 14 2001
HYDROLOGY SECTION

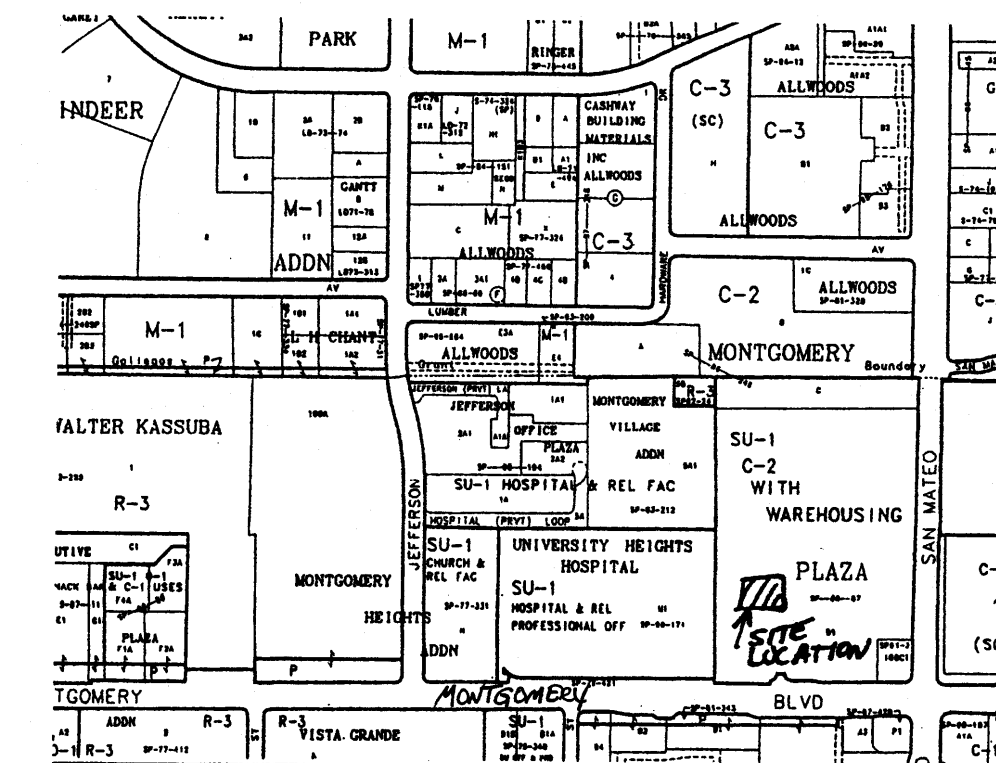

VICINITY MAP ZONE MAP: F-17

ACS BENCHMARK


ACS 9-F18
X= 399264.65 Y= 1504295.63
ELEV= 5209.56

LEGAL DESCRIPTION

TRCT D-1, MONTGOMERY O\PLAZA

LEGEND



- 93.82 TC PROPOSED TOP OF CONCRETE ELEVATION
- 93.82 TA PROPOSED TOP OF ASPHALT ELEVATION
- LOW POINT
- 1.0% SLOPE
- EXIST. TOP OF CURB ELEVATION
- EXIST. FLOWLINE ELEVATION
- EXIST. SPOT ELEVATION

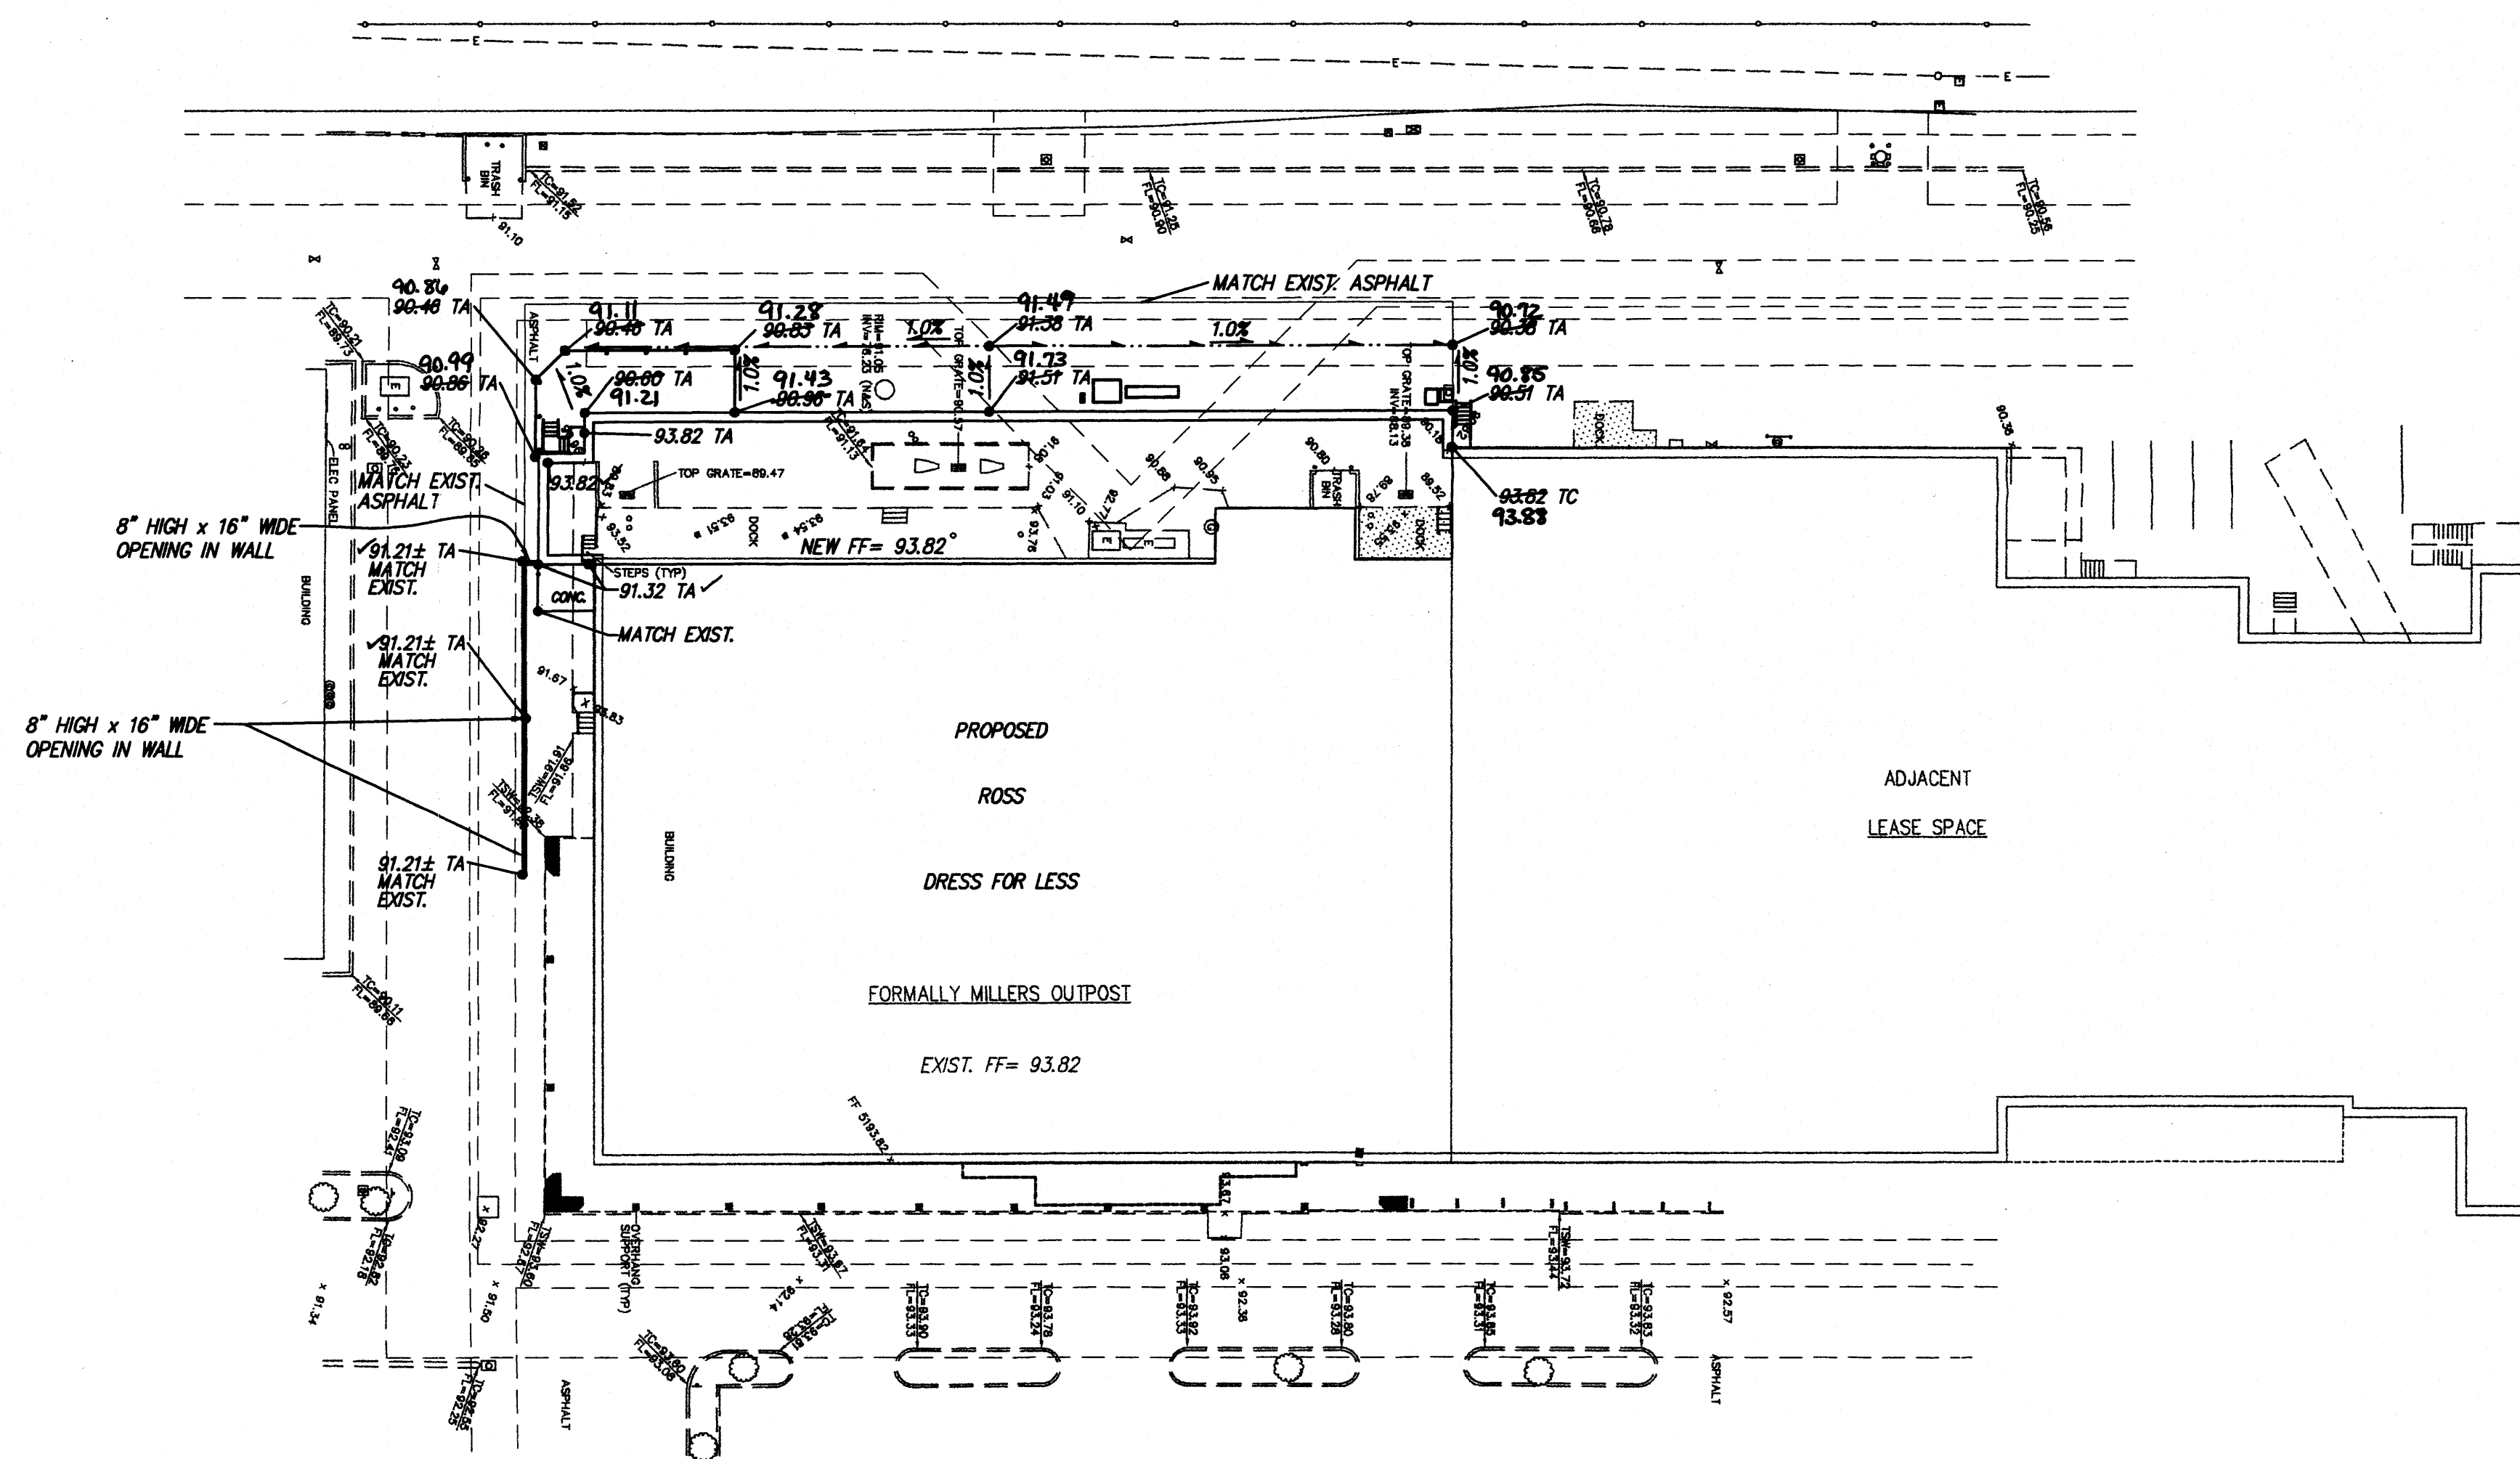

RECORD DRAWING

I hereby certify that the information contained on this drawing has been revised in accordance with information furnished by the contractor, Hart Construction, and by the surveyor, David Evans & Associates, and reflects the construction as actually accomplished. This plan as constructed is in substantial compliance with the Approved Plan.

Mark Goodwin
NMPE 8948

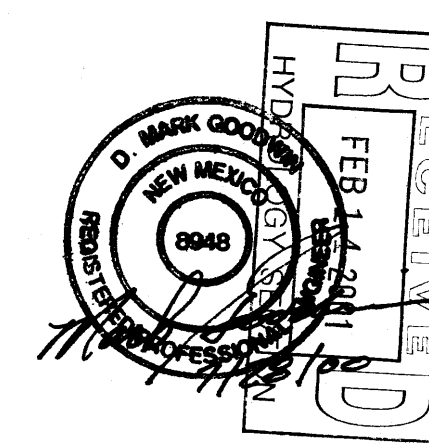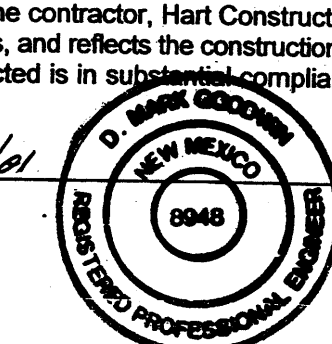

SCALE: 1" = 30'


MONTGOMERY PLAZA
GRADING AND DRAINAGE PLAN

dmg MARK GOODWIN & ASSOCIATES, P.A.
CONSULTING ENGINEERS
P.O. BOX 90606
ALBUQUERQUE, NEW MEXICO 87199
(505)828-2200, FAX (505)797-9539

Designed: ALD Drawn: KJS Checked: DMG
Scale: 1" = 30' Date: 7/00 Job: A0073 Sheet 1 of 1

A0073MONT/SITEPLAN/25-27-00 KJS NHM

RECEIVED
FEB 14 2001
HYDROLOGY SECTION

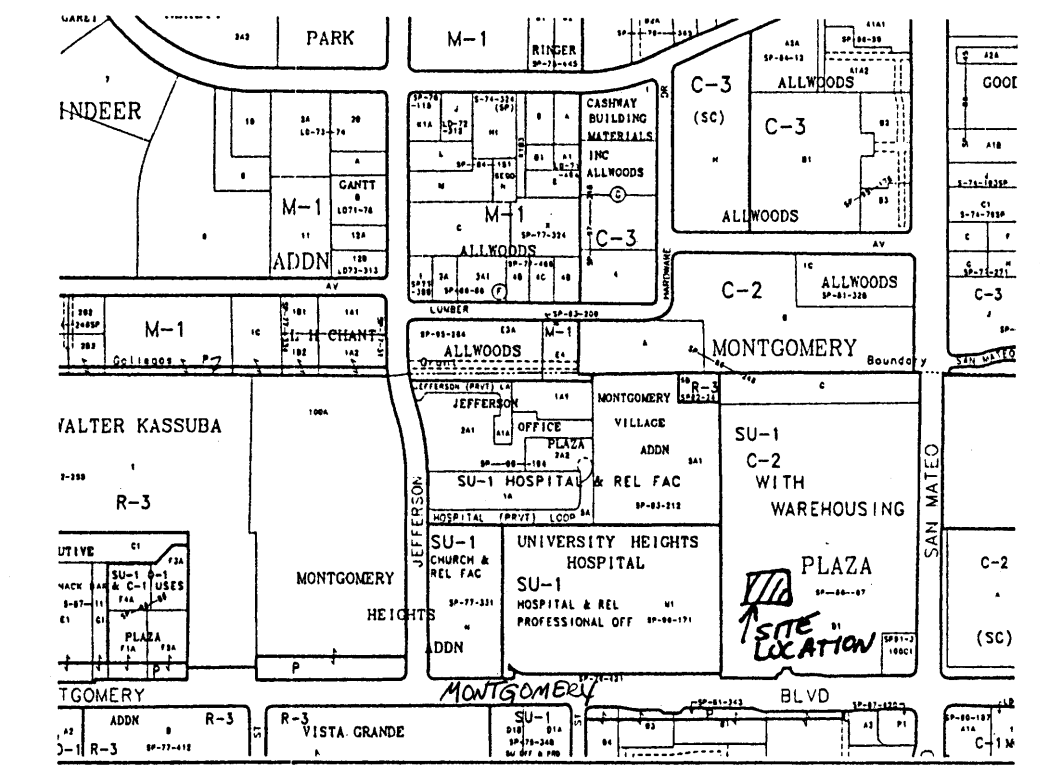

VICINITY MAP ZONE MAP: F-17

ACS BENCHMARK



ACS 9-F18
X= 399264.65 Y= 1504295.63
ELEV= 5209.56

LEGAL DESCRIPTION

TRCT D-1, MONTGOMERY O\PLAZA


LEGEND

- 93.82 TC PROPOSED TOP OF CONCRETE ELEVATION
- 93.82 TA PROPOSED TOP OF ASPHALT ELEVATION
- 1.0% SLOPE LOW POINT
- EXIST. TOP OF CURB ELEVATION
EXIST. FLOWLINE ELEVATION
- EXIST. SPOT ELEVATION

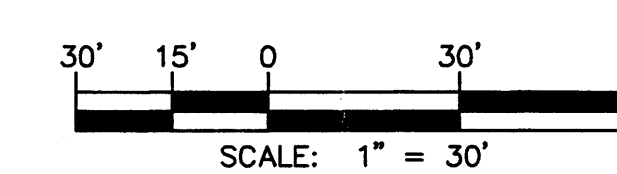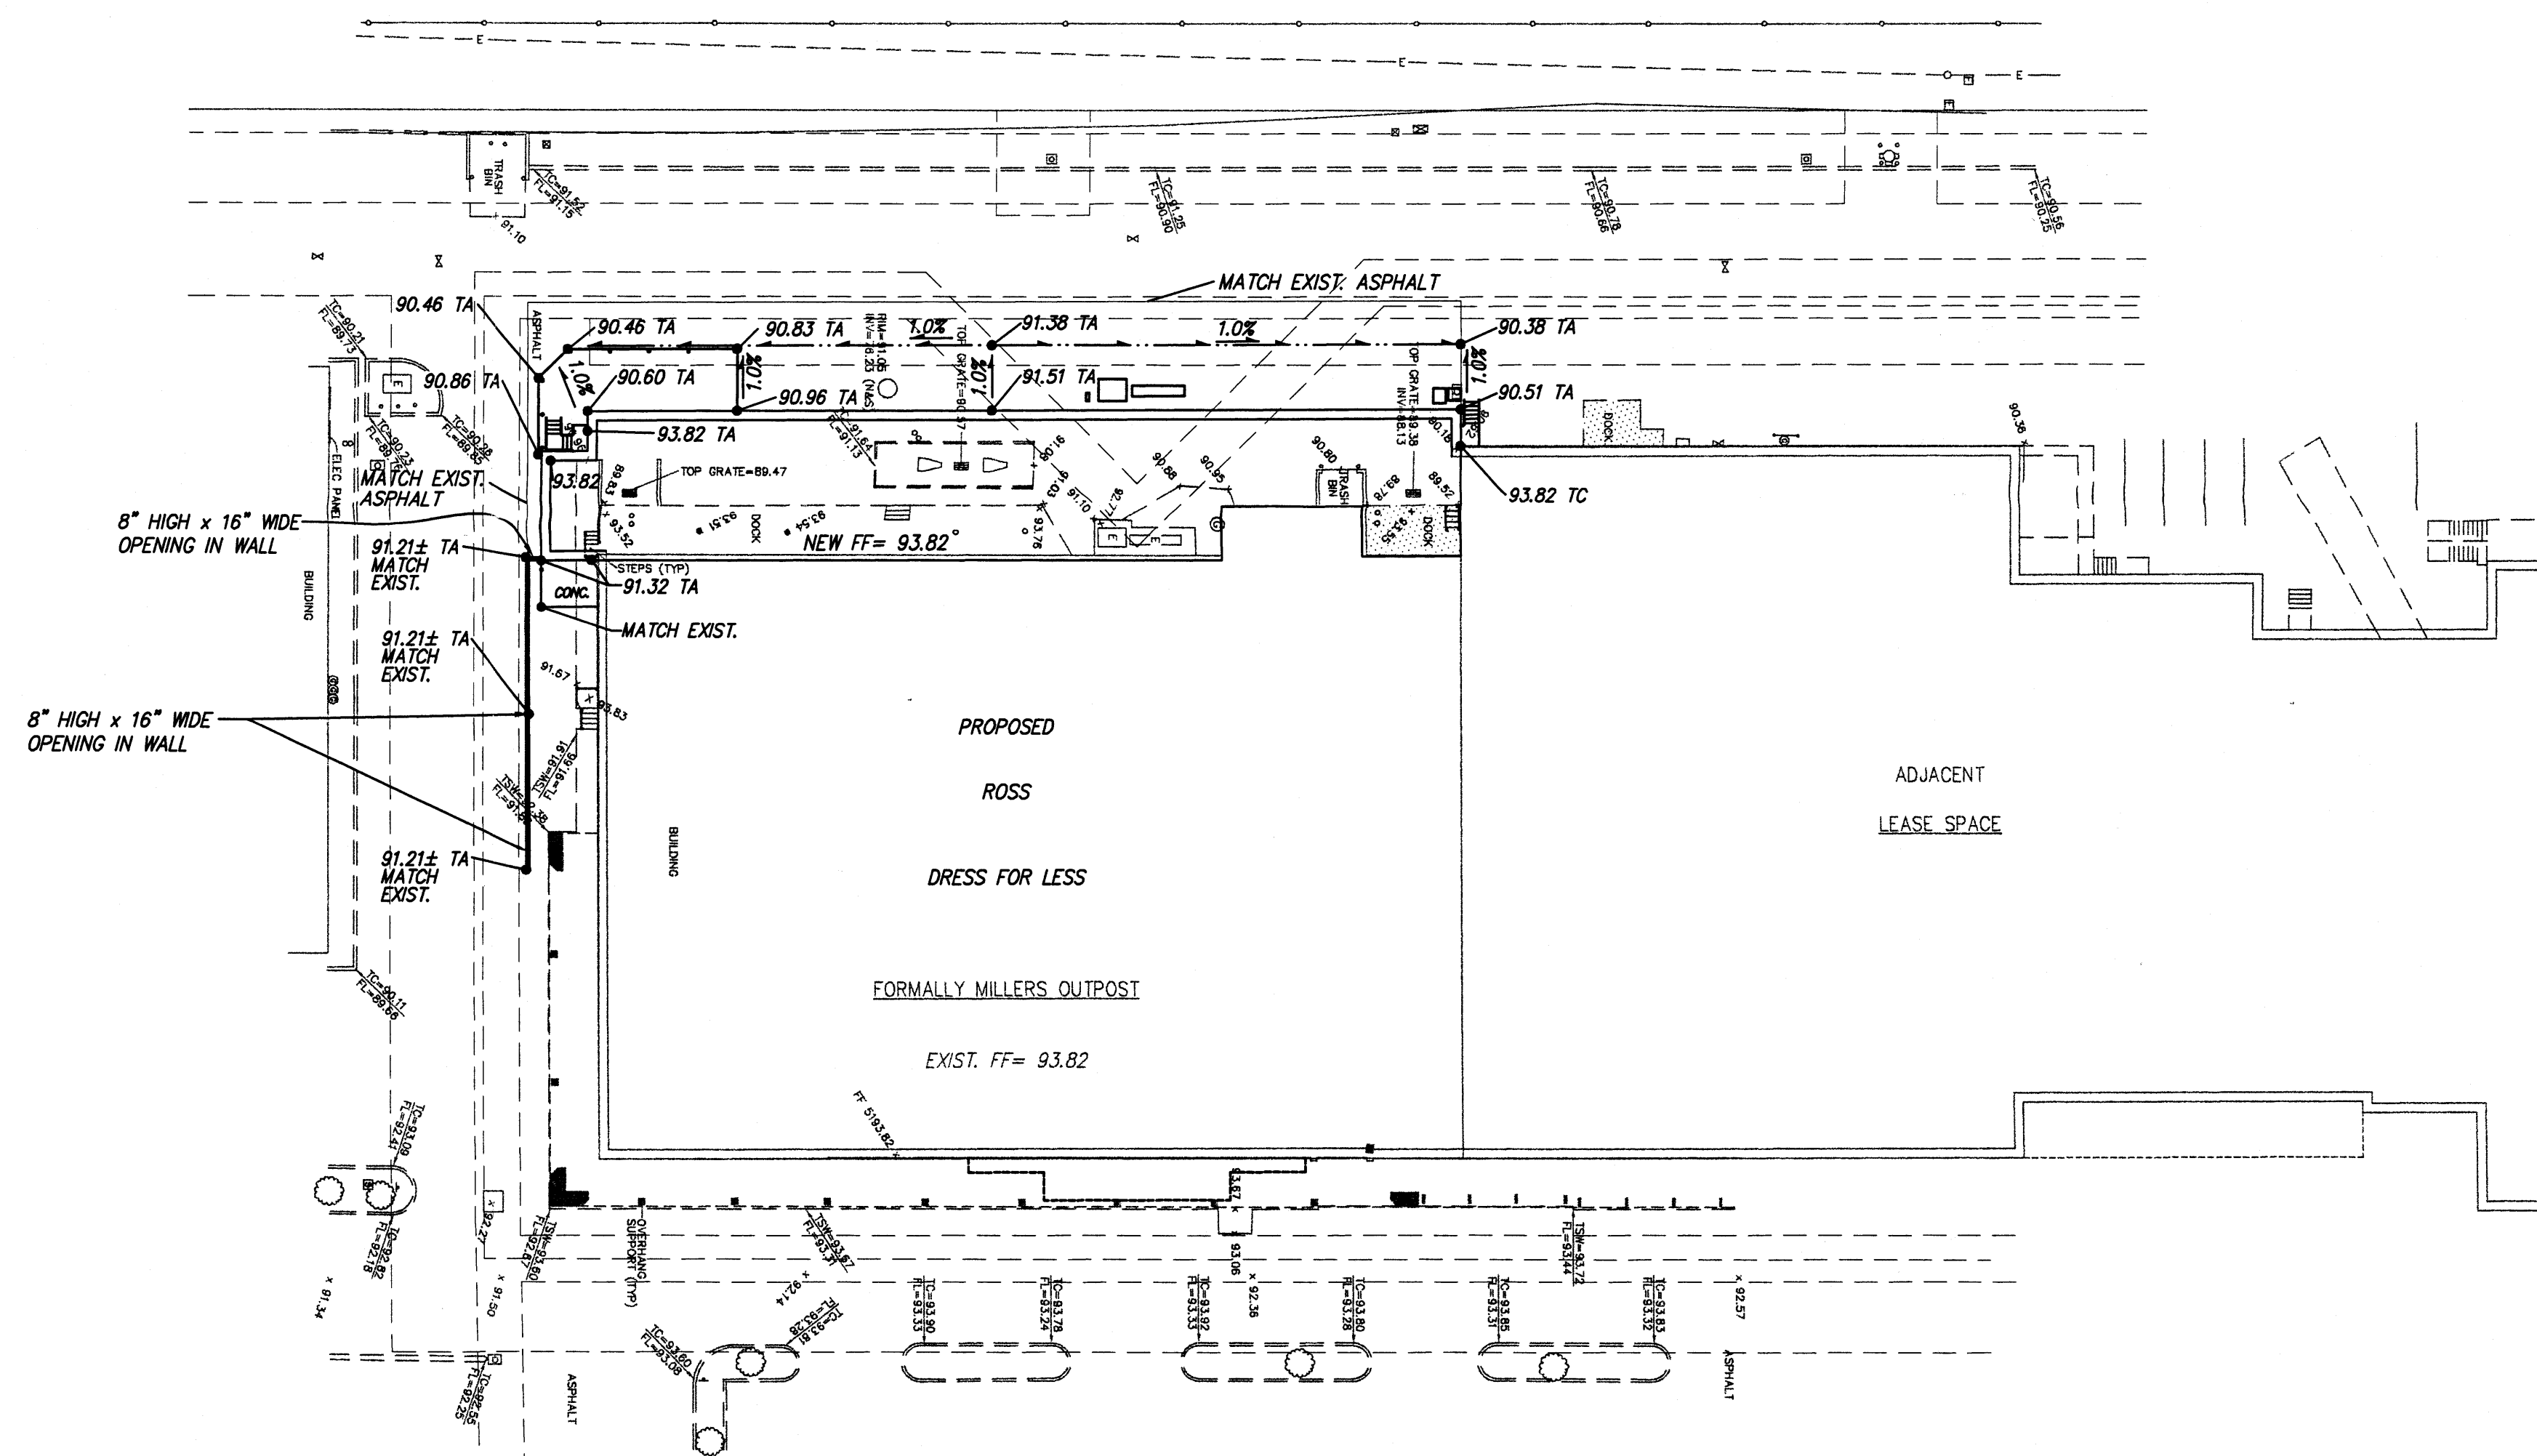

7/23/00 MONTGOMERY PLAZA GRADING AND DRAINAGE PLAN

dmg MARK GOODWIN & ASSOCIATES, P.A. CONSULTING ENGINEERS P.O. BOX 90606 ALBUQUERQUE, NEW MEXICO 87199 (505)828-2200, FAX (505)797-9539			
Designed: <i>ALD</i>	Drawn: <i>KJS</i>	Checked: <i>DMG</i>	Sheet <i>I</i> of <i>I</i>
Scale: 1" = 30'	Date: 7/00	Job: A0073	

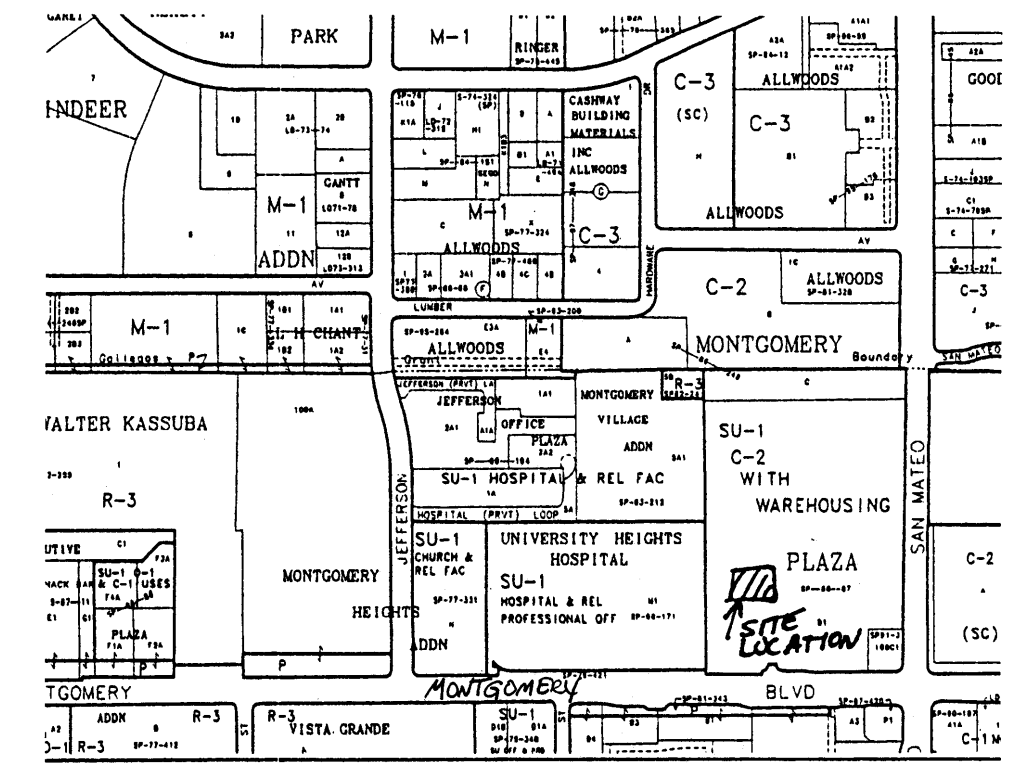

VICINITY MAP ZONE MAP: F-17

ACS BENCHMARK

ACS 9-F18
X= 399264.65 Y= 1504295.63
ELEV= 5209.56

LEGAL DESCRIPTION

TRCT D-1, MONTGOMERY O\PLAZA

LEGEND


- 93.82 TC PROPOSED TOP OF CONCRETE ELEVATION
- 93.82 TA PROPOSED TOP OF ASPHALT ELEVATION
- 1.0% SLOPE
- EXIST. TOP OF CURB ELEVATION
- EXIST. FLOWLINE ELEVATION
- EXIST. SPOT ELEVATION

7/23/00

MONTGOMERY PLAZA GRADING AND DRAINAGE PLAN

dmg MARK GOODWIN & ASSOCIATES, P.A.
CONSULTING ENGINEERS
P.O. BOX 90606
ALBUQUERQUE, NEW MEXICO 87199
(505)828-2200, FAX (505)797-9539

Designed: ALD	Drawn: KJS	Checked: DMG	Sheet 1 of 1
Scale: 1" = 30'	Date: 7/00	Job: A0073	

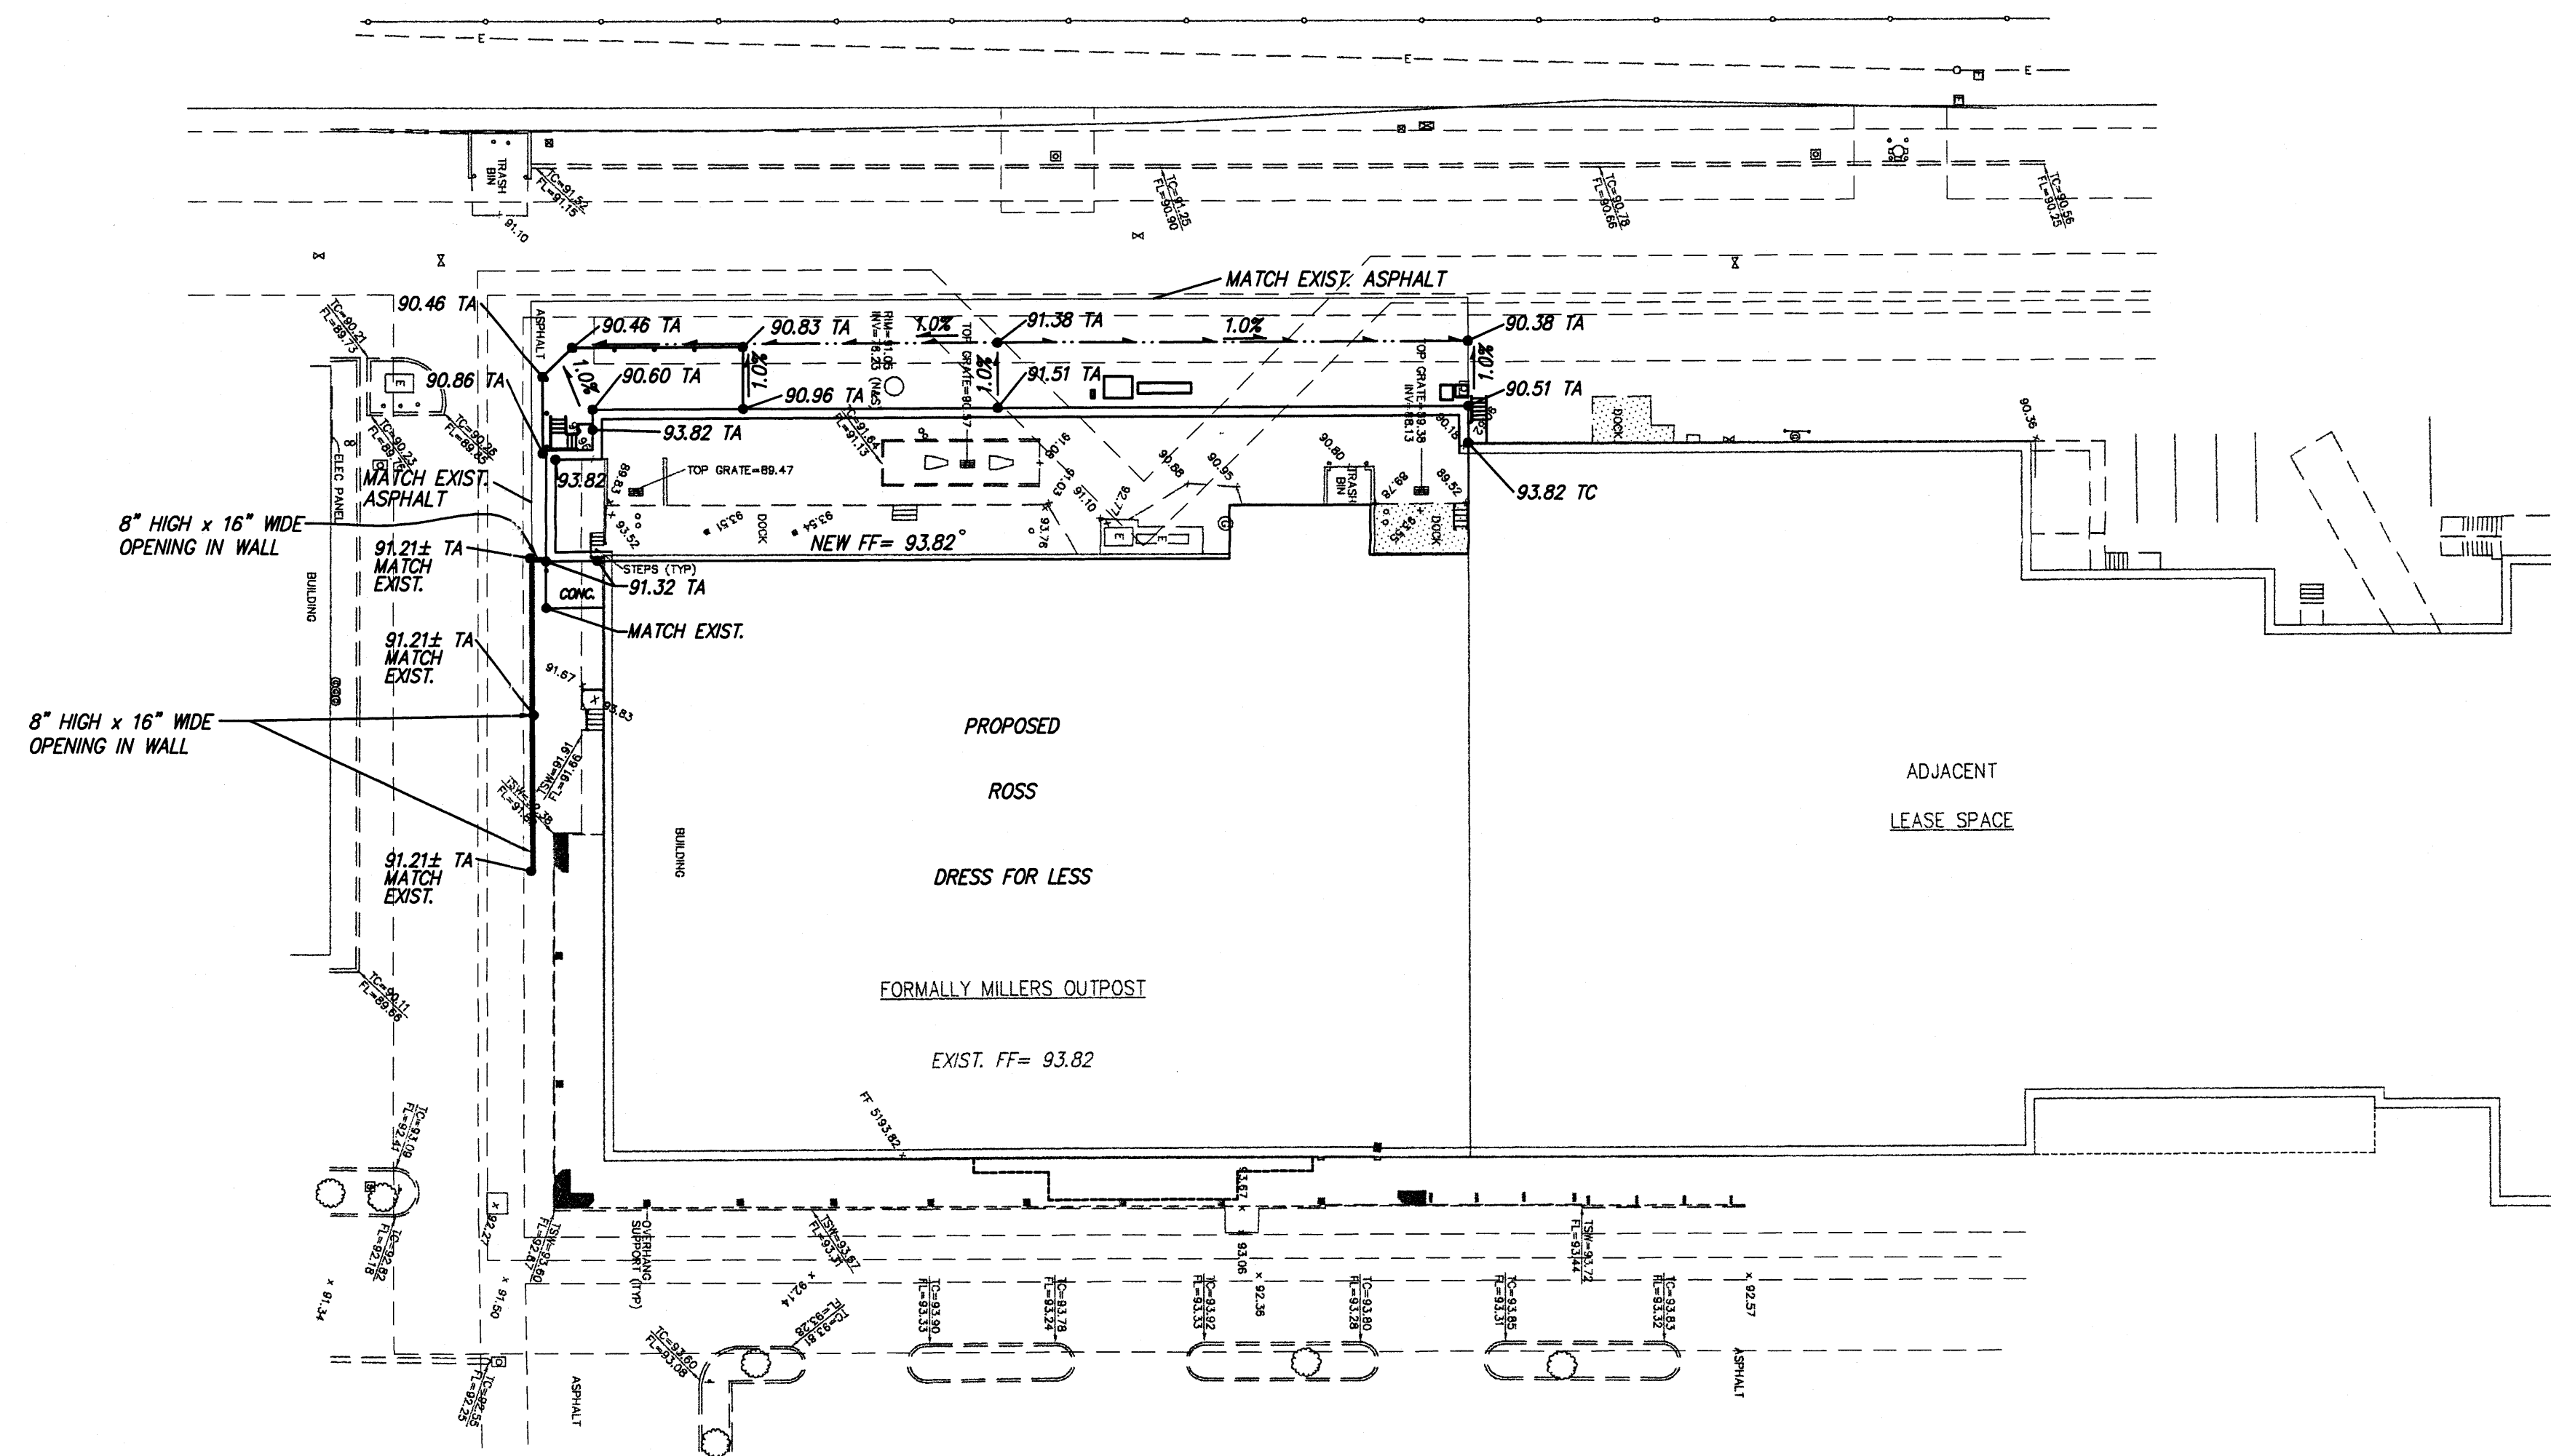

A0073MONT/SITEPLAN/25-27-00 KJS NHM