

GENERAL NOTES

1. ALL WORK DETAILED ON THESE PLANS AND PERFORMED UNDER THIS CONTRACT SHALL BE CONSTRUCTED IN ACCORDANCE WITH THE PROJECT SPECIFICATIONS AND THE PROJECT GEOTECHNICAL REPORT, WHERE APPLICABLE. CITY OF ALBUQUERQUE PUBLIC WORKS STANDARDS SHALL APPLY.
2. THE CONTRACTOR SHALL ABIDE BY ALL LOCAL, STATE, AND FEDERAL LAWS, RULES AND REGULATIONS WHICH APPLY TO THE CONSTRUCTION OF THESE IMPROVEMENTS, INCLUDING EPA REQUIREMENTS WITH RESPECT TO STORM WATER DISCHARGE.
3. PRIOR TO CONSTRUCTION, THE CONTRACTOR SHALL FIELD VERIFY THE HORIZONTAL AND VERTICAL LOCATIONS OF ALL POTENTIAL OBSTRUCTIONS INCLUDING ALL UNDERGROUND UTILITIES. SHOULD A CONFLICT EXIST, THE CONTRACTOR SHALL NOTIFY THE CONSTRUCTION OBSERVER OR ENGINEER SO THAT THE CONFLICT CAN BE RESOLVED WITH A MINIMUM AMOUNT OF DELAY.
4. TWO (2) WORKING DAYS PRIOR TO ANY EXCAVATION, THE CONTRACTOR SHALL CONTACT LINE LOCATING SERVICE FOR LOCATION OF EXISTING UTILITIES.
5. ALL ELECTRICAL, TELEPHONE, CABLE TV, GAS AND OTHER UTILITY LINES, CABLES, AND APPURTENANCES ENCOUNTERED DURING CONSTRUCTION THAT REQUIRE RELOCATION, SHALL BE COORDINATED WITH THAT UTILITY. THE CONTRACTOR SHALL BE RESPONSIBLE FOR COORDINATION OF ALL NECESSARY UTILITY ADJUSTMENTS. NO ADDITIONAL COMPENSATION WILL BE ALLOWED FOR DELAYS OR INCONVENIENCES CAUSED BY UTILITY COMPANY WORK CRUISES. THE CONTRACTOR MAY BE REQUIRED TO RESCHEDULE HIS ACTIVITIES TO ALLOW UTILITY CREWS TO PERFORM THEIR REQUIRED WORK.
6. THE CONTRACTOR IS RESPONSIBLE FOR PROTECTING ALL EXISTING UTILITY LINES WITHIN THE CONSTRUCTION AREA. ANY DAMAGE TO EXISTING FACILITIES CAUSED BY CONSTRUCTION ACTIVITY SHALL BE REPAIRED OR REPLACED AT THE CONTRACTOR'S EXPENSE AND APPROVED BY THE CONSTRUCTION OBSERVER.
7. CONSTRUCTION ACTIVITY SHALL BE LIMITED TO THE PROPERTY AND/OR PROJECT LIMITS. ANY DAMAGE TO ADJACENT PROPERTIES RESULTING FROM THE CONSTRUCTION PROCESS SHALL BE REPAIRED OR REPLACED AT THE CONTRACTOR'S EXPENSE.
8. OVERNIGHT PARKING OF CONSTRUCTION EQUIPMENT SHALL NOT OBSTRUCT DRIVEWAYS OR DESIGNATED TRAFFIC LANES. THE CONTRACTOR SHALL NOT STORE ANY EQUIPMENT OR MATERIAL WITHIN THE PUBLIC RIGHT-OF-WAY.
9. THE CONTRACTOR SHALL OBTAIN ALL THE NECESSARY PERMITS FOR THE PROJECT PRIOR TO COMMENCING CONSTRUCTION (I.E. BARRICADING, TOPSOIL DISTURBANCE, EXCAVATION PERMITS, EPA STORM WATER PERMITS, ETC.).
10. ALL PROPERTY CORNERS DESTROYED DURING CONSTRUCTION SHALL BE REPLACED AT THE CONTRACTOR'S EXPENSE. ALL PROPERTY CORNERS MUST BE RESET BY A REGISTERED LAND SURVEYOR.
11. THE CONTRACTOR SHALL PREPARE A CONSTRUCTION TRAFFIC CONTROL AND SCHEDULING PLAN AND OBTAIN APPROVAL OF SUCH PLAN FROM THE CITY OF ALBUQUERQUE, TRAFFIC ENGINEERING DEPARTMENT, PRIOR TO BEGINNING ANY CONSTRUCTION WORK ON OR ADJACENT TO EXISTING STREETS.
12. ALL BARRICADES AND CONSTRUCTION SCHEDULING SHALL CONFORM TO APPLICABLE SECTIONS OF THE "MANUAL ON UNIFORM TRAFFIC CONTROL DEVICES" (MUTCD), US DEPARTMENT OF TRANSPORTATION, LATEST EDITION.
13. THE CONTRACTOR SHALL MAINTAIN ALL CONSTRUCTION BARRICADES AND SCHEDULING AT ALL TIMES. THE CONTRACTOR SHALL VERIFY THE PROPER LOCATION OF ALL BARRICADES AT THE END AND BEGINNING OF EACH DAY.
14. THE CONTRACTOR SHALL TAKE ALL STEPS NECESSARY TO CONFORM WITH EPA REQUIREMENTS, INCLUDING COMPLIANCE WITH NPDES PHASE 2 REQUIREMENTS.

KEYED NOTES

1. EXISTING CURB & GUTTER TO REMAIN.
2. EXISTING CURB & GUTTER TO BE REMOVED. SEE DEMOLITION PLAN.
3. EXISTING TRUCK DOCK AREA TO BE REMOVED. SEE DEMOLITION PLAN.
4. EXISTING LANDING & STEPS TO REMAIN.
5. NEW RAMP AT 12:1 MAX SLOPE. SEE ARCH FOR DETAILS.
6. NEW SIDEWALK TO MATCH EXISTING TO GRADE.
7. MATCH NEW CURB & GUTTER TO EXISTING.
8. NEW GREASE TRAP. SEE PLUMBING PLANS.
9. NEW SIDEWALK SET AT 0.04' BELOW FF ON BLDG SIDE AND SLOPE AT 2% AWAY FROM BLDG.
10. NEW 3' WIDE CONCRETE VALLEY GUTTER PER COA STD DWG 2421. ENSURE POSITIVE DRAINAGE AWAY FROM BUILDING.
11. NEW RETAINING WALL. SEE ARCH/STRUCT FOR DETAILS.

BENCH MARK DATA: (ACS AND PROJECT)

THE STATION MARK IS A 3 1/4" ALUMINUM CAP SET FLUSH IN THE CURB STAMPED "S-F18" LOCATED ON THE SOUTHEAST CORNER OF SAN MATEO BOULEVARD AND SAN MATEO LANE N.E.

ELEVATION IN FEET = 5209.56 (1929)

LEGEND

- SAW CUT LINE, MATCH EXISTING PAVEMENT
- ⊙ EXIST CLEAN OUT
- ⊕ EXIST DROP INLET
- ⊖ EXIST FIRE HYDRANT
- ⊕ EXIST GAS METER
- ⊕ EXIST STORM DRAIN MH
- ⊕ EXIST WATER MH
- ⊕ EXIST WATER VALVE

DRAINAGE CERTIFICATE LEGEND

- FL56.85 DESIGN GRADE
- FL56.85 ASPHALT GRADE
- FL56.85


DRAINAGE CERTIFICATION

I, BRUCE J. STIDWORTHY, NMPE 14623, OF THE FIRM BOHANNAN HUSTON INC., HEREBY CERTIFY THAT THIS PROJECT HAS BEEN GRADED AND WILL DRAIN IN SUBSTANTIAL COMPLIANCE WITH AND IN ACCORDANCE WITH THE DESIGN INTENT OF THE APPROVED PLAN DATED 10/21/2005. THE RECORD INFORMATION EDITED ONTO THE ORIGINAL DESIGN DOCUMENT HAS BEEN OBTAINED BY ROBERT GROMATZKY, NMPS 18489, OF THE FIRM BOHANNAN HUSTON INC. I FURTHER CERTIFY THAT I HAVE PERSONALLY VISITED THE PROJECT SITE ON 07/21/2006 AND HAVE DETERMINED BY VISUAL INSPECTION THAT THE SURVEY DATA PROVIDED IS REPRESENTATIVE OF ACTUAL SITE CONDITIONS AND IS TRUE AND CORRECT TO THE BEST OF MY KNOWLEDGE AND BELIEF. THIS CERTIFICATION IS SUBMITTED IN SUPPORT OF A REQUEST FOR PERMANENT CERTIFICATE OF OCCUPANCY.

THE DRAINAGE SCHEME ON THE EAST SIDE OF THE BUILDING WAS MODIFIED FROM A VALLEY GUTTER TO DROP INLETS AND AN 8" STORM DRAIN.

THE RECORD INFORMATION PRESENTED HEREON IS NOT NECESSARILY COMPLETE AND INTENDED ONLY TO VERIFY SUBSTANTIAL COMPLIANCE OF THE GRADING AND DRAINAGE ASPECTS OF THIS PROJECT. THOSE RELYING ON THIS RECORD DOCUMENT ARE ADVISED TO OBTAIN INDEPENDENT VERIFICATION OF ITS ACCURACY BEFORE USING IT FOR ANY OTHER PURPOSE.

Bruce J. Stidworthy
BRUCE J. STIDWORTHY NMPE 14623 DATE 8/1/06

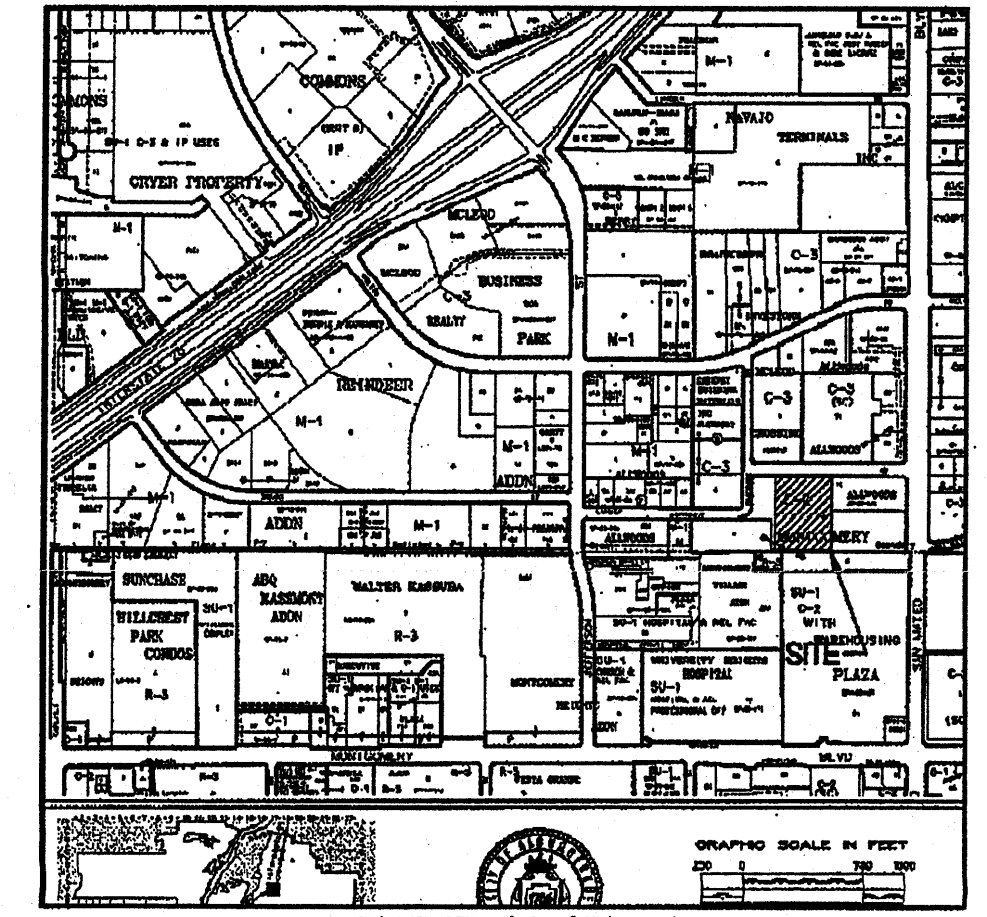

LEGAL DESC: TRACT C-1 MONTGOMERY PLAZA

GRADING NOTES

1. EXCEPT AS PROVIDED HEREIN, GRADING SHALL BE PERFORMED AT THE ELEVATIONS AND IN ACCORDANCE WITH THE DETAILS SHOWN ON THIS PLAN.
2. THE COST FOR REQUIRED CONSTRUCTION DUST AND EROSION CONTROL MEASURES SHALL BE INCIDENTAL TO THE PROJECT COST.
3. ALL WORK RELATIVE TO FOUNDATION CONSTRUCTION, SITE PREPARATION, AND PAVEMENT INSTALLATION, AS SHOWN ON THIS PLAN, SHALL BE CONSTRUCTED IN ACCORDANCE WITH THE "GEOTECHNICAL INVESTIGATION" AS PROVIDED BY THE ARCHITECT OR OWNER. ALL OTHER WORK SHALL, UNLESS OTHERWISE STATED OR PROVIDED FOR HEREON, BE CONSTRUCTED IN ACCORDANCE WITH THE PROJECT, (FIRST PRIORITY) SPECIFICATIONS, AND/OR THE CITY OF ALBUQUERQUE (COA) STANDARD SPECIFICATIONS FOR PUBLIC WORKS (SECOND PRIORITY).
4. EARTH SLOPES SHALL NOT EXCEED 3 HORIZONTAL TO 1 VERTICAL UNLESS SHOWN OTHERWISE.
5. IT IS THE INTENT OF THESE PLANS THAT THIS CONTRACTOR SHALL NOT PERFORM ANY WORK OUTSIDE OF THE PROPERTY BOUNDARIES EXCEPT AS REQUIRED BY THIS PLAN.
6. THE CONTRACTOR IS TO ENSURE THAT NO SOIL ERODES FROM THE SITE ONTO ADJACENT PROPERTY OR PUBLIC RIGHT-OF-WAY. THIS SHOULD BE ACHIEVED BY CONSTRUCTING TEMPORARY BERMS OR SILT FENCE AT THE PROPERTY LINES AND WEETING THE SOIL TO PROTECT IT FROM WIND EROSION.
7. A DISPOSAL SITE FOR ANY & ALL EXCESS EXCAVATION MATERIAL, AND UNSUITABLE MATERIAL AND/OR A BORROW SITE CONTAINING ACCEPTABLE FILL MATERIAL SHALL BE OBTAINED BY THE CONTRACTOR IN COMPLIANCE WITH APPLICABLE ENVIRONMENTAL REGULATIONS AND APPROVED BY THE OBSERVER. ALL COSTS INCURRED IN OBTAINING A DISPOSAL OR BORROW SITE AND Haul TO OR FROM SHALL BE CONSIDERED INCIDENTAL TO THE PROJECT AND NO SEPARATE MEASUREMENT OR PAYMENT SHALL BE MADE.
8. PAVING AND ROADWAY GRADES SHALL BE +/- 0.1' FROM PLAN ELEVATIONS. PAD ELEVATION SHALL BE +/- 0.05' FROM BUILDING PLAN ELEVATION.
9. ALL PROPOSED CONTOURS REFLECT TOP OF PAVEMENT ELEVATIONS IN THE PARKING AREA AND MUST BE ADJUSTED FOR MEDIAN AND ISLANDS.
10. VERIFY ALL ELEVATIONS SHOWN ON PLAN FROM BASIS OF ELEVATION CONTROL STATION PRIOR TO BEGINNING CONSTRUCTION.

DRAINAGE MANAGEMENT PLAN

I. INTRODUCTION

The purpose of this submittal is to provide a Drainage Management Plan for a proposed commercial development which involves the expansion of an existing building located on Tract C-1 of the Montgomery Plaza Site. The +/-7.55 acre site is located at the southwest corner of San Mateo and Lumber Avenue in Northeast Albuquerque.

II. EXISTING HYDROLOGIC CONDITIONS

The fully developed site has a current approved Drainage Management Plan located in the City of Albuquerque Hydrology file number F17 - D002D. The site generally drains from east to west from San Mateo to Lumber Avenue.

III. PROPOSED HYDROLOGIC CONDITIONS

Since the existing site is fully developed in its current state, the increase in the impervious area is minimal. We do not anticipate any negative impacts to the downstream drainage system west of the site.

IV. CONCLUSION

This submittal is made as an amendment to the original approved drainage management plan filed in City Hydrology file number F17-D002D. There will be a minimal increase to the impervious area of the site and there will be no negative impacts to the drainage of the site associated with this building expansion. With this submittal we are requesting approval of the final grading and drainage plan for Building Permit approval.

REVISIONS


- △
- △
DRAWN BY: RMB
REVIEWED BY: JTM
DATE: 10/20/05
PROJECT NO: 060126
DRAWING NAME:

**GRADING &
DRAINAGE PLAN**

SHEET NO.

C101
OF

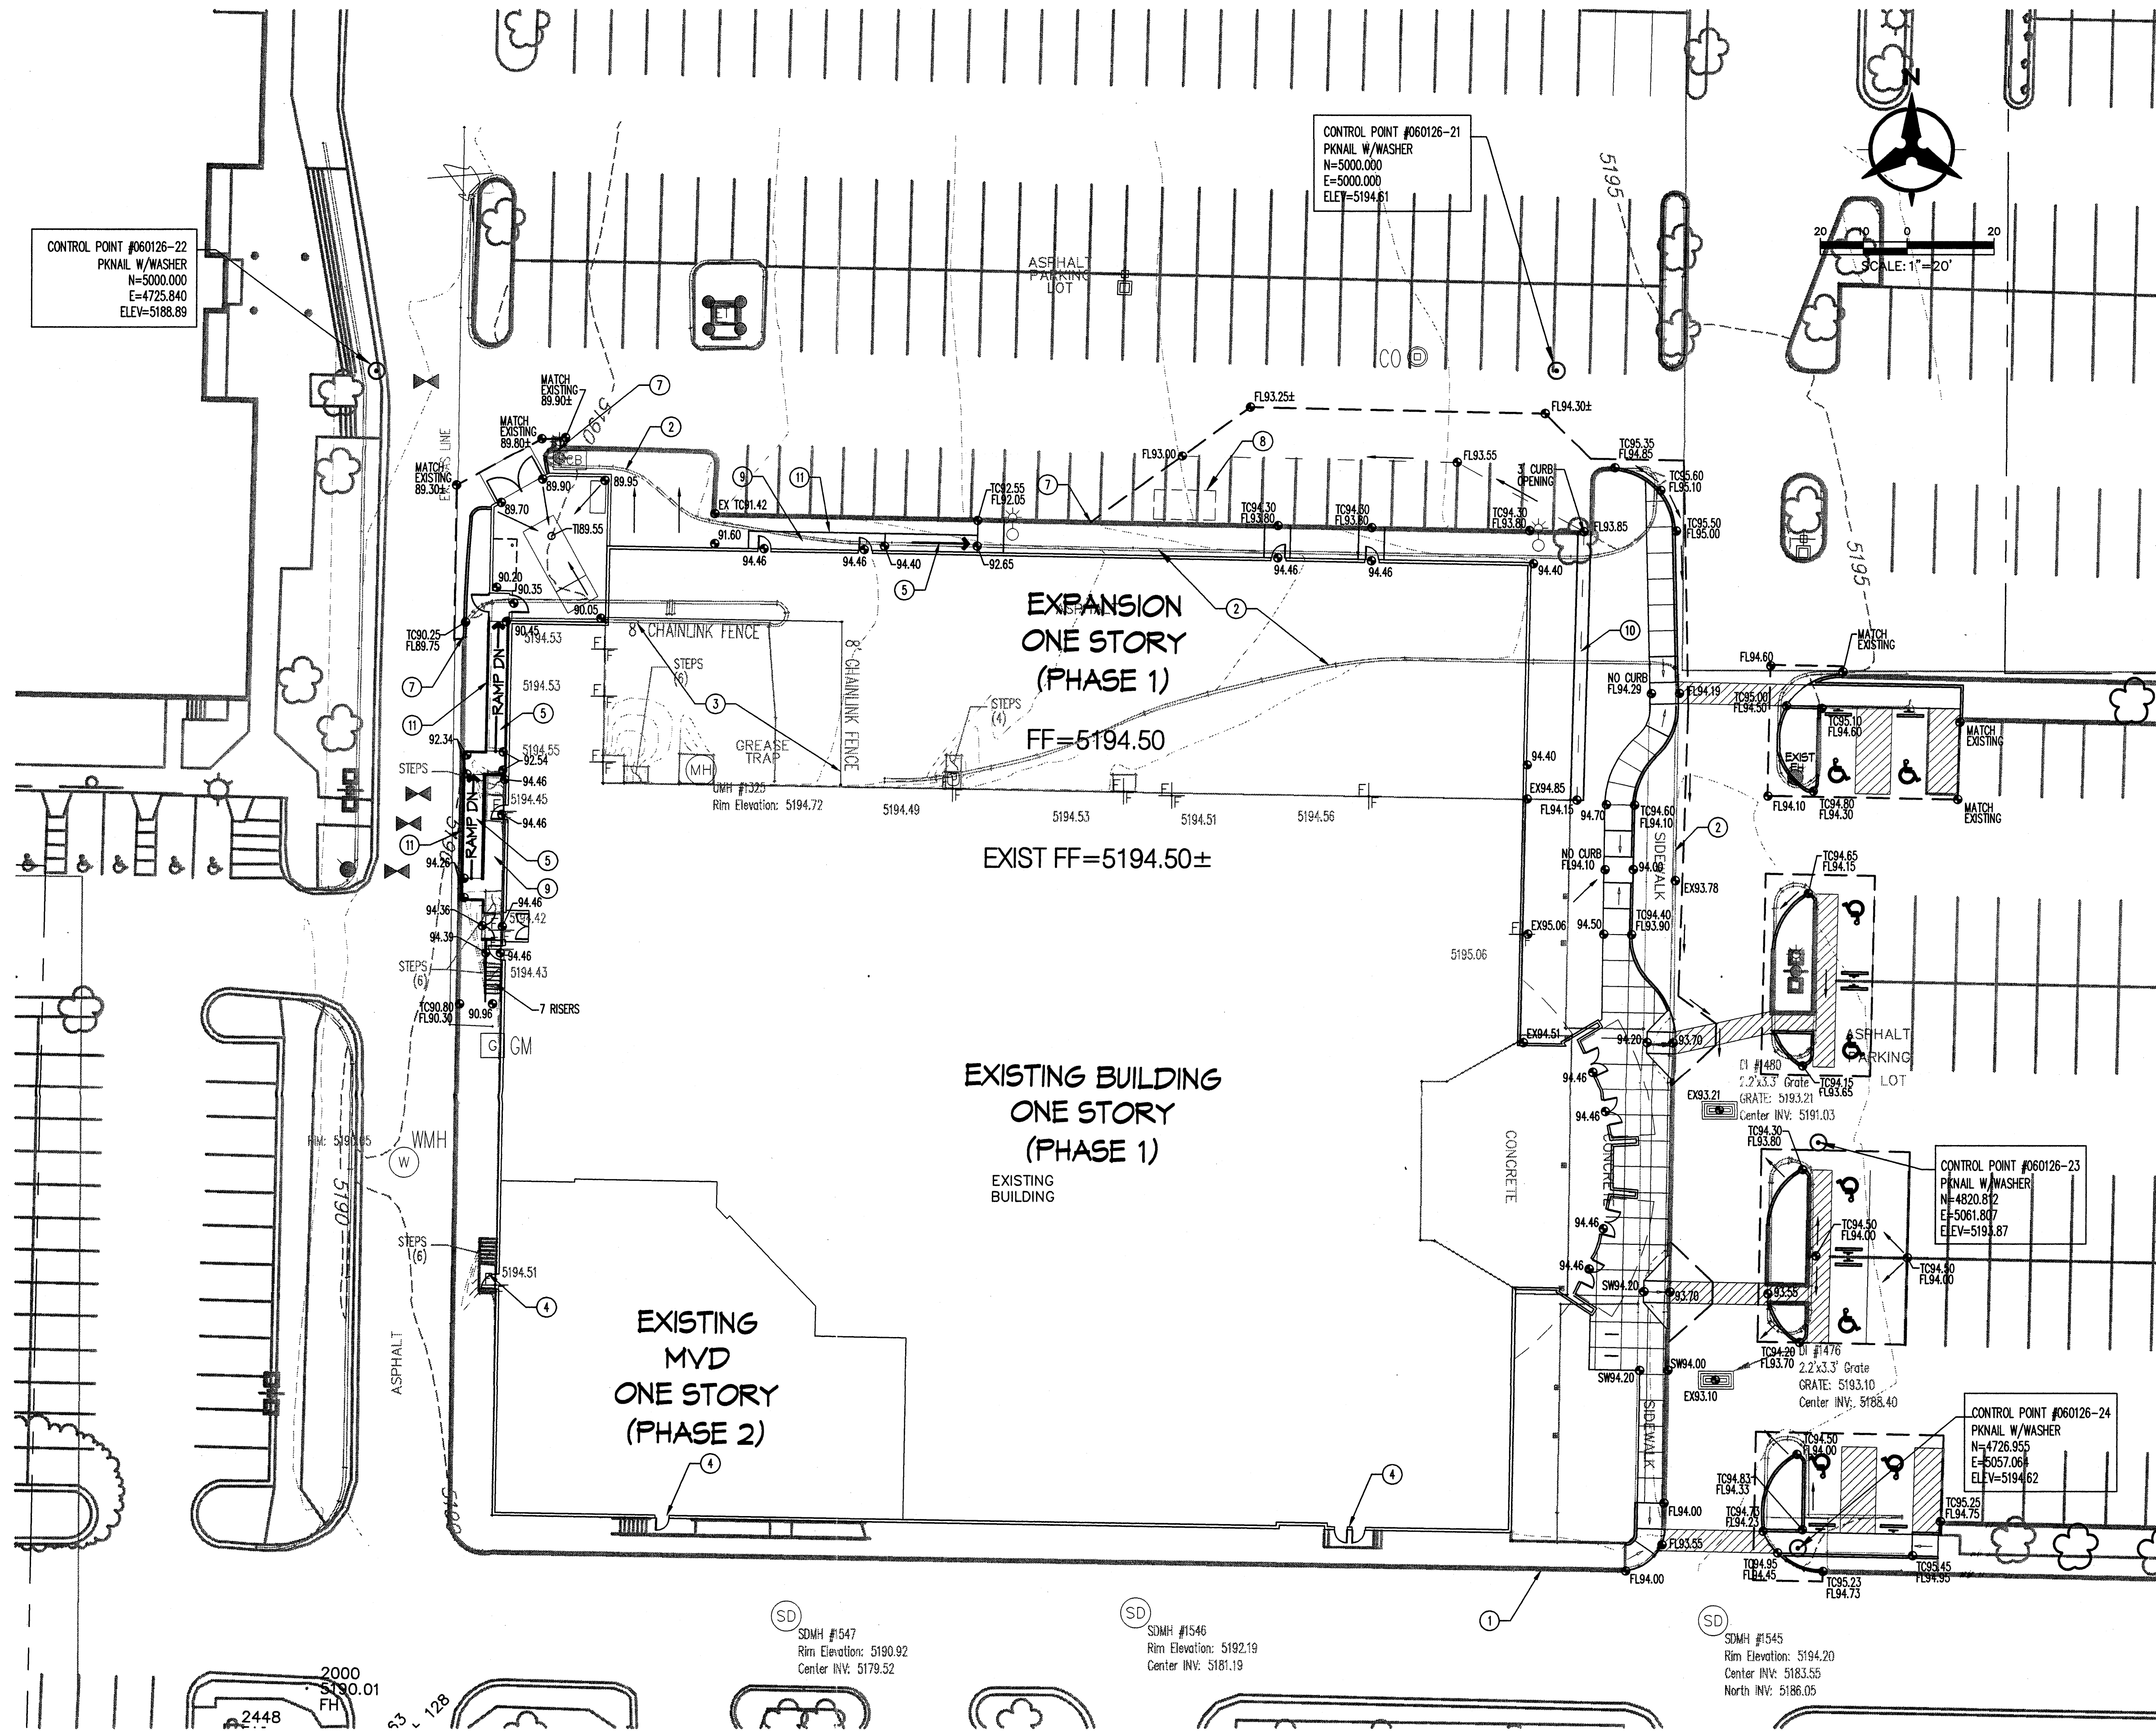

GENERAL NOTES

1. ALL WORK DETAIL ON THESE PLANS AND PERFORMED UNDER THIS CONTRACT SHALL BE CONSTRUCTED IN ACCORDANCE WITH THE PROJECT SPECIFICATIONS AND THE PROJECT GEOTECHNICAL REPORT. WHERE APPLICABLE, CITY OF ALBUQUERQUE PUBLIC WORKS STANDARDS SHALL APPLY.
2. THE CONTRACTOR SHALL ABIDE BY ALL LOCAL, STATE, AND FEDERAL LAWS, RULES AND REGULATIONS WHICH APPLY TO THE CONSTRUCTION OF THESE IMPROVEMENTS, INCLUDING EPA REQUIREMENTS WITH RESPECT TO STORM WATER DISCHARGE.
3. PRIOR TO CONSTRUCTION, THE CONTRACTOR SHALL FIELD VERIFY THE HORIZONTAL AND VERTICAL LOCATIONS OF ALL POTENTIAL OBSTRUCTIONS INCLUDING ALL UNDERGROUND UTILITIES. SHOULD A CONFLICT EXIST, THE CONTRACTOR SHALL NOTIFY THE CONSTRUCTION OBSERVER OR ENGINEER SO THAT THE CONFLICT CAN BE RESOLVED WITH A MINIMUM AMOUNT OF DELAY.
4. TWO (2) WORKING DAYS PRIOR TO ANY EXCAVATION, THE CONTRACTOR SHALL CONTACT LINE LOCATING SERVICE FOR LOCATION OF EXISTING UTILITIES.
5. ALL ELECTRICAL, TELEPHONE, CABLE TV, GAS AND OTHER UTILITY LINES, CABLES, AND APPURTENANCES ENCOUNTERED DURING CONSTRUCTION THAT REQUIRE RELOCATION, SHALL BE COORDINATED WITH THAT UTILITY. THE CONTRACTOR SHALL BE RESPONSIBLE FOR COORDINATION OF ALL NECESSARY UTILITY ADJUSTMENTS. NO ADDITIONAL COMPENSATION WILL BE ALLOWED FOR DELAYS OR INCONVENIENCES CAUSED BY UTILITY COMPANY WORK CREWS. THE CONTRACTOR MAY BE REQUIRED TO RESCHEDULE HIS ACTIVITIES TO ALLOW UTILITY CREWS TO PERFORM THEIR REQUIRED WORK.
6. THE CONTRACTOR IS RESPONSIBLE FOR PROTECTING ALL EXISTING UTILITY LINES WITHIN THE CONSTRUCTION AREA. ANY DAMAGE TO EXISTING FACILITIES CAUSED BY CONSTRUCTION ACTIVITY SHALL BE REPAIRED OR REPLACED AT THE CONTRACTOR'S EXPENSE AND APPROVED BY THE CONSTRUCTION OBSERVER.
7. CONSTRUCTION ACTIVITY SHALL BE LIMITED TO THE PROPERTY AND/OR PROJECT LIMITS. ANY DAMAGE TO ADJACENT PROPERTIES RESULTING FROM THE CONSTRUCTION PROCESS SHALL BE REPAIRED OR REPLACED AT THE CONTRACTOR'S EXPENSE.
8. OVERNIGHT PARKING OF CONSTRUCTION EQUIPMENT SHALL NOT OBSTRUCT DRIVEWAYS OR DESIGNATED TRAFFIC LANES. THE CONTRACTOR SHALL NOT STORE ANY EQUIPMENT OR MATERIAL WITHIN THE PUBLIC RIGHT-OF-WAY.
9. THE CONTRACTOR SHALL OBTAIN ALL THE NECESSARY PERMITS FOR THE PROJECT PRIOR TO COMMENCING CONSTRUCTION (I.E., BARRICADE, TOPSOIL DISTURBANCE, EXCAVATION PERMITS, EPA STORM WATER PERMITS, ETC.).
10. ALL PROPERTY CORNERS DESTROYED DURING CONSTRUCTION SHALL BE REPLACED AT THE CONTRACTOR'S EXPENSE. ALL PROPERTY CORNERS MUST BE RESET BY A REGISTERED LAND SURVEYOR.
11. THE CONTRACTOR SHALL PREPARE A CONSTRUCTION TRAFFIC CONTROL AND SLOWING PLAN AND OBTAIN APPROVAL OF SUCH PLAN FROM THE CITY OF ALBUQUERQUE, TRAFFIC ENGINEERING DEPARTMENT, PRIOR TO BEGINNING ANY CONSTRUCTION WORK ON OR ADJACENT TO EXISTING STREETS.
12. ALL BARRICADES AND CONSTRUCTION SIGNING SHALL CONFORM TO APPLICABLE SECTIONS OF THE "MANUAL ON UNIFORM TRAFFIC CONTROL DEVICES" (MUTCD), US DEPARTMENT OF TRANSPORTATION, LATEST EDITION.
13. THE CONTRACTOR SHALL MAINTAIN ALL CONSTRUCTION BARRICADES AND SIGNING AT ALL TIMES. THE CONTRACTOR SHALL VERIFY THE PROPER LOCATION OF ALL BARRICADE AT THE END AND BEGINNING OF EACH DAY.
14. THE CONTRACTOR SHALL TAKE ALL STEPS NECESSARY TO CONFORM WITH EPA REQUIREMENTS, INCLUDING COMPLIANCE WITH NPDES PHASE 2 REQUIREMENTS.

KEYED NOTES

1. EXISTING CURB & GUTTER TO REMAIN.
2. EXISTING CURB & GUTTER TO BE REMOVED. SEE DEMOLITION PLAN.
3. EXISTING TRUCK DOCK AREA TO BE REMOVED. SEE DEMOLITION PLAN.
4. EXISTING LANDING & STEPS TO REMAIN.
5. NEW RAMP AT 12:1 MAX. SLOPE. SEE ARCH FOR DETAILS.
6. NEW SIDEWALK TO MATCH EXISTING TO GRADE.
7. MATCH NEW CURB & GUTTER TO EXISTING.
8. NEW GREASE TRAP. SEE PLUMBING PLANS.
9. NEW SIDEWALK SET AT 0.04' BELOW FF ON BLDG SIDE AND SLOPE AT 2% AWAY FROM BLDG.
10. NEW 3' WIDE CONCRETE VALLEY GUTTER PER COA STD DWG 2421. ENSURE POSITIVE DRAINAGE AWAY FROM BUILDING.
11. NEW RETAINING WALL. SEE ARCH/STRUCT FOR DETAILS.


BENCH MARK DATA: (ACS AND PROJECT)

THE STATION MARK IS A 3 1/4" ALUMINUM CAP SET FLUSH IN THE CURB STAMPED "9-F18" LOCATED ON THE SOUTHEAST CORNER OF SAN MATEO BOULEVARD AND SAN MATEO LANE N.E.

ELEVATION IN FEET = 5209.56 (1929)

LEGEND

- SAW CUT LINE, MATCH EXISTING PAVEMENT
- ⊙ EXIST CLEAN OUT
- ⊞ EXIST DROP INLET
- ⊕ EXIST FIRE HYDRANT
- ⊞ EXIST GAS METER
- ⊞ EXIST STORM DRAIN MH
- ⊞ EXIST WATER MH
- ⊞ EXIST WATER VALVE

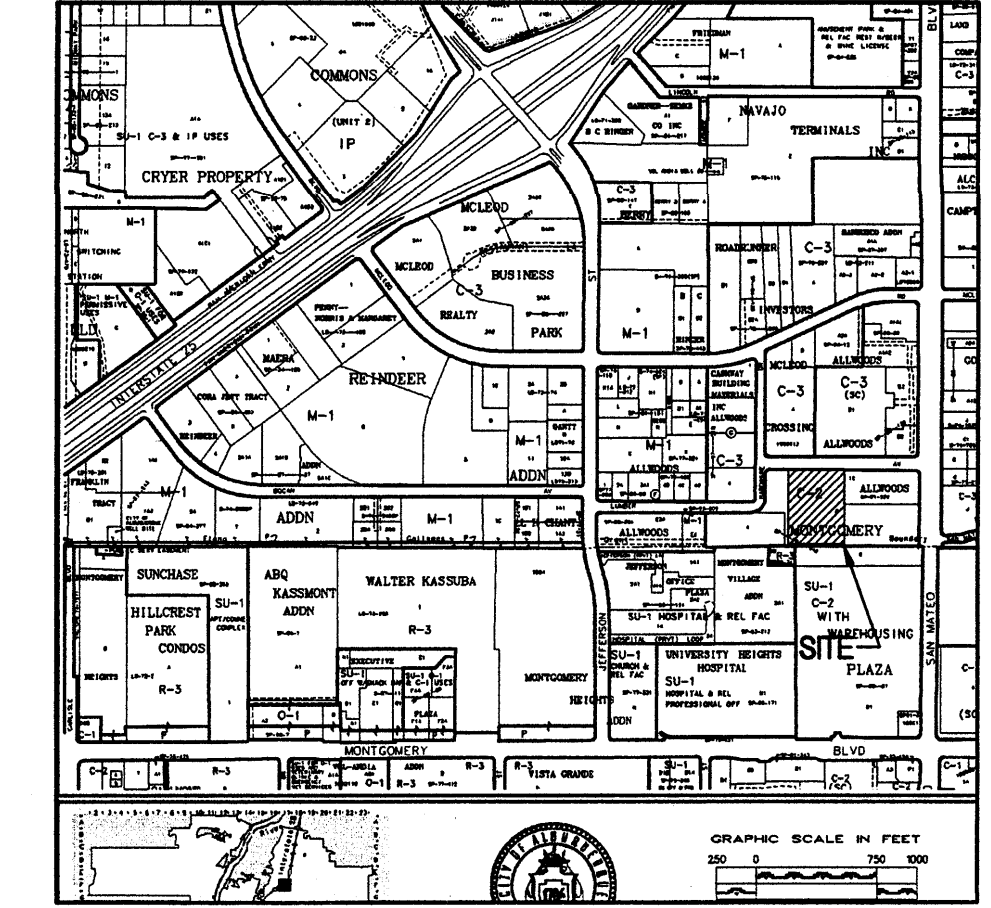

GRADING NOTES

1. EXCEPT AS PROVIDED HEREIN, GRADING SHALL BE PERFORMED AT THE ELEVATIONS AND IN ACCORDANCE WITH THE DETAILS SHOWN ON THIS PLAN.
2. THE COST FOR REQUIRED CONSTRUCTION DUST AND EROSION CONTROL MEASURES SHALL BE INCIDENTAL TO THE PROJECT COST.
3. ALL WORK RELATIVE TO FOUNDATION CONSTRUCTION, SITE PREPARATION, AND PAVEMENT INSTALLATION, AS SHOWN ON THIS PLAN, SHALL BE CONSTRUCTED IN ACCORDANCE WITH THE "GEOTECHNICAL INVESTIGATION," AS PROVIDED BY THE ARCHITECT OR OWNER. ALL OTHER WORK SHALL, UNLESS OTHERWISE STATED OR PROVIDED FOR HEREON, BE CONSTRUCTED IN ACCORDANCE WITH THE PROJECT, (FIRST PRIORITY) SPECIFICATIONS, AND/OR THE CITY OF ALBUQUERQUE (COA) STANDARD SPECIFICATIONS FOR PUBLIC WORKS (SECOND PRIORITY).
4. EARTH SLOPES SHALL NOT EXCEED 3 HORIZONTAL TO 1 VERTICAL UNLESS SHOWN OTHERWISE.
5. IT IS THE INTENT OF THESE PLANS THAT THIS CONTRACTOR SHALL NOT PERFORM ANY WORK OUTSIDE OF THE PROPERTY BOUNDARIES EXCEPT AS REQUIRED BY THIS PLAN.
6. THE CONTRACTOR IS TO ENSURE THAT NO SOIL ERODES FROM THE SITE ONTO ADJACENT PROPERTY OR PUBLIC RIGHT-OF-WAY. THIS SHOULD BE ACHIEVED BY CONSTRUCTING TEMPORARY BERMS OR SILT FENCE AT THE PROPERTY LINES AND NETTING THE SOIL TO PROTECT IT FROM WIND EROSION.
7. A DISPOSAL SITE FOR ANY & ALL EXCESS EXCAVATION MATERIAL, AND UNSUITABLE MATERIAL AND/OR A BORROW SITE CONTAINING ACCEPTABLE FILL MATERIAL SHALL BE OBTAINED BY THE CONTRACTOR IN COMPLIANCE WITH APPLICABLE ENVIRONMENTAL REGULATIONS AND APPROVED BY THE OBSERVER. ALL COSTS INCURRED IN OBTAINING A DISPOSAL OR BORROW SITE AND HAIL TO OR FROM SHALL BE CONSIDERED INCIDENTAL TO THE PROJECT AND NO SEPARATE MEASUREMENT OR PAYMENT SHALL BE MADE.
8. PAVING AND ROADWAY GRADES SHALL BE +/- 0.1' FROM PLAN ELEVATIONS. PAD ELEVATION SHALL BE +/- 0.05' FROM BUILDING PLAN ELEVATION.
9. ALL PROPOSED CONTOURS REFLECT TOP OF PAVEMENT ELEVATIONS IN THE PARKING AREA AND MUST BE ADJUSTED FOR MEDIANS AND ISLANDS.
10. VERIFY ALL ELEVATIONS SHOWN ON PLAN FROM BASIS OF ELEVATION CONTROL STATION PRIOR TO BEGINNING CONSTRUCTION.

DRAINAGE MANAGEMENT PLAN

I. INTRODUCTION

The purpose of this submittal is to provide a Drainage Management Plan for a proposed commercial development which involves the expansion of an existing building located on Tract C-1 of the Montgomery Plaza Site. The +/-7.55 acre site is located at the southwest corner of San Mateo and Lumber Avenue in Northeast Albuquerque.

II. EXISTING HYDROLOGIC CONDITIONS

The fully developed site has a current approved Drainage Management Plan located in the City of Albuquerque Hydrology file number F17 - D002D. The site generally drains from east to west from San Mateo to Lumber Avenue.

III. PROPOSED HYDROLOGIC CONDITIONS






Since the existing site is fully developed in its current state, the increase in the impervious area is minimal. We do not anticipate any negative impacts to the downstream drainage system west of the site.

IV. CONCLUSION

This submittal is made as an amendment to the original approved drainage management plan filed in City Hydrology file number F17-D002D. There will be a minimal increase to the impervious area of the site and there will be no negative impacts to the drainage of the site associated with this building expansion. With this submittal we are requesting approval of the final grading and drainage plan for Building Permit approval.

- REVISIONS
- △
 - △
DRAWN BY	RWB
REVIEWED BY	JTN
DATE	10/20/05
PROJECT NO.	060126
DRAWING NAME	

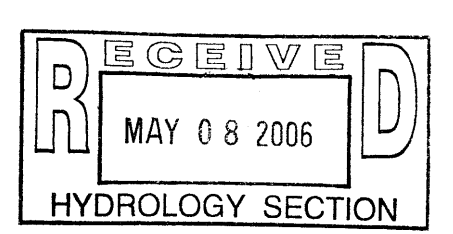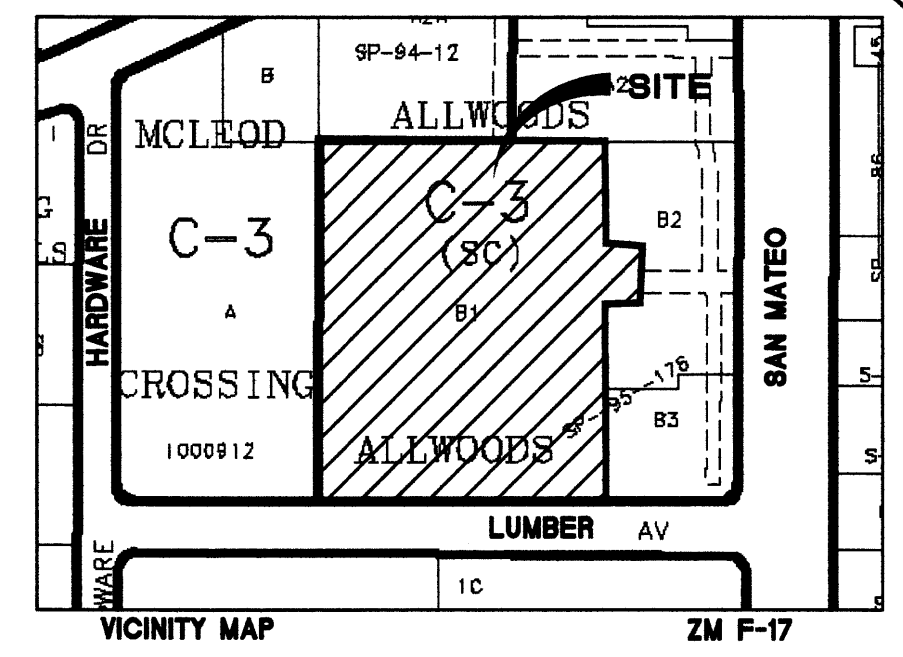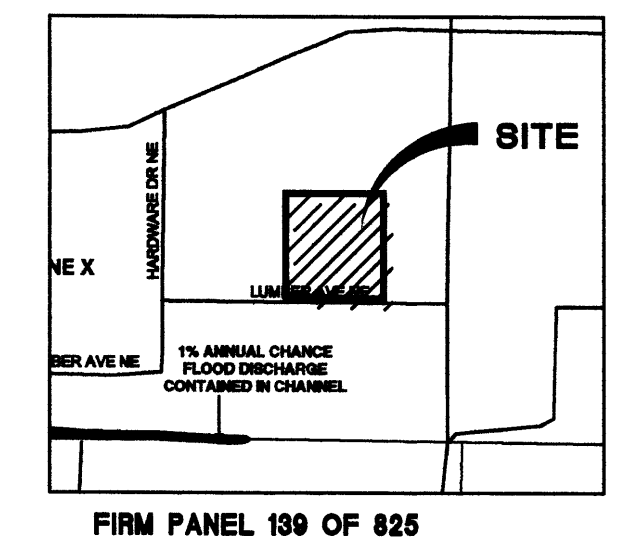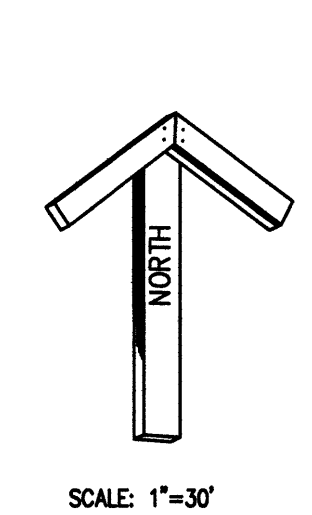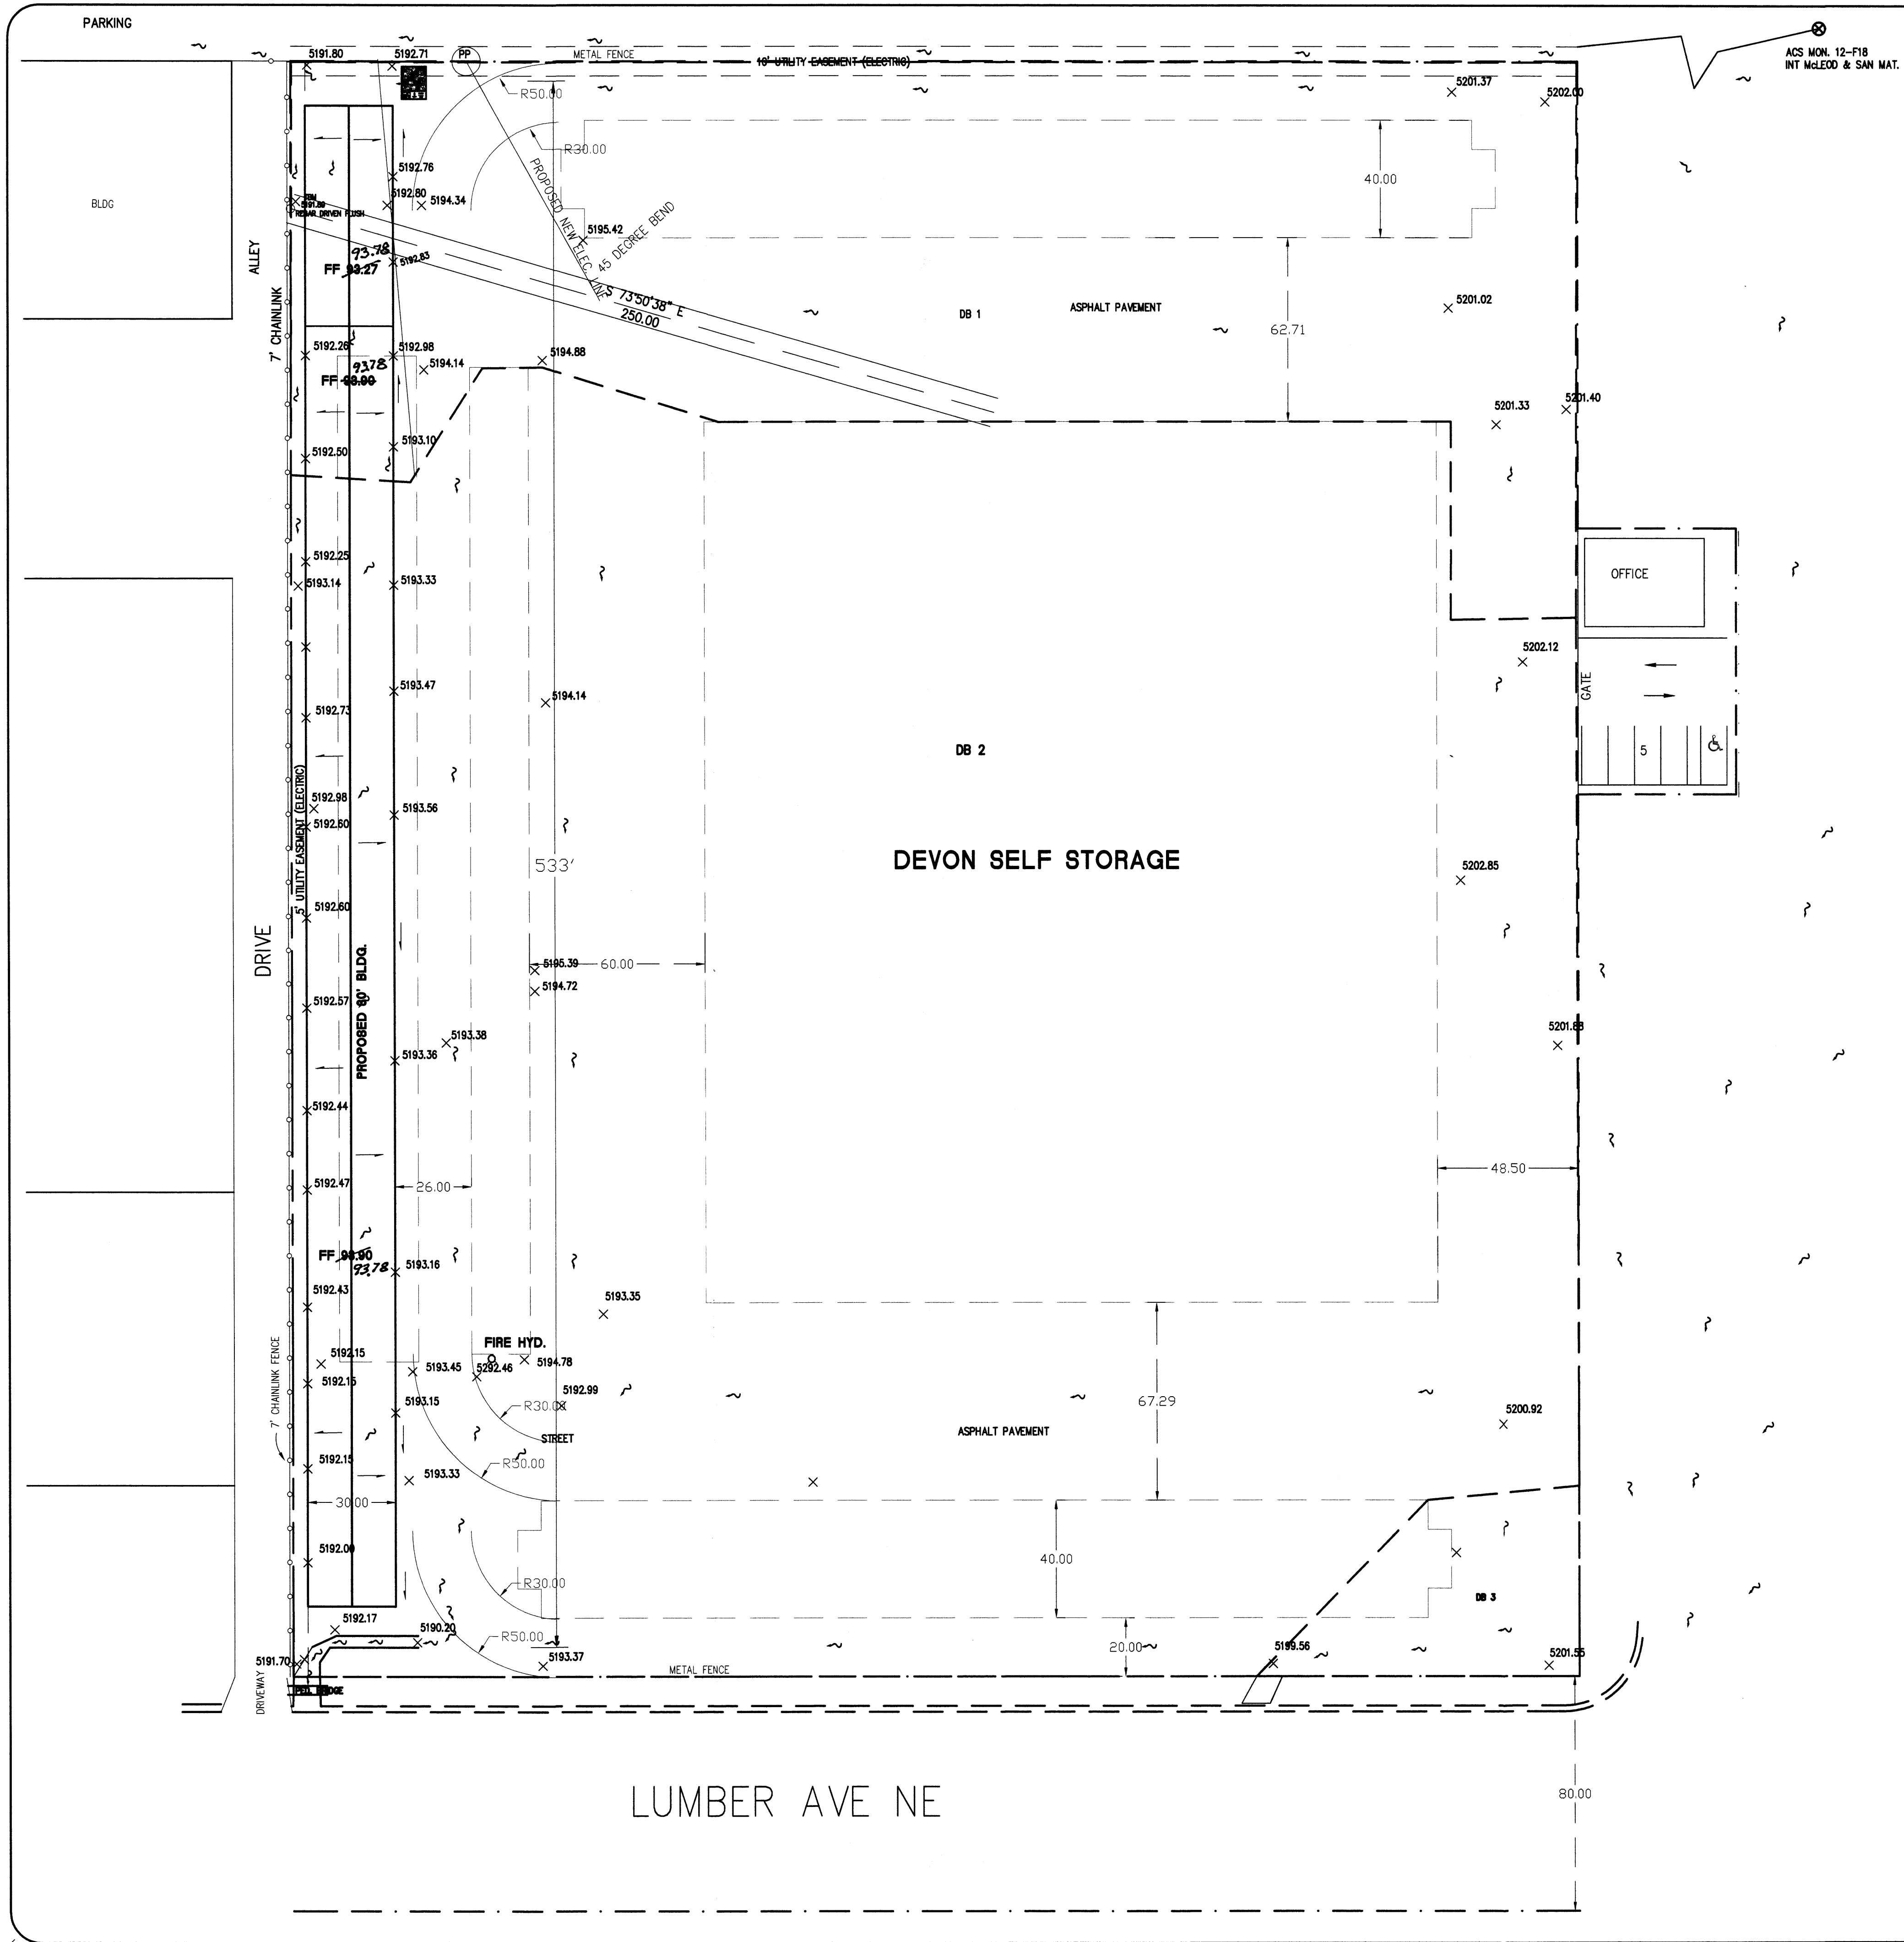

NARRATIVE

THIS PROJECT PROPOSES THE CONSTRUCTION OF A NEW 30 FOOT, ONE STORY, METAL, STORAGE BUILDING. THE RV SHED WILL BE REMOVED TO MAKE ROOM. THE UTILITY EASEMENT WILL BE MOVED AS INDICATED IN ORDER TO BUILD OVER THE PRESENT ELECTRIC SERVICE LINE LOCATION.

THE PRESENT DRAINAGE CONFIGURATION WILL NOT BE AFFECTED. THE PRESENT SURFACE IS 100% IMPERVIOUS AND WILL REMAIN SO AFTER CONSTRUCTION.

DRAINAGE FROM THE EAST FLOWS SOUTH ALONG THE DRIVEWAY EAST OF THE EAST FENCE AND ON TO LUMBER AVE. DRAINAGE FLOWS PARALLEL TO THE NORTH LINE AND NEVER ENTERS THE SITE. LIKEWISE ON THE SOUTH SIDE. THE WEST SIDE IS LOWER.

DRAINAGE CERTIFICATION

I, WALLACE L. BINGHAM NMPE 7281, HEREBY CERTIFY THAT THIS PROJECT HAS BEEN GRADED AND WILL DRAIN IN SUBSTANTIAL COMPLIANCE WITH AND IN ACCORDANCE WITH THE DESIGN INTENT OF THE APPROVED PLAN DATED 5/12/05. THE RECORD INFORMATION EDITED ONTO THE ORIGINAL DESIGN DOCUMENT HAS BEEN OBTAINED BY ME OR UNDER MY DIRECT SUPERVISION AND IS TRUE AND CORRECT TO THE BEST OF MY KNOWLEDGE AND BELIEF. THIS CERTIFICATION IS SUBMITTED IN SUPPORT OF A REQUEST FOR RELEASE OF CERTIFICATE OCCUPANCY.

AS-BUILT DESIGNATION 92.10
-92.08
OR
92.50




START TIME=0.0 CODE 0 LINES 80
*S COMPUTE 100 YR. HYDROGRAPHS FOR THE DEVON SELF STORAGE
*S
*S DEVIN.DAT - AHYMO PER JAN 1993 DPM REVISIONS
RAINFALL TYPE=1 RAIN QUAR=0.0 RAIN ONE= 1.8
RAIN SIX= 2.2 RAIN DAY=2.87 DT=0.0333
COMPUTE NM HYD ID=1 HYD NO= 101.1 DA=0.00196 SQ MI
PER A 0 PER B 0 PER C 0 PER D 100 TP=-.13
RAIN=-1 DT=0.0
PRINT HYD ID=1 CODE=10
COMPUTE NM HYD ID=2 HYD NO= 102.1 DA=0.00645 SQ MI
PER A 0 PER B 0 PER C 0 PER D 100 TP=-.13
RAIN=-1 DT=0.0
PRINT HYD ID=2 CODE=10
COMPUTE NM HYD ID=3 HYD NO= 103.1 DA=0.00179 SQ MI
PER A 0 PER B 0 PER C 0 PER D 100 TP=-.13
RAIN=-1 DT=0.0
PRINT HYD ID=3 CODE=10

AHYMO PROGRAM SUMMARY TABLE (AHYMO.DAT) - VERSION: 1997.02a RUN DATE (MON/DAY/YR) =03/29/2005
INPUT FILE = D:\ahymo\DEVON.LDT USER NO.= AHYMO-1-970201000076-SH


COMMAND	HYDROGRAPH IDENTIFICATION	FROM ID	TO ID	AREA (SQ MI)	PEAK DISCHARGE (CFS)	RUNOFF VOLUME (AC-FT)	TIME TO PEAK (HOURS)	CFS PER ACRE	NOTATION
START	*S COMPUTE 100 YR. HYDROGRAPHS FOR THE DEVON SELF STORAGE								
FINISH									
RAINFALL	TYPE= 1	101.10	1	.00196	5.35	.205	1.95775	1.499	RAIN=6 2.200
COMPUTE NM HYD	102.10	2	.00645	17.60	.673	1.95775	1.499	4.263 PER IMP= 100.00	
COMPUTE NM HYD	103.10	3	.00018	.50	.019	1.95775	1.499	4.333 PER IMP= 100.00	

- LEGEND**
- *10=4.43 PROPOSED TOP OF CURB ELEVATION
 - *10.0 PROPOSED SPOT ELEVATION
 - *10.0 EXISTING SPOT ELEVATION (GRID & 10)
 - PROPOSED CONCRETE VALLEY GUTTER
 - PROPOSED PAVING
 - PROPOSED CURB & GUTTER
 - FUTURE UNDER BUILD (BY OTHERS)
 - EXISTING CONTOUR W/ MEAS ELEVATION
 - 407.5
 - PROPOSED FLOW ARROW
 - STORM DRAIN WITH MANHOLE & INLETS
 - EXISTING FLOW ARROW
 - PROPOSED STORM DRAIN
 - PROPOSED STORM SEWER CATCH BASIN
 - PROPOSED WATER BLOCK
 - BASIN BOUNDARY
 - SUB BASIN BOUNDARY
 - PHASE LINE
 - RETAINING WALL

BINGHAM ENGINEERING
ALBUQUERQUE, NEW MEXICO
505 797 4899

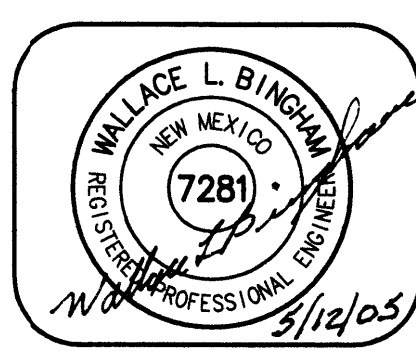

GRADING AND DRAINAGE PLAN
DEVON SELF STORAGE
4801 San Mateo Blvd NE

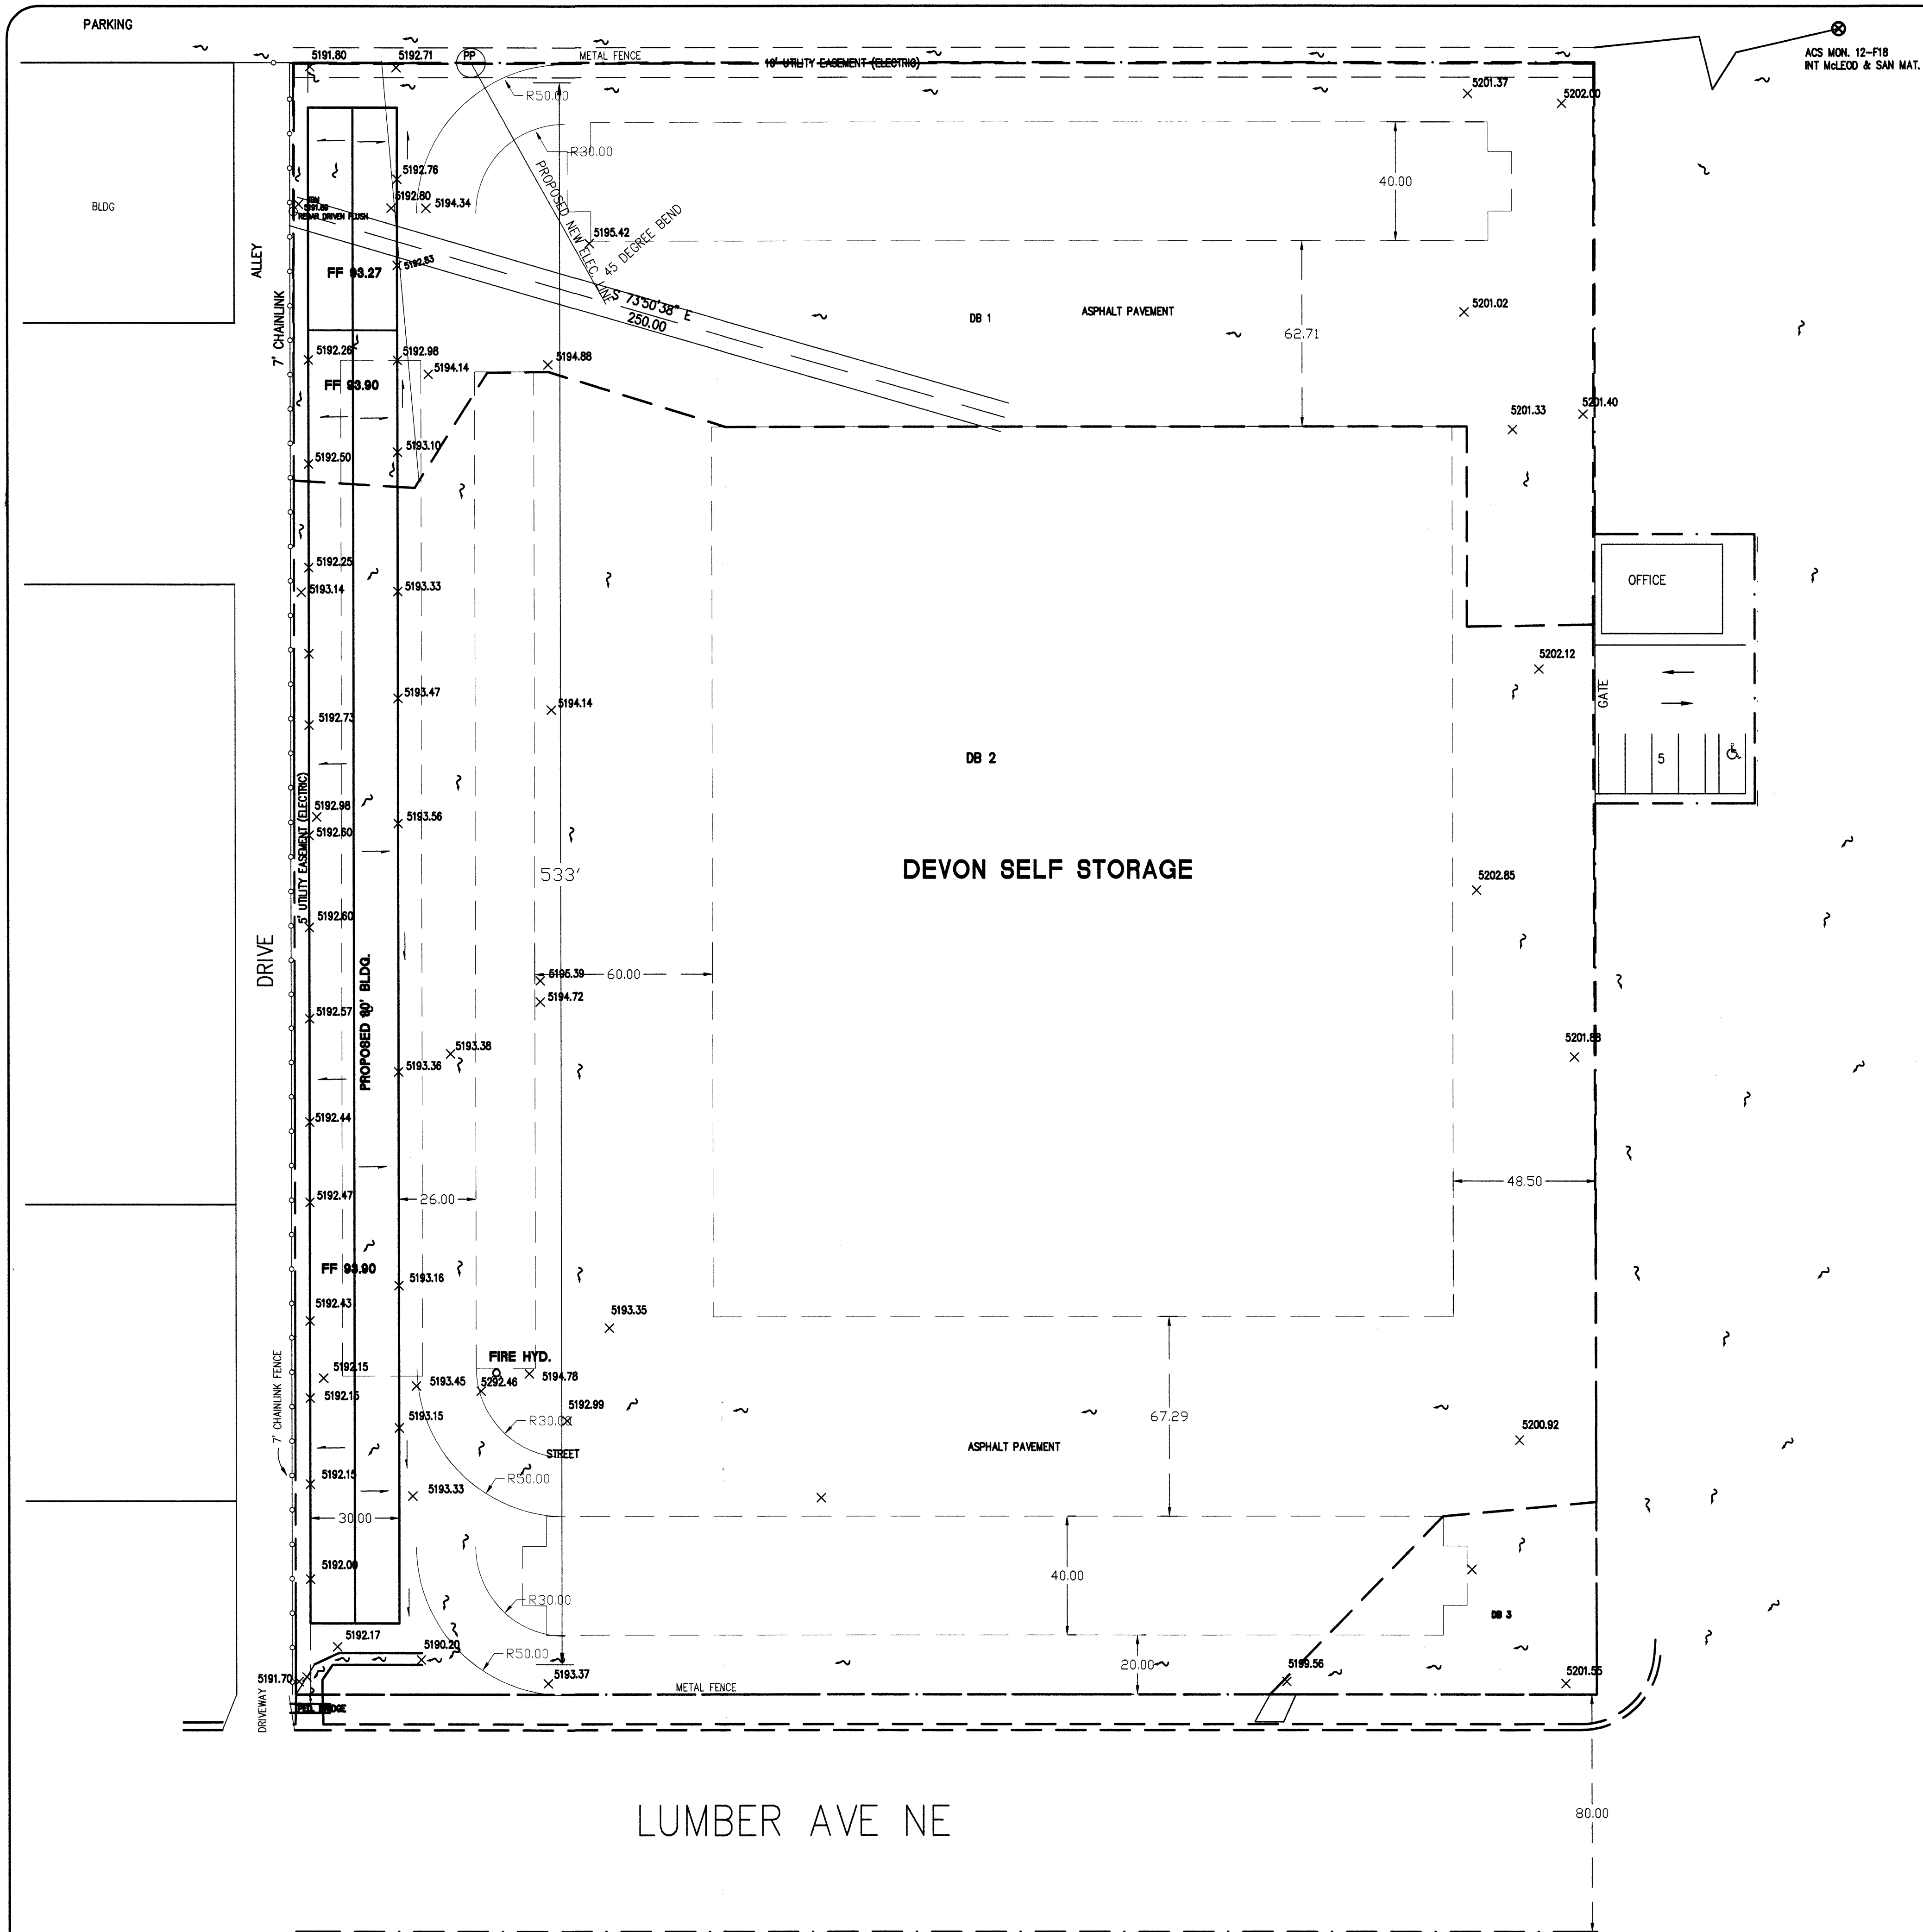

NARRATIVE

THIS PROJECT PROPOSES THE CONSTRUCTION OF A NEW 30 FOOT, ONE STORY, METAL, STORAGE BUILDING. THE RV SHED WILL BE REMOVED TO MAKE ROOM. THE UTILITY EASEMENT WILL BE MOVED AS INDICATED IN ORDER TO BUILD OVER THE PRESENT ELECTRIC SERVICE LINE LOCATION.


THE PRESENT DRAINAGE CONFIGURATION WILL NOT BE AFFECTED. THE PRESENT SURFACE IS 100% IMPERVIOUS AND WILL REMAIN SO AFTER CONSTRUCTION.

DRAINAGE FROM THE EAST FLOWS SOUTH ALONG THE DRIVEWAY EAST OF THE EAST FENCE AND ON TO LUMBER AVE. DRAINAGE FLOWS PARALLEL TO THE NORTH LINE AND NEVER ENTERS THE SITE. LIKEWISE ON THE SOUTH SIDE. THE WEST SIDE IS LOWER.

START TIME=0.0 CODE 0 LINES 80
*S COMPUTE 100 YR. HYDROGRAPHS FOR THE DEVON SELF STORAGE
*S
*S DEVIN.DAT - AHYMO PER JAN 1993 DPM REVISIONS
RAINFALL TYPE=-1 RAIN QUAR=0.0 RAIN ONE=1.8
RAIN SIX=2.2 RAIN DAY=2.67 DT=0.0333
COMPUTE NM HYD ID=1 HYD NO= 101.1 DA=0.00196 SQ MI
PER A 0 PER B 0 PER C 0 PER D 100 TP=-.13
RAIN=-1 DT=0.0
ID=1 CODE=10
PRINT HYD
*S COMPUTE NM HYD ID=2 HYD NO= 102.1 DA=0.00645 SQ MI
PER A 0 PER B 0 PER C 0 PER D 100 TP=-.13
RAIN=-1 DT=0.0
ID=2 CODE=10
PRINT HYD
*S COMPUTE NM HYD ID=3 HYD NO= 103.1 DA=0.000179 SQ MI
PER A 0 PER B 0 PER C 0 PER D 100 TP=-.13
RAIN=-1 DT=0.0
ID=3 CODE=10
PRINT HYD
AHYMO PROGRAM SUMMARY TABLE (AHYMO_37) -
INPUT FILE = D:\ahymo\DEVON.txt - VERSION: 1997.02s RUN DATE (MON/DAY/YR) -03/29/2005
USER NO.= AHYMO-I-9702s01000076-SH


HYDROGRAPH NO.	TO NO.	AREA (SQ MI)	PEAK DISCHARGE (CFS)	RUNOFF VOLUME (AC-FT)	RUNOFF (INCHES)	TIME TO PEAK (HOURS)	CFS PER ACRE	PAGE
101.1	1	.00196	5.35	.205	1.95775	1.499	4.267 PER IMP= 100.00	1
102.1	2	.00645	17.60	.673	1.95775	1.499	4.263 PER IMP= 100.00	
103.1	3	.00018	.50	.019	1.95775	1.499	4.333 PER IMP= 100.00	

START *S COMPUTE 100 YR. HYDROGRAPHS FOR THE DEVON SELF STORAGE
*S
*S GRANITE SNOW.DAT - AHYMO PER JAN 1993 DPM REVISIONS
RAINFALL TYPE= 1
COMPUTE NM HYD 101.10 - 1 .00196 5.35 .205 1.95775 1.499 4.267 PER IMP= 100.00
COMPUTE NM HYD 102.10 - 2 .00645 17.60 .673 1.95775 1.499 4.263 PER IMP= 100.00
COMPUTE NM HYD 103.10 - 3 .00018 .50 .019 1.95775 1.499 4.333 PER IMP= 100.00
FINISH

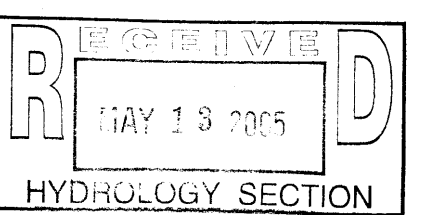

LEGEND	
TO=48.43	PROPOSED TOP OF CURB ELEVATION
48.43	PROPOSED SPOT ELEVATION
X 09.0	EXISTING SPOT ELEVATION (GRID & TO)
	PROPOSED CONCRETE VALLEY GUTTER
	TEMPORARY FILLING
	PROPOSED CURB & GUTTER
	FUTURE UNDER BLVD (BY OTHERS)
-49.73-	EXISTING CONTOUR 1/2" HICK ELEVATION
	PROPOSED FLOW ARROW
	STORM DRAIN WITH MANHOLE & INLETS
	EXISTING FLOW ARROW
-8' 0"	PROPOSED STORM DRAIN
	PROPOSED STORM SEWER CATCH BASIN
	PROPOSED WATER BLOCK
	BLVD BOUNDARY
	SUB BASIN BOUNDARY
	PHASE LINE
	RETAINING WALL


BINGHAM ENGINEERING
ALBUQUERQUE, NEW MEXICO
505 797 4699

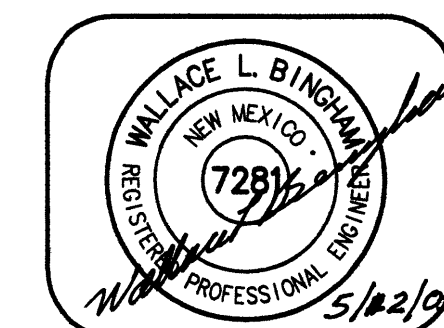

GRADING AND DRAINAGE PLAN
DEVON SELF STORAGE
4801 San Mateo Blvd NE

RECEIVED
DEC 14 2001
HYDROLOGY SECTION

Montgomery Boulevard, N.E.

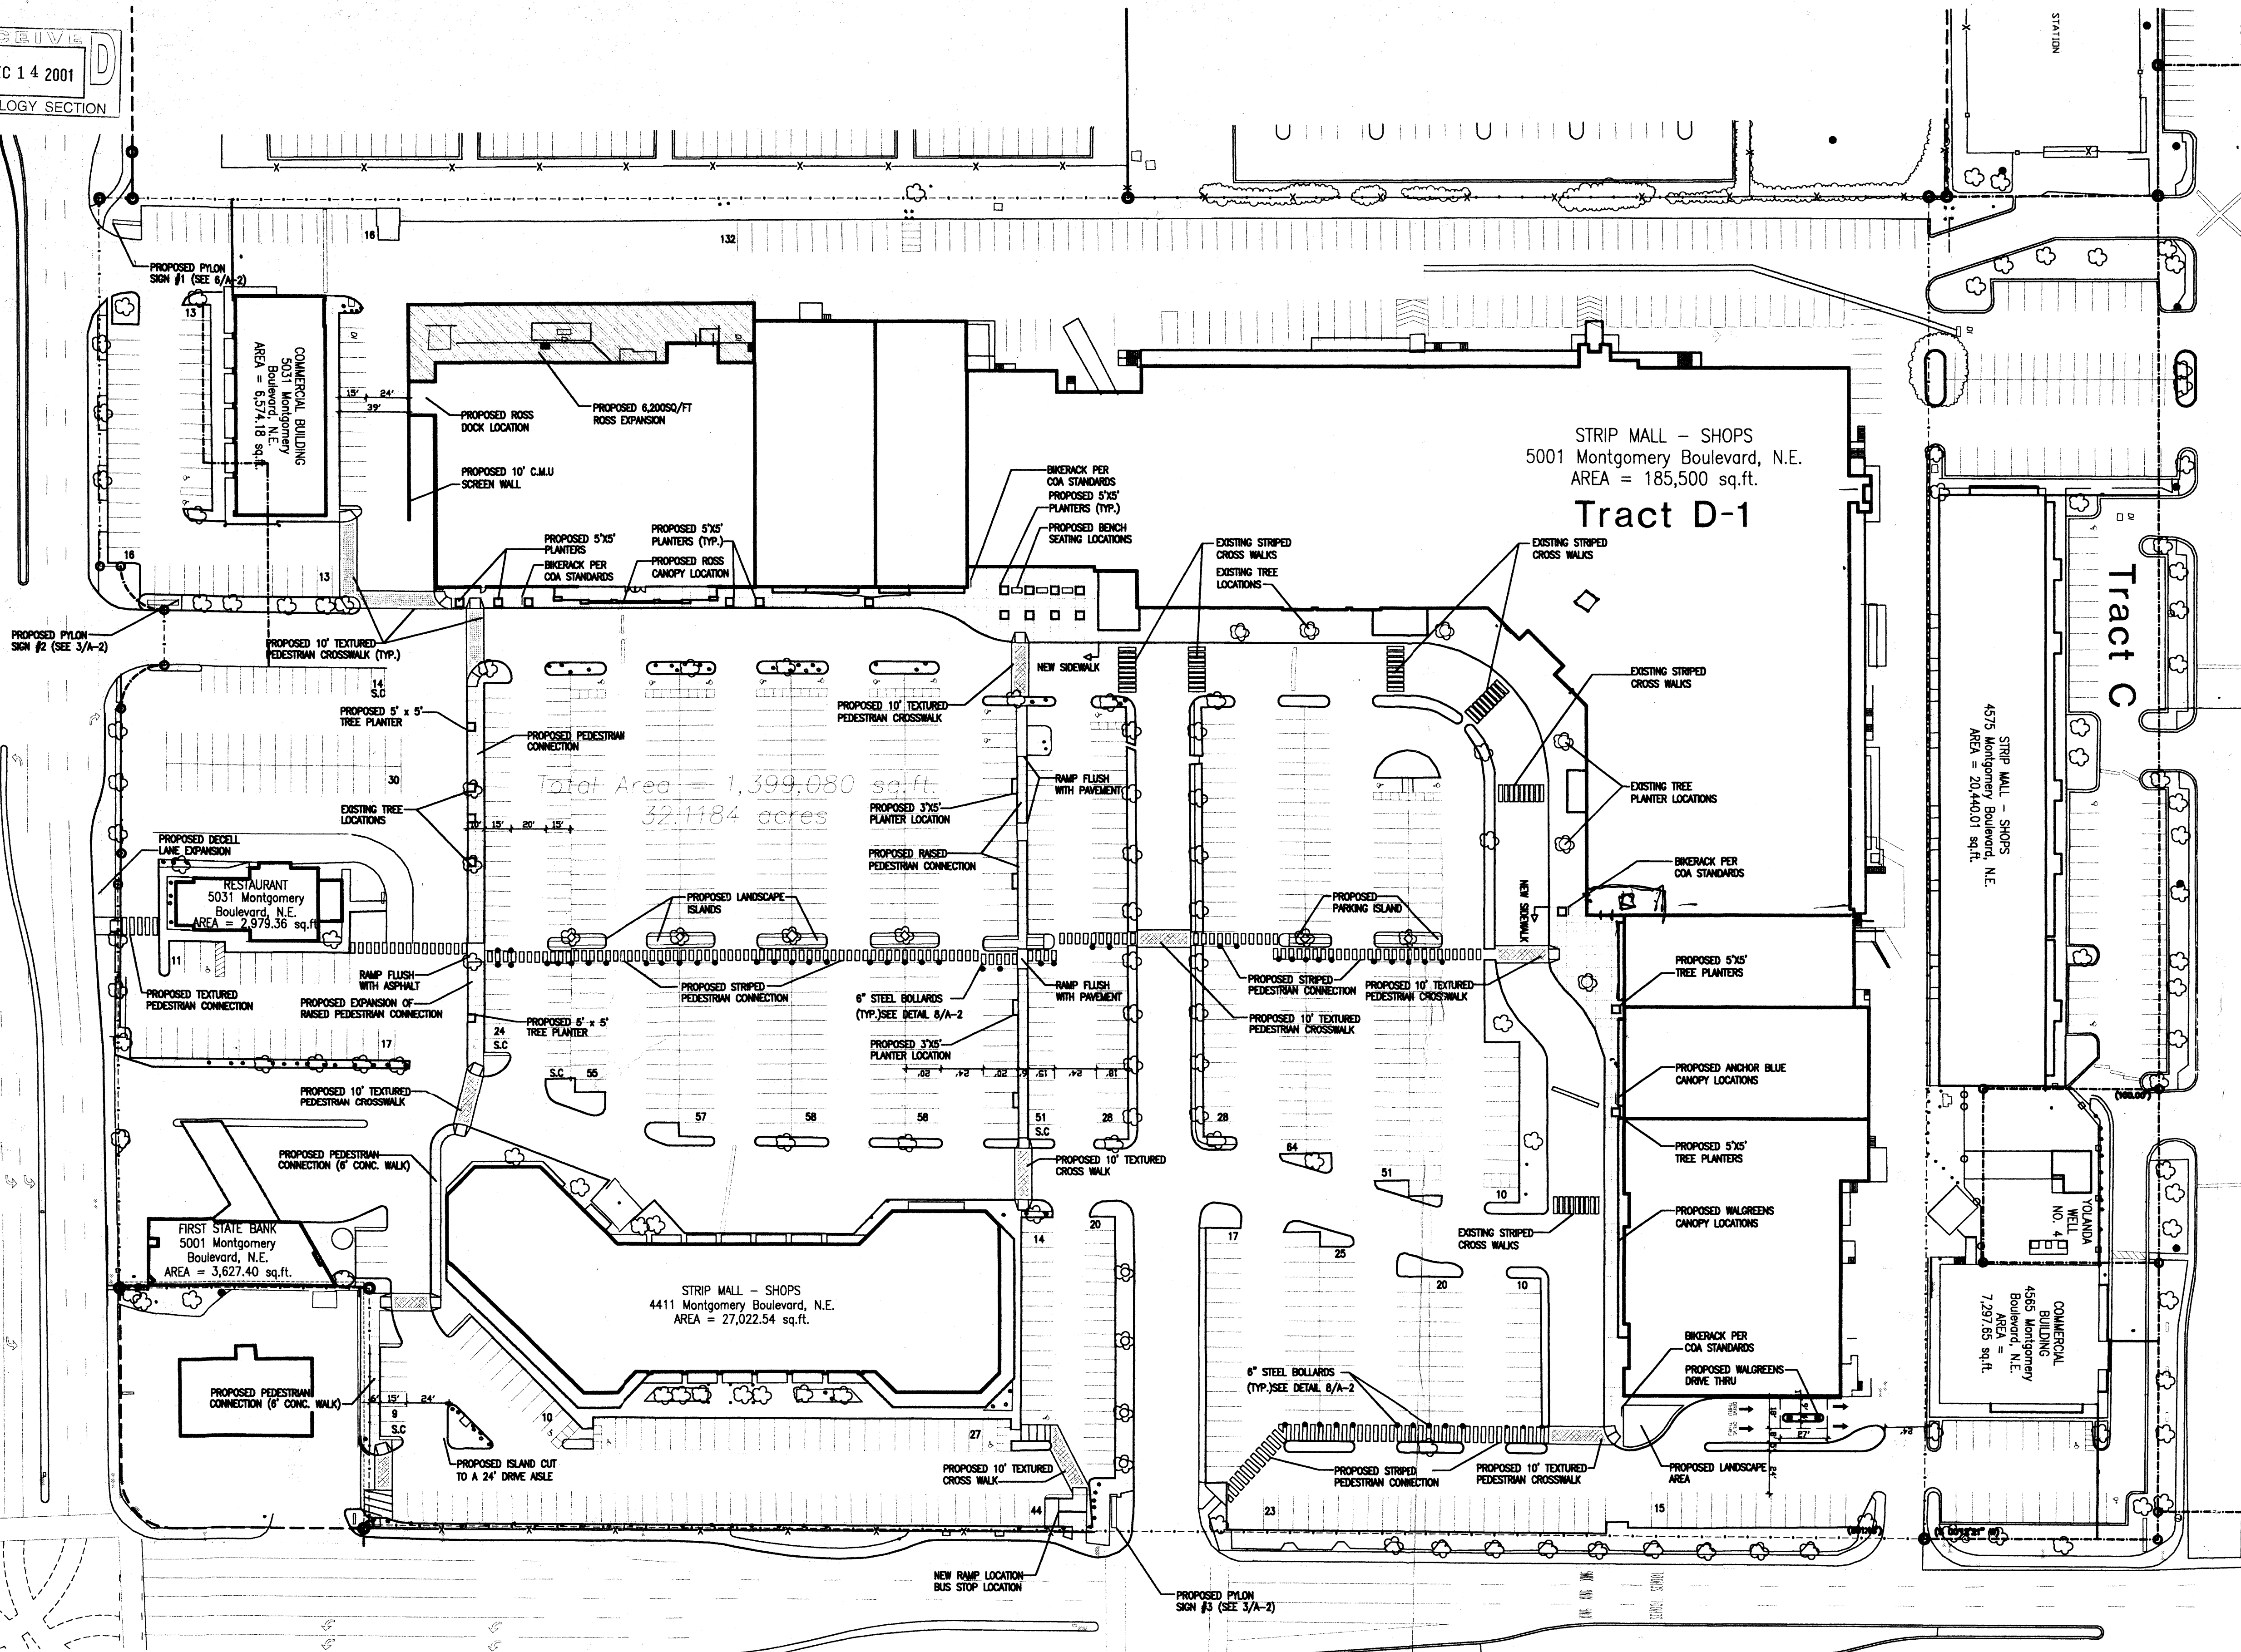

BUILDING AREA & PARKING CALCULATIONS:

BUILDING AREA

COMMERCIAL BUILDING @ 5031 MONTGOMERY BLVD. N.E.
6,722 SF. BUILDING

1 RENT A CENTER
7 CHECK MART
3 PAYLESS SHOES
6,722 SF / 200 = 34 SPACES
SPACES REQUIRED 34 SPACES

RESTAURANT @ 5031 MONTGOMERY BLVD. N.E.

85 SEATS / 4 = 21 SPACES
SPACES REQUIRED 21 SPACES

BANK @ 5001 MONTGOMERY BLVD. N.E.

3,200 SF. BUILDING
3,200 SF / 200 = 16 SPACES
SPACES REQUIRED 16 SPACES

MALL @ 4411 MONTGOMERY BLVD. N.E.

27,022 SF. BUILDING

6 BLOCKBUSTER VIDEO
7 VACANT
8 VACANT
9 VACANT
10 NUTRITION WAREHOUSE
11 J.B. CUSTOM JEWELERS
12 SUPER SALAD (174 SEATS) / 4
13 CIGARETTES CHEAPER
14 AIRTOUCH CELLULAR
15 AIRTOUCH CELLULAR
16 VACANT
17 NO APPT. HAIRCUTTERS
23,167 SF / 200 = 116 SPACES
174 SEATS / 4 = 44 SPACES
SPACES REQUIRED 160 SPACES

MALL @ 5001 MONTGOMERY BLVD. N.E.

191,200 SF. BUILDING

18 ROSS
19 FASHION BUG
20 VACANT
21 FURRS CAFETERIA (328 SEATS) / 4
22 BURLINGTON COAT FACTORY
23 VACANT
24 HEALTH CLUB (293 PERSON CAPACITY)
25 COMMONWEALTH THEATRES (TO BE UNUSED) +345 SEATS
26 VACANT
27 LUXURY LINENS
28 VACANT
29 VACANT
30 ANCHOR BLUE
31 WALGREENS
185,770 SF / 200 = 929 SPACES
328 SEATS - (1380 THEATRE SEATS) / 4 = +263 SPACES
293 PERSON HEALTH CLUB / 3 = 102 SPACES
SPACES REQUIRED 1027 SPACES

MALL @ 4565 MONTGOMERY BLVD. N.E.

7,297 SF. BUILDING

7,297 SF / 200 = 37 SPACES
SPACES REQUIRED 37 SPACES

MALL @ 4557 MONTGOMERY BLVD. N.E.

20,440 SF. BUILDING

20,440 SF / 200 = 102 SPACES
SPACES REQUIRED 102 SPACES

MOVIE THEATER @ 4591 MONTGOMERY BLVD. N.E.

1,925 SEATS / 4 = 481 SPACES
SPACES REQUIRED 481 SPACES

BLOCK PARTY @ 4595 MONTGOMERY BLVD. N.E.

40,300 SF. BUILDING

40,300 SF / 200 = 201 SPACES
SPACES REQUIRED 201 SPACES

HOOTERS RESTAURANT @ 4601 SAN MATEO BLVD. N.E.

CORRER CREEK STEAKHOUSE @ 4601 SAN MATEO BLVD. N.E.

488 SEATS / 3 = 163 SPACES
SPACES REQUIRED 163 SPACES

PARKING NOTES:

TYPICAL STANDARD SPACES ARE 9'-0" x 18'-0"
TYPICAL SMALL CAR SPACES ARE 7'-6" x 15'-0"
TYPICAL HANDICAP SPACES ARE 8'-0" x 18'-0"
WITH A 8' WIDE ACCESS AISLE


* ALL SPACES ARE STANDARD SIZE UNLESS OTHERWISE NOTED *

TOTAL STANDARD PARKING SPACES PROVIDED 1825 SPACES
TOTAL HC PARKING SPACES PROVIDED 47 SPACES
TOTAL SMALL CAR PARKING SPACES PROVIDED 91 SPACES
TOTAL PROVIDED 1963 SPACES

TOTAL REQUIRED SPACES = 2242 SPACES
15% BUS CREDIT DEDUCTION = 336 SPACES
TOTAL REQUIRED SPACES WITH 15% BUS CREDIT DEDUCTION = 1906 SPACES
TOTAL PROVIDED SPACES = 1963 SPACES

SITE PLAN

SCALE: 1"=50'-0"

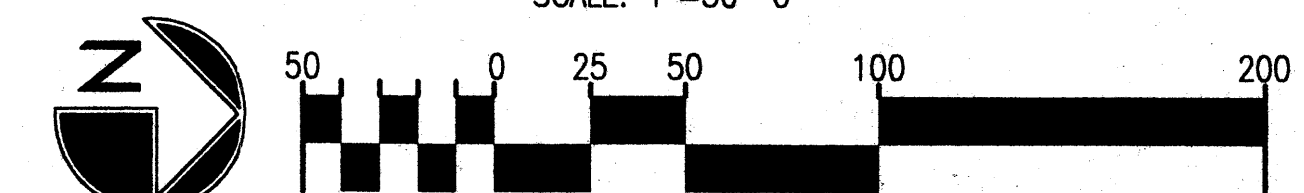


Project # 1000736
ADMINISTRATIVE
DEVELOPMENT PLAN AMENDMENT
FILE NO. AA-0122
see attached letter
APPROVED
Date 11/20/00
By JDM
DEPT. TRAFFIC ENGINEERING
Albuquerque, New Mexico
Planning Director DATE

RECEIVED
DEC 14 2001
HYDROLOGY SECTION

REV	DATE	BY	REVISION
1			
2			
3			
4			
5			
6			


GEORGE RAINHART ARCHITECT AND ASSOCIATES PC
2325 SAN PEDRO N.E. SUITE 2-B
ALBUQUERQUE, NEW MEXICO 87110
PHONE (505) 884-9110 FAX (505) 837-9877

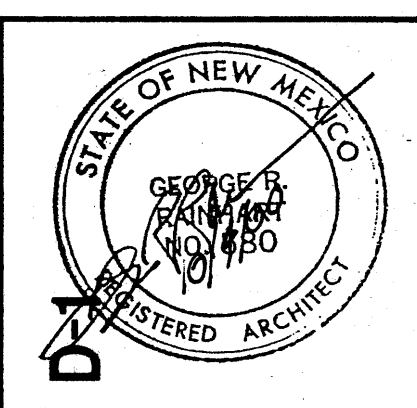

PROJECT TITLE
MONTGOMERY PLAZA TRACT D-1
5001 MONTGOMERY PLAZA N.E.
Albuquerque, New Mexico
PROJECT MANAGER
George Rainhart, AIA
JOB NO.
0030
DRAWN BY
SD
SHEET TITLE
SITE PLAN

DATE
7/20/00
SCALE
1"=50'
sheet-
A-1
of

Montgomery Boulevard, N.E.

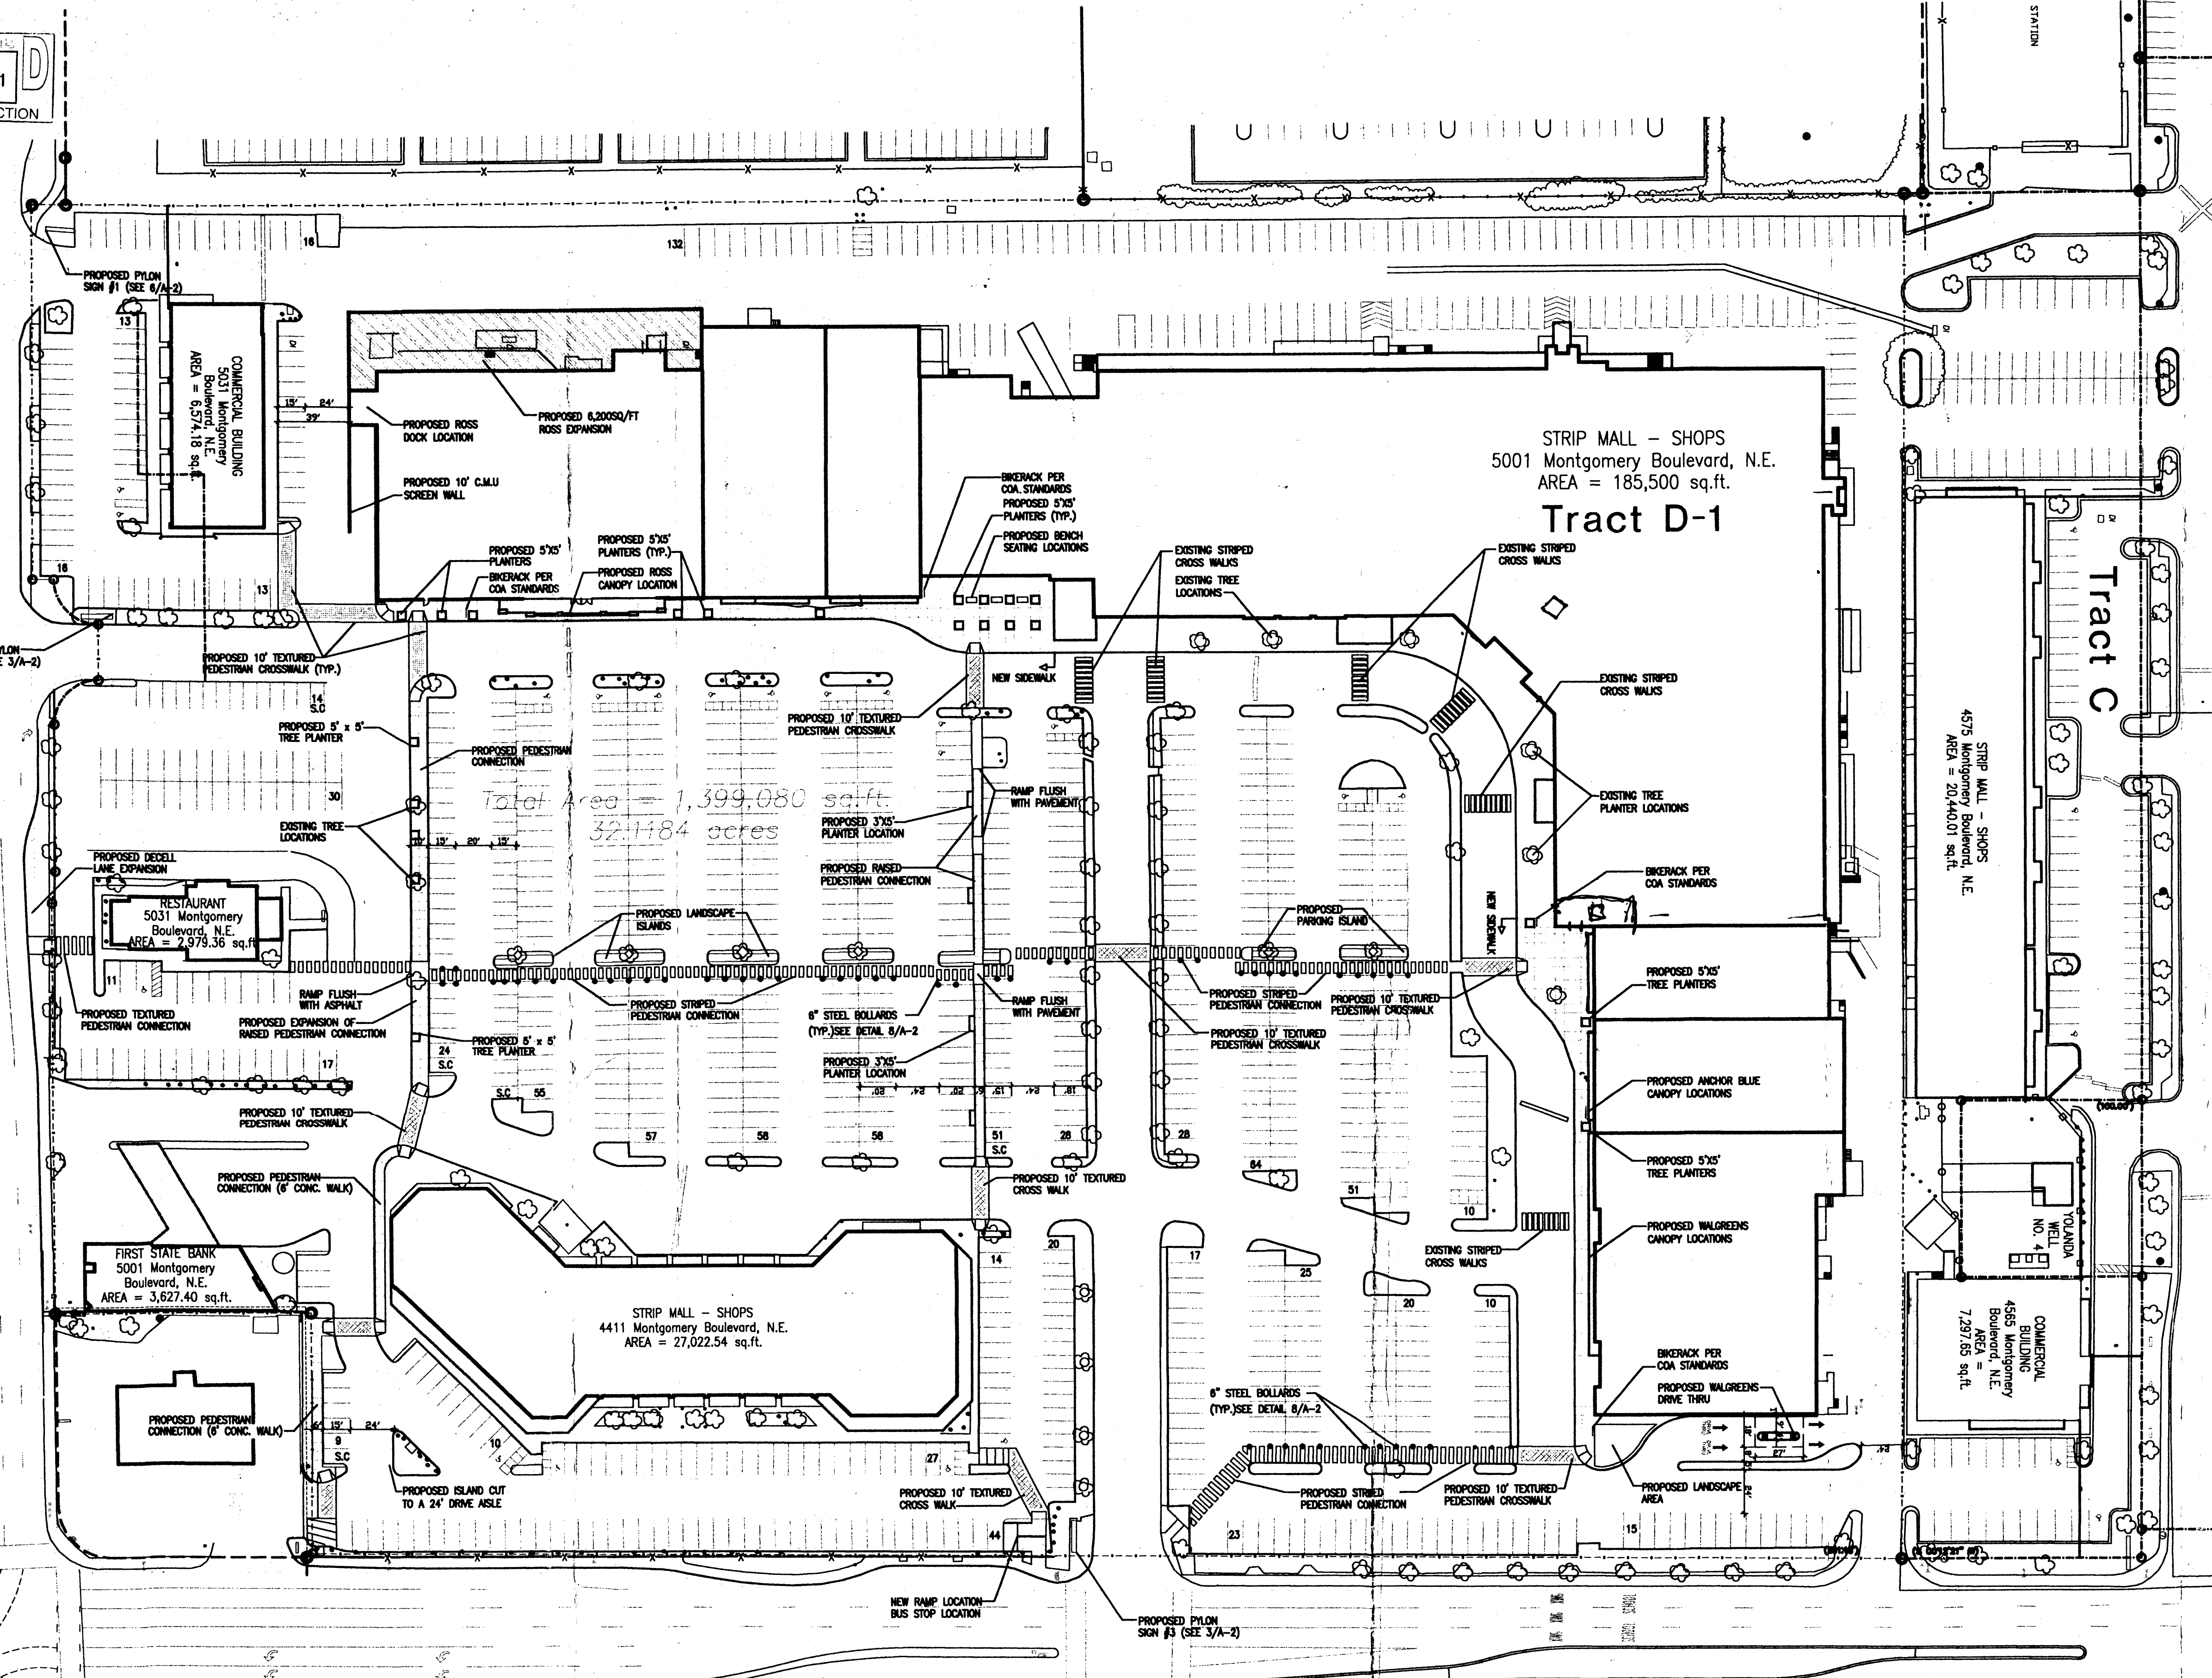

BUILDING AREA & PARKING CALCULATIONS:

BUILDING AREA	
COMMERCIAL BUILDING @ 5031 MONTGOMERY BLVD. N.E. 6,722 SF. BUILDING	
1 RENT A CENTER	
2 CHECK MART	
3 PAYLESS SHOES	
6,722 SF / 200 =	34 SPACES
SPACES REQUIRED	34 SPACES
RESTAURANT @ 5031 MONTGOMERY BLVD. N.E.	
85 SEATS / 4 =	21 SPACES
SPACES REQUIRED	21 SPACES
BANK @ 5001 MONTGOMERY BLVD. N.E. 3,200 SF. BUILDING	
3,200 SF / 200 =	16 SPACES
SPACES REQUIRED	16 SPACES
MALL @ 4411 MONTGOMERY BLVD N.E. 27,022 SF. BUILDING	
6 BLOCKBUSTER VIDEO	
7 VACANT	
8 VACANT	
9 VACANT	
10 NUTRITION WAREHOUSE	
11 J.B. CUSTOM JEWELERS	
12 SOUPER SALAD (174 SEATS)/4	
13 CIGARETTES CHEAPER	
14 AIRTOUCH CELLULAR	
15 AIRTOUCH CELLULAR	
16 VACANT	
17 NO APPT. HAIRCUTTERS	
23,167 SF / 200 =	116 SPACES
174 SEATS / 4 =	44 SPACES
SPACES REQUIRED	160 SPACES

MALL @ 5001 MONTGOMERY BLVD N.E. 191,200 SF. BUILDING	
18 ROSS	
19 FASHION BUG	
20 VACANT	
21 FURRS CAFETERIA (328 SEATS) /4	
22 BURLINGTON COAT FACTORY	
23 VACANT	
24 HEALTH CLUB (283 PERSON CAPACITY)	
25 COMMONWEALTH THEATRES (TO BE UNUSED) +345 SEATS	
26 VACANT	
27 LUXURY LINENS	
28 VACANT	
29 VACANT	
30 ANCHOR BLUE	
31 WALGREENS	
185,770 SF / 200 =	929 SPACES
328 SEATS - (1380 THEATRE SEATS) / 4 =	+263 SPACES
283 PERSON HEALTH CLUB/3 =	98 SPACES
SPACES REQUIRED	1027 SPACES
MALL @ 4565 MONTGOMERY BLVD N.E. 7,297 SF. BUILDING	
7,297 SF / 200 =	37 SPACES
SPACES REQUIRED	37 SPACES
MALL @ 4557 MONTGOMERY BLVD N.E. 20,440 SF. BUILDING	
20,440 SF / 200 =	102 SPACES
SPACES REQUIRED	102 SPACES
MOVIE THEATER @ 4591 MONTGOMERY BLVD N.E.	
1,925 SEATS / 4 =	481 SPACES
SPACES REQUIRED	481 SPACES
BLOCK PARTY @ 4595 MONTGOMERY BLVD N.E. 40,300 SF. BUILDING	
40,300 SF / 200 =	201 SPACES
SPACES REQUIRED	201 SPACES
HOOTERS RESTAURANT @ 4601 SAN MATEO BLVD N.E. CORRER CREEK STEAKHOUSE @ 4601 SAN MATEO BLVD N.E.	
488 SEATS / 3 =	163 SPACES
SPACES REQUIRED	163 SPACES

PARKING NOTES:

TYPICAL STANDARD SPACES ARE 9'-0" x 18'-0"
TYPICAL SMALL CAR SPACES ARE 7'-6" x 15'-0"
TYPICAL HANDICAP SPACES ARE 8'-0" x 18'-0"
WITH A 8' WIDE ACCESS AISLE


* ALL SPACES ARE STANDARD SIZE UNLESS OTHERWISE NOTED *

TOTAL STANDARD PARKING SPACES PROVIDED	1825 SPACES
TOTAL HC PARKING SPACES PROVIDED	47 SPACES
TOTAL SMALL CAR PARKING SPACES PROVIDED	91 SPACES
TOTAL PROVIDED	1963 SPACES

TOTAL REQUIRED SPACES = 2242 SPACES
15% BUS CREDIT DEDUCTION= 336 SPACES
TOTAL REQUIRED SPACES WITH 15% BUS CREDIT DEDUCTION= 1906 SPACES
TOTAL PROVIDED SPACES = 1963 SPACES


Project # 1000236
ADMINISTRATIVE
DEVELOPMENT PLAN AMENDMENT
FILE NO. AA-01122
see attached letter
PLANNING DIRECTOR
DATE

APPROVED
Date 11/20/00
By JOM
DEPT. TRAFFIC ENGINEERING
Albuquerque, New Mexico

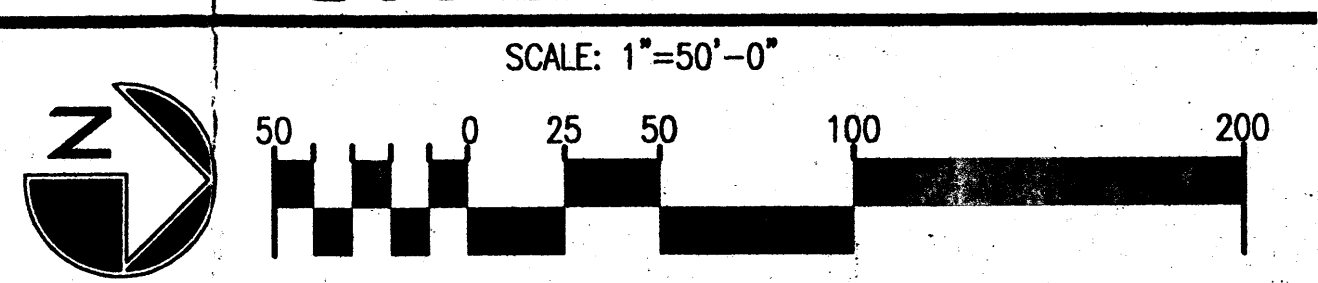

REV	DATE	BY	REVISION
1			
2			
3			
4			


GEORGE RAINHART ARCHITECT AND ASSOCIATES PC
2325 SAN PEDRO N.E. SUITE 2-B
ALBUQUERQUE, NEW MEXICO 87110
PHONE (505) 884-9110 FAX (505) 837-9877

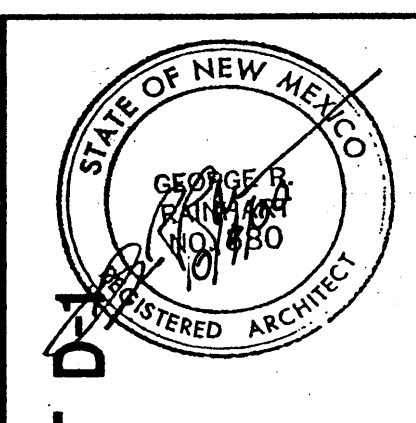


PROJECT TITLE	MONTGOMERY PLAZA TRACT D-1
PROJECT MANAGER	George Rainhart, AIA
DRAWN BY	SD
JOB NO.	0030
SHEET TITLE	SITE PLAN
DATE	7/20/00
SCALE	1"=50'
SHEET	A-1

Montgomery Blvd.

San Mateo Blvd.

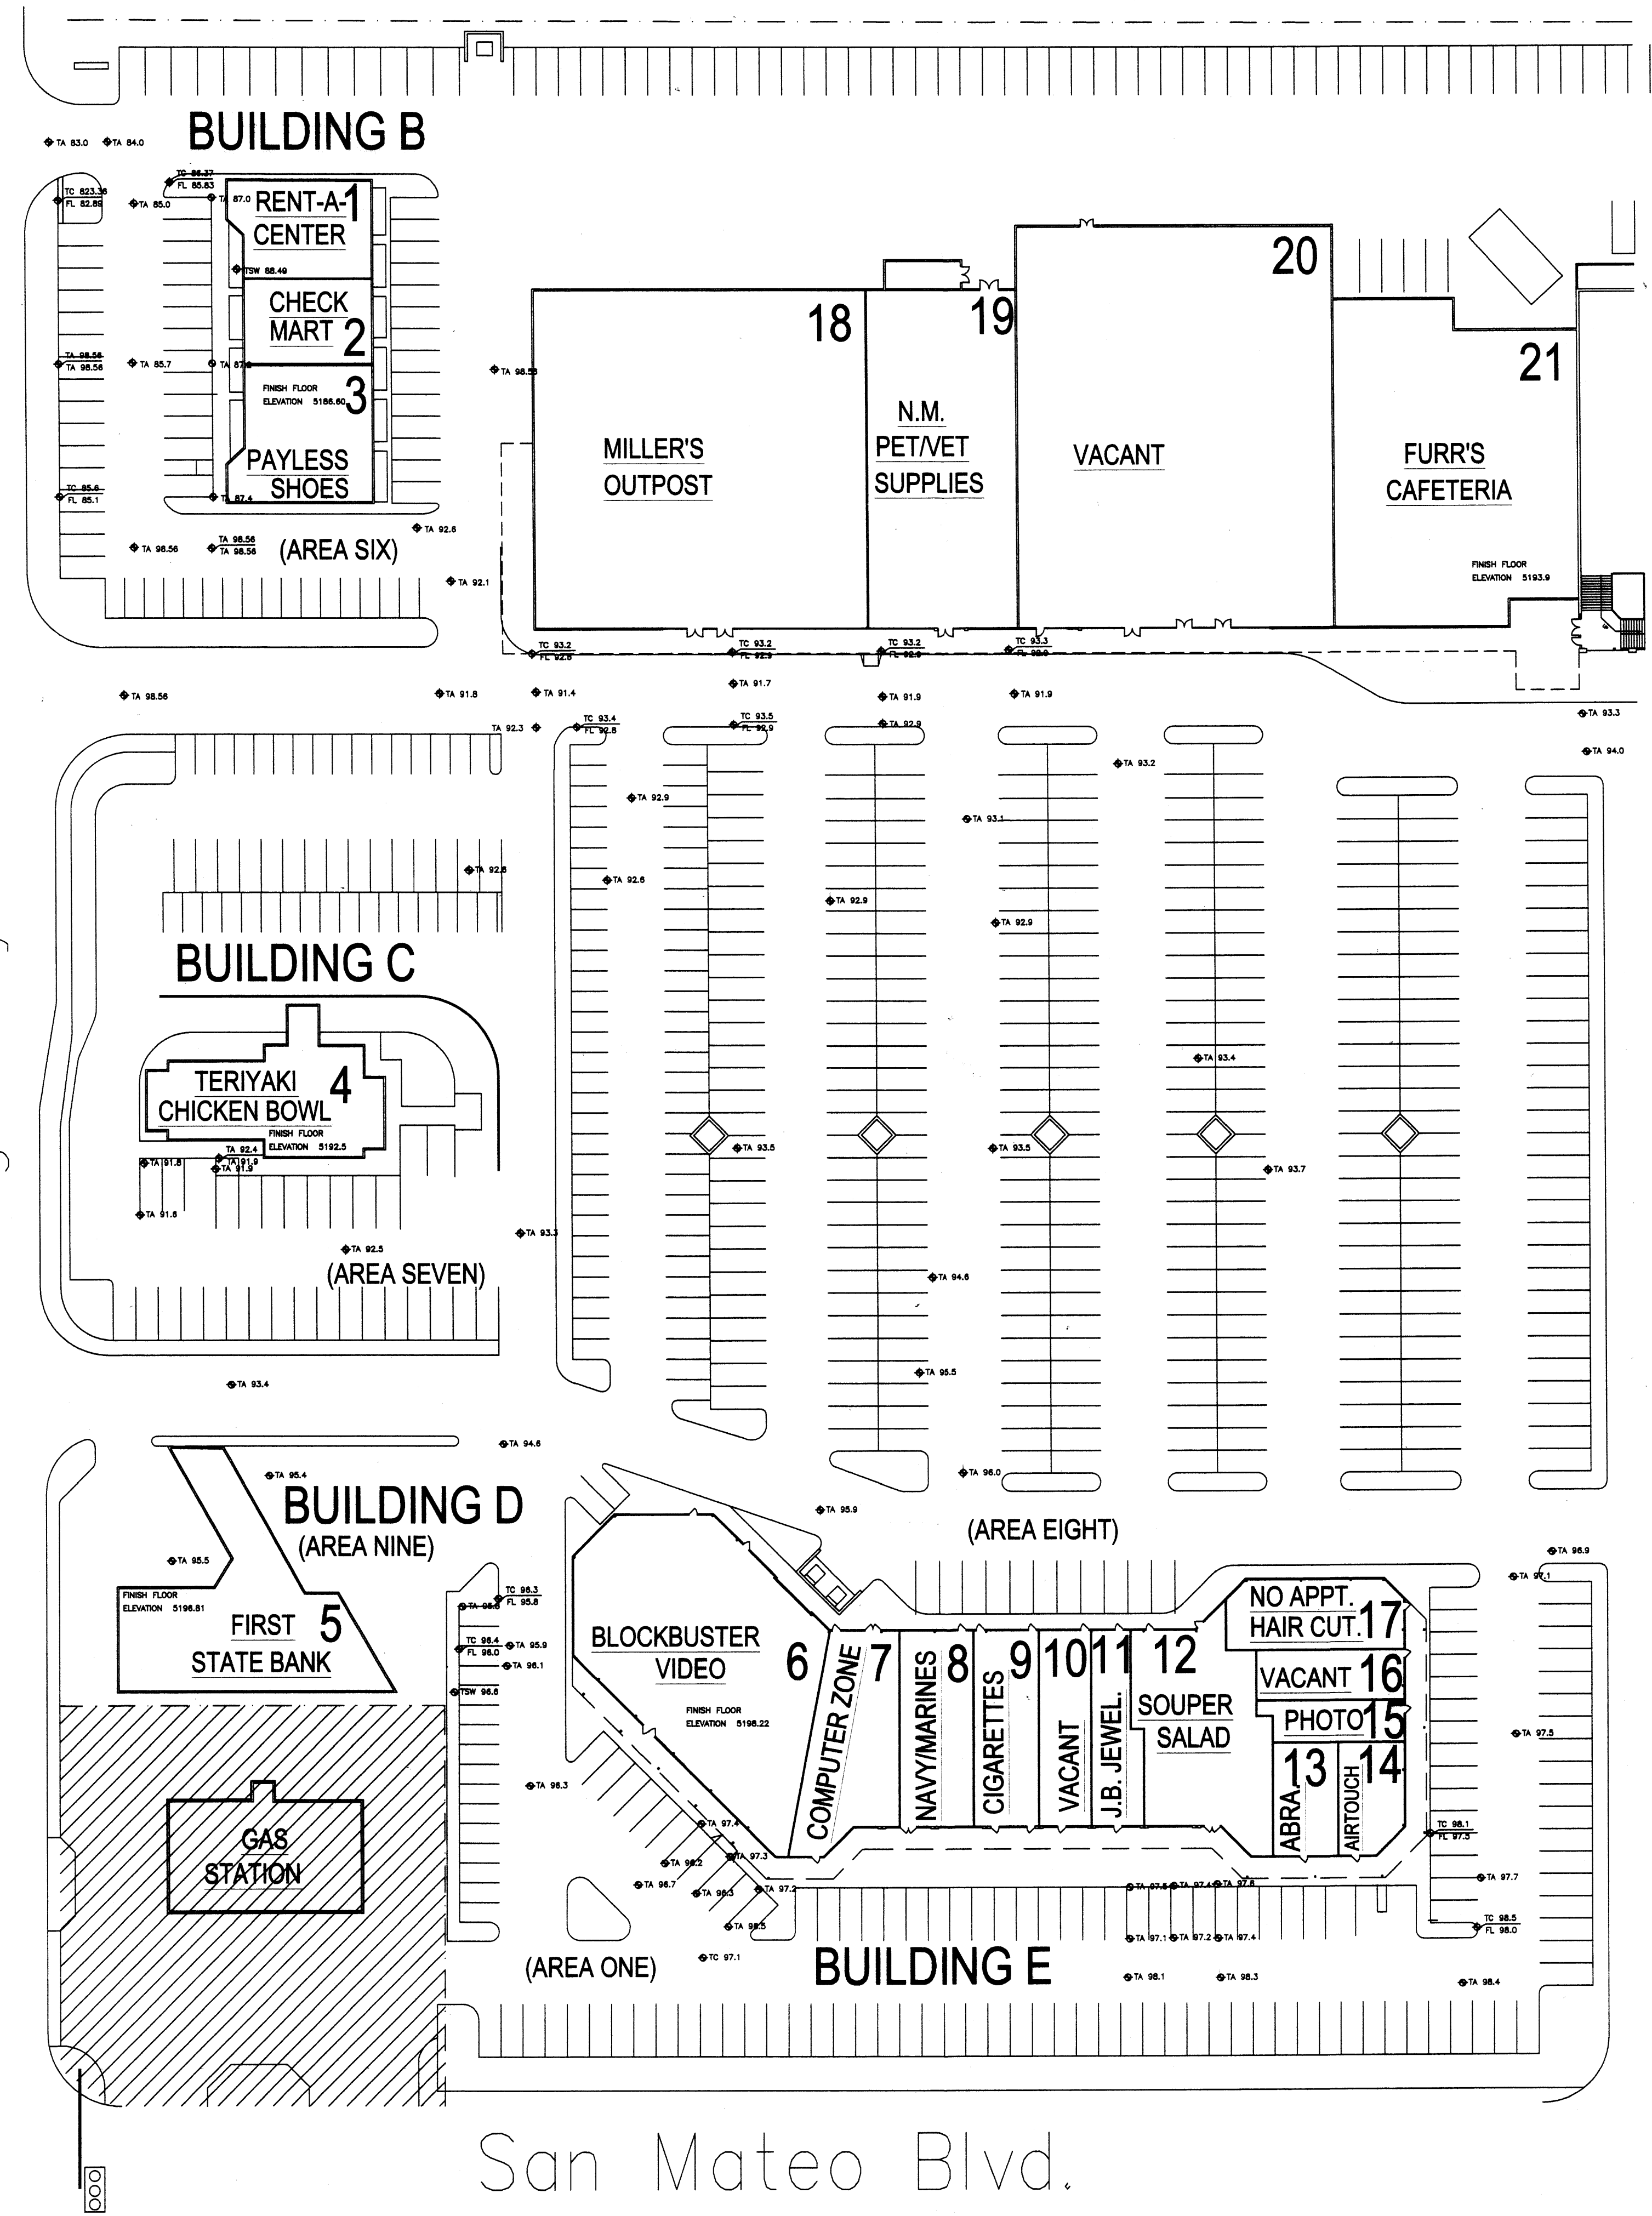

RECEIVED
FEB 28 2000
HYDROLOGY SECTION

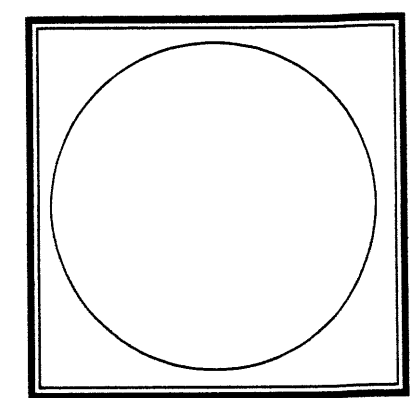


JOB NO:
DATE: FEBRUARY 18, 2000
REVISIONS


Sheet Title
GRADING & PAVING PLAN
Drawn By: BJM
Checked By:

BJM DEVELOPMENT CONSULTANT
DESIGN - PLANNER
Albuquerque, New Mexico

Project Name
MONTGOMERY PLAZA
ALBUQUERQUE, NM

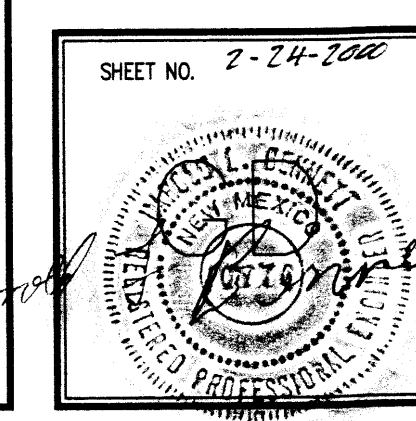

MONTGOMERY PLAZA PAVING RENOVATIONS

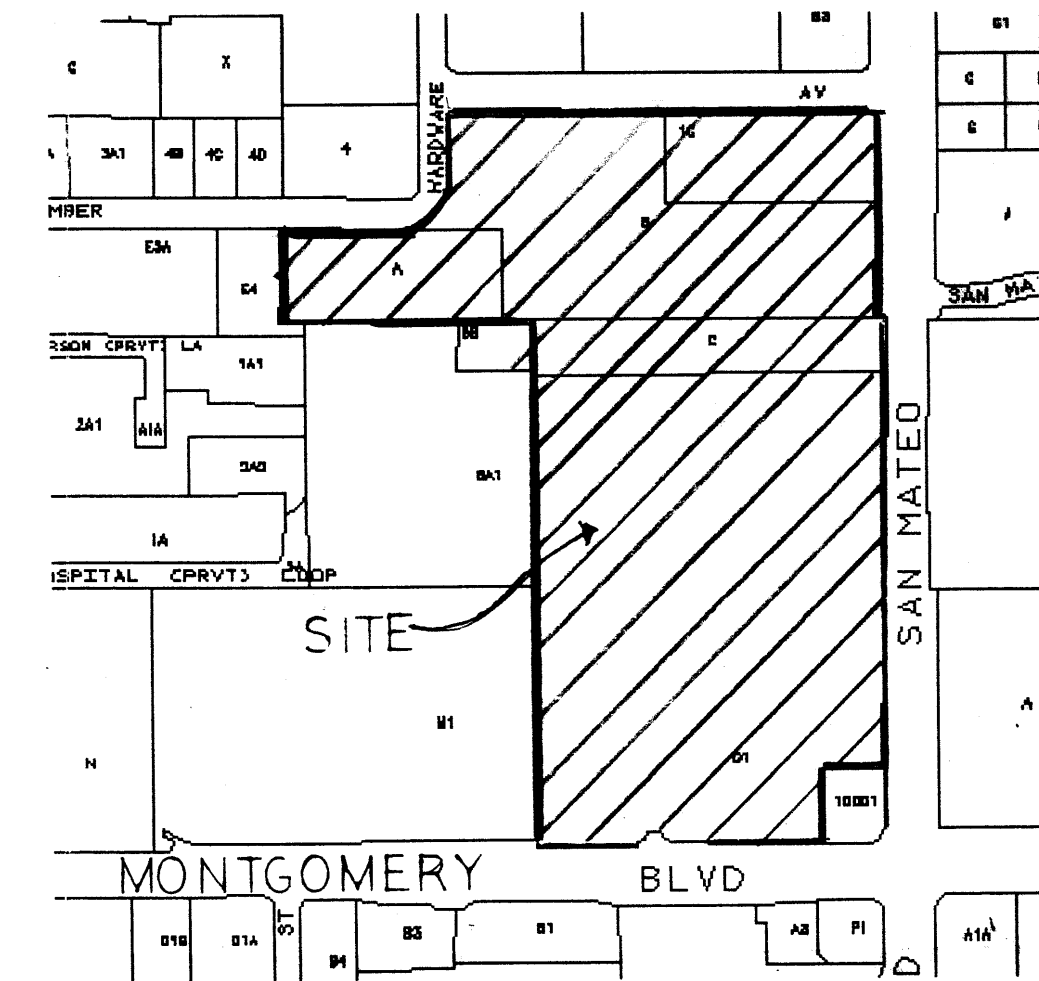

VICINITY MAP F-17
FIRM PANEL 0139-D

GRADING/PAVING PLAN

The following items concerning the Montgomery Plaza Mall Grading/Paving Plan are contained hereon:

1. Vicinity Map
2. Grading/Paving Plan
3. Firm Panel Map

EXISTING CONDITIONS

As shown by the vicinity map, the site is located at the northwest corner of the intersection of Montgomery Blvd. NE and San Mateo Blvd. NE. The shopping center is bordered by San Mateo Blvd. on the east, Montgomery Blvd. on the south, Lumber Avenue on the north, and developed Saint Joseph Hospital parking to the west. At present the site is fully developed as a shopping center. Furthermore, due to the developed nature of the site and the surrounding parcels, there are no off-site flows of concern in this analysis. According to the Flood Insurance Rate Map, Panel 0139-D, dated September 20, 1996, the site is not located within a designated flood zone.

PROPOSED CONDITIONS

As shown by this plan, the proposed improvements will not alter the existing drainage patterns. A majority of the existing asphalt areas are in poor condition and will be repaired and overlaid. Some areas will be totally removed and repaved. The existing grades will not be altered to a point that will require redesign. The majority of the handicap ramps and accessible parking spaces that don't meet ADA requirements will be regraded. Mr. John Rife Torkelson from Austin, Texas has been hired to evaluate these conditions. All existing developed run-off will be routed in its historical pattern, no swales, curb-cuts, inlets or any other drainage features will be altered. The original drainage concept will remain intact. No additional impervious or pervious areas will be created.

AREAS OF REPAIR

AREA ONE	- Rejuvenator Sealer	- 5,086 square yards.	1,646 square feet, cut and remove repairs.
AREA TWO	- Rejuvenator Sealer	- 11,628 square yards.	1,072 square feet, cut and remove repairs.
AREA THREE	- Rejuvenator Sealer	- 17,746 square yards.	8,321 square feet, cut and remove repairs.
AREA FOUR	- 1 1/2" Overlay	- 8,010 square yards.	3,010 square feet, cut and remove repairs.
AREA FIVE	- 1 1/2" Overlay	- 3,749 square yards.	566 square feet, cut and remove repair.
AREA SIX	- Rejuvenator Sealer	- 1,347 square yards.	1,347 square feet, cut and remove repair.
AREA SEVEN	- 1 1/2" Overlay	- 2,011 square yards.	2,652 square feet, cut and remove repairs.
AREA EIGHT	- 1 1/2" Overlay	- 2,155 square yards.	8,231 square feet, cut and remove repairs.
AREA NINE	- 1 1/2" Overlay	- 878 square yards.	621 square feet, cut and remove repair.


LEGEND:

- EXISTING SPOT ELEVATION
- EXISTING SPOT ELEVATION

LEGAL DESCRIPTION:
TRACTS A, B, C, AND D-1 OF MONTGOMERY PLAZA
AND TRACT 1-C OF ALLWOOD SUBDIVISION

PROJECT BENCHMARK:
ACS STATION 5-F18A LOCATED AT THE
INTERSECTION OF MONTGOMERY AND SAN MATEO
ON THE NOSE OF THE EAST MEDIAN ELEVATION 5201.83
TEMPORARY BENCHMARK: EXISTING FINISH FLOORS OF EACH BUILDING

RECEIVED
FEB 28 2000
HYDROLOGY SECTION

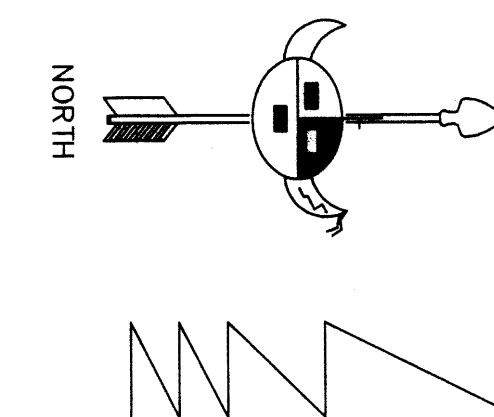

GRADING/PAVING PLAN

Scale 1"=40'-0"

RECEIVED
CCT 01 2001
HYDROLOGY SECTION

JOB NO:

FEBRUARY 18, 2000

REVISIONS

GRADING/PAVING PLAN

Sheet Title

Checked By: B. MONTOYA

Drawn By: B. MONTOYA


BUM DEVELOPMENT CONSULTANT


4409 KAROL RD. SW • Albuquerque, NM • 87121 • (505) 877-4841

Project Name


MONTGOMERY PLAZA
ALBUQUERQUE, NEW MEXICO

SHEET NO.

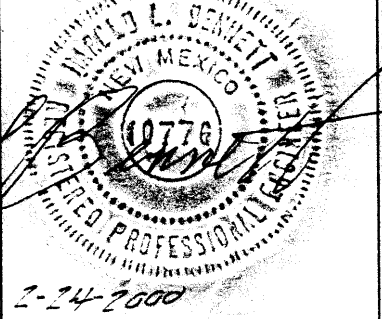

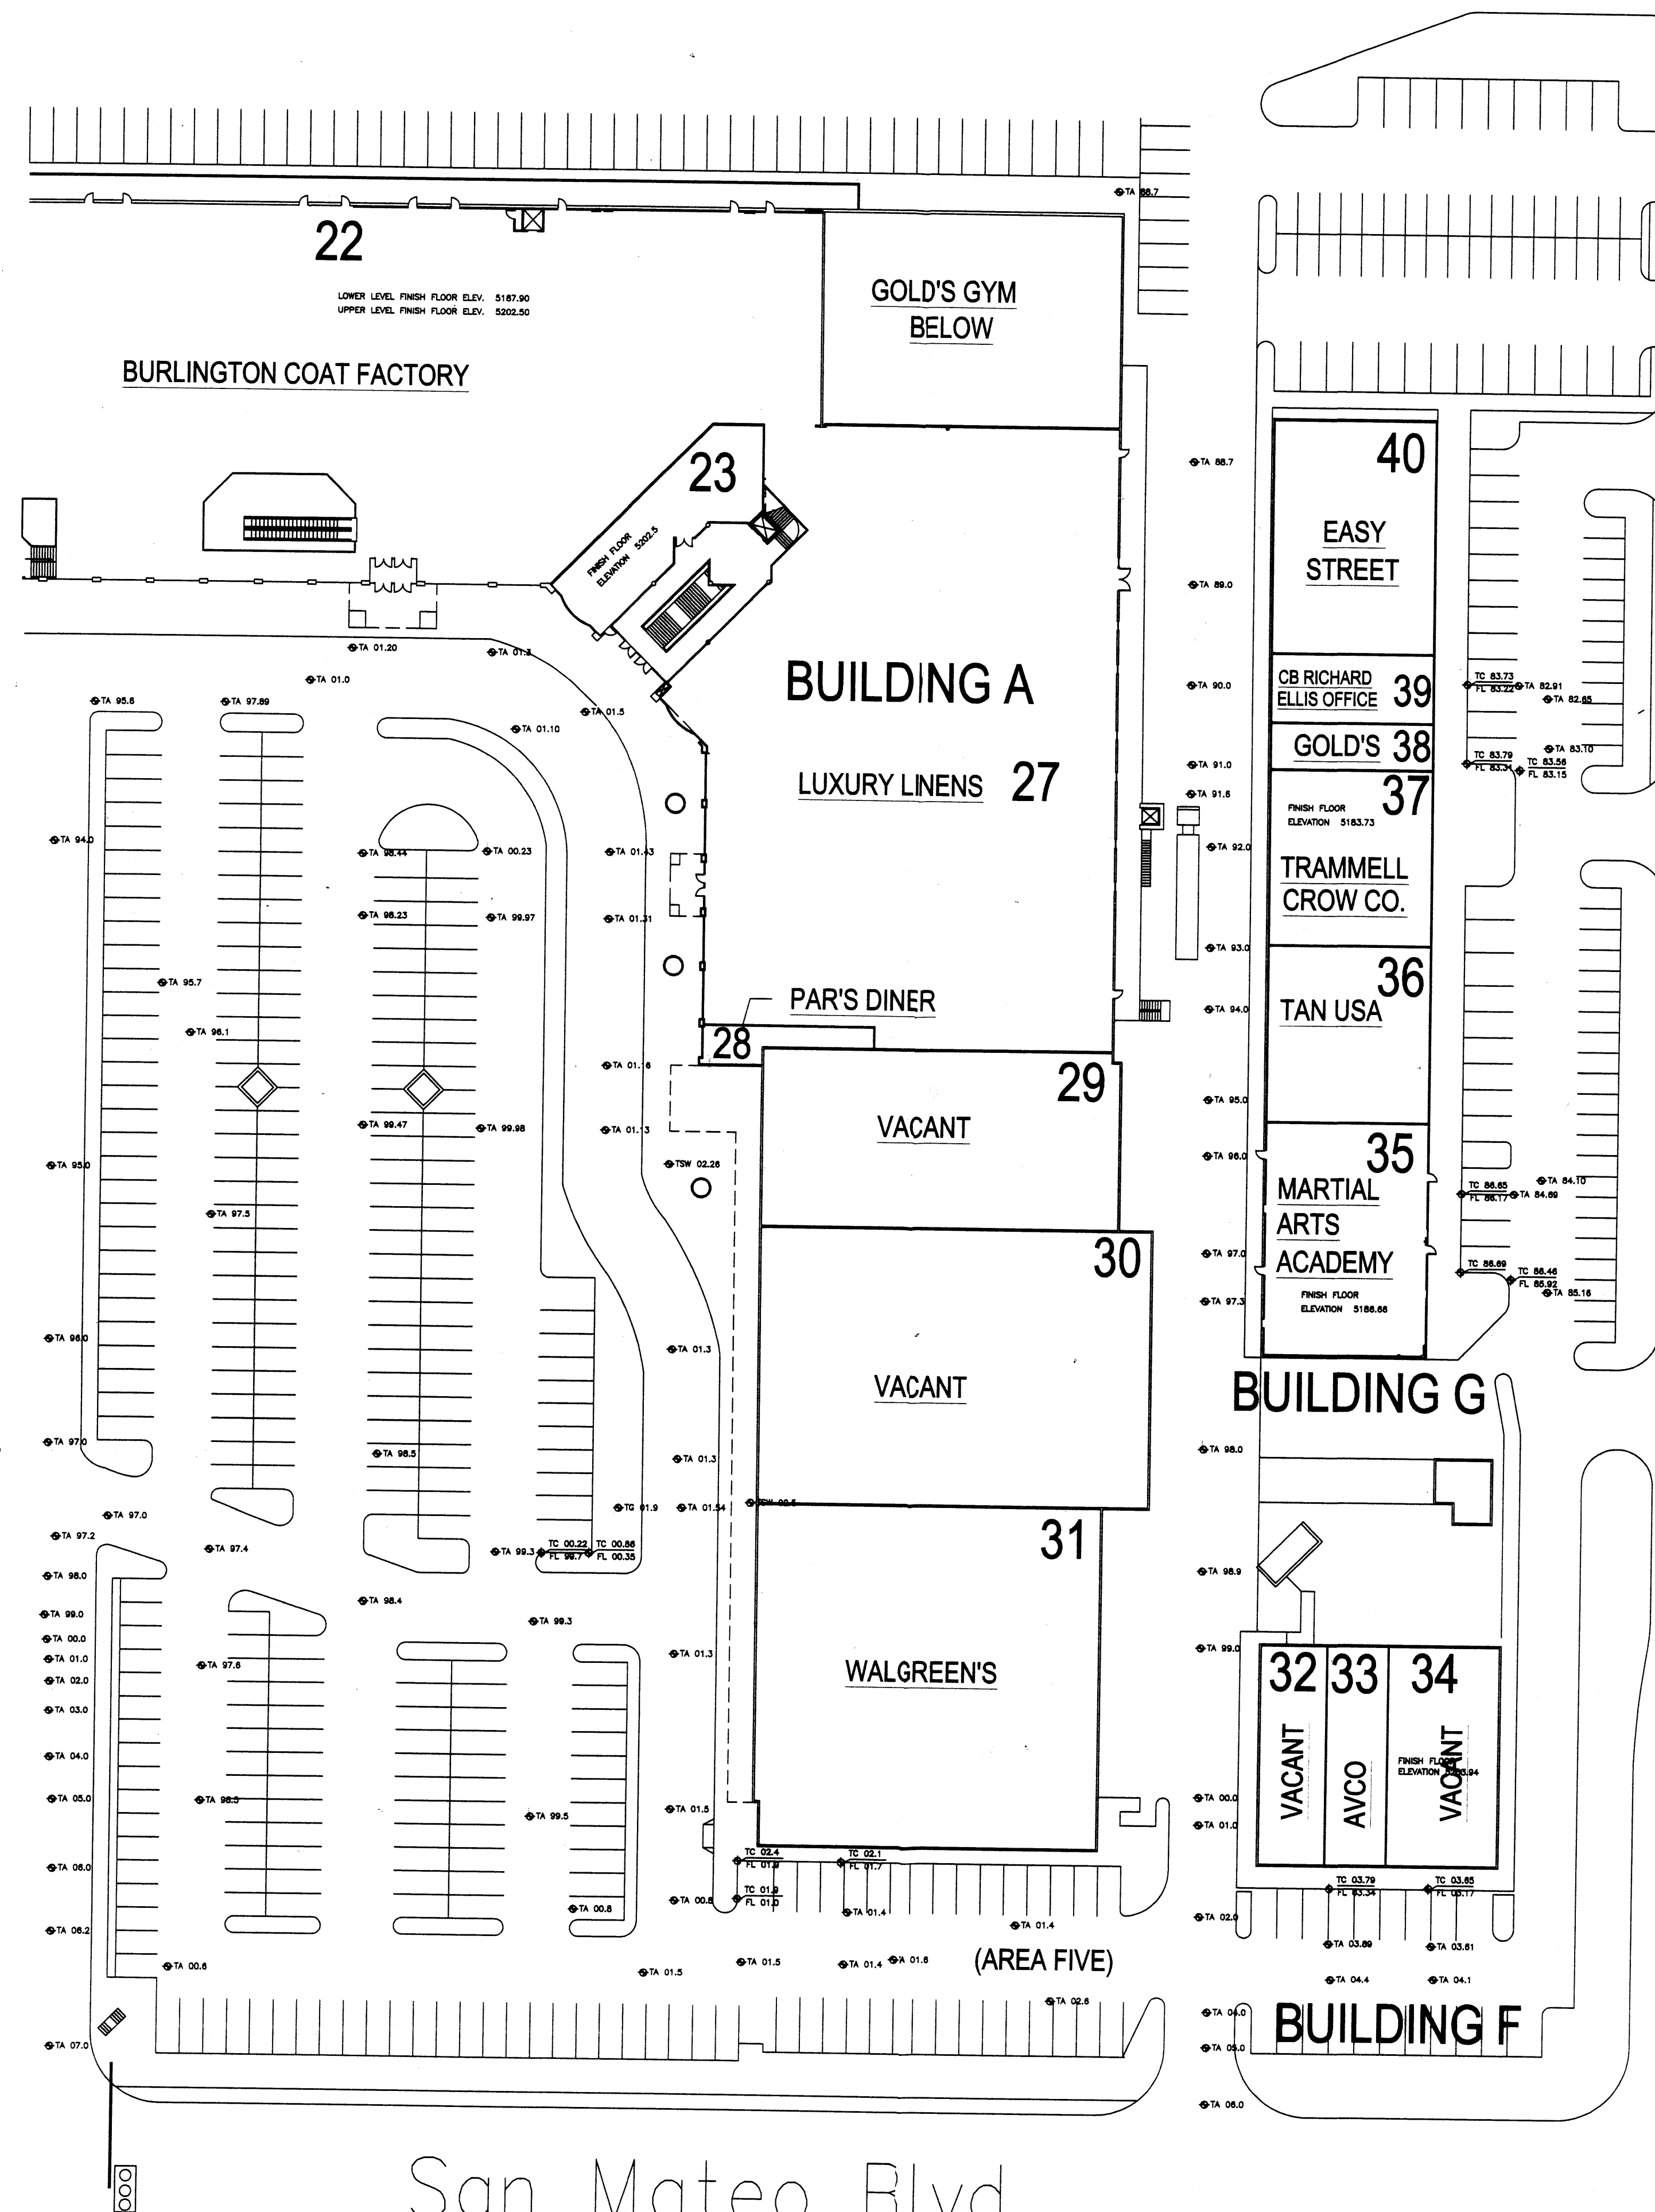

RECEIVED
FEB 28 2000
HYDROLOGY SECTION

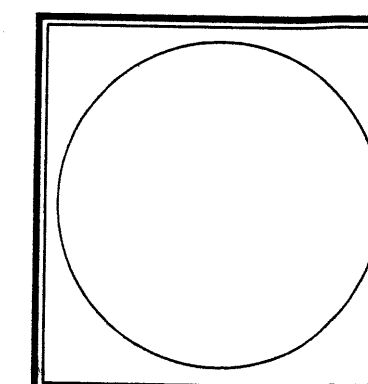



JOB NO.	
DATE:	FEBRUARY 18, 2000
REVISIONS	

Sheet Title
GRADING & PAVING PLAN
Drawn By: BIM
Checked By:

BIM DEVELOPMENT CONSULTANT
DESIGN - PLANNER
Albuquerque, New Mexico

Project Name
MONTGOMERY PLAZA
ALBUQUERQUE, NM

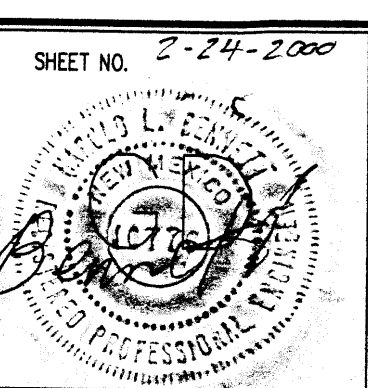


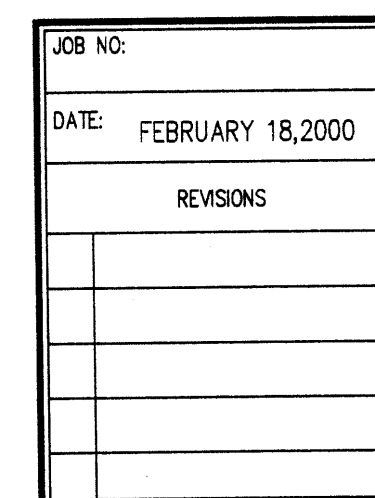


Sheet Title
GRADING & PAVING PLAN

BUM DEVELOPMENT CONSULTANT
DESIGN — PLANNER
Albuquerque, New Mexico

Project Name
MONTGOMERY PLAZA ALBUQUERQUE, NM

A circular professional engineer seal for the State of New Mexico. The outer ring contains the text "NEW MEXICO" at the top and "PROFESSIONAL ENGINEER" at the bottom. Inside the ring, the words "STATE OF" and "NEW MEXICO" are written in a smaller arc. The center of the seal features the license number "2776" and a signature, which appears to be "J. H. Smith". The seal is stamped over a document that includes the text "SHEET NO." and a handwritten number "2-24" in the top right corner.

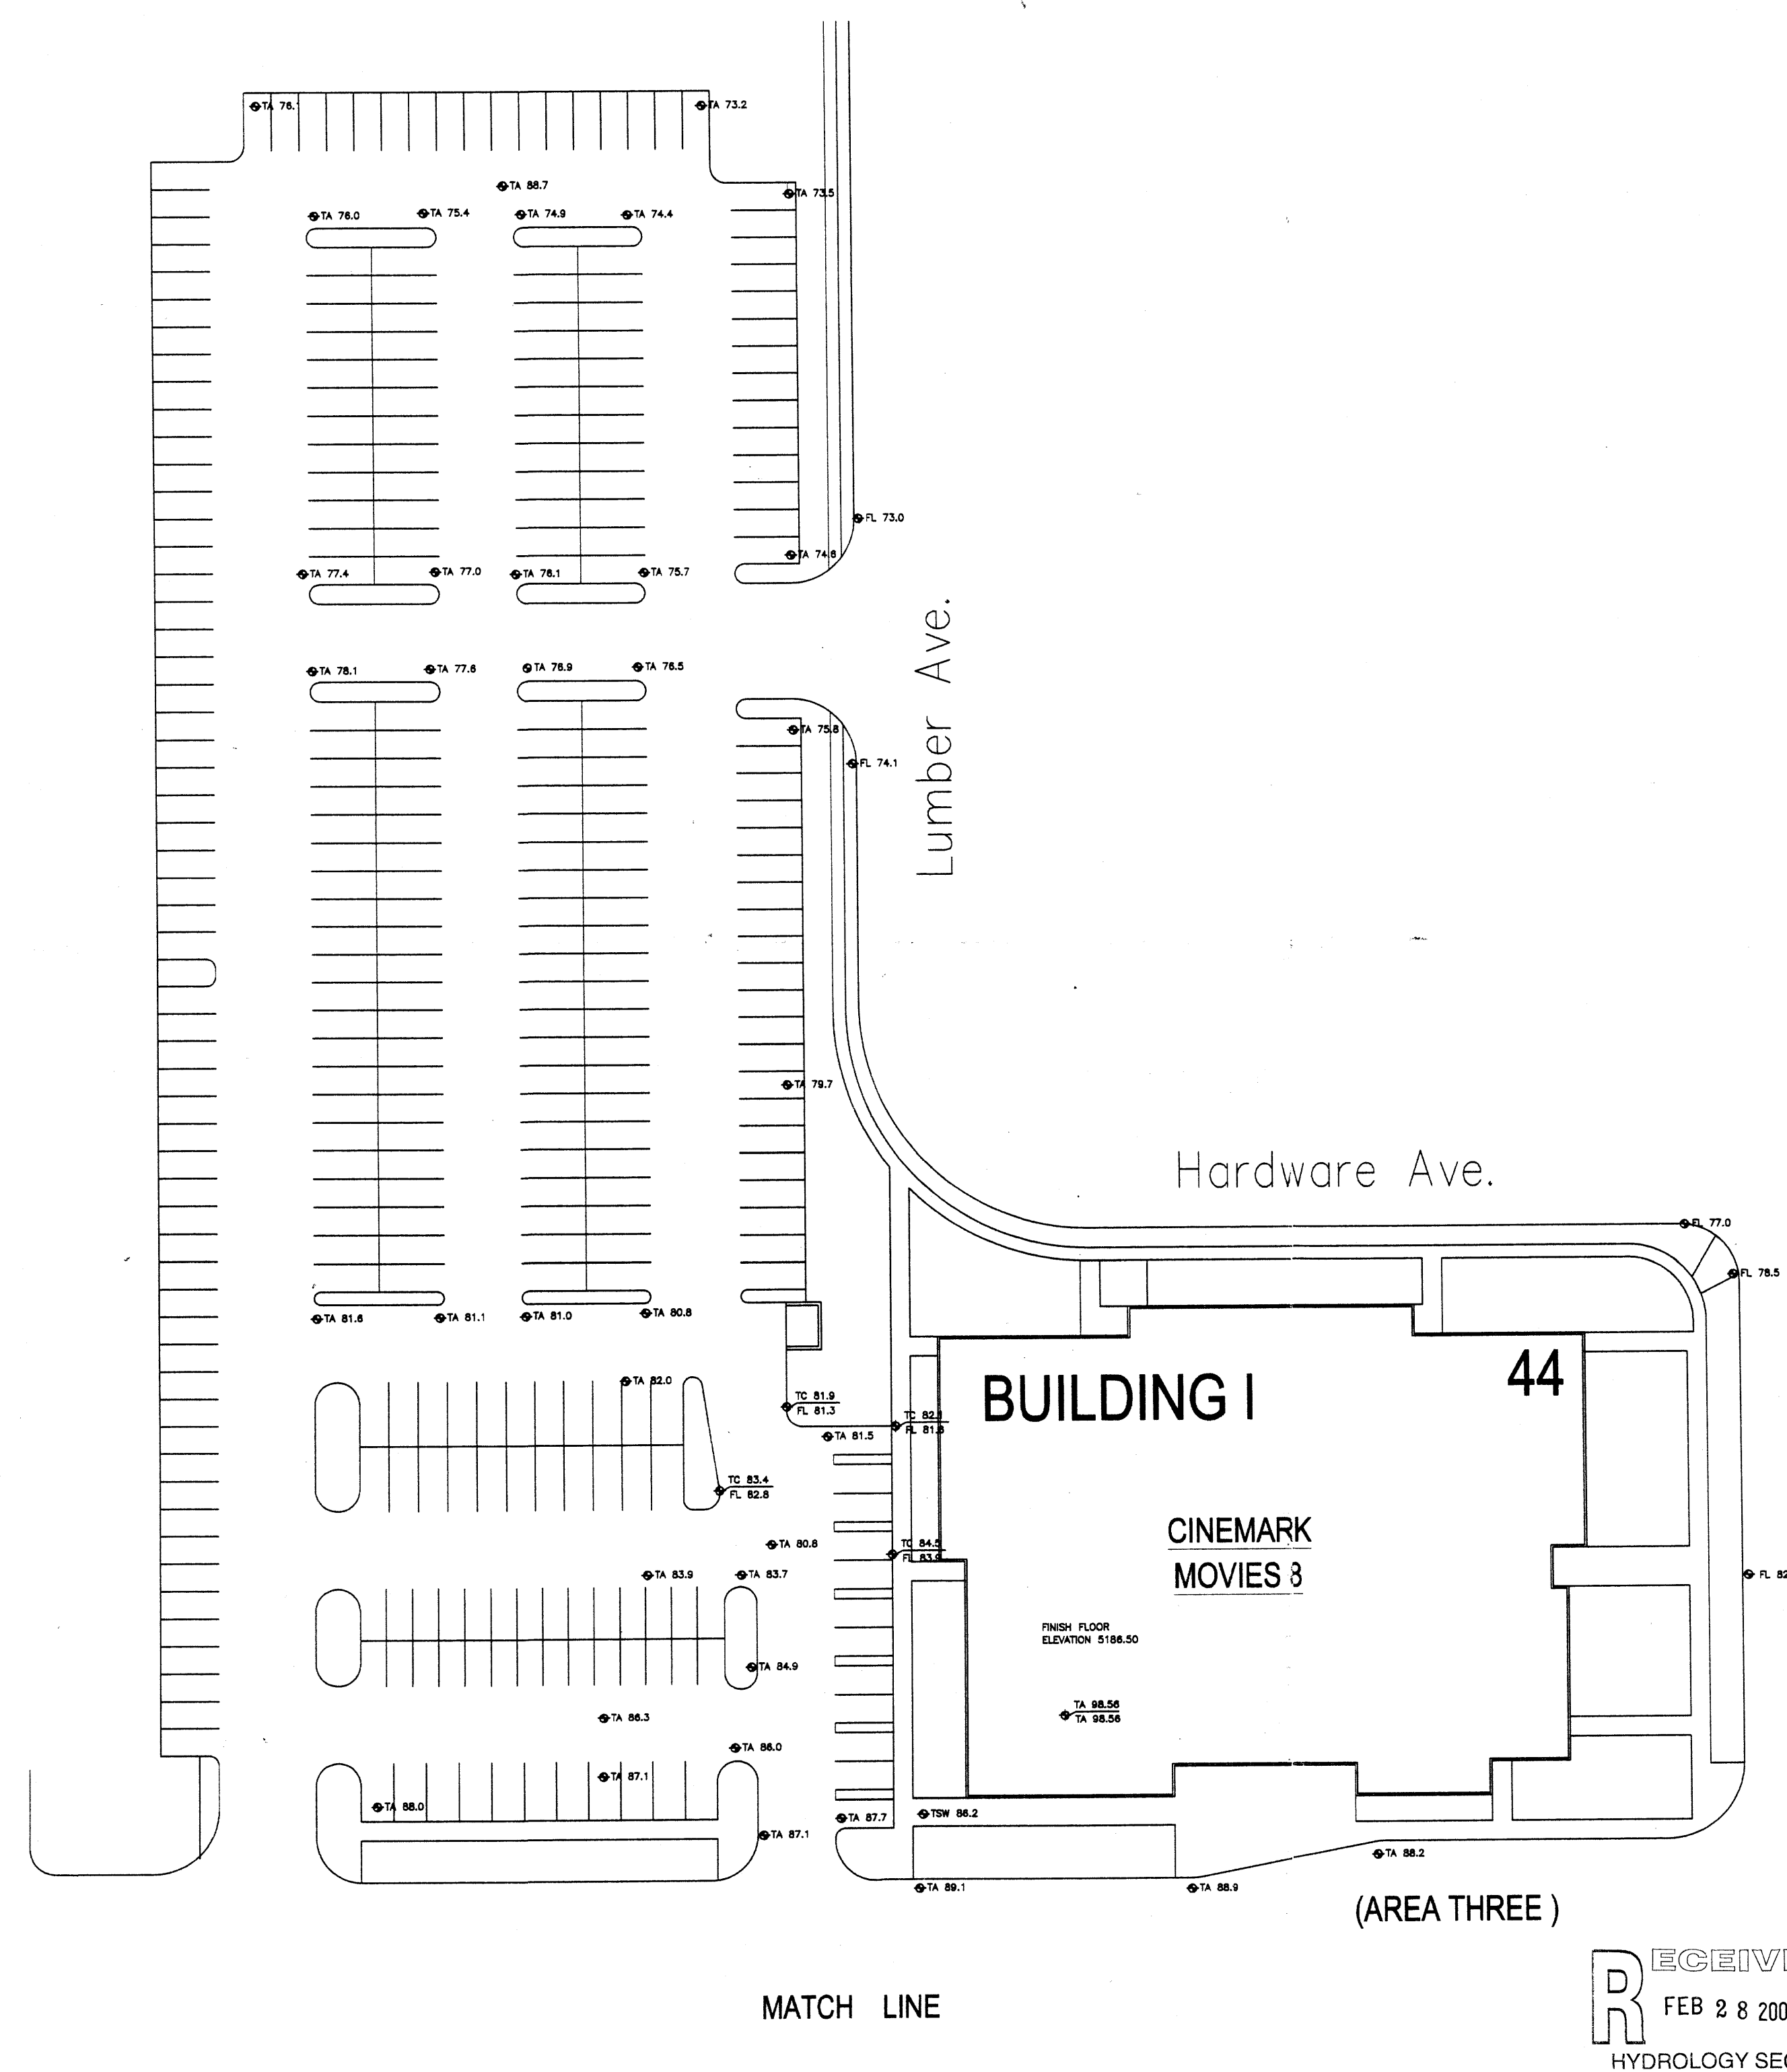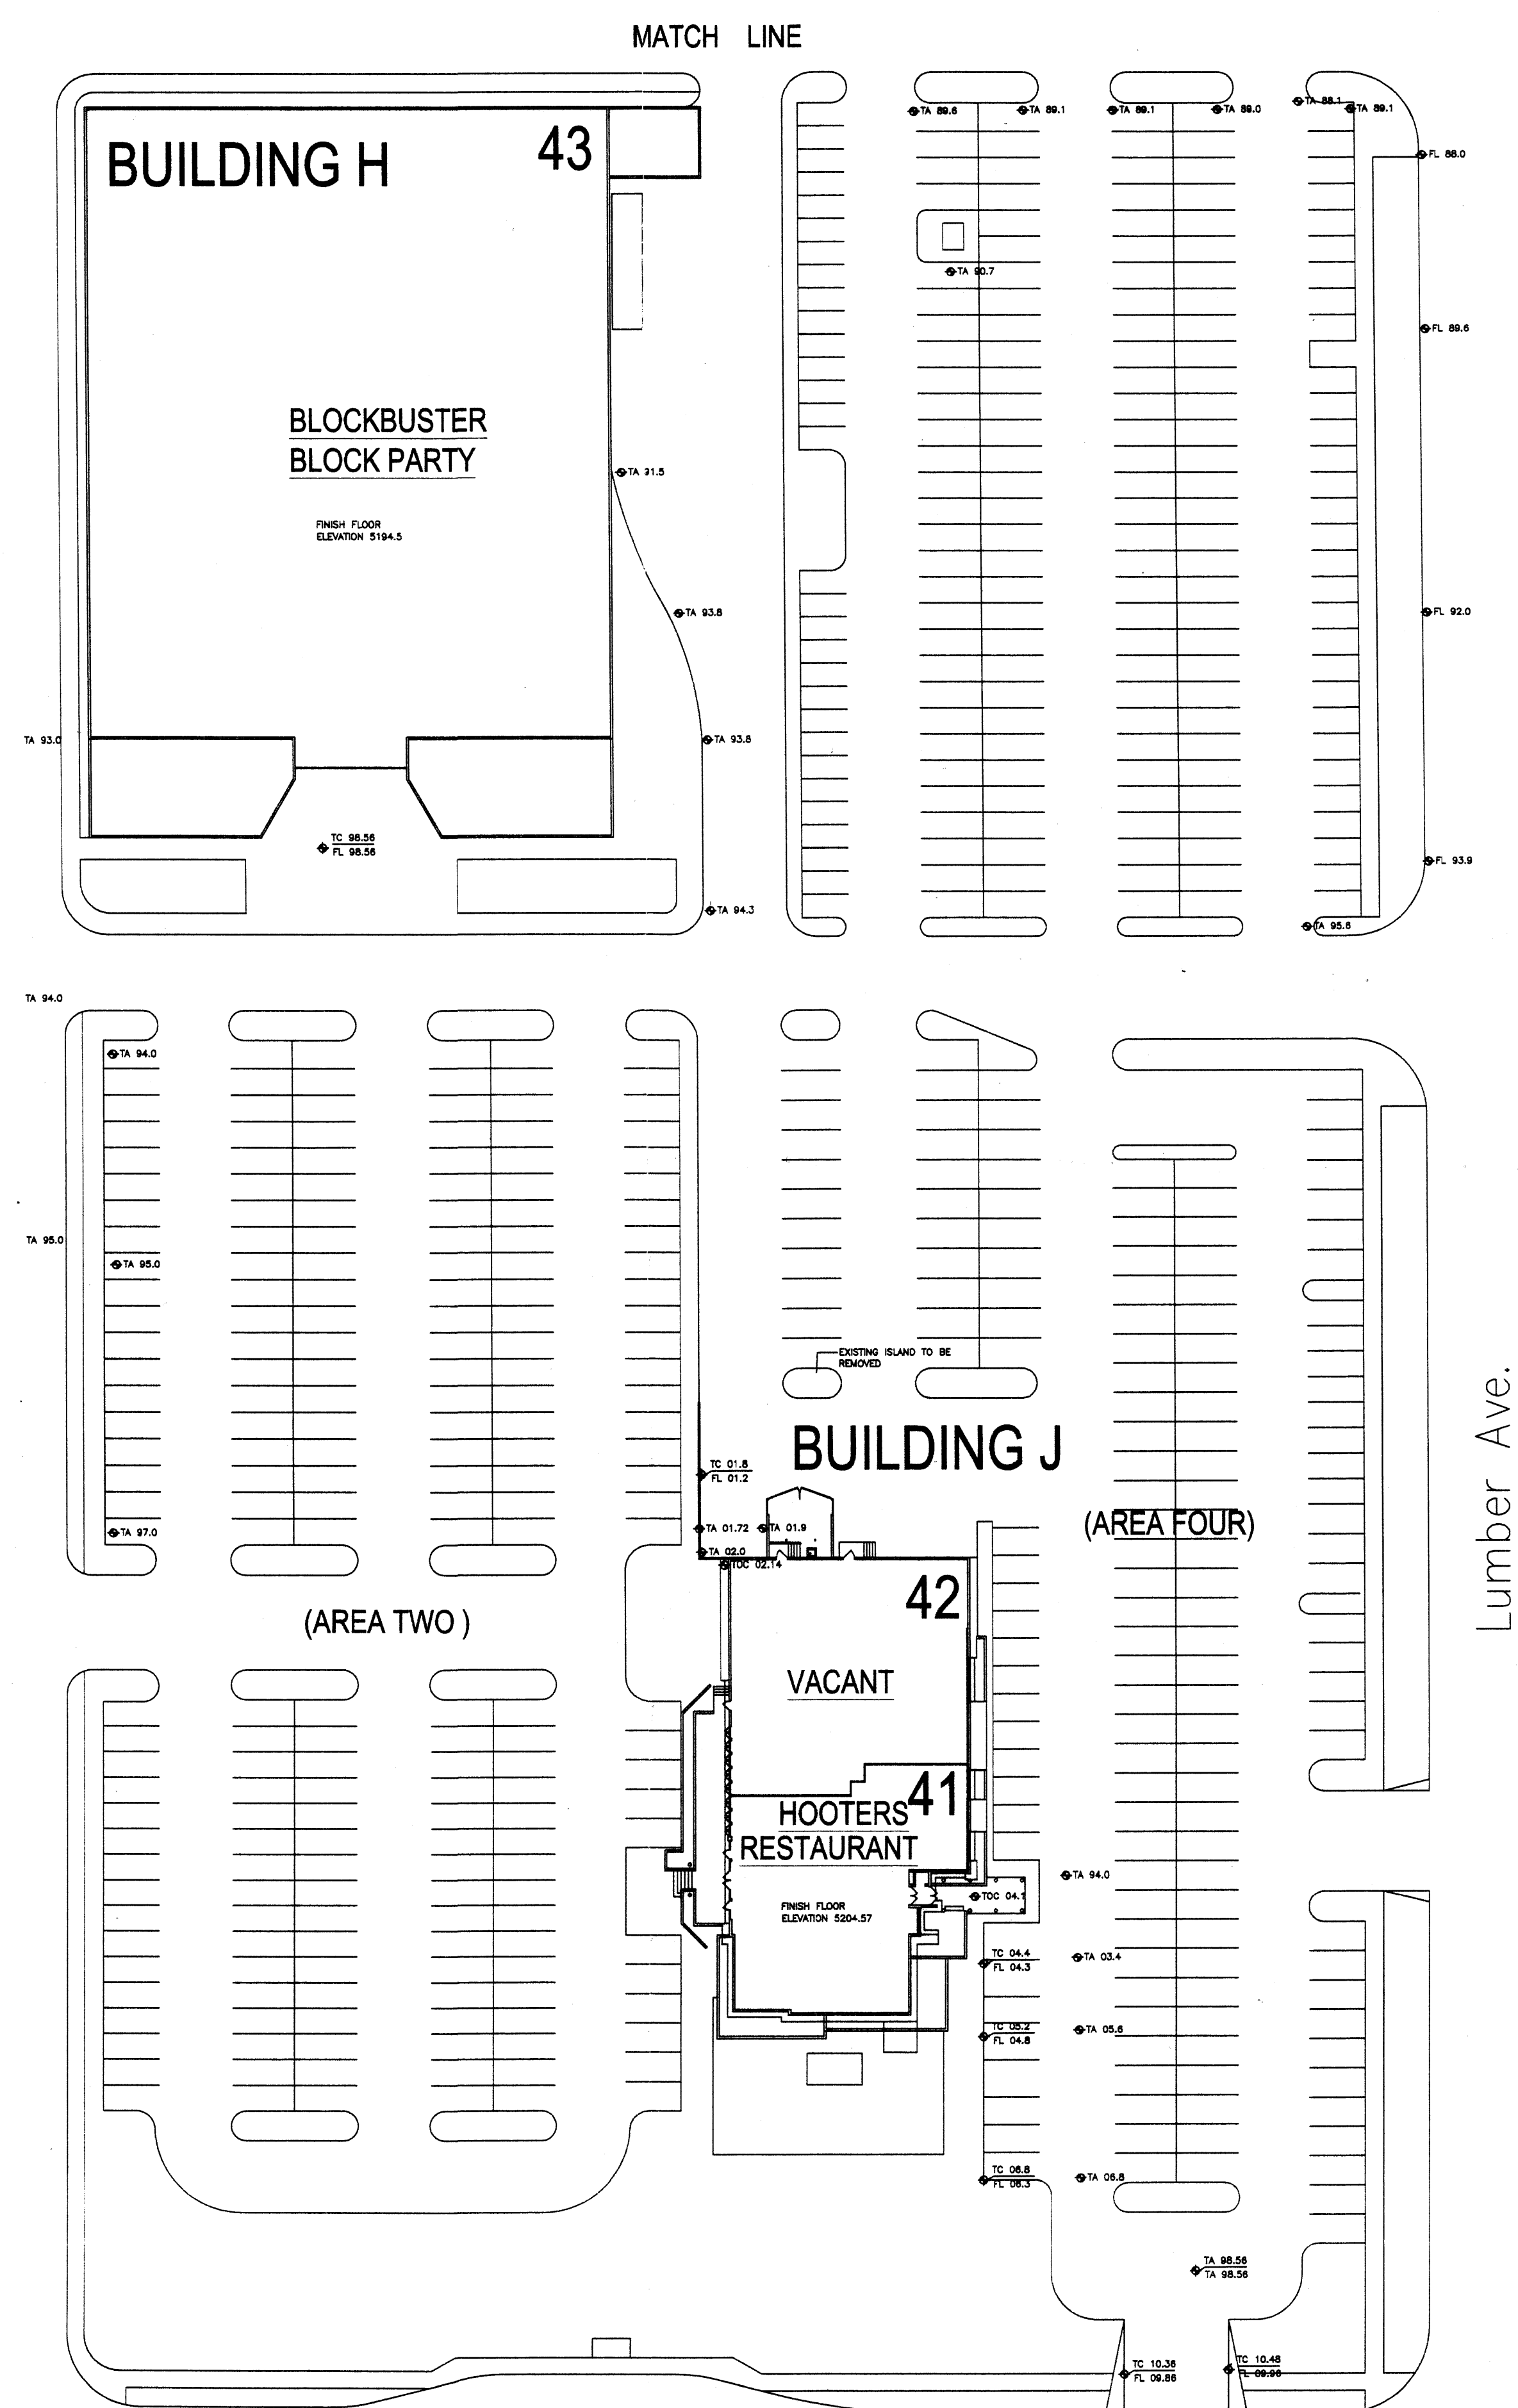


RECEIVED
FEB 28 2000
HYDROLOGY SECTION

GENERAL NOTES


- RADI CENTER POINTS TO BE LOCATED BY MEASURING PERPENDICULAR TO THE ADJACENT STRAIGHT CURB LINE.
- DIMENSIONS ARE TO FACE OF CURB.
- IF LAYOUT DIFFERS SIGNIFICANTLY FROM CIVIL DRAWINGS, NOTIFY ARCHITECT IMMEDIATELY.

KEYED NOTES


- EXISTING CONCRETE SIDEWALK TO REMAIN.
- EXISTING ASPHALT PAVING TO REMAIN.
- EXISTING CONCRETE CURB TO REMAIN.
- PROTECT EXISTING LANDSCAPE AREA TO REMAIN.
- NEW BLDG. EXPANSION, REFER TO A100.
- EXISTING LANDSCAPING TO BE REMOVED.
- NEW ASPHALT PAVING.
- EXISTING CONCRETE CURB TO REMOVED.
- REMOVE EXISTING ASPHALT.
- REMOVE EXISTING STAIRS AND ASSOCIATED RAILINGS.
- REMOVE EXISTING CONCRETE STOOP.
- EXISTING TRANSFORMER TO REMAIN.
- EXISTING CANOPY TO BE REMOVED.
- EXISTING DRAINAGE INLET TO REMAIN, TYP. OF 2.
- NEW H.C. STRIPING, REFER TO D6/A041.
- NEW H.C. SIGNAGE, REFER TO E6/A041.
- NEW CONCRETE BUMPER, TYP. OF 2.
- NEW LANDSCAPING, REFER TO L001.
- NEW BIKE RACK, REFER TO E4/A041.
- NEW H.C. SIDEWALK RAMP TO ASPHALT, MAX SLOPE 1:20.
- NEW H.C. ACCESSIBLE RAMP, REFER TO C4 OR B4/A041.
- NEW CONCRETE SIDEWALK, REFER TO E3/A041.
- EXISTING CONCRETE WALK TO BE REMOVED.
- NEW CONCRETE STOOP TO MATCH FIN. FLOOR.
- EXISTING OVERHEAD DOORS & ASSOCIATED DOCK EQUIP. TO BE REMOVED.
- EXISTING CHAINLINK FENCING TO BE REMOVED.
- EXISTING GREASE INTERCEPTOR & ASSOC. PIPING TO BE REMOVED.
- EXISTING PARKING LOT LIGHT TO REMAIN.
- NEW COMPACTOR ENCLOSURE AND GATES, REFER TO D2/A041.
- EXISTING STAIRS AND RAILINGS TO REMAIN.
- NEW CONCRETE JOINT, TYP. REFER TO E1/A041.
- COMPACTOR ENCLOSURE GATES, REFER TO D4/A041.
- NEW 6,000 GAL. GREASE INTERCEPTOR, REFER TO M001.
- EXISTING PARKING LOT LIGHTING TO BE REMOVED, TYP. OF 2.
- EXISTING H.C. SIGNAGE TO BE REMOVED.
- RE-STRIP PAVEMENT.
- EXISTING HANDICAP RAMP TO REMAIN.
- 30 CU. YD. COMPACTOR BY OTHERS, N.C.
- BALLER BY OTHERS, N.C.
- NEW H.C. ACCESSIBLE RAMP, REFER TO C1/A001.
- NEW CONCRETE CURB, REFER TO E1/A041.
- NEW STAIRS AND RAILINGS, REFER TO A1/A041.
- RELOCATED LIGHT POLE, TYP. OF 2.
- DASHED LINE DELINEATES APPROX. ELECTRICAL TRENCH REQUIRED FOR RELOCATED PARKING LOT LIGHTING, PATCH AND REPAIR ASPHALT AS NECESSARY, TYP. OF 2 LOCATIONS.
- NEW 3" WIDE CONCRETE VALLEY, REFER TO C101.
- CONCRETE RAMP, LANDINGS AND 1 1/2" STEEL PIPE HANDRAIL.
- EXISTING CONCRETE RED PAINT FOR FIRE LANE.
- PAINT CURB GREEN W/ WHITE LETTERING FOR "LOADING ONLY" IN THE DROP-OFF INLET.
- NEW 6" CURB PAINTED RED FOR FIRE LANE.

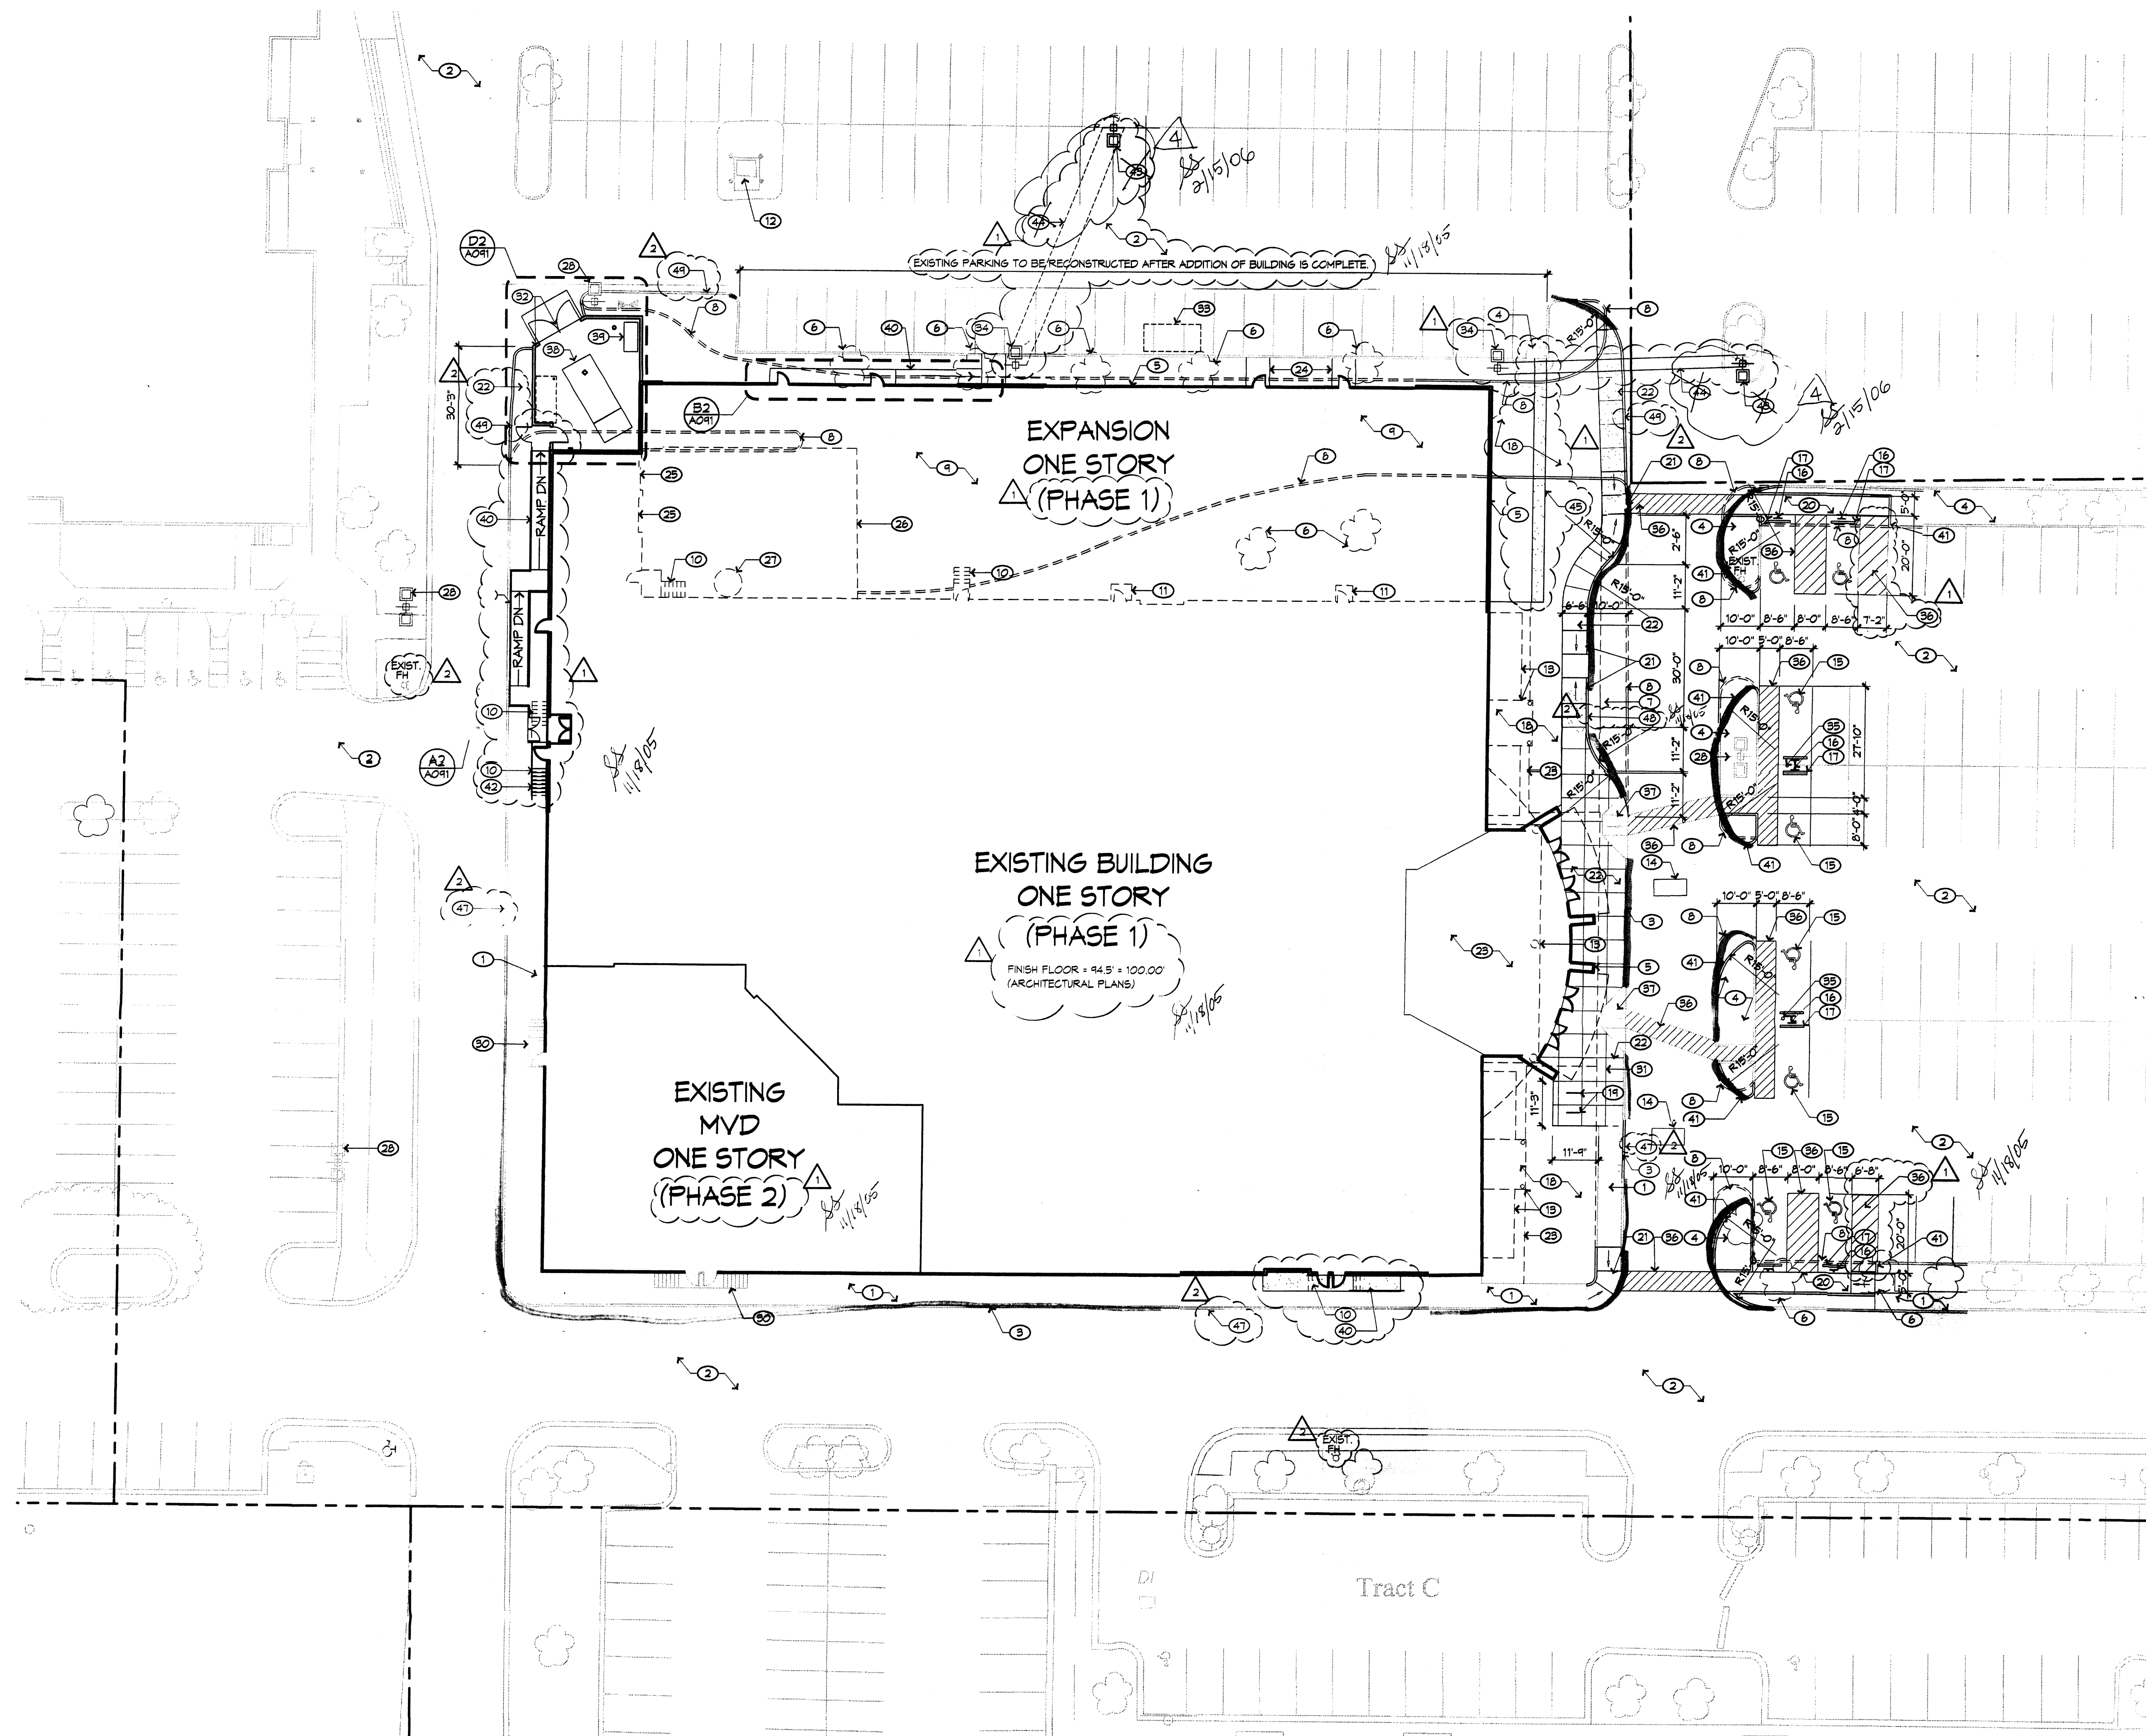

SITE PLAN
1"=20'-0"

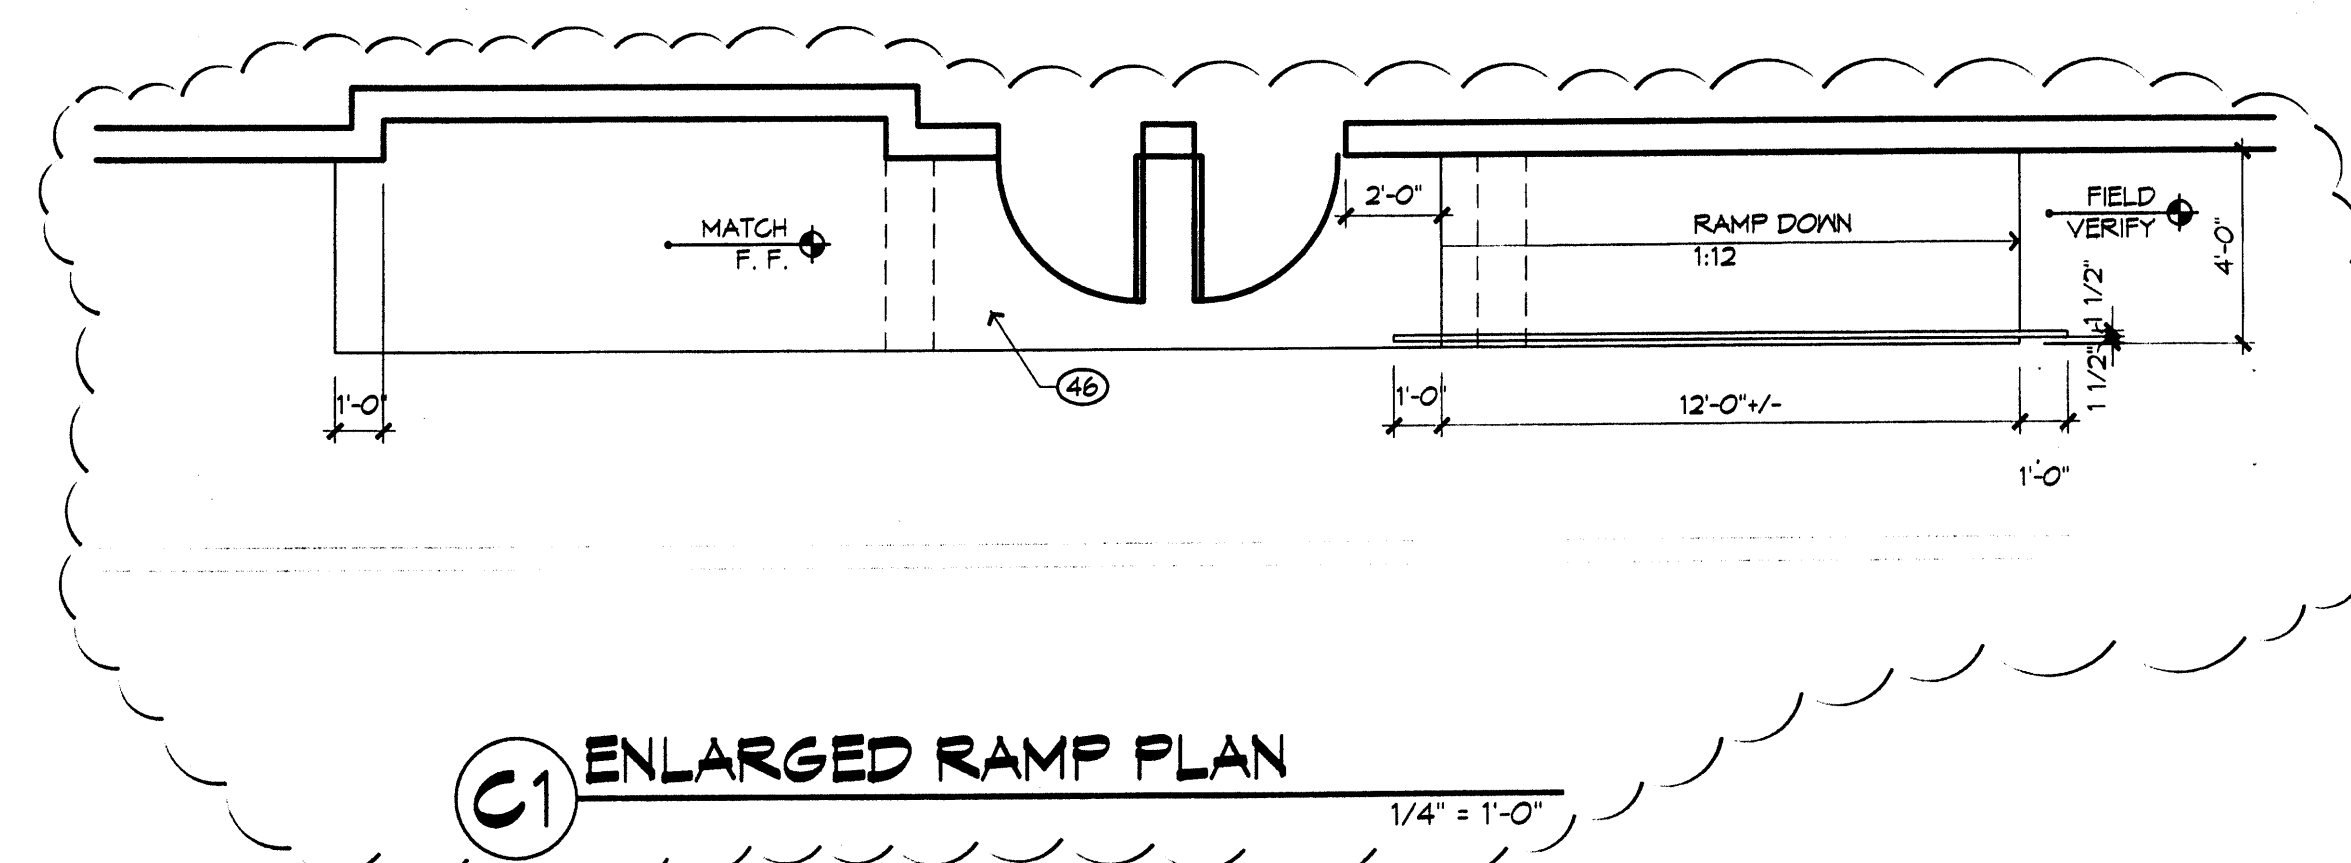

C1 ENLARGED RAMP PLAN
1/4"=1'-0"

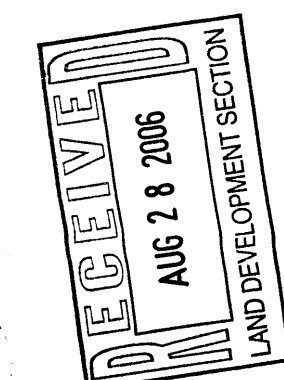

ALBUQUERQUE
BLDG & SAFETY
OCT 13 2009
U.S.C.
PLAN CHECK
SECTION

- REVISIONS**
- 10/31/05 GENERAL REVISIONS
 - 11/14/05 PERMIT COMMENTS
 - 2/15/06 OWNER REVISIONS

DRAWN BY: SAB
REVIEWED BY: AMD
DATE: 10/08/05
PROJECT NO.: 05103
DRAWING NAME: SITE PLAN

**Dekker
Perich
Sabatini**

6801 Jefferson NE
Suite 100
Albuquerque, NM 87109
505 761-9700
fax 761-4222
dps@dpsabq.com

ARCHITECT

ENGINEER

PROJECT

Montgomery Plaza Bldg. J
Max & Vito's Pizzeria

Albuquerque, New Mexico

KEYED NOTES

- 1 TO BE REMOVED
- 2 EXISTING SIDEWALK, CONCRETE
- 3 EXISTING PAVING, ASPHALT
- 4 EXISTING CURB, 6" HIGH, CONCRETE
- 5 EXISTING LANDSCAPE AREA, RE. L001
- 6 NEW EXPANSION
- 7 NEW CONCRETE CURB AND SIDEWALK
- 8 NEW LANDSCAPE AREA
- 9 NEW DROP OFF AREA
- 10 NEW ASPHALT
- 11 NEW CONCRETE RAMP, 30" MAX RISE BETWEEN LEVEL LANDINGS
- 12 NEW CONCRETE STAIRS
- 13 NEW SERVICE COURT W/ BLOCK WALL, ENCLOSURE & METAL GATES FOR ACCESS.
- 14 EXISTING BUS STOP
- 15 NEW ADA ACCESSIBLE RAMP PER DPM STANDARDS
- 16 NEW ADA ACCESSIBLE VAN PARKING SPACE, 20'X8.5' WITH 8' WIDE ACCESS AISLE
- 17 NEW ADA ACCESSIBLE PARKING SPACE, 20'X8.5' WITH 5' WIDE ACCESS AISLE
- 18 5' WIDE PAINTED ACCESS AISLE ACROSS DRIVEWAY, TYPICAL
- 19 PRECAST CONCRETE PARKING STOP

ADMINISTRATIVE AMENDMENT

File # 05-01304 Project # 1000736
Bldg. expansion and related improvements
APPROVED BY Bob Paul DATE 9/10/05

RECEIVED
AUG 28 2005
LAND DEVELOPMENT SECTION



REVISIONS
2/24/2005 Traffic Comments

DRAWN BY AR/SAG
REVIEWED BY CG
DATE 08/15/05
PROJECT NO.
DRAWING NAME

**SITE PLAN
ADMINISTRATIVE
AMENDMENT**

SHEET NO.

A1
OF

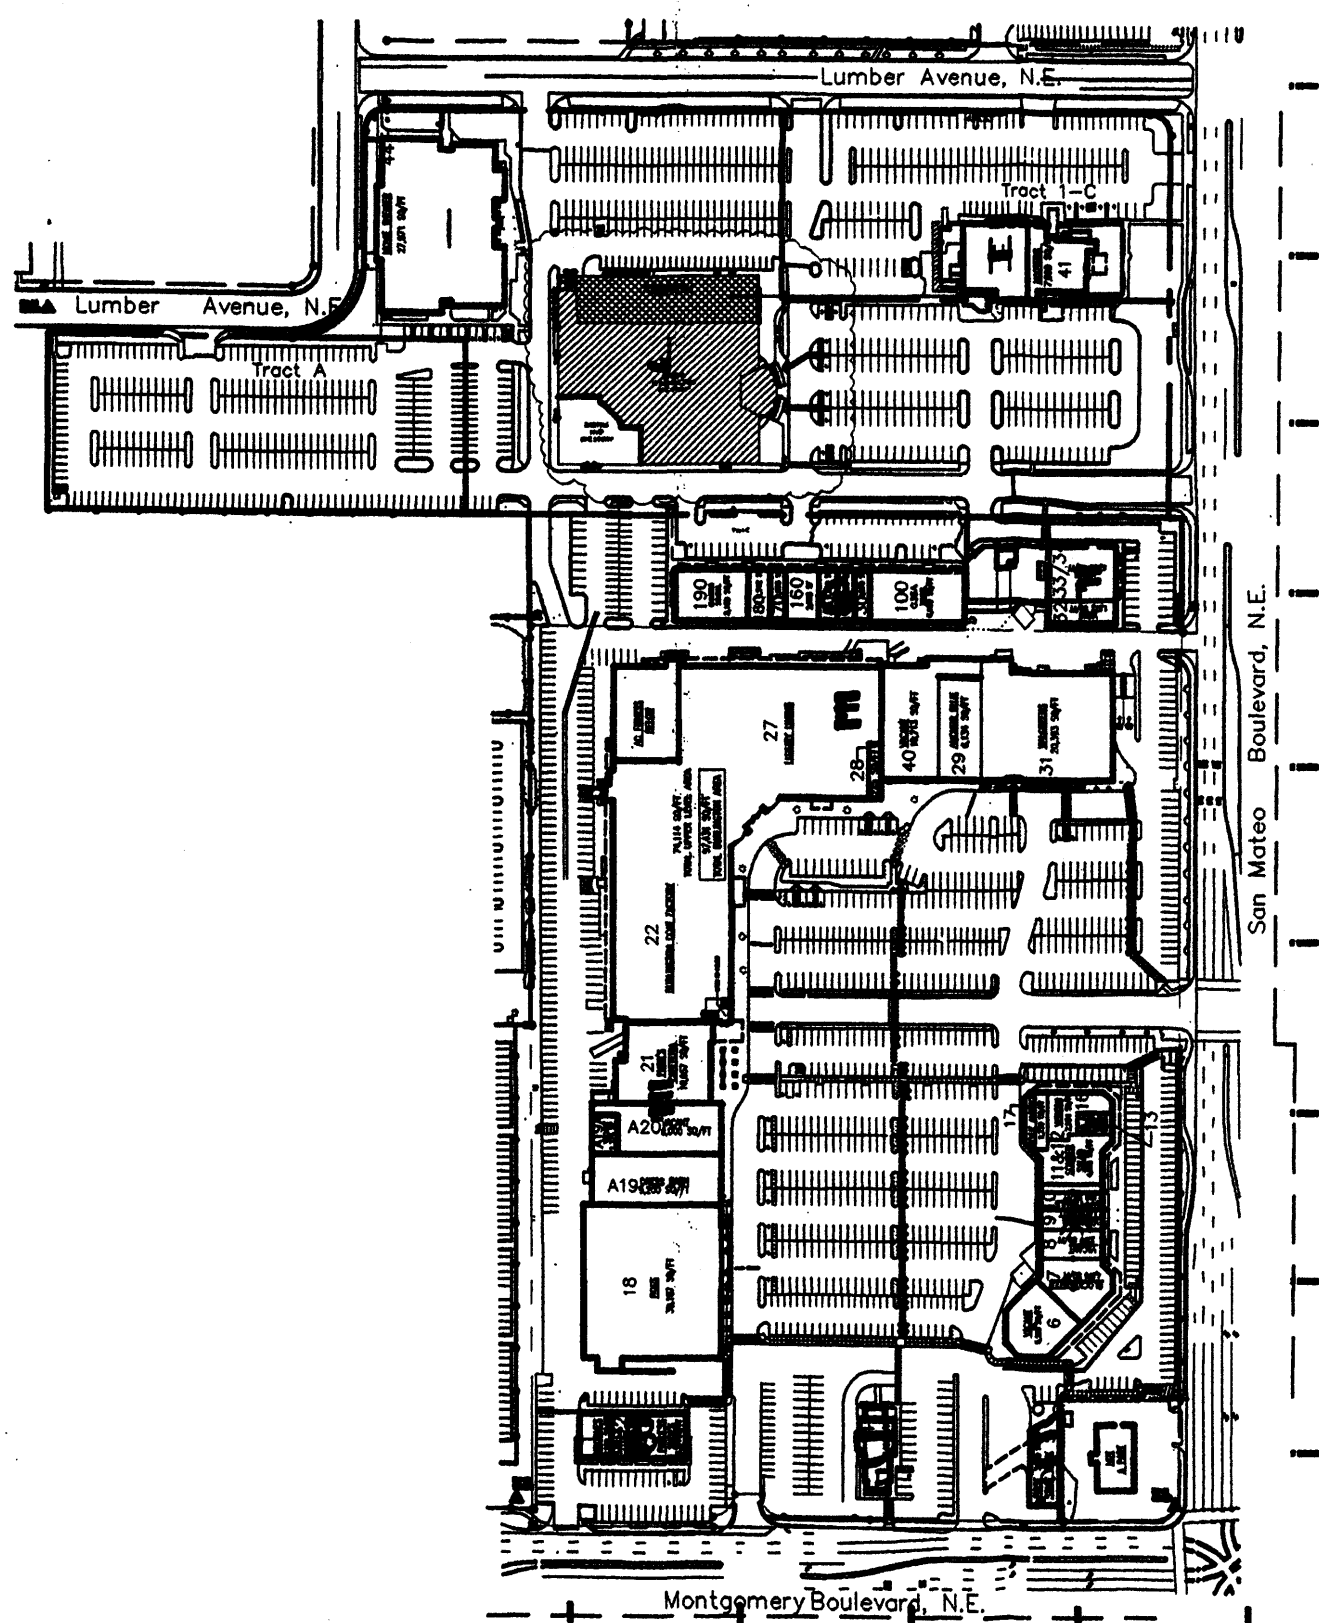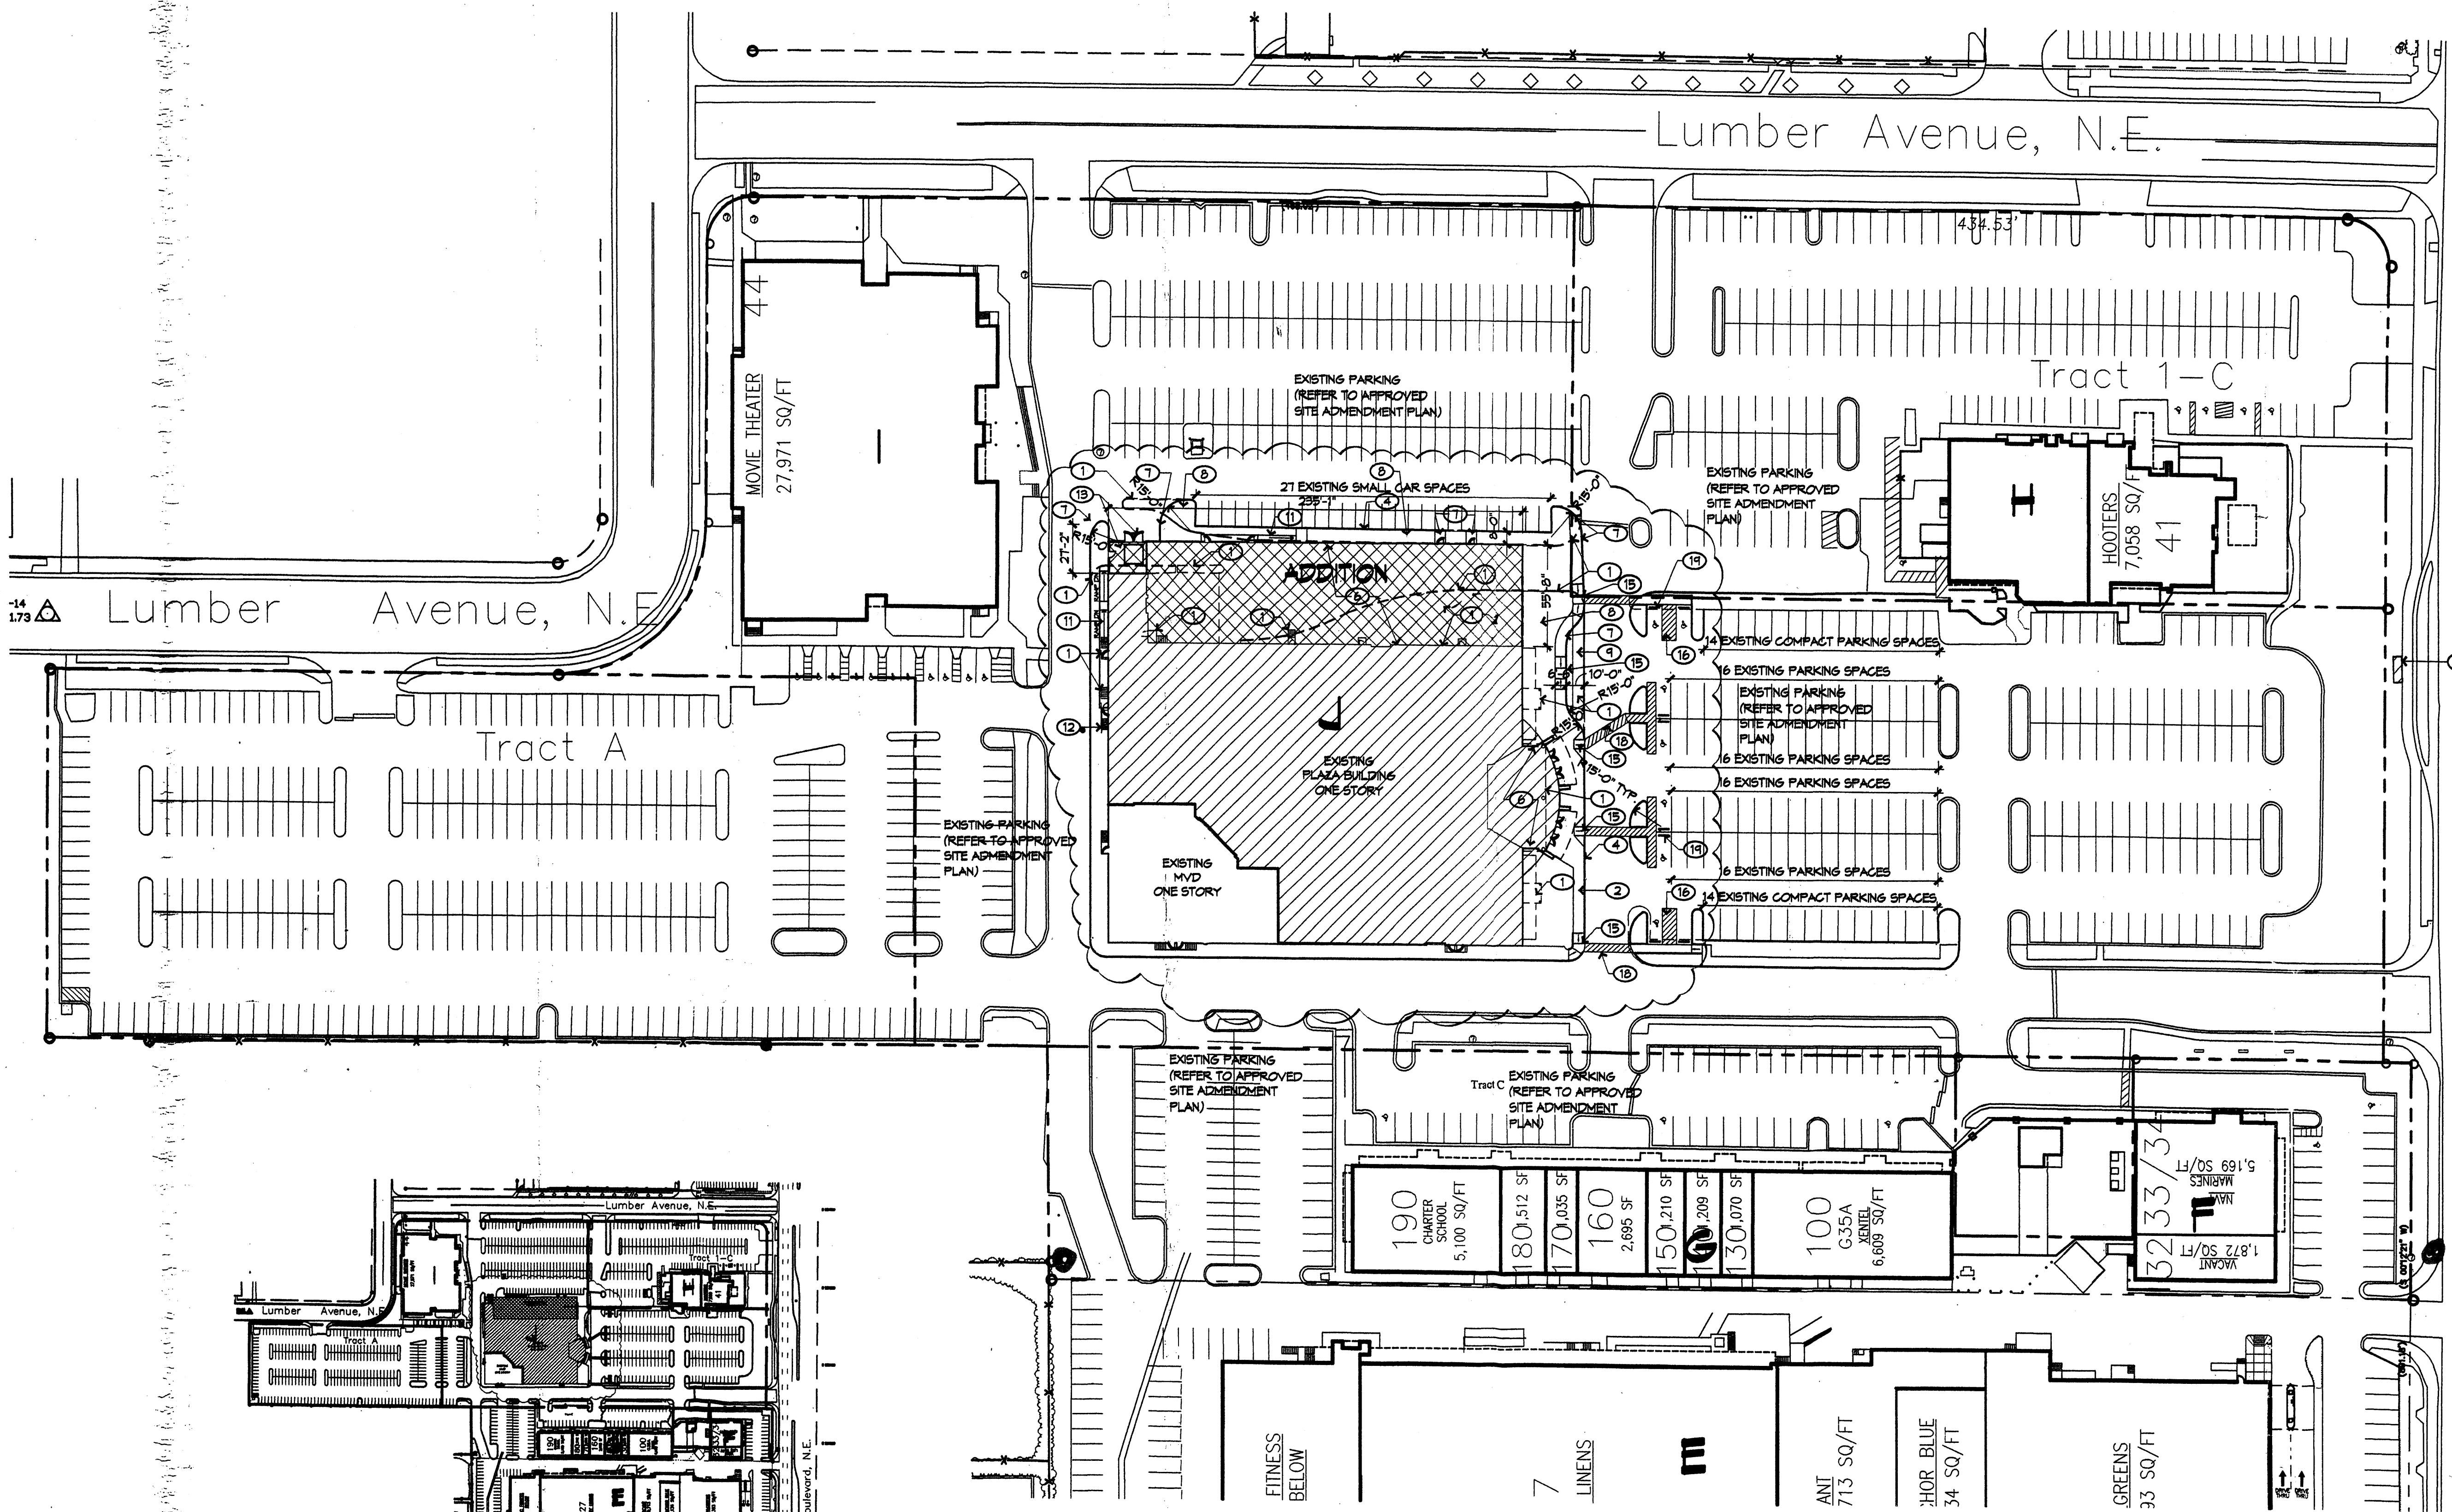

OVERALL SITE PLAN


EXISTING SITE DATA

SPACE PHASE I	BUILDING AREA	SEATS	PARKING RATIO	PARKING REQUIRED	15% TRANSIT REDUCTION	NET PARKING REQUIRED	PARKING PROVIDED
A SHOPS	27,022		1/200 SF	135			
B COMMERCIAL	6,722		1/200 SF	34			
C BANK	3,627		1/200 SF	18			
D RESTAURANT	2,914	85	1/4 SEATS	21			
E RETAIL	191,200		1/200 SF	956			
PHASE II							
F COMMERCIAL	7,291		1/200 SF	36			
G SHOPS	20,440		1/200 SF	102			
H RESTAURANT	10,800	329	1/4 SEATS	81			
I THEATER	28,013	1,925	1/4 SEATS	481			
J OFFICE	94,200		1/200 SF	471			
J ENTERTAINMENT		658	1/4 SEATS	165			
TOTAL	397,900 SF	2,338		2,060	304	1,751	2,060

PROPOSED SITE DATA FOR THIS ADJUDICATION

SPACE PHASE I	BUILDING AREA	SEATS	PARKING RATIO	PARKING REQUIRED	15% TRANSIT REDUCTION	NET PARKING REQUIRED	PARKING PROVIDED
A SHOPS	27,022		1/200 SF	135			
B COMMERCIAL	6,722		1/200 SF	34			
C BANK	3,627		1/200 SF	18			
D RESTAURANT	2,914	85	1/4 SEATS	21			
E RETAIL	191,200		1/200 SF	956			
PHASE II							
F COMMERCIAL	7,291		1/200 SF	36			
G SHOPS	20,440		1/200 SF	102			
H RESTAURANT	10,800	329	1/4 SEATS	81			
I THEATER	28,013	1,925	1/4 SEATS	481			
J OFFICE	94,200		1/200 SF	471			
J ENTERTAINMENT		658	1/4 SEATS	165			
TOTAL	349,300 SF	2,338		2,106	316	1,790	2,060

ALBUQUERQUE
BLDG & SAFETY
OCT 18 2005
U.B.C.
PLAN CHECK
SECTION

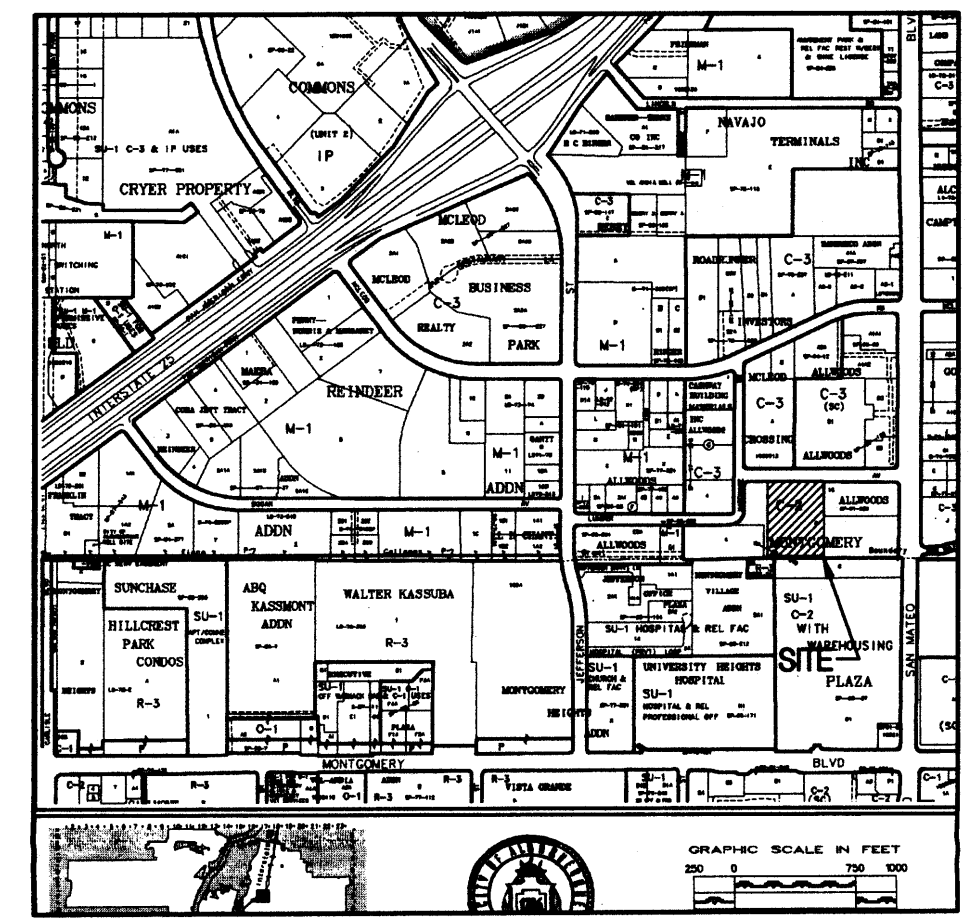

LEGAL DESC: TRACT C-1 MONTGOMERY PLAZA

GRADING NOTES

- EXCEPT AS PROVIDED HEREIN, GRADING SHALL BE PERFORMED AT THE ELEVATIONS AND IN ACCORDANCE WITH THE DETAILS SHOWN ON THIS PLAN.
- THE COST FOR REQUIRED CONSTRUCTION DUST AND EROSION CONTROL MEASURES SHALL BE INCIDENTAL TO THE PROJECT COST.
- ALL WORK RELATIVE TO FOUNDATION CONSTRUCTION, SITE PREPARATION, AND PAVEMENT INSTALLATION, AS SHOWN ON THIS PLAN, SHALL BE CONSTRUCTED IN ACCORDANCE WITH THE "GEOTECHNICAL INVESTIGATION," AS PROVIDED BY THE ARCHITECT OR OWNER. ALL OTHER WORK SHALL, UNLESS OTHERWISE STATED OR PROVIDED FOR HEREON, BE CONSTRUCTED IN ACCORDANCE WITH THE PROJECT, (FIRST PRIORITY) SPECIFICATIONS, AND/OR THE CITY OF ALBUQUERQUE (COA) STANDARD SPECIFICATIONS FOR PUBLIC WORKS (SECOND PRIORITY).
- EARTH SLOPES SHALL NOT EXCEED 3 HORIZONTAL TO 1 VERTICAL UNLESS SHOWN OTHERWISE.
- IT IS THE INTENT OF THESE PLANS THAT THIS CONTRACTOR SHALL NOT PERFORM ANY WORK OUTSIDE OF THE PROPERTY BOUNDARIES EXCEPT AS REQUIRED BY THIS PLAN.
- THE CONTRACTOR IS TO ENSURE THAT NO SOIL ERODES FROM THE SITE ONTO ADJACENT PROPERTY OR PUBLIC RIGHT-OF-WAY. THIS SHOULD BE ACHIEVED BY CONSTRUCTING TEMPORARY BARRIERS OR SILT FENCE AT THE PROPERTY LINES AND MENDING THE SOIL TO PROTECT IT FROM WIND EROSION.
- A DISPOSAL SITE FOR ANY & ALL EXCESS EXCAVATION MATERIAL, AND UNSUITABLE MATERIAL AND/OR A BORROW SITE CONTAINING ACCEPTABLE FILL MATERIAL SHALL BE OBTAINED BY THE CONTRACTOR IN COMPLIANCE WITH APPLICABLE ENVIRONMENTAL REGULATIONS AND APPROVED BY THE OBSERVER. ALL COSTS INCURRED IN OBTAINING A DISPOSAL OR BORROW SITE AND HAUL TO OR FROM SHALL BE CONSIDERED INCIDENTAL TO THE PROJECT AND NO SEPARATE MEASUREMENT OR PAYMENT SHALL BE MADE.
- PAVING AND ROADWAY GRADES SHALL BE +/- 0.1' FROM PLAN ELEVATIONS. PAD ELEVATION SHALL BE +/- 0.05' FROM BUILDING PLAN ELEVATION.
- ALL PROPOSED CONTOURS REFLECT TOP OF PAVEMENT ELEVATIONS IN THE PARKING AREA AND MUST BE ADJUSTED FOR MEDIAN AND ISLANDS.
- VERIFY ALL ELEVATIONS SHOWN ON PLAN FROM BASIS OF ELEVATION CONTROL STATION PRIOR TO BEGINNING CONSTRUCTION.

DRAINAGE MANAGEMENT PLAN

I. INTRODUCTION

The purpose of this submittal is to provide a Drainage Management Plan for a proposed commercial development which involves the expansion of an existing building located on Tract C-1 of the Montgomery Plaza Site. The +/-7.55 acre site is located at the southwest corner of San Mateo and Lumber Avenue in Northeast Albuquerque.

II. EXISTING HYDROLOGIC CONDITIONS

The fully developed site has a current approved Drainage Management Plan located in the City of Albuquerque Hydrology file number F17-D002D. The site generally drains from east to west from San Mateo to Lumber Avenue.

III. PROPOSED HYDROLOGIC CONDITIONS

Since the existing site is fully developed in its current state, the increase in the impervious area is minimal. We do not anticipate any negative impacts to the downstream drainage system west of the site.

IV. CONCLUSION

This submittal is made as an amendment to the original approved drainage management plan filed in City Hydrology file number F17-D002D. There will be a minimal increase to the impervious area of the site and there will be no negative impacts to the drainage of the site associated with this building expansion. With this submittal we are requesting approval of the final grading and drainage plan for Building Permit approval.

GENERAL NOTES

- ALL WORK DETAIL ON THESE PLANS AND PERFORMED UNDER THIS CONTRACT SHALL BE CONSTRUCTED IN ACCORDANCE WITH THE PROJECT SPECIFICATIONS AND THE PROJECT GEOTECHNICAL REPORT WHERE APPLICABLE, CITY OF ALBUQUERQUE PUBLIC WORKS STANDARDS SHALL APPLY.
- THE CONTRACTOR SHALL ABIDE BY ALL LOCAL, STATE, AND FEDERAL LAWS, RULES AND REGULATIONS WHICH APPLY TO THE CONSTRUCTION OF THESE IMPROVEMENTS, INCLUDING EPA REQUIREMENTS WITH RESPECT TO STORM WATER DISCHARGE.
- PRIOR TO CONSTRUCTION, THE CONTRACTOR SHALL FIELD VERIFY THE HORIZONTAL AND VERTICAL LOCATIONS OF ALL POTENTIAL OBSTRUCTIONS INCLUDING ALL UNDERGROUND UTILITIES. SHOULD A CONFLICT EXIST, THE CONTRACTOR SHALL NOTIFY THE CONSTRUCTION OBSERVER OR ENGINEER SO THAT THE CONFLICT CAN BE RESOLVED WITH A MINIMUM AMOUNT OF DELAY.
- TWO (2) WORKING DAYS PRIOR TO ANY EXCAVATION, THE CONTRACTOR SHALL CONTACT LINE LOCATING SERVICE FOR LOCATION OF EXISTING UTILITIES.
- ALL ELECTRICAL, TELEPHONE, CABLE TV, GAS AND OTHER UTILITY LINES, CABLES, AND APPURTENANCES ENCOUNTERED DURING CONSTRUCTION THAT REQUIRE RELOCATION, SHALL BE COORDINATED WITH THAT UTILITY. THE CONTRACTOR SHALL BE RESPONSIBLE FOR COORDINATION OF ALL NECESSARY UTILITY ADJUSTMENTS. NO ADDITIONAL COMPENSATION WILL BE ALLOWED FOR DELAYS OR INCONVENIENCES CAUSED BY UTILITY COMPANY WORK CREWS. THE CONTRACTOR MAY BE REQUIRED TO RESCHEDULE HIS ACTIVITIES TO ALLOW UTILITY CREWS TO PERFORM THEIR REQUIRED WORK.
- THE CONTRACTOR IS RESPONSIBLE FOR PROTECTING ALL EXISTING UTILITY LINES WITHIN THE CONSTRUCTION AREA. ANY DAMAGE TO EXISTING FACILITIES CAUSED BY CONSTRUCTION ACTIVITY SHALL BE REPAIRED OR REPLACED AT THE CONTRACTOR'S EXPENSE AND APPROVED BY THE CONSTRUCTION OBSERVER.
- CONSTRUCTION ACTIVITY SHALL BE LIMITED TO THE PROPERTY AND/OR PROJECT LIMITS. ANY DAMAGE TO ADJACENT PROPERTIES CAUSED BY THE CONSTRUCTION PROCESS SHALL BE REPAIRED OR REPLACED AT THE CONTRACTOR'S EXPENSE.
- OVERNIGHT PARKING OF CONSTRUCTION EQUIPMENT SHALL NOT OBSTRUCT DRIVEWAYS OR DESIGNATED TRAFFIC LINES. THE CONTRACTOR SHALL NOT STORE ANY EQUIPMENT OR MATERIAL WITHIN THE PUBLIC RIGHT-OF-WAY.
- THE CONTRACTOR SHALL OBTAIN ALL THE NECESSARY PERMITS FOR THE PROJECT PRIOR TO COMMENCING CONSTRUCTION (I.E. BARRICADE, TOPSOIL DISTURBANCE, EXCAVATION PERMITS, EPA STORM WATER PERMITS, ETC.).
- ALL PROPERTY CORNERS DESTROYED DURING CONSTRUCTION SHALL BE REPLACED AT THE CONTRACTOR'S EXPENSE. ALL PROPERTY CORNERS MUST BE RESET BY A REGISTERED LAND SURVEYOR.
- THE CONTRACTOR SHALL PREPARE A CONSTRUCTION TRAFFIC CONTROL AND SCHEDULING PLAN AND OBTAIN APPROVAL OF SUCH PLAN FROM THE CITY OF ALBUQUERQUE, TRAFFIC ENGINEERING DEPARTMENT, PRIOR TO BEGINNING ANY CONSTRUCTION WORK ON OR ADJACENT TO EXISTING STREETS.
- ALL BARRICADES AND CONSTRUCTION SCHEDULING SHALL CONFORM TO APPLICABLE SECTIONS OF THE "MANUAL ON UNIFORM TRAFFIC CONTROL DEVICES" (MUTCD), US DEPARTMENT OF TRANSPORTATION, LATEST EDITION.
- THE CONTRACTOR SHALL MAINTAIN ALL CONSTRUCTION BARRICADES AND SCHEDULING AT ALL TIMES. THE CONTRACTOR SHALL VERIFY THE PROPER LOCATION OF ALL BARRICADE AT THE END AND BEGINNING OF EACH DAY.
- THE CONTRACTOR SHALL TAKE ALL STEPS NECESSARY TO CONFORM WITH EPA REQUIREMENTS, INCLUDING COMPLIANCE WITH NPDES PHASE 2 REQUIREMENTS.

KEYED NOTES

- EXISTING CURB & GUTTER TO REMAIN.
- EXISTING CURB & GUTTER TO BE REMOVED. SEE DEMOLITION PLAN.
- EXISTING TRUCK DOCK AREA TO BE REMOVED. SEE DEMOLITION PLAN.
- EXISTING LANDING & STEPS TO REMAIN.
- NEW RAMP AT 12:1 MAX SLOPE. SEE ARCH FOR DETAILS.
- NEW SIDEWALK TO MATCH EXISTING TO GRADE.
- MATCH NEW CURB & GUTTER TO EXISTING.
- NEW GREASE TRAP. SEE PLUMBING PLANS.
- NEW SIDEWALK SET AT 0.04' BELOW FF ON BLDG SIDE AND SLOPE AT 2% AWAY FROM BUILDING.
- NEW 3" WIDE CONCRETE VALLEY GUTTER PER COA STD DWG 2421. ENSURE POSITIVE DRAINAGE AWAY FROM BUILDING.
- NEW RETAINING WALL. SEE ARCH/STRUCT FOR DETAILS.

BENCH MARK DATA: (ACS AND PROJECT)

THE STATION MARK IS A 3 1/4" ALUMINUM CAP SET FLUSH IN THE CURB STAMPED "9-F18" LOCATED ON THE SOUTHEAST CORNER OF SAN MATEO BOULEVARD AND SAN MATEO LANE N.E.

ELEVATION IN FEET = 5209.56 (1929)

LEGEND

- SAW CUT LINE, MATCH EXISTING PAVEMENT
- ⊙ EXIST CLEAN OUT
- ⊙ EXIST DROP INLET
- ⊙ EXIST FIRE HYDRANT
- ⊙ EXIST GAS METER
- ⊙ EXIST STORM DRAIN MH
- ⊙ EXIST WATER MH
- ⊙ EXIST WATER VALVE

DRAINAGE CERTIFICATE LEGEND

- ⊙ DESIGN GRADE
- ⊙ ASBUILT GRADE


DRAINAGE CERTIFICATION

I, BRUCE J. STIDWORTHY, NMPE 14523, OF THE FIRM BOHANNAN HUSTON INC., HEREBY CERTIFY THAT THIS PROJECT HAS BEEN GRADED AND WILL DRAIN IN SUBSTANTIAL COMPLIANCE WITH AND IN ACCORDANCE WITH THE DESIGN INTENT OF THE APPROVED PLAN DATED 10/21/2004. THE RECORD INFORMATION EDITED ONTO THE ORIGINAL DESIGN DOCUMENT HAS BEEN OBTAINED BY ROBERT GROMATZKY, NMPS 16468, OF THE FIRM BOHANNAN HUSTON INC. I FURTHER CERTIFY THAT I HAVE PERSONALLY VISITED THE PROJECT SITE ON 07/20/2004 AND HAVE DETERMINED BY VISUAL INSPECTION THAT THE SURVEY DATA PROVIDED IS REPRESENTATIVE OF ACTUAL SITE CONDITIONS AND IS TRUE AND CORRECT TO THE BEST OF MY KNOWLEDGE AND BELIEF. THIS CERTIFICATION IS SUBMITTED IN SUPPORT OF A REQUEST FOR TEMPORARY CERTIFICATE OF OCCUPANCY.

THE DRAINAGE SCHEME ON THE EAST SIDE OF THE BUILDING WAS MODIFIED FROM A VALLEY GUTTER TO DROP INLETS AND AN 8" STORM DRAIN. PRIOR TO FINAL C.D., THE FINAL GRADING OF THE LANDSCAPE AREAS ON THE EAST SIDE OF THE BUILDING AND NEAR THE NW CORNER OF THE BUILDING MUST BE COMPLETED.

THE RECORD INFORMATION PRESENTED HEREON IS NOT NECESSARILY COMPLETE AND INTENDED ONLY TO VERIFY SUBSTANTIAL COMPLIANCE OF THE GRADING AND DRAINAGE ASPECTS OF THIS PROJECT. THOSE RELYING ON THIS RECORD DOCUMENT ARE ADVISED TO OBTAIN INDEPENDENT VERIFICATION OF ITS ACCURACY BEFORE USING IT FOR ANY OTHER PURPOSE.

Bruce J. Stidworthy 7/21/05
BRUCE J. STIDWORTHY NMPE 14523 DATE

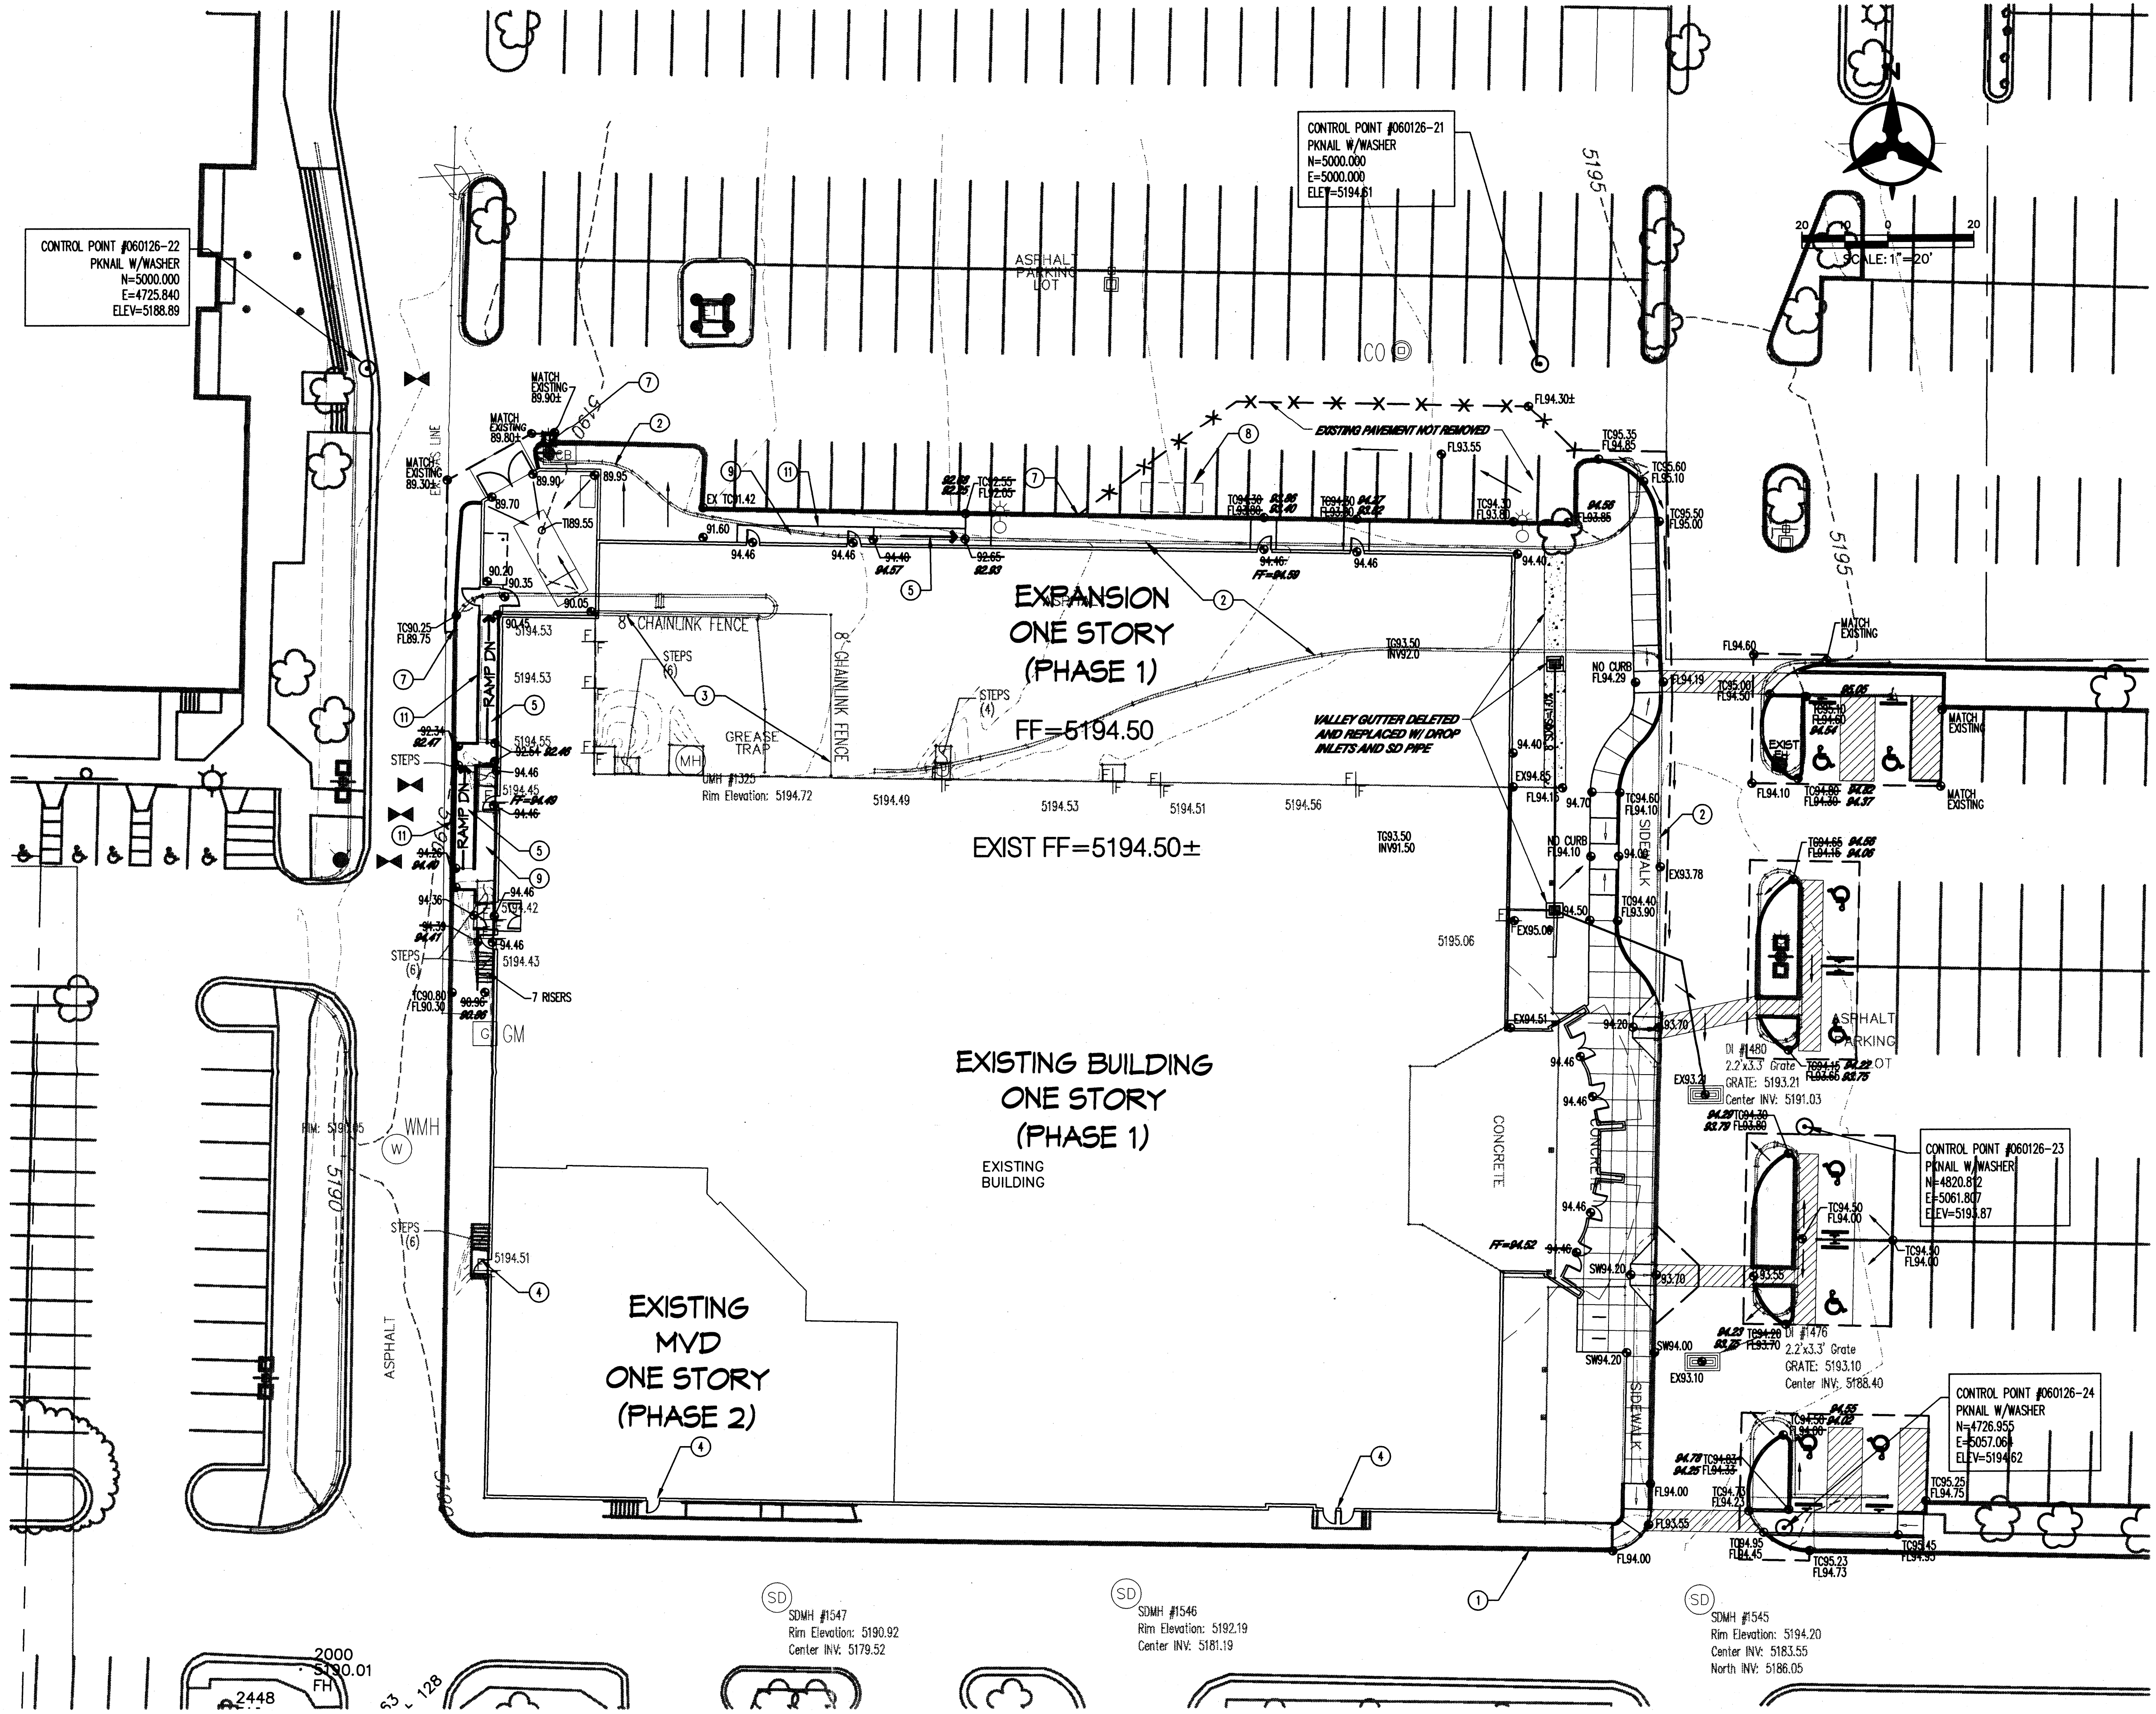

GENERAL CONSTRUCTION NOTES

GENERAL

CONTRACTOR IS RESPONSIBLE FOR OBTAINING ALL REQUIRED CONSTRUCTION PERMITS, INCLUDING A TOP SOIL DISTURBANCE PERMIT, PRIOR TO START OF CONSTRUCTION.

ALL WORK ON THIS PROJECT SHALL BE PERFORMED IN ACCORDANCE WITH APPLICABLE FEDERAL, STATE, AND LOCAL LAWS, ORDINANCES, AND REGULATIONS CONCERNING CONSTRUCTION SAFETY AND HEALTH.

REFERENCES MADE TO STANDARD SPECIFICATIONS AND STANDARD DRAWINGS REFER TO THE CITY OF ALBUQUERQUE STANDARD SPECIFICATIONS FOR PUBLIC WORKS CONSTRUCTION, 1986 EDITION WITH ALL UPDATES.

THE CONTRACTOR SHALL NOT INSTALL ITEMS AS SHOWN ON THESE PLANS WHEN IT IS OBVIOUS THAT FIELD CONDITIONS ARE DIFFERENT THAN SHOWN IN THE PLANS. SUCH CONDITIONS SHALL BE BROUGHT TO THE ATTENTION OF THE ENGINEER IN A TIMELY MANNER. IN THE EVENT THE CONTRACTOR DOES NOT NOTIFY THE ENGINEER IN A TIMELY MANNER, THE CONTRACTOR ASSUMES FULL RESPONSIBILITY AND EXPENSE FOR ANY REVISIONS NECESSARY, INCLUDING ENGINEERING DESIGN FEES.

EXISTING SITE IMPROVEMENTS WHICH ARE DAMAGED OR DISPLACED BY THE CONTRACTOR SHALL BE REMOVED AND REPLACED BY THE CONTRACTOR AT THE CONTRACTOR'S EXPENSE. REPAIRS SHALL BE APPROVED BY THE OWNER PRIOR TO CONSTRUCTION OF THE REPAIRS. REPAIRS SHALL BE ACCEPTED BY THE OWNER PRIOR TO FINAL PAYMENT.

EXISTING FENCING THAT IS NOT DESIGNATED FOR REMOVAL SHALL NOT BE DISTURBED. ANY FENCING THAT IS DISTURBED OR ALTERED BY THE CONTRACTOR SHALL BE RESTORED TO ITS ORIGINAL CONDITION AT THE CONTRACTOR'S EXPENSE. IF THE CONTRACTOR DESIRES TO REMOVE FENCING TO ACCOMMODATE CONSTRUCTION ACTIVITIES, THE CONTRACTOR SHALL OBTAIN THE OWNER'S WRITTEN PERMISSION BEFORE THE FENCE IS REMOVED. CONTRACTOR SHALL RESTORE THE FENCE TO ITS ORIGINAL CONDITION AT THE EARLIEST OPPORTUNITY. WHILE ANY FENCING IS REMOVED, THE CONTRACTOR SHALL BE SOLELY RESPONSIBLE FOR SECURITY OF THE SITE UNTIL THE FENCE IS RESTORED.

WORK WITHIN ADJACENT RIGHT-OF-WAY

PRIOR TO BEGINNING ANY CONSTRUCTION ACTIVITIES WITHIN ADJACENT RIGHT-OF-WAYS OR WITHIN PROPERTY NOT OWNED BY THE OWNER OF THE PROJECT SITE, THE CONTRACTOR SHALL ASSURE THAT ALL PERMITS AND PERMISSIONS REQUIRED HAVE BEEN OBTAINED IN WRITING.

SURVEY MONUMENTS, PROPERTY CORNERS, BENCHMARKS

THE CONTRACTOR SHALL NOTIFY THE OWNER AT LEAST SEVEN DAYS BEFORE BEGINNING ANY CONSTRUCTION ACTIVITY THAT COULD DAMAGE OR DISPLACE SURVEY MONUMENTS, PROPERTY CORNERS, OR PROJECT BENCHMARKS SO THESE ITEMS MAY BE RELOCATED.

ANY SURVEY MONUMENTS, PROPERTY CORNERS, OR BENCHMARKS THAT ARE NOT IDENTIFIED FOR RELOCATION ARE THE RESPONSIBILITY OF THE CONTRACTOR TO PRESERVE AND PROTECT. RELOCATION OR REPLACEMENT OF THESE ITEMS SHALL BE DONE BY THE OWNER'S SURVEYOR AT THE EXPENSE OF THE CONTRACTOR.

DIMENSIONS

ALL DIMENSIONS TO CURBS ARE TO THE FLOWLINE UNLESS OTHERWISE NOTED.

ALL STATIONING IS TO THE CENTERLINE OF THE RIGHT-OF-WAY UNLESS OTHERWISE NOTED.

ALL SLOPES AND GRADES ARE IN PERCENT UNLESS OTHERWISE NOTED.

CURB ELEVATIONS ARE SHOWN AT THE FLOW LINE UNLESS OTHERWISE NOTED. SEE THE DETAIL SHEET TO DETERMINE THE CURB HEIGHT ABOVE FLOW LINE.

SOILS

UNLESS OTHERWISE SPECIFIED, SUBGRADE, ENGINEERED FILL, AND STRUCTURAL FILL SHALL BE COMPACTED TO THE FOLLOWING SPECIFICATIONS OF THE ASTM D-1557 MAXIMUM DRY DENSITY.

MATERIAL LOCATION	PERCENT COMPACTION
STRUCTURAL FILL IN THE BUILDING AREA	95%
SUBBASE FOR SLAB SUPPORT	95%
MISCELLANEOUS BACKFILL BELOW STRUCTURAL FILL OR ROADWAY PAVEMENT	95%
MISCELLANEOUS BACKFILL BELOW UNPAVED, NON-BUILDING AREAS	90%
ROADWAY PAVEMENT SUBGRADE	95%
SIDEWALK SUBGRADE	90%
CURB AND GUTTER SUBGRADE	95%

PAVEMENT

WHEN ABUTTING NEW PAVEMENT TO EXISTING PAVEMENT, CUT EXISTING PAVEMENT EDGE TO A NEAT, STRAIGHT LINE AS NECESSARY TO REMOVE ANY BROKEN OR CRACKED PAVEMENT AND MATCH NEW PAVEMENT ELEVATION TO EXISTING.

ALL UTILITIES AND UTILITY SERVICE LINES SHALL BE INSTALLED AND APPROVED PRIOR TO PAVING.

ALL WATER VALVE BOXES AND ELECTRICAL, TELEPHONE, TELEVISION, AND SEWER MANHOLES IN THE CONSTRUCTION AREA SHALL BE ADJUSTED TO FINISHED GRADE BEFORE PAVING.

WHEN SIDEWALK OR CURB AND GUTTER IS REMOVED, IT SHALL BE REMOVED TO EXISTING CONSTRUCTION JOINTS. CUTTING OR BREAKING SHALL NOT BE ALLOWED.

UTILITIES

IF ANY UTILITY LINES, PIPELINES, OR UNDERGROUND UTILITY LINES ARE SHOWN ON THESE DRAWINGS, THEY ARE SHOWN IN AN APPROXIMATE LOCATION ONLY BASED ON THE INFORMATION PROVIDED TO THE ENGINEER BY OTHERS. THIS INFORMATION MAY BE INACCURATE OR INCOMPLETE. ADDITIONALLY, UNDERGROUND LINES MAY EXIST THAT ARE NOT SHOWN. THE CONTRACTOR SHALL VERIFY THE LOCATION OF ANY UTILITY LINE, PIPELINE, OR UNDERGROUND UTILITY LINE IN OR NEAR THE AREA OF THE WORK IN ACCORDANCE WITH CHAPTER 82, ARTICLE 14-1, THROUGH 14-8, NMSA 1978.

THE CONTRACTOR SHALL CONTACT THE STATEWIDE UTILITY LOCATOR SERVICE AT 1-800-321-2537 AT LEAST TWO WORKING DAYS BEFORE BEGINNING CONSTRUCTION. AFTER THE UTILITIES ARE SPOTTED, THE CONTRACTOR SHALL EXPOSE ALL PERTINENT UTILITIES TO VERIFY THEIR VERTICAL AND HORIZONTAL LOCATION. IF A CONFLICT EXISTS BETWEEN EXISTING UTILITIES AND PROPOSED CONSTRUCTION, THE CONTRACTOR SHALL NOTIFY THE ENGINEER SO THAT THE CONFLICT CAN BE RESOLVED WITH MINIMAL DELAY.

THE CONTRACTOR SHALL EXERCISE DUE CARE TO AVOID DISTURBING ANY EXISTING UTILITIES, ABOVE OR BELOW GROUND. UTILITIES THAT ARE DAMAGED BY CARELESS CONSTRUCTION SHALL BE REPAIRED OR REPLACED AT THE CONTRACTOR'S EXPENSE.

EXISTING VALVES SHALL ONLY BE OPERATED BY THE UTILITY COMPANY. CONTRACTOR SHALL NOTIFY THE UTILITY A MINIMUM OF TWO WORKING DAYS BEFORE ANY VALVE, NEW OR EXISTING, NEEDS TO BE OPERATED.

THE CONTRACTOR SHALL COORDINATE ANY REQUIRED UTILITY INTERRUPTIONS WITH THE OWNER AND AFFECTED UTILITY COMPANY A MINIMUM OF THREE WORKING DAYS BEFORE THE INTERRUPTION.

THE CONTRACTOR SHALL MAINTAIN A RECORD DRAWING SET OF PLANS AND PROMPTLY LOCATE ALL UTILITIES, EXISTING OR NEW, IN THEIR CORRECT LOCATION, HORIZONTAL AND VERTICAL. THIS RECORD SET OF DRAWINGS SHALL BE MAINTAINED ON THE PROJECT SITE AND SHALL BE AVAILABLE TO THE OWNER AND ENGINEER AT ANY TIME DURING CONSTRUCTION.

EROSION CONTROL, ENVIRONMENTAL PROTECTION, AND STORM WATER POLLUTION PREVENTION PLAN

THE CONTRACTOR SHALL CONFORM TO ALL CITY, COUNTY, STATE, AND FEDERAL DUST AND EROSION CONTROL REGULATIONS. THE CONTRACTOR SHALL OBTAIN AND PREPARE ANY DUST CONTROL OR EROSION CONTROL PERMITS REQUIRED FROM THE REGULATORY AGENCIES.

THE CONTRACTOR SHALL PROMPTLY REMOVE ANY MATERIAL EXCAVATED WITH THE PUBLIC RIGHT-OF-WAY OR ADJACENT PROPERTY TO KEEP IT FROM WASHING OFF THE PROJECT SITE.

THE CONTRACTOR SHALL ENSURE THAT NO SOIL ERODES FROM THE SITE ONTO ADJACENT PROPERTY BY CONSTRUCTION OF TEMPORARY EROSION CONTROL BERMES OR INSTALLING SILT FENCES AT THE PROPERTY LINES AND WETTING THE SOIL TO PREVENT IT FROM BLOWING.

WATERING, AS REQUIRED FOR CONSTRUCTION DUST CONTROL, SHALL BE CONSIDERED INCIDENTAL TO CONSTRUCTION AND NO MEASUREMENT OR PAYMENT SHALL BE MADE. CONSTRUCTION AREAS SHALL BE WATERED FOR DUST CONTROL IN COMPLIANCE WITH GOVERNMENT ORDINANCES. THE CONTRACTOR SHALL BE RESPONSIBLE FOR LOCATING AND SUPPLYING WATER AS REQUIRED.

ANY AREAS DISTURBED BY CONSTRUCTION AND NOT COVERED BY LANDSCAPING OR IMPERVIOUS SURFACES SHALL BE REVEGETATED WITH RECLAMATION SEEDING.

THE CONTRACTOR SHALL PROPERLY HANDLE AND DISPOSE OF ALL ASPHALT REMOVED ON THE PROJECT BY HAULING IT TO AN APPROVED DISPOSAL SITE IN ACCORDANCE WITH THE REQUIREMENTS OF THE NEW MEXICO SOLID WASTE ACT.

ALL WASTE PRODUCTS FROM THE CONSTRUCTION SITE, INCLUDING ITEMS DESIGNED FOR REMOVAL, CONSTRUCTION WASTE, CONSTRUCTION EQUIPMENT WASTE PRODUCTS (OIL, GAS, TIRES, ETC.), GARBAGE, GRUBBING, EXCESS CUT MATERIAL, VEGETATIVE DEBRIS, ETC., SHALL BE APPROPRIATELY DISPOSED OF OFFSET AT NO ADDITIONAL COST TO THE OWNER. IT SHALL BE THE CONTRACTOR'S RESPONSIBILITY TO OBTAIN ANY PERMITS REQUIRED FOR HAUL OR DISPOSAL OF WASTE PRODUCTS. IT SHALL BE THE CONTRACTOR'S RESPONSIBILITY TO ENSURE THAT THE WASTE DISPOSAL SITE COMPLIES WITH GOVERNMENT REGULATIONS REGARDING THE ENVIRONMENT, ENDANGERED SPECIES, AND ARCHAEOLOGICAL RESOURCES.

THE CONTRACTOR SHALL BE RESPONSIBLE FOR THE CLEANUP AND REPORTING OF SPILLS OF HAZARDOUS MATERIALS ASSOCIATED WITH THE CONSTRUCTION SITE. HAZARDOUS MATERIALS INCLUDE GASOLINE, DIESEL FUEL, MOTOR OIL, SOLVENTS, CHEMICALS, PAINT, ETC. WHICH MAY BE A THREAT TO THE ENVIRONMENT. THE CONTRACTOR SHALL REPORT THE DISCOVERY OF PAST OR PRESENT SPILLS TO THE NEW MEXICO EMERGENCY RESPONSE AT 1-800-219-8157.

THE CONTRACTOR SHALL COMPLY WITH ALL APPLICABLE REGULATIONS CONCERNING SURFACE AND UNDERGROUND WATER. CONTACT WITH SURFACE WATER BY CONSTRUCTION EQUIPMENT AND PERSONNEL SHALL BE MINIMIZED. EQUIPMENT MAINTENANCE AND REFUELING OPERATIONS SHALL BE PERFORMED IN AN ENVIRONMENTALLY SAFE MANNER IN COMPLIANCE WITH GOVERNMENT REGULATIONS.

THE CONTRACTOR SHALL COMPLY WITH ALL APPLICABLE REGULATIONS CONCERNING CONSTRUCTION NOISE AND HOURS OF OPERATION.

ACCESSIBLE FACILITIES

ALL SURFACES ALONG ACCESSIBLE ROUTES AND FOR HANDICAP RAMPS SHALL BE STABLE FIRM, SLIDE RESISTANT AND SHALL COMPLY WITH UNIFORM FEDERAL ACCESSIBILITY STANDARDS, PARAGRAPH 4.5.

LONGITUDINAL SLOPES ALONG ACCESSIBLE ROUTE SIDEWALKS, EXCEPT AT HANDICAP RAMPS, SHALL NOT BE STEEPER THAN 1:20. CROSS SLOPES ALONG ACCESSIBLE ROUTE SIDEWALKS EXCEPT AT HANDICAP RAMPS, SHALL NOT BE STEEPER THAN 1:48. SLOPES IN ACCESSIBLE PARKING SPACES, ACCESS AISLES, AND PASSENGER LOADING ZONES SHALL NOT BE STEEPER THAN 1:48 IN ALL DIRECTIONS.

THE SITE SHALL COMPLY WITH ANSI A117.1-1992, "ACCESSIBLE AND USABLE BUILDINGS AND FACILITIES".

TRAFFIC CONTROL

THE CONTRACTOR SHALL PROVIDE ALL REQUIRED TRAFFIC CONTROL PLANS. ALL SIGNS, BARRICADES, CHANNELIZATION DEVICES, SIGN FRAMES AND ERECTION OF SUCH DEVICES SHALL CONFORM TO THE REQUIREMENTS OF "MANUAL OF UNIFORM TRAFFIC CONTROL DEVICES FOR STREETS AND HIGHWAYS" LATEST EDITION. PRIOR TO CONSTRUCTION, TRAFFIC CONTROL PLANS SHALL BE APPROVED BY THE GOVERNING AUTHORITY.

ABBREVIATIONS

A = AIR LINE
AD = AREA DRAIN
AIP = ABANDONED IN PLACE
BLDG = BUILDING
BM = BENCHMARK
CATV = CABLE TELEVISION LINE
CIP = CAST IRON PIPE
CMP = CORRUGATED METAL PIPE
CMPA = CORRUGATED METAL PIPE ARCH
CO = CLEAN OUT
COA = CITY OF ALBUQUERQUE
CONC = CONCRETE
CL = CENTERLINE
DIA = DIAMETER
DIP = DUCTILE IRON PIPE
DTL = DETAIL
DWG = DRAWING
E = ELECTRIC LINE
ELEC. = ELECTRIC
ELEV = ELEVATION
EX = EXISTING
FF = FINISHED FLOOR ELEVATION

FG = FINISHED GRADE
FH = FIRE HYDRANT
FL = FLOW LINE
G = GAS PIPE
GM = GAS METER
GV = GATE VALVE
HI PT = HIGH POINT
INV = INVERT ELEVATION
LF = LINEAL FEET
LP = LIGHT POLE
L/S = LANDSCAPING
MH = MANHOLE
NG = NATURAL GROUND
OE = OVERHEAD ELECTRIC LINE
OT = OVERHEAD TELEPHONE LINE
PB = ELECTRICAL PULL BOX
PCC = PORTLAND CEMENT CONCRETE
PP = POWER POLE
PROP = PROPOSED
PVC = POLYVINYL CHLORIDE PIPE
RCP = REINFORCED CONCRETE PIPE
RD = ROOF DRAIN

R/W = RIGHT-OF-WAY
S = SLOPE
SAS = SANITARY SEWER
SD = STORM DRAIN
STA = STATION
STD = STANDARD
SW = SIDEWALK
T = TELEPHONE
TA = TOP OF ASPHALT PAVEMENT
TAC = TOP OF ASPHALT CURB
TC = TOP OF CRUSHER FINES (STABILIZED)
TOC = TOP OF CONCRETE CURB
TG = TOP OF GRATE
TS = TOP OF SIDEWALK
TW = TOP OF WALL
TYP = TYPICAL
TB = TELEPHONE BOX
UE = UNDERGROUND ELECTRIC
UT = UNDERGROUND TELEPHONE
W = WATER
WM = WATER METER
WV = WATER VALVE

RECORD BEARING AND DISTANCES

LEGEND

N 00°00'00" E	RECORD BEARING AND DISTANCES	→	DOWN GUY
○ NS	NAIL & SHINER	☆	LIGHT POLE
•	FOUND AS INDICATED	*	UTILITY POLE WITH LIGHT
△	HWY R/W MARKER T RAIL	—OT—	OVERHEAD TELEPHONE
C/C	CORNER TO CORNER DIMENS.	—OE—	OVERHEAD ELECTRIC
EX FG 83.54	EX SPOT ELEV.	—○—	FENCE
TA 36.74	PROP SPOT ELEV.	—	BLOCK WALL
—5160—	EX CONTOUR LINE	—	DRAINAGE SWALE
◇	POWER POLE	■	EX US WEST RISER

○ GM	GAS METER
□	EX FIRE HYDRANT
⊕	PROP FIRE HYDRANT
—	EX WATER VALVE
—	PROP WATER VALVE
○	EX SD MANHOLE
○	PROP SD MANHOLE
⊙	EX SAS MANHOLE
●	PROP SAS MANHOLE

■	EX SD INLET
■	PROP SD INLET
CONC	CONCRETE
•	EX SIGN
⊙	EX WATER METER
⊙	PROP WATER METER
○	PLANTER
⊙	PROPOSED TREE
●	EXIST. TREE

CIVIL GENERAL NOTES
THE JUNCTION BAR
ALBUQUERQUE, NEW MEXICO

RECEIVED
APR 13 2000
HYDROLOGY SECTION



LARRY READ & ASSOCIATES
Civil Engineers
12836-B Lomas Blvd. NE
Albuquerque, New Mexico 87112
(505) 237-8421



REVISION	DATE	DESCRIPTION

FILE NAME: JUNCTION_DT 04/0400

JEFFERSON STREET (86' R/W)

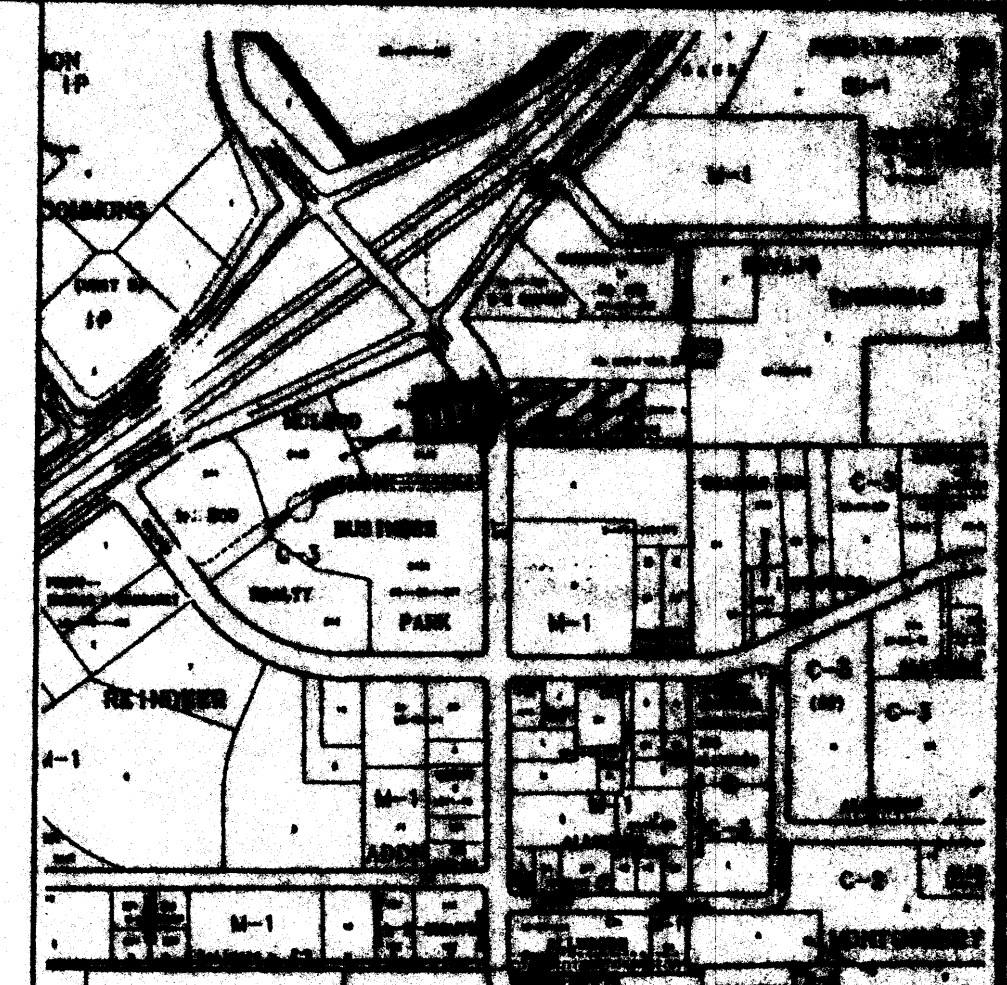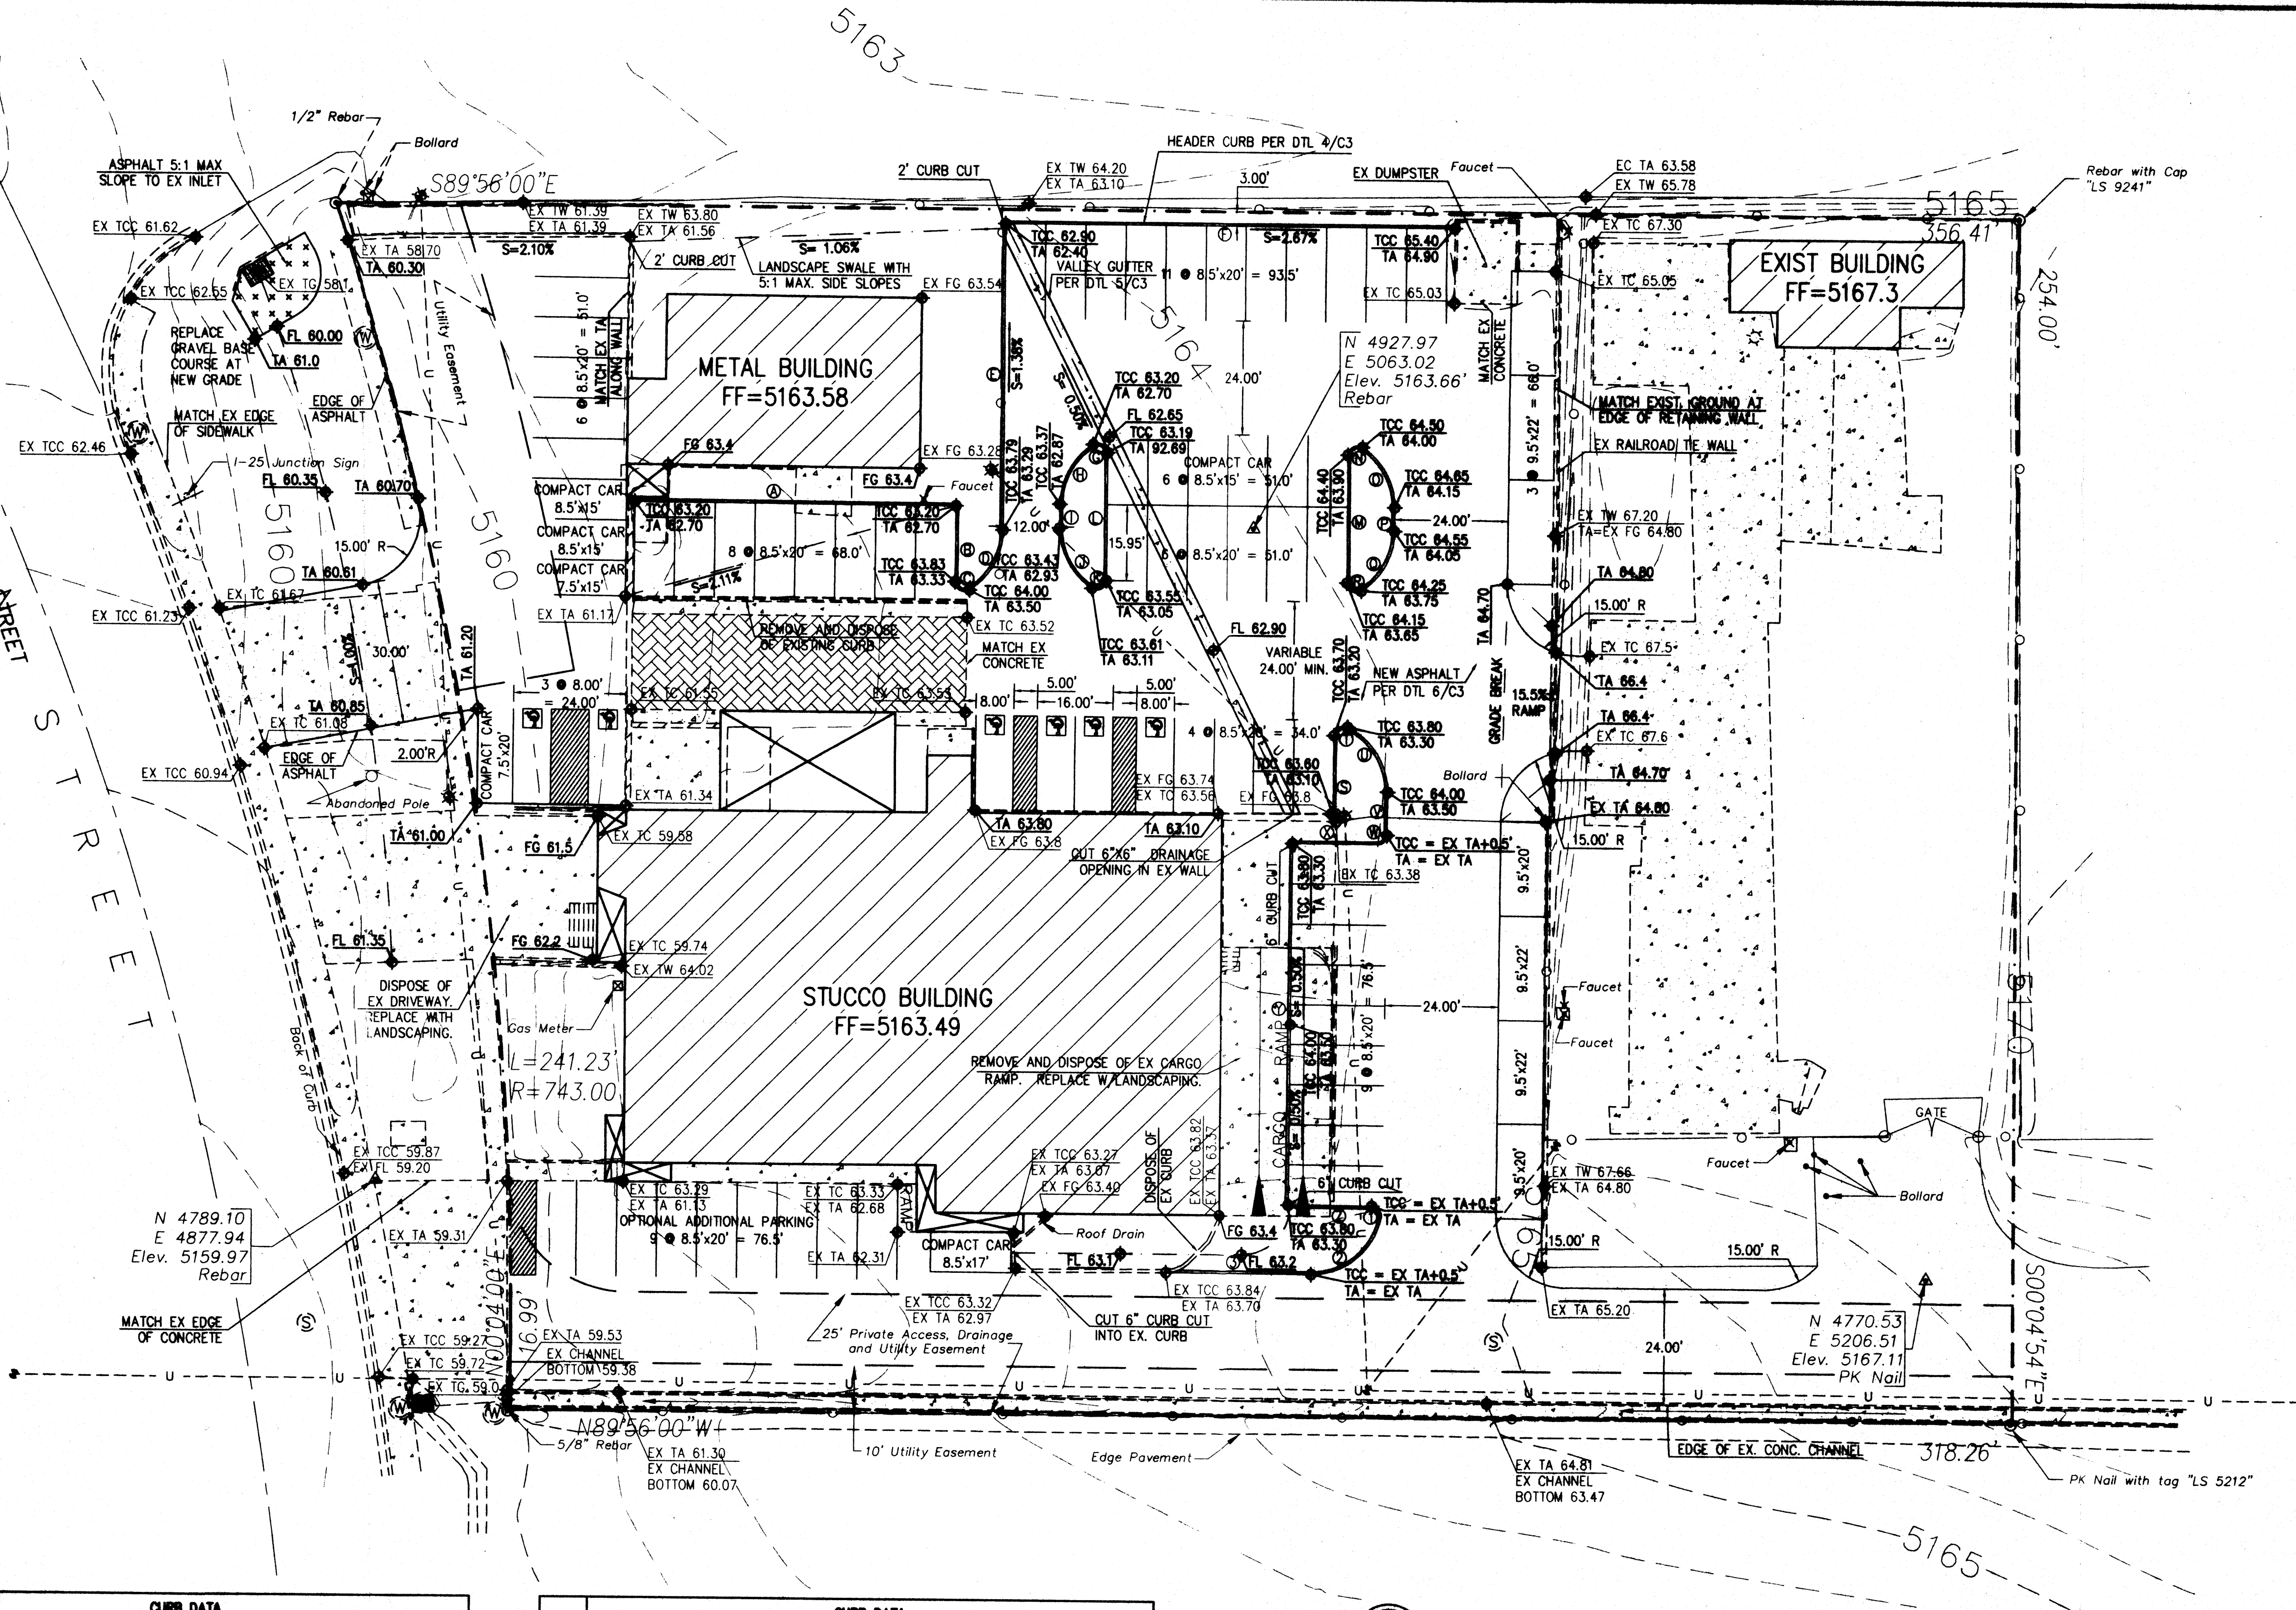

VICINITY MAP F-17

LEGAL DESCRIPTION

TRACT 3, BERRY SUBDIVISION, ALBUQUERQUE, BERNALILLO COUNTY, NEW MEXICO FILED MAY 21, 1989 IN PLAT BOOK C39, PAGE 62.

ACS BENCHMARK

ELEVATIONS ARE BASED ON ACS MONUMENT 13-F18, HAVING AN ELEVATION OF 5214.24.

SURVEY NOTES

FIELD SURVEY BY: CARTESIAN SURVEYS, P.O. BOX 44414, RIO RANCHO, NM 87174. SURVEY DATE: MARCH 2000. PHONE: (505) 898-3060. FAX: (505) 891-0244.

LOCATION OF ALL UTILITIES SHOWN ON THESE PLANS ARE BASED ON INFORMATION SUPPLIED TO THE SURVEYOR BY THE APPROPRIATE UTILITY COMPANIES. SURVEYOR DOES NOT GUARANTEE THESE LOCATIONS NOR THE FACT THAT SOME UTILITIES MIGHT BE LEFT OUT. IT IS THE RESPONSIBILITY OF THE CONTRACTOR TO CONTACT BLUE STAKE AND ANY OTHER INVOLVED AGENCIES TO LOCATE ALL UTILITIES PRIOR TO CONSTRUCTION.

THIS IS NOT A BOUNDARY SURVEY AND SHOULD NOT BE USED BY THE OWNER AS SUCH. APPARENT PROPERTY CORNERS ARE SHOWN FOR ORIENTATION ONLY. BOUNDARY DATA SHOWN IS FROM PREVIOUS SURVEY.


CONTOUR INTERVAL IS ONE FOOT (1'). ALL DISTANCES ARE GROUND DISTANCES: US SURVEY FOOT.

FLOODPLAIN

THE PROPERTY SHOWN HEREON LIES WITHIN ZONE X WITH THE AS SHOWN ON THE FLOOD INSURANCE RATE MAP OF THE CITY OF ALBUQUERQUE, BERNALILLO COUNTY, NEW MEXICO, COMMUNITY-PANEL NO. 33001C0139 D; EFFECTIVE DATE SEPTEMBER 20, 1988.

CURB DATA						
Ø	RADIUS	LENGTH	TANGENT	DELTA	CHORD	CHORD BEARING
①	—	68.00'	—	—	—	S89°41'50"E
②	—	15.97'	—	—	—	S00°18'10"W
③	2.00'	4.28'	3.84'	122°28'17"	3.51'	S80°55'58"E
④	15.00'	15.12'	8.27'	57°45'53"	14.49'	N28°56'56"E
⑤	—	64.56'	—	—	—	N00°04'00"E
⑥	—	95.26'	—	—	—	S89°55'00"E
⑦	2.00'	4.28'	3.85'	122°34'44"	3.51'	N61°13'22"W
⑧	15.00'	15.03'	8.22'	57°25'16"	14.41'	S28°46'38"W
⑨	—	5.00'	—	—	—	S00°04'00"W
⑩	15.00'	15.03'	8.22'	57°25'16"	14.41'	S28°46'38"E
⑪	2.00'	4.28'	3.85'	122°34'44"	3.51'	N61°21'22"E
⑫	—	28.91'	—	—	—	N00°04'00"E
⑬	—	28.91'	—	—	—	N00°04'00"E
⑭	2.00'	4.28'	3.85'	122°34'44"	3.51'	N61°21'22"E
⑮	15.00'	15.03'	8.22'	57°25'16"	14.41'	S28°38'38"E

CURB DATA						
Ø	RADIUS	LENGTH	TANGENT	DELTA	CHORD	CHORD BEARING
①	—	5.00'	—	—	—	S00°04'00"W
②	15.00'	15.03'	8.22'	57°25'16"	14.41'	S28°46'38"W
③	2.00'	4.28'	3.85'	122°34'44"	3.51'	N61°13'22"W
④	—	16.78'	—	—	—	N00°18'10"E
⑤	2.00'	4.02'	3.14'	115°01'44"	3.37'	N57°49'02"E
⑥	15.00'	17.01'	9.55'	84°58'16"	16.11'	S32°10'58"E
⑦	—	9.05'	—	—	—	S00°18'10"W
⑧	2.00'	3.14'	2.00'	90°00'00"	2.83'	S45°18'10"W
⑨	—	18.00'	—	—	—	N86°41'50"W
⑩	—	76.50'	—	—	—	S00°18'10"W
⑪	—	17.76'	—	—	—	S89°41'50"E
⑫	2.00'	3.53'	2.43'	101°05'15"	3.09'	S39°09'13"E
⑬	15.00'	20.84'	12.33'	78°50'47"	19.05'	S50°48'48"W
⑭	—	30.89'	—	—	—	N89°45'46"W

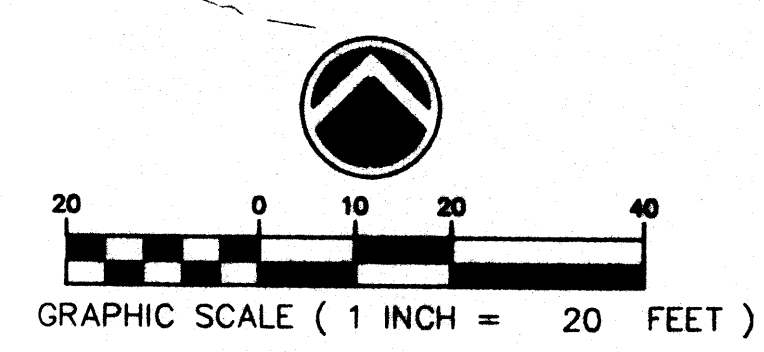


PARKING SPACES DESIGNATED AS COMPACT CAR SHALL BE MARKED AS SUCH DURING THE STRIPING OPERATION.

PARKING SPACE SCHEDULE	
DESCRIPTION	NUMBER
REGULAR	60
COMPACT	11
REGULAR ADA	4
VAN ADA	2
TOTAL	77


GRADING AND DRAINAGE PLAN

THE JUNCTION BAR
ALBUQUERQUE, NEW MEXICO

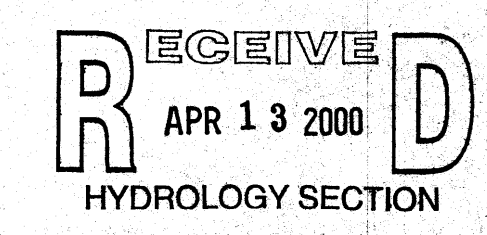


LARRY READ & ASSOCIATES
Civil Engineers
12836-B Lomas Blvd. NE
Albuquerque, New Mexico 87112
(505) 237-8421

REVISION	DATE	DESCRIPTION
FILE NAME: JUNCTION_GD 04/04/00		SHEET C2 of 3

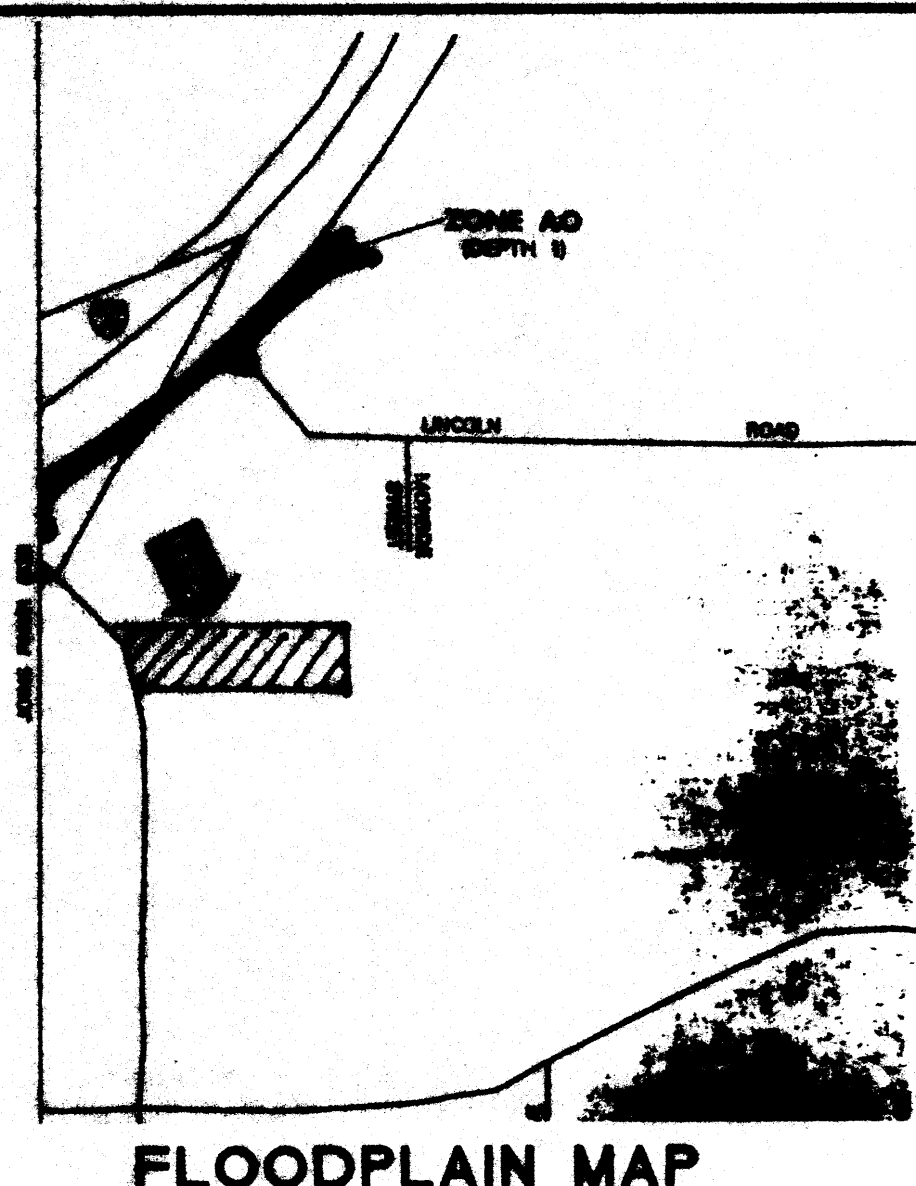

FLOODPLAIN MAP

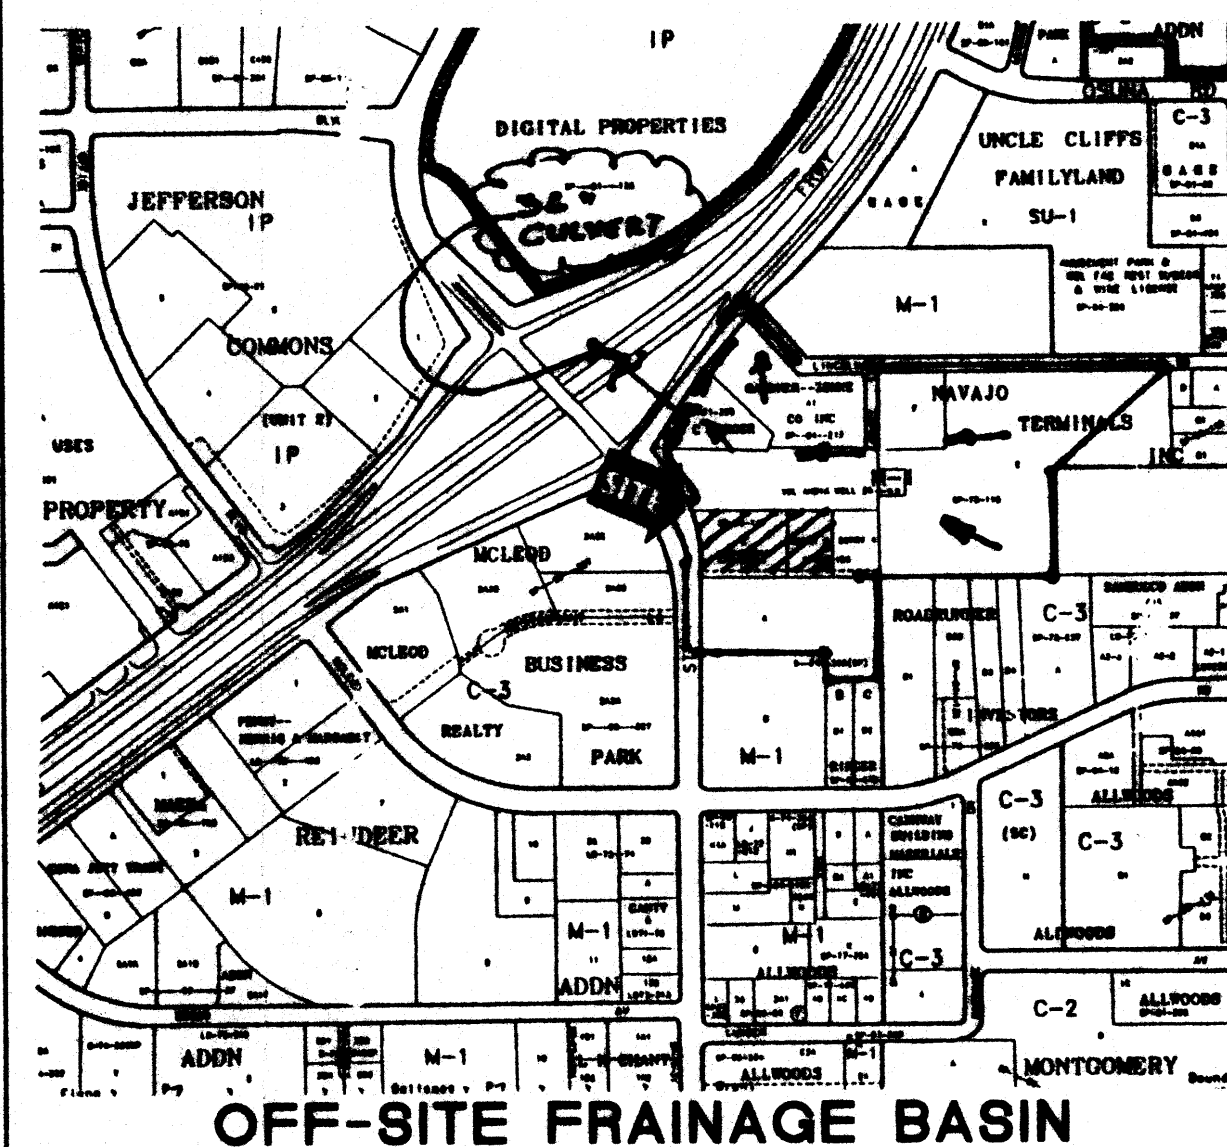

OFF-SITE DRAINAGE BASIN

100-YEAR HYDROLOGIC CALCULATIONS

BASIN #	AREA (acres)	LAND TREATMENT				WEIGHTED E (in)	V (6-hr) (acre-ft)	V (6-hr) (cu-ft)	V (10 day) (acre-ft)	V (10 day) (cu-ft)	Q (cfs)
		A (%)	B (%)	C (%)	D (%)						
EXISTING CONDITIONS											
ON-SITE	1.9228	0.00	0.00	40.00	60.00	1.72	0.28	12,038	0.43	18,741	7.84
PROPOSED CONDITIONS											
ON-SITE	1.9228	0.00	0.00	25.00	75.00	1.87	0.30	13,975	0.48	21,453	8.29
WATER QUALITY											
WATER QUALITY						0.53	0.78	1.13	2.12	E (in)	
PEAK DISCHARGE						1.88	2.28	3.14	4.7	Q _p (cfs)	
ZONE = 2											
WEIGHTED E (in) = (E _A (%A) + (E _B (%B) + (E _C (%C) + (E _D (%D)						P _{6hr} (in.) = 2.35					
V _{6hr} (acre-ft) = (WEIGHTED E)(AREA)/12						P _{10day} (in.) = 2.75					
V _{10day} (acre-ft) = V _{6hr} + (A _C)(P _{6hr} - P _{10day})/12						P _{peak} (in.) = 3.95					
Q (cfs) = (Q _A (A _A) + (Q _B (A _B) + (Q _C (A _C) + (Q _D (A _D)											

LOCATION & DESCRIPTION

THE PROPOSED INFILL SITE IS 1.92 ACRES LOCATED ON THE EAST SIDE OF JEFFERSON STREET BETWEEN I-25 AND MCLEOD ROAD (SEE MONITOR MAP ON SHEET C2). IT IS CURRENTLY DEVELOPED WITH THREE (3) BUILDINGS AS SHOWN ON SHEET C2. THE REMAINING PORTION OF THE LOT HAS BEEN USED HEAVILY FOR PARKING AND IS EITHER EXISTING ASPHALT AS INDICATED ON THE GRADING AND DRAINAGE SHEET OR GRAVEL. THE PROPOSED IMPROVEMENTS FOR THIS PROJECT INCLUDE RENOVATING THE INTERIOR OF THE EXISTING BUILDINGS AND INCREASING THE AREA OF ASPHALT PARKING. THE EAST END OF THE SITE IS SEPARATED BY A RETAINING WALL MAKING IT ABOUT 2.5' HIGHER THAN THE REST OF THE SITE AND WILL BE USED AS OVERFLOW PARKING. THE OVERFLOW PARKING WILL LEAVE THE EXISTING CONCRETE PAD SHOWN ON THE GRADING AND DRAINAGE PLAN AND FILL IN AROUND IT WITH BASE COURSE. THEREFORE, NO CHANGE IN DRAINAGE CHARACTERISTICS WILL OCCUR ON THIS PORTION OF THE PROPERTY AS A RESULT OF THIS DEVELOPMENT.

FLOODPLAIN STATUS

THIS PROJECT, AS SHOWN ON FEMA'S FLOOD INSURANCE RATE MAP 35001C0139 D, DATED SEPTEMBER 20, 1996 IS NOT WITHIN ANY DESIGNATED 100-YEAR FLOODPLAIN. A COPY OF THIS PANEL WITH THE SITE DESIGNATED IS ATTACHED TO THIS SHEET.

METHODOLOGY

THE HYDROLOGY FOR THIS PROJECT WAS ANALYZED USING THE QUICK CALCULATIONS OF THE JUNE 1997 RELEASE OF THE CITY OF ALBUQUERQUE DEVELOPMENT PROCESS MANUAL, SECTION 22.2.

PRECIPITATION

THE 100-YR 6-HR DURATION STORM WAS USED AS THE DESIGN STORM FOR THIS ANALYSIS. THIS SITE IS WITHIN ZONE 2 AS IDENTIFIED IN THE CITY OF ALBUQUERQUE DEVELOPMENT PROCESS MANUAL, SECTION 22.2. TABLES WITHIN THIS SECTION WERE USED TO ESTABLISH THE 6-HOUR PRECIPITATION, EXCESS PRECIPITATION, AND PEAK DISCHARGE.

EXISTING DRAINAGE


THE ENTIRE SITE DRAINS FROM EAST TO WEST AND IS COLLECTED IN TWO INLETS WITHIN THE JEFFERSON STREET RIGHT OF WAY. THESE INLETS ARE CONNECTED TOGETHER BY A 12" CORRUGATED METAL PIPE THAT DISCHARGES WEST OF FRUEHAUF TRAILERS DRIVEWAY INTO THE CHANNEL THAT FOLLOWS THE NORTH BOUND ACCESS RAMP FROM JEFFERSON TO I-25. THIS CHANNEL DISCHARGES INTO A 36" CMP CULVERT THAT GOES WEST UNDER I-25. IT IS ASSUMED THE CULVERT CONNECTS TO THE CONCRETE BOX CULVERT THAT DISCHARGES INTO THE VINEYARD CHANNEL. THIS CULVERT ALSO COLLECTS RUNOFF FROM THE PARCELS TO THE NORTH AND EAST INCLUDING THE WEST COAST SOUND BUILDING, GARDNER ZEMKE CONSTRUCTION YARD, AND NAVAJO (ABF) TRUCK TERMINAL YARDS. A COPY OF THE ZONE ATLAS PAGE IS SHOWN ON THIS SHEET THAT HAS THE APPROXIMATE OFF-SITE BASIN DELINEATED.

THE PARCEL EAST OF THIS SITE AND THE JOINT ACCESS DRIVE ALONG THE SOUTH PROPERTY LINE OF THIS SITE DRAIN TO AN EXISTING CONCRETE CHANNEL ALONG THE SOUTH PROPERTY LINE. THIS CHANNEL ALSO DISCHARGES TO THE SAME INLETS ALONG JEFFERSON THAT THE SUBJECT PROPERTY DISCHARGES TO. SINCE THE PROPERTY TO THE EAST DRAINS TO THIS CHANNEL, THERE IS NO OFFSITE DRAINAGE ENTERING THE SITE FROM THE EAST. THIS CHANNEL ELIMINATES ANY RUNOFF FROM ENTERING THE SITE FROM THE SOUTH AND A SHORT WALL ALONG THE NORTH PROPERTY LINE ENABLES THIS SITE TO BE ABOVE THE ADJACENT PROPERTY TO THE NORTH. UNDER EXISTING CONDITIONS, THE FRONT OF THE PROPERTY IS BELOW THE STREET GRADE OF JEFFERSON STREET WHICH ALLOWS FOR MINOR PONDING WITHIN THE JEFFERSON STREET RIGHT-OF-WAY. IN ORDER TO IMPROVE THE ACCESS TO THE SITE, THIS AREA WILL BE FILLED IN AS PART OF THIS PAVING PROJECT. A DRAINAGE SWALE WILL BE CONSTRUCTED TO CONVEY RUNOFF TO THE EXISTING INLETS, THEREFORE ELIMINATING THE PONDING IN THE JEFFERSON STREET RIGHT-OF-WAY.


DEVELOPED CONDITION

THE DEVELOPED CONDITIONS FOR THIS SITE DOES NOT ALTER THE DRAINAGE PATTERN THAT ALREADY EXISTS. THE BUILDING FOOTPRINTS STAY AS THEY CURRENTLY EXIST. THE ONLY CHANGES WILL BE RAISING THE GRAVEL SURFACE ON THE EAST END OF THE SITE TO MATCH THE EXISTING CONCRETE PAD IN ORDER TO USE THIS AREA AS OVERFLOW PARKING. THIS DOES NOT CHANGE THE DRAINAGE SINCE THIS AREA IS ALREADY GRAVEL. THE MAJOR CHANGES OCCUR IN THE CENTER OF THE LOT. THE PRIMARY PARKING AREA ALONG THE NORTH-CENTRAL PART OF THE PROPERTY WILL BE GRADED TO THE NORTHWEST IN ORDER TO IMPROVE ON-SITE DRAINAGE. THIS GRAVEL PARKING AREA WILL BE REPLACED WITH ASPHALT PAVEMENT. THE EXISTING LOADING DOCK RAMP ON THE EAST END OF THE PRIMARY BUILDING WILL BE REMOVED AND REPLACED WITH ASPHALT PARKING AND LANDSCAPE MATERIAL. IN ADDITION TO THESE CHANGES, STRIPING WILL BE ADDED ALONG THE SOUTH SIDE OF THE BUILDING TO DESIGNATE PARKING ON THE EXISTING ASPHALT AND A LANDSCAPED SWALE WILL BE CONSTRUCTED ALONG THE NORTH PROPERTY LINE TO DRAIN THE NEW ASPHALT PARKING AREA TO THE NORTH INLET IN THE JEFFERSON STREET RIGHT-OF-WAY. FINALLY, THE CENTER DRIVEWAY WILL BE REMOVED AND REPLACED WITH LANDSCAPE MATERIAL ALONG WITH RAISING THE GRADE WITHIN THE RIGHT-OF-WAY TO CREATE POSITIVE DRAINAGE TO THE EXISTING INLETS AND IMPROVE THE ENTRANCE CONDITIONS TO THIS SITE.


BY INCREASING LANDSCAPE AREAS, ONLY A MINOR INCREASE IN RUNOFF WILL OCCUR DUE TO THIS INFILL PAVING PROJECT. THE NET IMPERVIOUS AREA WILL BE INCREASED FROM 60% TO 75%. HOWEVER, THIS 15% INCREASE IN IMPERVIOUSNESS CREATES ONLY AN INCREASE IN 100-YEAR PEAK RUNOFF OF 0.45 CFS. THIS IS INSIGNIFICANT FOR AN INFILL SITE OF THIS SIZE SINCE, UNDER EXISTING CONDITIONS THE LAND TREATMENT IN THE PAVING AREA WAS ALREADY TYPE 'C'.

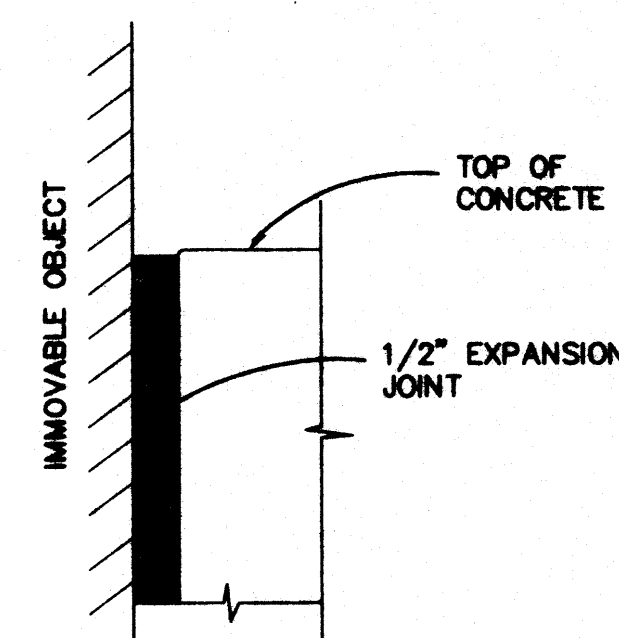

1 EXPANSION JOINT AT IMMOVABLE OBJECT
C3 N. T. S.

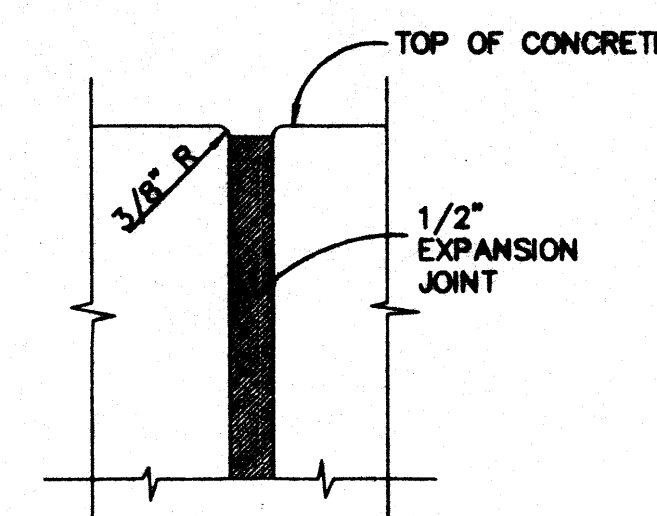


2 EXPANSION JOINT DETAIL
C3 N. T. S.

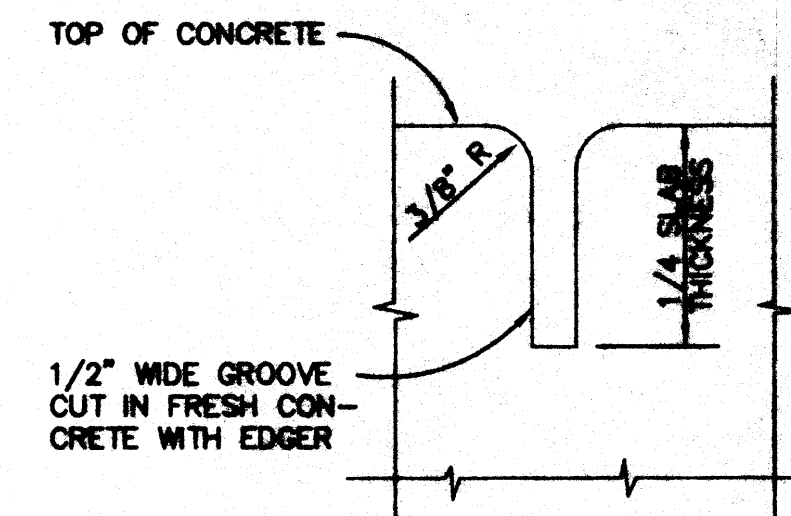

3 CONTRACTION JOINT DETAIL
C3 N. T. S.

CONSTRUCTION NOTES:


1. PROVIDE 1/2" EXPANSION JOINTS AT 36' O.C., AT IMMOVABLE OBJECTS, AND AT THE BEGINNING AND END OF CURVES.
2. PROVIDE CONTRACTION JOINTS @ 6' O.C.
3. ALL EXPOSED CONCRETE CORNERS TO HAVE 3/4" RADII.

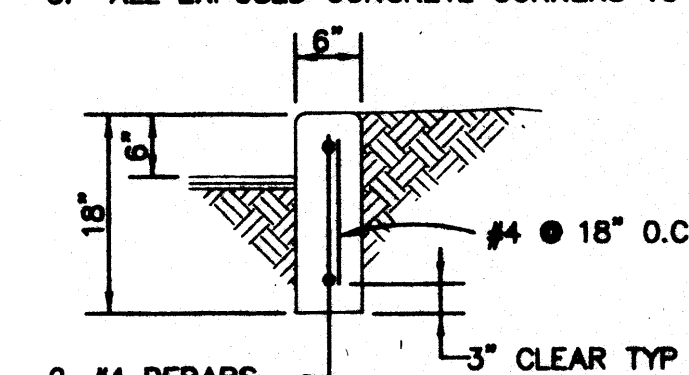


4 CONCRETE HEADER CURB DETAIL
C3 N. T. S.

CONSTRUCTION NOTES:


1. PROVIDE 1/2" EXPANSION JOINTS AT 36' O.C., AT IMMOVABLE OBJECTS AND AT PERPENDICULAR CURBS PER DETAIL THIS SHEET
2. PROVIDE CONTRACTION JOINTS @ 6' O.C. PER DETAIL THIS SHEET

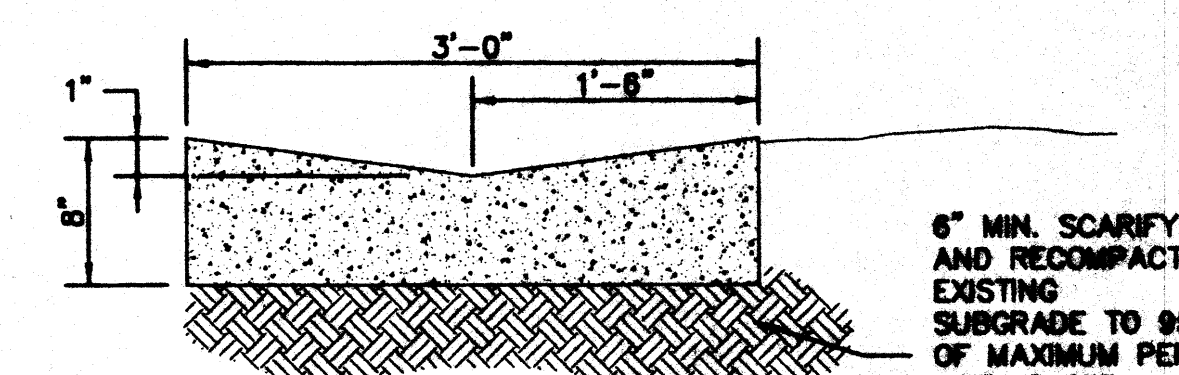

5 CONCRETE VALLEY GUTTER
C3 N. T. S.

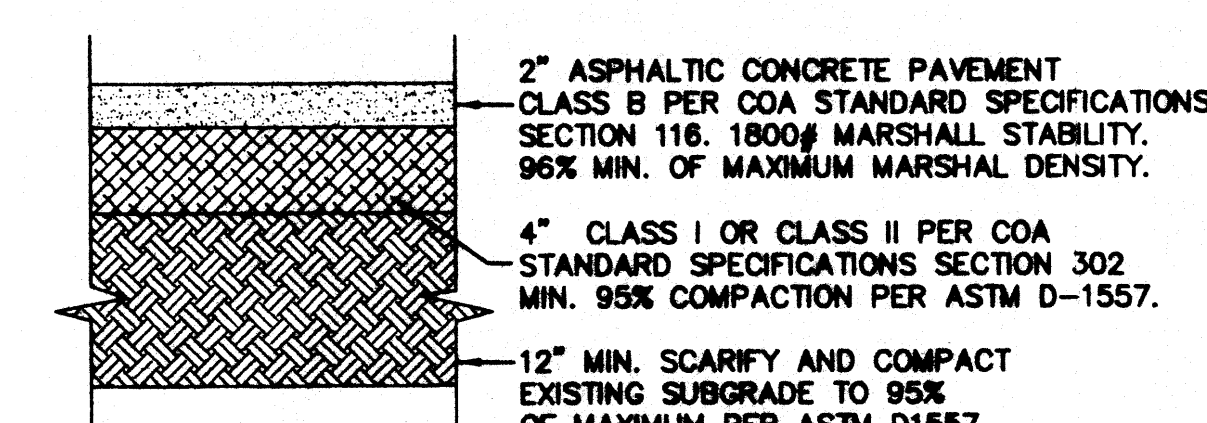

6 ASPHALT PAVEMENT SECTION
C3 N. T. S.

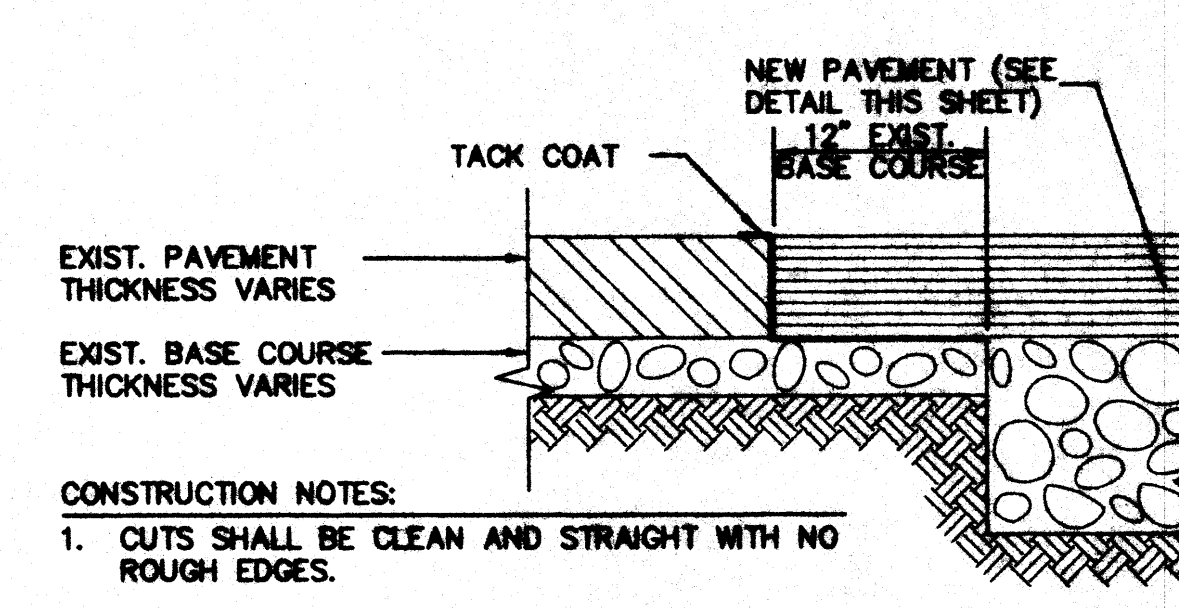

7 PAVEMENT CUT AND PATCH DETAIL
C3 N. T. S.

CIVIL DETAILS

THE JUNCTION

ALBUQUERQUE, NEW MEXICO

RECEIVED
APR 13 2000
HYDROLOGY SECTION

LARRY READ & ASSOCIATES
Civil Engineers
12836-B Lomas Blvd. NE
Albuquerque, New Mexico 87112
(505) 237-8421



REVISION	DATE	DESCRIPTION

FILE NAME: JUNCTION_DT 04/04/00

SHEET C3 of 3