



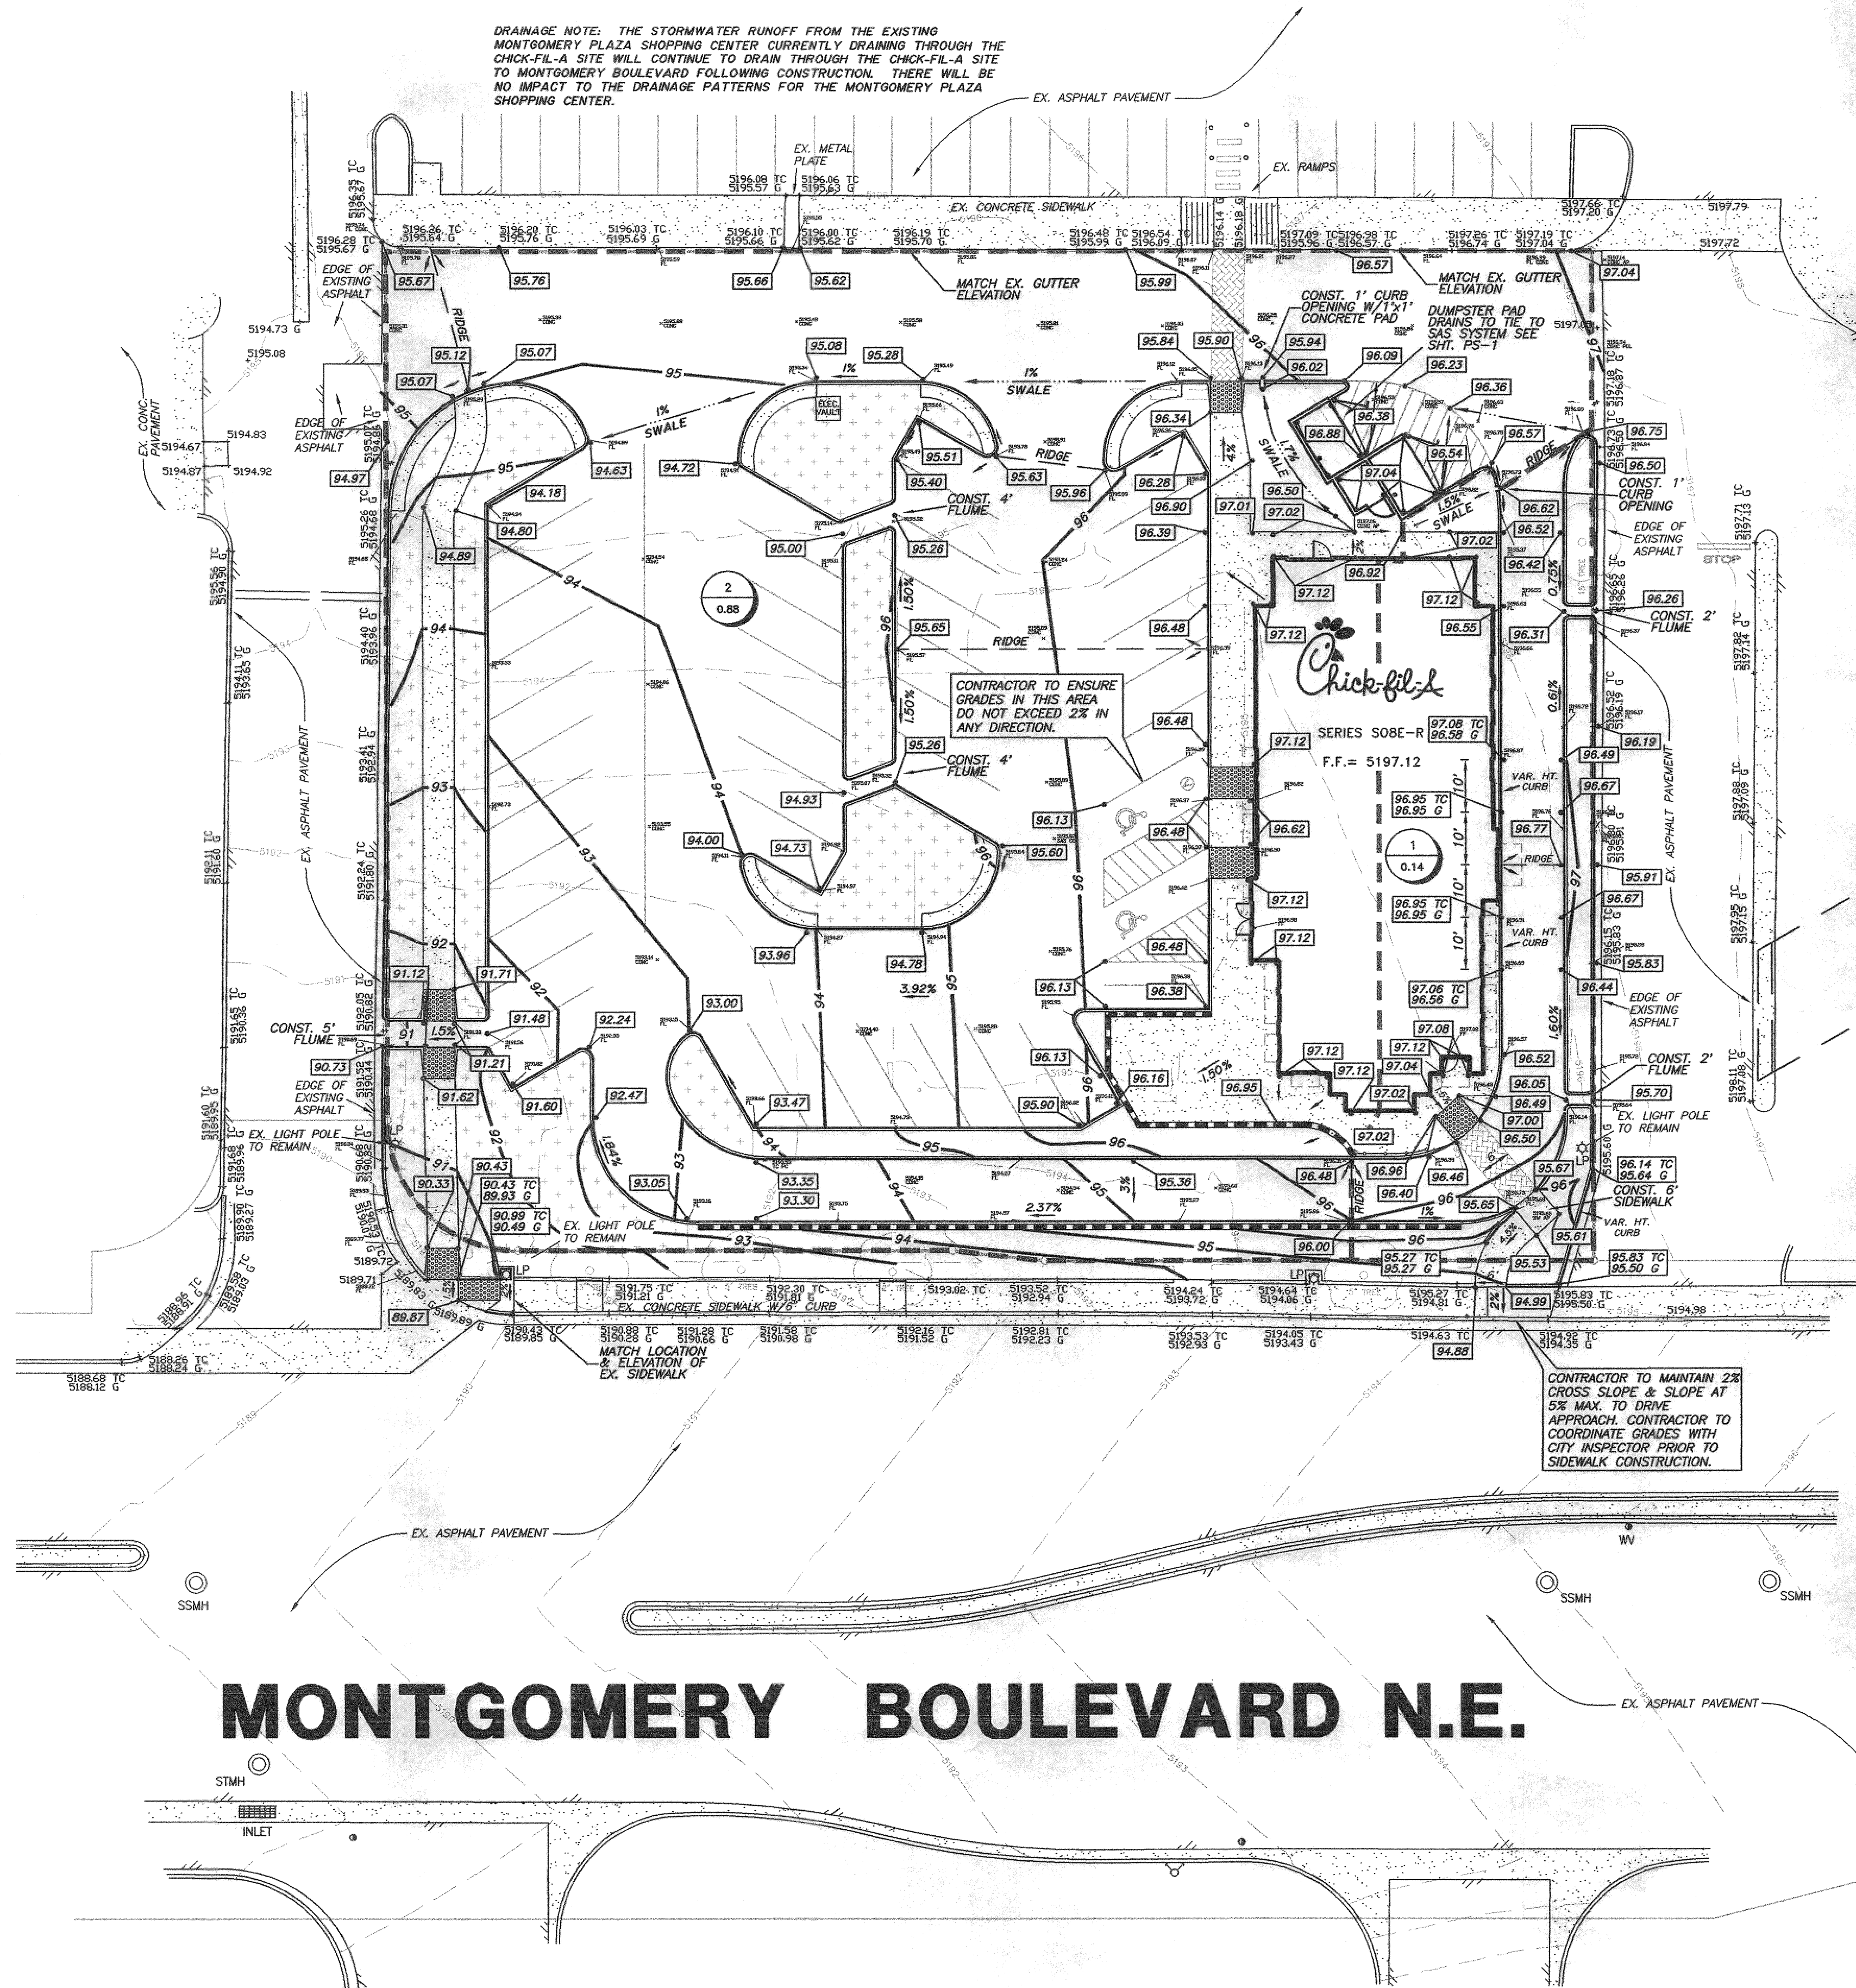

MONTGOMERY BOULEVARD N.E.

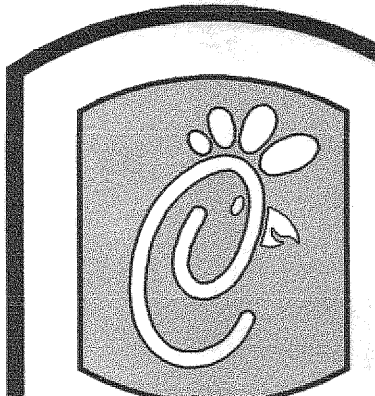

Chick-fil-A

5200 Buffington Rd.
Atlanta Georgia,
30349-2998

Revisions:


Mark Date By



Mark Date By



Mark Date By

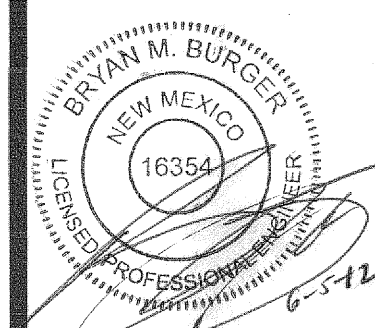

PART OF TRACT D-1
MONTGOMERY PLAZA
5031 MONTGOMERY BOULEVARD, NE
CITY OF ALBUQUERQUE, NEW MEXICO

STORE

SERIES
S08E-R

SHEET TITLE

GRADING &
DRAINAGE
PLAN

☒ Preliminary
☐ 80% Submittal
☐ For Construction

Job No. : 013-007

Store : 2793

Date : 11/18/10

Drawn By : JAC

Checked By: BMB

Sheet

C-4

BURGER
ENGINEERING
Civil Consultants

17103 Preston Road, Suite 180N
Dallas, Texas 75248
Office: 972.630.3360 Fax: 972.630.3380