


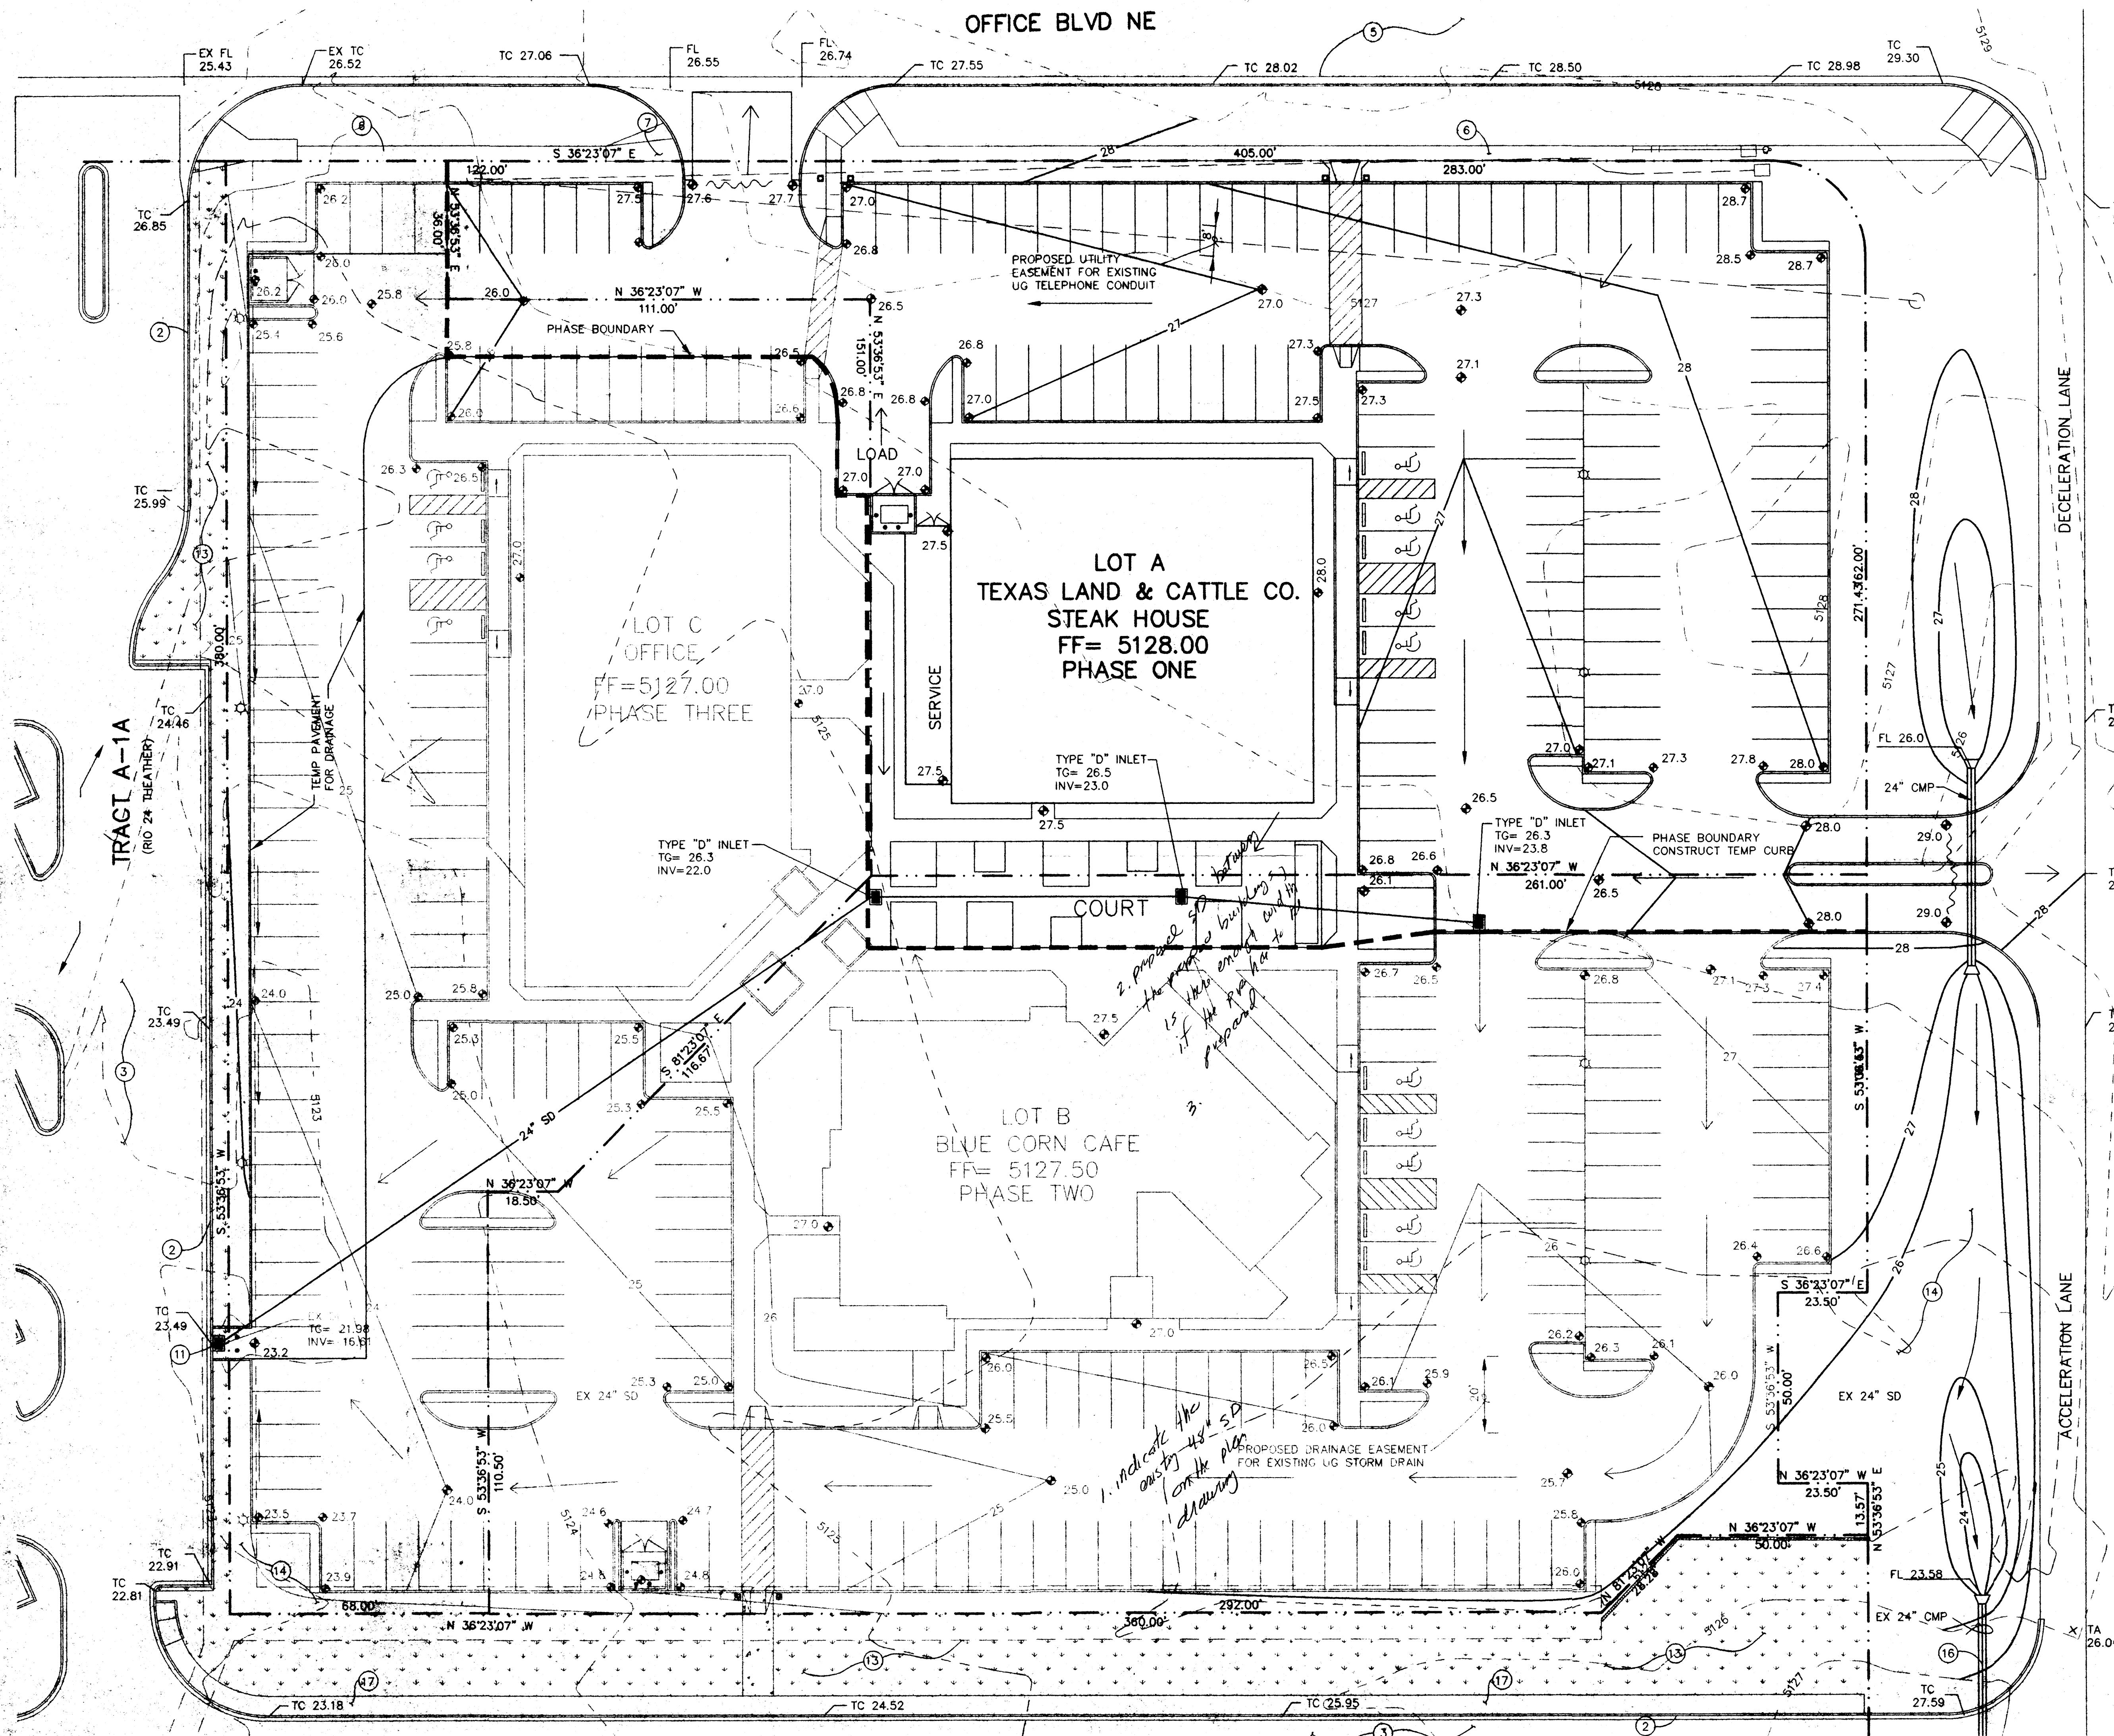

LEGEND

- 6001 — EXISTING CONTOUR ELEVATION
- 02.5 x — EXISTING SPOT ELEVATION
- 01 — PROPOSED CONTOUR ELEVATION
- — — — — PROPERTY LINE
- 01.5 ♦ — PROPOSED SPOT ELEVATION
- ← — DIRECTION OF FLOW
- — — — — DRAINAGE SWALE
- - - - - DRAINAGE BASIN DIVIDE

LEGAL DESCRIPTION

TRACT A-1B CRYER PROPERTY

ADDRESS



WEST PAN AMERICAN FREEWAY

SURVEY

TOPOGRAPHY BY BRASHER & LORENZ, INC.
DATED AUGUST 1997

KEYED NOTES

- 6" CONCRETE CURB
- EXISTING CONCRETE CURB
- EXISTING ASPHALT PAVEMENT
- ASPHALT PAVEMENT IMPROVEMENTS TO OFFICE BLVD.
- 6" SIDEWALK
- HANDICAP RAMP
- ACCESSIBLE WAY (5' WIDE)
- PLANTER
- REFUSE ENCLOSURE SEE SHT C-2
- EXISTING INLET
- TYPE DBL '0' INLET
- EXISTING LANDSCAPING
- LANDSCAPING - SEE SHT L-1
- 24" CULVERT PIPE SEE SHT C-5
- EXISTING CULVERT PIPE
- EXISTING 4' SIDEWALK

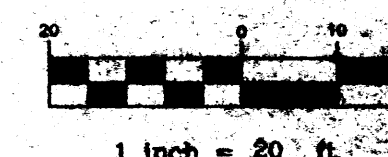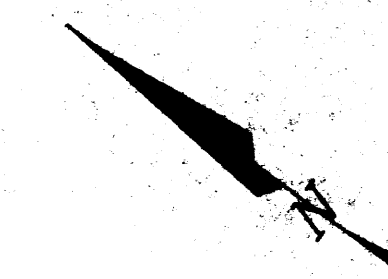

BRASHER & LORENZ, INC.
Consulting Engineers
2201 San Pedro NE Building 4 Suite 210
Albuquerque, New Mexico 87110
Ph. 505-883-6088 Fax 505-888-6188




TEXAS LAND & CATTLE COMPANY
STEAK HOUSE
ALBUQUERQUE, NEW MEXICO

GRADING AND
DRAINAGE PLAN

REVISIONS:

CHECKED BY:
D.A.L.
DRAWN BY:
M.D.T.
JOB NO:
7040
FILE NO:
7040-GDG.DWG
SHEET NO:

G-5

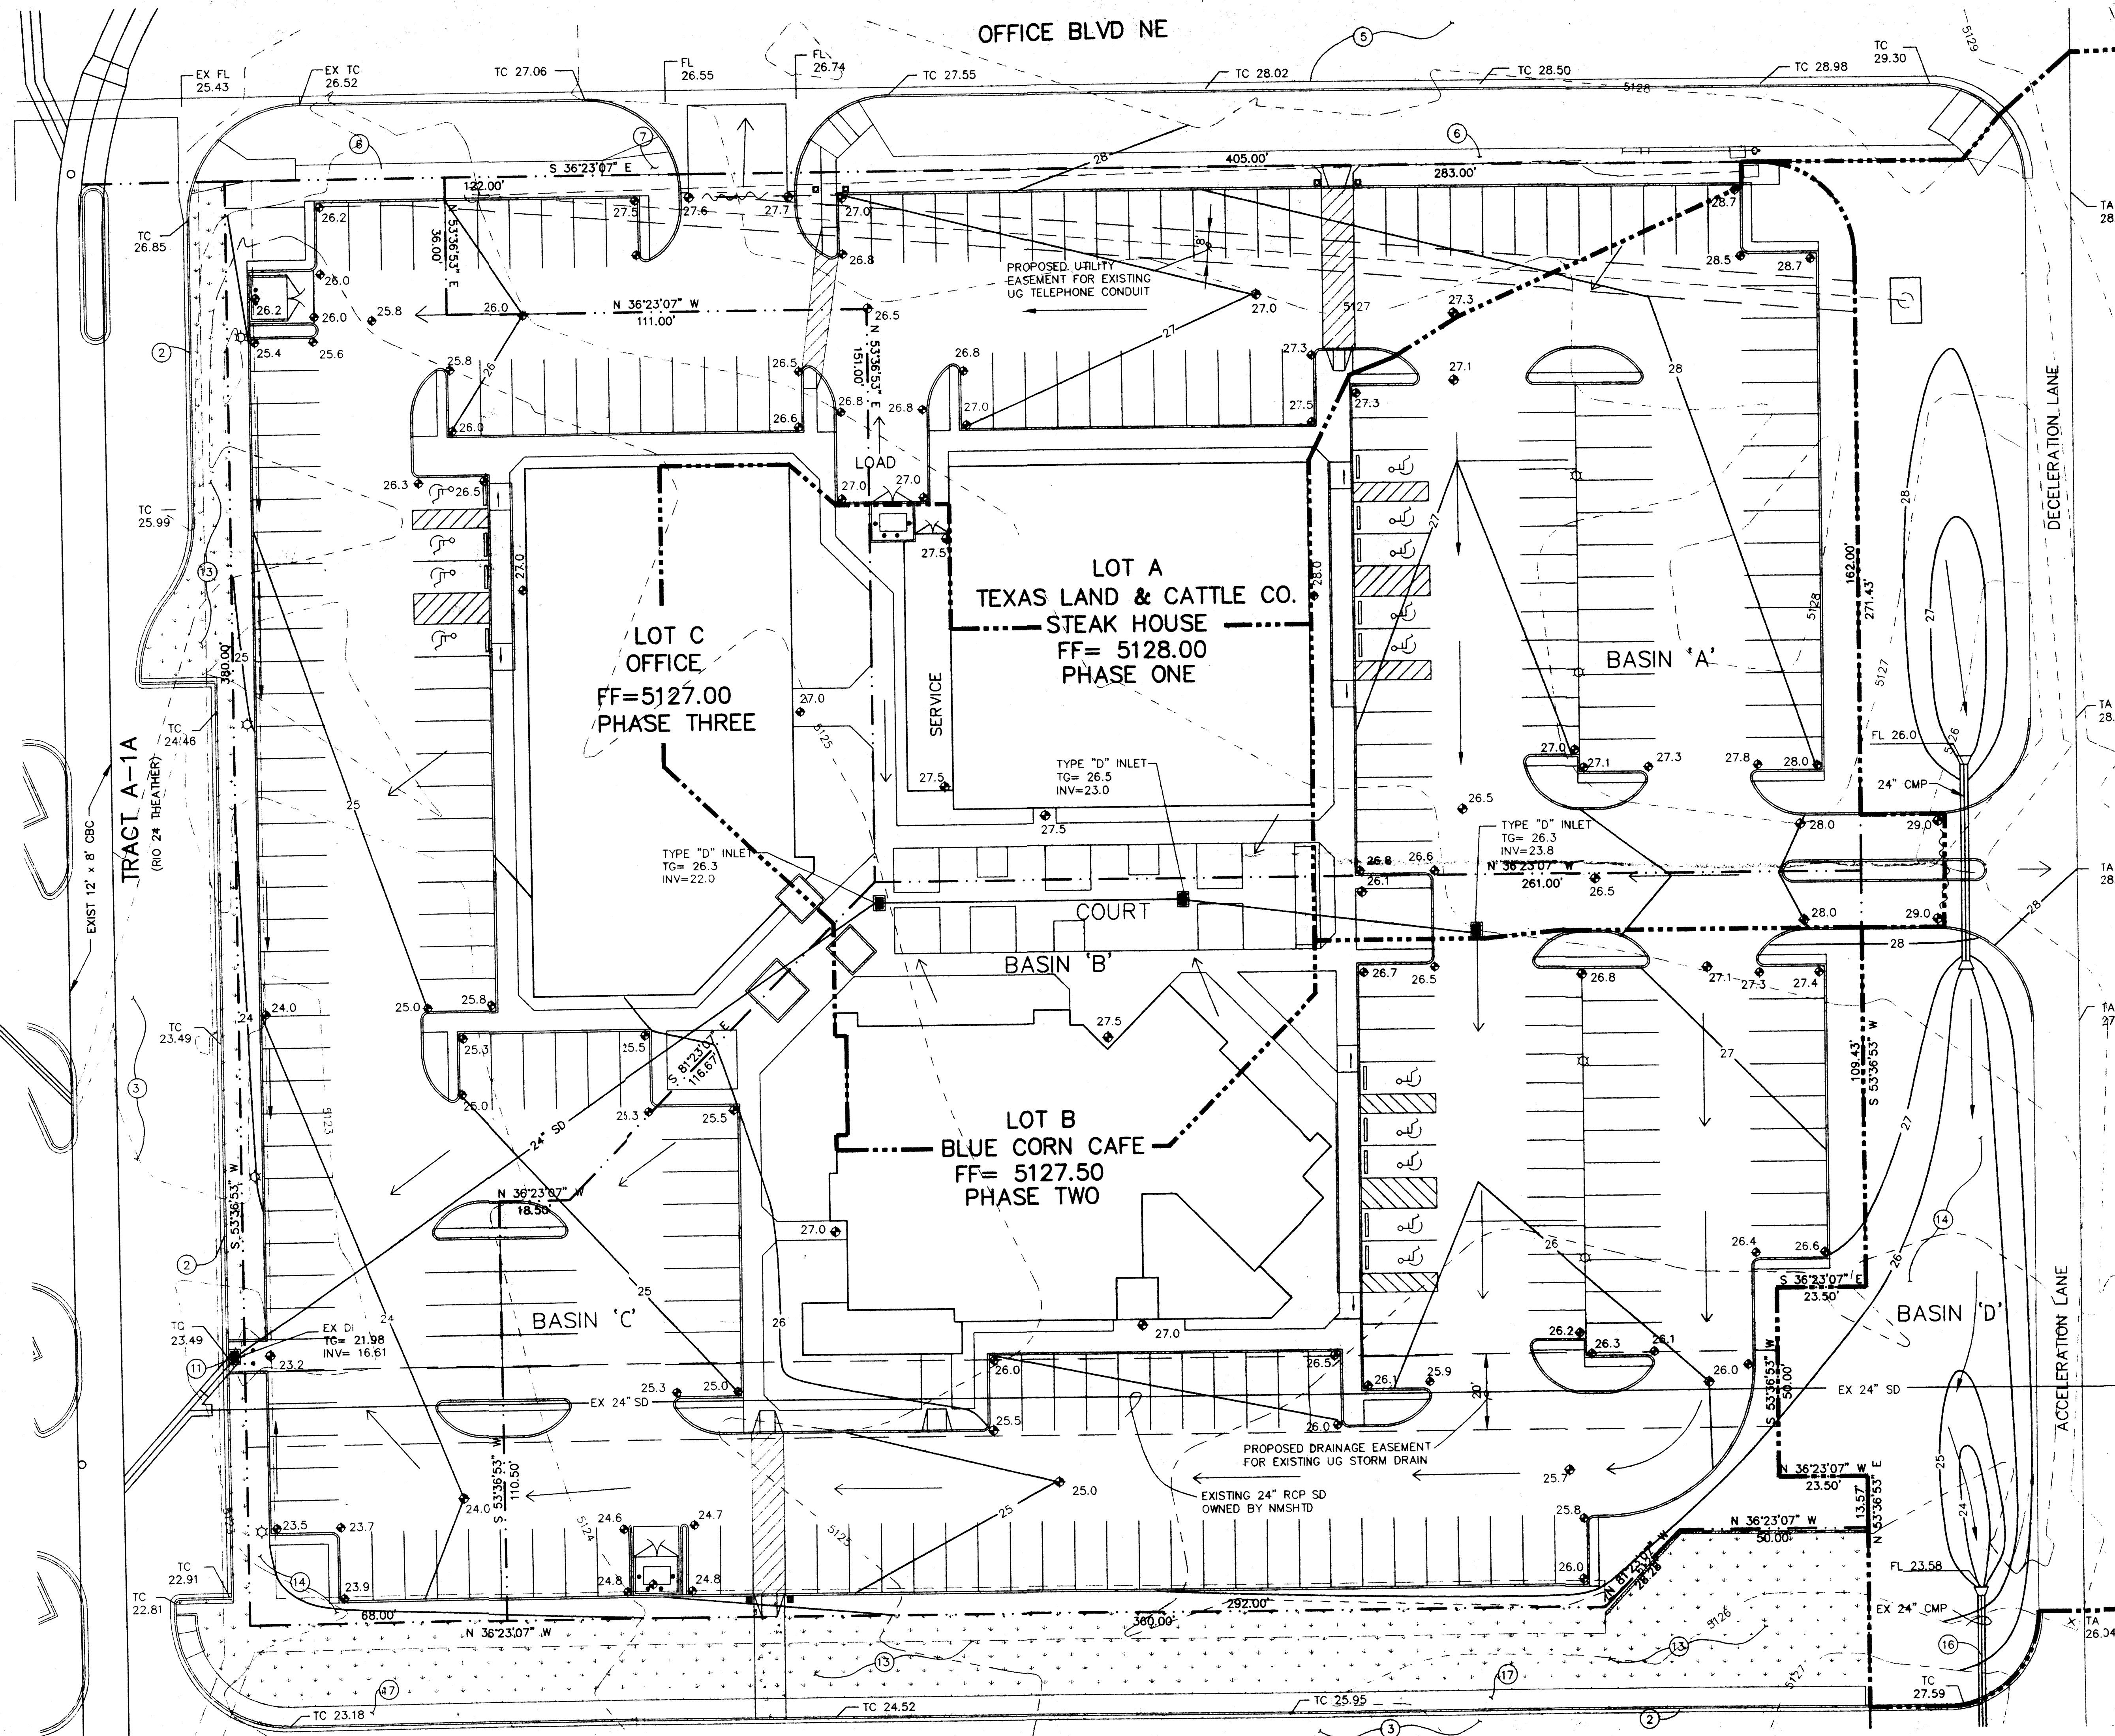

LEGEND

- 6001 — EXISTING CONTOUR ELEVATION
- 02.5 x — EXISTING SPOT ELEVATION
- 01 — PROPOSED CONTOUR ELEVATION
- ... — PROPERTY LINE
- 01.5 — PROPOSED SPOT ELEVATION
- ← — DIRECTION OF FLOW
- — DRAINAGE SWALE
- - - DRAINAGE BASIN DIVIDE

LEGAL DESCRIPTION

TRACT A-1B CRYER PROPERTY

ADDRESS



WEST PAN AMERICAN FREEWAY

SURVEY

TOPOGRAPHY BY BRASHER & LORENZ INC.
DATED AUGUST 1997

KEYED NOTES

- 6" CONCRETE CURB
- EXISTING CONCRETE CURB
- EXISTING ASPHALT PAVEMENT
- ASPHALT PAVEMENT
- IMPROVEMENTS TO OFFICE BLVD.
- 6" SIDEWALK
- HANDICAP RAMP
- ACCESSIBLE WAY (5' WIDE)
- PLANTER
- REFUSE ENCLOSURE SEE SHT C-2
- EXISTING INLET
- TYPE DBL "D" INLET
- EXISTING LANDSCAPING
- LANDSCAPING - SEE SHT L-1
- 24" CULVERT PIPE SEE SHT C-5
- EXISTING CULVERT PIPE
- EXISTING 4" SIDEWALK

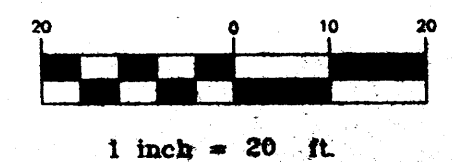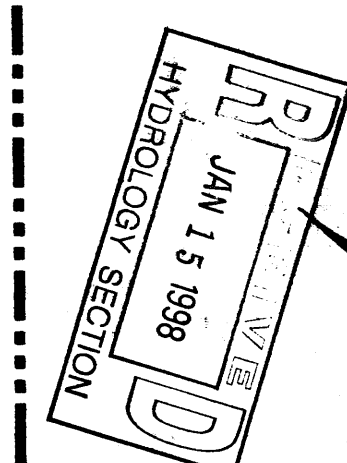

BRASHER & LORENZ, INC.
Consulting Engineers
2201 San Pedro NE Building 1 Suite 210
Albuquerque, New Mexico 87110
Ph: 505-888-6088 Fax: 505-888-6188

BLI

★

TEXAS LAND & CATTLE COMPANY
STEAK HOUSE

★

ALBUQUERQUE, NEW MEXICO


★

GRADING AND
DRAINAGE PLAN

★

REVISIONS:

CHECKED BY:	D.A.L.
DRAWN BY:	M.D.T.
JOB NO:	7040
FILE NO:	7040-GD.DWG
SHEET NO:	C-2

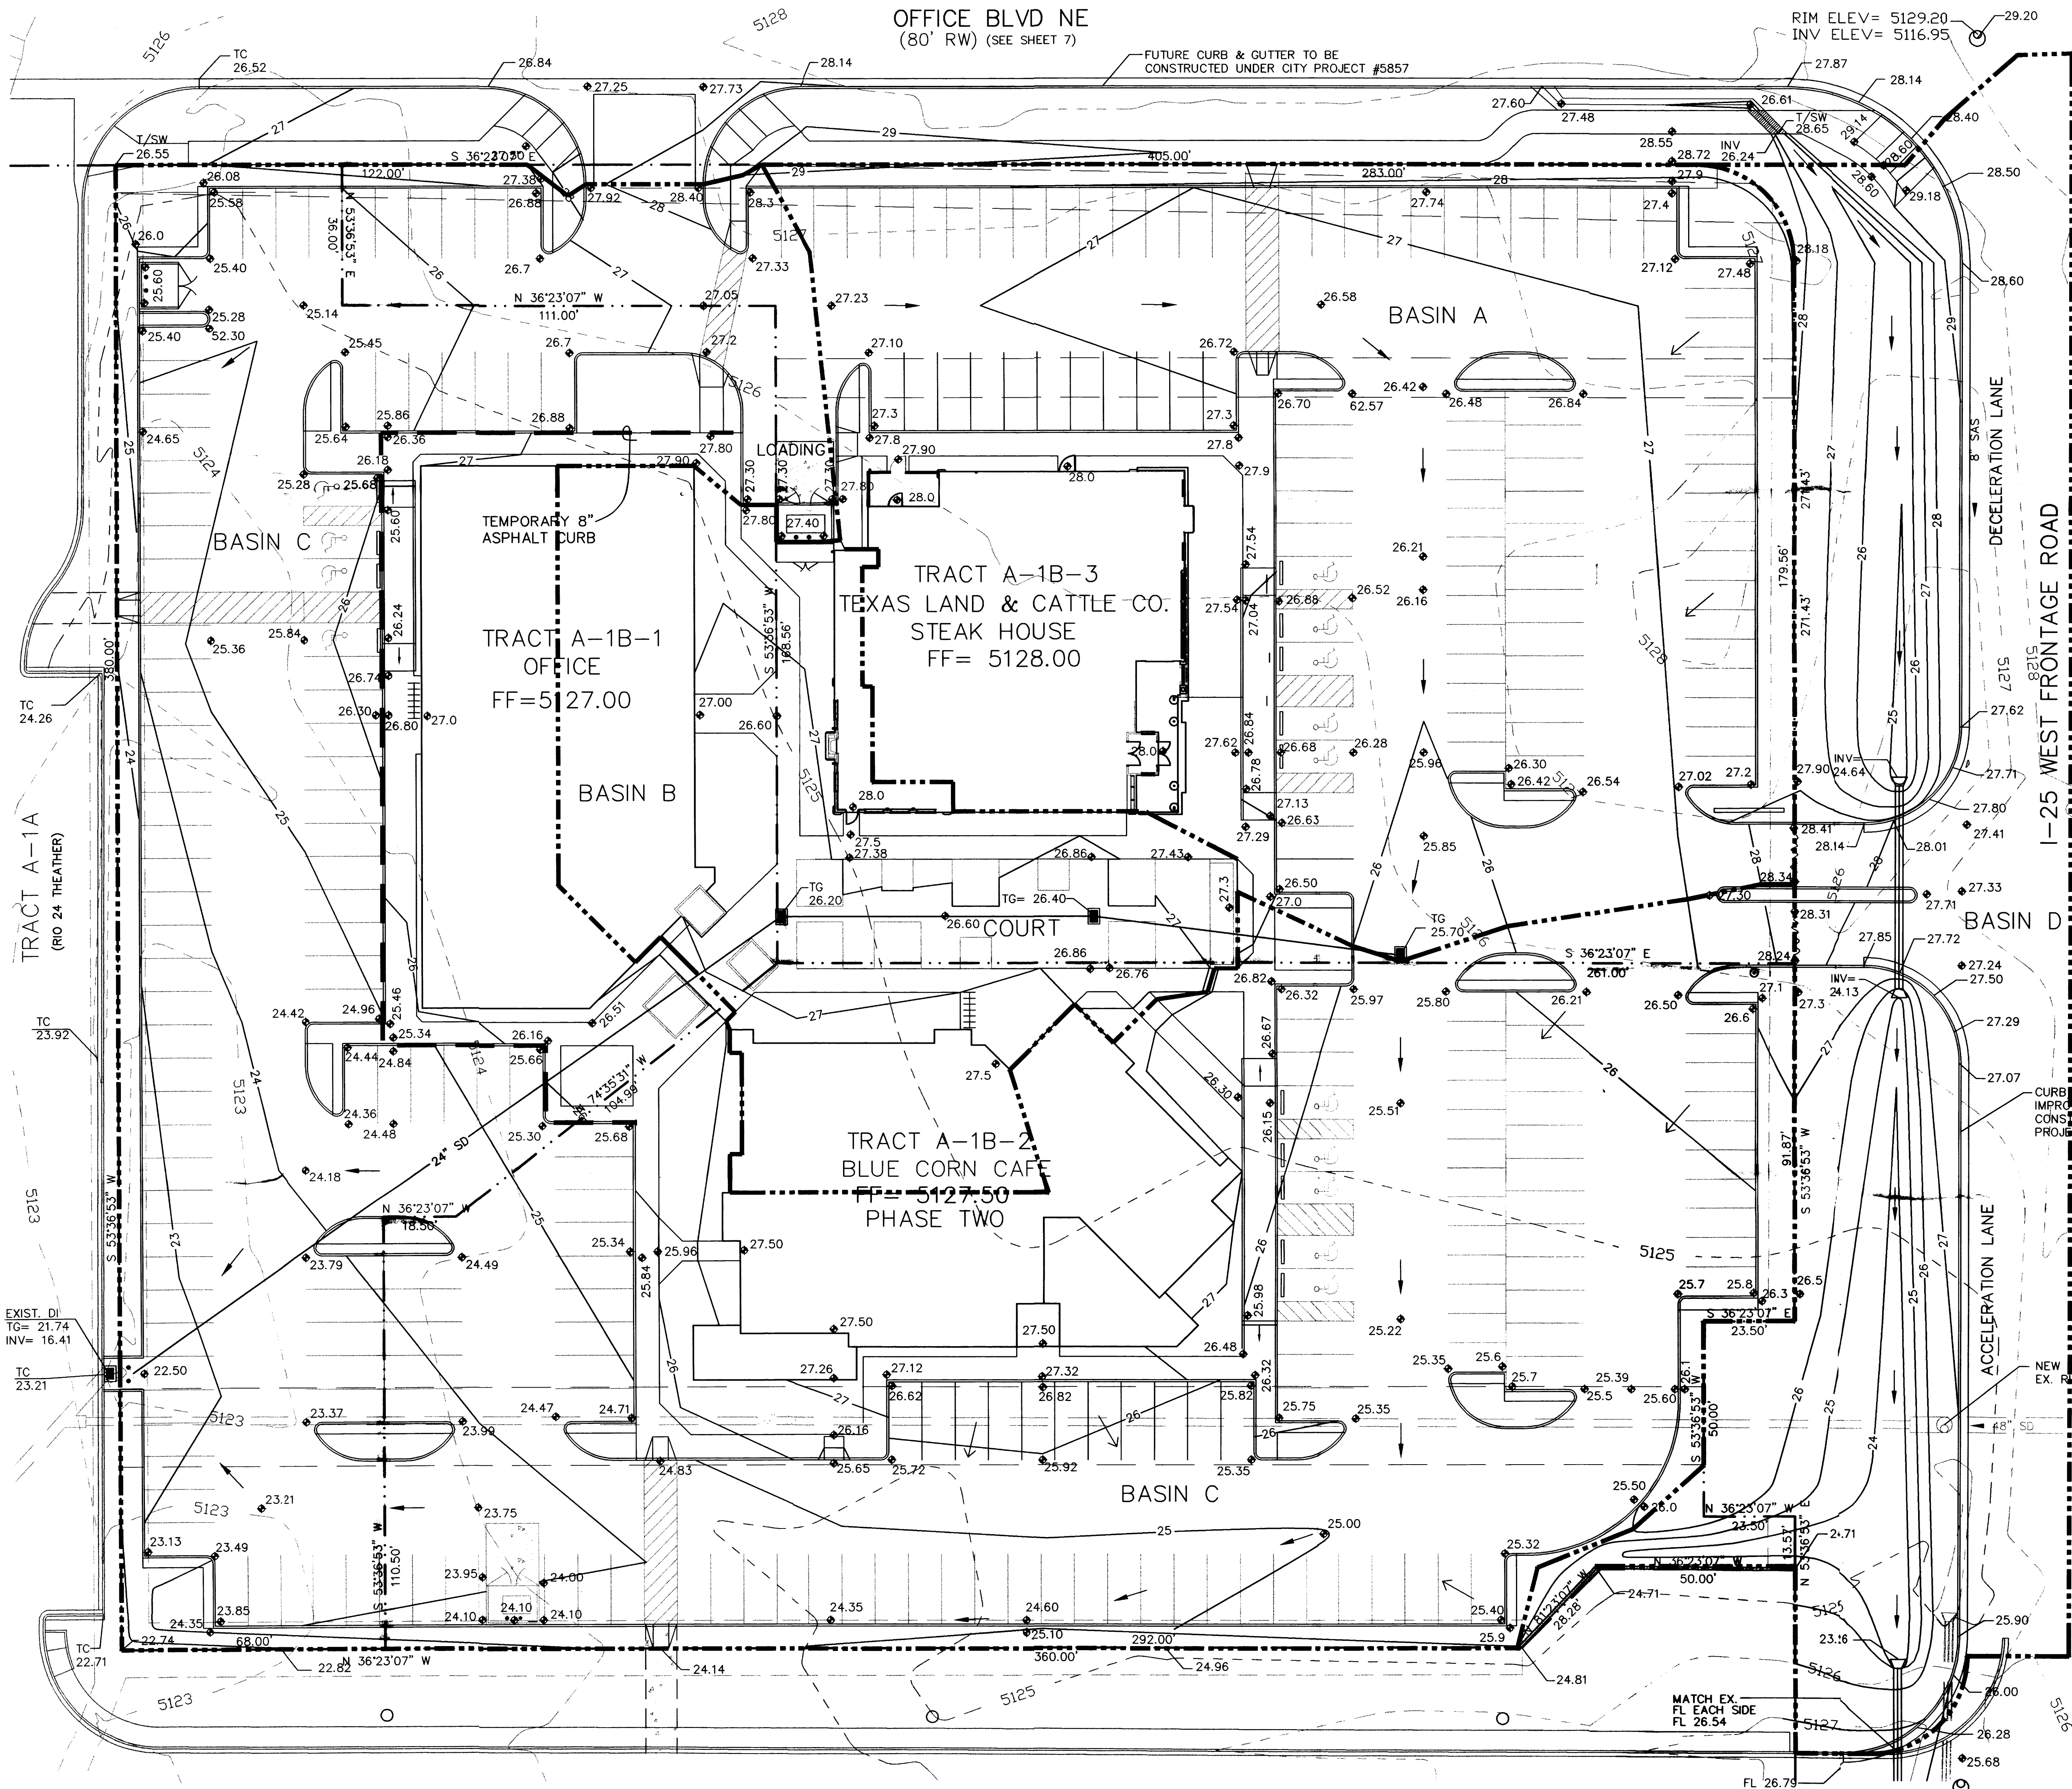


- LEGEND**
- 6001 — EXISTING CONTOUR ELEVATION
 - 02.5 x — EXISTING SPOT ELEVATION
 - 01 — PROPOSED CONTOUR ELEVATION
 - — — — — PROPERTY LINE
 - 01.5 — PROPOSED SPOT ELEVATION
 - ← — DIRECTION OF FLOW
 - — — — — DRAINAGE SWALE
 - — — — — DRAINAGE BASIN DIVIDE

LEGAL DESCRIPTION
TRACT A-1B CRYER PROPERTY

ADDRESS
WEST PAN AMERICAN FREEWAY

SURVEY
TOPOGRAPHY BY BRASHER & LORENZ INC.
DATED AUGUST 1997

- KEYED NOTES**
- 6" CONCRETE CURB
 - EXISTING CONCRETE CURB
 - EXISTING ASPHALT PAVEMENT
 - ASPHALT PAVEMENT
 - IMPROVEMENTS TO OFFICE BLVD.
 - 6" SIDEWALK
 - HANDICAP RAMP
 - ACCESSIBLE WAY (5' WIDE)
 - PLANTER
 - REFUSE ENCLOSURE SEE SHT C-2
 - EXISTING INLET
 - TYPE DBL 'D' INLET
 - EXISTING LANDSCAPING
 - LANDSCAPING- SEE SHT L-1
 - 24" CULVERT PIPE SEE SHT C-5
 - EXISTING CULVERT PIPE
 - EXISTING 4' SIDEWALK
 - BICYCLE RACK

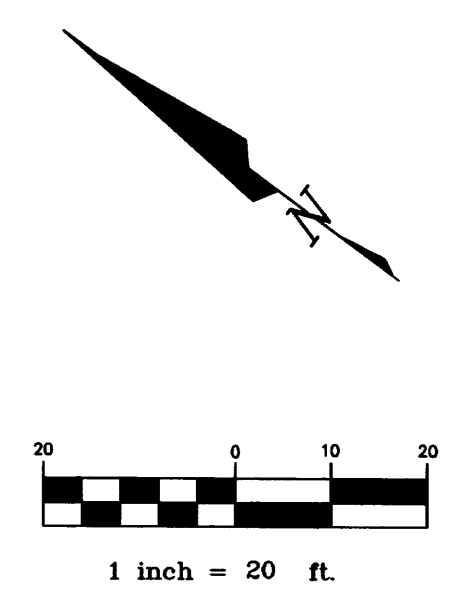

BRASHER & LORENZ, INC.
Consulting Engineers
2201 San Pedro NE Building 1 Suite 210
Albuquerque, New Mexico 87110
Ph: 505-888-6088 Fax: 505-888-6188

BLI


PAUL T. BRASHER
NEW MEXICO
17282
REGISTERED PROFESSIONAL ENGINEER

TEXAS LAND & CATTLE COMPANY
STEAK HOUSE
ALBUQUERQUE, NEW MEXICO

GRADING AND DRAINAGE PLAN

REVISIONS:

CHECKED BY:	D.A.L.
DRAWN BY:	M.D.T.
JOB NO:	7040
FILE NO:	7040G20.DWG
SHEET NO:	C-5

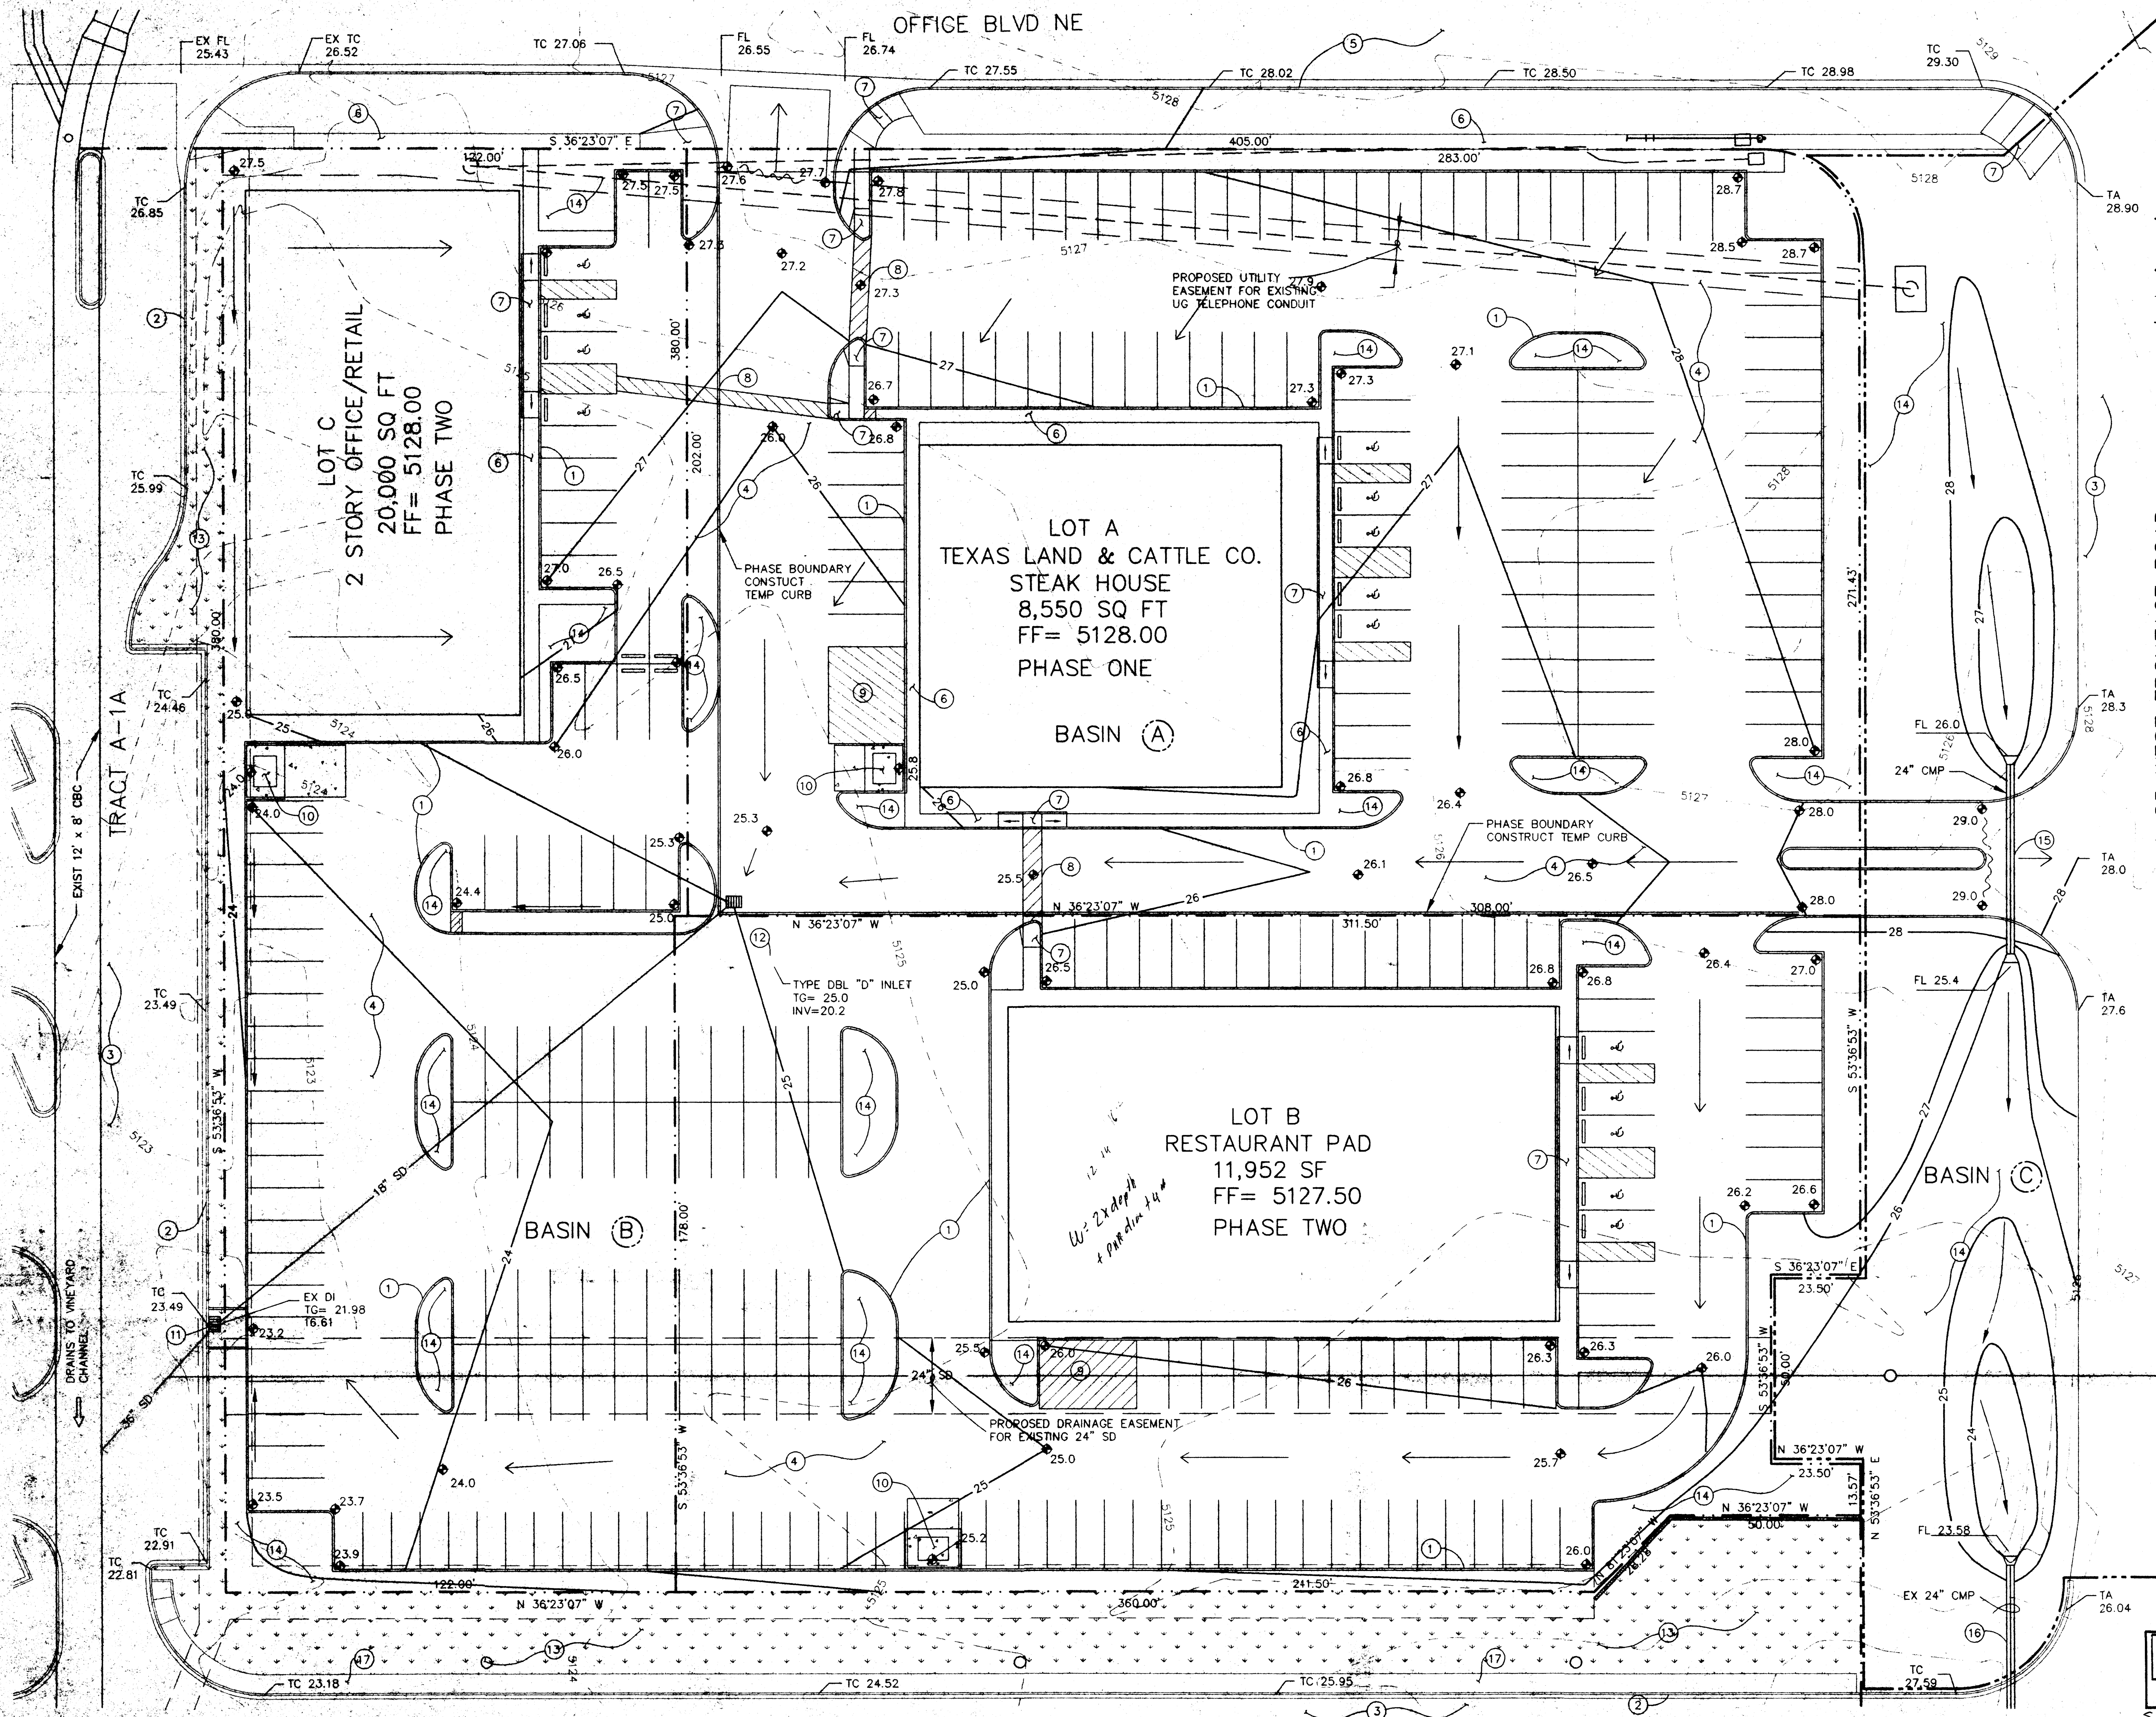

LEGEND

- 6001 — EXISTING CONTOUR ELEVATION
- 02.5 x — EXISTING SPOT ELEVATION
- 01 — PROPOSED CONTOUR ELEVATION
- — — — — PROPERTY LINE
- 01.5 — PROPOSED SPOT ELEVATION
- — — — — DIRECTION OF FLOW
- — — — — DRAINAGE SWALE
- — — — — DRAINAGE BASIN DIVIDE

LEGAL DESCRIPTION

TRACT A-1B CRYER PROPERTY

ADDRESS

WEST PAN AMERICAN FREEWAY


SURVEY

TOPOGRAPHY BY BRASHER & LORENZ INC.
DATED AUGUST 1997

KEYED NOTES

- 6" CONCRETE CURB
- EXISTING CONCRETE CURB
- EXISTING ASPHALT PAVEMENT
- ASPHALT PAVEMENT
- IMPROVEMENTS TO OFFICE BLVD.
- 4' SIDEWALK
- HANDICAP RAMP
- ACCESSIBLE WAY (5' WIDE)
- LOADING ZONE
- REFUSE ENCLOSURE SEE SHT C-2
- EXISTING INLET
- TYPE DBL "D" INLET
- EXISTING LANDSCAPING
- LANDSCAPING - SEE SHT L-1
- 24" CULVERT PIPE SEE SHT C-5
- EXISTING CULVERT PIPE
- EXISTING 4' SIDEWALK

- Phasing plan identify phases
- Plot will need to identify cross-street drainage
- What is the existing 4" SD drainage and was it built who does it belong to and was it built in standards?
- Please identify on a table your results from the flow meter for the existing proposed flow rates and volume
- Determine the proposed drainage drainage to the existing 24" S.D. on the

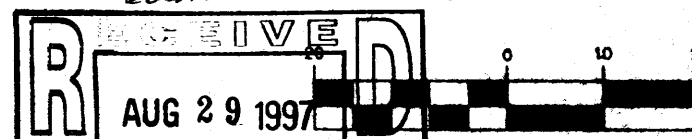

HYDROLOGY SECTION

5 Evaluate what the easement required for underground storm sewer is for the proposed easement. Existing 24" R 4' S.D.

BRASHER & LORENZ, INC.
Consulting Engineers
2201 San Pedro NE Building 1 Suite 210
Albuquerque, New Mexico 87110
Ph: 505-888-6088 Fax: 505-888-6188


BLI
BRASHER & LORENZ, INC.
REGISTERED PROFESSIONAL ENGINEERS
STATE OF NEW MEXICO
8-28-97

★
TEXAS LAND & CATTLE COMPANY
★
STEAK HOUSE
ALBUQUERQUE, NEW MEXICO

CONCEPTUAL
GRADING AND
DRAINAGE PLAN

REVISIONS:

DATE:	8/97
CHECKED BY:	D.A.L.
DRAWN BY:	M.D.T.
JOB NO:	7040
FILE NO:	7040-GD.DWG
SHEET NO:	C-5

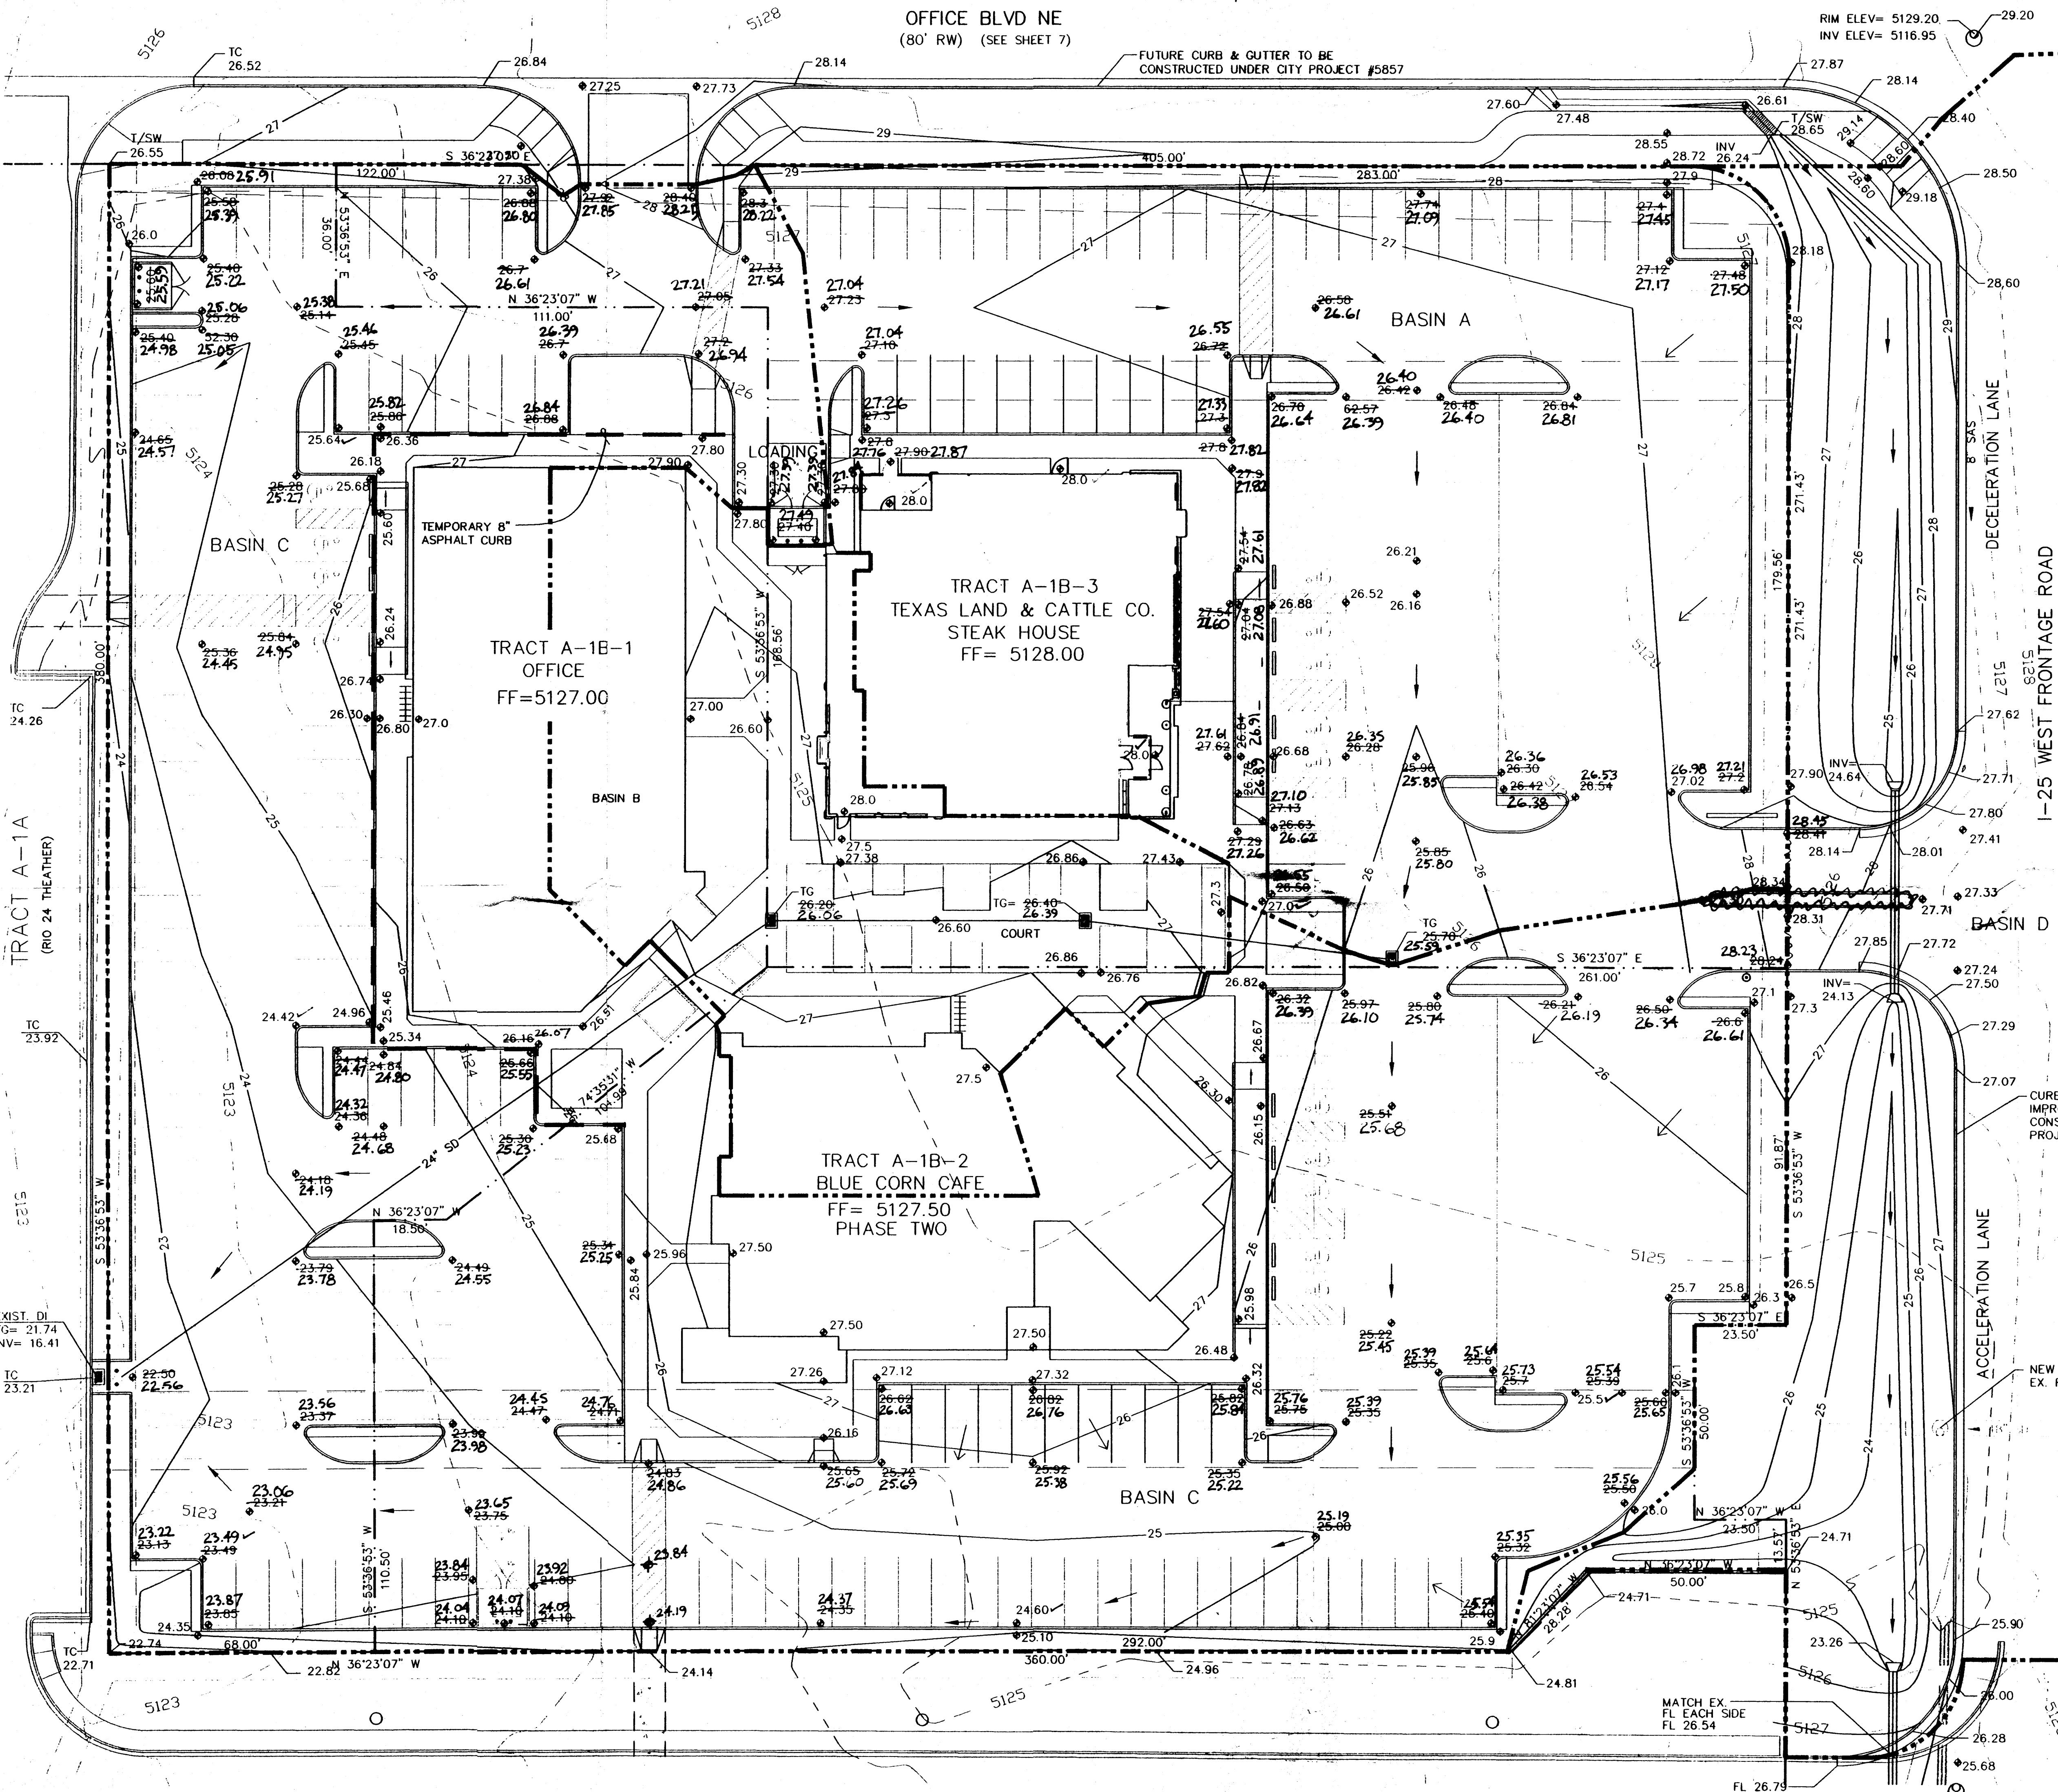

LEGEND

- 6001 — EXISTING CONTOUR ELEVATION
- 02.5 x — EXISTING SPOT ELEVATION
- 01 — PROPOSED CONTOUR ELEVATION
- — — — — PROPERTY LINE
- 01.5 — PROPOSED SPOT ELEVATION
- ← — DIRECTION OF FLOW
- — — — — DRAINAGE SWALE
- — — — — DRAINAGE BASIN DIVIDE
- 01.52 — AS-BUILT ELEVATION
- 01.56 — AS-BUILT ELEVATION

ENGINEER'S CERTIFICATION

I, the undersigned, being a Professional Engineer in the State of New Mexico, do hereby certify that this drawing was prepared by me or under my supervision, and that the as-built information shown hereon is based on actual field measurements and inspections performed by Brasher & Lorenz, Inc. I further certify that the as-built condition of the site is in substantial compliance with the approved Grading and Drainage Plan prepared by Brasher & Lorenz, Inc., with the following exceptions, which must be completed per plan prior to issuance of final Certificate of Occupancy:

1. Corrected existing grading improvements.
Paul T. Brasher
Professional Engineer
10-15-10
Date

LEGAL DESCRIPTION

TRACT A-1B CRYER PROPERTY

ADDRESS



WEST PAN AMERICAN FREEWAY

SURVEY

TOPOGRAPHY BY BRASHER & LORENZ INC.
DATED AUGUST 1997

KEYED NOTES

- 6" CONCRETE CURB
- EXISTING CONCRETE CURB
- EXISTING ASPHALT PAVEMENT
- ASPHALT PAVEMENT
- IMPROVEMENTS TO OFFICE BLVD.
- 6" SIDEWALK
- HANDICAP RAMP
- ACCESSIBLE WAY (5' WIDE)
- PLANTER
- REFUSE ENCLOSURE SEE SHT C-2
- EXISTING INLET
- TYPE DBL 'D' INLET
- EXISTING LANDSCAPING
- LANDSCAPING- SEE SHT L-1
- 24" CULVERT PIPE SEE SHT C-5
- EXISTING CULVERT PIPE
- EXISTING 4' SIDEWALK
- BICYCLE RACK

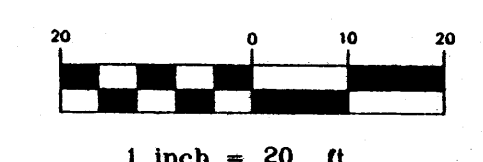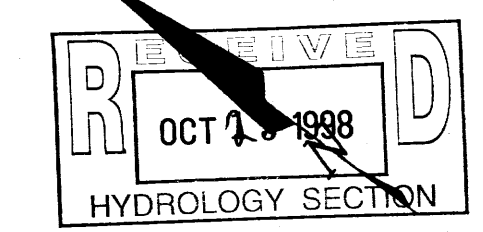

BRASHER & LORENZ, INC.
Consulting Engineers
2201 San Pedro NE Building 1 Suite 210
Albuquerque, New Mexico 87110
Ph: 505-888-6088 Fax: 505-888-6188

BLI


REGISTERED PROFESSIONAL ENGINEER
NEW MEXICO
PAUL T. BRASHER
7286
10-15-10

★ **TEXAS LAND & CATTLE COMPANY** ★
STEAK HOUSE
ALBUQUERQUE, NEW MEXICO


★ **GRADING AND DRAINAGE PLAN**

REVISIONS:

CHECKED BY:	D.A.L.
DRAWN BY:	M.D.T.
JOB NO:	7040
FILE NO:	7040G20.DWG
SHEET NO:	C-5

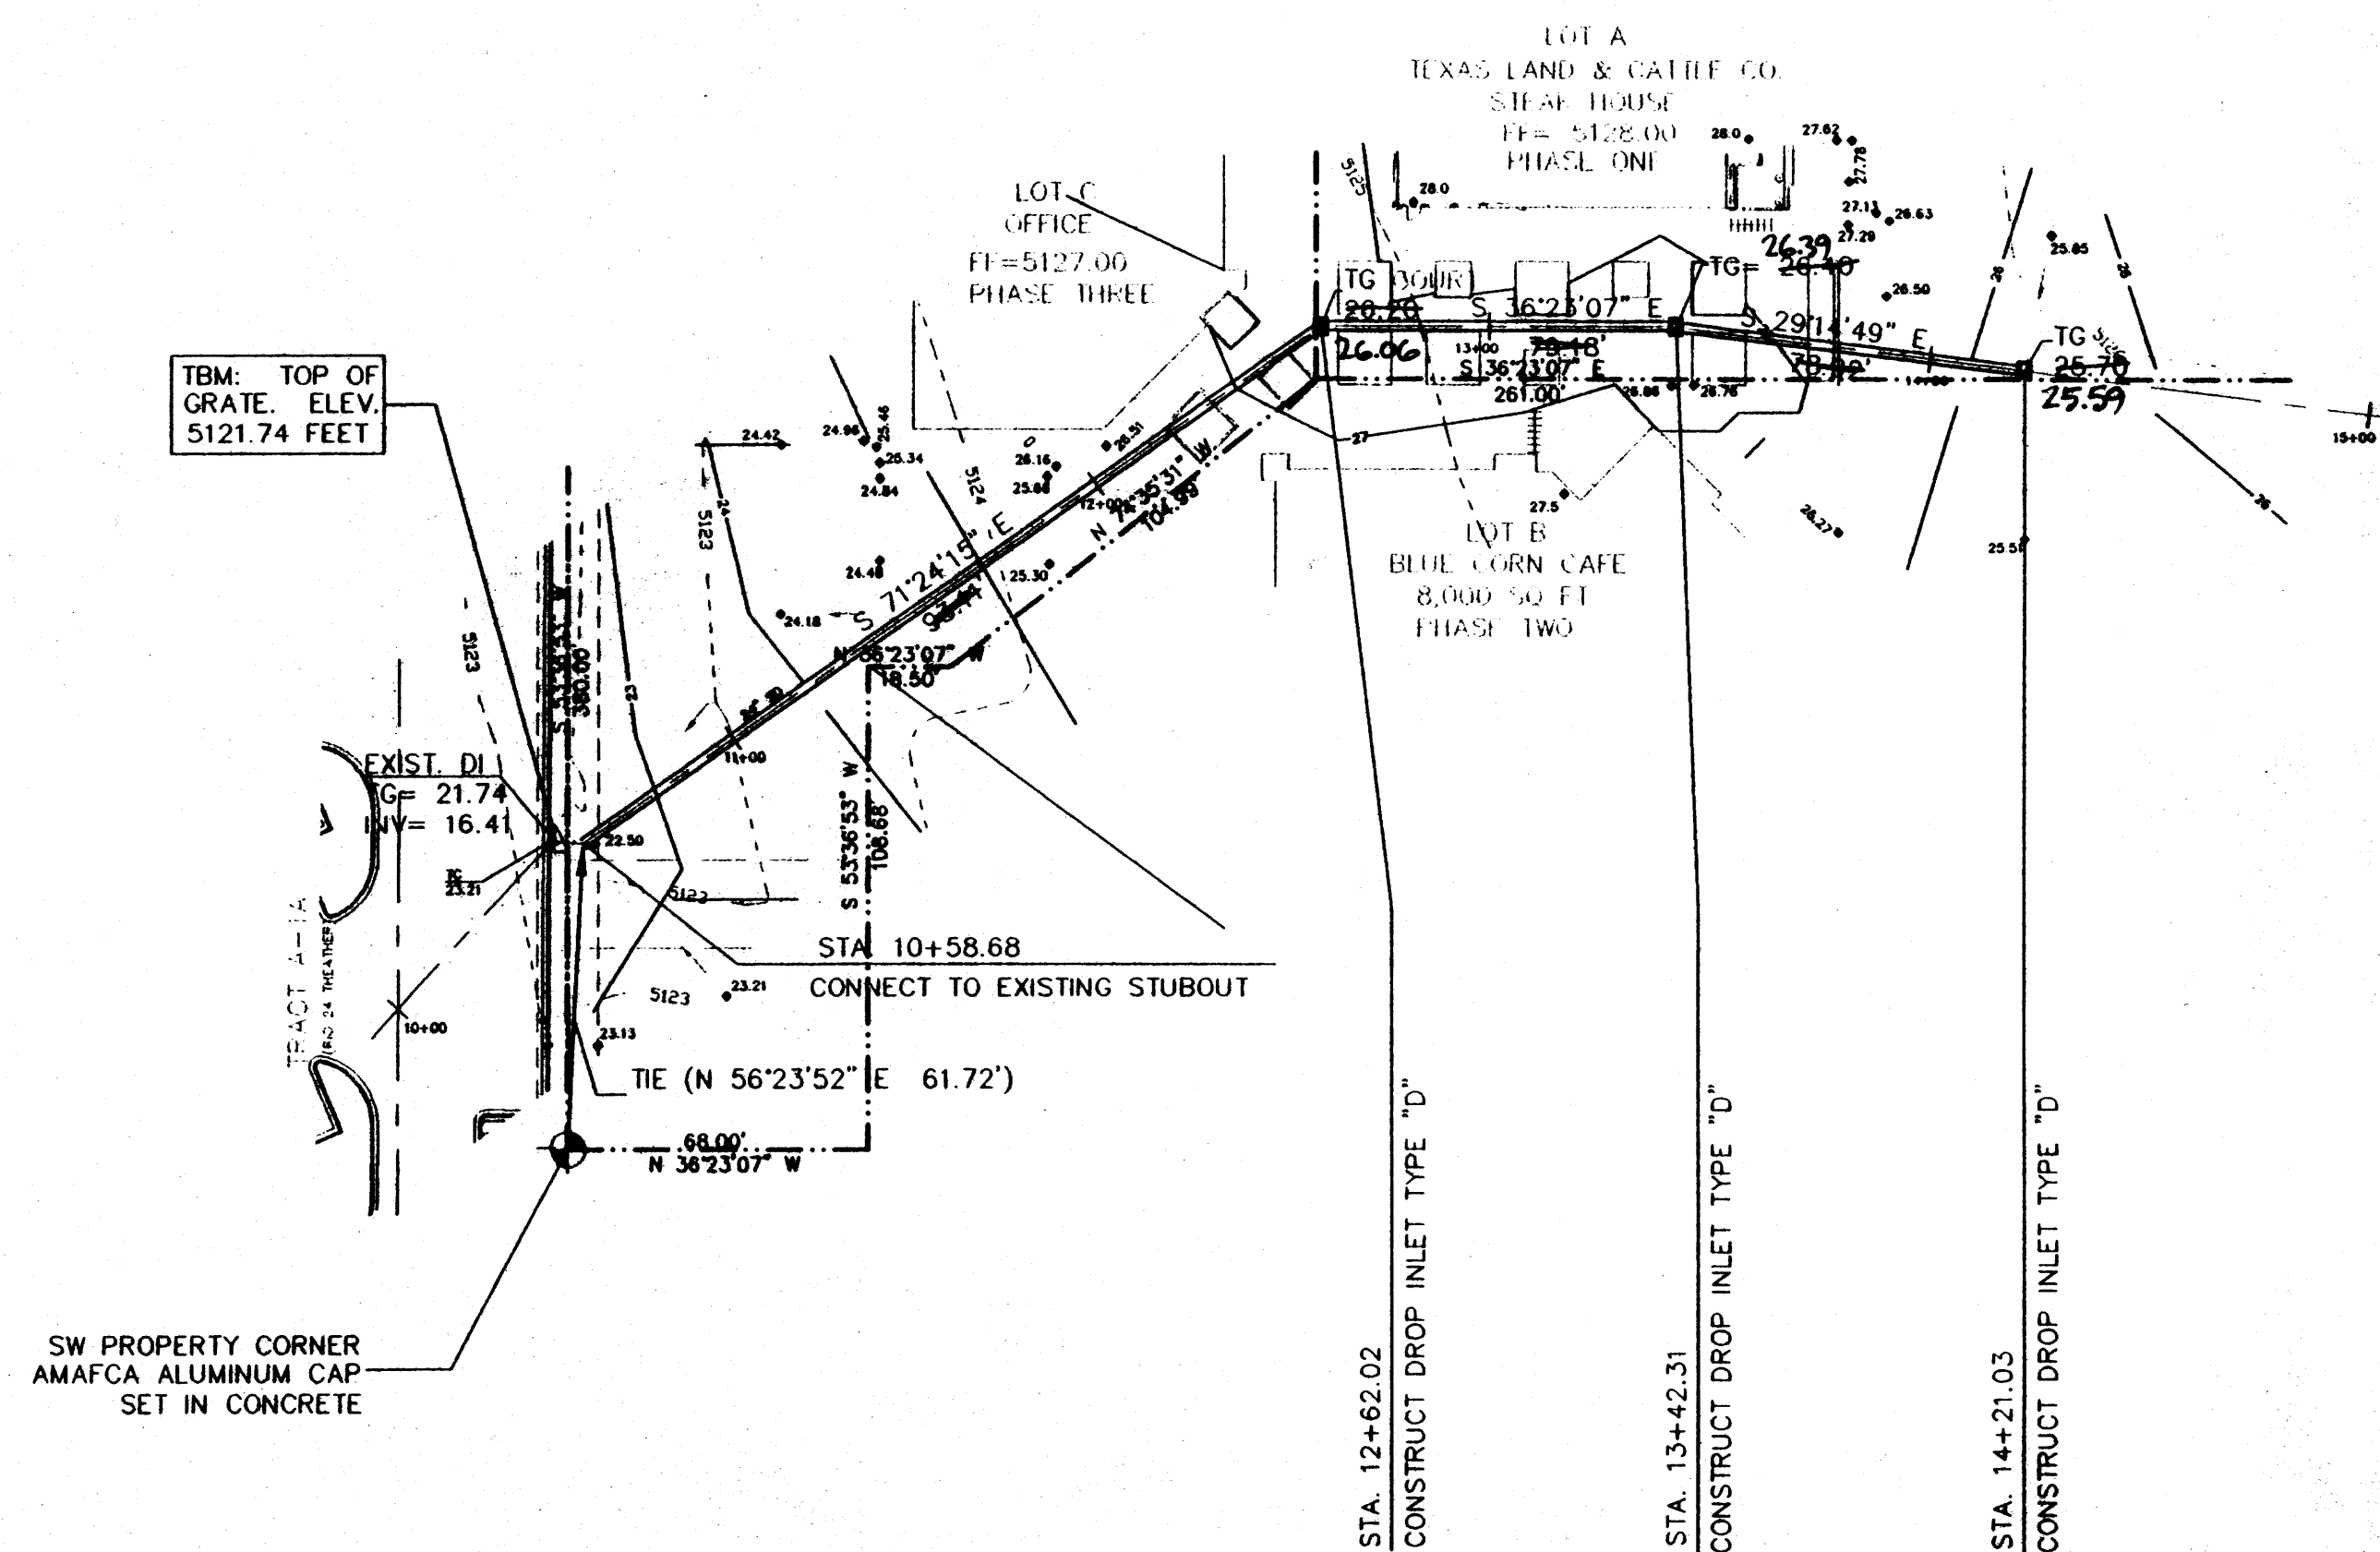

PRIVATE STORM DRAIN

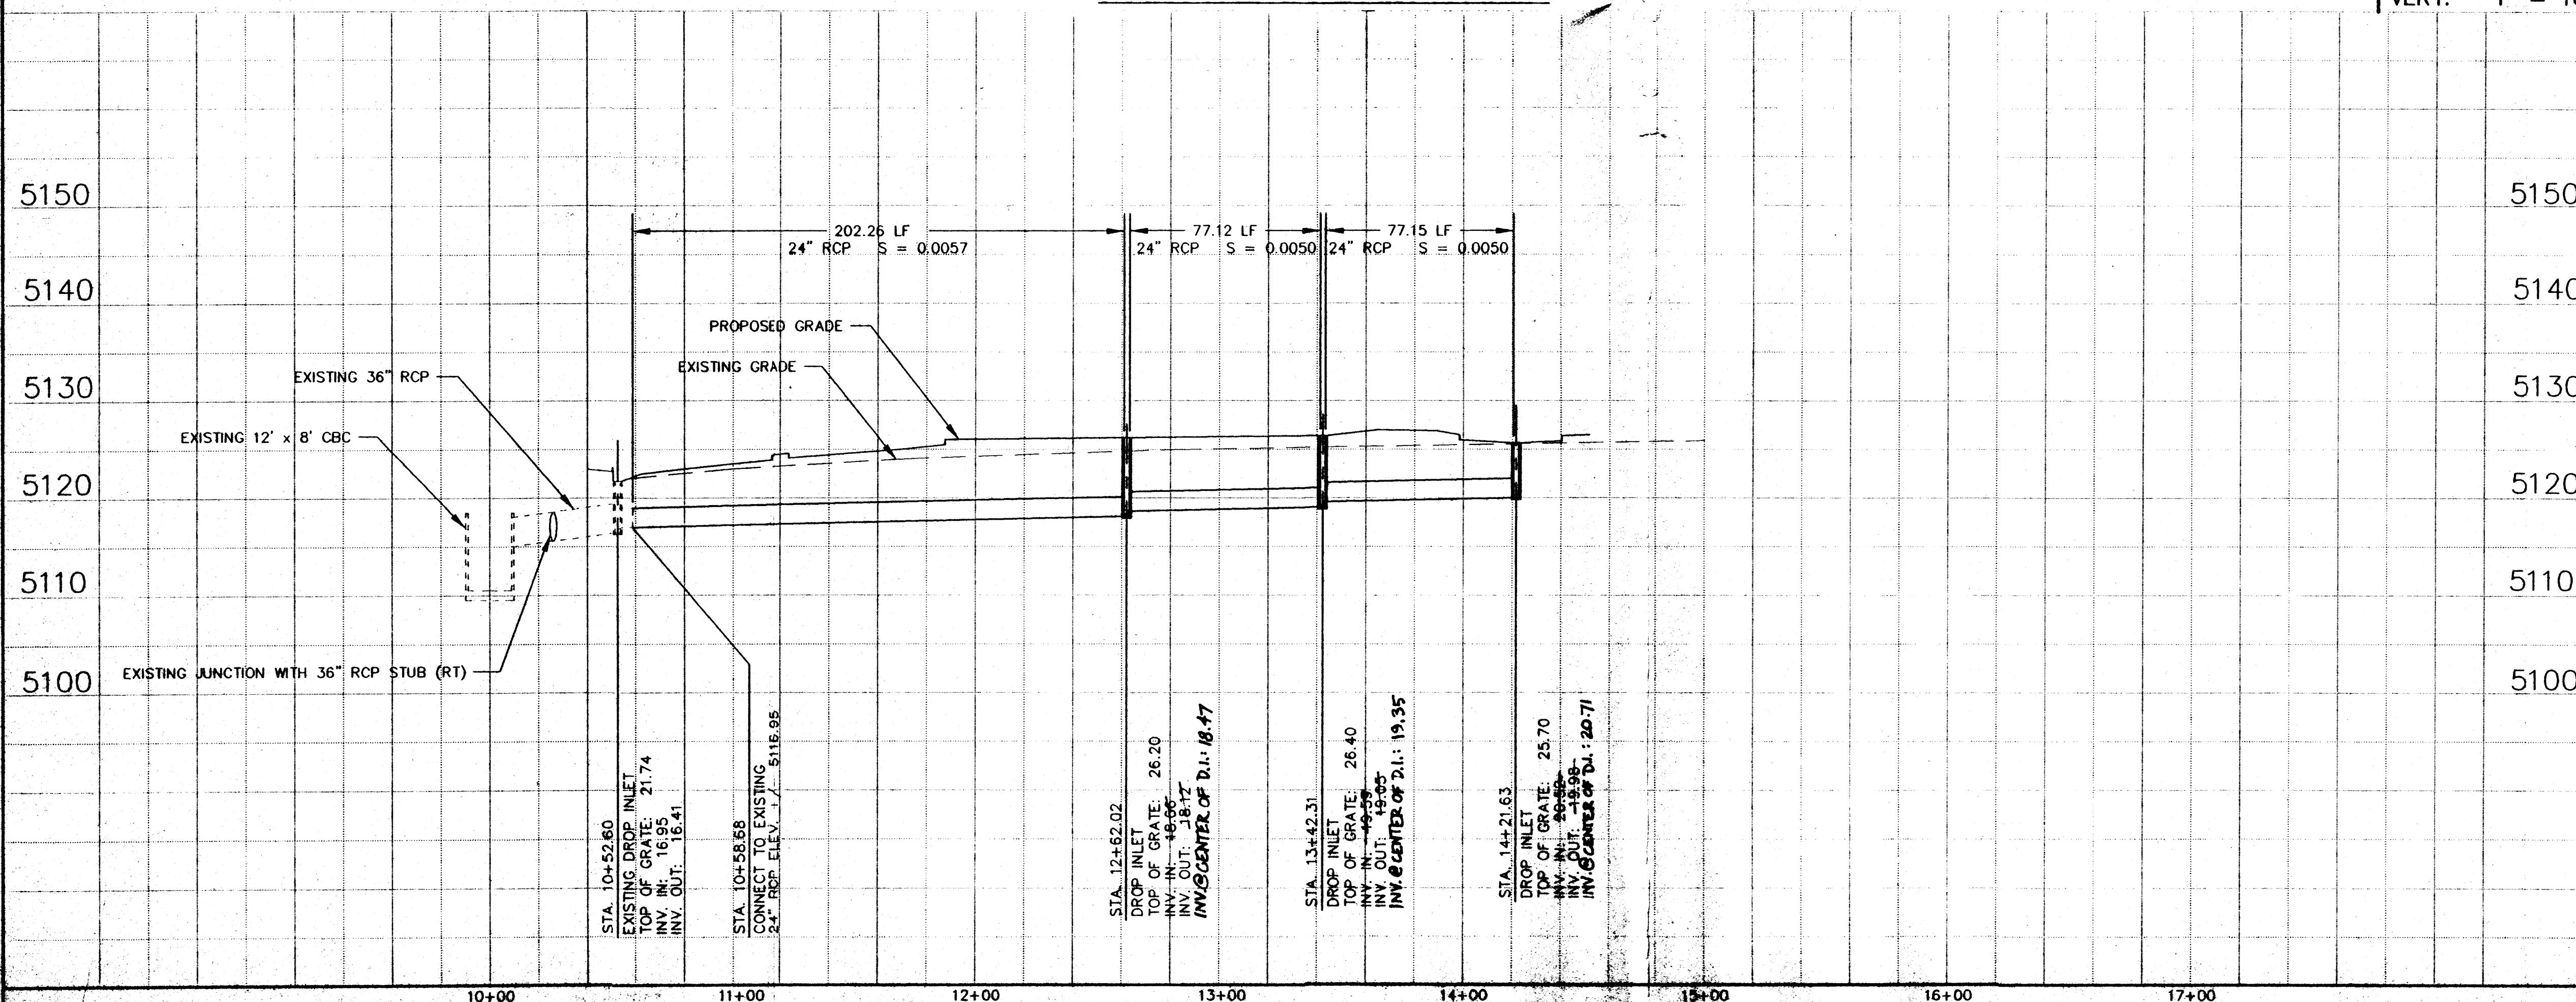

7040-SDP.DWG 3/11/98 1"=40'



CONSTRUCTION NOTES

- ALL CONSTRUCTION METHODS AND MATERIALS SHALL BE IN COMPLIANCE WITH CITY OF ALBUQUERQUE DEVELOPMENT PROCESS MANUAL REQUIREMENTS.
- DROP INLETS SHOWN SHALL BE CONSTRUCTED PER CITY OF ALBUQUERQUE STANDARD #2206, FOR TYPE "D" SINGLE INLETS.

LEGEND		
ITEM	EXISTING	PROPOSED
WATERLINE	6" W	6" W
SANITARY SEWER	8" SAS	8" SAS
STORM SEWER	36" SD	24" SD
FIRE HYDRANT	⊙	⊙
VALVE	⋈	⋈
WATER SERVICE (SINGLE)	—	—
WATER SERVICE (DOUBLE)	—	—
MANHOLE	⊙	⊙
CURB	—	—
DROP INLET	—	—
OVERHEAD ELEC.	OHE	OHE
UNDERGROUND ELEC., GAS, TEL, TV	UGT	UGT
FLOWLINE ELEV.	FL 0.14	FL 0.14
TOP OF CURB ELEV.	99.3	99.31
SPOT ELEV.	x 16.7	16.7
SEWER SERVICE	—	—
RIGHT OF WAY	—	—
POWER POLE (GUYPED)	PP	PP
CHAIN LINK FENCE	—	—
CENTERLINE	—	—
RETAINING WALL	—	—
TOP OF ASPHALT ELEV.	TA 16.2	TA 16.2
AS-BUILT ELEV.	26.06	26.20

ENGINEER'S CERTIFICATION

I, the undersigned, being a Professional Engineer in the State of New Mexico, do hereby certify that the drawings and specifications prepared by me or under my supervision, and that the as-built information shown herein is based on actual field measurements and inspections performed by Brasher & Lorenz, Inc. I further certify that the as-built condition of the site is in substantial compliance with the approved Grading and Drainage Plan prepared by Brasher & Lorenz, Inc.

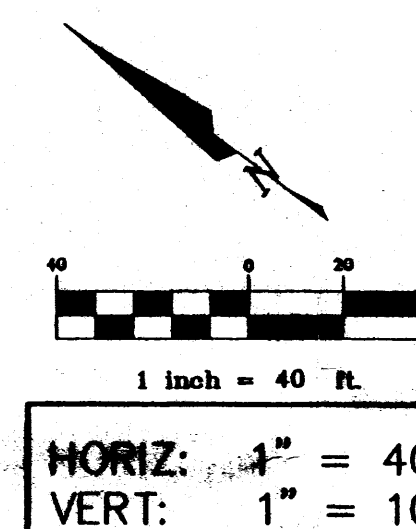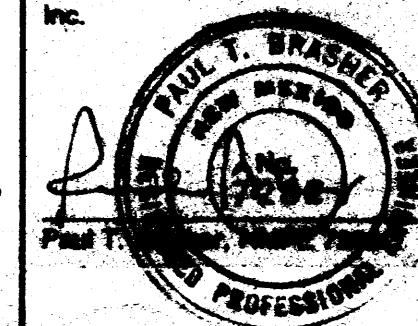

PROPERTY ADDRESS

Office Boulevard at I-25 West Frontage Road

LEGAL DESCRIPTION

Tract A1-B, Cryer Property

PROJECT BENCHMARK

TBM: top of capped rebar near south corner of Digital Properties, Parcel 3. Elev. = 5127.31 ft.

SURVEY

Topographic and Field Measurements by Brasher & Lorenz, Inc. Dated February, 1998

★ TEXAS LAND & CATTLE COMPANY ★
STEAK HOUSE
ALBUQUERQUE, NEW MEXICO

STORM DRAIN
PLAN & PROFILE

REVISIONS:

CHECKED BY:
D.A.L.

DRAWN BY:
M.D.T.


JOB NO:
7040


FILE NO:
7040-SDP.DWG

SHEET NO:

C-6

BRASHER & LORENZ, INC.
Consulting Engineers
2201 San Pedro NE Building 1 Suite 210
Albuquerque, New Mexico 87110
PH: 505-888-6088 Fax: 505-888-6188

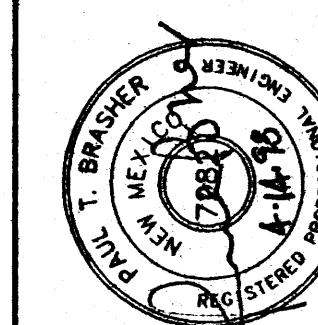

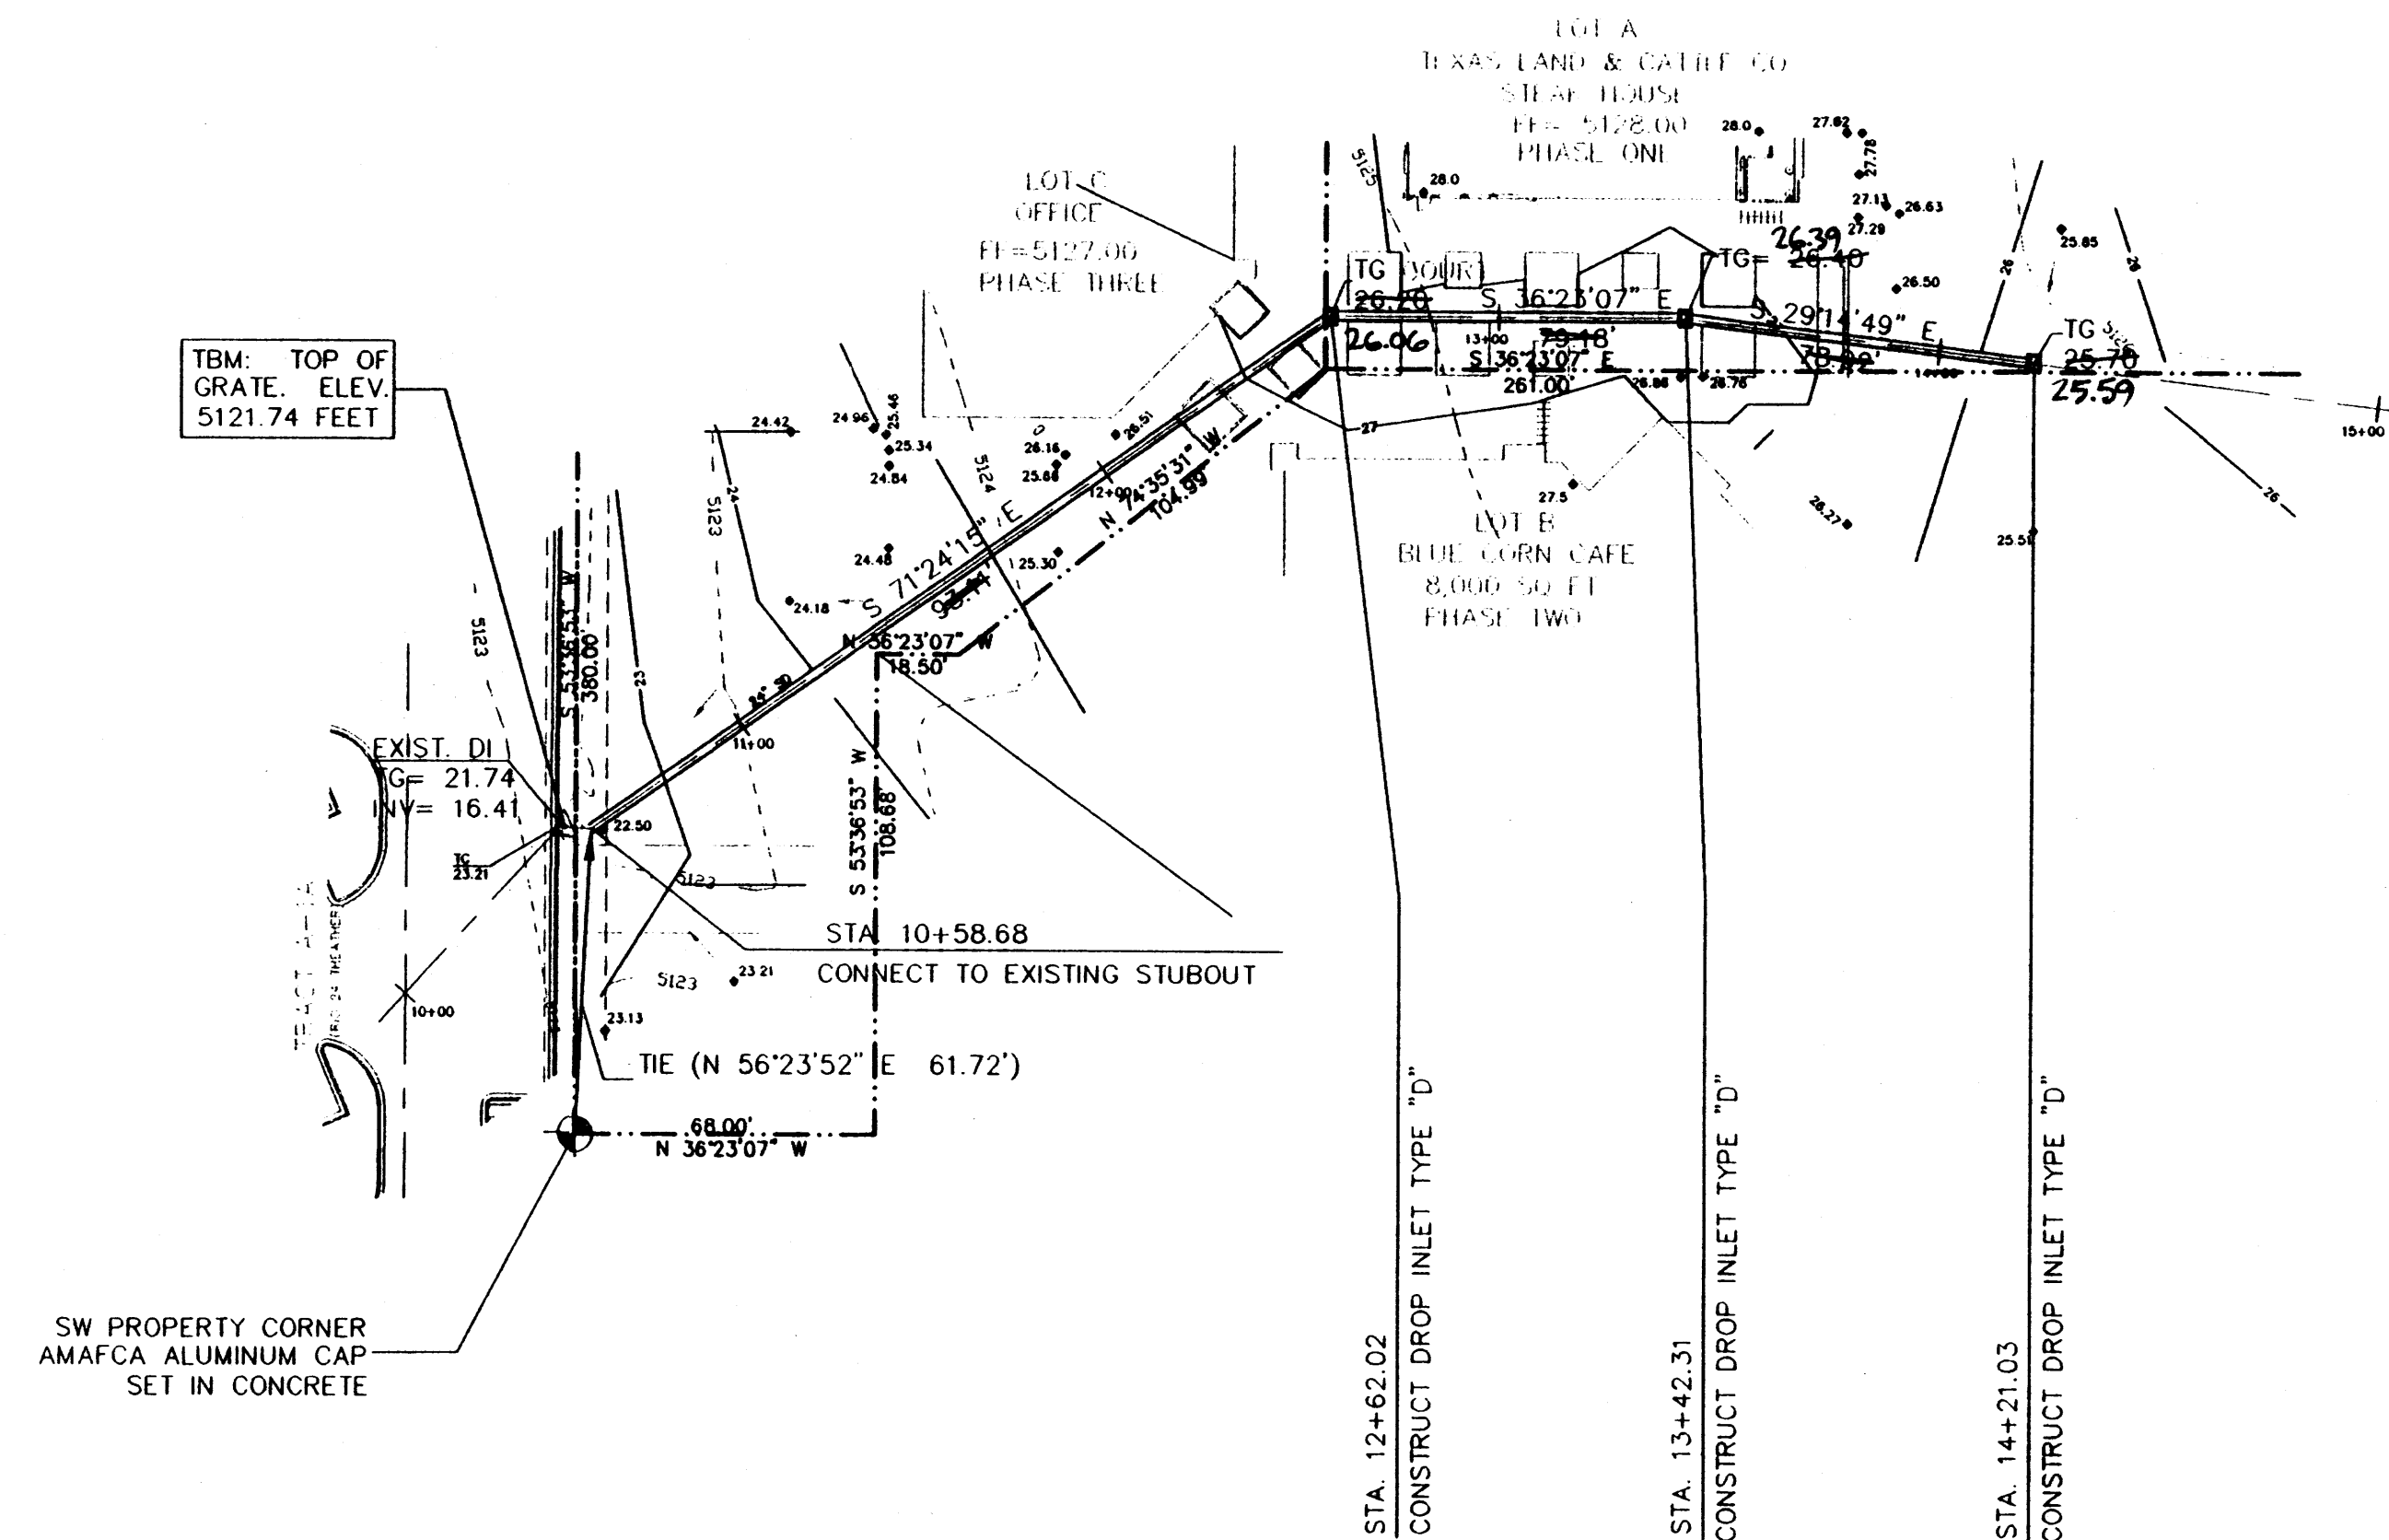


CONSTRUCTION NOTES

- ALL CONSTRUCTION METHODS AND MATERIALS SHALL BE IN COMPLIANCE WITH CITY OF ALBUQUERQUE DEVELOPMENT PROCESS MANUAL REQUIREMENTS.
- DROP INLETS SHOWN SHALL BE CONSTRUCTED PER CITY OF ALBUQUERQUE STANDARD #2206, FOR TYPE "D" SINGLE INLETS.


LEGEND		
ITEM	EXISTING	PROPOSED
WATERLINE	6" W	6" W
SANITARY SEWER	8" SAS	8" SAS
STORM SEWER	36" SD	24" SD
FIRE HYDRANT	⊙	⊙
VALVE	⋈	⋈
WATER SERVICE (SINGLE)	—	—
WATER SERVICE (DOUBLE)	—	—
MANHOLE	⊙	⊙
CURB	—	—
DROP INLET	—	—
OVERHEAD ELEC.	OHE	OHE
UNDERGROUND ELEC.	UGT	UGT
GAS, TEL, TV	—	—
FLOWLINE ELEV.	FL 0.14	FL 0.14
TOP OF CURB ELEV.	99.3	99.31
SPOT ELEV.	x 16.7	16.7
SEWER SERVICE	—	—
RIGHT OF WAY	—	—
POWER POLE (GUYED)	PP	PP
CHAIN LINK FENCE	x	x
CENTERLINE	—	—
RETAINING WALL	—	—
TOP OF ASPHALT ELEV.	TA 16.2	TA 16.2
AS-BUILT ELEV.	—	26.06 26.20

ENGINEER'S CERTIFICATION


I, the undersigned, being a Professional Engineer in the State of New Mexico, do hereby certify that the drawings were prepared by me or under my supervision, and that the as-built information shown herein is based on actual field measurements and inspections performed by Brasher & Lorenz, Inc. I further certify that the as-built condition of the site is in substantial compliance with the approved Grading and Drainage Plan prepared by Brasher & Lorenz, Inc.

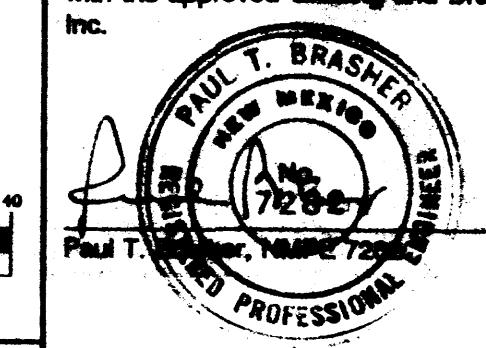

LANDSCAPE COMPLETE
11-18-98
10-15-98
Date

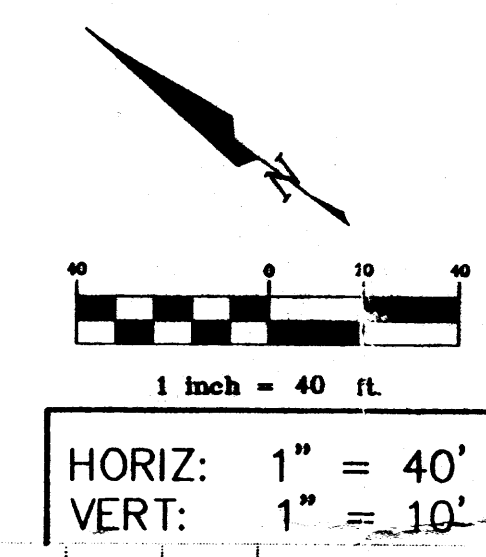

PRIVATE STORM DRAIN

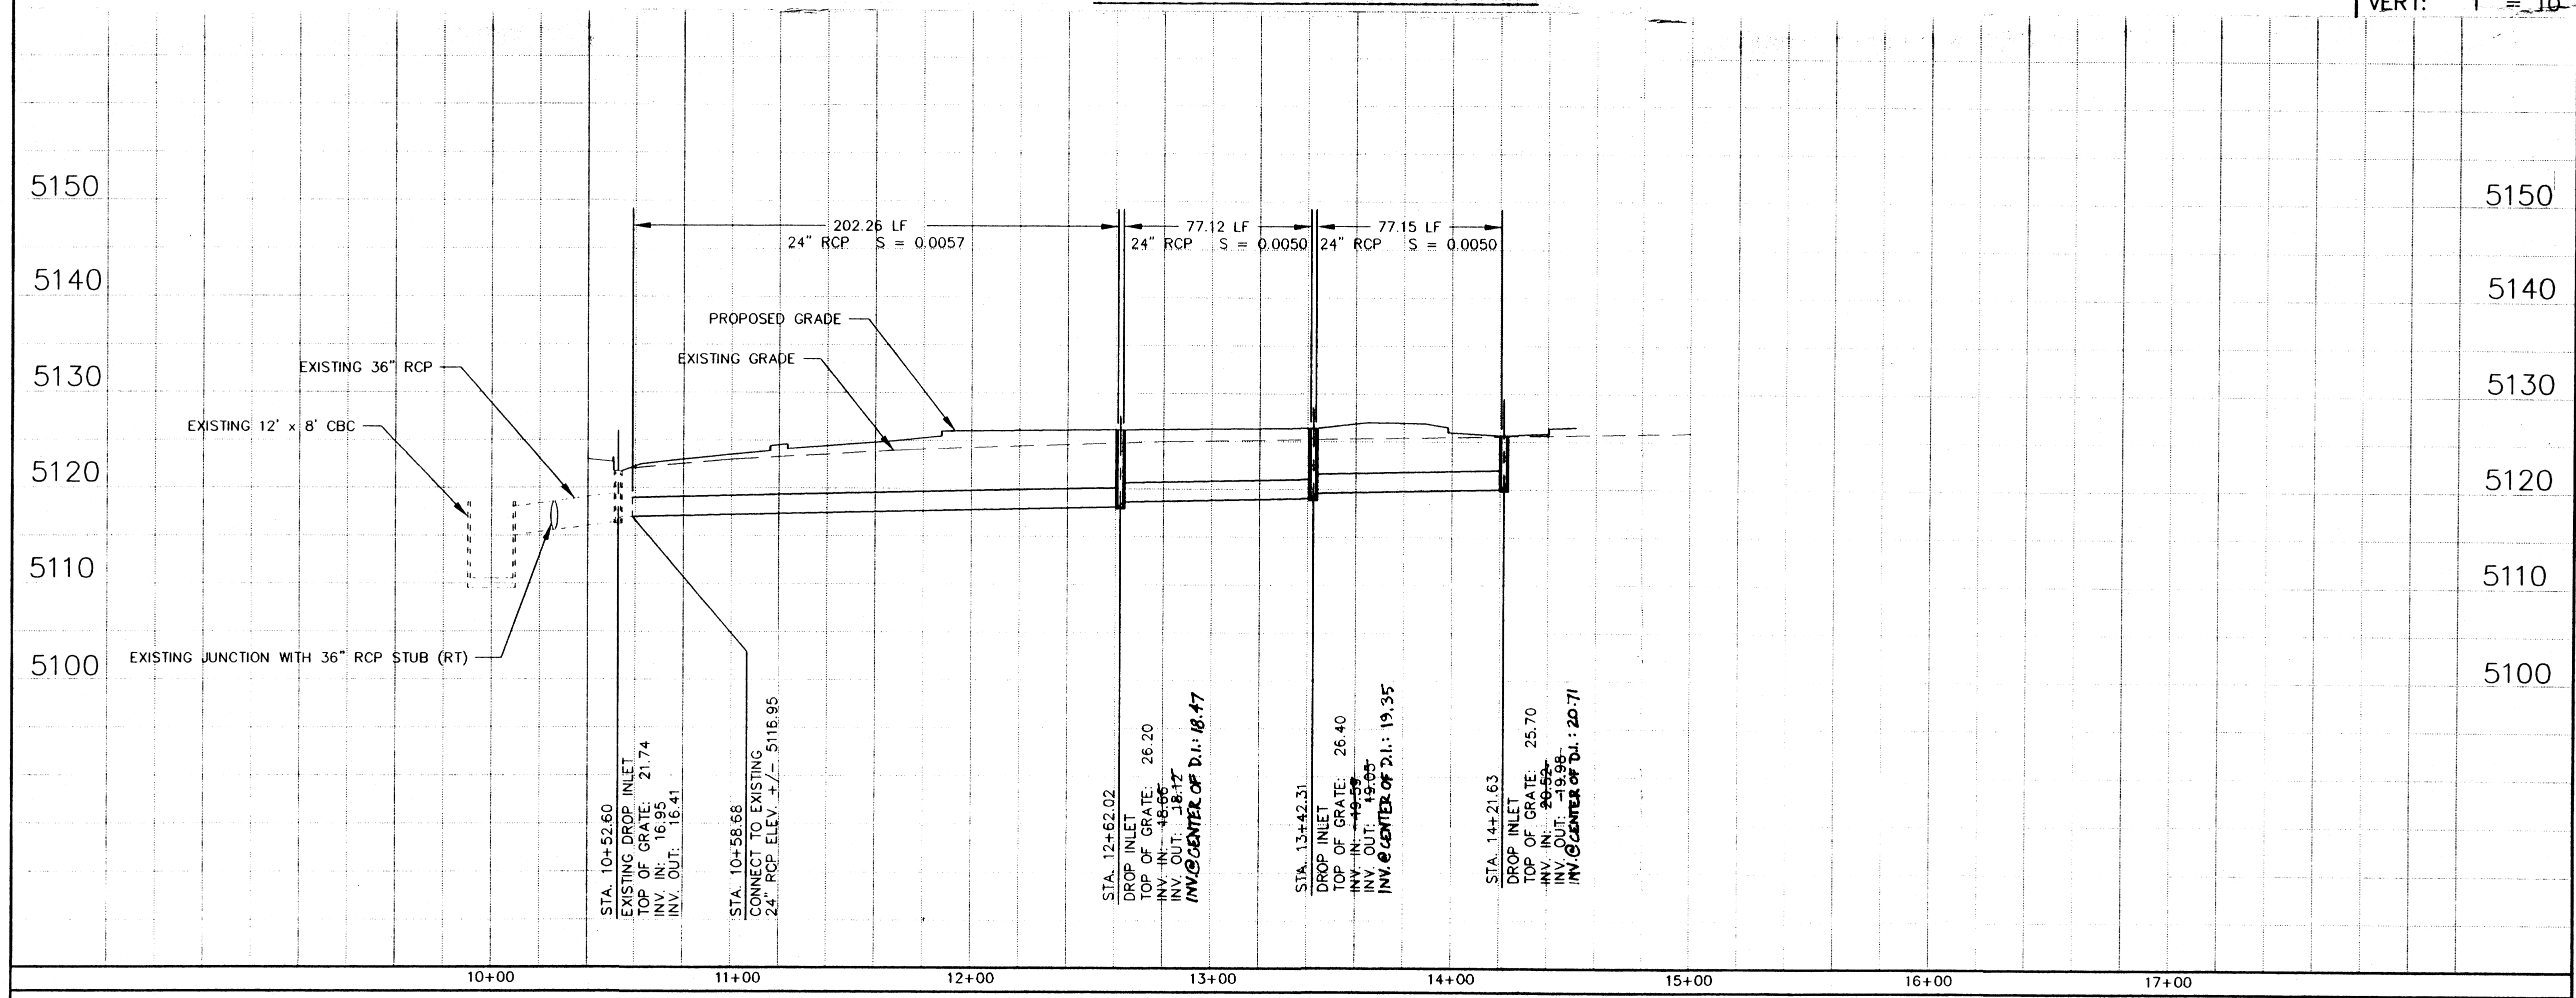

PROPERTY ADDRESS
Office Boulevard at I-25 West Frontage Road

LEGAL DESCRIPTION
Tract A1-B, Cryer Property

PROJECT BENCHMARK
TBM: top of capped rebar near south corner of Digital Properties, Parcel 3. Elev. = 5127.31 ft.

SURVEY
Topographic and Field Measurements by Brasher & Lorenz, Inc. Dated February, 1998

★
TEXAS LAND & CATTLE COMPANY
★
STEAK HOUSE
ALBUQUERQUE, NEW MEXICO

STORM DRAIN
PLAN & PROFILE

REVISIONS:


CHECKED BY:
D.A.L.

DRAWN BY:
M.D.T.

JOB NO:
7040

FILE NO:
7040-SDP.DWG

SHEET NO:

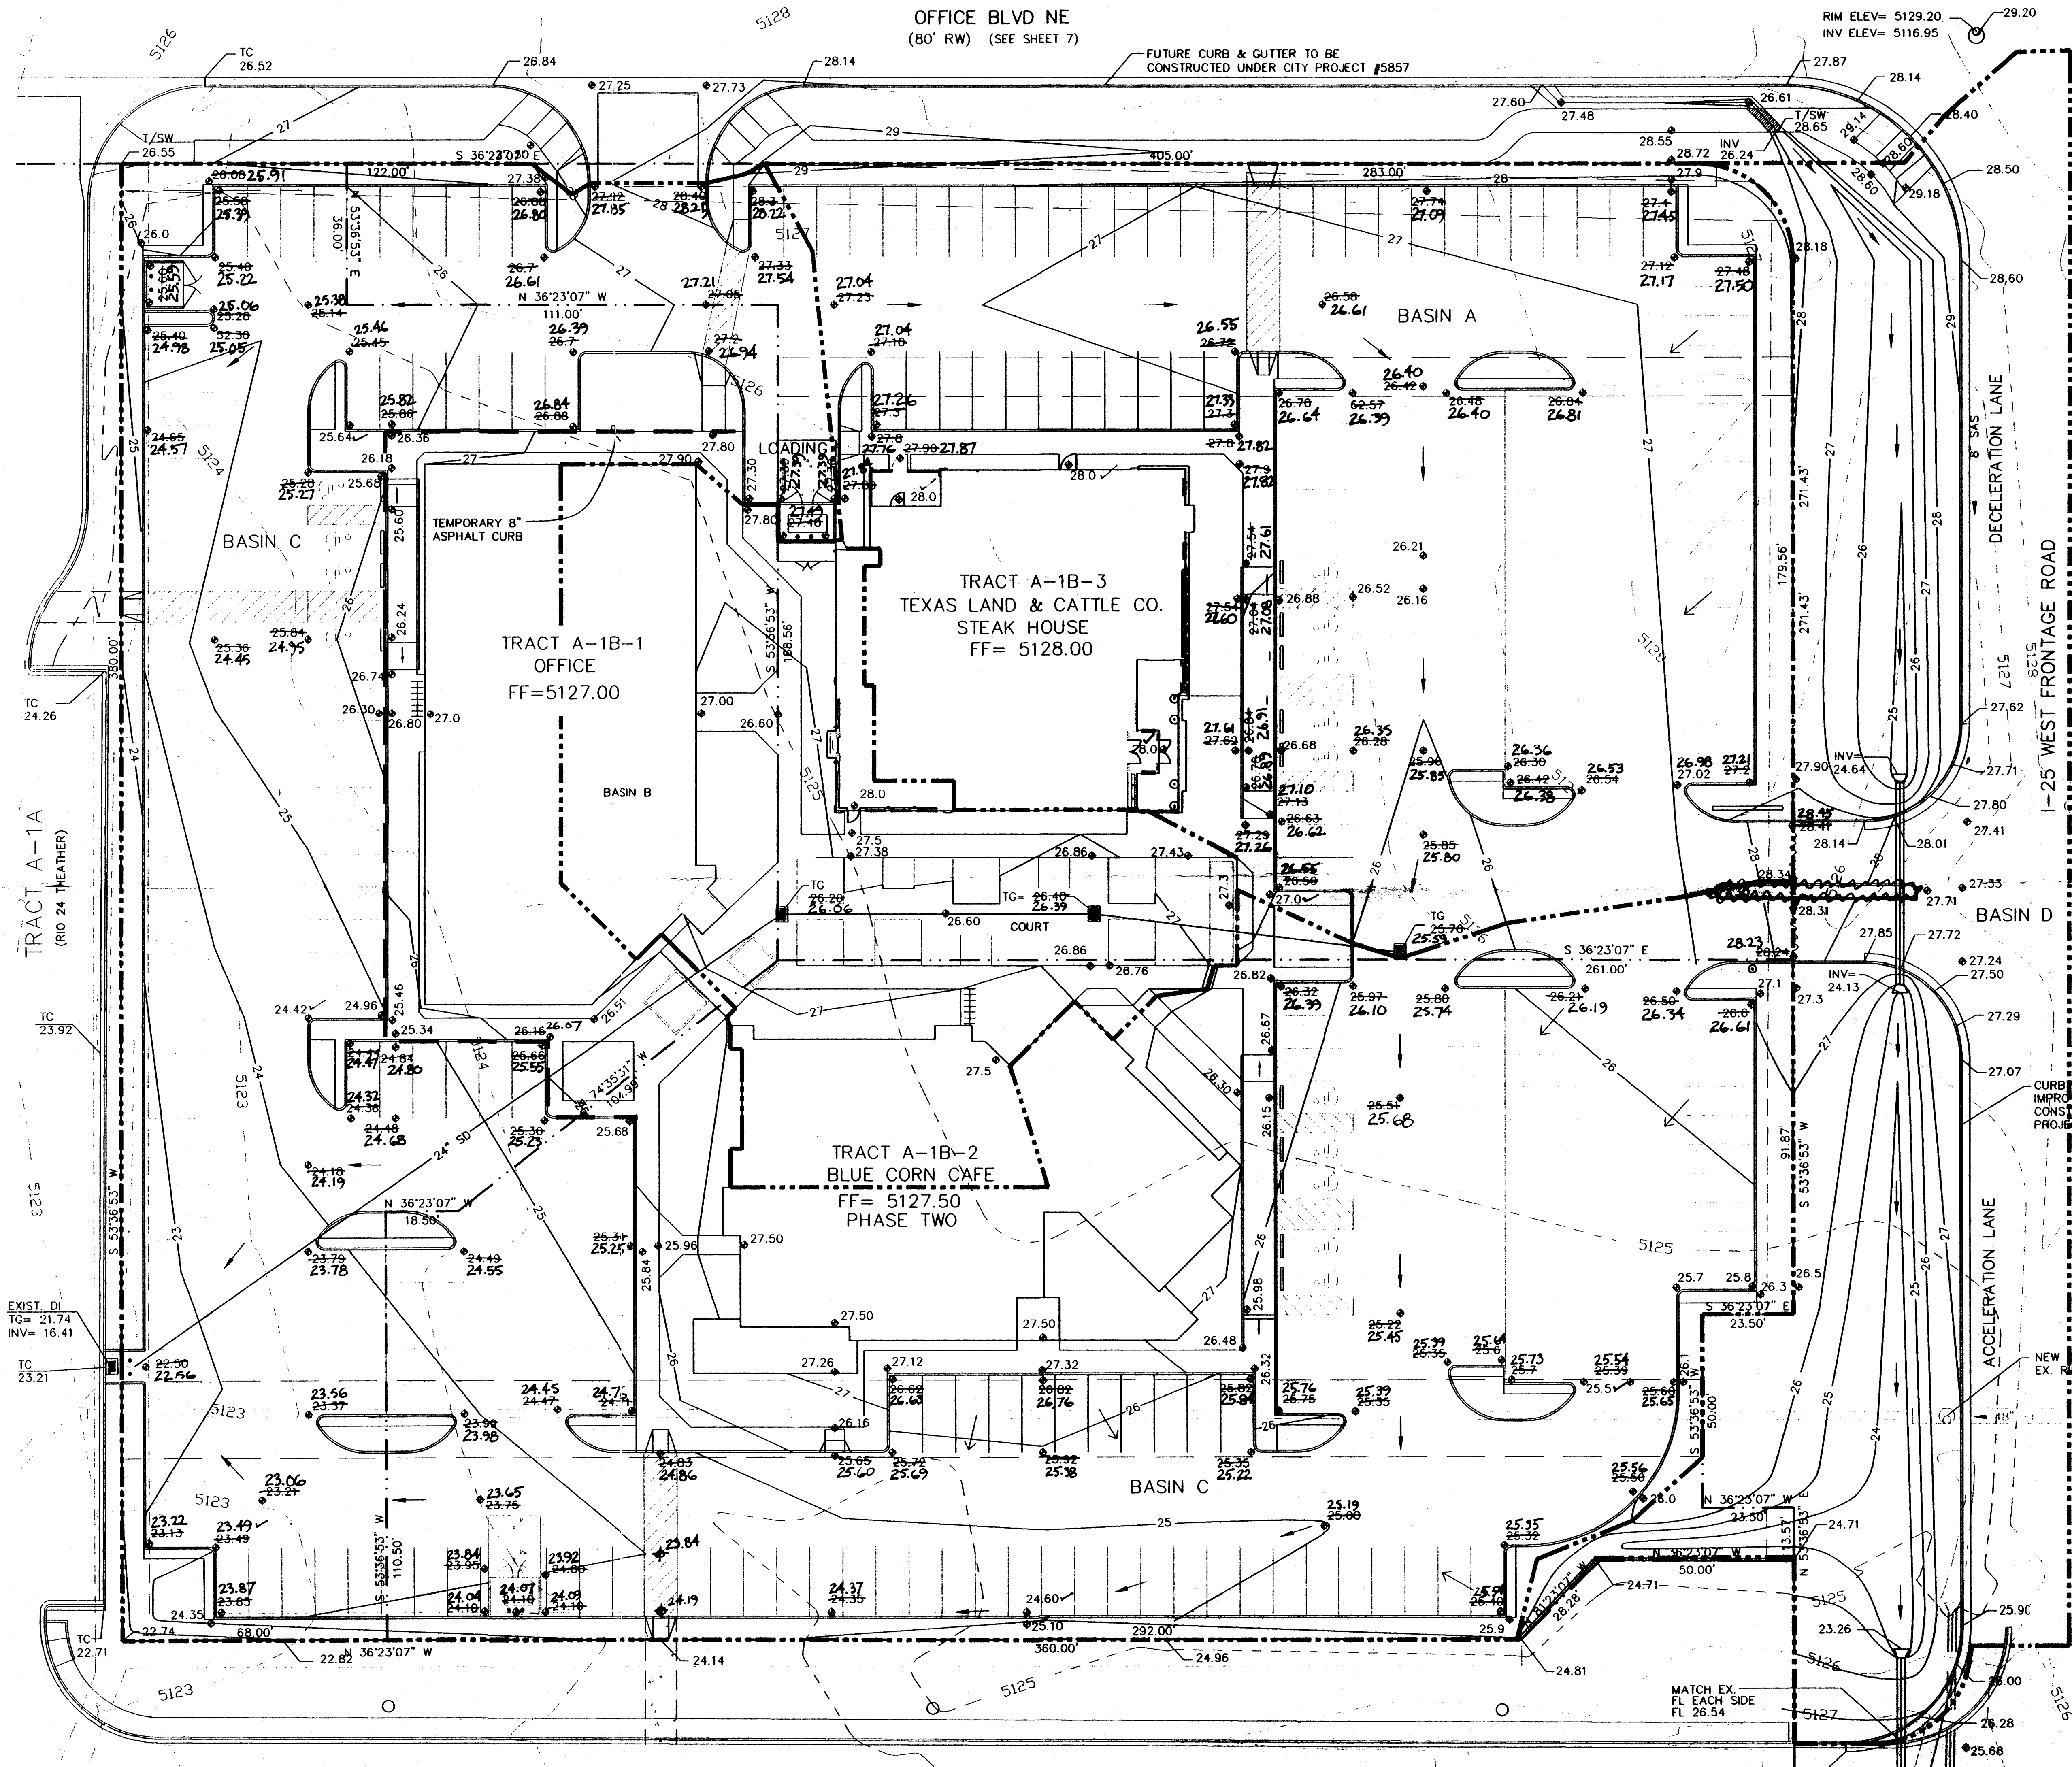

- LEGEND**
- 6001 — EXISTING CONTOUR ELEVATION
 - 02.5 x — EXISTING SPOT ELEVATION
 - 01 — PROPOSED CONTOUR ELEVATION
 - 01.5 — PROPOSED SPOT ELEVATION
 - — DIRECTION OF FLOW
 - — DRAINAGE SWALE
 - DRAINAGE BASIN DIVIDE
 - 01.52 01.56 AS-BUILT ELEVATION

ENGINEER'S CERTIFICATION

I, the undersigned, being a Professional Engineer in the State of New Mexico, do hereby certify that this drawing was prepared by me or under my supervision, and that the as-built information shown hereon is based on actual field measurements and inspections performed by Brasher & Lorenz, Inc. I further certify that the as-built condition of the site is in substantial compliance with the approved Grading and Drainage Plan prepared by Brasher & Lorenz, Inc., with the following exceptions, which must be completed per plan prior to issuance of final Certificate of Occupancy:

LANDSCAPING COMPLETE 11-18-98

10-15-98 Date

PAUL T. BRASHER PROFESSIONAL ENGINEER


LEGAL DESCRIPTION
TRACT A-1B CRYER PROPERTY

ADDRESS
WEST PAN AMERICAN FREEWAY

SURVEY
TOPOGRAPHY BY BRASHER & LORENZ INC.
DATED AUGUST 1997

- KEYED NOTES**
- 6" CONCRETE CURB
 - EXISTING CONCRETE CURB
 - EXISTING ASPHALT PAVEMENT
 - ASPHALT PAVEMENT
 - IMPROVEMENTS TO OFFICE BLVD.
 - 6" SIDEWALK
 - HANDICAP RAMP
 - ACCESSIBLE WAY (5' WIDE)
 - PLANTER
 - REFUSE ENCLOSURE SEE SHT C-2
 - EXISTING INLET
 - TYPE DBL "D" INLET
 - EXISTING LANDSCAPING
 - LANDSCAPING - SEE SHT L-1
 - 24" CULVERT PIPE SEE SHT C-5
 - EXISTING CULVERT PIPE
 - EXISTING 4" SIDEWALK
 - BICYCLE RACK

RECEIVED
DEC 31 1998
HYDROLOGY SECTION

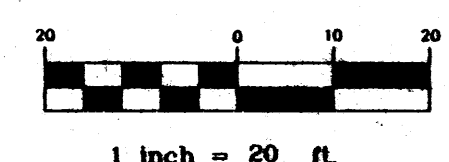

BRASHER & LORENZ, INC.
Consulting Engineers
2201 San Pedro NE Building 1 Suite 210
Albuquerque, New Mexico 87110
Ph: 505-888-6088 Fax: 505-888-6188

BLI

TEXAS LAND & CATTLE COMPANY
STEAK HOUSE
ALBUQUERQUE, NEW MEXICO

GRADING AND DRAINAGE PLAN

REVISIONS:

CHECKED BY:	D.A.L.
DRAWN BY:	M.D.T.
JOB NO:	7040
FILE NO:	7040G20.DWG
SHEET NO:	C-5

DRAINAGE CALCULATIONS:

- I. REFERENCES:
 - A. CITY OF ALBUQUERQUE DEVELOPMENT PROCESS MANUAL (DPM) VOL. 2 DESIGN CRITERIA, CHAPTER 22: DRAINAGE, FLOOD CONTROL, AND EROSION CONTROL.
 - B. SOIL SURVEY OF BERNALILLO COUNTY AND PARTS OF SAGUO AND VALLEJO COUNTIES, NEW MEXICO, UNITED STATES DEPT. OF AGRICULTURE, SOIL CONSERVATION SERVICE.
 - C. FLOODWAY, FLOOD BOUNDARY AND FLOODWAY MAP, CITY OF ALBUQUERQUE, NEW MEXICO, PANEL 18 OF 50.
 - D. ZONE ATLAS PAGE F-17-Z.
- II. DESIGN SYNOPSIS:
 - A. ARROYO IS ON PRIVATE PROPERTY. THERE ARE NO EASEMENTS IN PLACE. DOWNSTREAM EROSION PROBLEMS EXIST WITHIN THE ARROYO.
 - B. A RETENTION POND WILL BE CONSTRUCTED TO RECEIVE 100% OF THE DEVELOPED RUNOFF BASED ON 24 HOUR STORM CRITERIA. THIS POND WILL SERVE ITS PURPOSE UNTIL DOWNSTREAM EASEMENTS AND CAPACITY ARE ESTABLISHED.
 - C. ALL OF THE DEVELOPED RUNOFF FROM BASIN "A" WILL BE DIRECTED TO THE RETENTION POND.
 - D. ALL OF THE RUNOFF FROM THE UNDEVELOPED AND UNDISTURBED BASIN "B" WILL BE PERMITTED TO FOLLOW ITS HISTORIC COURSE TO THE ARROYO.
 - E. OFFSITE FLOWS, DESCRIBED BELOW, WILL BE ACCEPTED AND PERMITTED TO FREELY CROSS THE SUBJECT PROPERTY.
- III. GENERAL INFORMATION:
 - A. SOIL TYPE (REF. B, SHEET NO. 21) SOIL TYPE IS EMBUDO, GRAVELLY FINE SANDY LOAM (CWS), HYDROLOGIC SOIL GROUP "B".
 - B. IMPERVIOUSNESS:



EXISTING		PROPOSED	
BASIN "A"	BASIN "B"	BASIN "A"	BASIN "B"
TYPE OF SURFACE	ACRES	TYPE OF SURFACE	ACRES
UNDEVELOPED	1.1014	UNDEVELOPED	1.1014
BASIN TOTAL	2.5285	BASIN TOTAL	2.5285
 - C. "C" FACTOR:

EXISTING		PROPOSED	
BASIN "A"	BASIN "B"	BASIN "A"	BASIN "B"
TYPE OF SURFACE	AREA	TYPE OF SURFACE	AREA
UNDEVELOPED	0.40	UNDEVELOPED	0.40
BASIN TOTAL	2.5285	BASIN TOTAL	2.5285
 - D. EXISTING WEIGHTED "C" FACTOR BASIN "A" = 0.40
EXISTING WEIGHTED "C" FACTOR BASIN "B" = 0.40
 - E. PROPOSED IMPERVIOUS SURFACES:

BASIN "A"		BASIN "B"	
"C" FACTOR	AREA	"C" FACTOR	AREA
UNDEVELOPED	0.40	UNDEVELOPED	0.40
BASIN TOTAL	2.5285	BASIN TOTAL	2.5285
 - F. PROPOSED WEIGHTED "C" FACTOR BASIN "A" = 0.38
PROPOSED WEIGHTED "C" FACTOR BASIN "B" = 0.40
 - G. 100 YEAR RAINFALL, 24 HOUR, P(24) = 2.75 INCHES.
 - H. TIME OF CONCENTRATION: Tc = 10 MINUTES (MINIMUM VALUE) FOR CALCULATIONS.
 - I. RAINFALL INTENSITY, I: (SEE REF. A, PLATE 22.2 D-2)
 $I = P(24) \times 6.84 \times 10^{(-0.01)}$
 $I = 2.75 \times 6.84 \times 10^{(-0.01)}$
 $I = 5.81$ INCHES
 - IV. PEAK DISCHARGE - (RATIONAL METHOD)
 $Q(100) = C \times A \times I$
A. PEAK DISCHARGE EXISTING CONDITIONS:
 1. BASIN "A":
 $Q(100) = 0.40 \times 5.81 \times 2.5285 = 5.88$ CFS
 $Q(100) = 0.40 \times 5.81 \times 2.5285 = 5.88$ CFS
 2. BASIN "B":
 $Q(100) = 0.40 \times 5.81 \times 1.1014 = 2.71$ CFS
 $Q(100) = 0.40 \times 5.81 \times 1.1014 = 2.71$ CFS
 - B. PEAK DISCHARGE PROPOSED CONDITIONS:
 1. BASIN "A":
 $Q(100) = 0.38 \times 5.81 \times 2.5285 = 5.68$ CFS
 $Q(100) = 0.38 \times 5.81 \times 2.5285 = 5.68$ CFS
 2. BASIN "B":
 $Q(100) = 0.40 \times 5.81 \times 1.1014 = 2.71$ CFS
 $Q(100) = 0.40 \times 5.81 \times 1.1014 = 2.71$ CFS
 - V. VOLUME CALCULATION (SCS METHOD)
 - A. CURVE NUMBERS (REF. A, PLATE 22.2, C-2, TYPE "B" SOIL):

SURFACE	CN
BUILDING AND PAVED SURFACES	01-08
CRUSHED ROCK	01-05
UNDEVELOPED	01-07
PASTURE GRASS	01-07
LANDSCAPING	01-01
 - B. DIRECT RUNOFF VALUES (REF. A, PLATE 22.2, C-4):
WHERE $Q = (P - 0.25)(C) / (P + 0.85)$
AND $S = (1000 / CN) - 10$


SURFACE	Q	S
BUILDING AND PAVED SURFACES	0.52 INCHES	9.08
CRUSHED ROCK	0.41 INCHES	14.10
UNDEVELOPED	0.41 INCHES	14.10
PASTURE GRASS	0.41 INCHES	14.10
LANDSCAPING	0.28 INCHES	25.71
 - C. 100 YEAR AND 10 YEAR, 24 HOUR VOLUMES:
 $V(100) = AREA \times Q / 12$ $V(10) = 0.657 \times V(100)$
 1. UNDEVELOPED CONDITION BASIN "A":
 $V(100) = 110142 \times 1.01 / 12 = 9270$ CU.FT.
 $V(10) = 0.657 \times 9270 = 6091$ CU.FT.
 2. UNDEVELOPED CONDITION BASIN "B":
 $V(100) = 50748 \times 1.01 / 12 = 4271$ CU.FT.
 $V(10) = 0.657 \times 4271 = 2808$ CU.FT.
 3. DEVELOPED CONDITION BASIN "A":
 $V(100) = (21129 \times 2.52) + (54288 \times 1.38) + (28155 \times 0.38) + (6588 \times 0.28) / 12 = 11723$ CU.FT.
 $V(10) = 0.657 \times 11723 = 7702$ CU.FT.
 - VI. RETENTION POND:
 - A. POND VOLUME REQUIRED IS 11723 CU.FT.
 - B. POND VOLUME CALCULATION:
AREA OF SURFACE OF POND: 13997 SQ.FT.
AREA OF BOTTOM OF POND: 12578 SQ.FT.
AVERAGE POND AREA: $(13997 + 12578) / 2 = 13288$ SQ.FT.
POND DEPTH REQUIRED: $11723 \text{ CU.FT.} / 13288 \text{ SQ.FT.} = 0.89$ FT.
 - VII. FLOOD INFORMATION:
A PORTION OF THE SITE CONCURRENT WITH THE ALIGNMENT OF THE ARROYO LIES WITHIN A DESIGNATED 100 YEAR FLOOD ZONE, ZONE AO, DEPTH 1 (REF. C, PANEL 18 OF 50).
 - VIII. OFF-SITE FLOWS:
THERE ARE NO OFF-SITE FLOWS TO THIS PROPERTY. FLOWS FROM THE FRONTAGE ROAD ARE DIRECTED TO A SHALLOW BARR DITCH IN THE PUBLIC RIGHT-OF-WAY.
 - IX. CONSTRUCTION NOTES:
 - A. AN EXCAVATION/CONSTRUCTION PERMIT WILL BE REQUIRED BEFORE BEGINNING ANY WORK WITHIN CITY RIGHT-OF-WAY. AN APPROVED COPY OF THESE PLANS MUST BE SUBMITTED AT THE TIME OF APPLICATION FOR THIS PERMIT.
 - B. ALL WORK DETAILED ON THESE PLANS TO BE PERFORMED, EXCEPT AS OTHERWISE STATED OR PROVIDED HEREON, SHALL BE CONSTRUCTED IN ACCORDANCE WITH
 - C. TWO (2) WORKING DAYS PRIOR TO ANY EXCAVATION CONTRACTOR MUST CONTACT LINE LOCATING SERVICE AT 785-1234 FOR LOCATION OF EXISTING UTILITIES.
 - D. PRIOR TO CONSTRUCTION, THE CONTRACTOR SHALL EXCAVATE AND VERIFY THE HORIZONTAL AND VERTICAL LOCATIONS OF ALL POTENTIAL OBSTRUCTIONS. SHOULD A CONFLICT EXIST, THE CONTRACTOR SHALL NOTIFY THE ENGINEER SO THAT THE CONFLICT CAN BE RESOLVED WITH A MINIMUM AMOUNT OF DELAY.
 - E. BACKFILL COMPACTION SHALL BE ACCORDING TO ARTERIAL STREET USE.
 - F. MAINTENANCE OF THIS FACILITY SHALL BE THE RESPONSIBILITY OF THE OWNER OF THE PROPERTY SERVED.

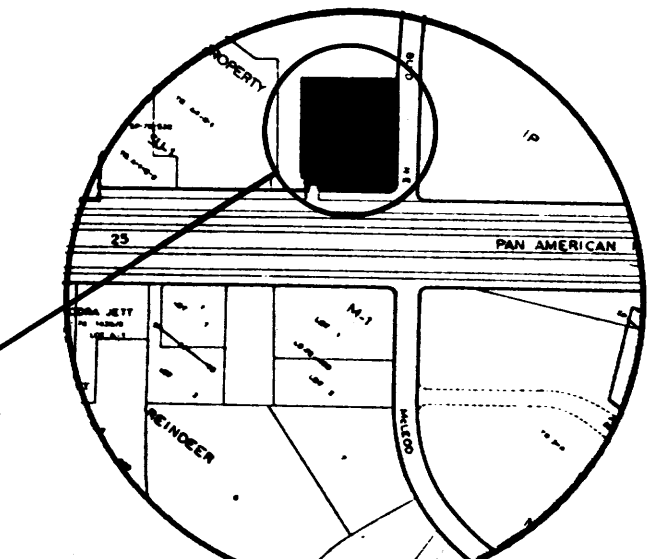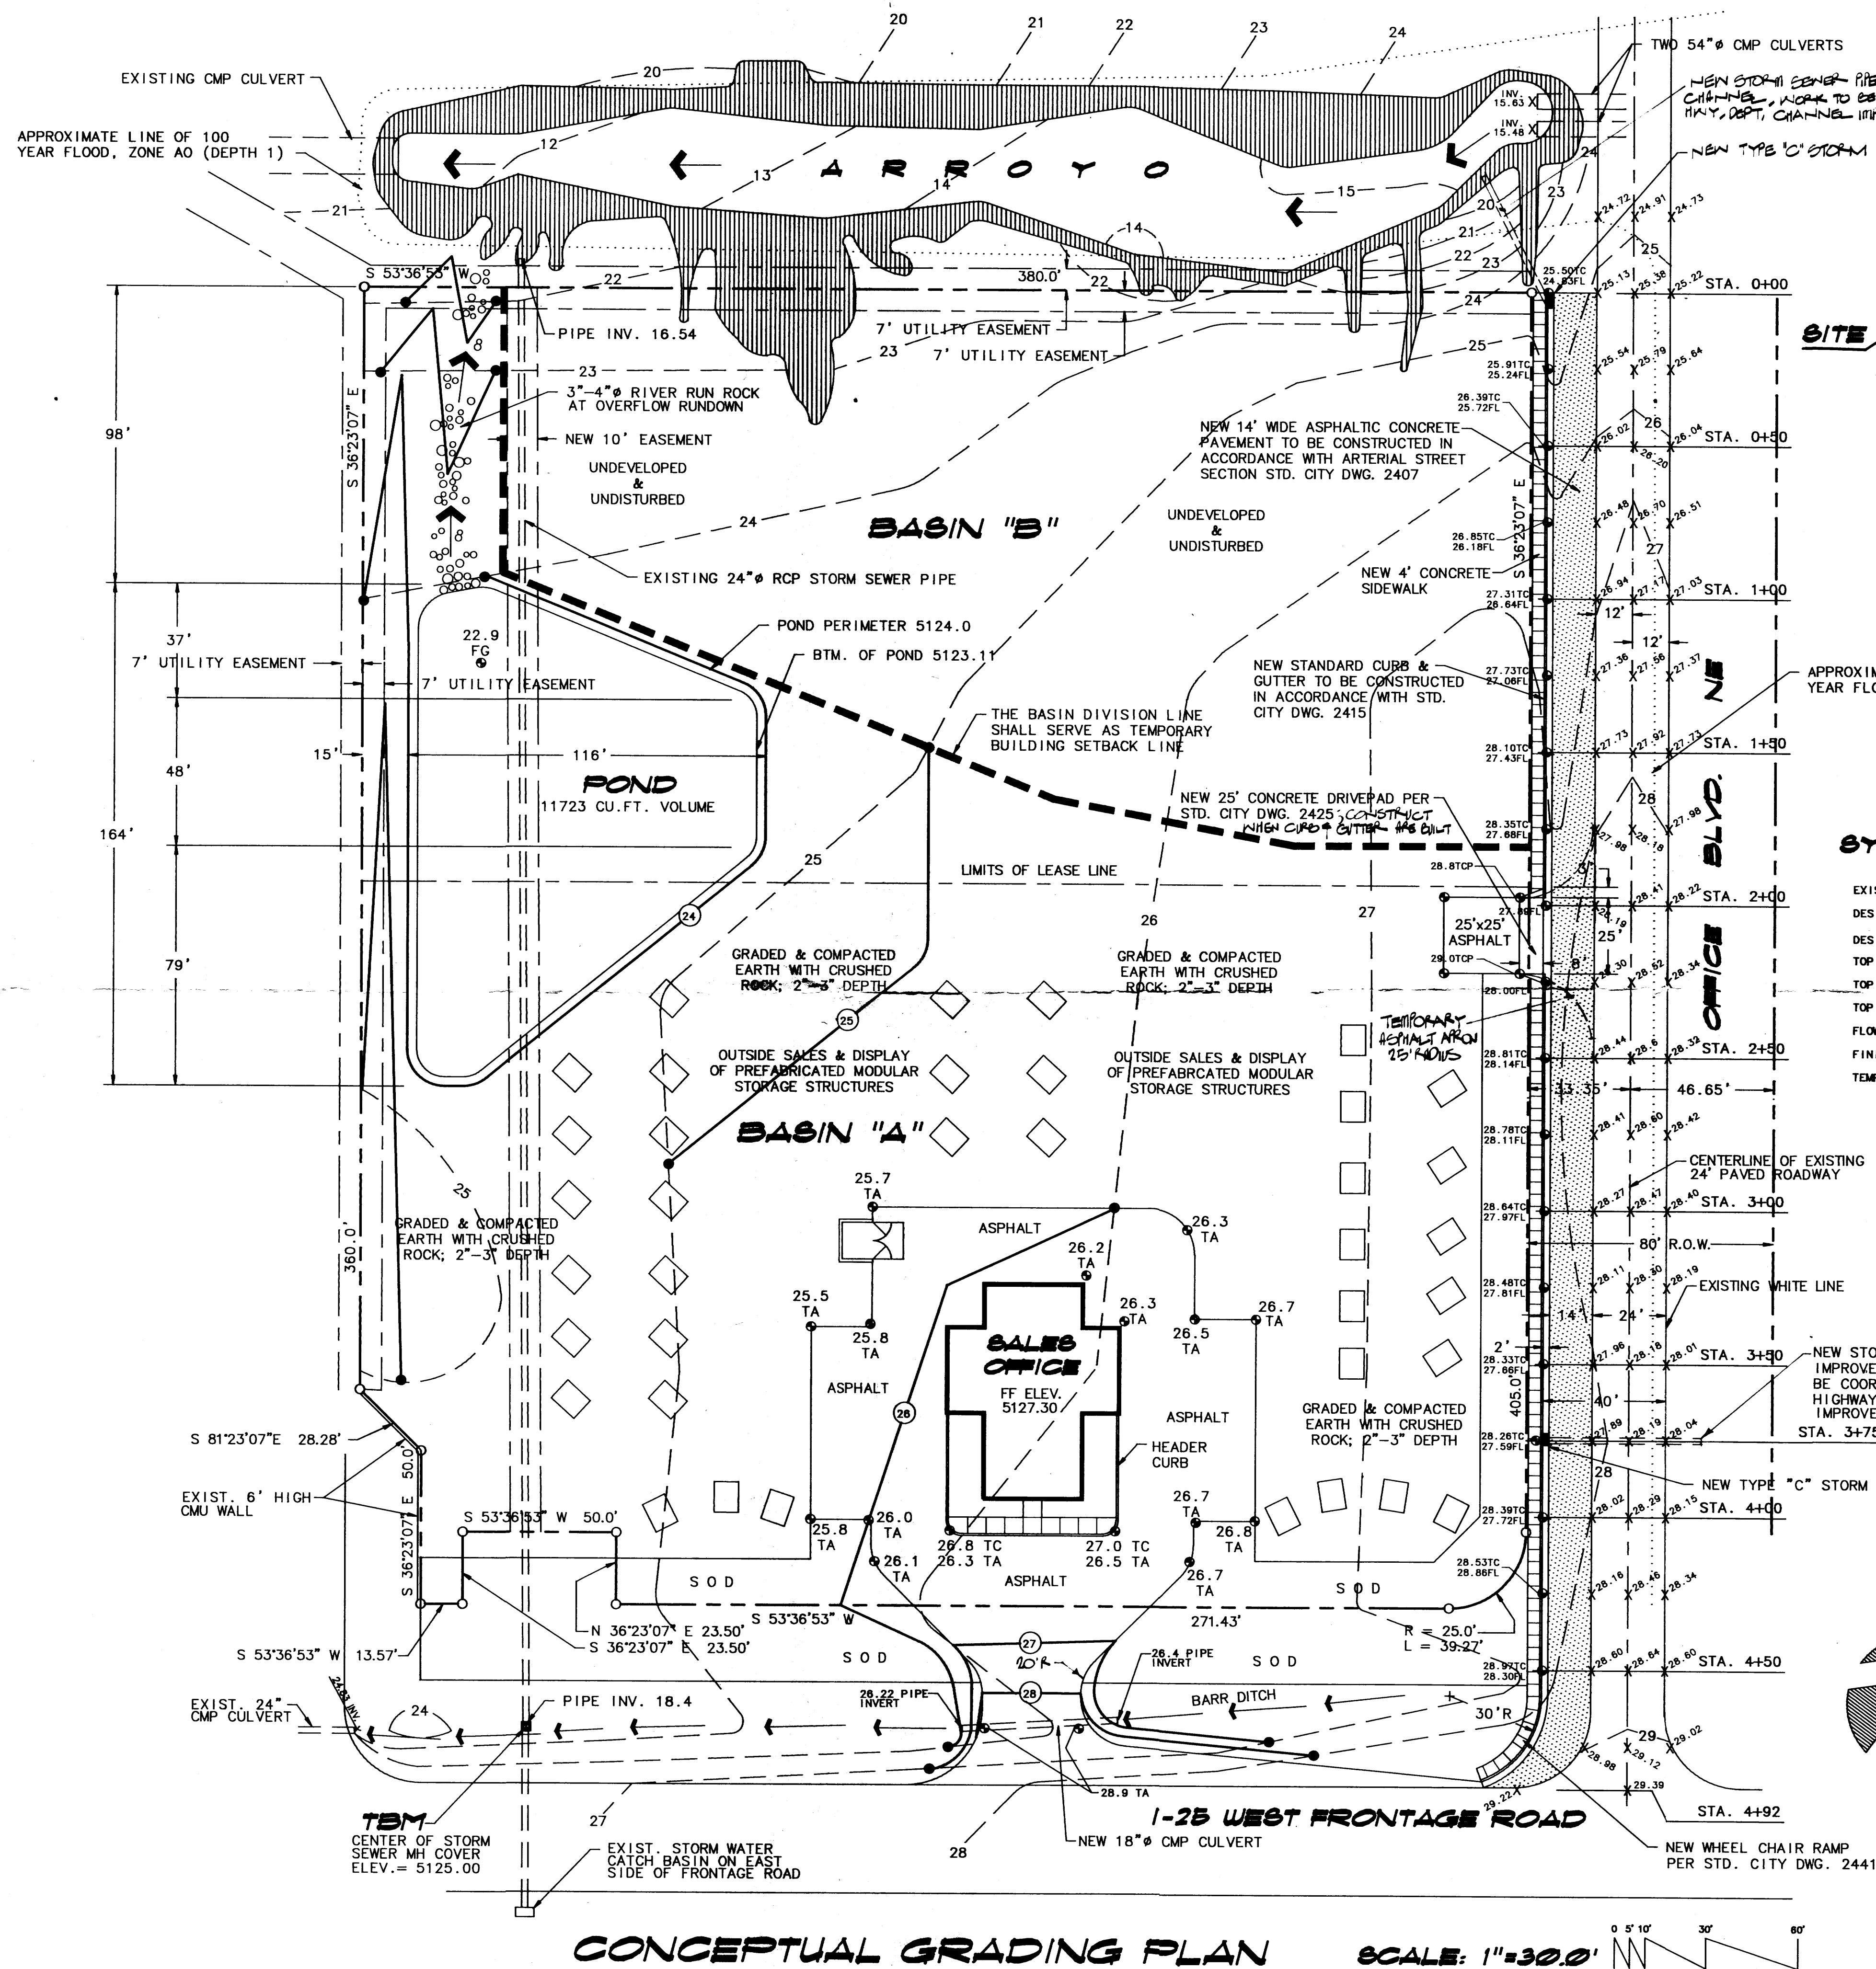

VICINITY MAP
ZONE ATLAS MAP #F-17-Z
LEGAL DESCRIPTION:
TRACT A-1-B
CRUYER PROPERTY
CITY OF ALBUQUERQUE
BERNALILLO COUNTY

SYMBOLS LEGEND:

- EXISTING CONTOUR LINE
- DESIGN CONTOUR LINE
- DESIGN SPOT ELEVATION @ 26.08 TA
- TOP OF ASPHALT TA
- TOP CONCRETE PAVING TCP
- TOP OF CURB TC
- FLOW LINE FL
- FINISH GRADE FG
- TEMPORARY BENCHMARK TBM

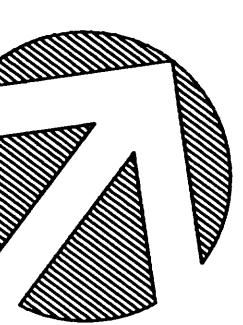

**PROPOSED OFFICE AND SHOW ROOM
FOR MORGAN BUILDING SYSTEMS, INC.**
WEST FRONTAGE ROAD AT OFFICE BOULEVARD NE

THE KEN HOWEY DESIGN GROUP INC.
ARCHITECTURE BY
505 255-9400 • 335 JEFFERSON STREET, SUITE B, ALBUQUERQUE, N.M. 87108

JOB NO: 0925
DATE: 27 MARCH 1990
REVISIONS
9 APRIL 1990
HYDROLOGY DIVISION

SHEET
2

CONCEPTUAL GRADING PLAN

SCALE: 1"=30.0'