## CITY OF ALBUQUERQUE



## Planning Department Transportation Development Services

October 21, 2015

Joe Simons Simons Architecture, PC PO Box 67408 Albuquerque, NM

Re:

**Campbell Brewery** 

**4814 Hardware NE** 

**Traffic Circulation Layout** 

Engineer's/Architect's Stamp dated 8-7-15 (F17-D097)

Dear Mr. Simons,

The TCL submittal received 10-15-15 is approved for Building Permit. A copy of the stamped and signed plan will be needed for each of the building permit plans. Please keep the original to be used for certification of the site for final C.O. for Transportation.

PO Box 1293

Albuquerque

When the site construction is completed and a Certificate of Occupancy (C.O.) is requested, use the original City stamped approved TCL for certification. Redline any minor changes and adjustments that were made in the field. A NM registered architect or engineer must stamp, sign, and date the certification TCL along with indicating that the development was built in "substantial compliance" with the TCL. Submit this certification TCL with a completed <u>Drainage and Transportation Information Sheet</u> to front counter personnel for log in and evaluation by Transportation.

New Mexico 87103

Once verification of certification is completed and approved, notification will be made to Building Safety to issue Final C.O. To confirm that a final C.O. has been issued, call Building Safety at 924-3690.

www.cabq.gov

Sincerely,

Racquel M. Michel, P.E.

Traffic Engineer, Planning Dept. Development Review Services

\gs

via: email

C:

CO Clerk, File

## City of Albuquerque

Planning Department


Development & Building Services Division DRAINAGE AND TRANSPORTATION INFORMATION SHEET (REV 02/2013)

x17tmB

Project Title: CAMPBELL BREWER	Building Permit #: T201692225 City Drainage #:
DRB#: EPC#:	Work Order#:
Legal Description: LOT A, BLOCK 0000, MªCLEOD CROSSING	
City Address: 4814 HAPPWAPE, AF	BQ. NM
	P. NE
Engineering Firm: Address:	Contact:
Phone#: Fax#:	r
Flone#: Fax#:	E-mail:
Owner: SUN MOUNTAIN ESTAT	FES INC. Contact:
Address: 404 BRUNN SCHOOL P	DA SANTA FE HM 87505
Phone#: 720 - 4770 Fax#:	E-mail: brewer. compbellegma
Architect: SIMONS ARCHITECT	THE P.C. Contact: UDE SIMONS
Address: P.O. Box 67408	Contact.
Phone#: 480-4796 Fax#:	E-mail: \0 <<
1000	simons architecture . com
Surveyor:	Contact:
Address:	
Phone#: Fax#:	E-mail:
Contractor:	Contact:
Address:	
Phone#: Fax#:	E-mail:
TABLE OF CURNITY AL	CHECK TURE OF ADDOMAL A CORDE AND COLICIES
TYPE OF SUBMITTAL:  DRAINAGE REPORT	CHECK TYPE OF APPROVAL/ACCEPTANCE SOUGHT: SIA/FINANCIAL GUARANTEE RELEASE
DRAINAGE PLAN 1st SUBMITTAL	DREI MANARY BLAT ADDROVAL
DRAINAGE PLAN RESUBMITTAL	PRELIMINARY PLAT APPROVAL  S. DEV. PLAN FOR SUB'D APPROVAL
CONCEPTUAL G & D PLAN	C DEV FOR DI DC DEPART APPROVAL
GRADING PLAN	SECTOR PLAN APPROVAL
EROSION & SEDIMENT CONTROL PLAN (ESC)	FINAL PLAT APPROVAL
ENGINEER'S CERT (HYDROLOGY)	CERTIFICATE OF OCCUPANCY (PERM) LAND DEVELOPMENT SECTION
CLOMR/LOMR	CERTIFICATE OF OCCUPANCY (TCL TEMP)
TRAFFIC CIRCULATION LAYOUT (TCL)	FOUNDATION PERMIT APPROVAL
ENGINEER'S CERT (TCL)	BUILDING PERMIT APPROVAL
ENGINEER'S CERT (DRB SITE PLAN)	GRADING PERMIT APPROVALSO-19 APPROVAL
ENGINEER'S CERT (ESC)	PAVING PERMIT APPROVAL ESC PERMIT APPROVAL
SO-19	WORK ORDER APPROVALESC CERT. ACCEPTANCE
OTHER (SPECIFY)	GRADING CERTIFICATION OTHER (SPECIFY)
WAS A PRE-DESIGN CONFERENCE ATTENDED:	Yes No Copy Provided
DATE SUBMITTED: 10.15.15	By: JOE SIMONS JC.
DATE SUDMITTED: (O ) - ( -	Dy: 00 F - 17(0143 01- 2

Requests for approvals of Site Development Plans and/or Subdivision Plats shall be accompanied by a drainage submittal. The particular nature, location, an scope to the proposed development defines the degree of drainage detail. One or more of the following levels of submittal may be required based on the followin

- 1. Conceptual Grading and Drainage Plan: Required for approval of Site Development Plans greater than five (5) acres and Sector Plans
- 2. Drainage Plans: Required for building permits, grading permits, paving permits and site plans less than five (5) acres
- 3. Drainage Report: Required for subdivision containing more than ten (10) lots or constituting five (5) acres or more
- 4. Erosion and Sediment Control Plan: Required for any new development and redevelopment site with 1-acre or more of land disturbing area, including project less than 1-acre than are part of a larger common plan of development

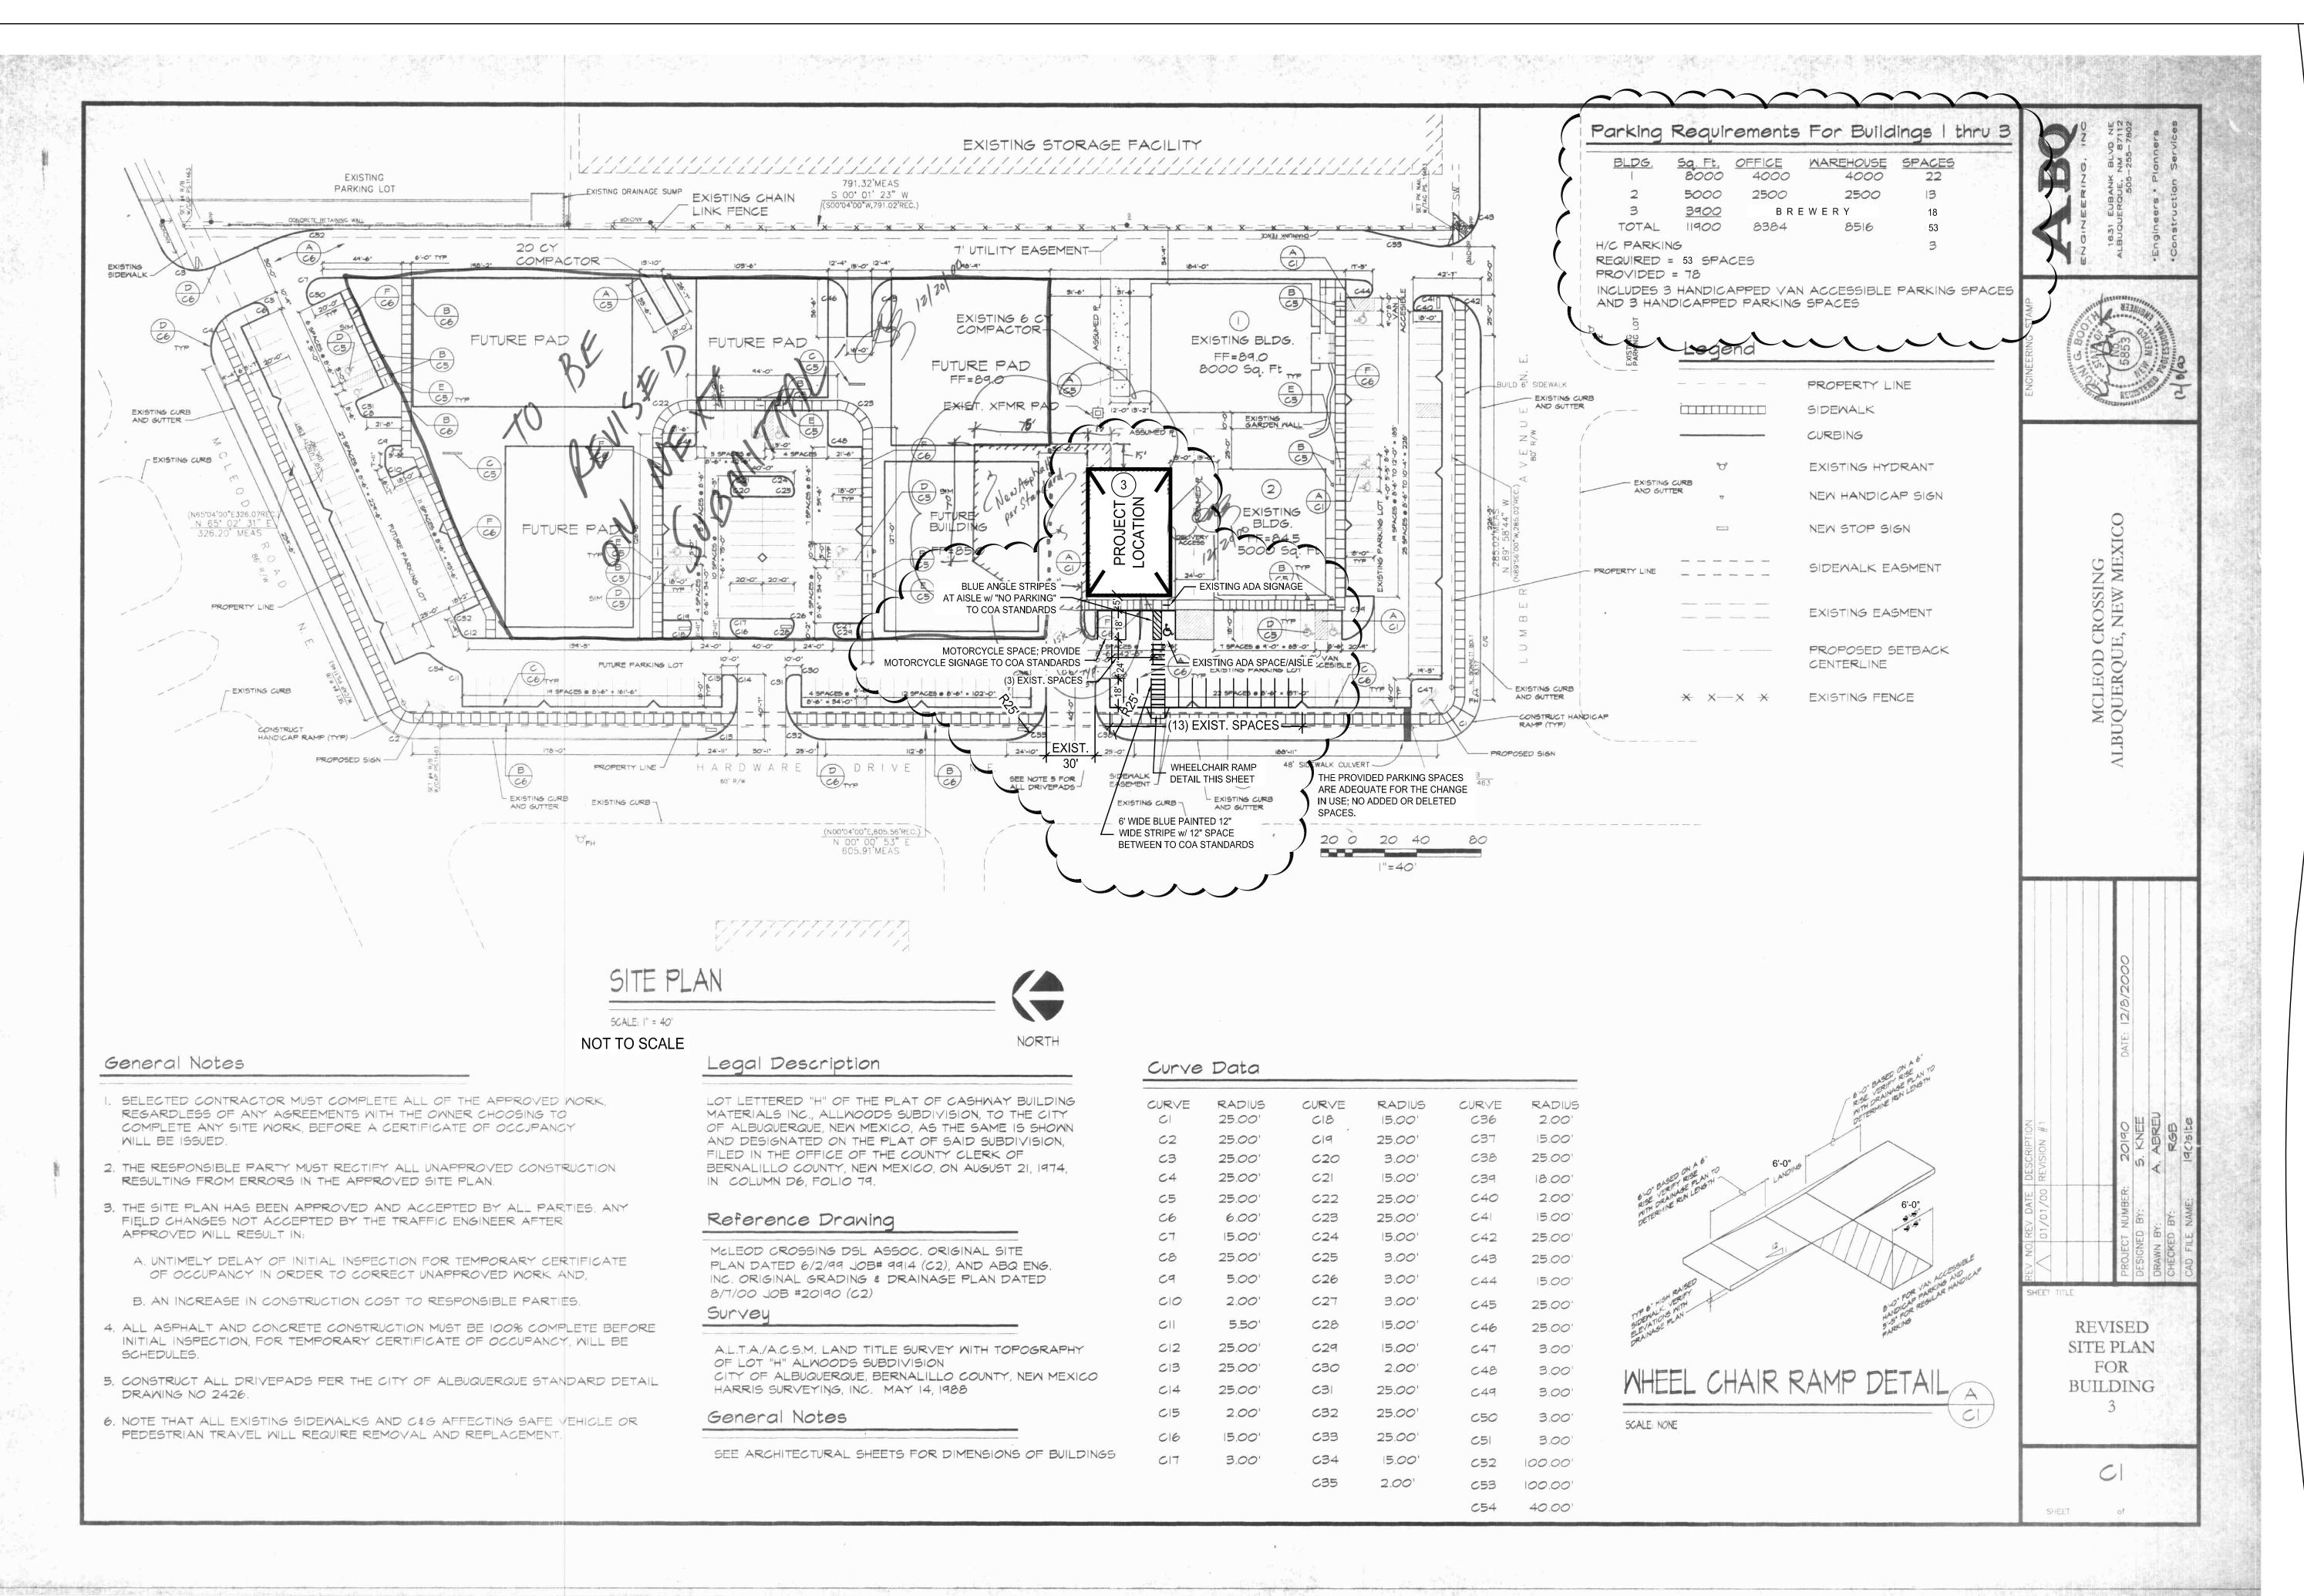

Joseph F.
Simons, Jr.
No. 2890
SOT. 15
VERED ARCHITE

MONS ARCHITECTURE IS NOT RESPONSIBLE FOR ANY WORK
ONE BY CONTRACTOR'SUB-CONTRACTOR OR SUPPLIER
LL MEASUREMENTS AND DIMENSIONS TO BE CHECKED &
ONFIRMED BY OWNER & CONTRACTOR.
MONS ARCHITECTURE, ALL RIGHTS RESERVED
OPYRIGHT WARRING
ESIGNS PREPARED BY SIMONS ARCHITECTURE
RE THE PROPERTY OF SIMONS ARCHITECTURE
ERROUGTION IN ANY FORM WITHOUT WRITTEN CONSENT IS
SYRESSLY PROHIBITED, FEDERAL COPYRIGHT PROTECTION
XTENDS TO ORIGINAL AND MODIFED DERIVATIVE PLANS,
S APPLICABLE TO INTENTIONAL AND UNINITENTIONAL
FIRMINGEMENTS, AND PROVIDES FOR SPECIFIC STATUTORY

eph f. simons jr., aia nm lic 002890 p.o. box 67408 abq, n.m., 87193-7408 ph.505.480.4796

SIMONS

CAMPBELL BREWERY
4814 HARDWARE DR. NE.
ALBUQUERQUE, NEW MEXICO
BERNALILLO COUNTY

JOB NUMBER
S.A. # CAMP-001
A.D. # 15-3695

DATE
08.07.15

DRAWING NAME
SITE PLAN


REVISIONS

DRAWN BY


ADWELLING

C

## **ADA SIGN DETAIL**

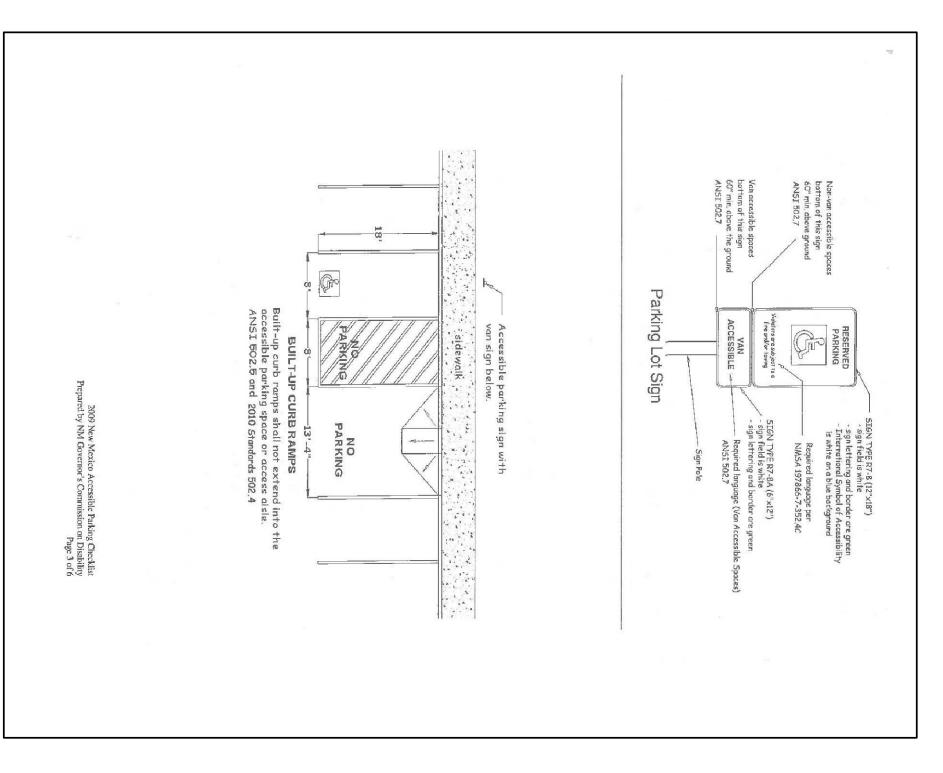

**CLARIFICATION NOTE FOR SITE PLAN** THE RAMP WIDTH IS TO BE 6' WIDE. RAMP DETAIL;

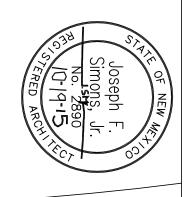



joseph f. simons jr., aia nm lic 002890 p.o. box 67408 abq, n.m., 87193-7408 ph.505.480.4796

**CAMPBELL BREWERY** 4814 HARDWARE DR. NE Albuquerque, NM Bernalillo County

ALL MEASUREMENTS AND DIMENSIONS TO BE CHECKED & CONFIRMED BY OWNER & CONTRACTOR.

DATE 10.19.15 JOB NUMBER

CAM-001

C1.1