




 












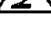




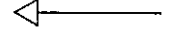




### LEGEND

FOR SURVEY LEGEND, SEE SHEET C-001

GRADING LEGEND:

	(38.00)	FUTURE SPOT ELEVATION
	38.00	PROPOSED SPOT ELEVATION
	...	EXISTING FLOWLINE
	...	PROPOSED FLOWLINE
	5240	PROPOSED CONTOUR
		EXISTING DIRECTION OF FLOW
		PROPOSED DIRECTION OF FLOW
		HIGH POINT / DIVIDE
		PROPOSED CONCRETE
		PROPOSED ASPHALT

## SHEET CG-101-S KEYED NOTES:

- (1)  INSTALL 18" RCP PREFABRICATED END SECTION.
- (2)  INSTALL 18" RCP (CLASS III) STORM DRAIN.
- (3)  CONSTRUCT TYPE "C" INLET PER STD DWG 2205, SHEET CG-301.
- (4)  REFER TO SHEET CP-101-S FOR REMOVAL AND REPLACEMENT OF CONCRETE PAD.  
MATCH NEW PAVEMENT OR CONCRETE ELEVATION WITH NEW RIM AND PAD.
- (5)  EXISTING CLEANOUT TO BE ADJUSTED TO GRADE, REFER TO SHEET CP-101-S.
- (6)  DEPRESS THIS AREA FOR WATER HARVESTING.
- (7)  MATCH EXISTING GRADE.
- (8)  INSTALL 12" HDPE (SMOOTH INTERIOR) STORM DRAIN.
- (9)  INSTALL 18" NYOPLAST DRAIN BASIN WITH 12" HINGED STANDARD GRATE.
- (10)  INSTALL 15"x15"x15" HDPE CROSS WITH 15"x8" REDUCERS ON SW & SE LEGS.
- (11)  CORE DRILL OPENING FOR NEW 15" DPE PIPE INV 27.30. INSERT NEW PIPE WITH  
WATER STOP AND PACK WITH NON-~~E~~ RINK GROUT.
- (12)  INSTALL 15" HDPE (SMOOTH INTERIOR) STORM DRAIN.

2 RECORD DRAWING LEGEND

CONSTRUCT	RECORD INFORMATION AS-BUILT SURVEY
✓	AS-CONSTRUCTED = AS-DESIGNED (VERIFIED BY AS-BUILT SURVEY)
38' 42"	RECORD INFORMATION FROM AS-BUILT SURVEY
+25.2	RECORD INFORMATION FROM AS-BUILT SURVEY
⊕ 28.98/92	RECORD INFORMATION FROM AS-BUILT SURVEY

DEL NORTE  
HIGH SCHOOL  
5323 MONTGOMERY NE  
ALBUQUERQUE, NM

THIS IS NOT A BOUNDARY SURVEY; DATA IS SHOWN FOR ORIENTATION ONLY. THE BOUNDARY INFORMATION DEPICTED BY THIS PLAN IS BASED UPON THE BOUNDARY SURVEY PREPARED BY HIGH MESA CONSULTING GROUP, NMPS NO. 11184, DATED 06/30/2008. TOPOGRAPHIC SURVEY INFORMATION IS BASED UPON A TOPOGRAPHIC SURVEY PREPARED BY HIGH MESA CONSULTING GROUP ON 06/30/2008. NMPS NO. 11184, AN OFFSITE TOPOGRAPHIC AND UTILITY SURVEY PREPARED BY HIGH MESA CONSULTING GROUP ON 07/23/2008, NMPS NO. 11184, AND SUPPLEMENTAL TOPOGRAPHIC AND UTILITY SURVEYS PREPARED BY HIGH MESA CONSULTING GROUP DATED 10/06/2009 AND 01/03/2011. NMES NO. 11184.

REVISIONS

1	NO CHANGE THIS SHEET
2	ENGINEER'S CERTIFICATION

DRAWN BY	J.Y.R.
REVIEWED BY	G.M.
DATE	03-04-2013
PROJECT NO.	08-0041
DRAWING NAME	
GRADING PLAN - SOUTH	

SHEET NO.  
CG-101-S

INDUSTRIAL AND  
FINE ARTS BUILDING



**HIGH  
MESA Consulting Group**

6010-B MIDWAY PARK BLVD. NE • ALBUQUERQUE, NEW MEXICO 87109  
PHONE: 505.345.4250 • FAX: 505.345.4254 • [www.highmesacq.com](http://www.highmesacq.com)

~~201318282010.048.1~~

**RECORD DRAWING**  
**SEE SHEET C-001. FOR CERTIFICATION**


A1 GRADING PLAN - SOUTH  
SCALE: 1" = 20'

SCALE: 1" = 20'






FOR SURVEY LEGEND, SEE SHEET C-001

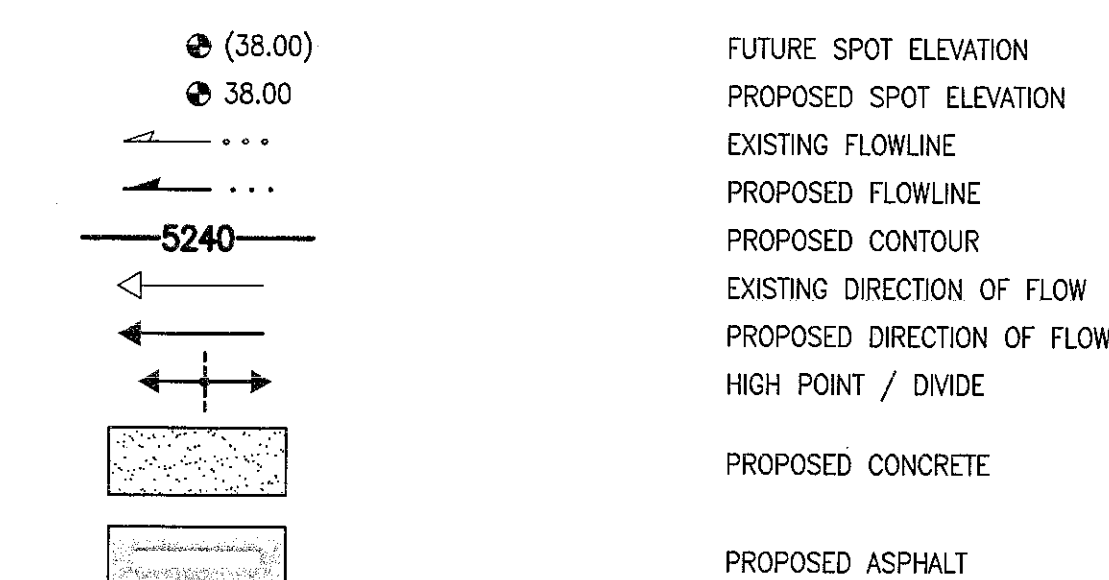GRADING LEGEND:



## SHEET CG-101-N KEYED NOTES:


- ⑦ TRANSITION FROM MOUNTABLE CURB TO STANDARD CURB AND GUTTER
- ⑧ MATCH EXISTING GRADE
- ⑨  CONSTRUCT 2'-0" CURB OPENING @ FLOWLINE ELEVATION
- ⑩ EXISTING CLEANOUT TO BE ADJUSTED TO GRADE, REFER TO SHEET CP-101-S
- ⑪ EXISTING STORM DRAIN TO REMAIN
- ⑫  INSTALL 15" HOPE (SMOOTH INTERIOR) STORM DRAIN
- ⑬  INSTALL 15" HOPE CAP

SURVEY NOTE:

THIS IS NOT A BOUNDARY SURVEY; DATA IS SHOWN FOR ORIENTATION ONLY. THE BOUNDARY INFORMATION DEPICTED BY THIS PLAN IS BASED UPON THE BOUNDARY SURVEY PREPARED BY HIGH MESA CONSULTING GROUP, NMPS NO. 11184, DATED 06/30/2008. TOPOGRAPHIC SURVEY INFORMATION IS BASED UPON A TOPOGRAPHIC SURVEY PREPARED BY HIGH MESA CONSULTING GROUP ON 06/30/2008. NMPS NO. 11184, AN OFFSITE TOPOGRAPHIC AND UTILITY SURVEY PREPARED BY HIGH MESA CONSULTING GROUP ON 07/23/2008, NMPS NO. 11184, AND SUPPLEMENTAL TOPOGRAPHIC AND UTILITY SURVEYS PREPARED BY HIGH MESA CONSULTING GROUP DATED 10/06/2008 AND 01/03/2011. NMPS NO. 11184.

GENERAL NOTES:

1. REFER TO UTILITY PLAN FOR EXISTING AND PROPOSED UTILITIES.
2. STOCKPILE IS AVAILABLE FOR USE BY CONTRACTOR.
3. DEMO CONSTRUCTION IN PROGRESS AT TIME OF PLAN PREPARATION - CONTRACTOR TO VERIFY FIELD CONDITIONS AT TIME OF BIDDING.

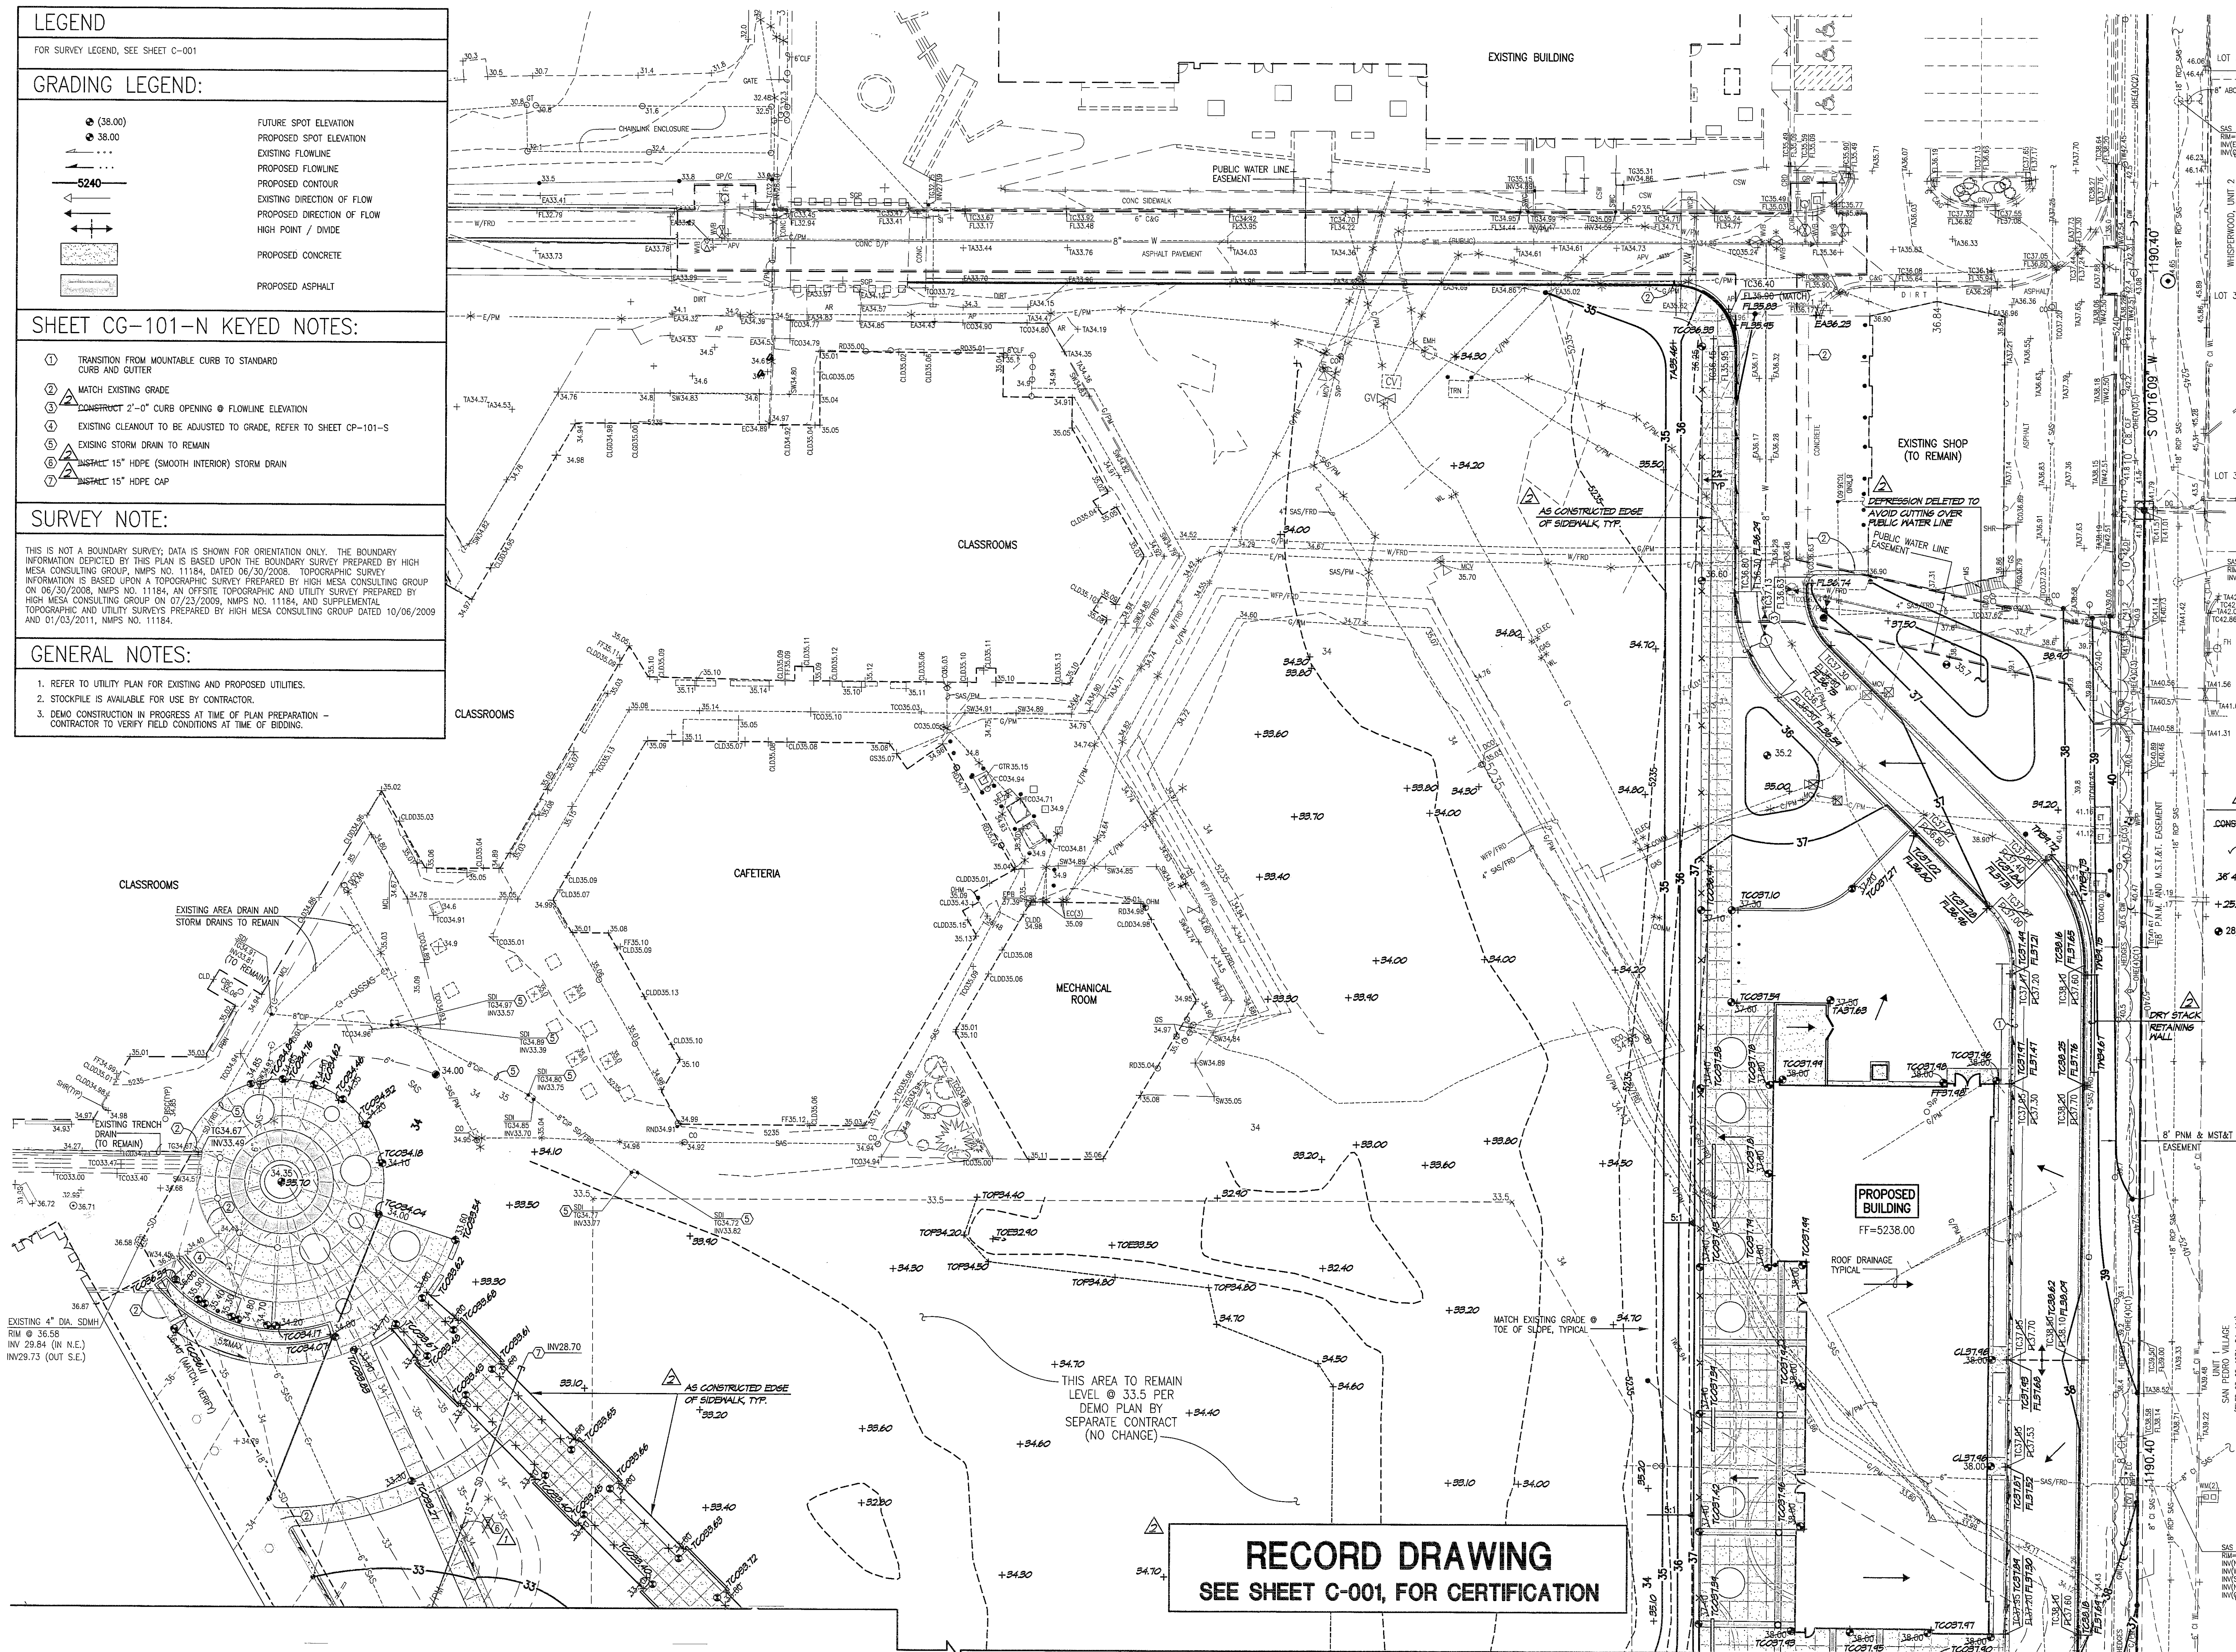

### RECORD DRAWING LEGEND

- |             |   |
|-------------|---|
| CONSTRUCT   | RECORD INFORMATION AS-BUILT SURVEY                            |
| ✓           | AS-CONSTRUCTED = AS-DESIGNED<br>(VERIFIED BY AS-BUILT SURVEY) |
| 38' 42"     | RECORD INFORMATION FROM<br>AS-BUILT SURVEY                    |
| + 25.2      | RECORD INFORMATION FROM<br>AS-BUILT SURVEY                    |
| ④ 28.95' 42 | RECORD INFORMATION FROM<br>AS-BUILT SURVEY                    |

## REVISIONS

- KEYED NOTE ON  
SHEET CG-101-N  
**ENGINEER'S CERTIFICATION**

DRAWN BY	J.Y.R.
REVIEWED BY	G.M.

DATE	02-04-2010
------	------------

DATE 03-04-2013

PROJECT NO. 08-0041

21 DRAWING NAME

## GRADING PLAN (NORTH)

SHEET NO.

CG-101-N

OF