



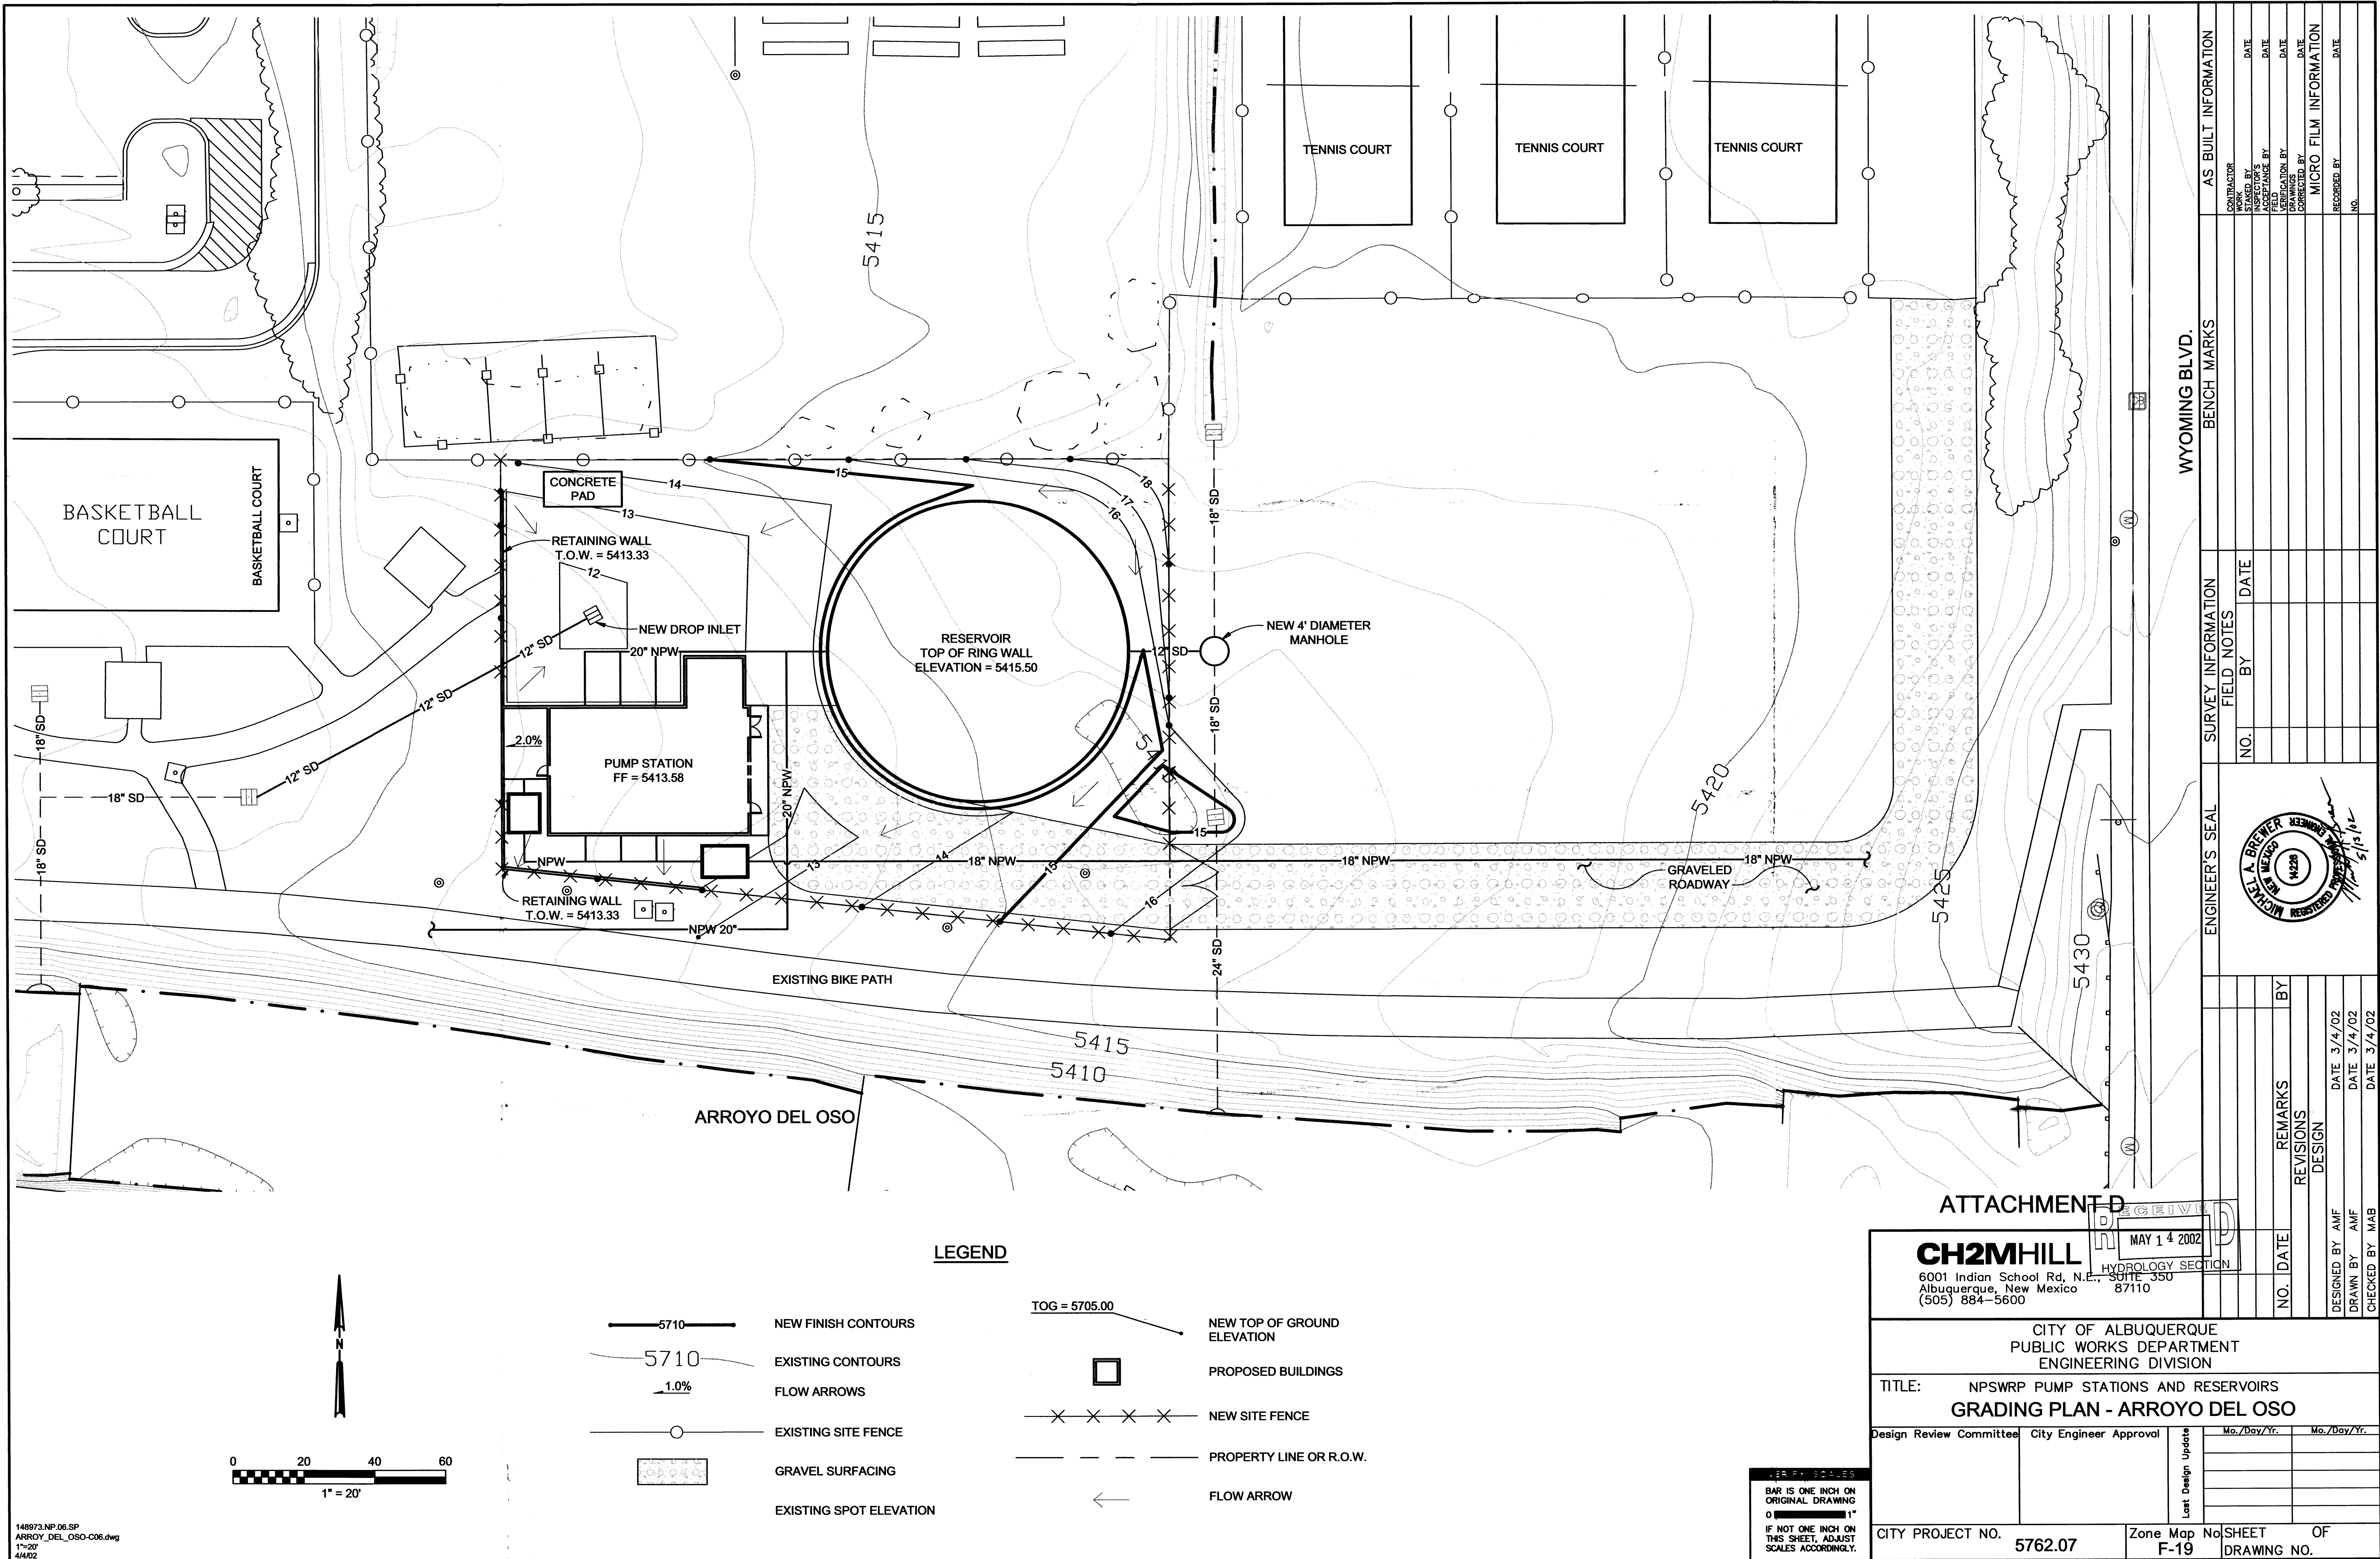

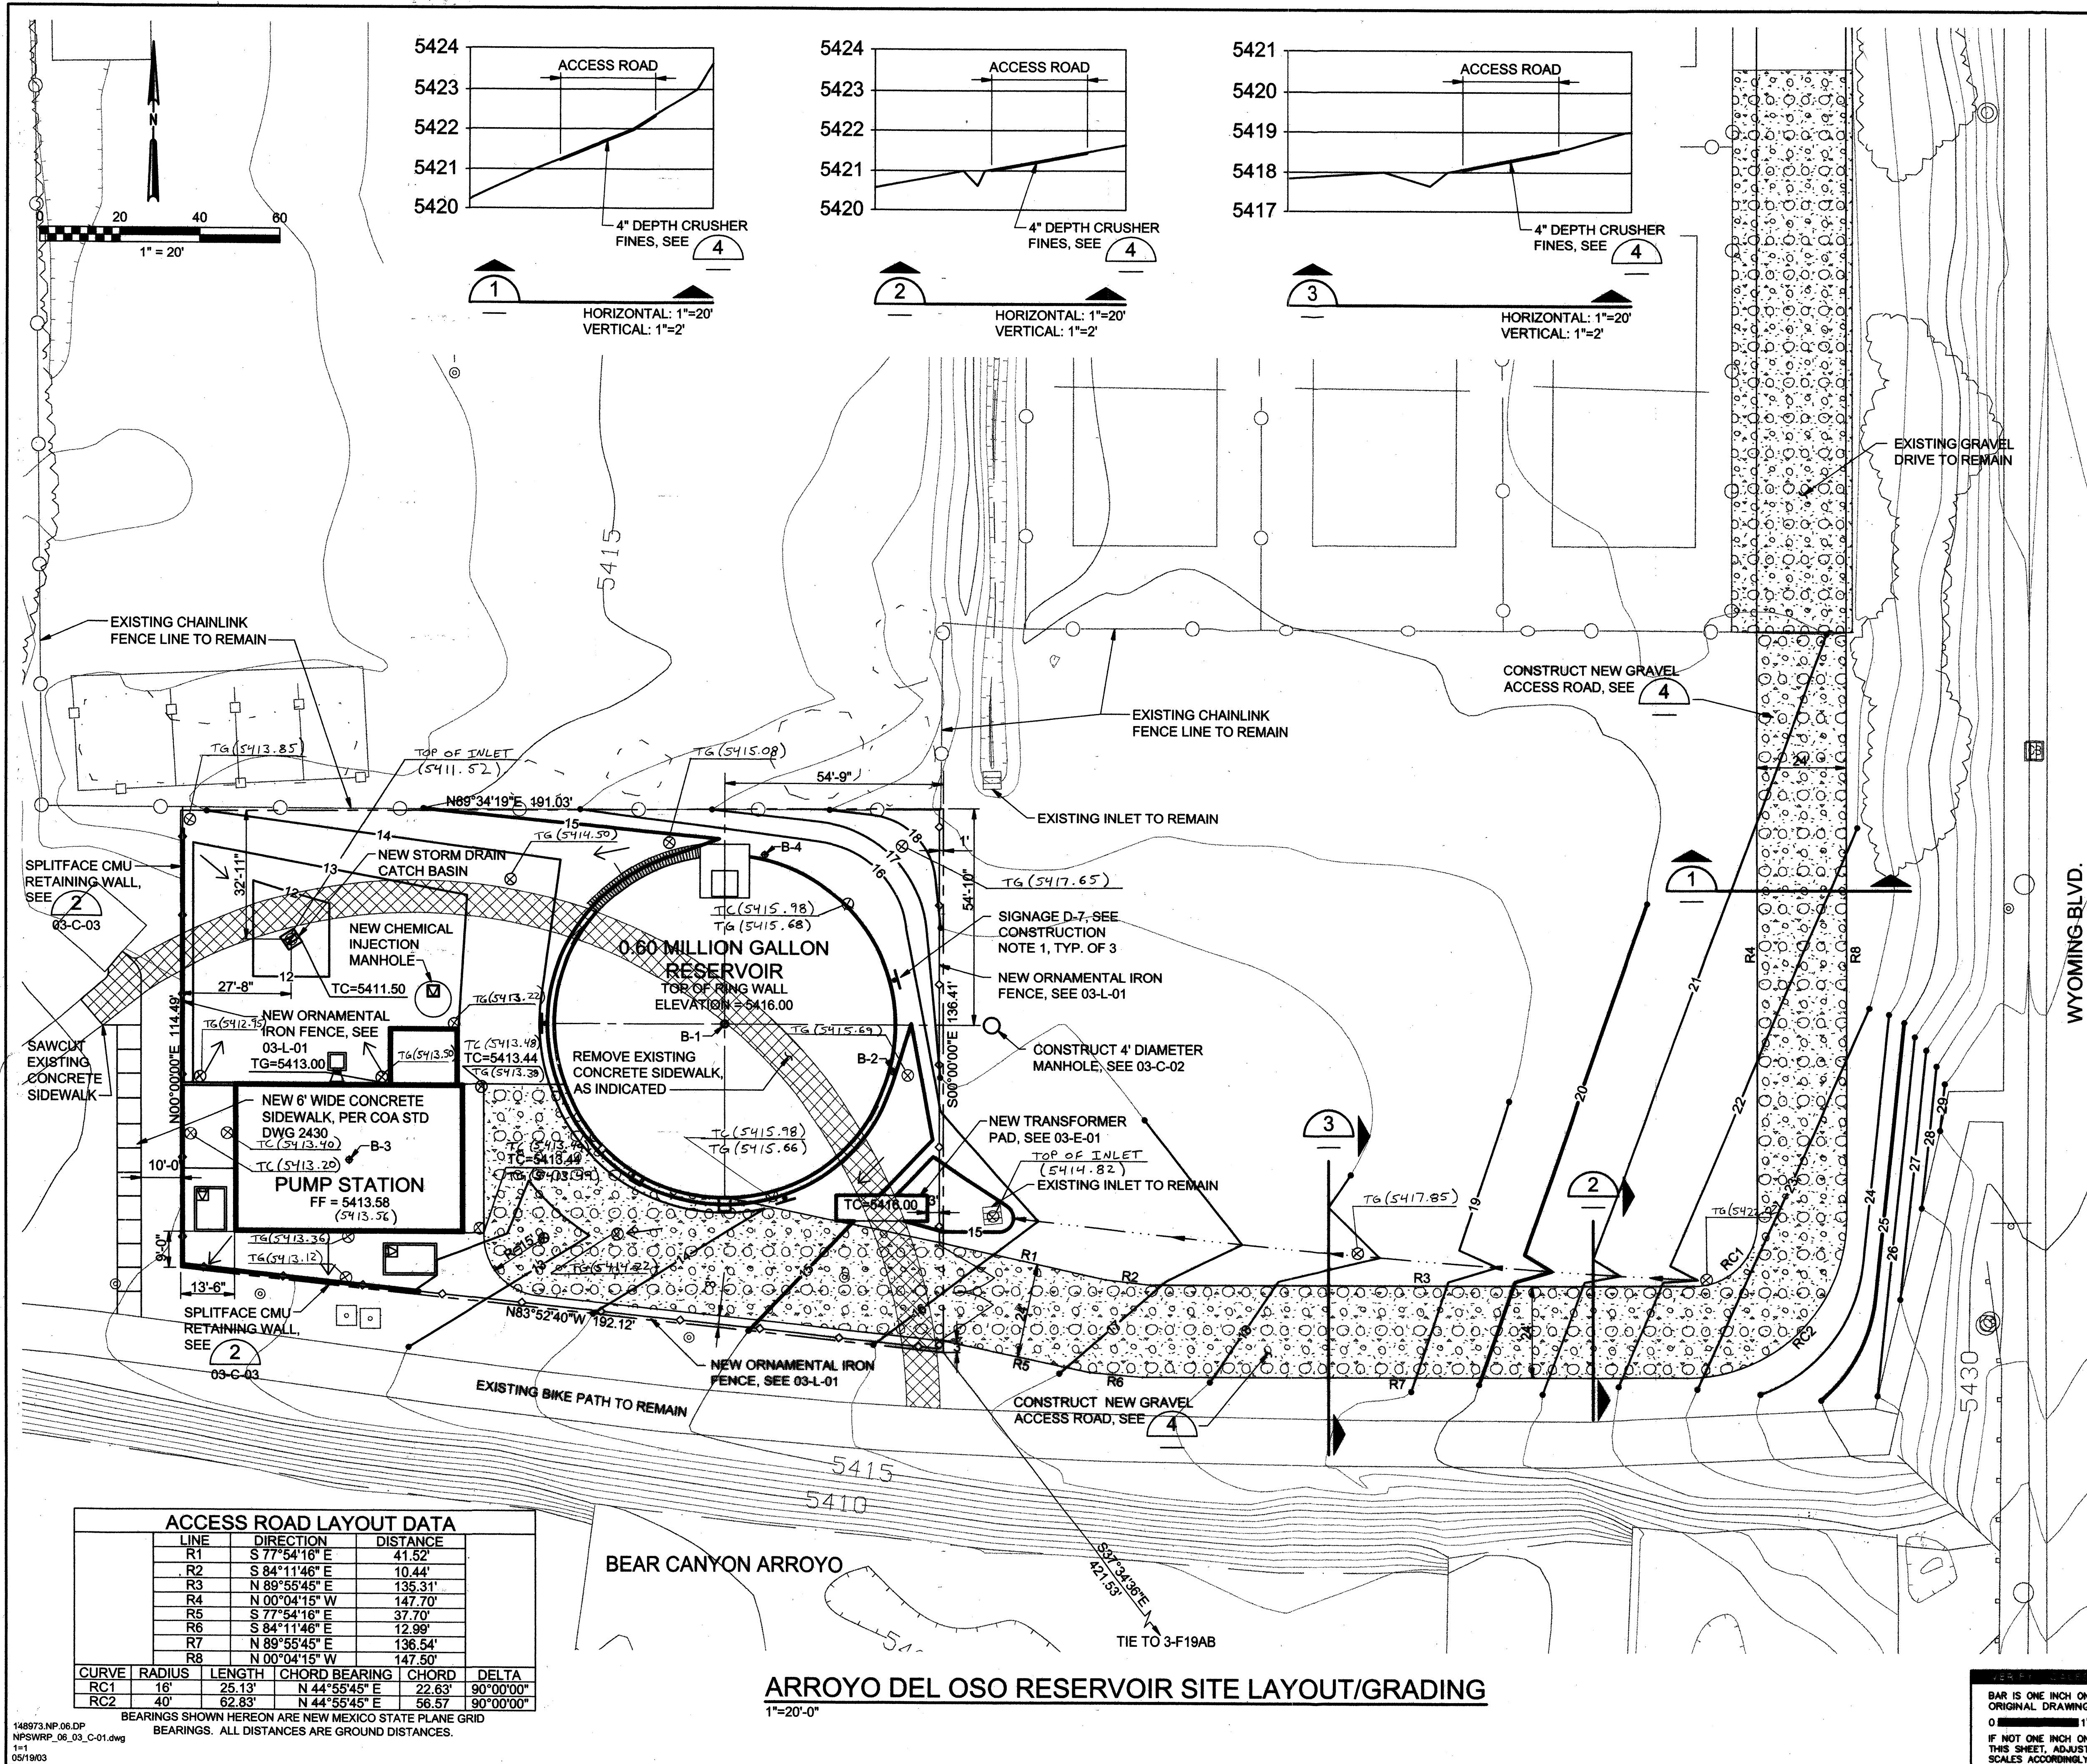

ACCESS ROAD LAYOUT DATA					
LINE	DIRECTION	DISTANCE			
R1	S 77°54'16" E	41.52'			
R2	S 84°11'46" E	10.44'			
R3	N 89°55'45" E	135.31'			
R4	N 00°04'15" W	147.70'			
R5	S 77°54'16" E	37.70'			
R6	S 84°11'46" E	12.99'			
R7	N 89°55'45" E	136.54'			
R8	N 00°04'15" W	147.50'			
CURVE	RADIUS	LENGTH	CHORD BEARING	CHORD	DELTA
RC1	16'	25.13'	N 44°55'45" E	22.63'	90°00'00"
RC2	40'	62.83'	N 44°55'45" E	56.57'	90°00'00"

BEARINGS SHOWN HEREON ARE NEW MEXICO STATE PLANE GRID BEARINGS. ALL DISTANCES ARE GROUND DISTANCES.

148973.NP.06.DP
NPSWRP_06_03_C-01.dwg
1-1
05/19/03

ARROYO DEL OSO RESERVOIR SITE LAYOUT/GRADING

CONSTRUCTION NOTES:
1. PROVIDE AND INSTALL SIGNAGE, POST MOUNTED PER SPECIFICATION SECTION 10400 IDENTIFYING DEVICES.

LEGEND:
B-2 SOIL BORING LOCATION
NEW ORNAMENTAL IRON FENCE

TC TOP OF CONCRETE



TG TOP OF GROUND

5291.50 (5291.20)
DESIGN (AS BUILT)


I, MIKE BREWER, NMPE 14226, OF THE FIRM CH2M HILL, INC. HEREBY CERTIFY THAT THIS PROJECT HAS BEEN GRADED AND WILL DRAIN IN SUBSTANTIAL COMPLIANCE WITH AND IN ACCORDANCE WITH THE DESIGN INTENT OF THE APPROVED PLAN DATED 05/19/2003. THE RECORD INFORMATION EDITED ONTO THE ORIGINAL DESIGN DOCUMENT HAS BEEN OBTAINED BY ME OR UNDER MY DIRECT SUPERVISION AND IS TRUE AND CORRECT TO THE BEST OF MY KNOWLEDGE AND BELIEF. THIS CERTIFICATION IS SUBMITTED IN SUPPORT OF A REQUEST FOR CERTIFICATE OF OCCUPANCY (PERM.).

THE RECORD INFORMATION PRESENTED HEREON IS NOT NECESSARILY COMPLETE AND INTENDED ONLY TO VERIFY SUBSTANTIAL COMPLIANCE OF THE GRADING AND DRAINAGE ASPECTS OF THIS PROJECT. THOSE RELYING ON THIS RECORD DOCUMENT ARE ADVISED TO OBTAIN INDEPENDENT VERIFICATION OF ITS ACCURACY BEFORE USING IT FOR ANY OTHER PURPOSE.

MIKE BREWER,
DATE 6/6/05

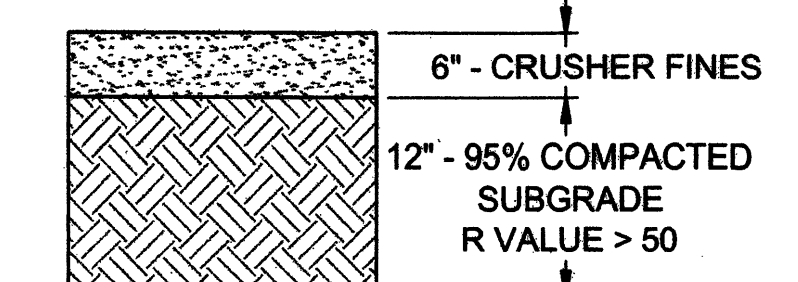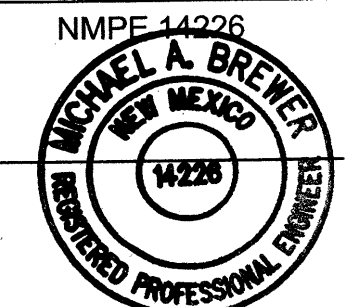


ACCESS ROAD SECTION
N.T.S.

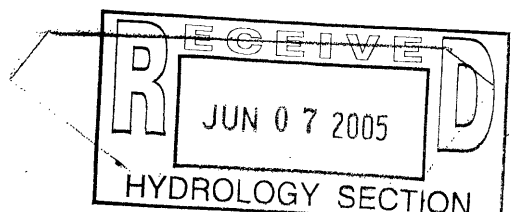

CH2MHILL
6001 Indian School Rd., N.E., SUITE 350
Albuquerque, New Mexico 87110
(505) 884-5600

CITY OF ALBUQUERQUE
PUBLIC WORKS DEPARTMENT
ENGINEERING DIVISION


TITLE: NONPOTABLE WATER PUMP STATIONS AND RESERVOIRS
ARROYO DEL OSO SITE LAYOUT/GRADING PLAN

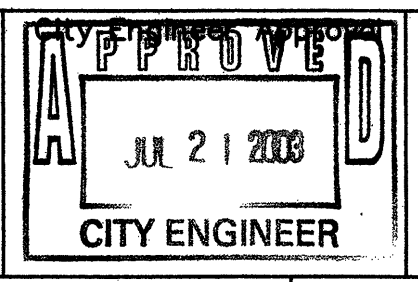

CITY PROJECT NO. 5762.07


Zone Map No. SHEET 40 OF 134
F-19 DRAWING NO. 03-C-01

AS BUILT INFORMATION		BENCH MARKS		SURVEY INFORMATION		ENGINEER'S SEAL	
CONTRACTOR	DATE	BENCHMARK LOCATED AT THE SE CORNER OF THE	DATE	NO.	BY	NO.	BY
WORK DONE BY	DATE	CITY-OWNED ARROYO DEL OSO GOLF COURSE AT THE	DATE				
INSPECTOR'S	DATE	NW QUADRANT OF THE INTERSECTION OF WYOMING	DATE				
ACCEPTANCE BY	DATE	BLVD. AND OSUNA RD. ACS BRASS TABLET STAMPED	DATE				
VERIFICATION BY	DATE	"3-F19AB" SET ON TOP OF CONCRETE POST FLUSH	DATE				
COMPLETED BY	DATE	WITH AND SUBTENDED BY CONCRETE CURB	DATE				
MICRO FILM INFORMATION	DATE		DATE				
RECORDED BY	DATE		DATE				
NO.			DATE				

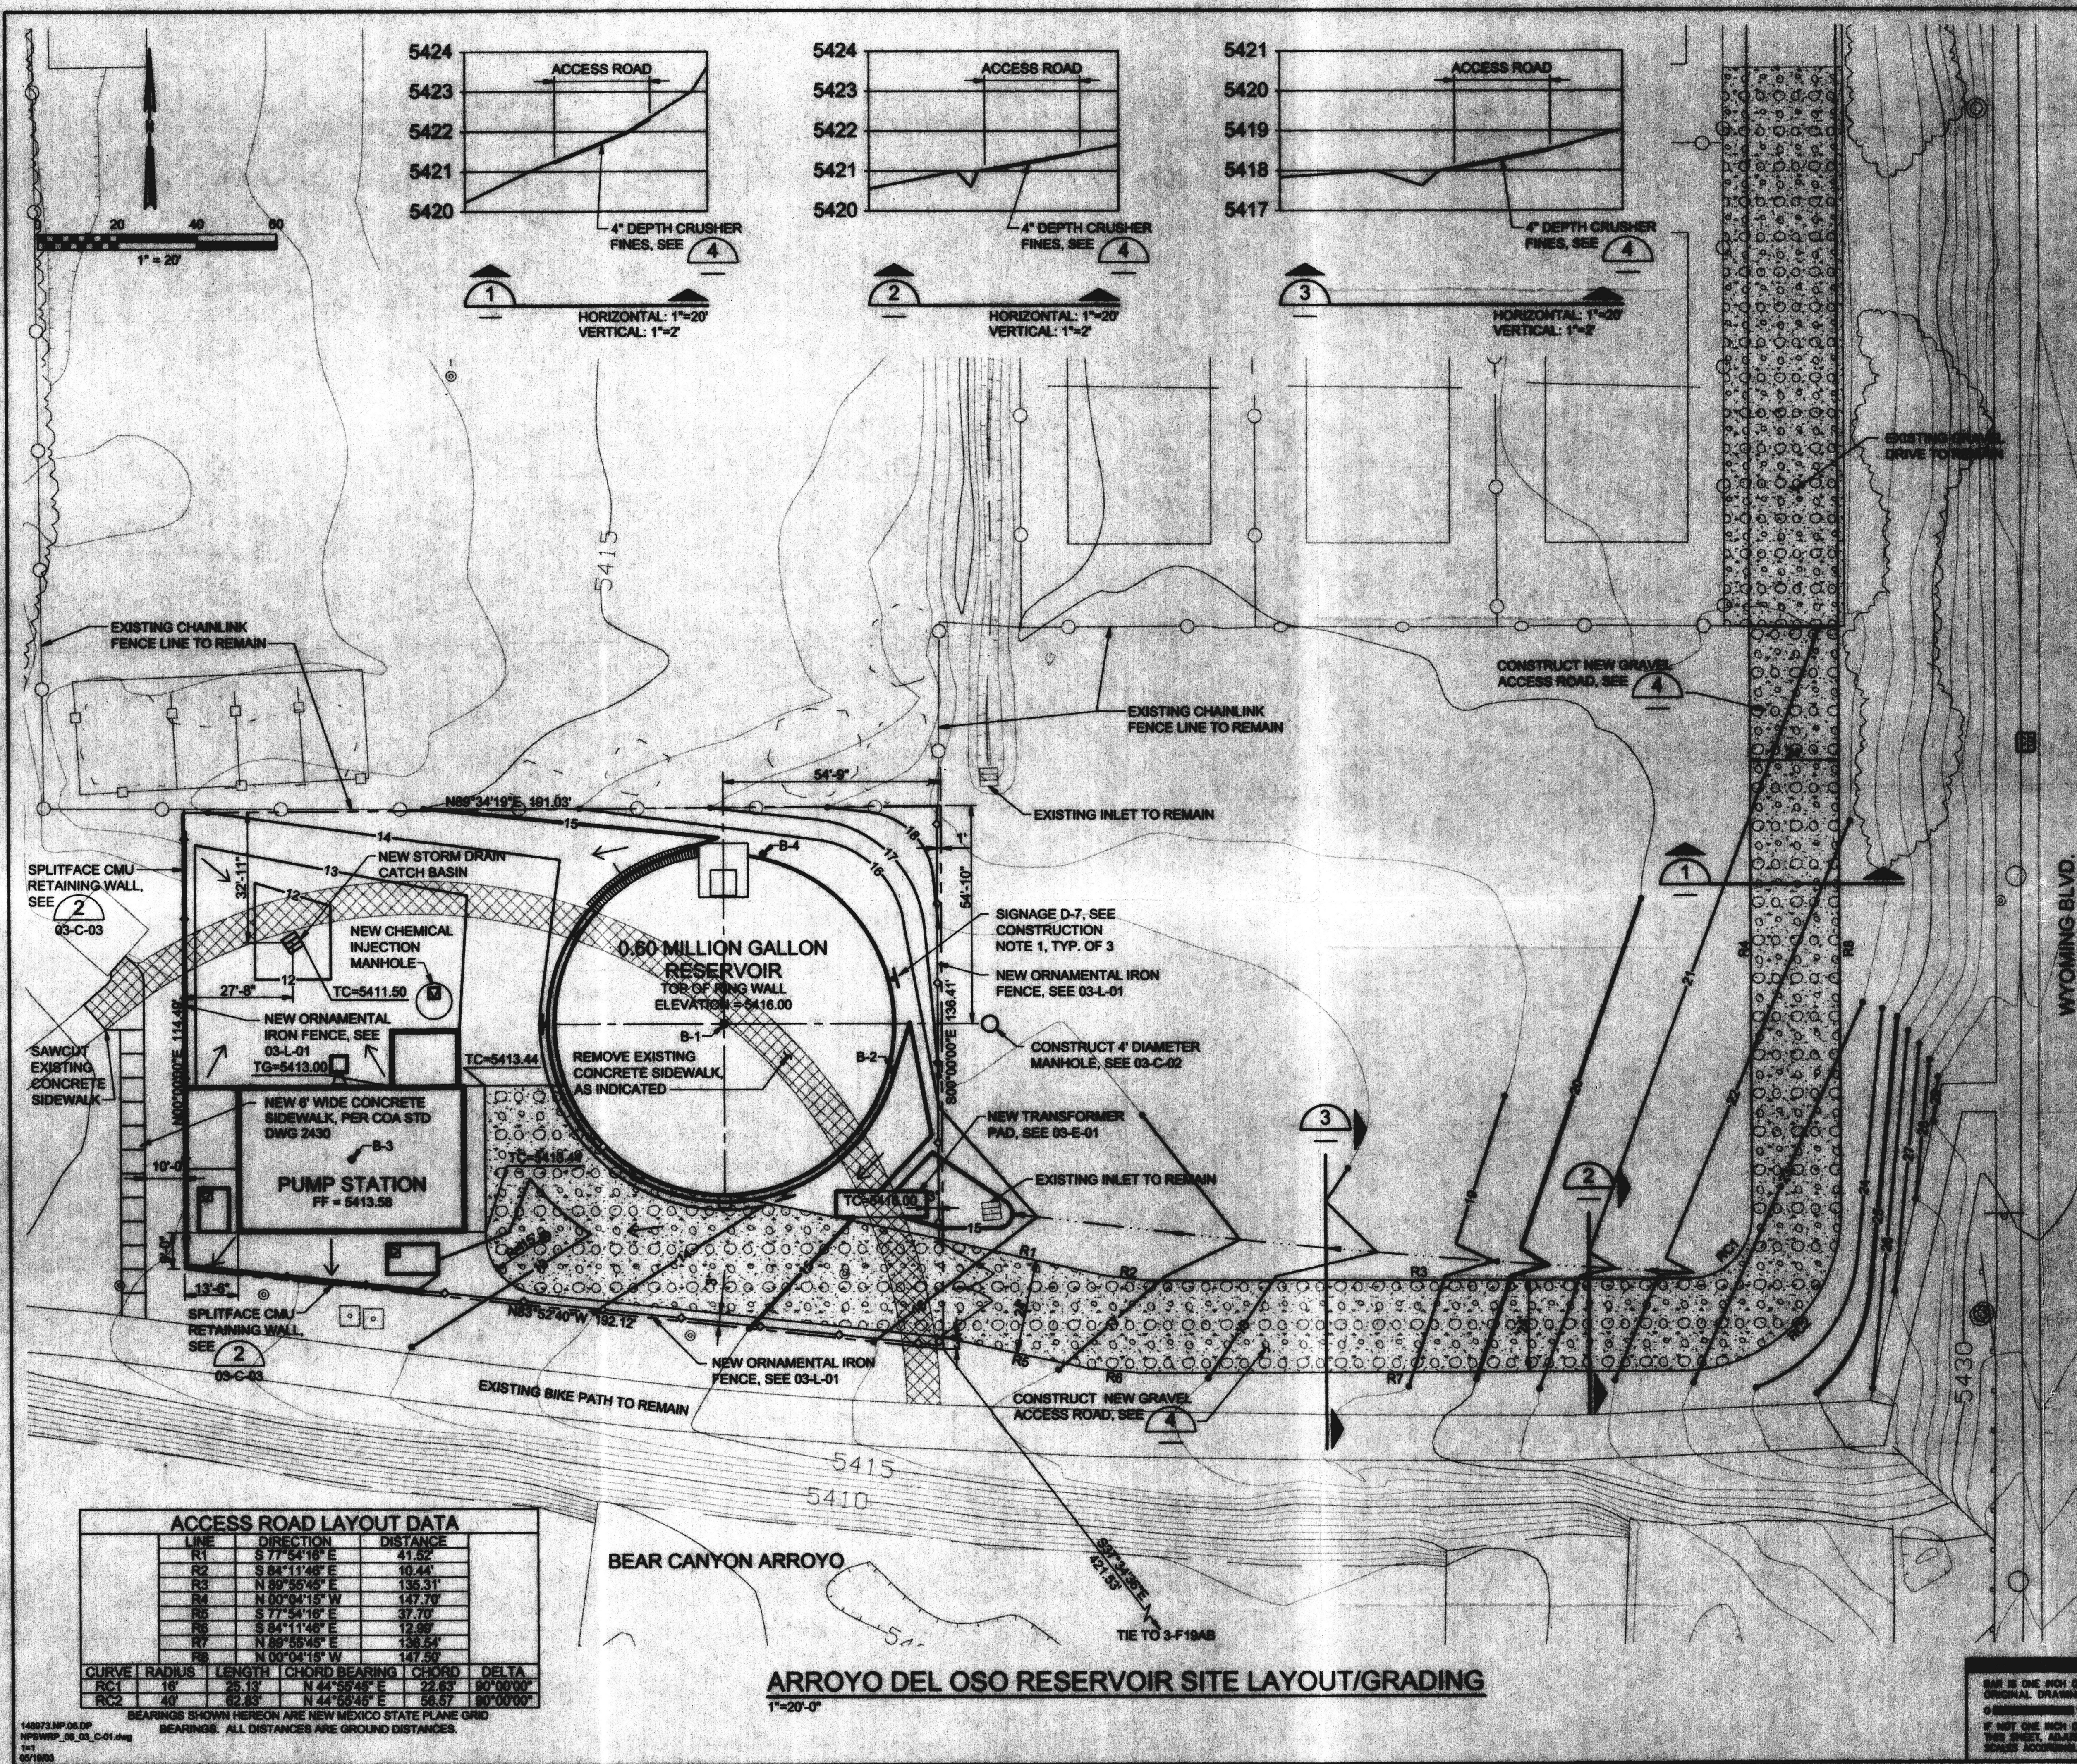

CONSTRUCTION NOTES:
 1. PROVIDE AND INSTALL SIGNAGE POST ISOLATED PER SPECIFICATION SECTION 03-01 IDENTIFYING DEVICES.

LEGEND:
 8-2 SOIL BORING LOCATION
 NEW ORNAMENTAL IRON FENCE

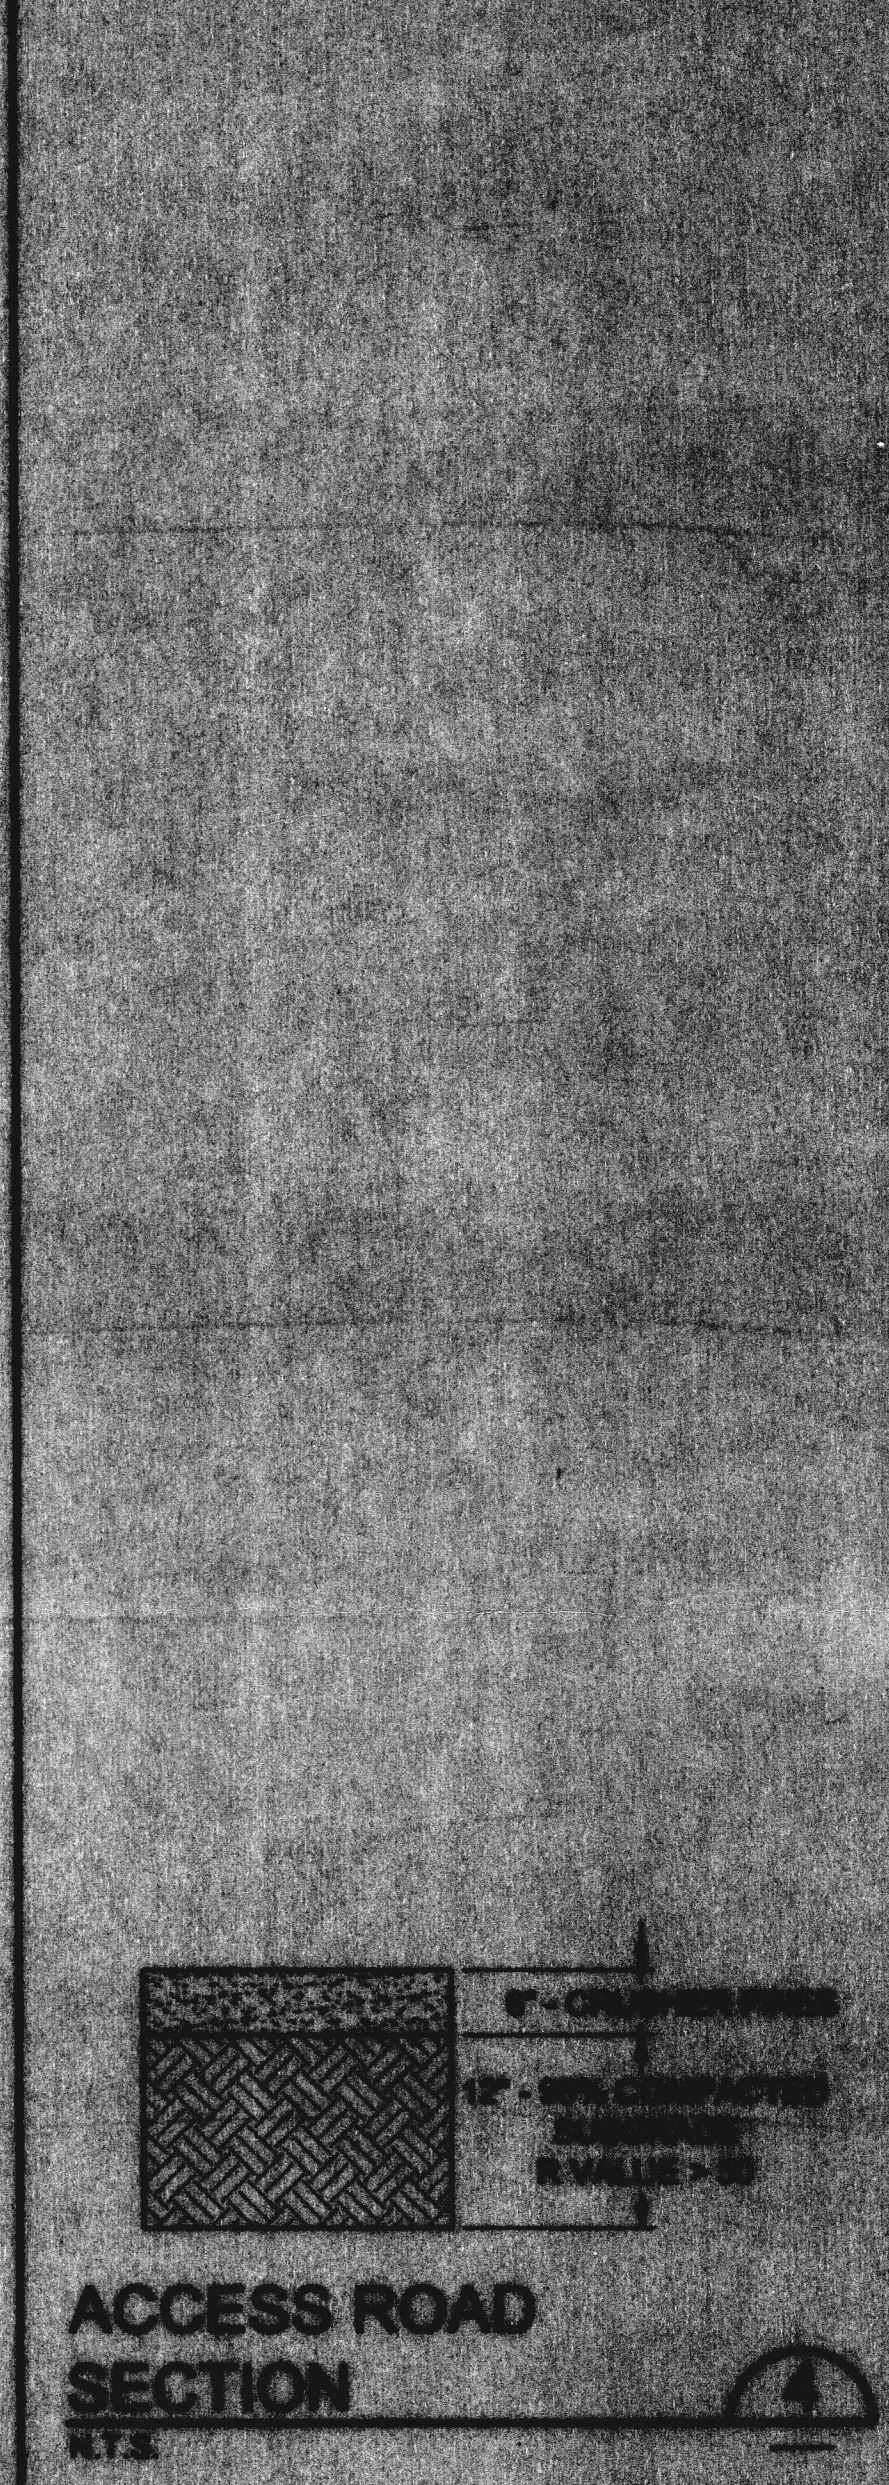

ACCESS ROAD SECTION
 1/2" = 1' HORIZONTAL
 1" = 2' VERTICAL

CH2M HILL
 5001 Indian School Rd. N.E.
 Albuquerque, New Mexico 87110
 (505) 884-5600

CITY OF ALBUQUERQUE
 PUBLIC WORKS DEPARTMENT
 ENGINEERING DIVISION

TITLE: NONPOTABLE WATER PLANT STATIONS AND RESERVOIRS
ARROYO DEL OSO SITE LAYOUT/GRADING PLAN

Design Review Committee City Engineer Approval

CITY PROJECT NO. 5762.07 **Sheet No.** 40 OF 124
DATE 11/15/2003 **DRAWING NO.** 03-C-01

NO.	DATE	BY	REVISIONS
1			
2			
3			
LINE	DIRECTION	DISTANCE
R1	S 77° 54' 16" E	41.52
R2	S 84° 11' 46" E	10.44
R3	N 89° 55' 45" E	135.31
R4	N 00° 04' 15" W	147.70
R5	S 77° 54' 16" E	37.70
R6	S 84° 11' 46" E	12.95
R7	N 89° 55' 45" E	135.54
R8	N 00° 04' 15" W	147.50

CURVE	RADIUS	LENGTH	CHORD BEARING	CHORD	DELTA
RC1	16'	23.13	N 44° 55' 45" E	22.63	90° 00' 00"
RC2	40'	62.83	N 44° 55' 45" E	58.57	90° 00' 00"

BEARINGS SHOWN HEREON ARE NEW MEXICO STATE PLANE GRID BEARINGS. ALL DISTANCES ARE GROUND DISTANCES.

148973.NP.03.DP
 NP03WP_03_03_01.dwg
 11/15/2003