
CITY OF ALBUQUERQUE

Planning Department
Brennon Williams, Director

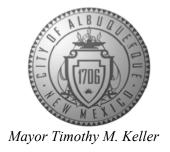

October 30, 2020

Ryan Morrissey Burkhardt Engineering Company 28 N. Cherry St. Germantown, OH 45327

Re: 4516 Wyoming NE

Request Permanent C.O.

Engineer's Stamp dated: 6-10-19 (F20D005)

Certification dated: 10-15-2020

Dear Mr. Morrissey,

Based upon the information provided in your submittal received 10/15/2020 and site visit on

10/30/20, this plan is approved for Certificate of Occupancy by Hydrology.

PO Box 1293

Albuquerque If you have any questions, you can contact me at 924-3986 or earmijo@cabq.gov.

Sincerely,

NM 87103

Ernest Armijo, P.E.

www.cabq.gov Principal Engineer, Planning Dept.

Development Review Services



City of Albuquerque

Planning Department

Development & Building Services Division

DRAINAGE AND TRANSPORTATION INFORMATION SHEET (REV 10/2018)

Project Title: Champion Xpress Car Wash	Building Permit #: BP-2019-00083	Hydrology File #: <u>F20D005</u>	
DRB#: PR-2019-001951	EPC#:	Work Order#: 436680	
Legal Description: Portion of Tract 11-N, Block 11 of	Ofimiano J. Gutierrez Lower Terrace, City of Albu	querque, Bernalillo County, New Mexico	
City Address: 4516 Wyoming Blvd. N. E. , Albuquerque	NM 8711		
Applicant: VIA Real Estate, LLC.		Contact: Derrick Merchant	
Address: 13105 Dover Ave., Lubbcok, TX 79424			
Phone#: 806-368-7843	Fax#:	E-mail: derrick@7bdev.com	
Other Contact: Burkhardt Engineering Company		Contact: Ryan Morrissey	
Address: ^{28 N.} Cherry St., Germantown, OH 45327			
Phone#: 937-388-0060	Fax#:	E-mail: rmorrissey@burkhardtinc.com	
TYPE OF DEVELOPMENT: PLAT (#			
IS THIS A RESUBMITTAL? Yes	× No		
DEPARTMENT: X TRAFFIC/TRANSPOR	TATION X HYDROLOGY/DR	AINAGE	
Check all that Apply:	TYPE OF APPR	OVAL/ACCEPTANCE SOUGHT:	
TYPE OF CUDMITTAL.		PERMIT APPROVAL	
× ENGINEER/ARCHITECT CERTIFICATION	M	TE OF OCCUPANCY	
PAD CERTIFICATION	PRELIMINA	ARY PLAT APPROVAL	
CONCEPTUAL G & D PLAN		FOR SUB'D APPROVAL	
GRADING PLAN		SITE PLAN FOR BLDG. PERMIT APPROVAL	
DRAINAGE MASTER PLAN		FINAL PLAT APPROVAL	
DRAINAGE REPORT		SIA/ RELEASE OF FINANCIAL GUARANTEE	
FLOODPLAIN DEVELOPMENT PERMIT	A DDI IC	FOUNDATION PERMIT APPROVAL GRADING PERMIT APPROVAL	
ELEVATION CERTIFICATE	GRADING		
CLOMR/LOMR		SO-19 APPROVAL	
TRAFFIC CIRCULATION LAYOUT (TCI		PAVING PERMIT APPROVAL	
TRAFFIC IMPACT STUDY (TIS)	GRADING/	GRADING/ PAD CERTIFICATION	
OTHER (SPECIFY)		WORK ORDER APPROVAL CLOMR/LOMR	
PRE-DESIGN MEETING?			
		IN DEVELOPMENT PERMIT PECIFY)	
DATE SUBMITTED: 10-14-2020			
COA STAFF:	ELECTRONIC SUBMITTAL RECEIVED:		

FEE PAID:_____

IDO Zone Atlas F-20-Z


PROPERTY INFORMATION

Address: 4516 Wyoming Blvd. N.E., Albuquerque, NM 87111 Legal Description: Portion of Tract 11-N, Block 11 of Ofimiano J. Gutierrez Lower Terrace, City of Albuquerque, Bernalillo County, New Mexico. Area: 1.0307 acres

Zoning: "MX-M" Mixed Use - Moderate Intensity Zone District Flood Zone: FIRM # 35001C0143G, effective date: September 26, 2008 Zone "X": Areas determined to be outside the 0.2% annual chance floodplain. Note - Wyoming Boulevard subject to flooding depth of 1'

> SEE GRADING & DRAINAGE NOTES AND DETAILS, SHEET C-3.1 FOR ADDITIONAL INFORMATION, FLOW CALCULATIONS, GENERAL NOTES, DETAILS AND CROSS SECTIONS.

GRADING LEGEND T/C TOP-OF-CURB SIDEWALK PAVEMENT CONCRETE PAVEMENT TOP-OF-PLATE (FOR CURB CULVERT) FINISHED GRADE FLOW LINE TOP-OF-WALL EDGE OF PAVEMENT SHEET FLOW CHANNEL FLOW +00.00 SPOT ELEVATION PROPOSED CONTOUR 12" THICK STONE LINER

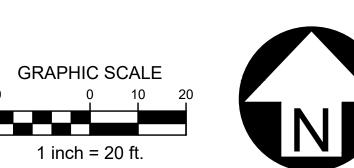



SITE
SITE
1.03C
OFINIANC
DE ALBUC

Design: RJM Proj: 18.160 Draw: RJM Dwg: 18-160.dwg Check: JDB Tab: C3.0-GP Scale: 1" = 20'

01.04.2019

GRADING & DRAINAGE PLAN

Know what's below. Call before you dig.

I, RYAN JOSEPH MORRISSEY, NMPE 25323, OF THE FIRM BURKHARDT ENGINEERING COMPANY, HEREBY I, IX ANI JUSEPH MURKISSEY, NIMPE 25323, OF THE FIRM BURKHARD I ENGINEERING COMPANY, HEREBY CERTIFY THAT THIS PROJECT HAS BEEN GRADED AND WILL DRAIN IN SUBSTANTIAL COMPLIANCE WITH AND IN ACCORDANCE WITH THE DESIGN INTENT OF THE APPROVED PLAN DATED 6/10/2019. THE RECORD INFORMATION EDITED ONTO THE ORIGINAL DESIGN DOCUMENT HAS BEEN OBTAINED BY STEVEN JOHN SANDOVAL, NMPS 12315, OF THE FIRM CONSTRUCTION SURVEYING SERVICES.

I FURTHER CERTIFY THAT I HAVE PERSONALLY REVIEWED PHOTOGRAPHY AND HAVE DETERMINED BY VISUAL INSPECTION THAT THE SURVEY DATA PROVIDED IS REPRESENTATIVE OF ACTUAL SITE CONDITIONS AND IS TRUE AND CORRECT TO THE BEST OF MY KNOWLEDGE AND BELIEF.

THIS CERTIFICATION IS SUBMITTED IN SUPPORT OF A REQUEST FOR CERTIFICATE OF OCCUPANCY. THE RECORD INFORMATION PRESENTED HEREON IS NOT NECESSARILY COMPLETE AND INTENDED ONLY TO VERIFY SUBSTANTIAL COMPLIANCE OF THE GRADING AND DRAINAGE ASPECTS OF THIS PROJECT. THOSE RELYING ON THIS RECORD DOCUMENT ARE ADVISED TO OBTAIN INDEPENDENT VERIFICATION OF ITS ACCURACY BEFORE USING IT FOR ANY OTHER PURPOSE.



ASPHALT

PARKING LOT

BUILDING ON PROPERTY LINE SMOKE HOUSE LÓT 1B, BLOCK 11 OFIMIANO J GUTIERREZ LOWER TERRACE SUBDIVISION



- 1. All spot elevations indicated in pavement areas are at bottom face of curb and/or finished pavement grade unless noted otherwise. All spot elevations indicated in grass or landscape areas are finished grade unless noted otherwise.
- 2. The Contractor shall be responsible for the removal and disposal of all vegetation and organic materials from the site that results from clearing & grubbing activities.
- 3. The Contractor shall be responsible for stripping and removal of all excess topsoil from the site. All topsoil that cannot be used on site shall be removed from the site at the Contractor's expense. The Contractor may dispose of excess topsoil by burying topsoil in landscape areas only at the direction of the Owner or the Owner's Representative.
- 4. The Contractor will be responsible for all safety requirements and for the protection of all existing and proposed utilities or structures during earthwork
- 5. The Contractor shall be responsible for the import of structural fill materials if suitable material is not available on site. The location and testing of suitable material shall be the Contractor's responsibility. The Contractor shall be responsible for the export and disposal of all excess or unsuitable materials.
- 6. The Contractor shall provide construction dewatering as necessary to complete construction as outlined in plans.
- 7. The Contractor shall exercise extreme care in establishing all grades and slopes in pavement areas, ramps and sidewalks in the vicinity of handicap parking and access areas and shall comply with Federal, State, and Local Codes.
- 8. In areas where sheet drainage flows from grass or landscape areas onto paved areas, the finished grade in grass or landscape areas shall be 1/2 inch above the top of curb or above the pavement in areas without curb. In areas where sheet drainage flows from pavement to grass or landscaped areas, the finished grade in grass or landscape areas shall be 1/2 inch below the pavement.
- 9. The Contractor shall provide positive drainage in all areas and away from all
- 10. All pavement shall be laid on a straight, even, and uniform grade with a minimum of 1:100 (1.0%) slope toward the collection points unless otherwise specified on plans. Cut or fill slopes in unpaved areas shall not exceed 3:1 (33.3%) maximum grade unless otherwise noted on plans.
- 11. ADA accessible areas shall not exceed the following slopes:

Ramps - 1:12 (8.3%) max. Routes - 1:20 (5.0%) max. Parking - 1:50 (2.0%) max. Cross Slopes - 1:50 (2.0%) max.

- 12. The Contractor shall adjust tops/lids/grates of all cleanouts, manholes, inlets, valves, etc. to match final grade.
- 13. Following grading of subsoil to subgrade elevations, the Contractor shall provide 4" of topsoil (minimum) in all disturbed areas which are not to be paved. Final grades should be smoothly finished to surrounding areas and ensure positive drainage. Stockpiled topsoil shall be screened prior to respreading and should be free of subsoil, debris, and stones.
- 14. The Contractor shall be responsible for determining exact quantities of cut and/or fill for estimating and construction and should alert the Engineer of any excessive cut and/or fill, especially if additional cut and/or fill will be required due to poor existing soil conditions discovered during earthwork
- 15. Refer to the Architectural and Structural Plans for information regarding any perimeter foundation drains.
- 16. The Contractor shall obtain a copy of the Geotechnical / Soils Report and become thoroughly familiar with site and subgrade information and fully implement recommendations given therein.

Private Drainage Facilities within City Right-of-Way **Notice to Contractor**

(Special Order 19 ~ "SO-19")

- 1. An excavation permit will be required before beginning any work within City Right-Of-Way.
- 2. All work on this project shall be performed in accordance with applicable federal, state and local laws, rules and regulations concerning construction safety and health.
- 3. Two working days prior to any excavation, the contractor must contact **New Mexico One Call, dial "811"** [or (505) 260-1990] for the location of existing utilities.
- 4. Prior to construction, the contractor shall excavate and verify the locations of all obstructions. Should a conflict exist, the contractor shall notify the engineer so that the conflict can be resolved with a minimum amount of delay.
- 5. Backfill compaction shall be according to traffic/street use. 6. Maintenance of the facility shall be the responsibility of the
- owner of the property being served. 7. Work on arterial streets may be required on a 24-hour basis.
- 8. Contractor must contact Jason Rodriguez at 235-8016 and Construction Coordination at 924-3416 to schedule an inspection.

Know what's below.

Call before you dig.

DRAINAGE CERTIFICATION

, RYAN JOSEPH MORRISSEY, NMPE 25323, OF THE FIRM BURKHARDT ENGINEERING COMPANY, HEREBY CERTIFY THAT THIS PROJECT HAS BEEN GRADED AND WILL DRAIN IN SUBSTANTIAL COMPLIANCE WITH AND IN ACCORDANCE WITH THE DESIGN INTENT OF THE APPROVED PLAN DATED 6/10/2019. THE RECORD INFORMATION EDITED ONTO THE ORIGINAL DESIGN DOCUMENT HAS BEEN OBTAINED BY STEVEN JOHN SANDOVAL, NMPS 12315, OF THE FIRM CONSTRUCTION SURVEYING SERVICES.


I FURTHER CERTIFY THAT I HAVE PERSONALLY REVIEWED PHOTOGRAPHY AND HAVE DETERMINED BY VISUAL INSPECTION THAT THE SURVEY DATA PROVIDED IS REPRESENTATIVE OF ACTUAL SITE CONDITIONS AND IS TRUE AND CORRECT TO THE BEST OF MY KNOWLEDGE AND BELIEF. THIS CERTIFICATION IS SUBMITTED IN SUPPORT OF A REQUEST FOR CERTIFICATE OF OCCUPANCY THE RECORD INFORMATION PRESENTED HEREON IS NOT NECESSARILY COMPLETE AND INTENDED ONLY THOSE RELYING ON THIS RECORD DOCUMENT ARE ADVISED TO OBTAIN INDEPENDENT VERIFICATION OF



TOP OF PLATE — ELEV.=5437.75

FLOW LINE ELEV.=5437.15-

SIDEWALK CULVERT

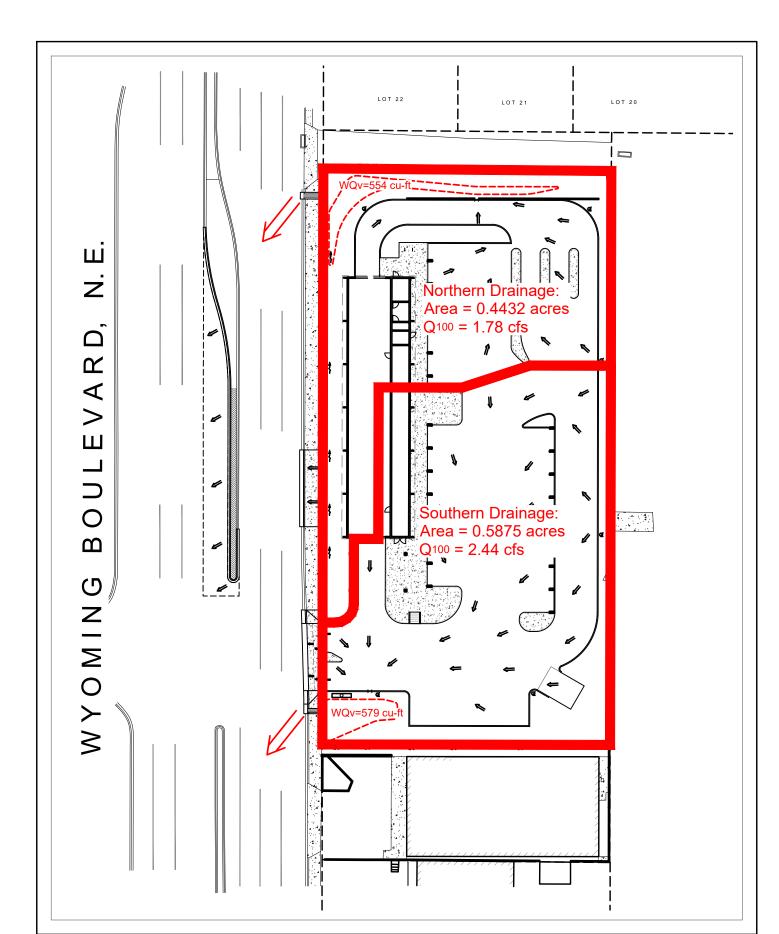

DRAINAGE AREA MAP Scale: 1"=50'

PER PLAN

4-6"ø COBBLE/LARGE STONE

1. GRADE OR EXCAVATE CROSS SECTION TO LINES

AND GRADES SHOWN ON THE PLANS ACCORDING

TO REQUIREMENTS IN THE GEOTECHNICAL REPORT

2. PLACE RIPRAP PROTECTION TO THE THICKNESS,

DEPTH, AND ELEVATIONS PER FINISHED GRADE.

NORTHERN WQv AREA SECTION


NOT TO SCALE

-ELEV.=5437.00

2' WIDE BERM

-ELEV.=5437.50

GEOTEXTILE FABRIC

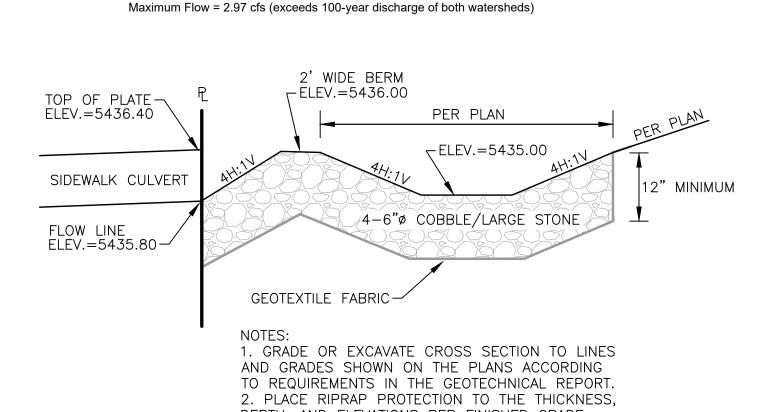

STORM WATER MANAGEMENT NOTES

Ibuquerque Development Process Manual

Treatment B (Desert Landscaping Area) - 24%

Provided Water Quality Storage Volume:

Treatment B (Desert Landscaping Area) - 17%

Provided Water Quality Storage Volume:

Curb Cut and Sidewalk Culvert Capacity:

Weir Equation; $Q = CxLxH^{3/2}$ where,

Treatment D (Impervious Area) - 83% = 0.4876 acres

*Average End Area Method used to calculate storage volumes.

100-year peak Discharge Rate = 4.15 cfs/acre (Table A-9)

Elevation Contour Area Surface Vol. Stone Vol. ∑Volume

*Stone Storage at Elevation = Contour Area x 12"(stone depth) x 40% void space

C = weir coefficient = 3.33 L = length of weir (ft)

For the 24" wide Curb Cuts and Sidewalk Culverts with a max depth of 7";

Q = discharge (cfs)

H = head or depth (ft)

Treatment D (Impervious Area) - 76% = 0.3370 acres 100-year peak Discharge Rate = 4.01 cfs/acre (Table A-9)

Chapter 22, Section 2, Part A:

Northern Drainage: Area = 0.4432 acres

 $Q_{100} = 1.78 \text{ cfs}$

WQv = 318 cu-ft (required)

Southern Drainage: Area = 0.5875 acres

 $Q_{100} = 2.44 \text{ cfs}$

WQv = 460 cu-ft (required)

Existing Lot Coverage - 90% impervious / 10% landscaping

Proposed Lot Coverage - 80% impervious / 20% landscaping

Net Decrease in Storm Water Runoff due to Development

"A simplified procedure for projects with sub-basins smaller than 40 acres

Provided Water Quality Storage Volume (As—Built)

*Stone Storage not included although it was installed. *Provided Surface Volume exceeds Required Volume.

*Stone Storage not included although it was installed.
*Provided Surface Volume exceeds Required Volume.

has been developed based on initial abstraction / uniform infiltration

Storm Water Quality Volume (WQv) = Impervious Area x 0.26 inches

No Storm Water Detention Required

precipitation losses and Rational Method procedures."

Precipitation Zone 3: "Between the San Mateo and Eubank"

Elevation Contour Area Surface Vol. Stone Vol. ΣVolume


*Stone Storage at Elevation = Contour Area x 12"(stone depth) x 40% void space

309


554 - overflow to R/W

579 - overflow to R/W


DEPTH, AND ELEVATIONS PER FINISHED GRADE. SOUTHERN WQv AREA SECTION NOT TO SCALE

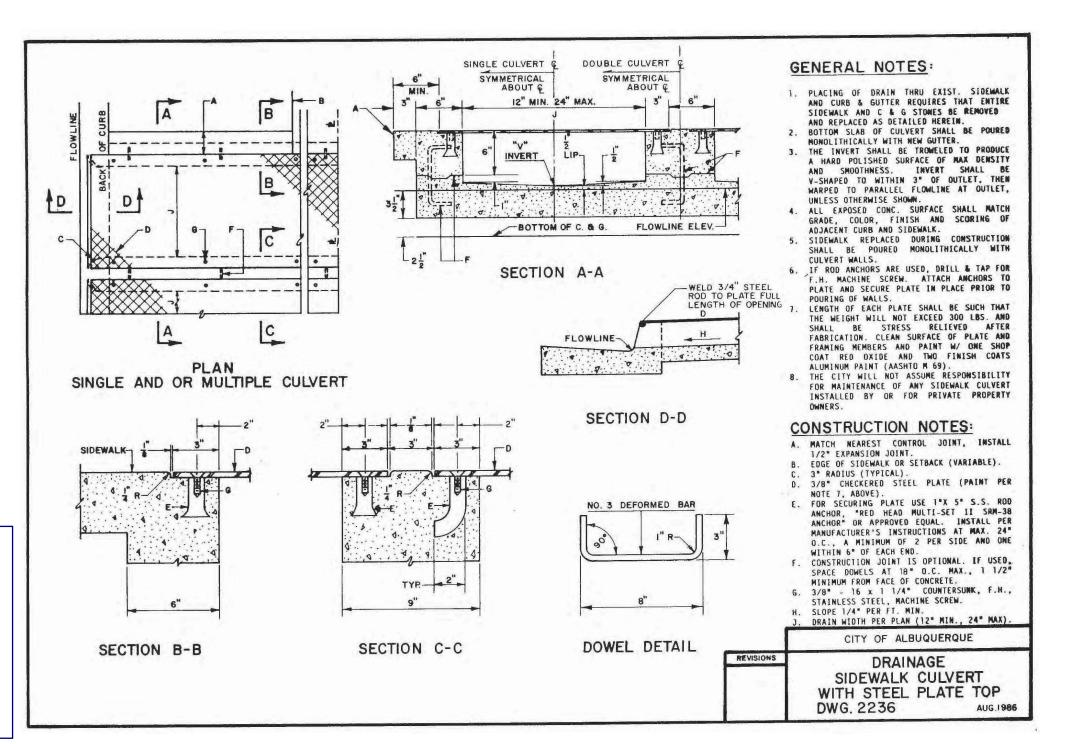

MINIMUM

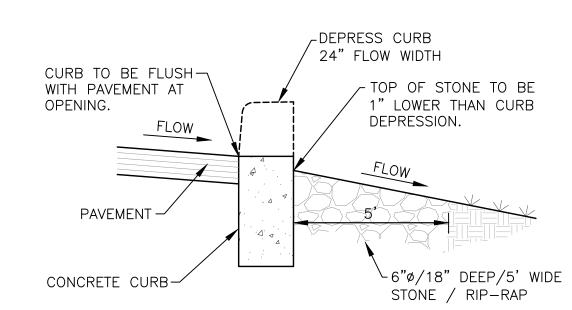


CURB CUT FOR CROSS DRAINAGE DETAIL NOT TO SCALE

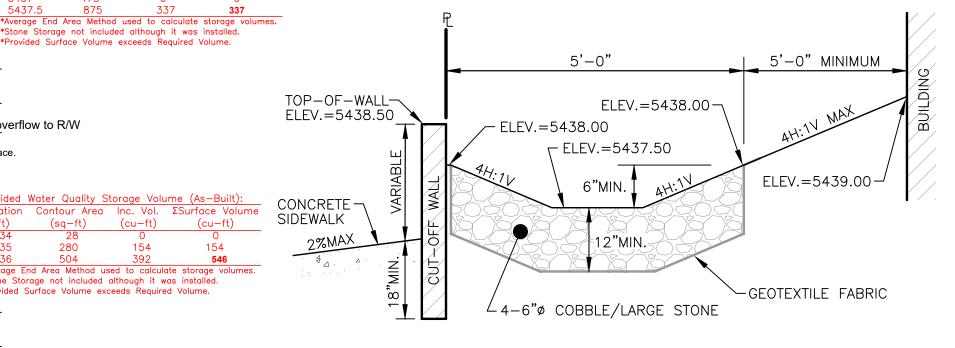

1. GRADE OR EXCAVATE CROSS SECTION TO LINES AND GRADES SHOWN ON THE PLANS ACCORDING TO REQUIREMENTS IN THE GEOTECHNICAL REPORT 2. PLACE RIPRAP PROTECTION TO THE THICKNESS, DEPTH, AND ELEVATIONS PER FINISHED GRADE.


DRAINAGE SWALE SECTION ALONG WYOMING BOULEVARD FRONTAGE NOT TO SCALE

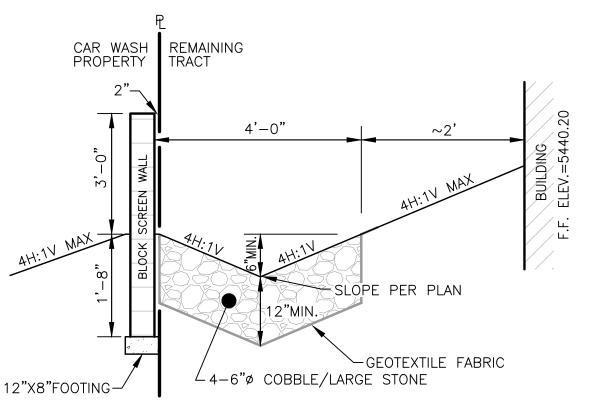

1. GRADE OR EXCAVATE CROSS SECTION TO LINES AND GRADES SHOWN ON THE PLANS ACCORDING TO REQUIREMENTS IN THE GEOTECHNICAL REPORT 2. PLACE RIPRAP PROTECTION TO THE THICKNESS, DEPTH. AND ELEVATIONS PER FINISHED GRADE.

DRAINAGE SWALE SECTION ALONG SOUTH PROPERTY LINE

NOT TO SCALE

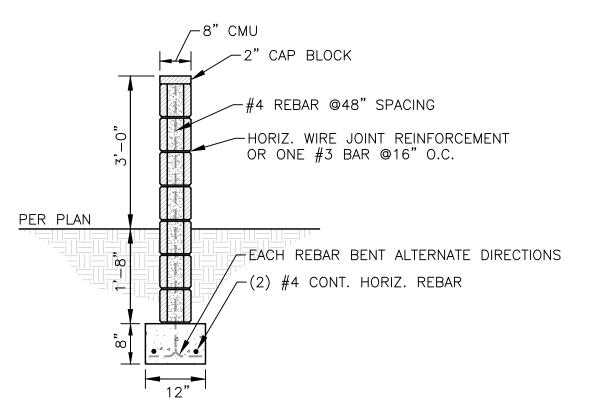

1. FOOTING TO BE IN COMPACTED SOIL @95%. 2. CONCRETE TO BE 2500 PSI MINIMUM.

3. REBAR TO BE GRADE 40.

4. 8" CMU TO BE fm=1350psi 5. MORTAR/GROUT TO BE TYPE S fm=1800psi

6. COLOR AND TEXTURE OF BLOCK TO BE SPECIFIED ON PLANS

7. INSTALL 1" EXPANSION JOINT WHEN

ABUTTING PAVEMENT OR CURBING. **BLOCK SCREENING WALL DETAIL** NOT TO SCALE



SH S

Design: RJM Proj: 18.160 Draw: RJM Dwg: 18-160.dwg Check: JDB Tab: C3.1-GP Scale: N/A

01.04.2019

GRADING & DRAINAGE NOTES AND DETAILS