
CITY OF ALBUQUERQUE

Planning Department
Alan Varela, Interim Director

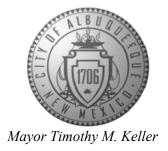

December 10, 2021

David Aube The Design Group 120 Vasser St. SE Albuquerque, NM 87106

RE: LaVida Llena

10501 Lagrima De Oro

Permanent Certificate of Occupancy - Accepted Grading and Drainage Plan Stamp Date: 7/31/19

Certification Dated: 11/22/21 Drainage File: F21D028

Dear Mr. Aube:

PO Box 1293

Based on the submittal received on 11/23/21 and site visit on 12/10/21, this certification is approved in support of Permanent Certificate of Occupancy by Hydrology for the out lined

portion of the site.

Albuquerque

If you have any questions, please contact me at 924-3986 or earmijo@cabq.gov.

NM 87103

Sincerely,

www.cabq.gov

Ernest Armijo, P.E.

Principal Engineer, Planning Dept. Development Review Services



City of Albuquerque


Planning Department

Development & Building Services Division

DRAINAGE AND TRANSPORTATION INFORMATION SHEET (REV 6/2018)

Project Title: La Vida Llena DRB#: #2019-002114 (1003807)		
Legal Description: Amended Plat Land in Se		
City Address: 10701 Lagrima de Oro Road N	<u> </u>	
Applicant: Haverland Carver Lifestyle Group		
Address: 101501 Montgomery Boulevard NE, Phone#: 505-991-5557		
Other Contact: The Design Group		Contact: David Aube
Address: 120 Vassar Drive SE, Albuquerque, Phone#: 505-998-6430		E-mail: daube@designgroupnm.co
TYPE OF DEVELOPMENT: PLAT (# IS THIS A RESUBMITTAL? Yes DEPARTMENT TRANSPORTATION	X No	
TYPE OF SUBMITTAL: X ENGINEER/ARCHITECT CERTIFICATION PAD CERTIFICATION CONCEPTUAL G & D PLAN GRADING PLAN DRAINAGE REPORT DRAINAGE MASTER PLAN FLOODPLAIN DEVELOPMENT PERMIT AF ELEVATION CERTIFICATE CLOMR/LOMR TRAFFIC CIRCULATION LAYOUT (TCL) TRAFFIC IMPACT STUDY (TIS) STREET LIGHT LAYOUT OTHER (SPECIFY) PRE-DESIGN MEETING?	BUILDING PERI X CERTIFICATE C PRELIMINARY SITE PLAN FOR SITE PLAN FOR FINAL PLAT AI POUNDATION F GRADING PERI SO-19 APPROV PAVING PERMI GRADING/PAD WORK ORDER A CLOMR/LOMR FLOODPLAIN D OTHER (SPECII	PLAT APPROVAL R SUB'D APPROVAL R BLDG. PERMIT APPROVAL PPROVAL OF FINANCIAL GUARANTEE PERMIT APPROVAL MIT APPROVAL AL IT APPROVAL O CERTIFICATION
DATE SUBMITTED: <u>11-22-2021</u>	By: David Aube	
COA STAFF:	ELECTRONIC SUBMITTAL RECEIVED:	

FEE PAID:_____

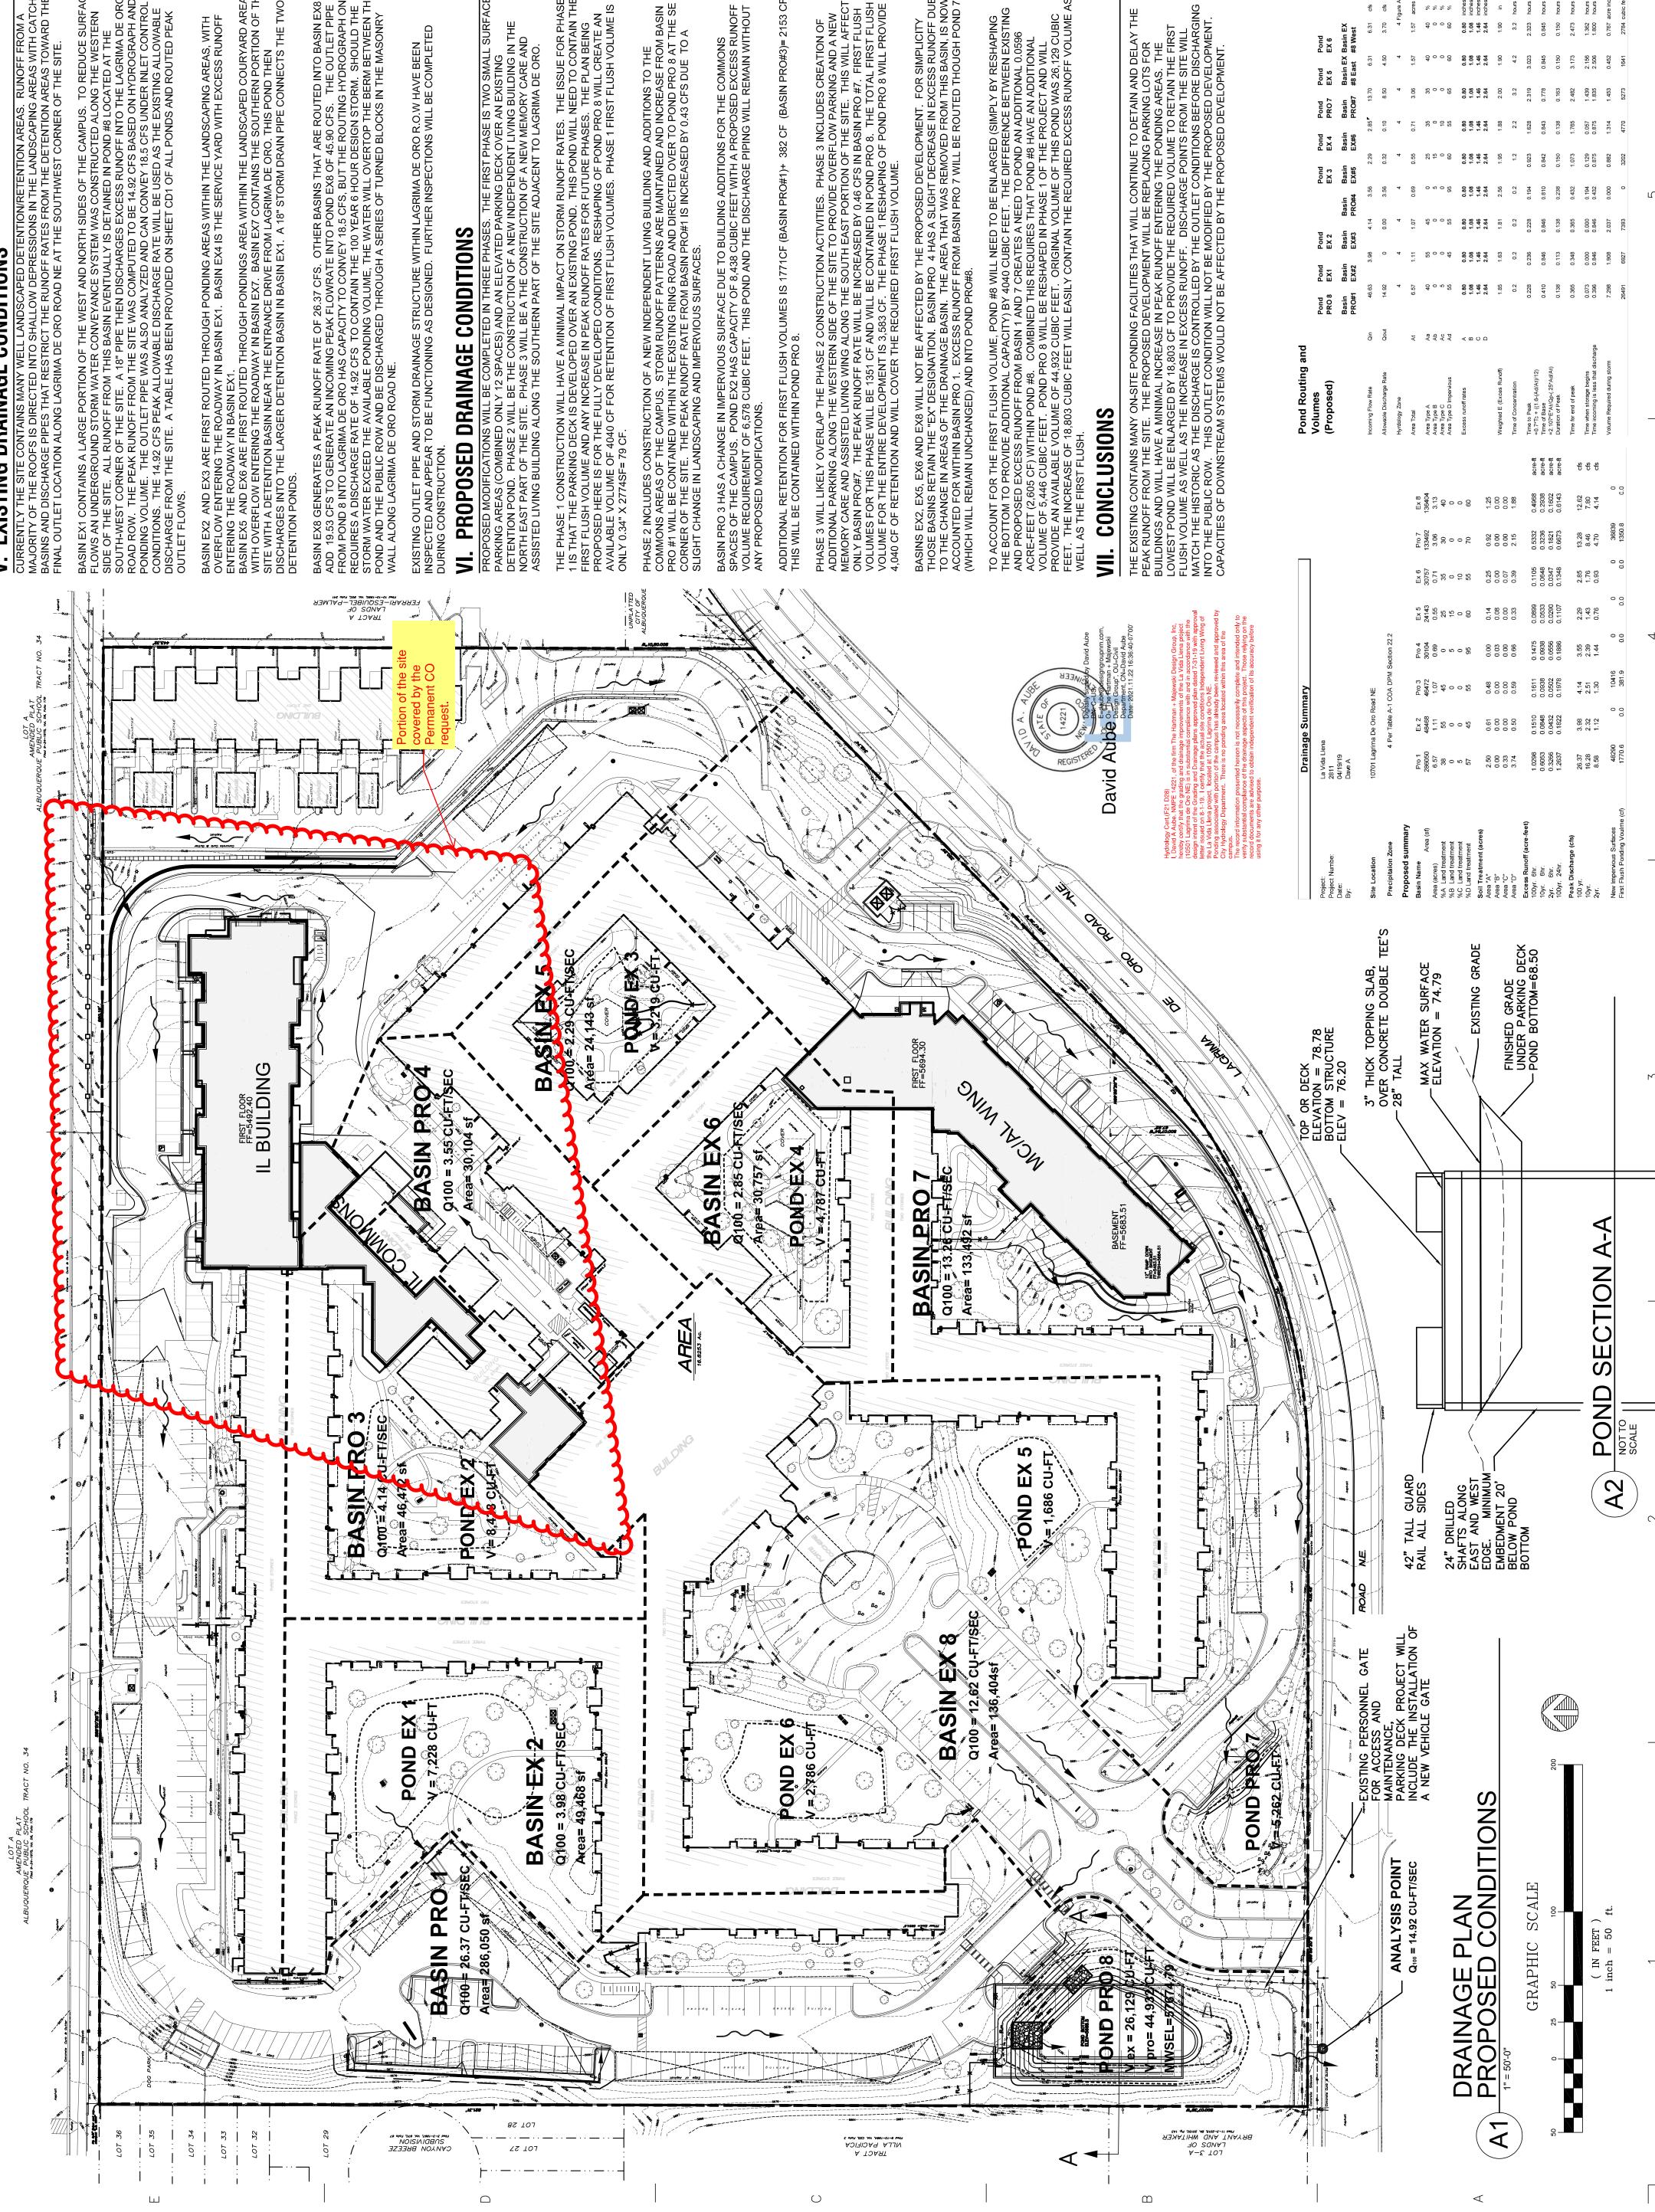

EXISTING DRAINAGE CONDITIONS

CURRENTLY THE SITE CONTAINS MANY WELL LANDSCAPED DETENTION/RETENTION AREAS. RUNOFF FROM A MAJORITY OF THE ROOFS IS DIRECTED INTO SHALLOW DEPRESSIONS IN THE LANDSCAPING AREAS WITH CATCH BASINS AND DISCHARGE PIPES THAT RESTRICT THE RUNOFF RATES FROM THE DETENTION AREAS TOWARD THE FINAL OUTLET LOCATION ALONG LAGRIMA DE ORO ROAD NE AT THE SOUTHWEST CORNER OF THE SITE.

BASIN EX1 CONTAINS A LARGE PORTION OF THE WEST AND NORTH SIDES OF THE CAMPUS. TO REDUCE SURFACE FLOWS AN UNDERGROUND STORM WATER CONVEYANCE SYSTEM WAS CONSTRUCTED ALONG THE WESTERN SIDE OF THE SITE. ALL RUNOFF FROM THIS BASIN EVENTUALLY IS DETAINED IN POND #8 LOCATED AT THE SOUTH-WEST CORNER OF THE SITE. A 18" PIPE THEN DISCHARGES EXCESS RUNOFF INTO THE LAGRIMA DE ORO ROAD ROW. THE PEAK RUNOFF FROM THE SITE WAS COMPUTED TO BE 14.92 CFS BASED ON HYDROGRAPH AND PONDING VOLUME. THE OUTLET PIPE WAS ALSO ANALYZED AND CAN CONVEY 18.5 CFS UNDER INLET CONTROL CONDITIONS. THE 14.92 CFS PEAK ALLOWABLE DISCHARGE RATE WILL BE USED AS THE EXISTING ALLOWABLE DISCHARGE FROM THE SITE. A TABLE HAS BEEN PROVIDED ON SHEET CD1 OF ALL PONDS AND ROUTED PEAK OUTLET FLOWS.

BASIN EX2 AND EX3 ARE FIRST ROUTED THROUGH PONDING AREAS WITHIN THE LANDSCAPING AREAS, WITH OVERFLOW ENTERING THE ROADWAY IN BASIN EX1. BASIN EX4 IS THE SERVICE YARD WITH EXCESS RUNOFF ENTERING THE ROADWAY IN BASIN EX1. BASIN EX5 AND EX6 ARE FIRST ROUTED THROUGH PONDINGS AREA WITHIN THE LANDSCAPED COURYARD AREAS, WITH OVERFLOW ENTERING THE ROADWAY IN BASIN EX7. BASIN EX7 CONTAINS THE SOUTHERN PORTION OF THE SITE WITH A DETENTION BASIN NEAR THE ENTRANCE DRIVE FROM LAGRIMA DE ORO. THIS POND THEN DISCHARGES INTO THE LARGER DETENTION BASIN IN BASIN EX1. A 18" STORM DRAIN PIPE CONNECTS THE TWO DETENTION PONDS.

120 Vassar Drive SE Suite 100 Albuquerque New Mexico 87106 T 505 242 6880 • F 505 242 6881

CONSULTANT

DESIGNAN
Architects • Engineer
Planners • Urban De

BASIN EX8 GENERATES A PEAK RUNOFF RATE OF 26.37 CFS. OTHER BASINS THAT ARE ROUTED INTO BASIN EX8 ADD 19.53 CFS TO GENERATE AN INCOMING PEAK FLOWRATE INTO POND EX8 OF 45.90 CFS. THE OUTLET PIPE FROM POND 8 INTO LAGRIMA DE ORO HAS CAPACITY TO CONVEY 18.5 CFS, BUT THE ROUTING HYDROGRAPH ONLY REQUIRES A DISCHARGE RATE OF 14.92 CFS TO CONTAIN THE 100 YEAR 6 HOUR DESIGN STORM. SHOULD THE STORM WATER EXCEED THE AVAILABLE PONDING VOLUME, THE WATER WILL OVERTOP THE BERM BETWEEN THE POND AND THE PUBLIC ROW AND BE DISCHARGED THROUGH A SERIES OF TURNED BLOCKS IN THE MASONRY WALL ALONG LAGRIMA DE ORO ROAD NE.

EXISTING OUTLET PIPE AND STORM DRAINAGE STRUCTURE WITHIN LAGRIMA DE ORO R.O.W HAVE BEEN INSPECTED AND APPEAR TO BE FUNCTIONING AS DESIGNED. FURTHER INSPECTIONS WILL BE COMPLETED DURING CONSTRUCTION.

PROPOSED MODIFICATIONS WILL BE COMPLETED IN THREE PHASES. THE FIRST PHASE IS TWO SMALL SURFACE PARKING AREAS (COMBINED ONLY 12 SPACES) AND AN ELEVATED PARKING DECK OVER AN EXISTING DETENTION POND. PHASE 2 WILL BE THE CONSTRUCTION OF A NEW INDEPENDENT LIVING BUILDING IN THE NORTH EAST PART OF THE SITE. PHASE 3 WILL BE A THE CONSTRUCTION OF A NEW MEMORY CARE AND ASSISTED LIVING BUILDING ALONG THE SOUTHERN PART OF THE SITE ADJACENT TO LAGRIMA DE ORO.

THE PHASE 1 CONSTRUCTION WILL HAVE A MINIMAL IMPACT ON STORM RUNOFF RATES. THE ISSUE FOR PHA 1 IS THAT THE PARKING DECK IS DEVELOPED OVER AN EXISTING POND. THIS POND WILL NEED TO CONTAIN TI FIRST FLUSH VOLUME AND ANY INCREASE IN PEAK RUNOFF RATES FOR FUTURE PHASES. THE PLAN BEING PROPOSED HERE IS FOR THE FULLY DEVELOPED CONDITIONS. RESHAPING OF POND PRO 8 WILL CREATE AN AVAILABLE VOLUME OF 4040 CF FOR RETENTION OF FIRST FLUSH VOLUMES. PHASE 1 FIRST FLUSH VOLUME IS ONLY 0.34" X 2774SF= 79 CF.

PHASE 2 INCLUDES CONSTRUCTION OF A NEW INDEPENDENT LIVING BUILDING AND ADDITIONS TO THE COMMONS AREAS OF THE CAMPUS. STORM RUNOFF PATTERNS ARE MAINTAINED AND INCREASE FROM BASIN PRO #1 WILL BE CONTAINED WITHIN THE EXISTING RING ROAD AND DIRECTED OVER TO POND PRO 8 AT THE SE CORNER OF THE SITE. THE PEAK RUNOFF RATE FROM BASIN PRO#1 IS INCREASED BY 0.43 CFS DUE TO A SLIGHT CHANGE IN LANDSCAPING AND IMPERVIOUS SURFACES.

BASIN PRO 3 HAS A CHANGE IN IMPERVIOUS SURFACE DUE TO BUILDING ADDITIONS FOR THE COMMONS SPACES OF THE CAMPUS. POND EX2 HAS CAPACITY OF 8,438 CUBIC FEET WITH A PROPOSED EXCESS RUNOFF VOLUME REQUIREMENT OF 6,578 CUBIC FEET. THIS POND AND THE DISCHARGE PIPING WILL REMAIN WITHOUT ANY PROPOSED MODIFICATIONS.

2153 CF. ADDITIONAL RETENTION FOR FIRST FLUSH VOLUMES IS 1771CF (BASIN PRO#1)+THIS WILL BE CONTAINED WITHIN POND PRO 8.

10501 LAGRIMA DE ORO NE

LA VIDA LLENA

PROJECT NAME

BASINS EX2, EX5, EX6 AND EX8 WILL NOT BE AFFECTED BY THE PROPOSED DEVELOPMENT. FOR SIMPLICITY THOSE BASINS RETAIN THE "EX" DESIGNATION. BASIN PRO 4 HAS A SLIGHT DECREASE IN EXCESS RUNOFF DUE TO THE CHANGE IN AREAS OF THE DRAINAGE BASIN. THE AREA THAT WAS REMOVED FROM THIS BASIN, IS NOW ACCOUNTED FOR WITHIN BASIN PRO 1. EXCESS RUNOFF FROM BASIN PRO 7 WILL BE ROUTED THOUGH POND 7 (WHICH WILL REMAIN UNCHANGED) AND INTO POND PRO#8.

10701 Montgomery Boulevard NE ALBUQUERQUE NM, 87111

HAVERLAND CARTER GROUP

THE EXISTING CONTAINS MANY ON-SITE PONDING FACILITIES THAT WILL CONTINUE TO DETAIN AND DELAY THE PEAK RUNOFF FROM THE SITE. THE PROPOSED DEVELOPMENT WILL BE REPLACING PARKING LOTS FOR BUILDINGS AND WILL HAVE A MINIMAL INCREASE IN PEAK RUNOFF ENTERING THE PONDING AREAS. THE LOWEST POND WILL BE ENLARGED BY 18,803 CF TO PROVIDE THE REQUIRED VOLUME TO RETAIN THE FIRST FLUSH VOLUME AS WELL AS THE INCREASE IN EXCESS RUNOFF. DISCHARGE POINTS FROM THE SITE WILL MATCH THE HISTORIC AS THE DISCHARGE IS CONTROLLED BY THE OUTLET CONDITIONS BEFORE DISCHARGING INTO THE PUBLIC ROW. THIS OUTLET CONDITION WILL NOT BE MODIFIED BY THE PROPOSED DEVELOPMENT.

PROPOSED CONDITIONS PLAN DRAINAGE

P:\2811_lvlmasterplanphase1buildout\02 Model\02 Civil\Phase 3 IL-Commons\P3-CD2.dwg, 8\12\2019 2:18:12 PM