


 






















SCALE: 1" = 20'-0"

**LEGAL DESCRIPTION:**LOT 11 OF UNPLATTED LANDS KNOWN AS  
"60 ACRE MASTER PLAN"**BENCHMARK:**A STANDARD N.H.S.C. BRASS TABLET STAMPED  
"JT-1A", SET IN THE TOP OF A CONCRETE POST  
FLUSH WITH THE GROUND LOCATED IN THE  
SOUTHERLY MEDIAN ON JUAN TABO BLVD. N.E.  
& MONTGOMERY BLVD. N.E.  
ELEVATION=5721.25 FEET(M.S.L.D)**LEGEND:**

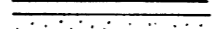	EXISTING SPOT ELEVATION		LIGHT FIXTURE
	PROPOSED SPOT ELEVATION		EXIST. LIGHT POLE
	EXISTING CONTOUR		EXISTING RETAINING WALL
	PROPOSED CONTOUR		PROPOSED CONCRETE GARDEN WALL
	EXISTING FLOWLINE		PROPERTY LINE
	PROPOSED FLOWLINE		EASEMENT LINE
	PROPOSED DIRECTION OF RUNOFF		CENTERLINE
	PROPOSED ROOF DRAINAGE		PROPOSED RETAINING WALL
	PROPOSED ASPHALT		HIGH POINT
	PROPOSED CONCRETE		FUTURE PROPOSED CONTOUR
TC	TOP OF CURB		TW TOP OF WALL ELEVATION
FL	FLOWLINE		PROPOSED CHAIN LINK FENCE
FF	FINISHED FLOOR ELEVATION		
	EXISTING FIRE HYDRANT		

**Erosion Control Measures:**

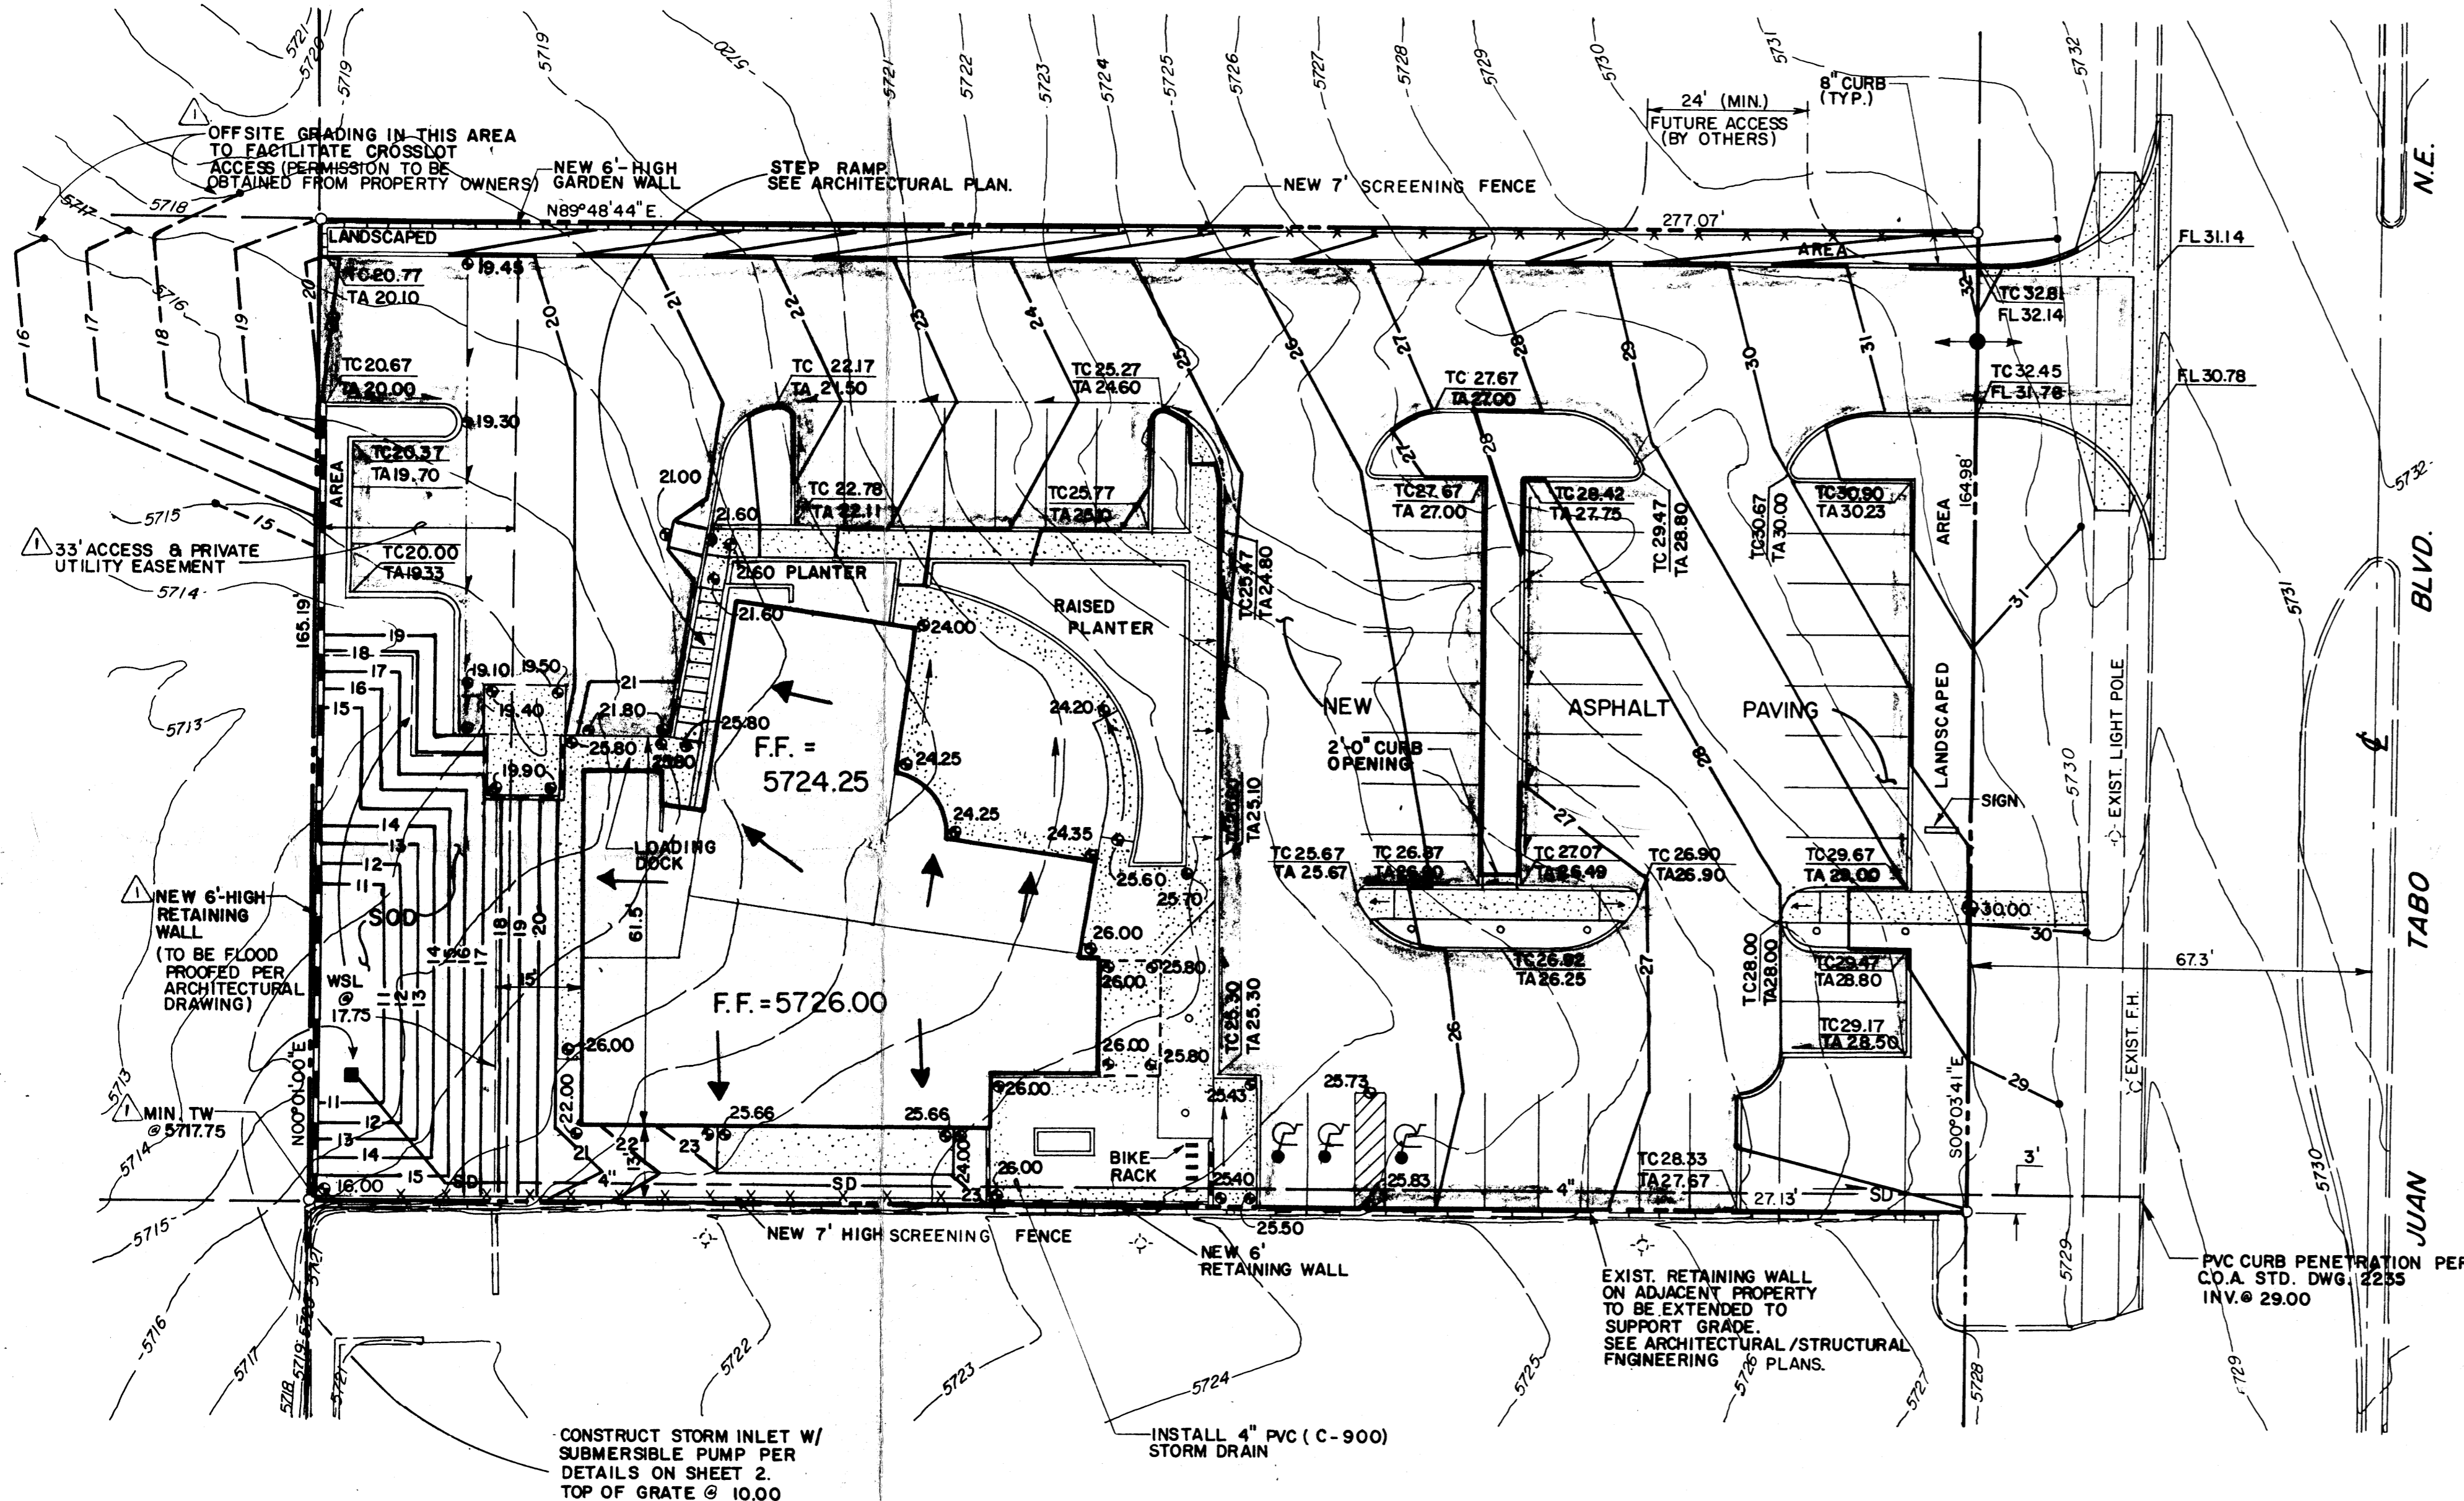- The contractor shall ensure that no soil erodes from the site into public right-of-way or onto private property. This can be achieved by constructing temporary berms at the property lines and wetting the soil to keep it from blowing.
- The contractor shall promptly clean up any material excavated within the public right-of-way so that the excavated material is not susceptible to being washed down the street.
- The contractor shall secure "Topsoil Disturbance Permit" prior to beginning construction.

**Survey Note**Boundary data is based on Replat  
of Lands of Ferrari-Esquivel-Palmer  
prepared by Southwest Surveying Co.  
Filed April 11, 1985. Book C-26,  
page 192.**DRAINAGE PLAN**The following items concerning the Double Rainbow Drainage  
Plan are contained herein:

- Vicinity Map
- Grading Plan
- Calculations
- Pump Details & Calculations

As shown by the Vicinity Map, the site is located on the west  
side of Juan Tabo Boulevard N.E. between Montgomery Boulevard  
N.E. and Lagrime de Oro N.E. At present, the site is  
undeveloped. Much of the surrounding area is developed,  
making this an infill site.As shown by Panel 18 of 50 of the National Flood Insurance  
Program Flood Insurance Rate Maps for the City of Albuquerque,  
New Mexico, dated October 14, 1983, this site does not lie  
within a designated flood hazard zone. Further review of this  
mapping does not reveal downstream flooding to which this site  
contributes. At present, the site slopes from east to west  
onto adjacent undeveloped property. The site is situated down  
slope from Juan Tabo Boulevard N.E., which is a developed City  
street.The Grading Plan shows 1) existing grades indicated by  
contours at 1'0" intervals, 2) proposed grades indicated by  
spot elevations and contours at 1'0" intervals, 3) the limit  
and character of the existing improvements, 4) the limit and  
character of the proposed improvements, and 5) continuity  
between existing and proposed grades. As shown this plan, the  
proposed improvements consist of the construction of a  
building along with adjacent paving and landscaping. Due to  
the fact that the site slopes away from Juan Tabo Boulevard  
N.E. at an average 5% gradient, it is not possible to obtain  
gravity drainage back to the street. Because of this, a pond  
is proposed to contain 100% of the 100-year developed runoff  
and to drain that pond with a submersible pump. The forced  
main discharge from the pond will discharge into Juan Tabo  
Boulevard N.E. Waterproofing of the adjacent walls will be  
necessary to allow for ponding within 15' of the structures.The Calculations which appear hereon analyze both the existing  
and developed conditions for the 100-year, 6-hour rainfall  
event. The Procedure for 40-acre and Smaller Basins, as set  
forth in the Revision of Section 22.2, Hydrology of the  
Development Process Manual, Volume 2, Design Criteria, dated  
January, 1993, has been used to quantify the peak rate of  
discharge and volume of runoff generated. As shown by these  
calculations, an increase in runoff is generated. The maximum  
depth of the pond will be approximately 1', thereby requiring  
fencing of the pond area. The required volume was not  
calculated using the hydrograph method from the new hydrology  
criteria, in the event that the submersible pump malfunctions.  
Therefore, the V<sub>100</sub> for the site was used so as to determine  
the volume of the pond. In order to provide erosion control  
for the pond, this area will be sodded.**CALCULATIONS****Site Characteristics**

- Precipitation Zone = 4
- P<sub>2</sub><sub>100</sub> = P<sub>360</sub> = 2.90 in.
- Total Area (A<sub>T</sub>) = 1.05 acres
- Existing Land Treatment

Treatment	Area (sf/ac)	%
A	40,950 / 0.94	89.5
B	4,790 / 0.11	10.5

**Developed Land Treatment**

Treatment	Area (sf/ac)	%
B	9,900 / 0.23	21.6
D	35,840 / 0.82	78.4

**Existing Condition****1. Volume**

$$E_w = (E_p A_p + E_p A_b + E_p A_c + E_p A_d) / A_T$$

$$E_w = [(0.80)(0.94) + (1.08)(0.11)] / 1.05 = 0.83 \text{ in.}$$

$$V_{100} = (E_w / 12) A_T$$

$$V_{100} = (0.83 / 12) 1.05 = 0.0726 \text{ ac. ft.; } 3,170 \text{ cf}$$

**2. Peak Discharge**

$$Q_p = Q_{pA} A_A + Q_{pB} A_B + Q_{pC} A_C + Q_{pD} A_D$$

$$Q_p = Q_{100} = (2.20)(0.94) + (2.92)(0.11) = 2.4 \text{ cfs}$$

**Developed Condition****1. Volume**

$$E_w = (E_p A_p + E_p A_b + E_p A_c + E_p A_d) / A_T$$

$$E_w = [(1.08)(0.23) + (2.64)(0.82)] / 1.05 = 2.30 \text{ in.}$$

$$V_{100} = (E_w / 12) A_T$$

$$V_{100} = (2.30 / 12) 1.05 = 0.2011 \text{ ac. ft.; } 8,760 \text{ cf}$$

**2. Peak Discharge**


$$Q_p = Q_{pA} A_A + Q_{pB} A_B + Q_{pC} A_C + Q_{pD} A_D$$

$$Q_p = Q_{100} = (2.92)(0.23) + (5.25)(0.82) = 5.0 \text{ cfs}$$

**Comparison**

- AV<sub>100</sub> = 8,760 - 3,170 = 5,590 cf (increase)
- AQ<sub>100</sub> = 5.0 - 2.4 = 2.6 cfs (increase)

APPROVALS	NAME	DATE
A.C.E. / DESIGN	B. Montoya	5/24/94
INSPECTOR		
A.C.E. / FIELD		

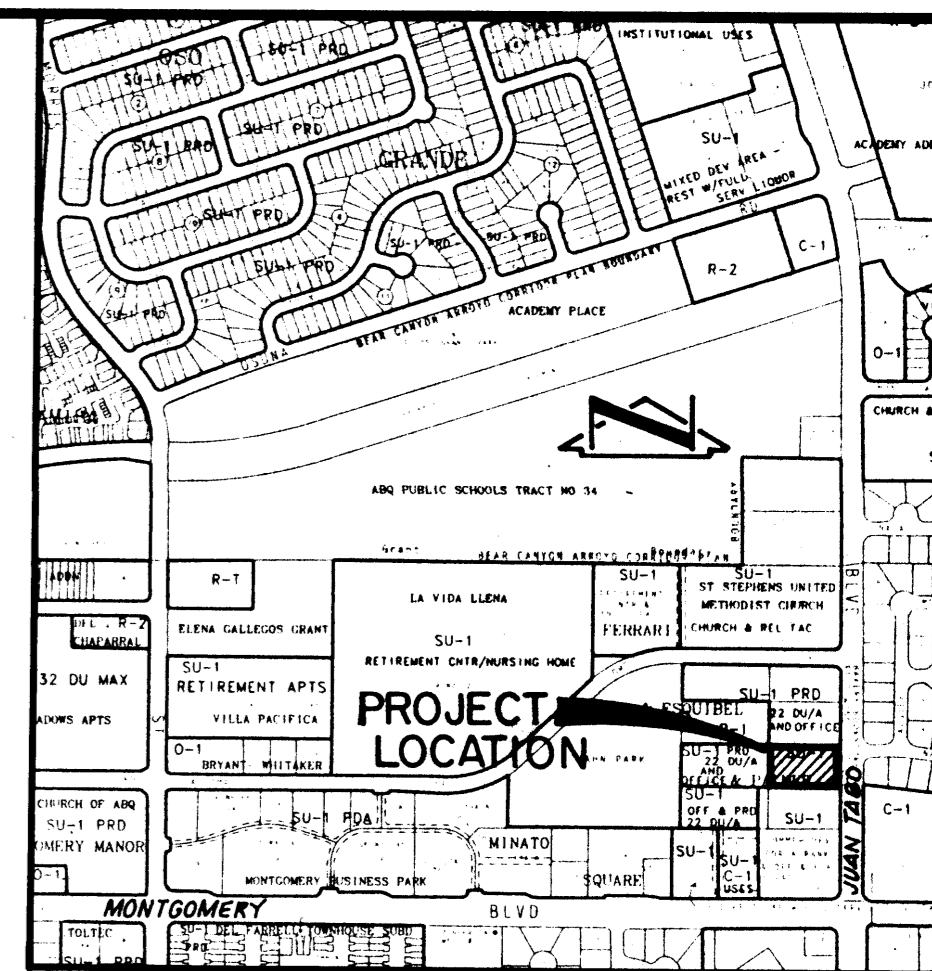VICINITY MAP  
SCALE: 1" = 750' (APPROX.)

F-21

**POND VOLUME** (Calculated by the Average End Area Method)

Elev (ft)	Area (ft <sup>2</sup> )	Vol (cf)	% Vol (cf)
10	0		
11	368	184	184
12	550	459	643
13	781	665.5	1,308.5
14	1,015	898	2,206.5
15	1,440	1,227.5	3,434
16	1,823	1,631.5	5,065.5
17	2,467	1,995	7,060.5
18	2,493	2,330	9,390.5
19	2,825	2,659	12,049.5

W.S.L. between 17 &amp; 18

By interpolation 17.75 area of 2411.5 sf

Vol = [(2167 + 2411.5) / 2] 0.7 = 1716.94 cf

ZVol = 7,060.5 + 1716.94 = 8,777.43 cf


W.S.L. approximately 17.75

**Construction Notes:**

- Two (2) working days prior to any excavation, contractor must contact New Mexico One Call System 260-1990, for location of existing utilities.
- Prior to construction, the contractor shall excavate and verify the horizontal and vertical location of all potential obstructions. Should a conflict exist, the contractor shall notify the engineer in writing so that the conflict can be resolved with a minimum amount of delay.
- All work on this project shall be performed in accordance with applicable federal, state and local laws, rules and regulations concerning construction safety and health.
- All construction within public right-of-way shall be performed in accordance with applicable City of Albuquerque Standards and Procedures.
- If any utility lines, pipelines, or underground utility lines are shown on these drawings, they are shown in an approximate manner only, and such lines may exist where none are shown. If any such existing lines are shown, the location is based upon information provided by the owner of said utility, and the information may be incomplete, or may be obsolete by the time construction commences. The engineer has conducted only preliminary investigation of the location, depth, size, or type of existing utility lines, pipelines, or underground utility lines. This investigation is not conclusive, and may not be complete, therefore, makes no representation pertaining thereto, and assumes no responsibility or liability therefor. The contractor shall inform itself of the location of any utility line, pipeline, or underground utility line in or near the area of the work in advance of and during excavation work. The contractor is fully responsible for any and all damage caused by its failure to locate, identify and preserve any and all existing utilities, pipelines, and underground utility lines. In planning and conducting excavation, the contractor shall comply with state statutes, municipal and local ordinances, rules and regulations, if any, pertaining to the location of these lines and facilities.
- The design of planters and landscaped areas is not part of this plan. All planters and landscaped areas adjacent to the building(s) shall be provided with positive drainage to avoid any ponding adjacent to the structure. For construction details, refer to landscaping plan.
- An Excavation/Construction Permit will be required before beginning any work within City right-of-way. An approved copy of these plans must be submitted at the time of application for this permit.
- Backfill compaction shall be according to ARTERIAL street use.
- Maintenance of these facilities shall be the responsibility of the owner of the property served.


JEFF MORTENSEN & ASSOCIATES, INC.  
6010-B MIDWAY PARK BLVD. N.E.  
ALBUQUERQUE, NEW MEXICO 87109  
ENGINEERS & SURVEYORS (505)345-4250**GRADING AND DRAINAGE PLAN****DOUBLE RAINBOW BAKERY & CAFE**

DESIGNED BY	M.F.D.	NO.	DATE	BY	REVISIONS	JOB NO.
		5/94	M.F.D.	REVISE DRAINAGE PLAN, SHOW EASEMENT, FLOOD PROOFING.		921122
DRAWN BY	T.P.H.					DATE
						12-1993
APPROVED BY	J.G.M.					SHEET
						1 OF 2

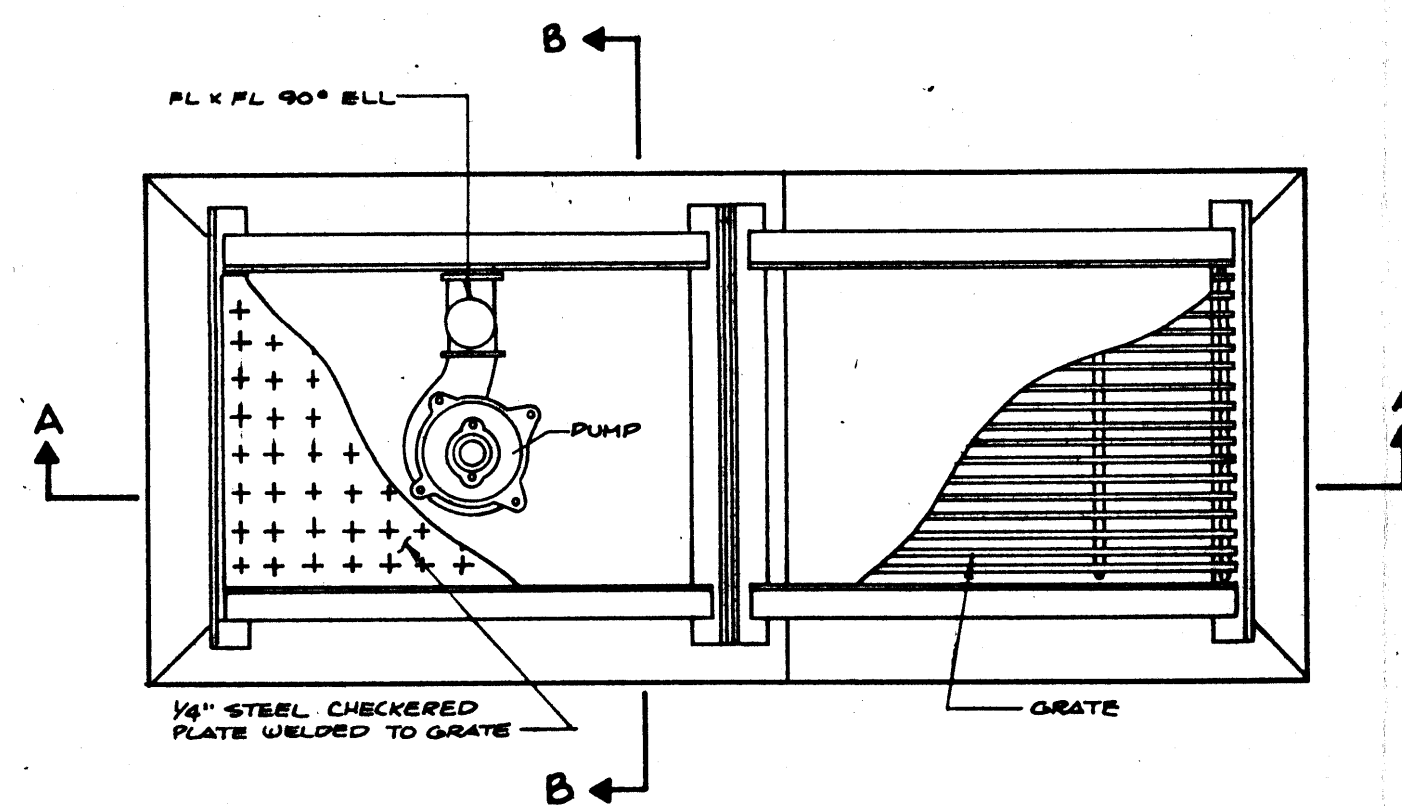


SUMP PIT AND INLET PLAN

SCALE: 3/4" = 1'-0"

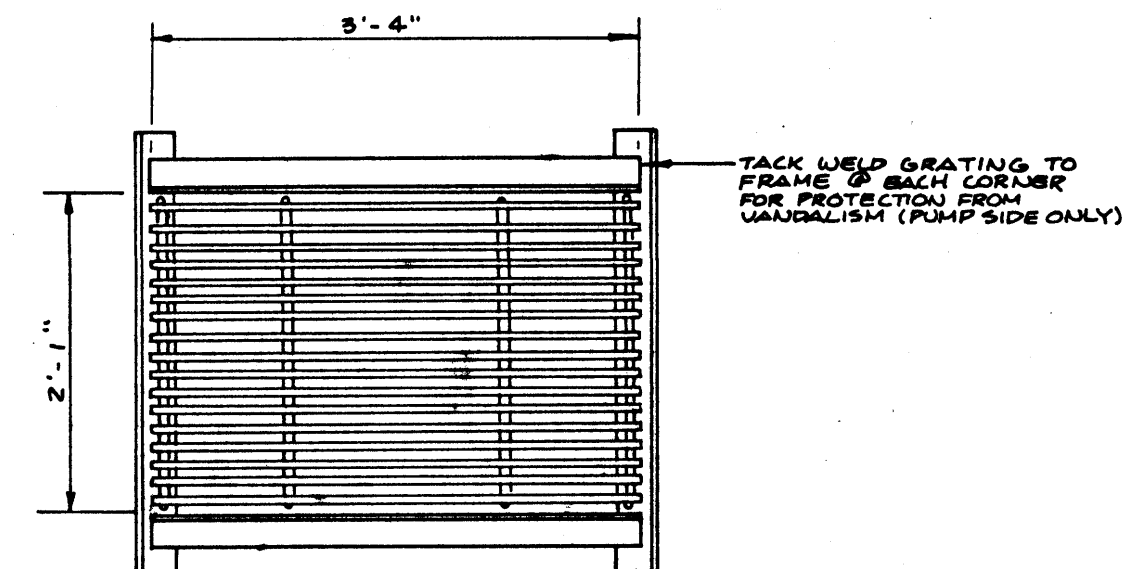


TYPICAL INLET GRATE PLAN

SCALE: 3/4" = 1'-0"

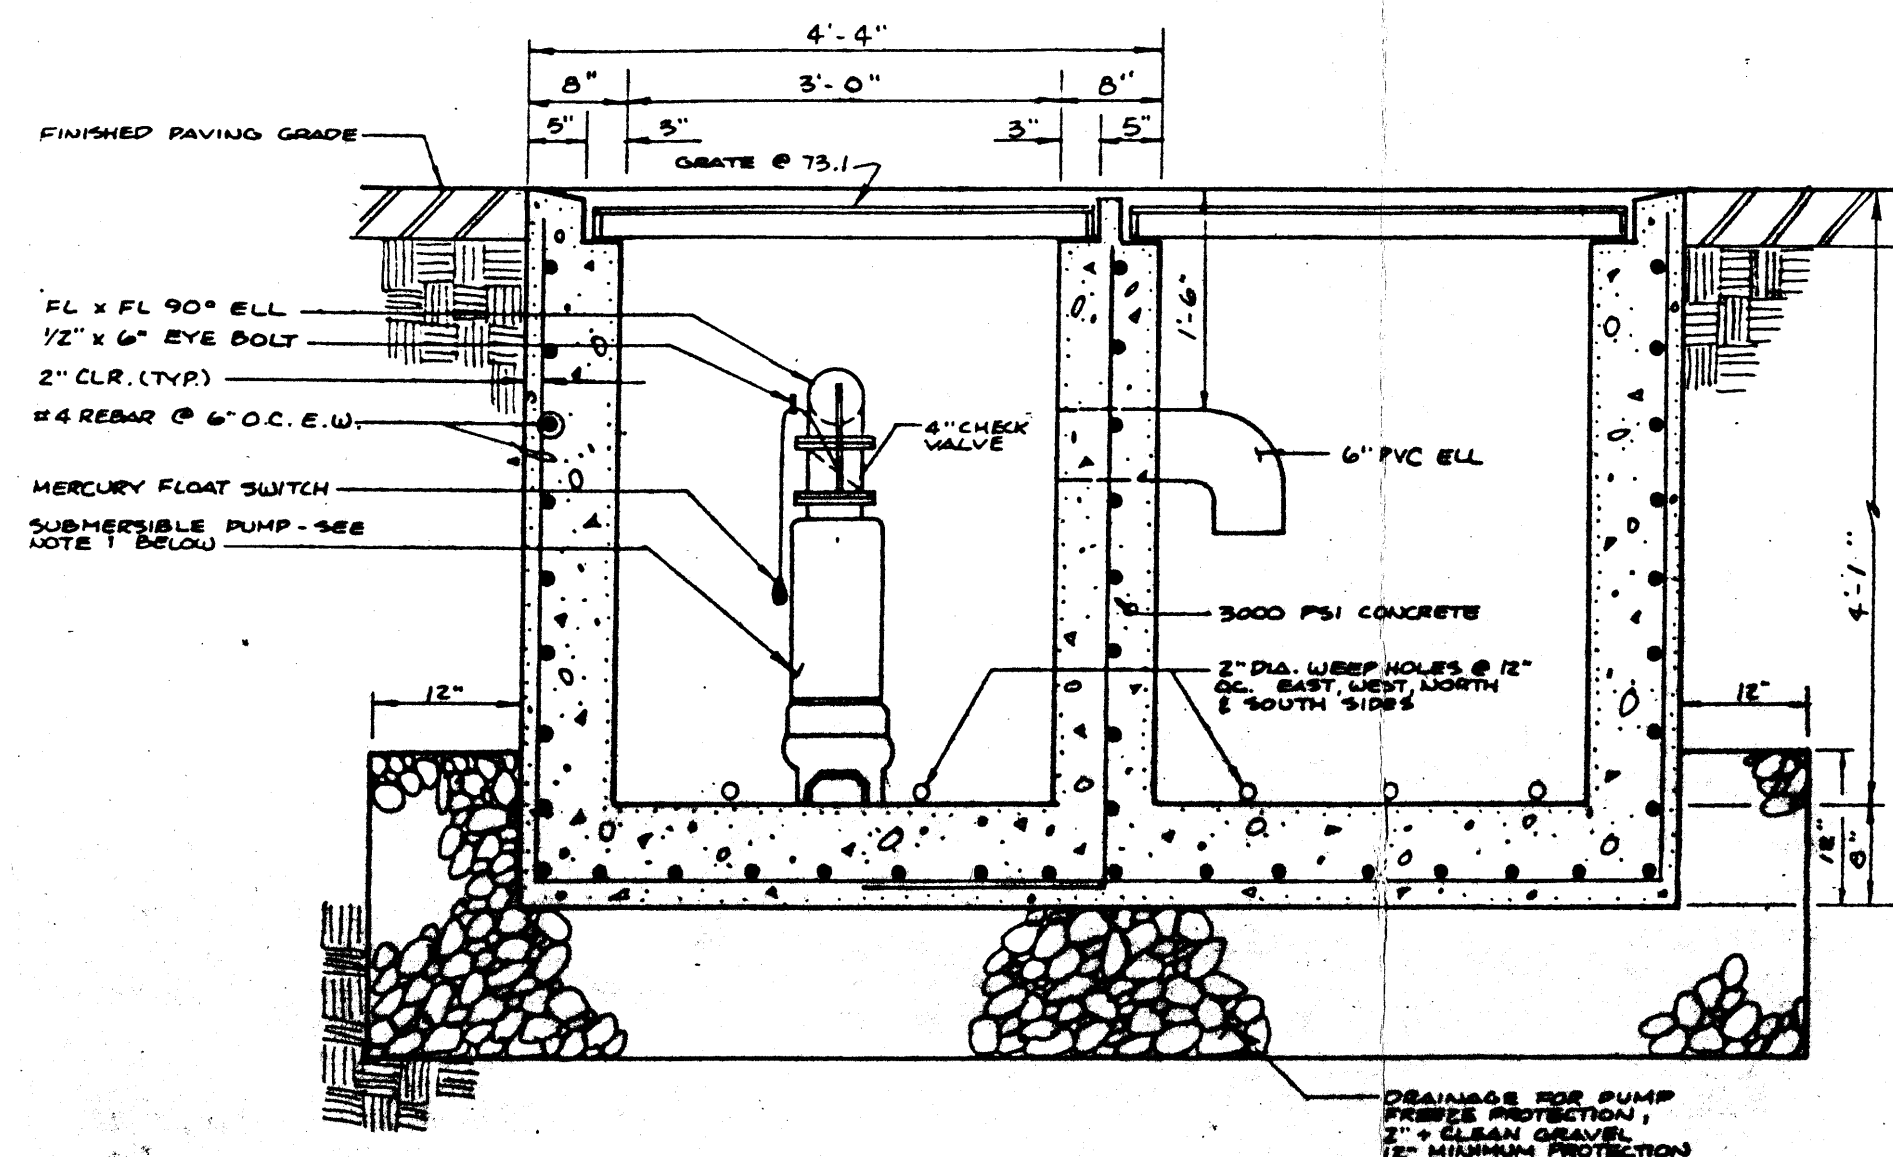


SECTION A-A

SCALE: 3/4" = 1'-0"

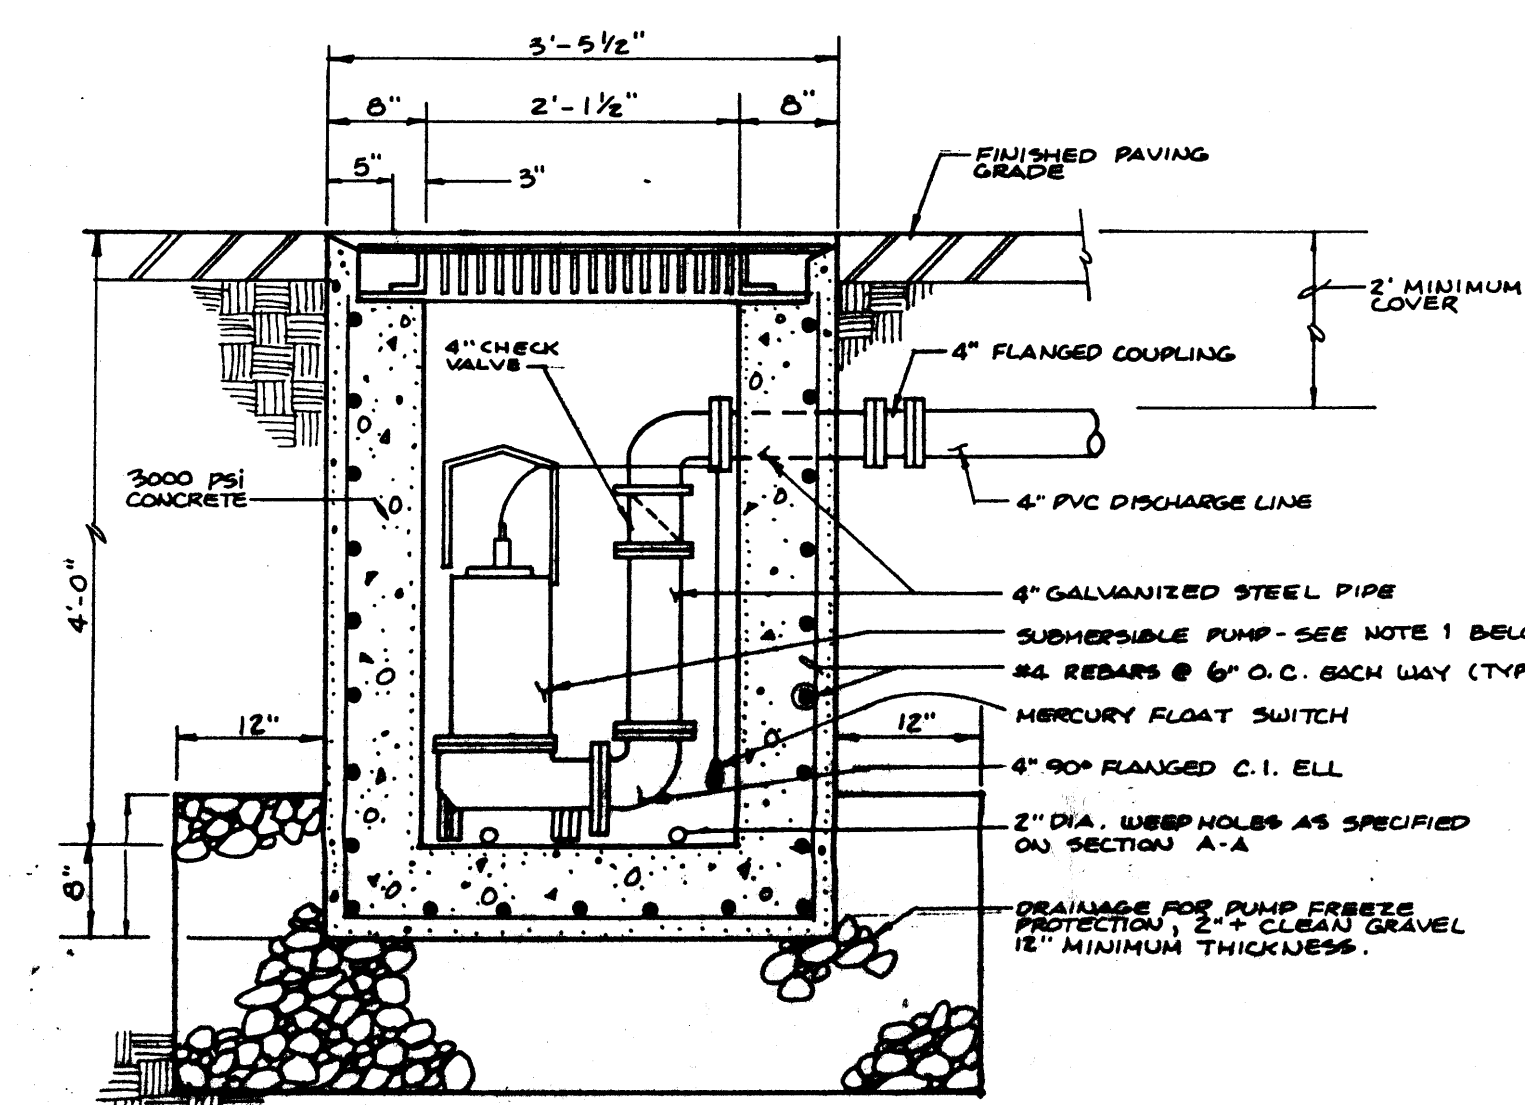

SECTION B-B

SCALE: 3/4" = 1'-0"

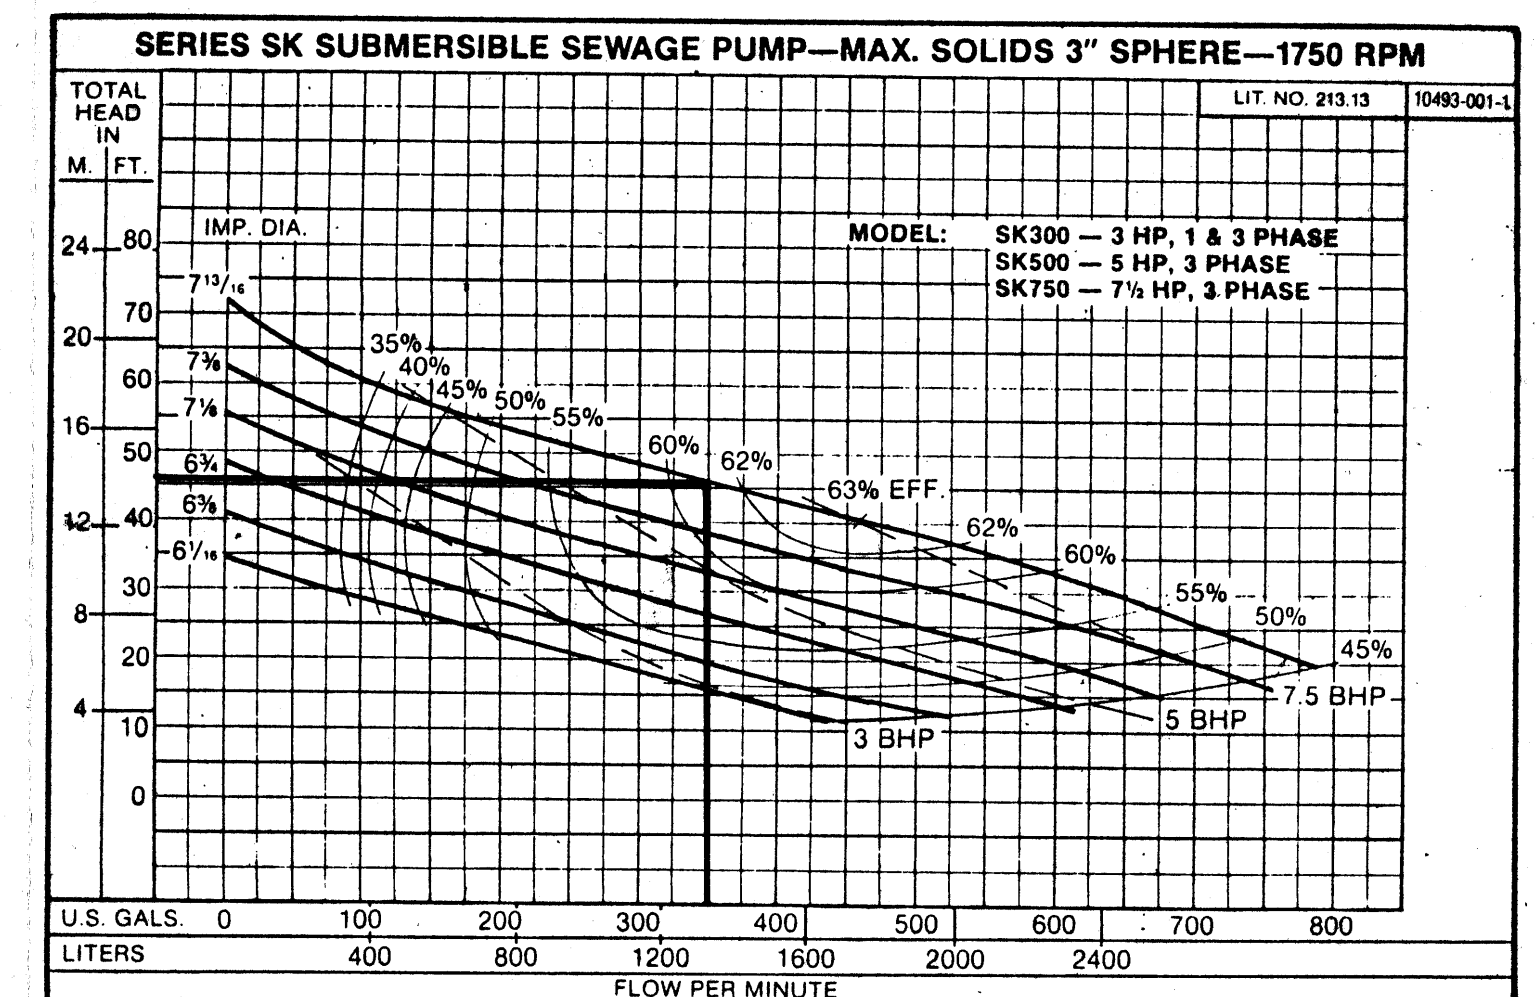

## Pump Calculations

- Estimated Discharge Rate 350 GPM

- Head Loss

- Elevation 29'-10" = 19'

- Friction (4" pipe)

Type of Pipe: PVC

Design C Value: 130

Chart C Value: 100

Correction Required = 0.62

 $H_f = 0.2083 \times (100/C)^{1.85} \times (Q^{1.85}/d^{4.8655})$  $H_f = 6.1 \text{ ft}/100 \text{ ft} \times (6.1/100) 305 = 18.61 \text{ ft}$ 

Length of Pipe = 305'±

- Friction (4" pipe)

Type of Pipe: Steel

Design C Value: 100

Chart C Value: 100

No Correction Required

 $H_f = 24.12 \text{ ft}/100 \text{ ft}$ 

Length of Pipe = 8'±

- Equivalent Length of Pipe

2 90° Ell @ 11 ft ea For 22 ft

1 45° Ell @ 5 ft ea For 5 ft

 $H_{f,s} = (8+22+5) (24.1/100) = 8.44 \text{ ft}$ 


- Total

 $H_T = H_z + H_{f,p} + H_{f,s} = 19 + 18.61 + 8.44 = 46.05 \text{ ft}$  $Q = 350 \text{ GPM} (1 \text{ cf}/7.48 \text{ gallons}) (1 \text{ min}/60 \text{ sec}) = 0.8 \text{ cfs}$ 

Reference: Cameron Hydraulic Data, 14th Edition Ingersoll-Rand Company, Woodcliff Lake, NM 1970, pp-27, 36 and 48.

## Notes:

- Install one HYDRO-O-MATIC submersible pumps, Model SK500, 7 1/2 HP motor, or approved equal. Pump installation shall include two mercury float switches with controls set for "OFF" and "ON" modes of operation.
- Refer to Electrical Plans for location of pump control box, installation of electrical cable/conduit and pump/control one-line diagrams.
- Grating and frame shall be cleaned of all scale, rust and foreign materials and shall be painted with one shop coat of red oxide primer, then 2 finish coats of aluminum paint (AASHO M69).
- Installation of the mercury float switches shall be at levels providing optimum pumping time without excessive pump cycling.

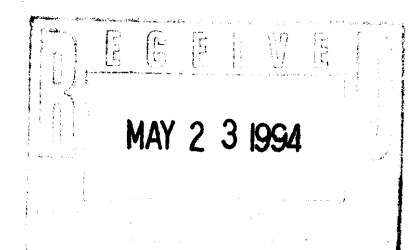

JEFF MORTENSEN & ASSOCIATES, INC.  
6010-B MIDWAY PARK BLVD. N.E.  
ALBUQUERQUE, NEW MEXICO 87109  
ENGINEERS & SURVEYORS (505)345-4250

SUBMERSIBLE PUMP DETAILS &amp; SECTIONS

DOUBLE RAINBOW BAKERY &amp; CAFE

DESIGNED BY M.F.D.

DRAWN BY T.P.H.

APPROVED BY J.G.M.

NO.	DATE	BY	REVISIONS	JOB NO.
1				921122
2				DATE
3				12-1993
4				SHEET
5				2 OF
6				2

# KEYED NOTES

## SITE WALLS AND PAVING (SEE STRUCTURAL DRAWINGS)

- EXISTING REIN. CONCRETE FOOTING (N.I.F.)
- EXISTING REIN. CONCRETE RET. WALL (N.I.F.)
- REIN. CONCRETE FOOTING ("L" FOOTING AT PROPERTY LINE)
- REIN. CONCRETE RET. WALL ARCHITECTURAL WHERE EXPOSED TO VIEW (SEE ELEVATIONS FOR JOINT AND TIE PATTERN)
- REIN. CMU WALL (CROWN TOP COURSE TO DRAIN)
- REIN. CONC. SLAB ON GRADE (SEE PLAN FOR JOINT PATTERN)
- SLIP RESISTANT SURFACE AT RAMP AND STAIR
- REIN. CONC. SLAB AT TRASH ENCLOSURE APRON
- 1/2" EXPANSION JOINT OF COMPRESSIBLE FILLER
- 1/2" TROWELED CONTROL JOINT (SEE DETAIL)
- PLASTIC CONE SNAP TIE PATTERN
- CAST-IN-PLACE RUSTICATION JOINT (SEE DETAIL 18C-4)
- ASPHALT PAVING
- COMPACTED FILL
- CONCRETE CURB (SEE DETAIL)

## HANDRAILS / GUARDRAILS / FENCING

- 1 1/2" O.D. STANDARD STEEL TUBING (PER ANSI AND ADA GUIDELINES)
- 2" O.D. STANDARD UNTREATED STEEL FENCE RAIL
- STEEL PIPE SLEEVE WITH MIN. OF 2 ANCHOR STUDS, GROUT SOLID (I.D. MAX. 1/2" LARGER THAN VERTICAL RAIL SUPPORT)
- SHRINK RESISTANT GROUT
- 3/8" STEEL ROD STOCK
- 3/8" STEEL PLATE (3/16" RADIUS AT ALL EXPOSED EDGES)
- 3/4 X 3/4 X 3/16 STEEL ANGLE FRAME W/ WELDED MITERED CORNERS
- 4" O.C. STEEL MESH OF 3/16" ROD (WELD TO FRAME AS REQ'D)
- 3/8" STEEL ROD WALL MOUNTED HANDRAIL SUPPORT
- MACHINE BOLT AND SPACER
- 6" LATH SLATS LASHED TO FENCE RAILS WITH BLACK WIRE (CUT TO UNIFORM HEIGHT AFTER INSTALLATION)

## MISC.

- 4" O.D. STEEL PIPE FILLED SOLID W/ CONC.
- 1 1/2" O.D. PAINTED STEEL BIKE RACK LOOP AND H.C. SIGN LOOP
- 4 X 4 X 1/4 STEEL ANGLE W/ ANCHORS, CAST-IN-PLACE
- DOCK BUMPER
- WALKWAY LIGHT CAST IN CONC. WALL OR BOLLARD
- CAST-IN-PLACE CONCRETE BOLLARD
- WELD AS REQUIRED
- "THOROSEAL" CEMENTIOUS WATERPROOF MEMBRANE @ EXPOSED RETAINING WALLS AROUND DETENTION POND, APPLY TO WALLS AND FOOTINGS.







## SITE WALL REIN. SCHEDULES

### 8" CONC. PROPERTY LINE RET. WALL

H' MAX	A'	V' BARS	X' BARS
≤ 4'-0"	2'-0"	#4 @ 10"	#3 @ 10"
4'-0" - 8'-0"	3'-4"	#4 @ 12"	#4 @ 10"
8'-0"	4'-8"	#5 @ 12"	#5 @ 12"

### 8" CMU PROPERTY LINE RET. WALL

H' MAX	A'	V' BARS	X' BARS
≤ 4'-0"	2'-0"	#4 @ 24"	#3 @ 10"
4'-0" - 8'-0"	3'-4"	#5 @ 16"	#4 @ 10"
8'-0"	4'-8"	#6 @ 8"	#5 @ 12"

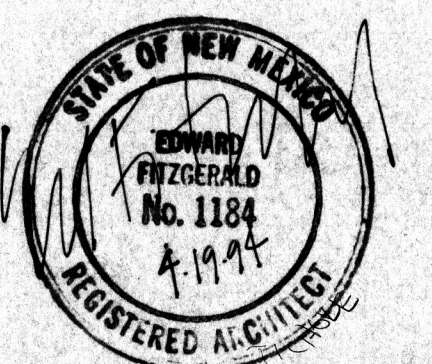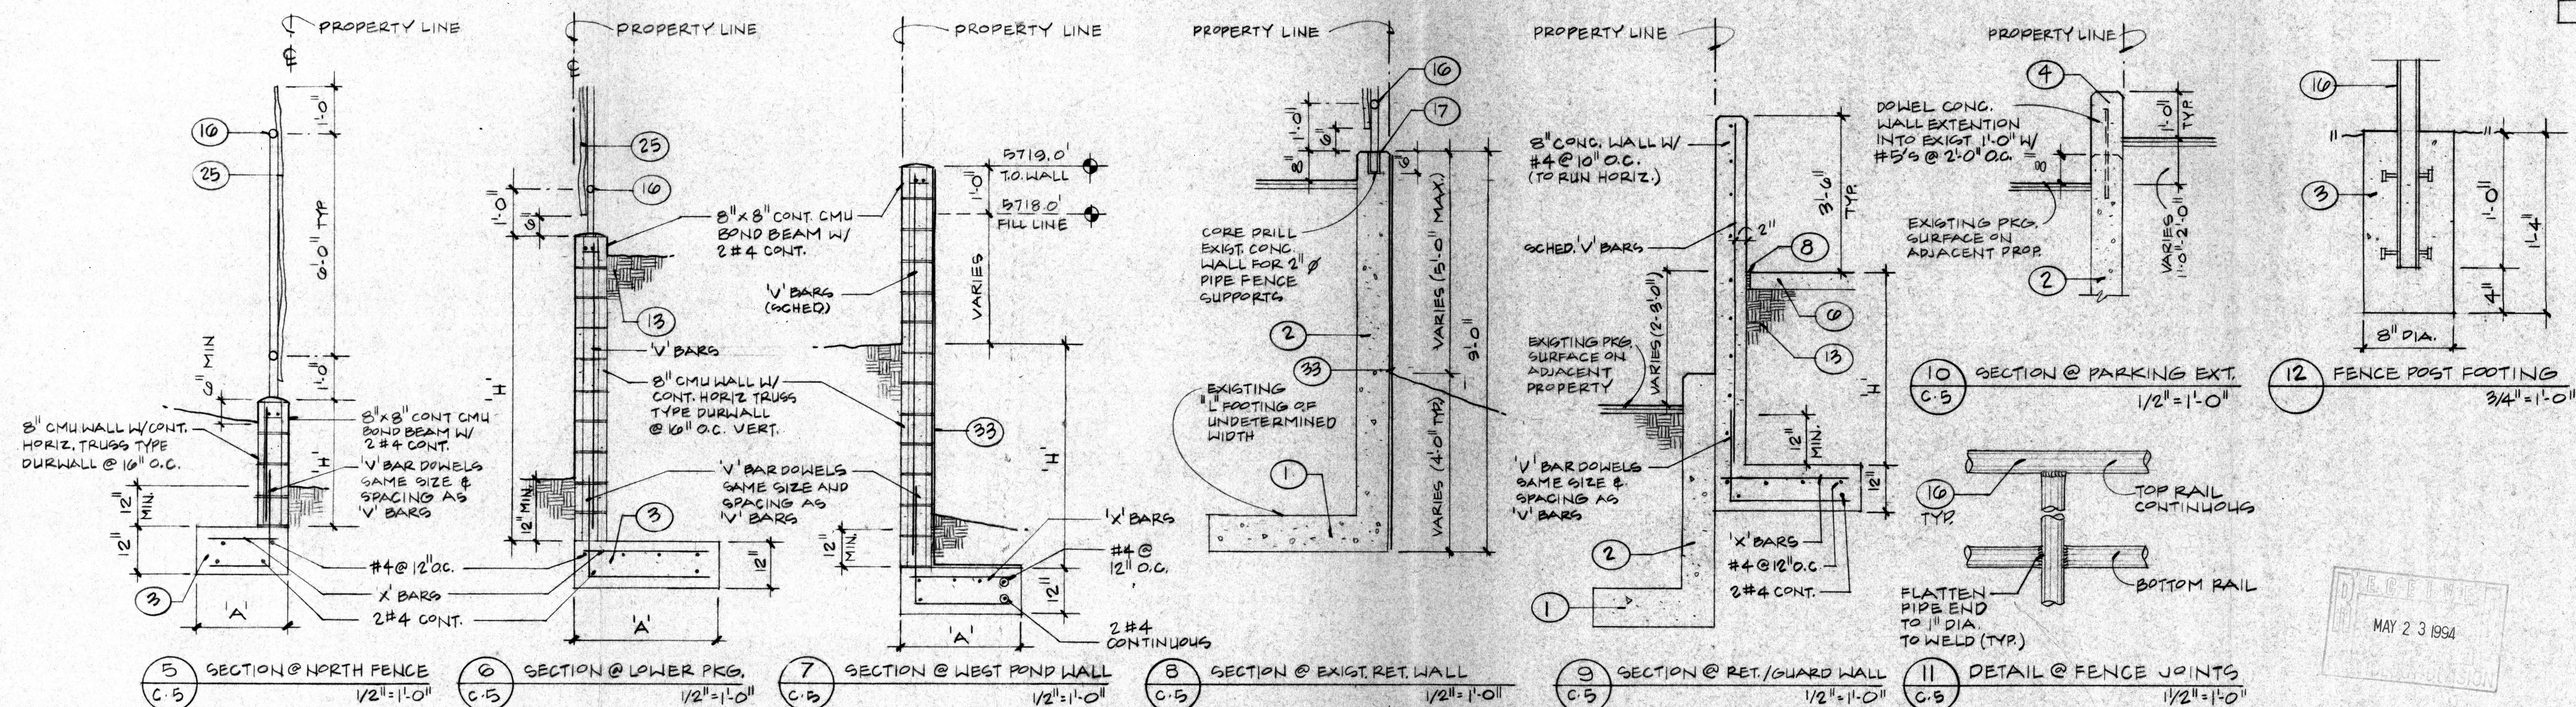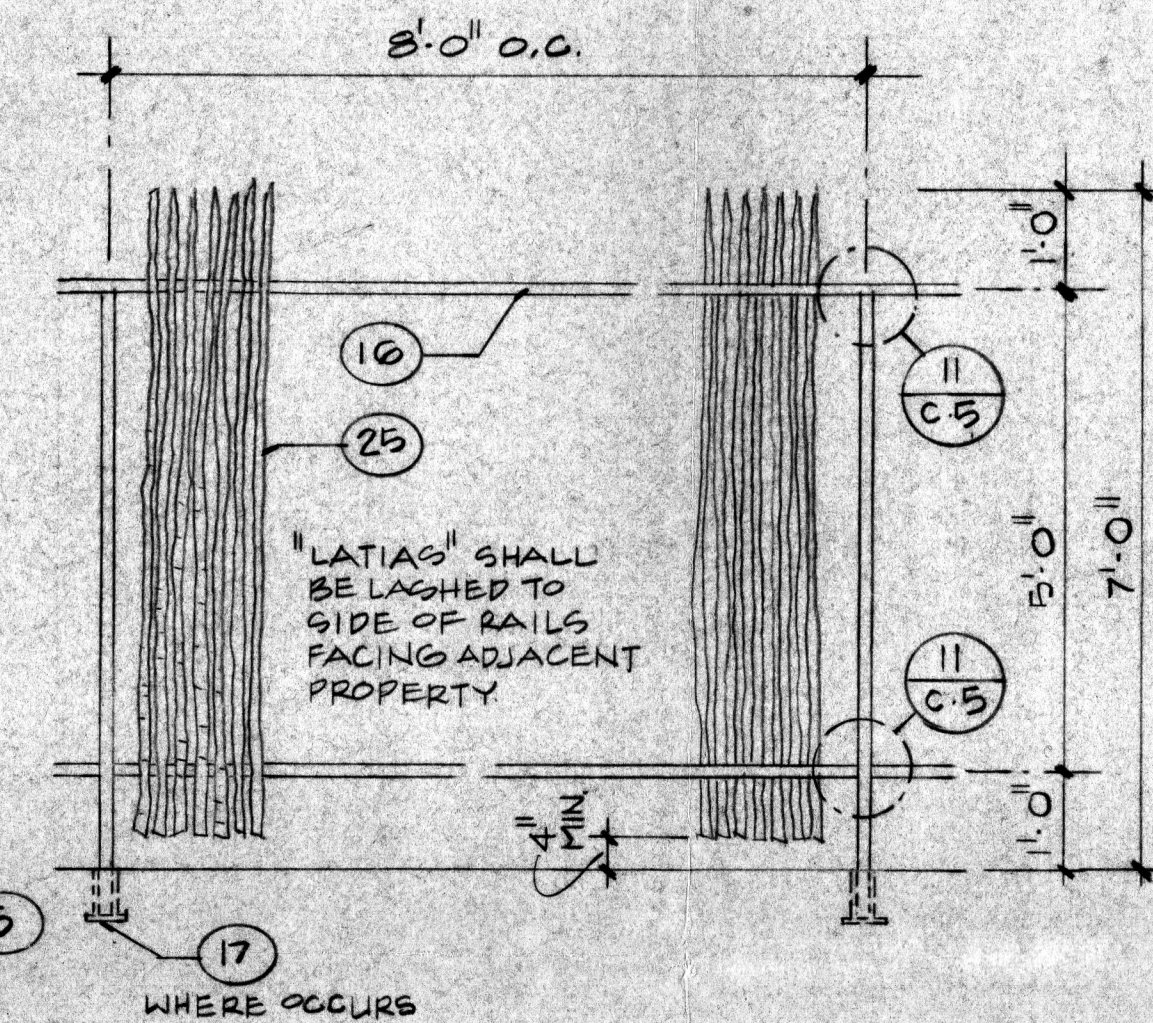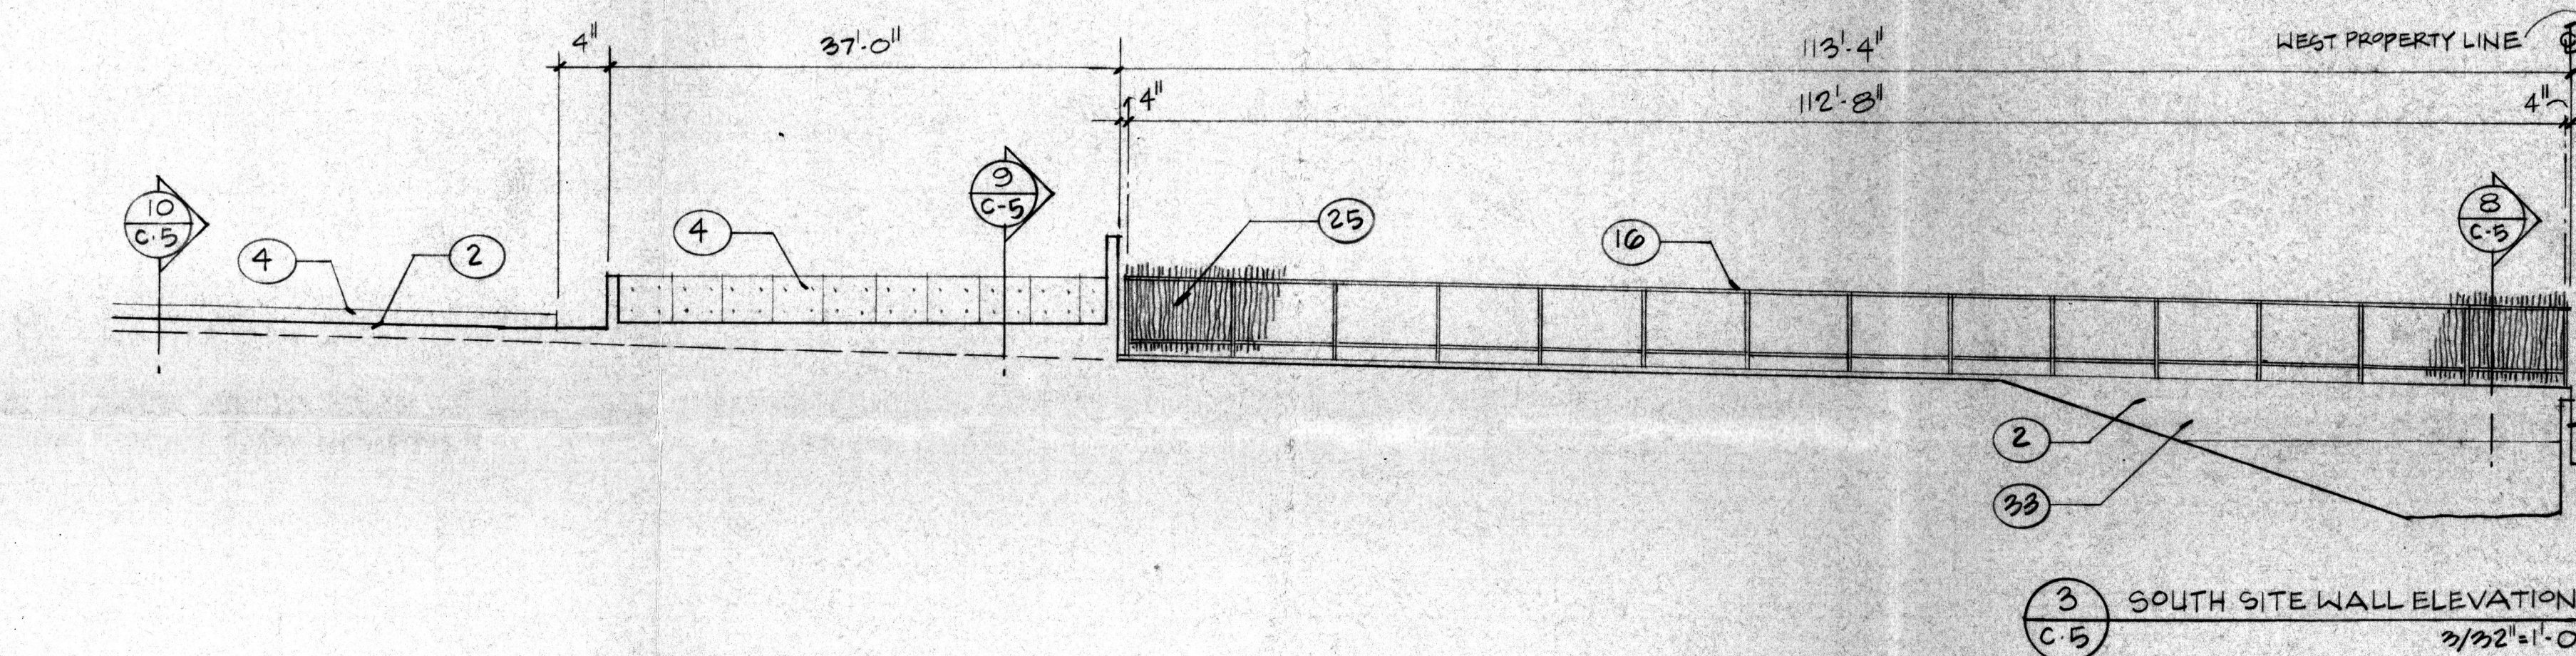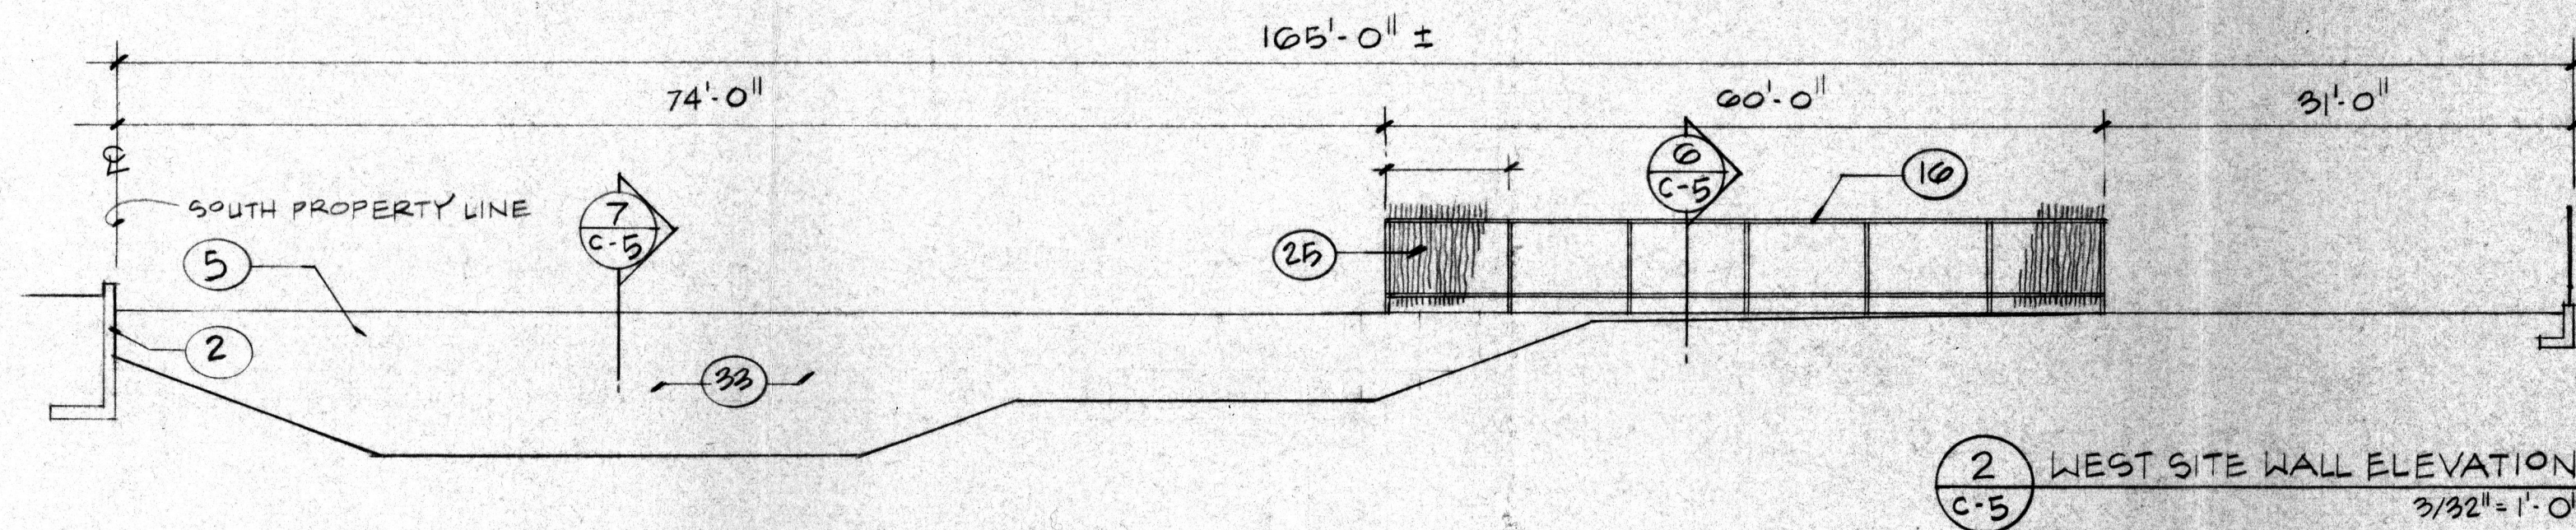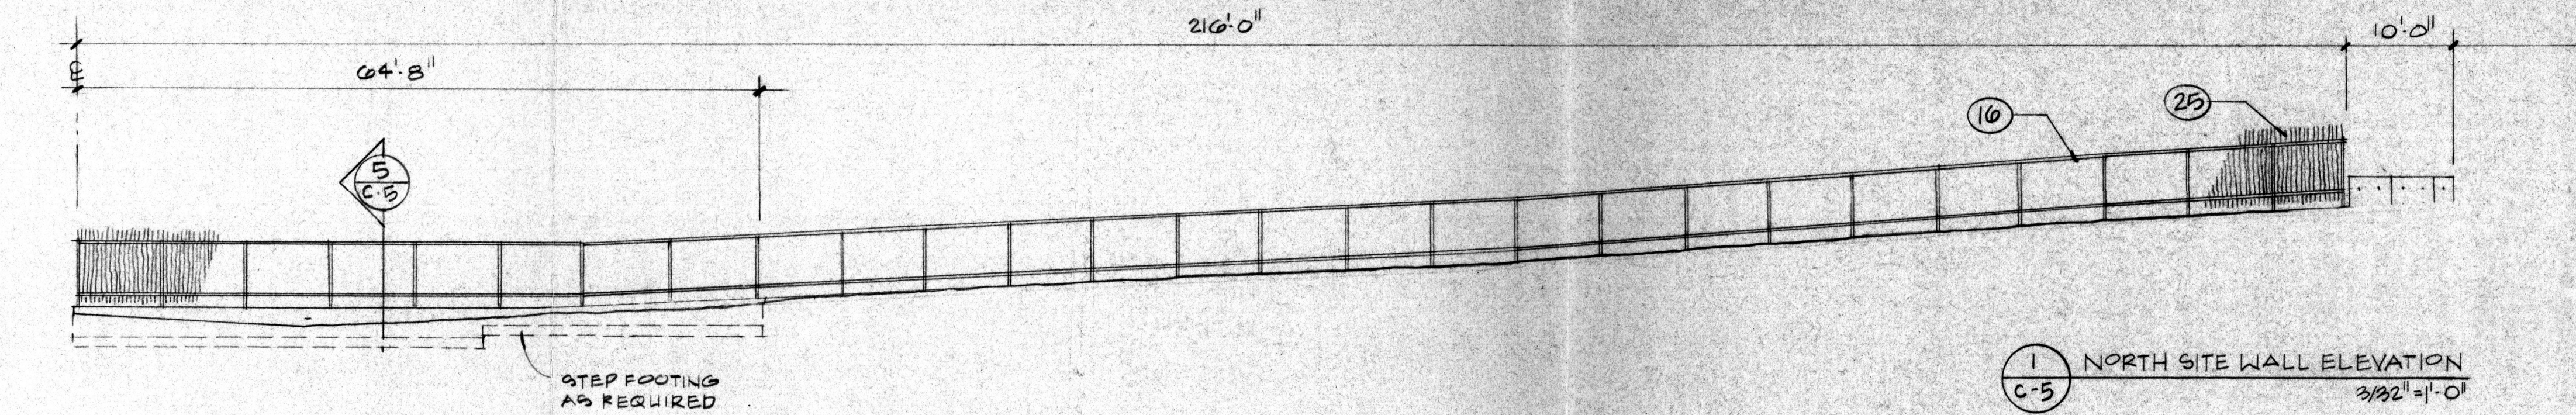


**DOUBLE RAINBOW**  
Bakery & Cafe  
Juan Tabo NE  
Albuquerque / New Mexico

Drawn By K.K. Date 4/9/94

Edward Fitzgerald  
Architect  
2225 Lead Avenue SE  
Albuquerque, New Mexico  
87106

**C-5**

Drawing SITE WALL ELEV./DETAILS

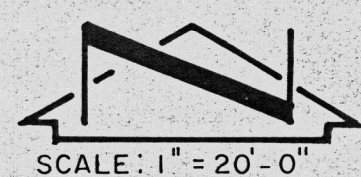

SCALE: 1" = 20'-0"

**LEGAL DESCRIPTION:**LOT 11 OF UNPLATTED LANDS KNOWN AS  
"160 ACRE MASTER PLAN".**BENCHMARK:**A STANDARD NNSHC BRASS TABLET STAMPED  
"JT-1A", SET IN THE TOP OF A CONCRETE POST  
FLUSH WITH THE GROUND LOCATED IN THE  
SOUTHERLY MEDIAN ON JUAN TABO BLVD. NE.  
& MONTGOMERY BLVD. NE.  
ELEVATION=5721.25 FEET(M.S.L.D)**LEGEND:**

	EXISTING SPOT ELEVATION		LIGHT FIXTURE
	PROPOSED SPOT ELEVATION		EXIST. LIGHT POLE
	EXISTING CONTOUR		EXISTING RETAINING WALL
	PROPOSED CONTOUR		PROPOSED CONCRETE GARDEN WALL
	EXISTING FLOWLINE		PROPERTY LINE
	PROPOSED FLOWLINE		EASEMENT LINE
	PROPOSED DIRECTION OF RUNOFF		CENTERLINE
	PROPOSED ROOF DRAINAGE		PROPOSED RETAINING WALL
	PROPOSED ASPHALT		HIGH POINT
	PROPOSED CONCRETE		FUTURE PROPOSED CONTOUR
	TOP OF CURB		TOP OF WALL ELEVATION
	FLOWLINE		PROPOSED CHAIN LINK FENCE
	FINISHED FLOOR ELEVATION		
	EXISTING FIRE HYDRANT		

**DRAINAGE PLAN**The following items concerning the Double Rainbow Drainage  
Plan are contained hereon:

1. Vicinity Map
2. Grading Plan
3. Calculations
4. Pump Details & Calculations

As shown by the Vicinity Map, the site is located on the west  
side of Juan Tabo boulevard N.E. between Montgomery Boulevard  
N.E. and Lagrima de Oro N.E. At present, the site is  
undeveloped. Much of the surrounding area is developed,  
making this an infill site.As shown by Panel 18 of 50 of the National Flood Insurance  
Program Flood Insurance Rate Maps for the City of Albuquerque,  
New Mexico, dated October 14, 1983, this site does not lie  
within a designated flood hazard zone. Further review of this  
mapping does not reveal downstream flooding to which this site  
contributes. At present, the site slopes from east to west  
onto adjacent undeveloped property. The site is situated down  
slope from Juan Tabo Boulevard N.E., which is a developed City  
street.The Grading Plan shows 1) existing grades, indicated by  
contours at 1'0" intervals, 2) proposed grades indicated by  
spot elevations and contours at 1'0" intervals, 3) the limit  
and character of the existing improvements, 4) the limit and  
character of the proposed improvements, and 5) continuity  
between existing and proposed grades. As shown this plan, the  
proposed improvements consist of the construction of a  
building along with adjacent paving and landscaping. Due to  
the fact that the site slopes away from Juan Tabo Boulevard  
N.E. at an average 5% gradient, it is not possible to obtain  
gravity drainage back to the street. Because of this, a pond is  
proposed to contain 100% of the 100-year developed runoff  
and to drain that pond with a submersible pump. The forced  
main discharge from the pond will discharge into Juan Tabo  
Boulevard N.E. Waterproofing of the adjacent walls will be  
necessary to allow for ponding within 15' of the structures.The Calculations which appear hereon analyze both the existing  
and developed conditions for the 100-year, 6-hour rainfall  
event. The Procedure for 40-acre and Smaller Basins, as set  
forth in the Revision of Section 22.2, Hydrology of the  
Development Process Manual, Volume 2, Design Criteria, dated  
January, 1993, has been used to quantify the peak rate of  
discharge and volume of runoff generated. As shown by these  
calculations, an increase in runoff is generated. The maximum  
depth of the pond will be approximately 6', thereby requiring  
fencing of the pond area. The required volume was not  
calculated using the hydrograph method from the new hydrology  
criteria, in the event that the submersible pump malfunctions.  
Therefore, the V<sub>100</sub> for the site was used so as to determine  
the volume of the pond. In order to provide erosion control  
for the pond, this area will be sodded.**CALCULATIONS****Site Characteristics**

1. Precipitation Zone = 4
2.  $P_{100} = P_{360} = 2.90$  in.
3. Total Area ( $A_T$ ) = 1.05 acres
4. Existing Land Treatment

Treatment	Area (sf/ac)	%
A	40,950 / 0.54	89.5
B	4,790 / 0.11	10.5

**5. Developed Land Treatment**

Treatment	Area (sf/ac)	%
B	9,900 / 0.23	21.6
D	35,840 / 0.82	78.4

**Existing Condition****1. Volume**

$$E_w = (E_A A_A + E_B A_B + E_C A_C + E_D A_D) / A_T$$

$$E_w = [(0.10)(0.94) + (1.08)(0.11)] / 1.05 = 0.83 \text{ in.}$$

$$V_{100} = (E_w / 12) A_T$$

$$V_{100} = (0.83 / 12) 1.05 = 0.0726 \text{ ac. ft.}; 3,170 \text{ cf}$$

**2. Peak Discharge**

$$Q_p = Q_{PA} A_A + Q_{PB} A_B + Q_{PC} A_C + Q_{PD} A_D$$

$$Q_p = Q_{100} = (2.20)(0.94) + (2.92)(0.11) = 2.4 \text{ cfs}$$

**Developed Condition****1. Volume**

$$E_w = (E_A A_A + E_B A_B + E_C A_C + E_D A_D) / A_T$$

$$E_w = [(1.08)(0.23) + (2.64)(0.82)] / 1.05 = 2.30 \text{ in.}$$

$$V_{100} = (E_w / 12) A_T$$

$$V_{100} = (2.30 / 12) (1.05) = 0.2011 \text{ ac. ft.}; 8,760 \text{ cf}$$

**2. Peak Discharge**


$$Q_p = Q_{PA} A_A + Q_{PB} A_B + Q_{PC} A_C + Q_{PD} A_D$$

$$Q_p = Q_{100} = (2.92)(0.23) + (5.25)(0.82) = 5.0 \text{ cfs}$$

**Comparison**

1.  $\Delta V_{100} = 8,760 - 3,170 = 5,590 \text{ cf (increase)}$
2.  $\Delta Q_{100} = 5.0 - 2.4 = 2.6 \text{ cfs (increase)}$

APPROVALS	NAME	DATE
A.C.E. / DESIGN		
INSPECTOR		
A.C.E. / FIELD		

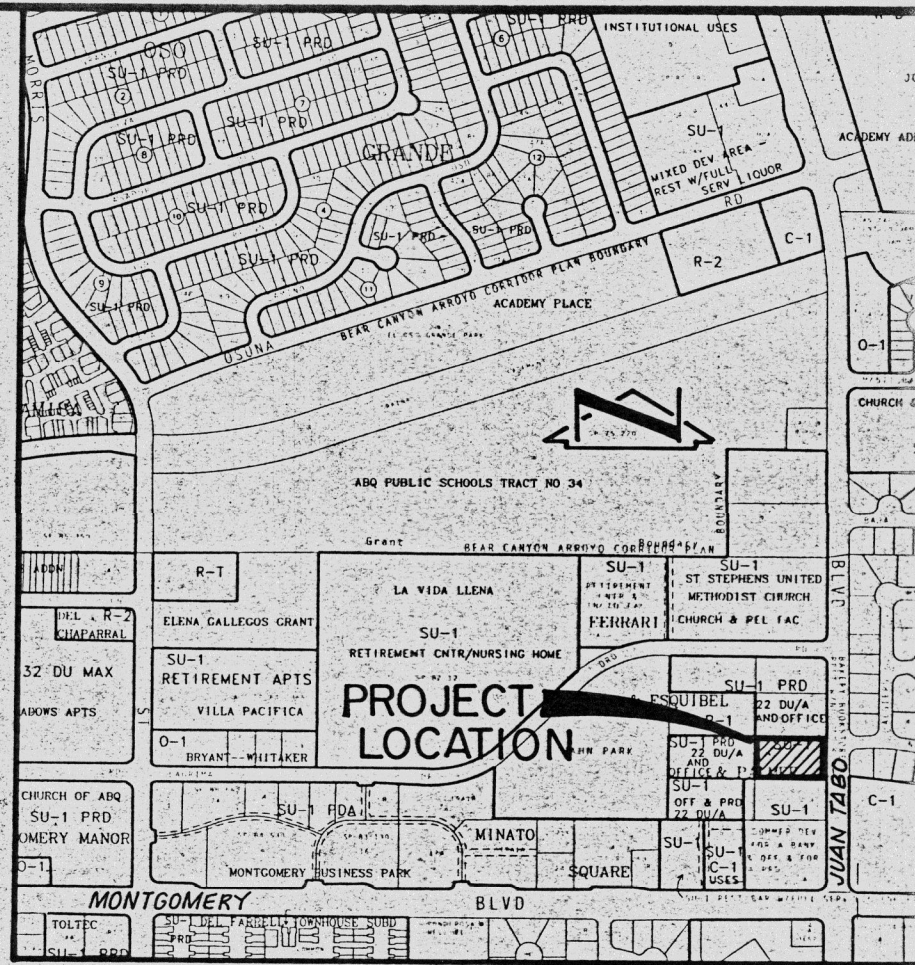**VICINITY MAP**  
SCALE: 1" = 750' (APPROX.)

F-21

**POND VOLUME** (Calculated by the Average End Area Method)

Elev (ft)	Area (ft <sup>2</sup> )	Vol (cf)	$\Sigma$ Vol (cf)
10	0		
11	368	184	184
12	550	459	643
13	781	665.5	1,308.5
14	1,015	898	2,206.5
15	1,440	1,227.5	3,434
16	1,823	1,631.5	5,065.5
17	2,167	1,995	7,060.5
18	2,493	2,330	9,390.5
19	2,825	2,659	12,049.5

W.S.L. between 17 & 18  
By interpolation 17.75 area of 2411.5 sf  
 $V_{100} = [(2167 + 2411.5) / 2] (0.7) = 1716.94 \text{ cf}$   
 $\Sigma V_{100} = 7,060.5 + 1716.94 = 8,777.43 \text{ cf}$   
W.S.L. approximately 17.75

**Construction Notes:**

1. Two (2) working days prior to any excavation, contractor must contact New Mexico One Call System 260-1990, for location of existing utilities.
2. Prior to construction, the contractor shall excavate and verify the horizontal and vertical location of all potential obstructions. Should a conflict exist, the contractor shall notify the engineer in writing so that the conflict can be resolved with a minimum amount of delay.
3. All work on this project shall be performed in accordance with applicable federal, state and local laws, rules and regulations concerning construction safety and health.
4. All construction within public right-of-way shall be performed in accordance with applicable City of Albuquerque Standards and Procedures.
5. If any utility lines, pipelines, or underground utility lines are shown on these drawings, they are shown in an approximate manner only, and such lines may exist where none are shown. If any such existing lines are shown, the location is based upon information provided by the owner of said utility, and the information may be incomplete, or may be obsolete by the time construction commences. The engineer has conducted only preliminary investigation of the location, depth, size, or type of existing utility lines, pipelines, or underground utility lines. This investigation is not conclusive, and may not be complete, therefore, makes no representation, pertaining thereto, and assumes no responsibility or liability therefor. The contractor shall inform itself of the location of any utility line, pipeline, or underground utility line in or near the area of the work in advance of and during excavation work. The contractor is fully responsible for any and all damage caused by its failure to locate, identify and preserve any and all existing utilities, pipelines, and underground utility lines. In planning and conducting excavation, the contractor shall comply with state statutes, municipal and local ordinances, rules and regulations, if any, pertaining to the location of these lines and facilities.
6. The design of planters and landscaped areas is not part of this plan. All planters and landscaped areas adjacent to the building(s) shall be provided with positive drainage to avoid any ponding adjacent to the structure. For construction details, refer to landscaping plan.
7. An Excavation/Construction Permit will be required before beginning any work within City right-of-way. An approved copy of these plans must be submitted at the time of application for this permit.
8. Backfill compaction shall be according to ARTERIAL street use.
9. Maintenance of these facilities shall be the responsibility of the owner of the property served.

C-1

**ASBUILT LEGEND**

ELEV. ASBUILT ELEV.

NOTE: TBM FOR ASBUILT IS INFORMATION  
SHOWN ON ASBUILT P&P SHEET FOR  
PUBLIC IMPROVEMENTS PROVIDED BY  
JMA, REF: SHEET 1 OF 2, PROJECT No. 4890-90

I, BERNARD W. SEITZ, JR., A REGISTERED PROFESSIONAL SURVEYOR IN THE STATE OF  
NEW MEXICO, DO HEREBY CERTIFY THAT THE ASBUILT ELEVATIONS SHOWN HEREON ARE  
BASED ON AN ACTUAL SURVEY PERFORMED JANUARY 14, 1995. THIS SURVEY MEETS THE  
MINIMUM REQUIREMENTS FOR LAND SURVEYS IN THE STATE OF NEW MEXICO ON THIS  
DATE.

BERNARD W. SEITZ, JR.

NMPS NO.

8478

01-14-95

DATE



Survey Note  
Boundary data is based on Replat  
of Lands of Ferrari-Esquivel-Palmer  
prepared by Southwest Surveying Co.  
Filed April 11, 1985. Book C-26,  
page 192.

**GRADING AND DRAINAGE PLAN****DOUBLE RAINBOW BAKERY & CAFE**

JEFF MORTENSEN & ASSOCIATES, INC.  
6010-B MIDWAY PARK BLVD. N.E.  
ALBUQUERQUE, NEW MEXICO 87109  
ENGINEERS & SURVEYORS (505)343-4250

DESIGNED BY	M.F.D.	NO.	DATE	BY	REVISIONS	JOB NO.
		1	3/94	M.F.D.	REVISE DRAINAGE PLAN, SHOW EASEMENT, FLOOD PROOFING.	921122
DRAWN BY	T.P.H.					DATE
						12-1993
APPROVED BY	J.G.M.					SHEET
						1 OF 2

# KEYED NOTES

## SITE WALLS AND PAVING (SEE STRUCTURAL DRAWINGS)

- EXISTING REIN. CONCRETE FOOTING (V.I.F.)
- EXISTING REIN. CONCRETE RET. WALL (V.I.F.)
- REIN. CONCRETE FOOTING ("L" FOOTING AT PROPERTY LINE)
- REIN. CONCRETE RET. WALL ARCHITECTURAL WHERE EXPOSED TO NEW (SEE ELEVATIONS FOR JOINT AND TIE PATTERN)
- REIN. CMU WALL (CROWN TOP COURSE TO DRAIN)
- 4" REIN. CONC. SLAB ON GRADE (SEE PLAN FOR JOINT PATTERN)
- SLIP RESISTANT SURFACE AT RAMP AND STAIR
- 6" REIN. CONC. SLAB AT TRASH ENCLOSURE APRON
- 1/2" EXPANSION JOINT OF COMPRESSIBLE FILLER
- 1/2" TROWELED CONTROL JOINT (SEE DETAIL)
- PLASTIC CONE SNAP TIE PATTERN
- CAST-IN-PLACE RUSTICATION JOINT (SEE DETAIL 18/C-4)
- ASPHALT PAVING
- COMPACTED FILL
- CONCRETE CURB (SEE DETAIL)

## HANDRAILS / GUARDRAILS / FENCING

- 1 1/2" O.D. STANDARD STEEL TUBING (PER ANSI AND ADA GUIDELINES)
- 2" O.D. STANDARD UNTREATED STEEL FENCE RAIL
- STEEL PIPE SLEEVE WITH MIN. OF 2 ANCHOR STUDS. GROUT SOLID (I.D. MAX. 1/2" LARGER THAN VERTICAL RAIL SUPPORT)
- SHRINK RESISTANT GROUT
- 3/8" STEEL ROD STOCK
- 3/8" STEEL PLATE (3/8" RADIUS AT ALL EXPOSED EDGES)
- 3/4 X 3/4 X 3/16 STEEL ANGLE FRAME W/ WELDED MITERED CORNERS
- 4" O.C. STEEL MESH OF 3/16" ROD (WELD TO FRAME AS REQ'D)
- 3/8" STEEL ROD WALL MOUNTED HANDRAIL SUPPORT
- MACHINE BOLT AND SPACER
- 6" LATA' SLATS LASHED TO FENCE RAILS WITH BLACK WIRE (CUT TO UNIFORM HEIGHT AFTER INSTALLATION)







## MISC.

- 4" O.D. STEEL PIPE FILLED SOLID W/ CONC.
- 1 1/2" O.D. PAINTED STEEL BIKE RACK LOOP AND H.C. SIGN LOOP
- 4 X 4 X 1/4 STEEL ANGLE W/ ANCHORS, CAST-IN-PLACE
- DOCK BUMPER
- WALKWAY LIGHT CAST IN CONC. WALL OR BOLLARD
- CAST-IN-PLACE CONCRETE BOLLARD
- WELD AS REQUIRED
- THOROSEAL CEMENTIOUS WATERPROOF MEMBRANE @ EXPOSED RETAINING WALLS AROUND DETENTION POND. APPLY TO WALLS AND FOOTINGS.

## SITE WALL REIN. SCHEDULES

8" CONC. PROPERTY LINE RET. WALL				
H' MAX	A'	V' BARS	X' BARS	
≤ 4'-0"	2'-0"	#4 @ 10"	#3 @ 16"	
4'-0"	3'-4"	#4 @ 12"	#4 @ 16"	
8'-0"	4'-8"	#5 @ 12"	#5 @ 12"	

8" CMU PROPERTY LINE RET. WALL				
H' MAX	A'	V' BARS	X' BARS	
≤ 4'-0"	2'-0"	#4 @ 24"	#3 @ 16"	
4'-0"	3'-4"	#5 @ 16"	#4 @ 16"	
8'-0"	4'-8"	#6 @ 8"	#5 @ 12"	

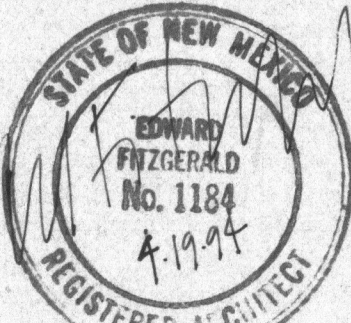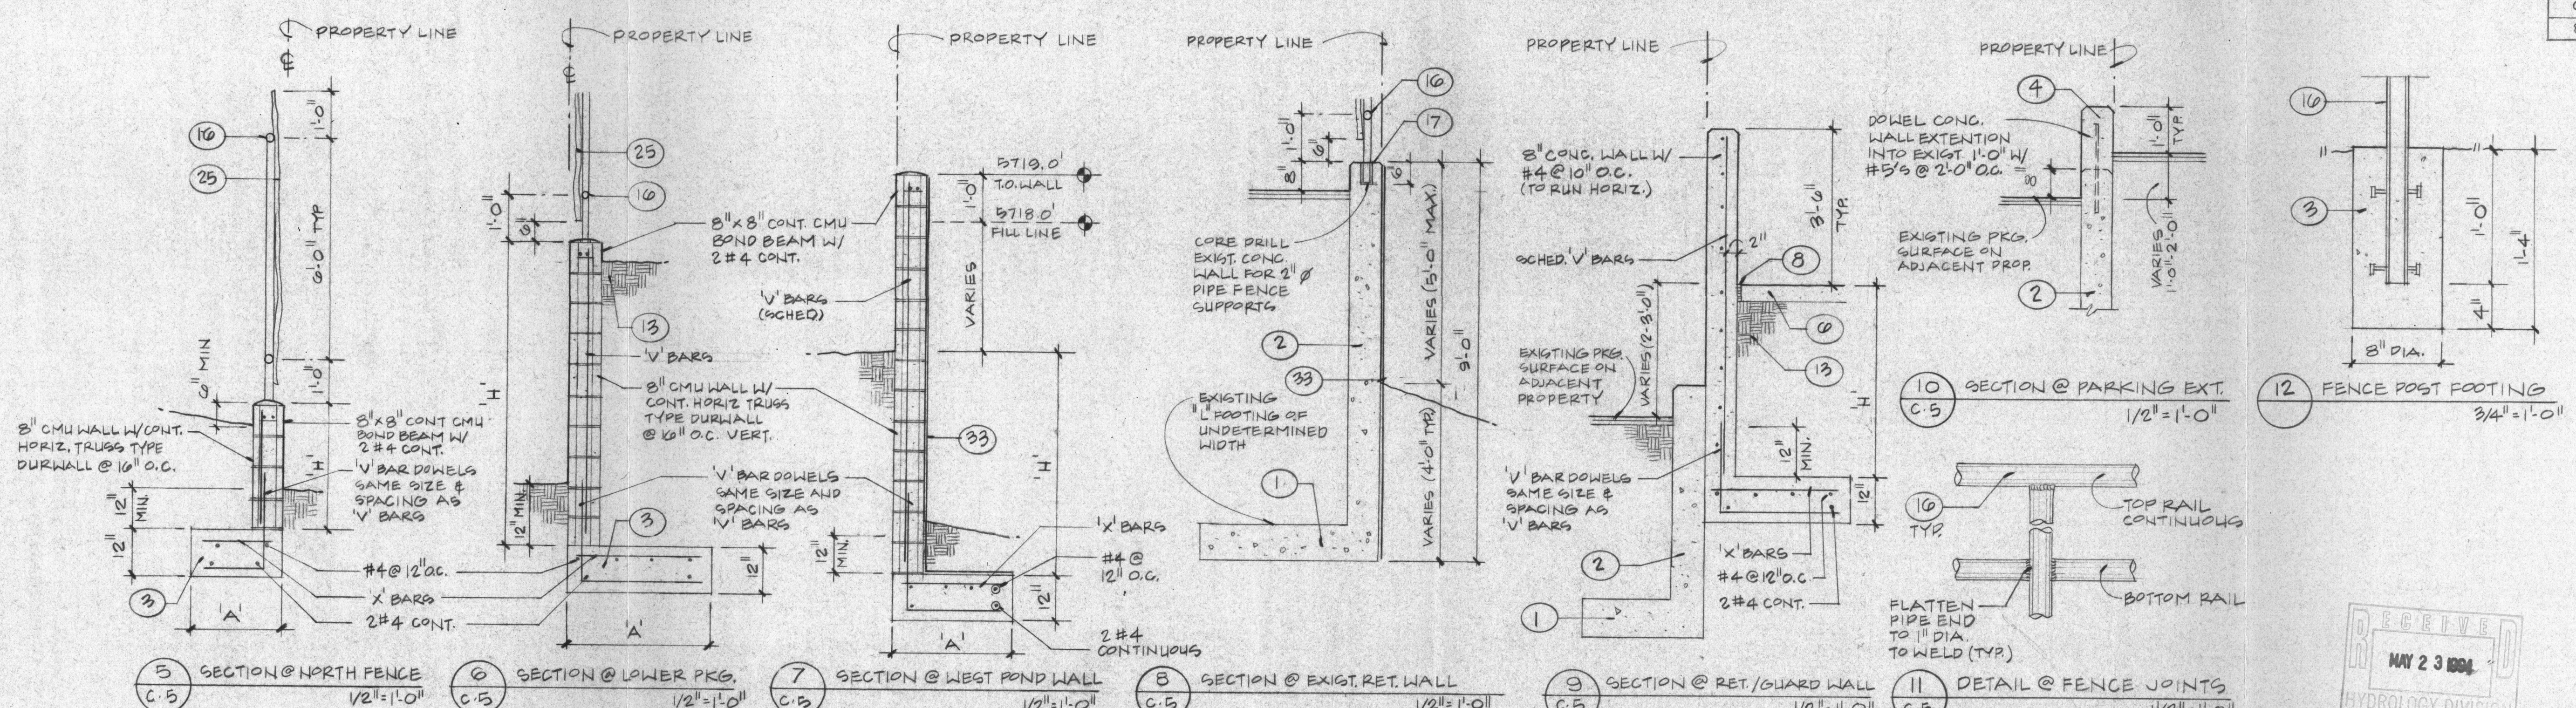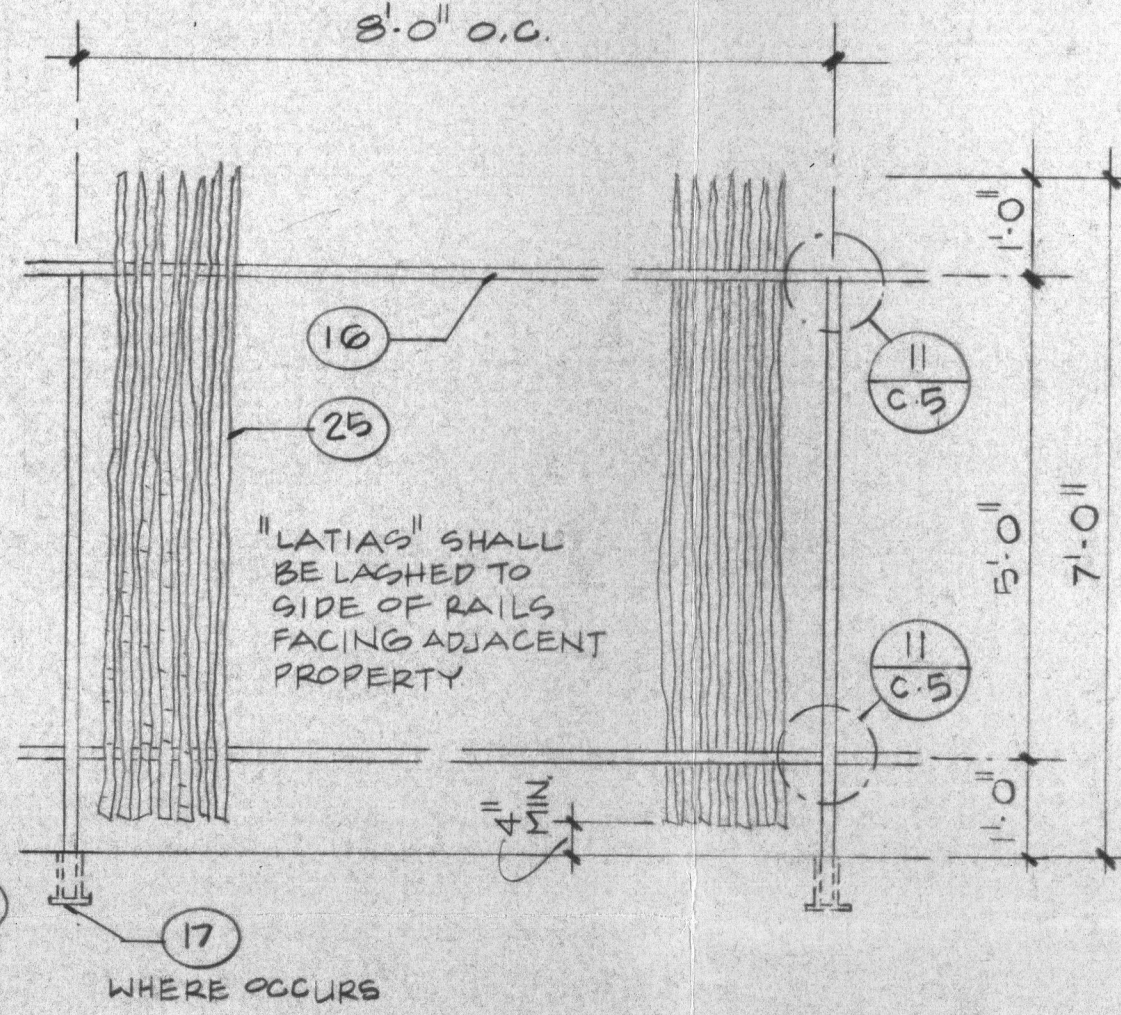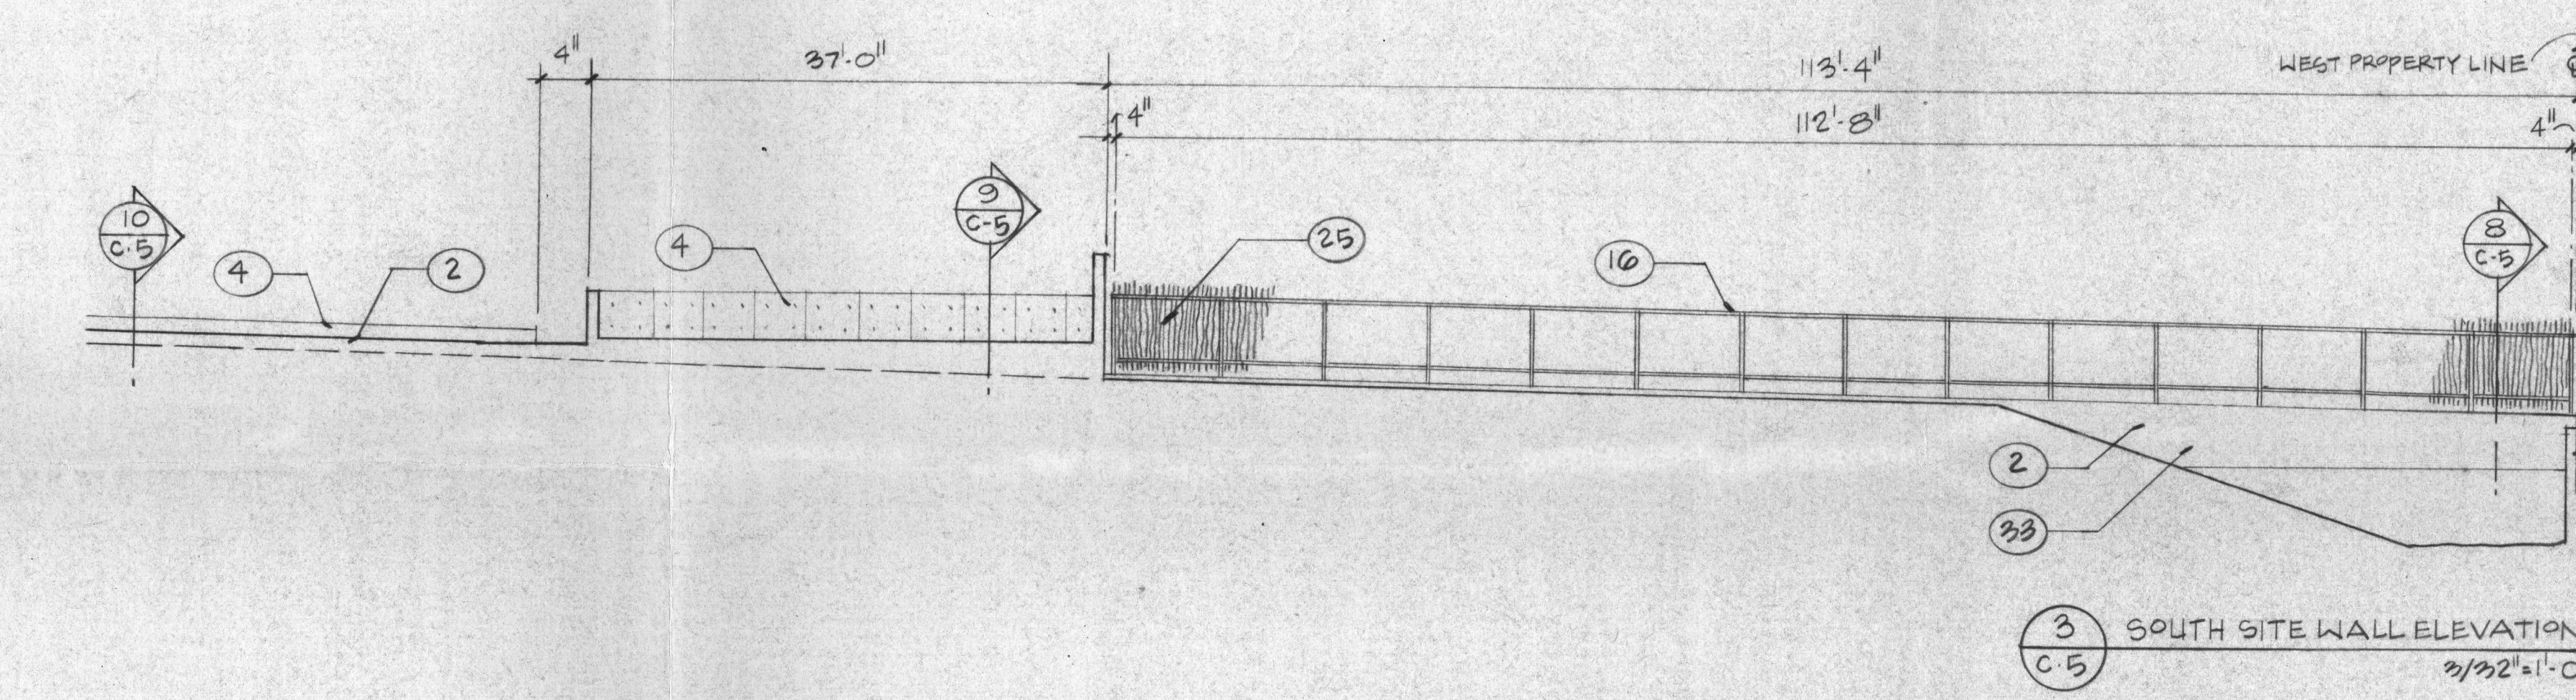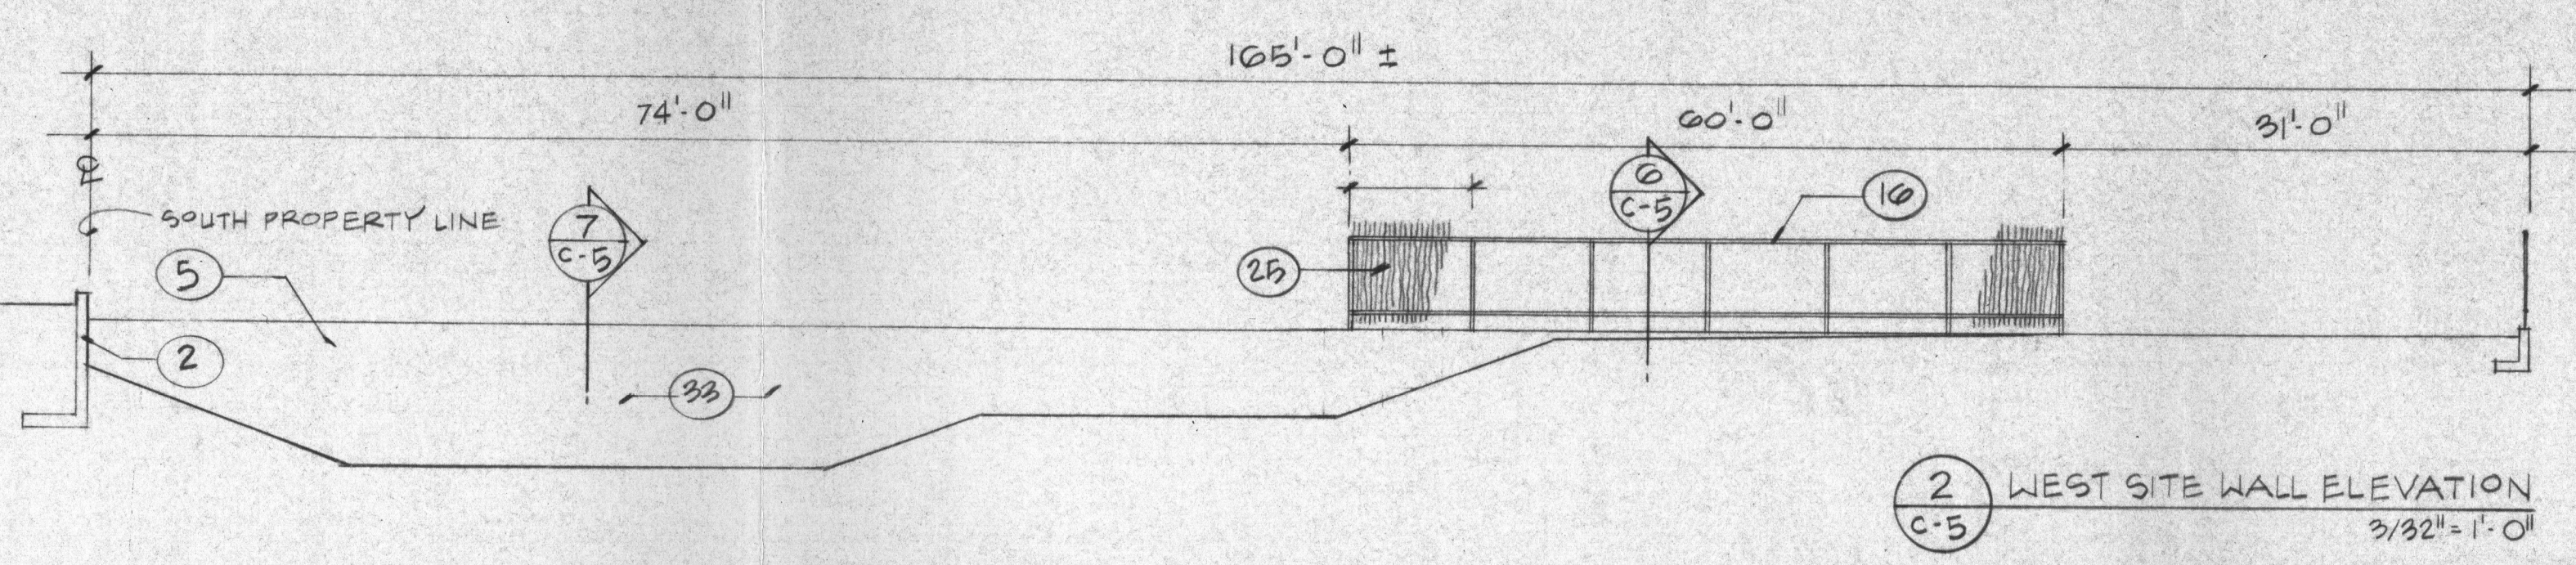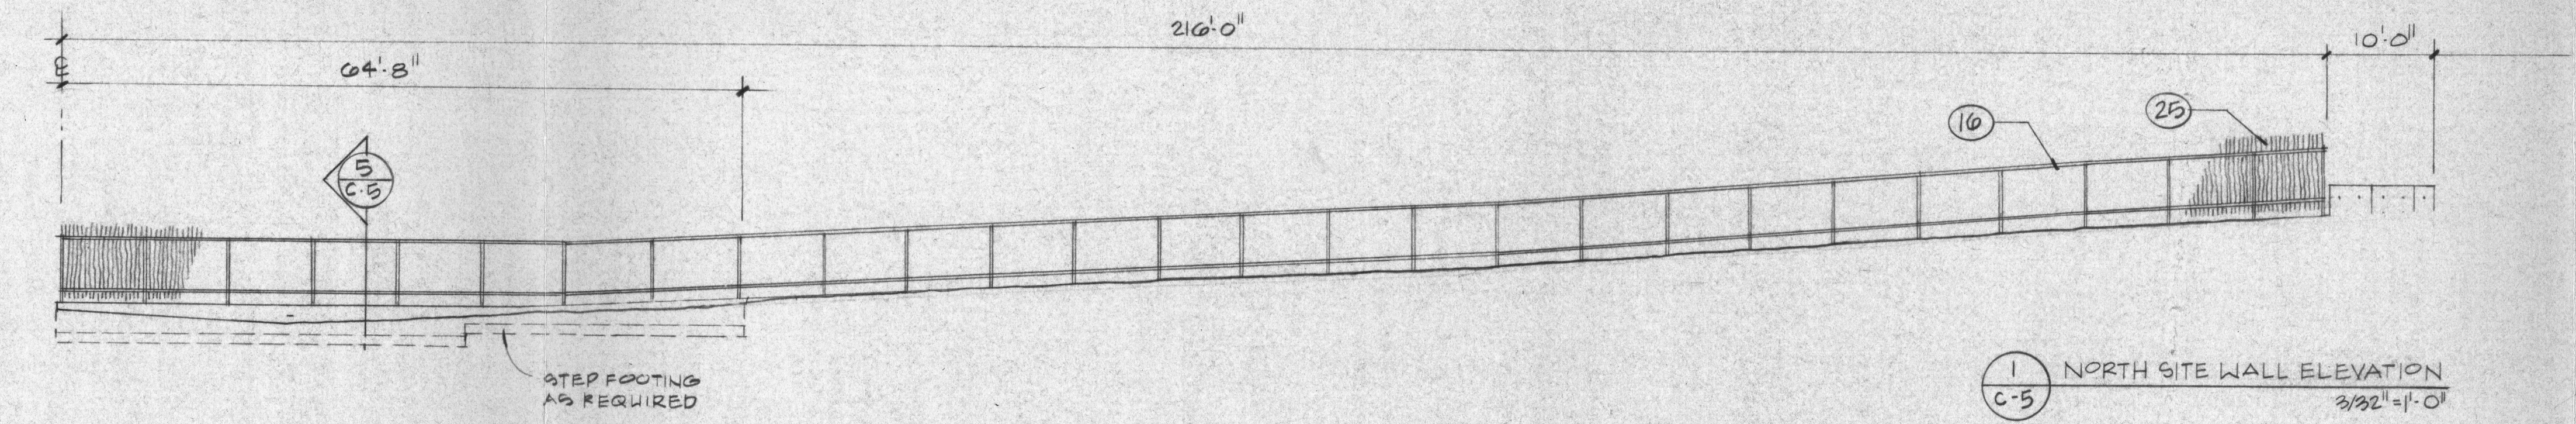


**DOUBLE RAINBOW**  
Bakery & Cafe  
Juan Tabo NE  
Albuquerque / New Mexico

Drawn By K.K. Date 4.19.94  
**Edward Fitzgerald**  
Architect  
2225 Lead Avenue SE  
Albuquerque, New Mexico  
8 7 7 1 0 6  
5 0 5 . 2 6 8 . 9 0 5 5

**C-5**

Drawing SITE WALL ELEV./DETAILS

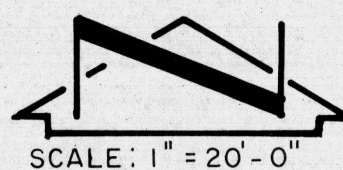


SCALE: 1" = 20'-0"

**LEGAL DESCRIPTION:**LOT 11 OF UNPLATTED LANDS KNOWN AS  
160 ACRE MASTER PLAN.**BENCHMARK:**A STANDARD NMSHC BRASS TABLET STAMPED  
"UT-1A", SET IN THE TOP OF A CONCRETE POST  
FLUSH WITH THE GROUND LOCATED IN THE  
SOUTHERLY MEDIAN ON JUAN TABO BLVD. NE.  
8 MONTGOMERY BLVD. NE.  
ELEVATION=5721.25 FEET (M.S.L.D.)**AS-BUILT LEGEND**

TW 19.41 AS-BUILT TOP-OF-WALL ELEVATION  
GRND 14.2 AS-BUILT GROUND SHOT  
24.45 AS-BUILT SPOT ELEVATION  
24.00 AS-BUILT SPOT ELEVATION

**LEGEND:**

EXISTING SPOT ELEVATION	EXISTING LIGHT POLE
PROPOSED SPOT ELEVATION	EXIST. LIGHT POLE
EXISTING CONTOUR	EXISTING RETAINING WALL
PROPOSED CONTOUR	PROPOSED CONCRETE GARDEN WALL
EXISTING FLOWLINE	PROPERTY LINE
PROPOSED FLOWLINE	EASEMENT LINE
PROPOSED DIRECTION OF RUNOFF	CENTERLINE
PROPOSED ROOF DRAINAGE	PROPOSED RETAINING WALL
PROPOSED ASPHALT	HIGH POINT
PROPOSED CONCRETE	FUTURE PROPOSED CONTOUR
TC TOP OF CURB	TW TOP OF WALL ELEVATION
FL FLOWLINE	PROPOSED CHAIN LINK FENCE
FF FINISHED FLOOR ELEVATION	
EXISTING FIRE HYDRANT	

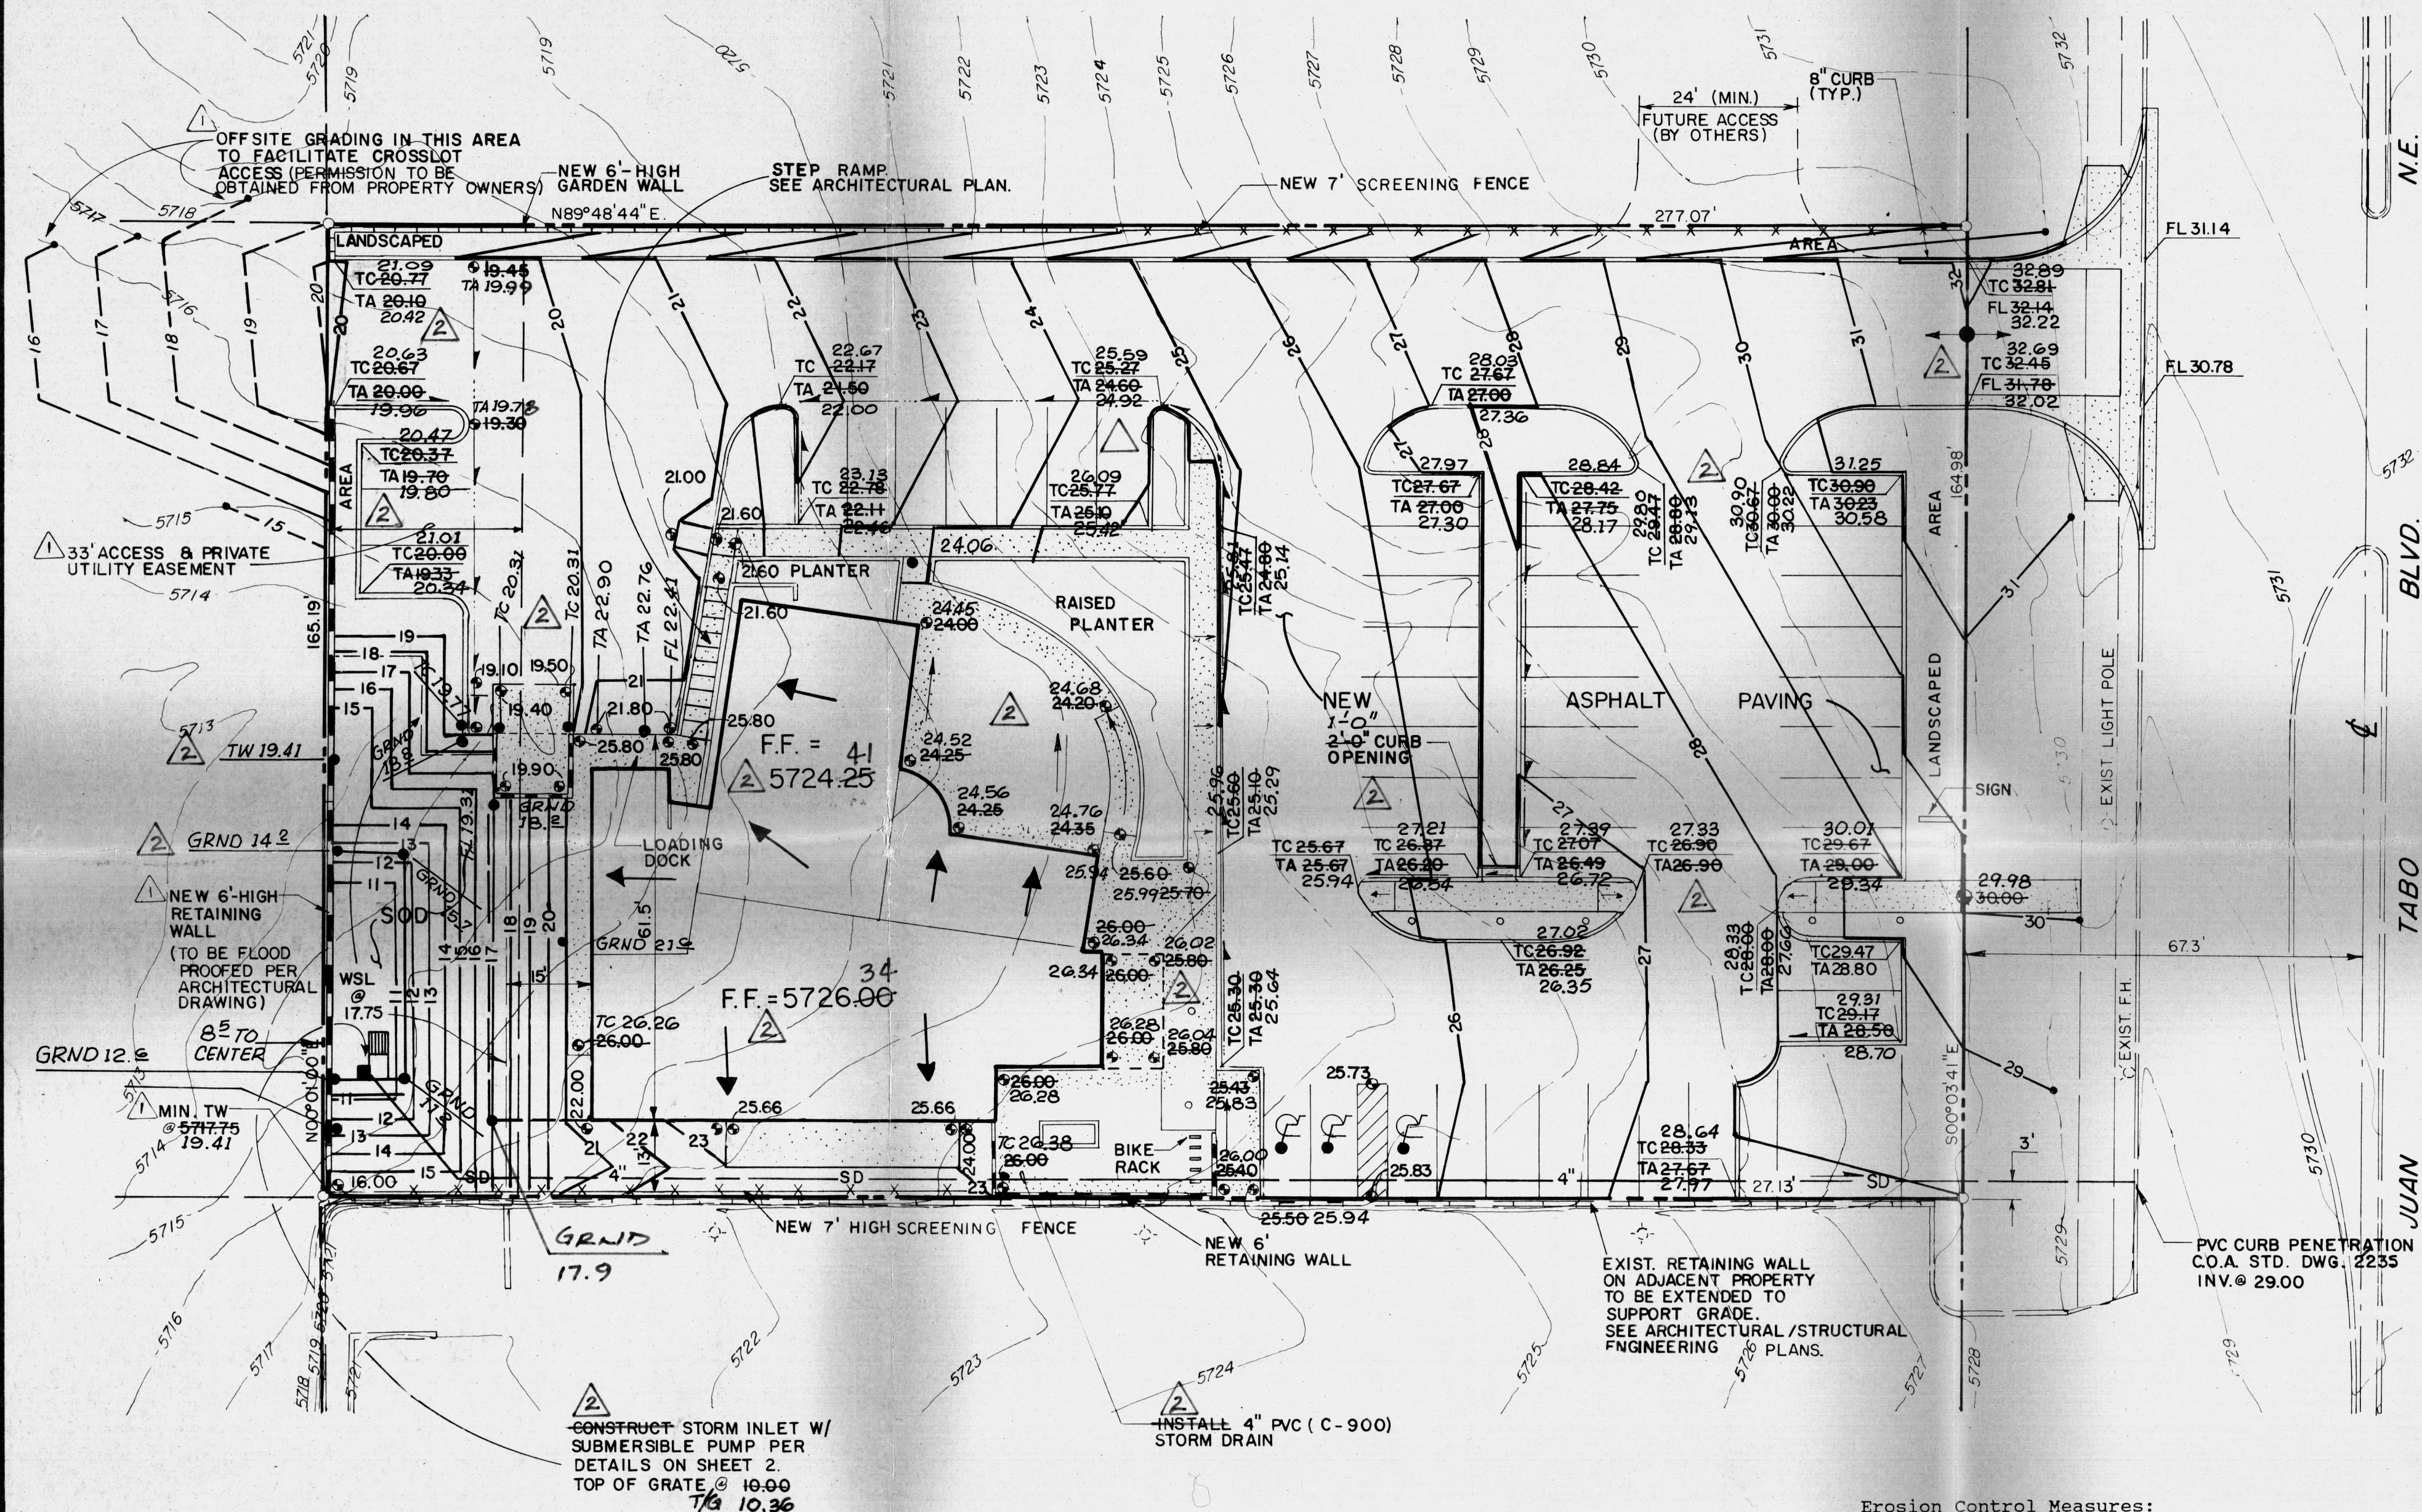

As indicated by the as-built information shown hereon, the Double Rainbow Bakery and Cafe has not been constructed in substantial conformance with the approved Grading and Drainage Plan. The as-built information shown hereon has been collected by Bernard W. Seitz, Jr., N.M.P.S. 8478. Close review of the as-built elevations indicates that the majority of the elevations are higher than designed. The average deviation is 0.3 vertical feet. For the most part, this does not present a problem in satisfying the intent of the approved plan. Consequently, the failure of the Contractor to follow the design grades within a closer tolerance will not adversely impact the ability of the parking lot and other paved surfaces to drain in accordance with the approved plan. The detention pond, on the other hand, has been constructed considerably higher than the approved plan even when the 0.3 feet difference is taken into consideration. Because of this, the required pond volume has not been provided at a safe distance from the new building. The top of the retaining wall at the west side of the project has been constructed taller than the minimum elevations specified on the approved plan. Whereby sufficient volume will hence be provided, the ponding limits will be shifted closer than 15 feet to the new building. Until such time as 1) the pond is regraded to conform with the intent of the approved plan, or 2) a certification from the geotechnical engineer that ponding closer than 15 feet will not create an adverse impact on the structure, the Permanent Certificate of Occupancy should be withheld. At this time, the engineer is only prepared to recommend issuance of a Temporary Certificate of Occupancy.

**CERTIFICATION**

CONSTRUCT STORM INLET W/  
SUBMERSIBLE PUMP PER  
DETAILS ON SHEET 2  
TOP OF GRATE @ 10.00  
T/W 10.36

INSTALL 4" PVC (C-900)  
STORM DRAIN

NEW 6' HIGH RETAINING WALL

NEW 7' HIGH SCREENING FENCE

NEW 6' HIGH GARDEN WALL

NEW 7' SCREENING FENCE

NEW 6' HIGH RETAINING WALL

NEW 7' SCREENING FENCE

NEW 6' HIGH RETAINING WALL

NEW 7' SCREENING FENCE

**Erosion Control Measures:**

- The contractor shall ensure that no soil erodes from the site into public right-of-way or onto private property. This can be achieved by constructing temporary berms at the property lines and wetting the soil to keep it from blowing.
- The contractor shall promptly clean up any material excavated within the public right-of-way so that the excavated material is not susceptible to being washed down the street.
- The contractor shall secure "Topsoil Disturbance Permit" prior to beginning construction.

**Survey Note**

Boundary data is based on Replat  
of Lands of Ferrari-Esquivel-Palmer  
prepared by Southwest Surveying Co.  
Filed April 11, 1985. Book C-26,  
page 192.

**Drainage Plan**

The following items concerning the Double Rainbow Drainage Plan are contained hereon:

- Vicinity Map
- Grading Plan
- Calculations
- Pump Details & Calculations

As shown by the Vicinity Map, the site is located on the west side of Juan Tabo boulevard N.E. between Montgomery Boulevard N.E. and Lagrima de Oro N.E. At present, the site is undeveloped. Much of the surrounding area is developed, making this an infill site.

As shown by Panel 18 of 50 of the National Flood Insurance Program Flood Insurance Rate Maps for the City of Albuquerque, New Mexico, dated October 14, 1983, this site does not lie within a designated flood hazard zone. Further review of this mapping does not reveal downstream flooding to which this site contributes. At present, the site slopes from east to west onto adjacent undeveloped property. The site is situated down slope from Juan Tabo Boulevard N.E., which is a developed city street.

The Grading Plan shows 1) existing grades indicated by contours at 1'0" intervals, 2) proposed grades indicated by spot elevations and contours at 1'0" intervals, 3) the limit and character of the existing improvements, 4) the limit and character of the proposed improvements, and 5) continuity between existing and proposed grades. As shown this plan, the proposed improvements consist of the construction of a building along with adjacent paving and landscaping. Due to the fact that the site slopes away from Juan Tabo Boulevard N.E. at an average 5% gradient, it is not possible to obtain gravity drainage back to the street. Because of this, a pond is proposed to contain 100% of the 100-year developed runoff and to drain that pond with a submersible pump. The forced main discharge from the pond will discharge into Juan Tabo Boulevard N.E. Waterproofing of the adjacent walls will be necessary to allow for ponding within 15' of the structures.

The Calculations which appear hereon analyze both the existing and developed conditions for the 100-year, 6-hour rainfall event. The Procedure for 40-acre and Smaller Basins, as set forth in the Revision of Section 22.2, Hydrology of the Development Process Manual, Volume 2, Design Criteria, dated January, 1993, has been used to quantify the peak rate of discharge and volume of runoff generated. As shown by these calculations, an increase in runoff is generated. The maximum depth of the pond will be approximately 6', thereby requiring fencing of the pond area. The required volume was not calculated using the hydrograph method from the new hydrology criteria, in the event that the submersible pump malfunctions. Therefore, the  $V_{100}$  for the site was used so as to determine the volume of the pond. In order to provide erosion control for the pond, this area will be sodded.

**Calculations****Site Characteristics**

- Precipitation Zone = 4
- $P_{100} = P_{360} = 2.90$  in.
- Total Area ( $A_T$ ) = 1.05 acres
- Existing Land Treatment

Treatment	Area (sf/ac)	%
A	40,950 / 0.94	89.5
B	4,790 / 0.11	10.5

**Developed Land Treatment**

Treatment	Area (sf/ac)	%
B	9,900 / 0.23	21.6
D	35,840 / 0.82	78.4

**Existing Condition****1. Volume**

$$E_w = (E_{PA} + E_{PA} + E_{PA} + E_{PA}) / A_T$$

$$E_w = [(0.80)(0.94) + (1.08)(0.11)] / 1.05 = 0.83 \text{ in.}$$

$$V_{100} = (E_w / 12) A_T$$

$$V_{100} = (0.83 / 12) (1.05) = 0.0726 \text{ ac. ft.}; 3,170 \text{ cf}$$

**2. Peak Discharge**

$$Q_p = Q_{PA} A_A + Q_{PA} A_B + Q_{PA} A_C + Q_{PA} A_D$$

$$Q_p = Q_{100} = (2.20)(0.94) + (2.92)(0.11) = 2.4 \text{ cfs}$$

**Developed Condition****1. Volume**

$$E_w = (E_{PA} + E_{PA} + E_{PA} + E_{PA}) / A_T$$

$$E_w = [(1.08)(0.23) + (2.64)(0.82)] / 1.05 = 2.30 \text{ in.}$$

$$V_{100} = (E_w / 12) A_T$$

$$V_{100} = (2.30 / 12) (1.05) = 0.2011 \text{ ac. ft.}; 8,760 \text{ cf}$$

**2. Peak Discharge**


$$Q_p = Q_{PA} A_A + Q_{PA} A_B + Q_{PA} A_C + Q_{PA} A_D$$

$$Q_p = Q_{100} = (2.92)(0.23) + (5.25)(0.82) = 5.0 \text{ cfs}$$

**Comparison**

- $\Delta V_{100} = 8,760 - 3,170 = 5,590 \text{ cf (increase)}$
- $\Delta Q_{100} = 5.0 - 2.4 = 2.6 \text{ cfs (increase)}$

APPROVALS	NAME	DATE
ACE / DESIGN		
INSPECTOR		
ACE / FIELD		

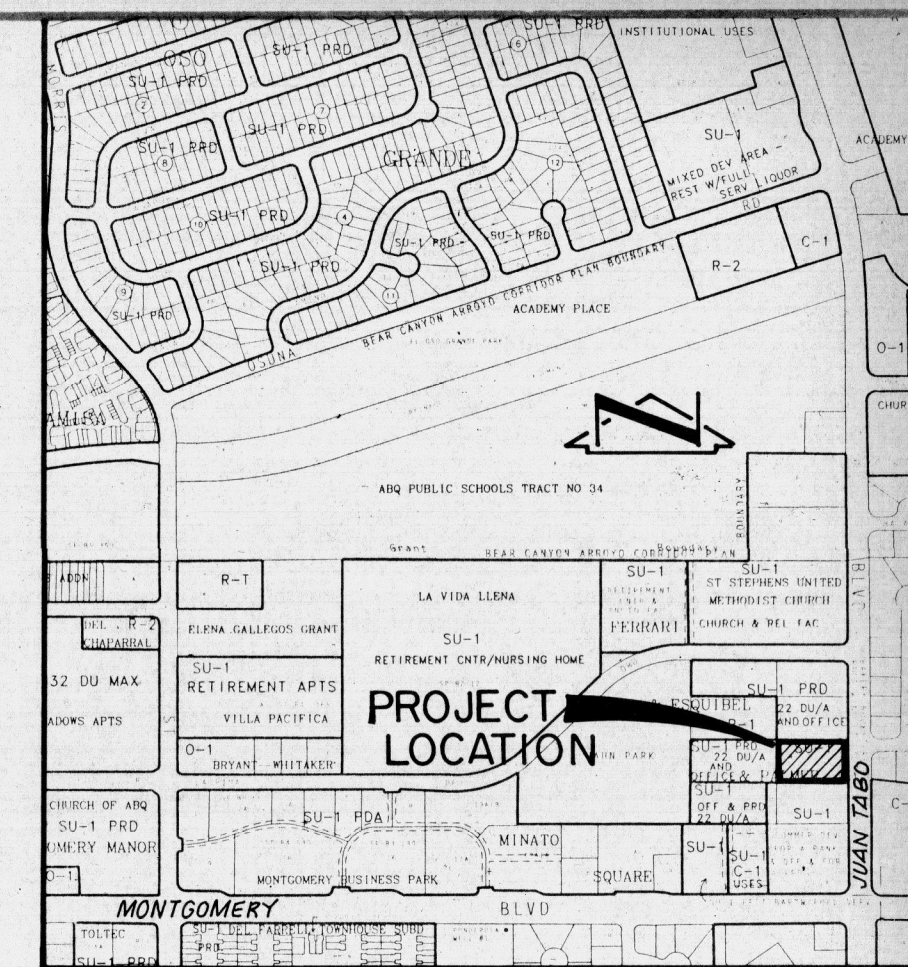**VICINITY MAP**

SCALE: 1" = 750' (APPROX)

F-21

**POND VOLUME** (Calculated by the Average End Area Method)

Elev (ft)	Area (ft <sup>2</sup> )	Vol (cf)	E Vol (cf)
10	0		
11	368	184	184
12	550	459	643
13	781	665.5	1,308.5
14	1,015	898	2,206.5
15	1,440	1,227.5	3,434
16	1,823	1,631.5	5,065.5
17	2,167	1,995	7,060.5
18	2,493	2,330	9,390.5
19	2,825	2,659	12,049.5

W.S.L. between 17 & 18  
By interpolation 17.75 area of 2411.5 sf  
Vol = [(2167 + 2411.5) / 2] (0.7) = 1716.94 cf  
EVol = 7,060.5 + 1716.94 = 8,777.43 cf  
W.S.L. approximately 17.75

**Construction Notes:**

- Two (2) working days prior to any excavation, contractor must contact New Mexico One Call System 260-1990, for location of existing utilities.
- Prior to construction, the contractor shall excavate and verify the horizontal and vertical location of all potential obstructions. Should a conflict exist, the contractor shall notify the engineer in writing so that the conflict can be resolved with a minimum amount of delay.
- All work on this project shall be performed in accordance with applicable federal, state and local laws, rules and regulations concerning construction safety and health.
- All construction within public right-of-way shall be performed in accordance with applicable City of Albuquerque Standards and Procedures.
- If any utility lines, pipelines, or underground utility lines are shown on these drawings, they are shown in an approximate manner only, and such lines may exist where none are shown. If any such existing lines are shown, the location is based upon information provided by the owner of said utility, and the information may be incomplete, or may be obsolete by the time construction commences. The engineer has conducted only preliminary investigation of the location, depth, size, or type of existing utility lines, pipelines, or underground utility lines. This investigation is not conclusive, and may not be complete, therefore, makes no representation pertaining thereto, and assumes no responsibility or liability therefor. The contractor shall inform itself of the location of any utility line, pipeline, or underground utility line in or near the area of the work in advance of and during excavation work. The contractor is fully responsible for any and all damage caused by its failure to locate, identify and preserve any and all existing utilities, pipelines, and underground utility lines. In planning and conducting excavation, the contractor shall comply with state statutes, municipal and local ordinances, rules and regulations, if any, pertaining to the location of these lines and facilities.
- The design of planters and landscaped areas is not part of this plan. All planters and landscaped areas adjacent to the building(s) shall be provided with positive drainage to avoid any ponding adjacent to the structure. For construction details, refer to landscaping plan.
- An Excavation/Construction Permit will be required before beginning any work within City right-of-way. An approved copy of these plans must be submitted at the time of application for this permit.
- Backfill compaction shall be according to ARTERIAL street use.
- Maintenance of these facilities shall be the responsibility of the owner of the property served.

JAN 30 1995

HYDROLOGICAL DIVISION

921222

DATE

12-1993

SHEET

1 OF 2



JEFF MORTENSEN & ASSOCIATES, INC.  
6010-B MIDWAY PARK BLVD. N.E.  
ALBUQUERQUE, NEW MEXICO 87109  
ENGINEERS & SURVEYORS (505)345-4250

**GRADING AND DRAINAGE PLAN****DOUBLE RAINBOW BAKERY & CAFE**

## LEGAL DESCRIPTION:

LOT 11 OF UNPLATTED LANDS KNOWN AS  
"160 ACRE MASTER PLAN".

## BENCHMARK:

A STANDARD N.H.S.C. BRASS TABLET STAMPED  
"J-1A", SET IN THE TOP OF A CONCRETE POST  
FLUSH WITH THE GROUND LOCATED IN THE  
SOUTHERLY MEDIAN ON JUAN TABO BLVD. N.E.  
A MONTGOMERY BLVD. N.E.  
ELEVATION = 5721.25 FEET (M.S.L.D.)

## AS-BUILT LEGEND

TW 19.41 AS-BUILT TOP-OF-  
WALL ELEVATION  
GRND 14.2 AS-BUILT GROUND  
SHOT  
24.45 AS-BUILT 3PT  
ELEVATION  
24.00

## LEGEND:

EXISTING SPOT ELEVATION	LIGHT FIXTURE
PROPOSED SPOT ELEVATION	EXIST. LIGHT POLE
EXISTING CONTOUR	EXISTING RETAINING WALL
PROPOSED CONTOUR	PROPOSED CONCRETE GARDEN WALL
EXISTING FLOWLINE	PROPERTY LINE
PROPOSED FLOWLINE	EASEMENT LINE
PROPOSED DIRECTION OF RUNOFF	CENTERLINE
PROPOSED ROOF DRAINAGE	PROPOSED RETAINING WALL
PROPOSED ASPHALT	HIGH POINT
PROPOSED CONCRETE	FUTURE PROPOSED CONTOUR
TC TOP OF CURB	TW TOP OF WALL ELEVATION
FL FLOWLINE	PROPOSED CHAIN LINK FENCE
FF FINISHED FLOOR ELEVATION	
EXISTING FIRE HYDRANT	

## RECERTIFICATION

As indicated by the as-built information shown hereon, collected by Bernard W. Sietz, Jr., N.M.P.S. 8478, the Double Rainbow Bakery and Cafe detention pond has not been constructed in conformance with the approved Grading and Drainage Plan. The pond has been regraded, however, to conform with the intent of the approved plan. The water surface elevation has been raised from 5717.75 to 5718.88. The setback from the building is 18 feet. The required pond volume has been provided at a safe distance from the new building. Based upon these modifications, issuance of a Permanent Certificate of Occupancy is hereby recommended.

Jeffrey G. Mortensen, N.M.P.S. 8547 Date 02-18-95

## DRAINAGE PLAN

The following items concerning the Double Rainbow Drainage Plan are contained hereon:

1. Vicinity Map
2. Grading Plan
3. Calculations
4. Pump Details & Calculations

As shown by the Vicinity Map, the site is located on the west side of Juan Tabo Boulevard N.E. between Montgomery Boulevard N.E. and Lagrima de Oro N.E. At present, the site is undeveloped. Much of the surrounding area is developed, making this an infill site.

As shown by Panel 18 of 50 of the National Flood Insurance Program Flood Insurance Rate Maps for the City of Albuquerque, New Mexico, dated October 14, 1983, this site does not lie within a designated flood hazard zone. Further review of this mapping does not reveal downstream flooding to which this site contributes. At present, the site slopes from east to west onto adjacent undeveloped property. The site is situated down slope from Juan Tabo Boulevard N.E., which is a developed city street.

The Grading Plan shows 1) existing grades indicated by contours at 1'0" intervals, 2) proposed grades indicated by spot elevations and contours at 1'0" intervals, 3) the limit and character of the existing improvements, 4) the limit and character of the proposed improvements, and 5) continuity between existing and proposed grades. As shown this plan, the proposed improvements consist of the construction of a building along with adjacent paving and landscaping. Due to the fact that the site slopes away from Juan Tabo Boulevard N.E. at an average 5% gradient, it is not possible to obtain gravity drainage back to the street. Because of this, a pond is proposed to contain 100% of the 100-year developed runoff and to drain that pond with a submersible pump. The forced main discharge from the pond will discharge into Juan Tabo Boulevard N.E. Waterproofing of the adjacent walls will be necessary to allow for ponding within 15' of the structures.

The Calculations which appear hereon analyze both the existing and developed conditions for the 100-year, 6-hour rainfall event. The Procedure for 40-acre and Smaller Basins, as set forth in the Revision of Section 22.2, Hydrology of the Development Process Manual, Volume 2, Design Criteria, dated January, 1993, has been used to quantify the peak rate of discharge and volume of runoff generated. As shown by these calculations, an increase in runoff is generated. The maximum depth of the pond will be approximately 6', thereby requiring fencing of the pond area. The required volume was not calculated using the hydrograph method from the new hydrology criteria, in the event that the submersible pump malfunctions. Therefore, the  $V_{100}$  for the site was used so as to determine the volume of the pond. In order to provide erosion control for the pond, this area will be sodded.

## CALCULATIONS

## Site Characteristics

1. Precipitation Zone = 4
2.  $P_{6,100} = P_{360} = 2.90$  in.
3. Total Area ( $A_T$ ) = 1.05 acres
4. Existing Land Treatment

Treatment	Area (sf/ac)	%
A	40,950 / 0.94	89.5
B	4,790 / 0.11	10.5

## Developed Land Treatment

Treatment	Area (sf/ac)	%
B	9,900 / 0.23	21.6
D	35,840 / 0.82	78.4

## Existing Condition

## 1. Volume

$$E_H = (E_A A_A + E_B A_B + E_C A_C + E_D A_D) / A_T$$

$$E_H = [(0.80)(0.94) + (1.08)(0.11)] / 1.05 = 0.83 \text{ in.}$$

$$V_{100} = (E_H / 12) A_T$$

$$V_{100} = (0.83 / 12) 1.05 = 0.0726 \text{ ac. ft.}; 3,170 \text{ cf}$$

## 2. Peak Discharge

$$Q_P = Q_{PA} A_A + Q_{PB} A_B + Q_{PC} A_C + Q_{PD} A_D$$

$$Q_P = Q_{100} = (2.20)(0.94) + (2.92)(0.11) = 2.4 \text{ cfs}$$

## Developed Condition

## 1. Volume

$$E_H = (E_A A_A + E_B A_B + E_C A_C + E_D A_D) / A_T$$

$$E_H = [(1.08)(0.23) + (2.64)(0.82)] / 1.05 = 2.30 \text{ in.}$$

$$V_{100} = (E_H / 12) A_T$$

$$V_{100} = (2.30 / 12) 1.05 = 0.2011 \text{ ac. ft.}; 8,760 \text{ cf}$$

## 2. Peak Discharge



$$Q_P = Q_{PA} A_A + Q_{PB} A_B + Q_{PC} A_C + Q_{PD} A_D$$

$$Q_P = Q_{100} = (2.92)(0.23) + (5.25)(0.82) = 5.0 \text{ cfs}$$

## Comparison

1.  $\Delta V_{100} = 8,760 - 3,170 = 5,590 \text{ cf (increase)}$
2.  $\Delta Q_{100} = 5.0 - 2.4 = 2.6 \text{ cfs (increase)}$

APPROVALS	NAME	DATE
A.C.E. / DESIGN		
INSPECTOR		
A.C.E. / FIELD		

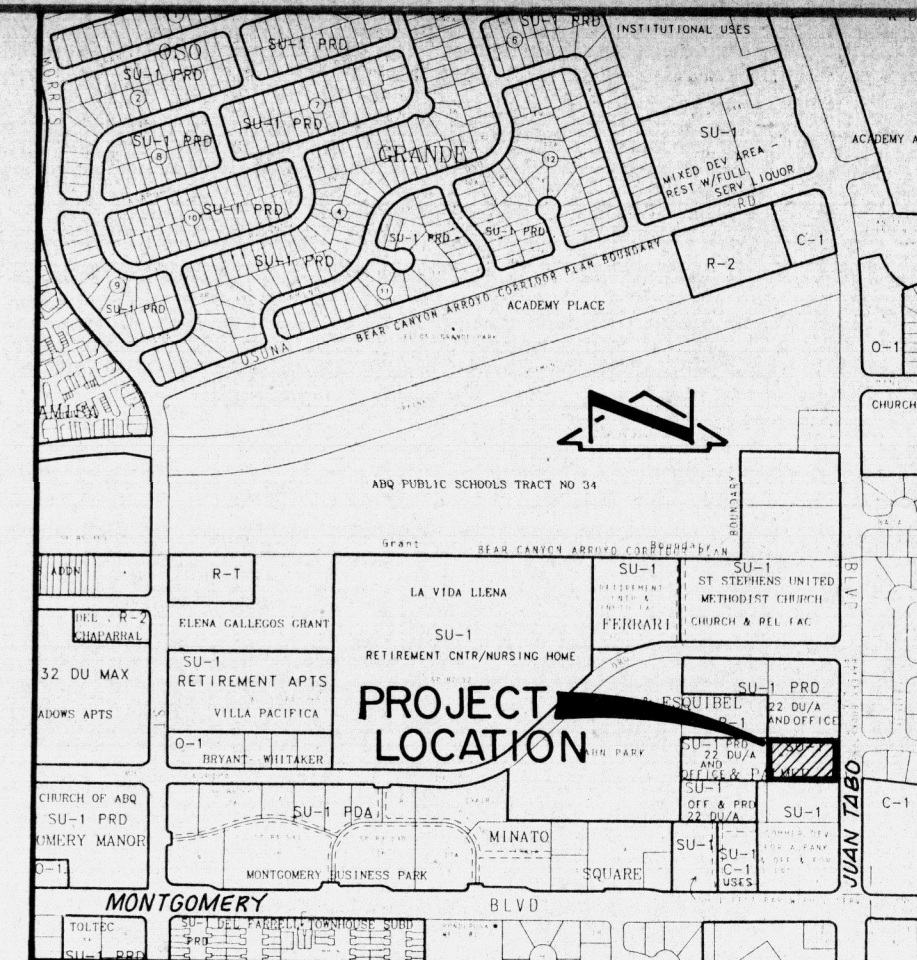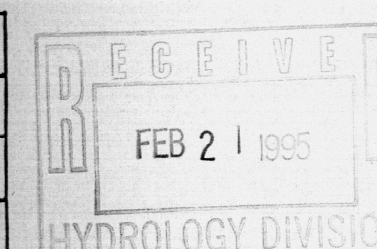

## VICINITY MAP

SCALE: 1" = 750' (APPROX.)

F-21

## POND VOLUME (Calculated by the Average End Area Method)

Elev (ft)	Area (ft <sup>2</sup> )	Vol (cf)	Σ Vol (cf)
10.4	0	39.0 184	164 39.0
11	368 130	560 275	2025 459
12	560 275	761 585	480 665.5
13	761 585	1,015 940	7625 090
14	1,015 940	1,440 1160	1050 1,227.5
15	1,440 1160	1,823 1397	1278 1,631.5
16	1,823 1397	2,167 1639	1518 1,995
17	2,167 1639	2,493 1876	17515 2,330
18	2,493 1876	2,825 2083	19795 2,659
19			12,049.5 90175

W.S.L. between 17 & 18 18.88

By interpolation 47.75 area of 2411.5 sf


Vol = [(2167 + 2411.5) / 2] 0.7 = 1716.94 cf

Σ Vol = 7,060.5 + 1716.94 = 8,777.43 cf

W.S.L. approximately 17.75-18.88

## Construction Notes:

1. Two (2) working days prior to any excavation, contractor must contact New Mexico One Call System 260-1990, for location of existing utilities.
2. Prior to construction, the contractor shall excavate and verify the horizontal and vertical location of all potential obstructions. Should a conflict exist, the contractor shall notify the engineer in writing so that the conflict can be resolved with a minimum amount of delay.
3. All work on this project shall be performed in accordance with applicable federal, state and local laws, rules and regulations concerning construction safety and health.
4. All construction within public right-of-way shall be performed in accordance with applicable City of Albuquerque Standards and Procedures.
5. If any utility lines, pipelines, or underground utility lines are shown on these drawings, they are shown in an approximate manner only, and such lines may exist where none are shown. If any such existing lines are shown, the location is based upon information provided by the owner of said utility, and the information may be incomplete, or may be obsolete by the time construction commences. The engineer has conducted only preliminary investigation of the location, depth, size, or type of existing utility lines, pipelines, or underground utility lines. This investigation is not conclusive, and may not be complete, therefore, makes no representation pertaining thereto, and assumes no responsibility or liability therefor. The contractor shall inform itself of the location of any utility line, pipeline, or underground utility line in or near the area of the work in advance of and during excavation work. The contractor is fully responsible for any and all damage caused by its failure to locate, identify and preserve any and all existing utilities, pipelines, and underground utility lines. In planning and conducting excavation, the contractor shall comply with state statutes, municipal and local ordinances, rules and regulations, if any, pertaining to the location of these lines and facilities.
6. The design of planters and landscaped areas is not part of this plan. All planters and landscaped areas adjacent to the building(s) shall be provided with positive drainage to avoid any ponding adjacent to the structure. For construction details, refer to landscaping plan.
7. An Excavation/Construction Permit will be required before beginning any work within City right-of-way. An approved copy of these plans must be submitted at the time of application for this permit.
8. Backfill compaction shall be according to ARTERIAL street use.
9. Maintenance of these facilities shall be the responsibility of the owner of the property served.

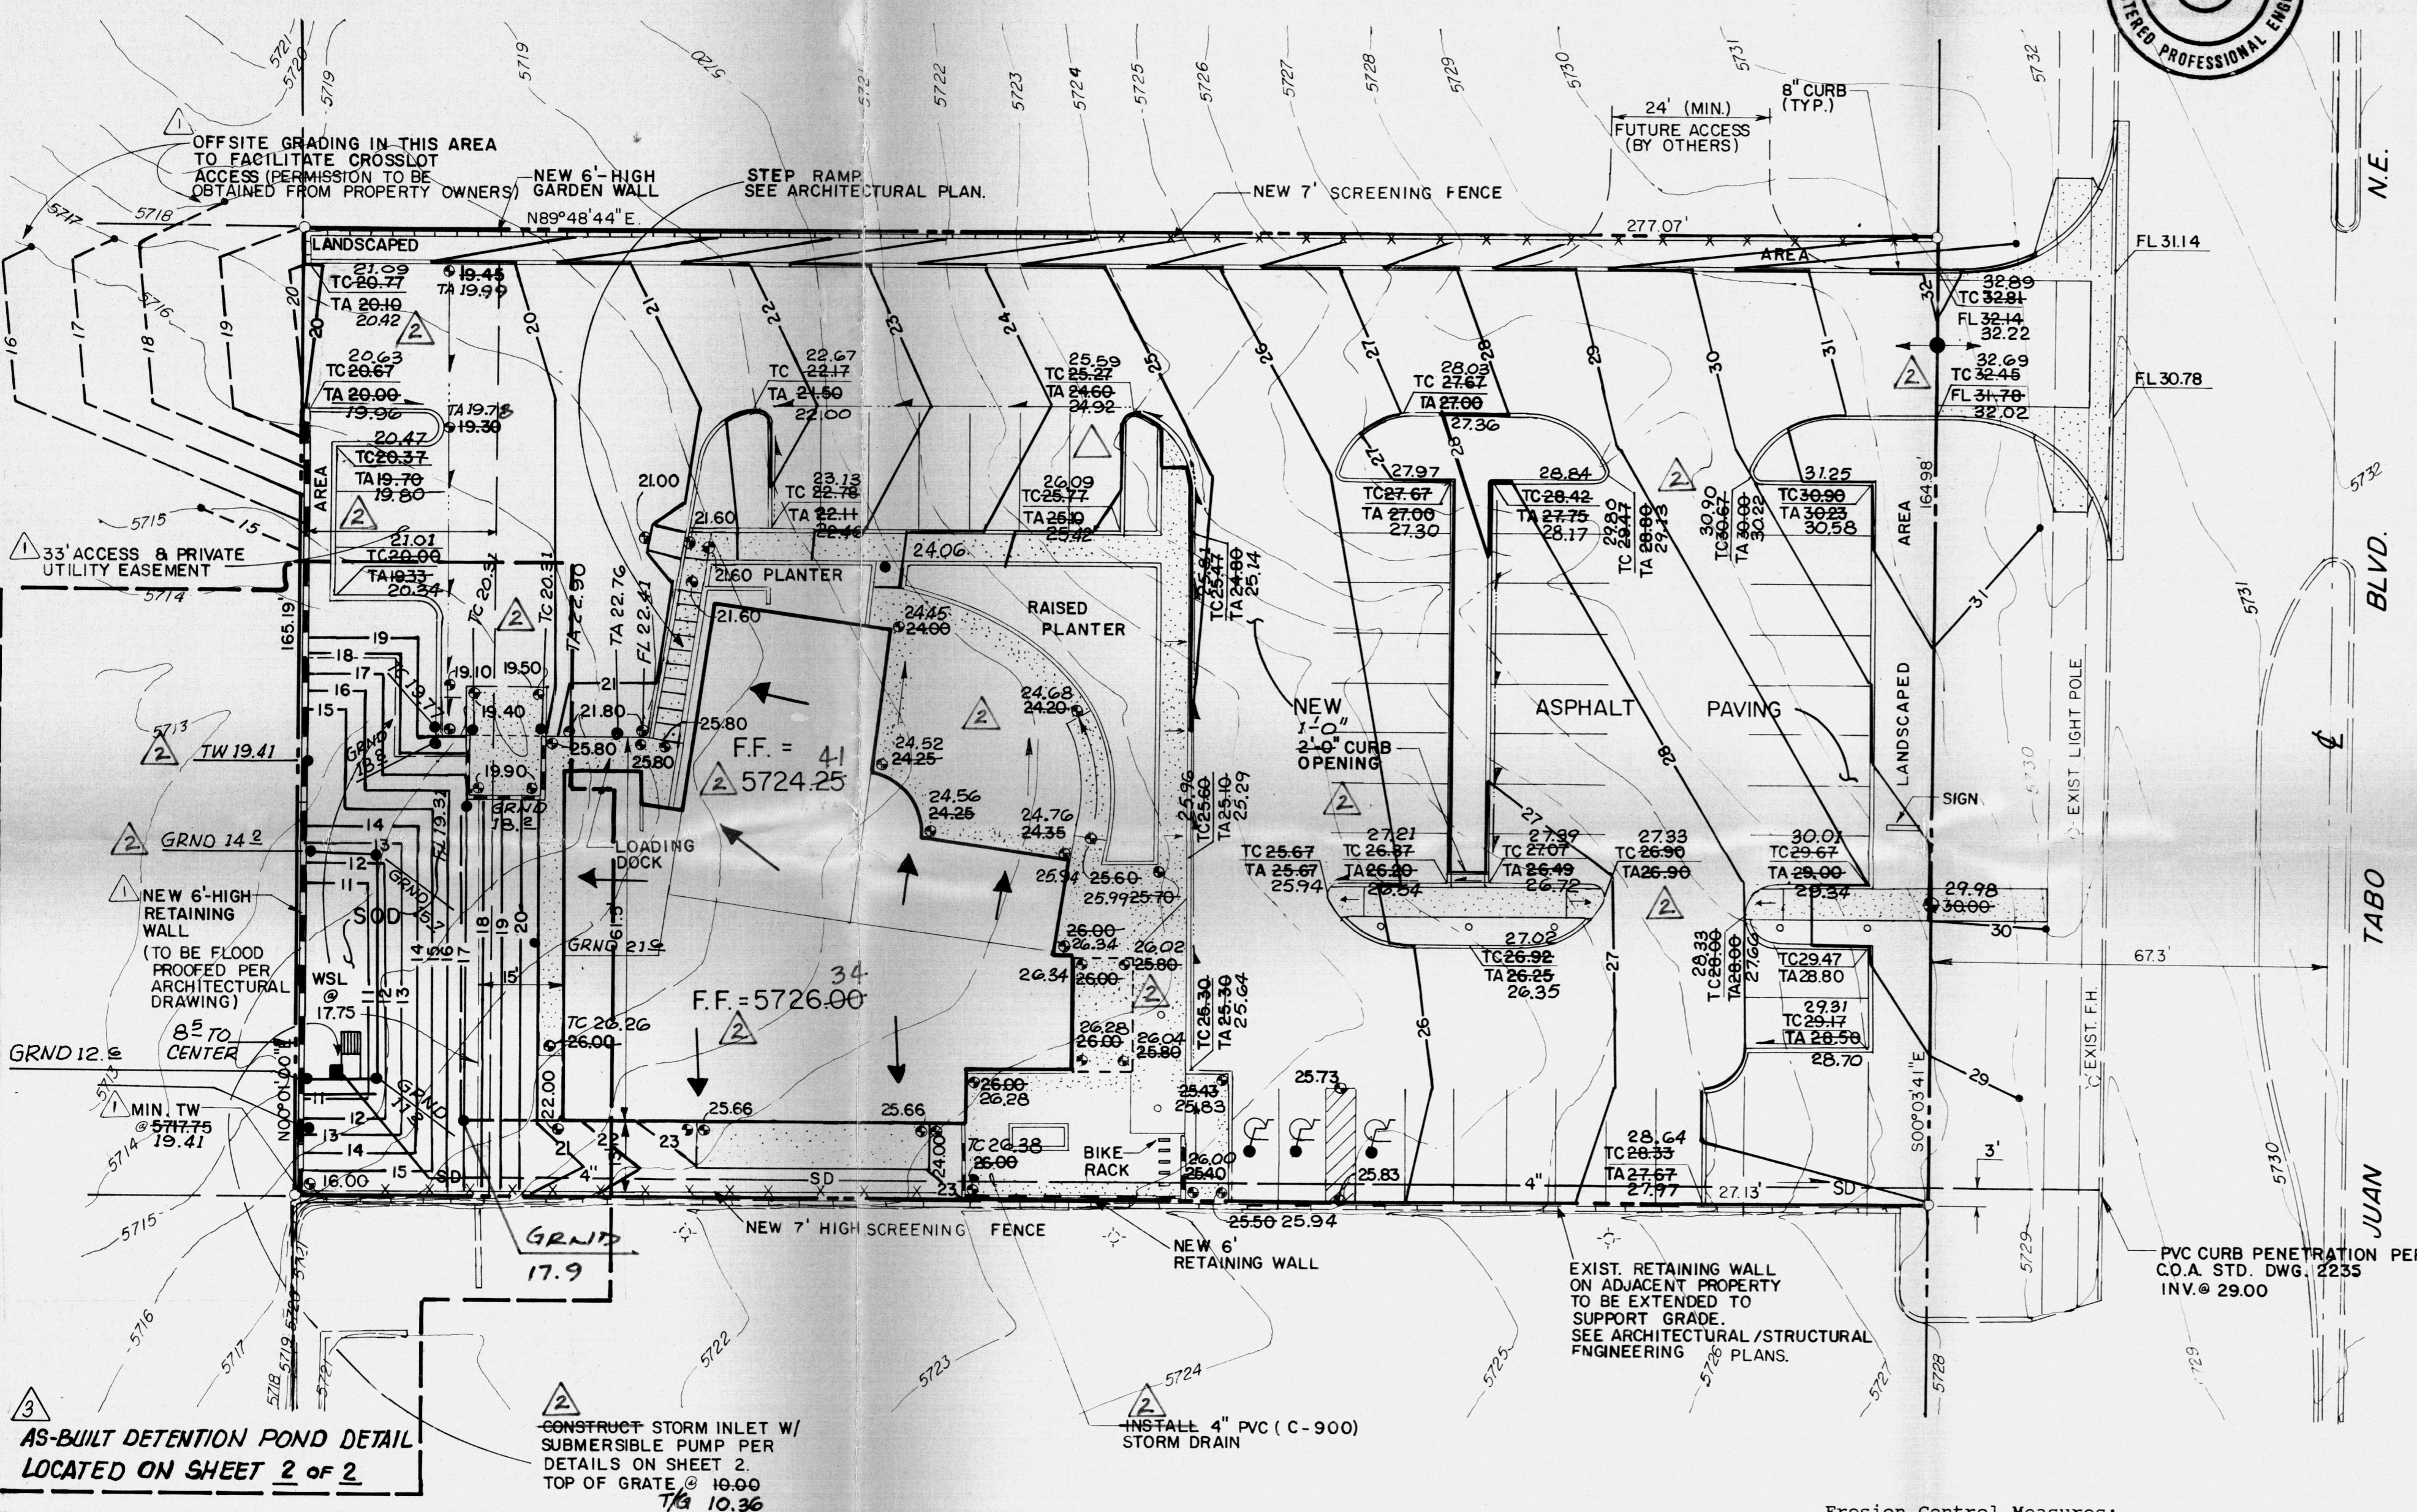

As indicated by the as-built information shown hereon, the Double Rainbow Bakery and Cafe has not been constructed in substantial conformance with the approved Grading and Drainage Plan. The as-built information shown hereon has been collected by Bernard W. Sietz, Jr., N.M.P.S. 8478. Close review of the as-built elevations indicates that the majority of the elevations are higher than designed. The average deviation is 0.3 vertical feet. For the most part, this does not present a problem in satisfying the intent of the approved plan. Consequently, the failure of the Contractor to follow the design grades within a closer tolerance will not adversely impact the ability of the parking lot and other paved surfaces to drain in accordance with the approved plan. The detention pond, on the other hand, has been constructed considerably higher than the approved plan even when the 0.3 feet difference is taken into consideration. Because of this, the required pond volume has not been provided at a safe distance from the new building. The top of the retaining wall at the west side of the project has been constructed taller than the minimum elevations specified on the approved plan. Whereby sufficient volume will hence be provided, the ponding limits will be shifted closer than 15 feet to the new building. Until such time as 1) the pond is regraded to conform with the intent of the approved plan, or 2) a certification from the geotechnical engineer that ponding closer than 15 feet will not create an adverse impact on the structure, the Permanent Certificate of Occupancy should be withheld. At this time, the engineer is prepared to recommend issuance of a Temporary Certificate of Occupancy.

## CERTIFICATION

As indicated by the as-built information shown hereon, the Double Rainbow Bakery and Cafe has not been constructed in substantial conformance with the approved Grading and Drainage Plan. The as-built information shown hereon has been collected by Bernard W. Sietz, Jr., N.M.P.S. 8478. Close review of the as-built elevations indicates that the majority of the elevations are higher than designed. The average deviation is 0.3 vertical feet. For the most part, this does not present a problem in satisfying the intent of the approved plan. Consequently, the failure of the Contractor to follow the design grades within a closer tolerance will not adversely impact the ability of the parking lot and other paved surfaces to drain in accordance with the approved plan. The detention pond, on the other hand, has been constructed considerably higher than the approved plan even when the 0.3 feet difference is taken into consideration. Because of this, the required pond volume has not been provided at a safe distance from the new building. The top of the retaining wall at the west side of the project has been constructed taller than the minimum elevations specified on the approved plan. Whereby sufficient volume will hence be provided, the ponding limits will be shifted closer than 15 feet to the new building. Until such time as 1) the pond is regraded to conform with the intent of the approved plan, or 2) a certification from the geotechnical engineer that ponding closer than 15 feet will not create an adverse impact on the structure, the Permanent Certificate of Occupancy should be withheld. At this time, the engineer is prepared to recommend issuance of a Temporary Certificate of Occupancy.




JEFF MORTENSEN & ASSOCIATES, INC.  
6010-B MIDWAY PARK BLVD. N.E.  
ALBUQUERQUE, NEW MEXICO 87109  
ENGINEERS & SURVEYORS (505)345-4250

## GRADING AND DRAINAGE PLAN


## DOUBLE RAINBOW BAKERY &amp; CAFE

DESIGNED BY	M.F.D.	DATE	5/94	M.F.D.	REVISE DRAINAGE PLAN, SHOW EASEMENT, FLOOD PROOFING	921122
DRAWN BY	T.P.H.	DATE	01/95	J.M.	AS-BUILT & CERTIFY	12-1993
APPROVED BY	J.G.M.	DATE	2/95	S.C.K.	AS-BUILT AND RECERTIFY	
						1 OF 2

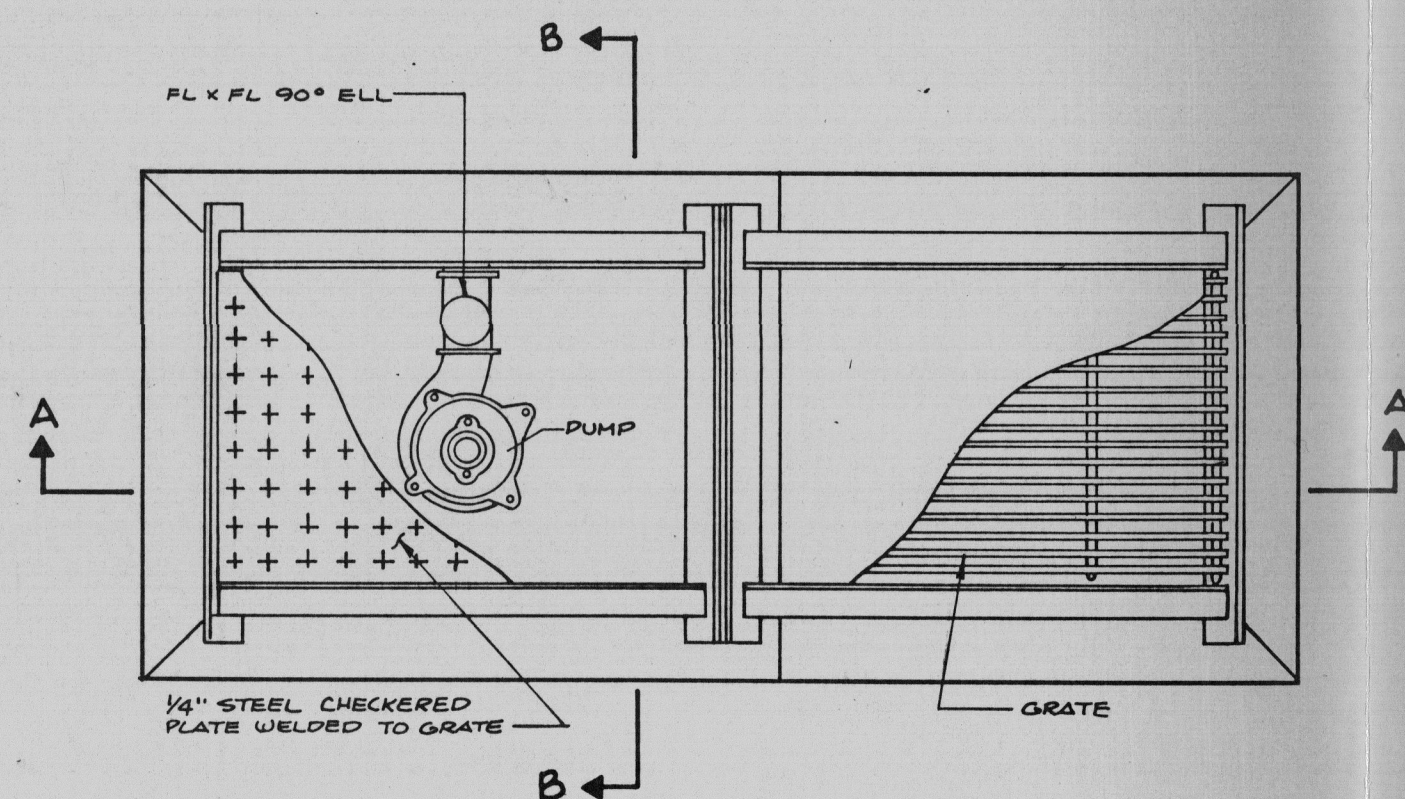


SUMP PIT AND INLET PLAN

SCALE: 3/4" = 1'-0"

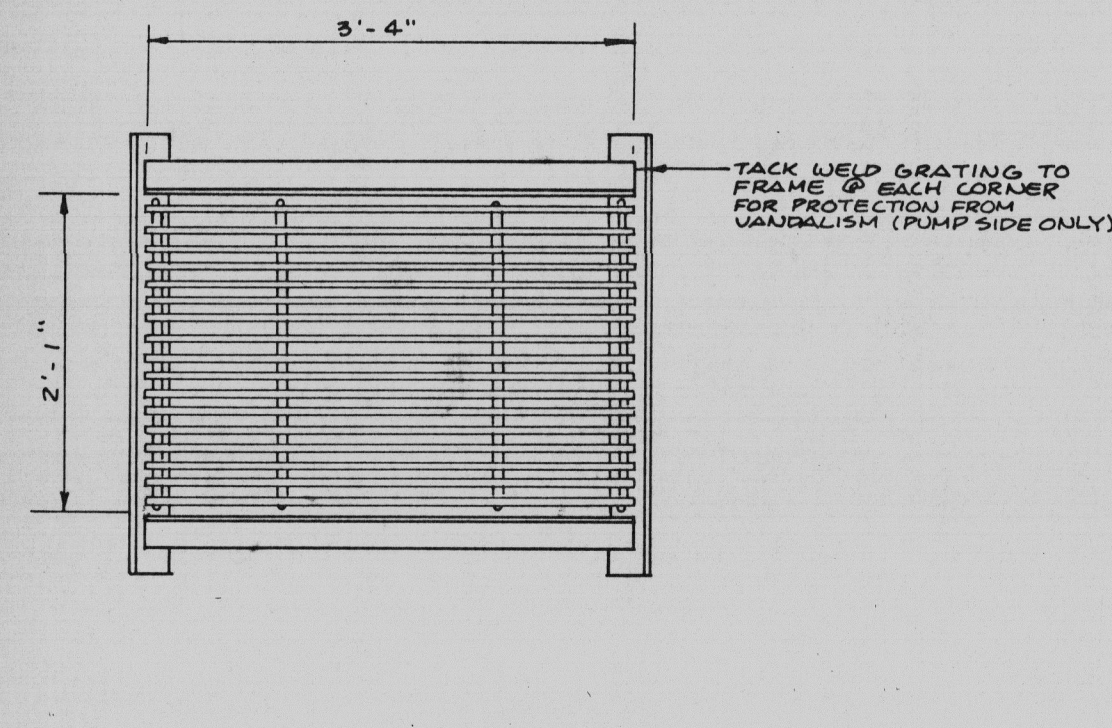


TYPICAL INLET GRATE PLAN

SCALE: 3/4" = 1'-0"

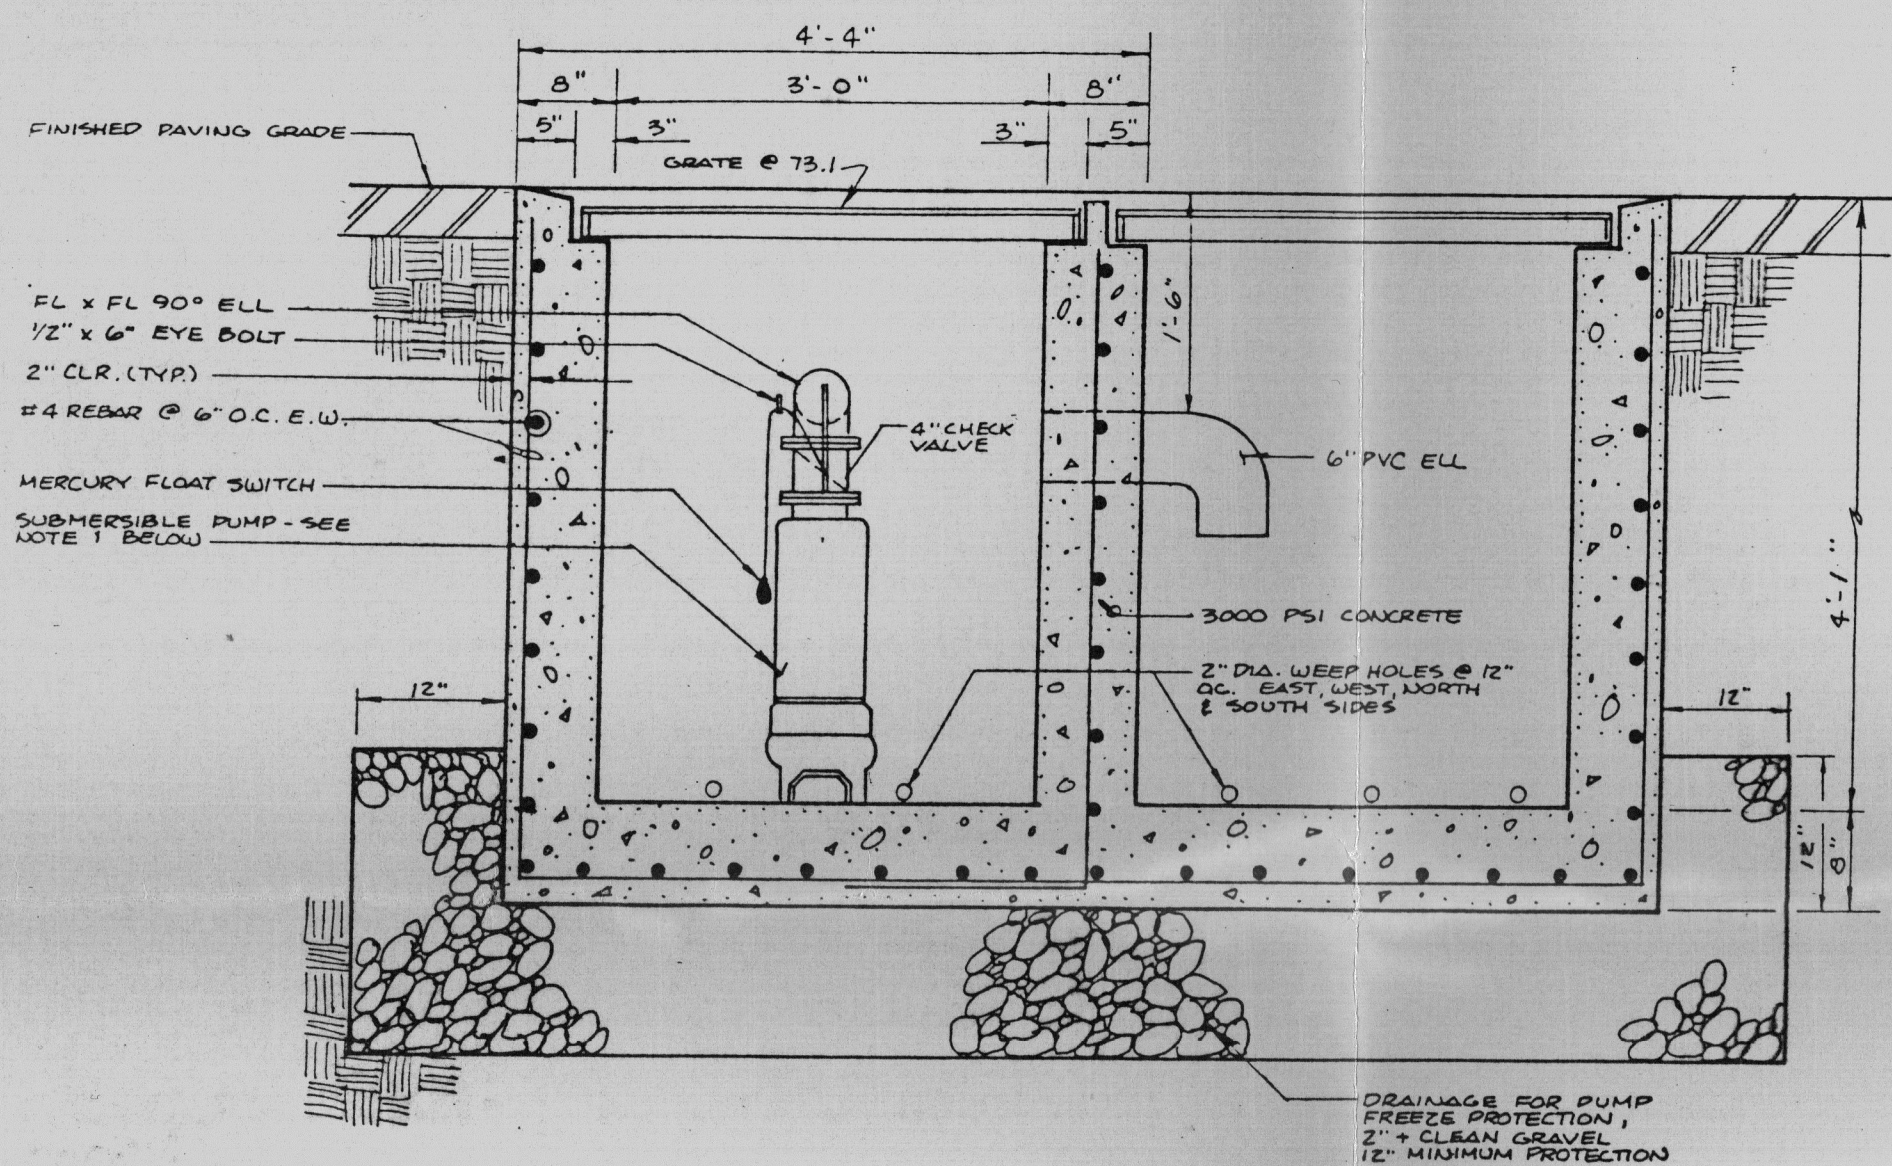

SECTION A-A

SCALE: 3/4" = 1'-0"

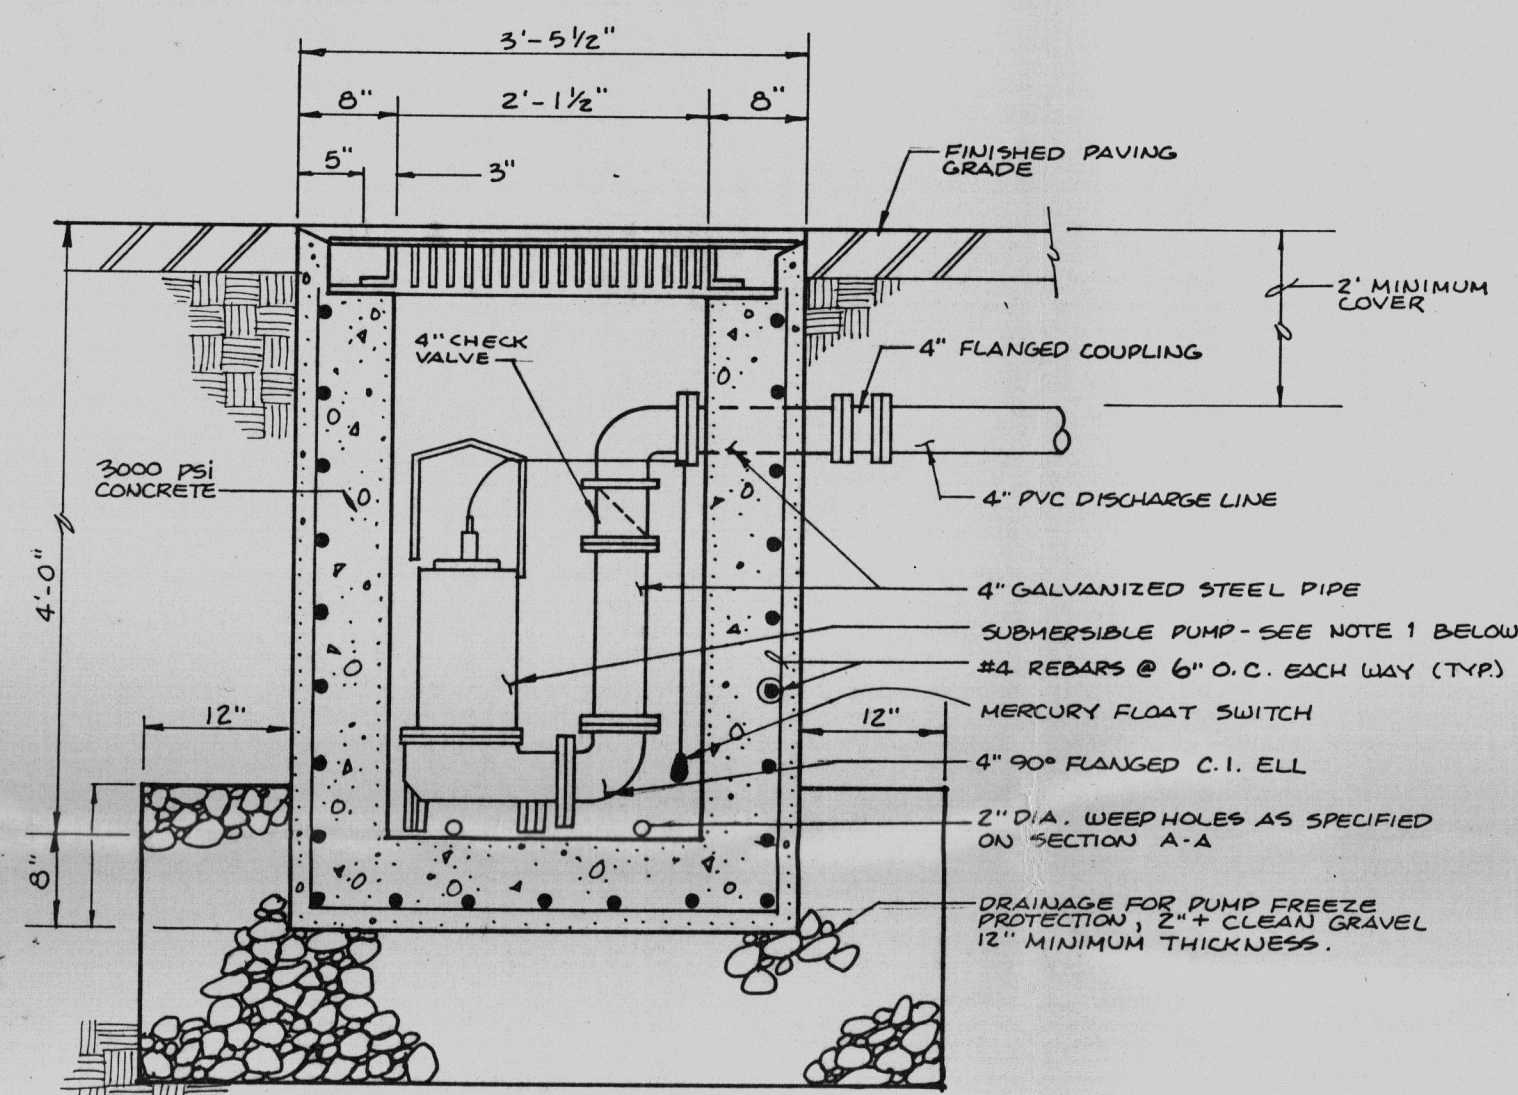


SECTION B-B

SCALE: 3/4" = 1'-0"

## 3 RECERTIFICATION

As indicated by the as-built information shown hereon, collected by Bernard W. Sietz, Jr., N.M.P.S. 8478, the Double Rainbow Bakery and Cafe detention pond has not been constructed in conformance with the approved Grading and Drainage Plan. The pond has been regraded, however, to conform with the intent of the approved plan. The water surface elevation has been raised from 5717.75 to 5718.88. The setback from the building is 18 feet. The required pond volume has been provided at a safe distance from the new building. Based upon these modifications, issuance of a Permanent Certificate of Occupancy is hereby recommended.

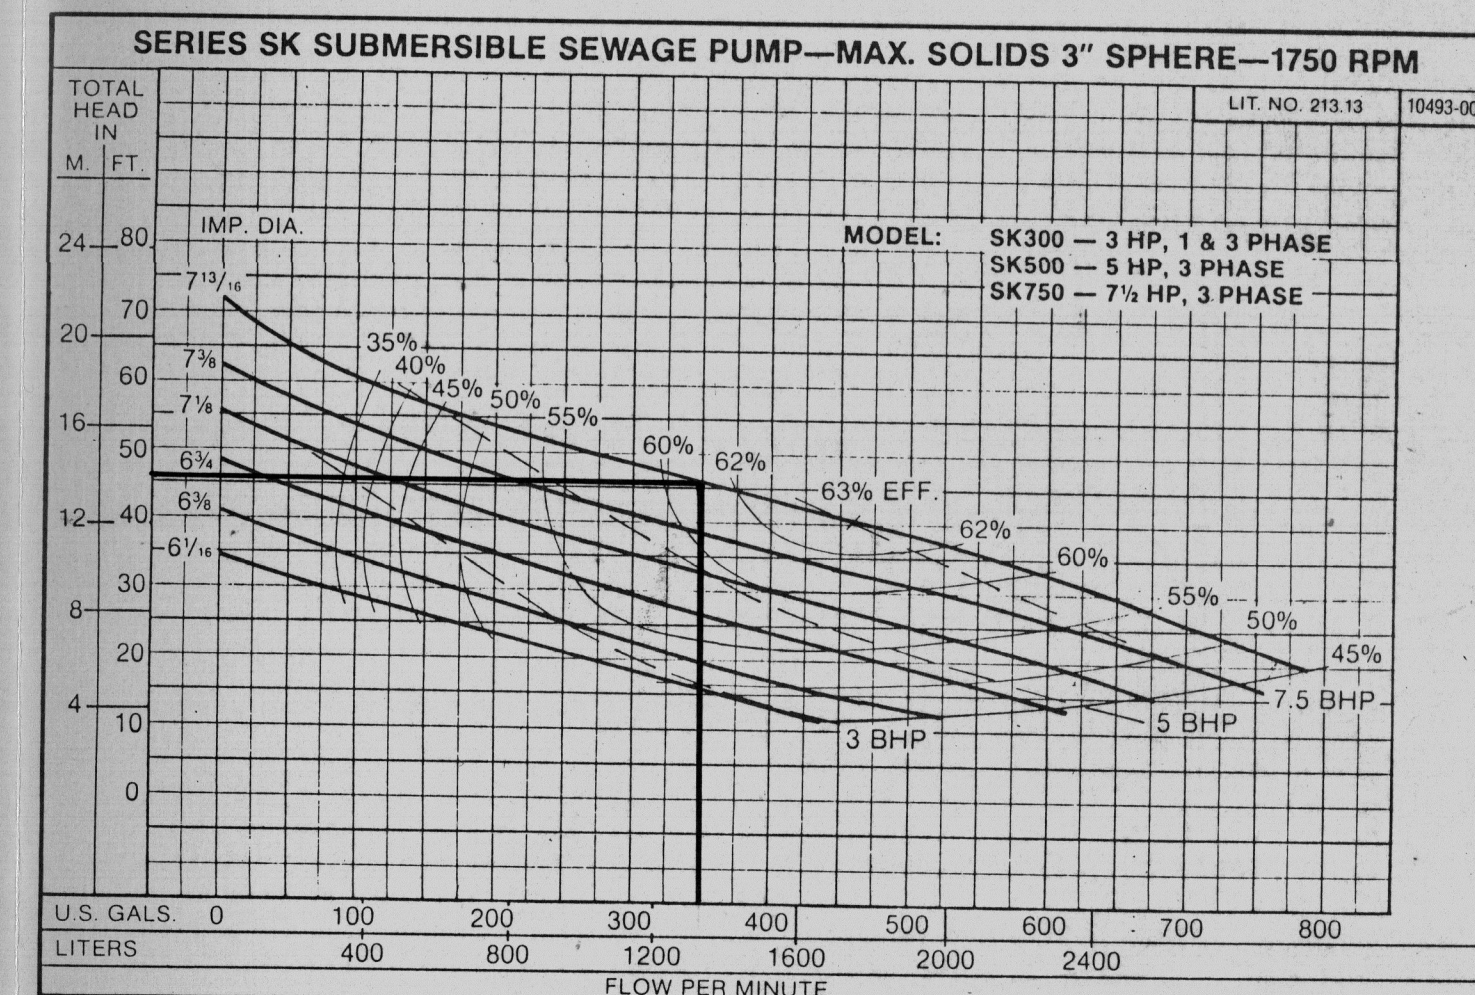SECTION 200  
DIMENSIONAL DRAWINGS  
& PERFORMANCE DATAHYDROMATIC  
PUMPS

## Pump Calculations

- Estimated Discharge Rate 350 GPM
- Head Loss
  - Elevation  $29' - 10' = 19'$
  - Friction (4" pipe)
    - Type of Pipe: PVC
    - Design C Value: 130
    - Chart C Value: 100
    - Correction Required = 0.62
    - $H_F = 0.2083 \times (100/C) \times 1.85 \times (Q^{1.85}/d^{4.8655})$
    - $H_F = 6.1 \text{ ft}/100 \text{ ft} \times (6.1/100) \times 305 = 18.61 \text{ ft}$
    - Length of Pipe = 305 ft
  - Friction (4" pipe)
    - Type of Pipe: Steel
    - Design C Value: 100
    - Chart C Value: 100
    - No Correction Required
    - $H_F = 24.12 \text{ ft}/100 \text{ ft}$
    - Length of Pipe = 8 ft
- Total
  - Equivalent Length of Pipe
  - 2 90° Ell @ 11 ft ea For 22 ft
  - 1 45° Ell @ 5 ft ea For 5 ft
  - $H_{F,S} = (8+22+5) \times (24.1/100) = 8.44 \text{ ft}$


$$H_T = H_2 + H_{F,P} + H_{F,S} = 19 + 18.61 + 8.44 = 46.05 \text{ ft}$$

$$Q = 350 \text{ GPM} (1 \text{ cf}/7.48 \text{ gallons}) (1 \text{ min}/60 \text{ sec}) = 0.8 \text{ cfs}$$

Reference: Cameron Hydraulic Data, 14th Edition Ingersoll-Rand Company, Woodcliff Lake, NM 1970, pp-27, 36 and 48.

## Notes:

- Install one HYDRO-O-MATIC submersible pumps, Model SK500, 7 1/2 HP motor, or approved equal. Pump installation shall include two mercury float switches with controls set for "OFF" and "ON" modes of operation.
- Refer to Electrical Plans for location of pump control box, installation of electrical cable/conduit and pump/control one-line diagrams.
- Grating and frame shall be cleaned of all scale, rust and foreign materials and shall be painted with one shop coat of red oxide primer, then 2 finish coats of aluminum paint (AASHO M69).
- Installation of the mercury float switches shall be at levels providing optimum pumping time without excessive pump cycling.

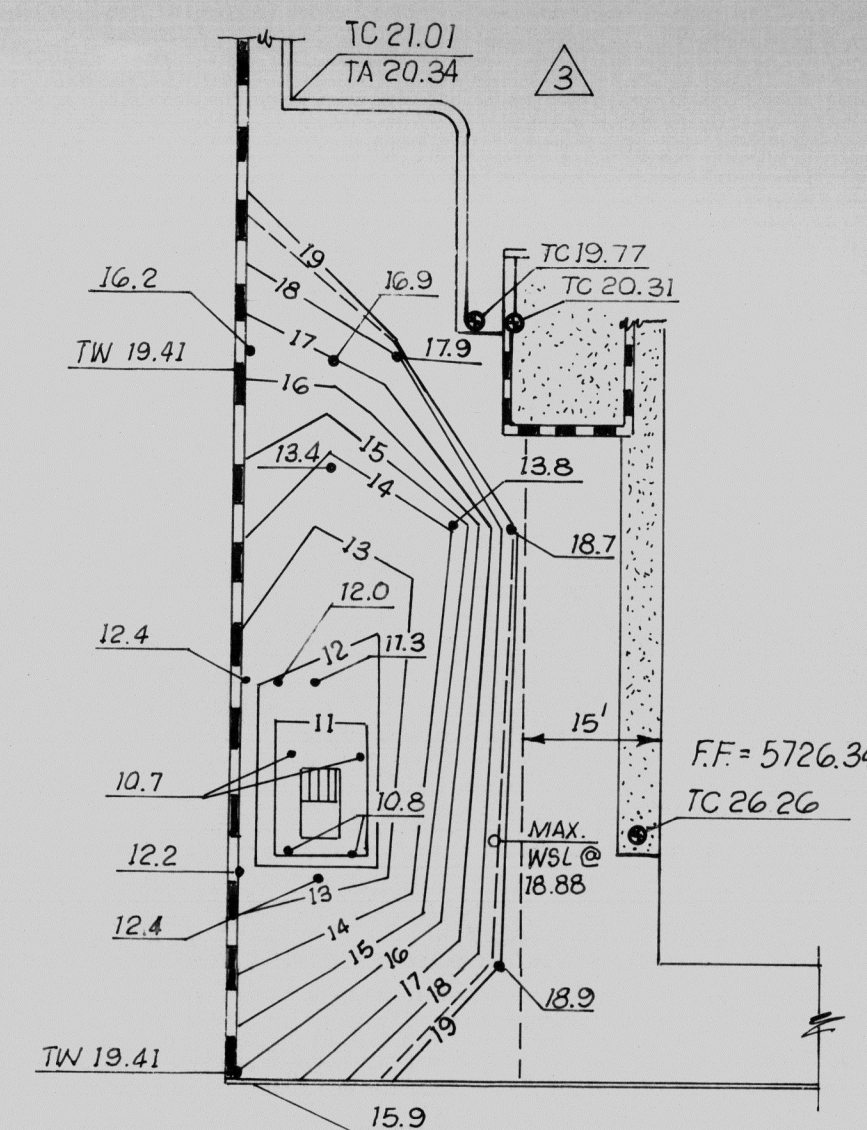

## AS-BUILT DETENTION POND DETAIL

SCALE: 1" = 20'

## LEGEND

- 16.9 AS-BUILT GROUND ELEVATIONS
- TC 19.85 AS-BUILT SPOT ELEVATIONS
- AS-BUILT CONTOURS
- AS-BUILT MAXIMUM WSL
- CONCRETE
- RETAINING WALL

RECORD DRAWING




JEFF MORTENSEN & ASSOCIATES, INC.  
6010-B MIDWAY PARK BLVD, N.E.  
ALBUQUERQUE, NEW MEXICO 87109  
ENGINEERS & SURVEYORS (505)345-4250

SUBMERSIBLE PUMP DETAILS &amp; SECTIONS

DOUBLE RAINBOW BAKERY &amp; CAFE

DESIGNED BY	DATE	BY	REVISIONS	JOB NO.
M.F.D.	1/27/95	J.M.	RECORD DRAWING	921122
DRAWN BY	2/95	SCK	AS-BUILT AND RECERTIFY	DATE
APPROVED BY		J.G.M.		12-1993
				SHEET
				2 OF 2

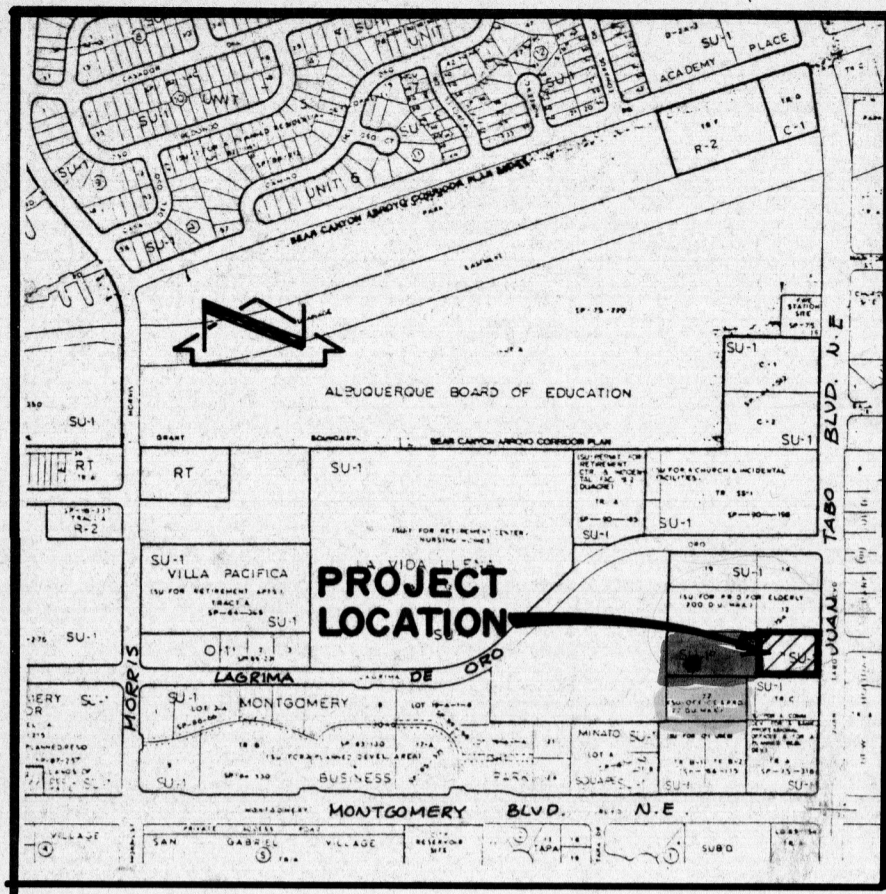

VICINITY MAP F-21  
SCALE: 1" = 800' (APPROX.)

### PROJECT BENCHMARK

A STANDARD NM5HC BRASS TABLET STAMPED, JT-1A, SET IN THE TOP OF A CONCRETE POST FLUSH WITH THE GROUND & LOCATED IN THE SOUTHERLY MEDIAN ON JUAN TABO BLVD. N.E. & MONTGOMERY BLVD. N.E.  
ELEVATION = 5721.25 FEET (M.S.L.D.)

### LEGEND

- 5725 EXIST. CONTOUR
- 5725 PROPOSED CONTOUR
- PROPOSED SPOT ELEVATION
- PROPOSED FLOWLINE
- PROPOSED DIRECTION OF RUNOFF
- PROPOSED CONCRETE
- PROPOSED ASPHALT
- TC TOP OF CURB
- FL FLOWLINE
- TW TOP OF WALL

### DRAINAGE PLAN

The following items concerning the Double Rainbow Drainage Plan are contained hereon:

- Vicinity Map
- Grading Plan
- Calculations

As shown by the Vicinity Map, the site is located on the west side of Juan Tabo Boulevard N.E. between Montgomery Boulevard N.E. and Lagrima de Oro N.E. At present, the site is undeveloped. Much of the surrounding area is developed, making this an infill site.

As shown by Panel 18 of 50 of the National Flood Insurance Program Flood Insurance Rate Maps for the City of Albuquerque, New Mexico, dated October 14, 1983, this site does not lie within a designated flood hazard zone. Further review of this mapping does not reveal downstream flooding to which this site contributes. At present, the site slopes from east to west onto adjacent undeveloped property. The site is situated down slope from Juan Tabo Boulevard N.E., which is a developed City street.

The Grading Plan shows 1) existing grades indicated by contours at 1'0" intervals, 2) proposed grades indicated by spot elevations and contours at 1'0" intervals, 3) the limit and character of the existing improvements, 4) the limit and character of the proposed improvements, and 5) continuity between existing and proposed grades. As shown this plan, the proposed improvements consist of the construction of a building along with adjacent paving and landscaping. Due to the fact that the site slopes away from Juan Tabo Boulevard N.E. at an average 5% gradient, it is not possible to obtain gravity drainage back to the street. Because of this, a pond is proposed to contain 100% of the 100-year developed runoff and to drain that pond with a submersible pump. The forced main discharge from the pond will discharge into Juan Tabo Boulevard N.E. Waterproofing of the adjacent walls will be necessary to allow for ponding within 15' of the structures.

The Calculations which appear hereon analyze both the existing and developed conditions for the 100-year, 6-hour rainfall event. The Rational Method has been used to calculate the peak rate of discharge, while the SCS Method has been used to compute the volume of runoff generated. Both Methods have been used in accordance with the City of Albuquerque Development Process Manual, Volume II, combined with the Mayor's Emergency Rule dated January 14, 1986. As shown by these calculations, the proposed improvements will result in a net increase in runoff generated by this site. The pond volume has been calculated using the Average End Area Method. As shown by the volume computation, the pond has adequate capacity to hold the 100-year developed runoff volume without credit for the mechanical discharge of the runoff. The maximum depth of pond will be approximately 4', thereby requiring fencing of the pond area.

### CALCULATIONS

#### Ground Cover Information

From SCS Bernalillo County Soil Survey, Plate 22: Etc - Embudo - Tijeras Complex  
Hydrologic Soil Group: B  
Existing Pervious CN = 61 (DPM Plate 22.2 C-2)  
Pasture or Range Land: good condition)  
Developed Pervious CN = 61 (DPM Plate 22.2 C-2)  
Open Space: good condition)

#### Time of Concentration/Time to Peak

$T_c = 0.0078 L^{0.77} / S^{0.385}$  (Kirpich Equation)

$T_p = T_c = 10 \text{ min.}$

#### Point Rainfall

$P_6 = 2.51 \text{ in.}$  (DPM Plate 22.2 D-1)

#### Rational Method

Discharge:  $Q = CiA$

Where C varies

$i = P_6(6.84)T^{-0.51} = 5.31 \text{ in/hr}$   
 $P_6 = 2.51 \text{ in}$  (DPM Plate 22.2D-1)  
 $T_c = 10 \text{ min}$  (minimum)  
 $A = \text{area, acres}$

#### SCS Method

Volume:  $V = 3630(DRO)A$

Where DRO = Direct runoff in inches  
 $A = \text{area, acres}$

#### Existing Condition

$A_{\text{total}} = 46,080 \text{ sf} = 1.06 \text{ Ac}$   
 $C = 0.40$  (Weighted average per Emergency Rule, 1/14/86)  
 $Q_{100} = CiA = 2.3 \text{ cfs}$   
 $\% \text{ impervious} = 0\%$   
Composite CN = 61 (DPM Plate 22.2 C-3)  
DRO = 0.2 in (DPM Plate 22.2 C-4)  
 $V_{100} = 3630 (DRO)A = 770 \text{ cf}$

#### Developed Condition

$A_{\text{total}} = 46,080 \text{ sf} = 1.06 \text{ Ac}$   
Roof area = 4,820 sf (10%)  
Paved area = 30,090 sf (65%)  
Landscaped area = 11,170 sf (25%)  
 $C = 0.77$  (Weighted average per Emergency Rule, 1/14/86)  
 $Q_{100} = CiA = 4.3 \text{ cfs}$   
 $\% \text{ impervious} = 75\%$   
Composite CN = 88 (DPM Plate 22.2 C-3)  
DRO = 1.4 in (DPM Plate 22.2 C-4)  
 $V_{100} = 3630 (DRO)A = 5,390 \text{ cf}$

#### Comparison

$AQ_{100} = 4.3 - 2.3 = 2.0 \text{ cfs}$  (increase)  
 $AV_{100} = 5,390 - 770 = 4,620 \text{ cf}$  (increase)

#### POND VOLUME

Elev.	Area	Vol.	$\Sigma \text{ Vol.}$
15	0	405	405
16	810	1055	1460
17	1300	1630	3090
18	1960	2280	5370
19	2600		


$V_{\text{pond}} \approx V_{100}$

93 Hydrology

Zone 4

$75\% D \quad 1.75(2.64) = 1.98$   
 $25\% B \quad 0.25(1.08) = 0.27$   
 $2.25$

Requires S.O. 19

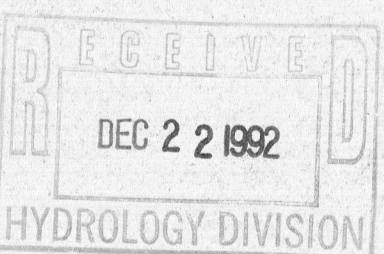

### CONCEPTUAL GRADING AND DRAINAGE PLAN

### DOUBLE RAINBOW



JEFF MORTENSEN & ASSOCIATES, INC.  
6010-B MIDWAY PARK BLVD. N.E.  
ALBUQUERQUE, NEW MEXICO 87109  
ENGINEERS & SURVEYORS (505)345-4250

DESIGNED BY	JGM	NO.	DATE	BY	REVISIONS	JOB NO.
DRAWN BY	SGH/CEN					921121
APPROVED BY	JGM					DATE
						12 - 92
						SHEET
						OF
						1