CITY OF ALBUQUERO

Planning Department Alan Varela, Interim Director



December 1, 2021

Jesus Lopez, PE RESPEC 5971 Jefferson St. NE Albuquerque, NM 87109

Re: **Guardian Storage**

Osuna & Juan Tabo (F21D081)

Request for Certificate of Occupancy Transportation Development Final Inspection

Engineer's/Architect's Stamp dated 1-28-20 (F21D081)

Certification dated 11-30-21

Dear Mr. Lopez,

Based upon the information provided in your submittal received 12-1-21, Transportation

Development has no objection to the issuance of a Permanent Certificate of Occupancy. This

letter serves as a "green tag" from Transportation Development for a Permanent Certificate of

Occupancy to be issued by the Building and Safety Division.

Albuquerque If you have any questions, please contact Ernie Gomez at (505) 924-3981.

Sincerely, NM 87103

www.cabq.gov

PO Box 1293

Jeanne Wolfenbarger, P.E.

)eanne Wolfenbarger

Traffic Engineer, Planning Dept.


Development Review Services

Ernie Gomez

Plan Checker, Planning Dept.

Development Review Services

EG via: email C: CO Clerk, File

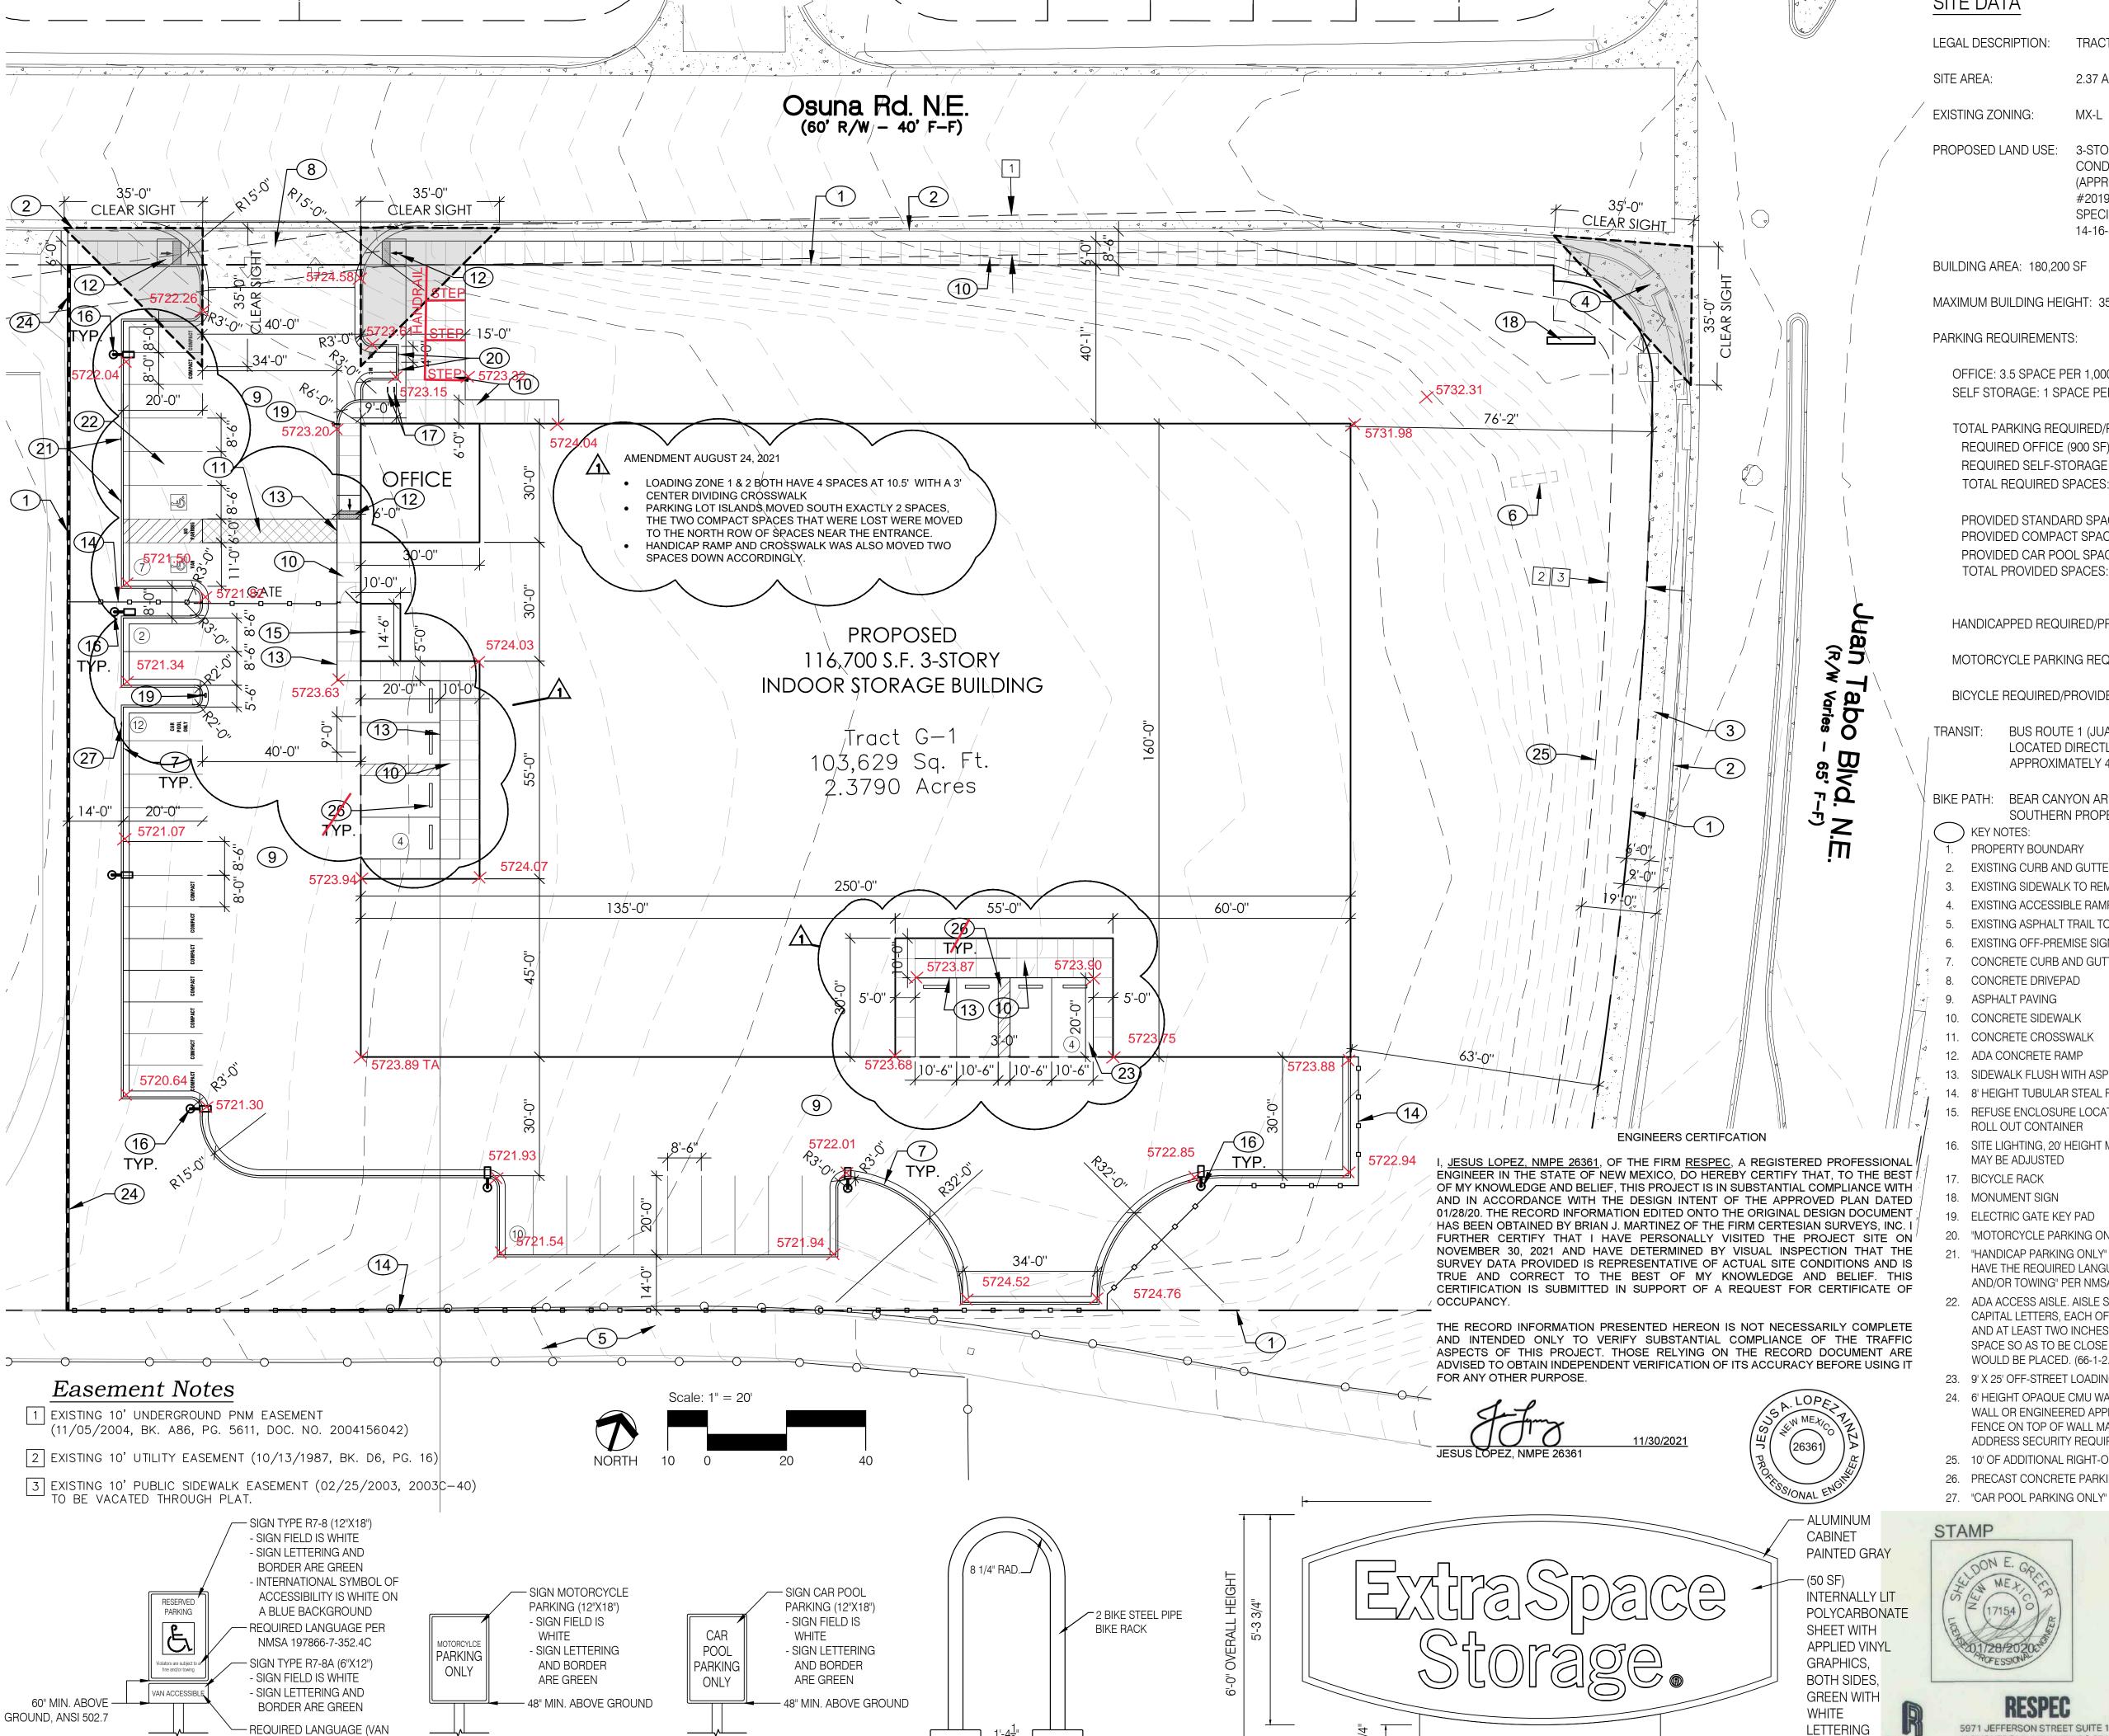

BICYCLE RACK

SCALE: N.T.S.

SCALE: N.T.S.

REQUIRED LANGUAGE (VAN

ACCESSIBLE SPACES) PER

ANSI 502.7

PARKING SIGNS

SITE DATA

TRACT G-1 LEGAL DESCRIPTION:

SITE AREA: 2.37 AC.

EXISTING ZONING:

PROPOSED LAND USE: 3-STORY BUILDING FOR SELF-STORAGE USES AS IS CONDITIONALLY ALLOWED IN MX-L ZONE DISTRICT

> (APPROVED BY ZHE, 5/1/2019, VA-2019-00086) #2019-002184). FACILITY SHALL COMPLY WITH SPECIFIC-USE STANDARDS SECTION 14-16-4-3(D)(28) SELF-STORAGE

BUILDING AREA: 180,200 SF

MAXIMUM BUILDING HEIGHT: 35 FEET

PARKING REQUIREMENTS

OFFICE: 3.5 SPACE PER 1,000 SF GFA

SELF STORAGE: 1 SPACE PER 3,000 SF GFA

TOTAL PARKING REQUIRED/PROVIDED: 41/42 REQUIRED OFFICE (900 SF) REQUIRED SELF-STORAGE (115,800 SF) TOTAL REQUIRED SPACES:

PROVIDED STANDARD SPACES: 29 PROVIDED COMPACT SPACES: 9 (21%) PROVIDED CAR POOL SPACES: +4 (1 SPACE =4 CREDITS

HANDICAPPED REQUIRED/PROVIDED: 2/2

MOTORCYCLE PARKING REQUIRED/PROVIDED: 2/2

BICYCLE REQUIRED/PROVIDED:

BUS ROUTE 1 (JUAN TABO BLVD). THE BUS STOPS ARE LOCATED DIRECTLY ACROSS JUAN TABO BLVD AND APPROXIMATELY 450' NORTH FROM THE SITE

BIKE PATH: BEAR CANYON ARROYO TRAIL RUNS PARALLEL TO THE SOUTHERN PROPERTY BOUNDARY

KEY NOTES:

PROPERTY BOUNDARY

2. EXISTING CURB AND GUTTER TO REMAIN

3. EXISTING SIDEWALK TO REMAIN

4. EXISTING ACCESSIBLE RAMP TO REMAIN 5. EXISTING ASPHALT TRAIL TO REMAIN

6. EXISTING OFF-PREMISE SIGN TO BE REMOVED

CONCRETE CURB AND GUTTER

8. CONCRETE DRIVEPAD

ASPHALT PAVING

10. CONCRETE SIDEWALK 11. CONCRETE CROSSWALK

12. ADA CONCRETE RAMP

13. SIDEWALK FLUSH WITH ASPHALT

14. 8' HEIGHT TUBULAR STEAL FENCE, COLOR: BLACK

15. REFUSE ENCLOSURE LOCATED IN BUILDING WITH ROLL UP DOOR AND **ROLL OUT CONTAINER**

16. SITE LIGHTING, 20' HEIGHT MAX, LOCATIONS SHOW ARE CONCEPTUAL AND

MAY BE ADJUSTED

17. BICYCLE RACK

18. MONUMENT SIGN 19. ELECTRIC GATE KEY PAD

"MOTORCYCLE PARKING ONLY" SIGN

"HANDICAP PARKING ONLY" SIGN WITH "VAN ACCESSIBLE" SIGN. SHALL HAVE THE REQUIRED LANGUAGE "VIOLATORS ARE SUBJECT TO A FINE AND/OR TOWING" PER NMSA 197866-7-352.4C.

22. ADA ACCESS AISLE. AISLE SHALL HAVE THE LANGUAGE "NO PARKING" IN CAPITAL LETTERS, EACH OF WHICH SHALL BE AT LEAST ONE FOOT HIGH AND AT LEAST TWO INCHES WIDE, PLACED AT THE REAR OF THE PARKING SPACE SO AS TO BE CLOSE TO WHERE AN ADJACENT VEHICLE'S REAR TIRE WOULD BE PLACED. (66-1-2.1.B NMSA 1978)

23. 9' X 25' OFF-STREET LOADING SPACE

24. 6' HEIGHT OPAQUE CMU WALL, 3' BLOCK WALL ON TOP OF 3' RETAINING WALL OR ENGINEERED APPROVED EQUAL. ADDITIONAL TUBULAR STEAL FENCE ON TOP OF WALL MAY BE ADDED AS DETERMINED BY OWNER TO ADDRESS SECURITY REQUIREMENTS.

Prepared for:

Guardian Storage VI, LLC

9221 Eagle Ranch Rd NW

Albuquerque, NM 87114

25. 10' OF ADDITIONAL RIGHT-OF-WAY TO BE DEDICATED THROUGH PLAT

26. PRECAST CONCRETE PARKING BUMPER.

27. "CAR POOL PARKING ONLY" SIGN.



GENERAL NOTES

- ALL LIGHTING SHALL COMPLY WITH THE CITY INTEGRATED DEVELOPMENT ORDINANCE (IDO) §14-16-5-8 OUTDOOR LIGHTING REGULATIONS. PARKING LOT SITE LIGHTING SHALL BE A MAXIMUM 20 FEET.
- 2. FUTURE CHANGES TO PROPOSED SIGNAGE CAN BE AMENDED ADMINISTRATIVELY. SIGNAGE WILL COMPLY WITH 5-12(F)(2) OF
- 3. ROOF-MOUNTED MECHANICAL EQUIPMENT SHALL BE SCREENED 4. ALL SCREENING AND VEGETATION SURROUNDING GROUND-MOUNTED TRANSFORMERS AND UTILITY PADS SHALL
 - ALLOW 10 FEET OF CLEARANCE IN FRONT OF THE EQUIPMENT DOOR AND 5-6 FEET OF CLEARANCE ON THE REMAINING THREE SIDES FOR SAFE OPERATION, MAINTENANCE, AND REPAIR PURPOSES.
- PNM COORDINATION: DEVELOPMENT SHALL ABIDE BY ALI CONDITIONS OR TERMS OF UTILITY EASEMENTS PRIOR TO DEVELOPMENT, CONTACT SHALL BE MADE TO PNM'S NEW SERVICE DELIVERY DEPARTMENT TO COORDINATE ELECTRIC SERVICE AND OPTIONS FOR THE LOCATION OF ELECTRIC SERVICE CONNECTION.
- ALL SIDEWALKS, RAMPS (INCLUDING REQUIRED TRUNCATED DOMES) CURB CUTS, AND CURB AND GUTTER SHALL BE BUILT PER C.O.A STANDARD DRAWINGS; SIDEWALK (2430), RAMPS (2440), CURB CUTS (2426), CURB AND GUTTER (2417A)
- 7. CLEAR SIGHT DISTANCE: LANDSCAPING AND SIGNAGE WILL NOT INTERFERE WITH CLEAR SIGHT REQUIREMENTS. THEREFORE SIGNS, WALLS, TREES, AND SHRUBBERY BETWEEN 3 AND 8 FEET TALL (AS MEASURED FROM THE GUTTER PAN) WILL NOT BE ALLOWED IN THIS AREA (SEE LANDSCAPE PLAN, SHEET 2, FOR SIGHT TRIANGLE).
- 8. HOURS OF OPERATION: OFFICE AND GATE ACCESS 7:00 TO 5:30 PM; GATE ONLY ACCESS IS ALLOWED UNTIL 7:00 PM.

PROJECT NUMBER: PR -2019-002184

Application Number: SI-2019-00379

Is an Infrastructure List required? (X) Yes () No If yes, then a set of approved DRC plans with a work order is required for any construction within Public Right-of-Way or for construction of public improvements.

DRB SITE DEVELOPMENT PLAN SIGNOFF APPROVAL:

Son When	01-29-28
Traffic Engineering, Transportation Division	Date
mistapher Cadens	01-29-20
ABCWUA	Date
Check Into	01.29.20
Parks and Recreation Department	Date
8-7-	1-30-20
City Engineer/Hydrology	Date
(5/5)	1.29.20
Code Enforcement	Date
N/A J.Wolfley	Jun 1, 2020
*Environmental Heath Department (conditional)	Date
7	d-30.20
Solid Waste Management	Date
In what	Jun 1, 2020
DRB Chairperson, Planning Department	Date

GUARDIAN STORAGE OSUNA ROAD

SITE PLAN - DRB

Prepared by: Consensus Planning, Inc. Consensus Planning, Inc 302 Eighth Street SW Albuquerque, NM 87102

Sheet 1 of 9 January 22, 2020



SCALE: 1/2"=1'-0"

6'-1"

MONUMENT SIGN

WATER & NATURAL RESOURCES

WWW.RESPEC.COM 505.253.9718



City of Albuquerque

Planning Department Development & Building Services Division

DRAINAGE AND TRANSPORTATION INFORMATION SHEET (REV 11/2018)

Project Title:	Building P	Permit #:	Hydrology File #:
DRB#:	EPC#:		Work Order#:
Legal Description:			
City Address:			
Applicant:			Contact:
Address:			
			E-mail:
Owner:			Contact:
Address:			
			E-mail:
TYPE OF SUBMITTAL:PLA	Γ (# OF LOTS)	RESIDENCE	_ DRB SITE ADMIN SITE
IS THIS A RESUBMITTAL?:	Yes	No	
DEPARTMENT: TRAFFIC/ T	RANSPORTATION _	HYDROLOG	Y/ DRAINAGE
Check all that Apply: TYPE OF SUBMITTAL: ENGINEER/ARCHITECT CERTON CONCEPTUAL G & D PLAN GRADING PLAN DRAINAGE MASTER PLAN DRAINAGE REPORT FLOODPLAIN DEVELOPMENTON ELEVATION CERTIFICATE CLOMR/LOMR TRAFFIC CIRCULATION LAY TRAFFIC IMPACT STUDY (TIEST) OTHER (SPECIFY) PRE-DESIGN MEETING?	PERMIT APPLIC OUT (TCL)	BUILI CERT PRELI SITE I SITE I FINAI SIA/ F FOUN GRAD SO-19 PAVII GRAD WORK CLOM FLOO	APPROVAL/ACCEPTANCE SOUGHT: DING PERMIT APPROVAL IFICATE OF OCCUPANCY IMINARY PLAT APPROVAL PLAN FOR SUB'D APPROVAL PLAN FOR BLDG. PERMIT APPROVAL RELEASE OF FINANCIAL GUARANTEE IDATION PERMIT APPROVAL DING PERMIT APPROVAL APPROVAL APPROVAL OF PERMIT APPROVAL
DATE SUBMITTED:	By:		

COA STAFF: ELECTRONIC SUBMITTAL RECEIVED:____

FEE PAID:

