


FINISHED FLOOR ELEVATIONS	
GARDEN LEVEL	5922.50
1ST FLOOR	5935.50
2ND FLOOR	5948.50
PHASE 1	
ADDITIONS	5,812 sq. ft.
ROOF AREA	6,445 sq. ft.

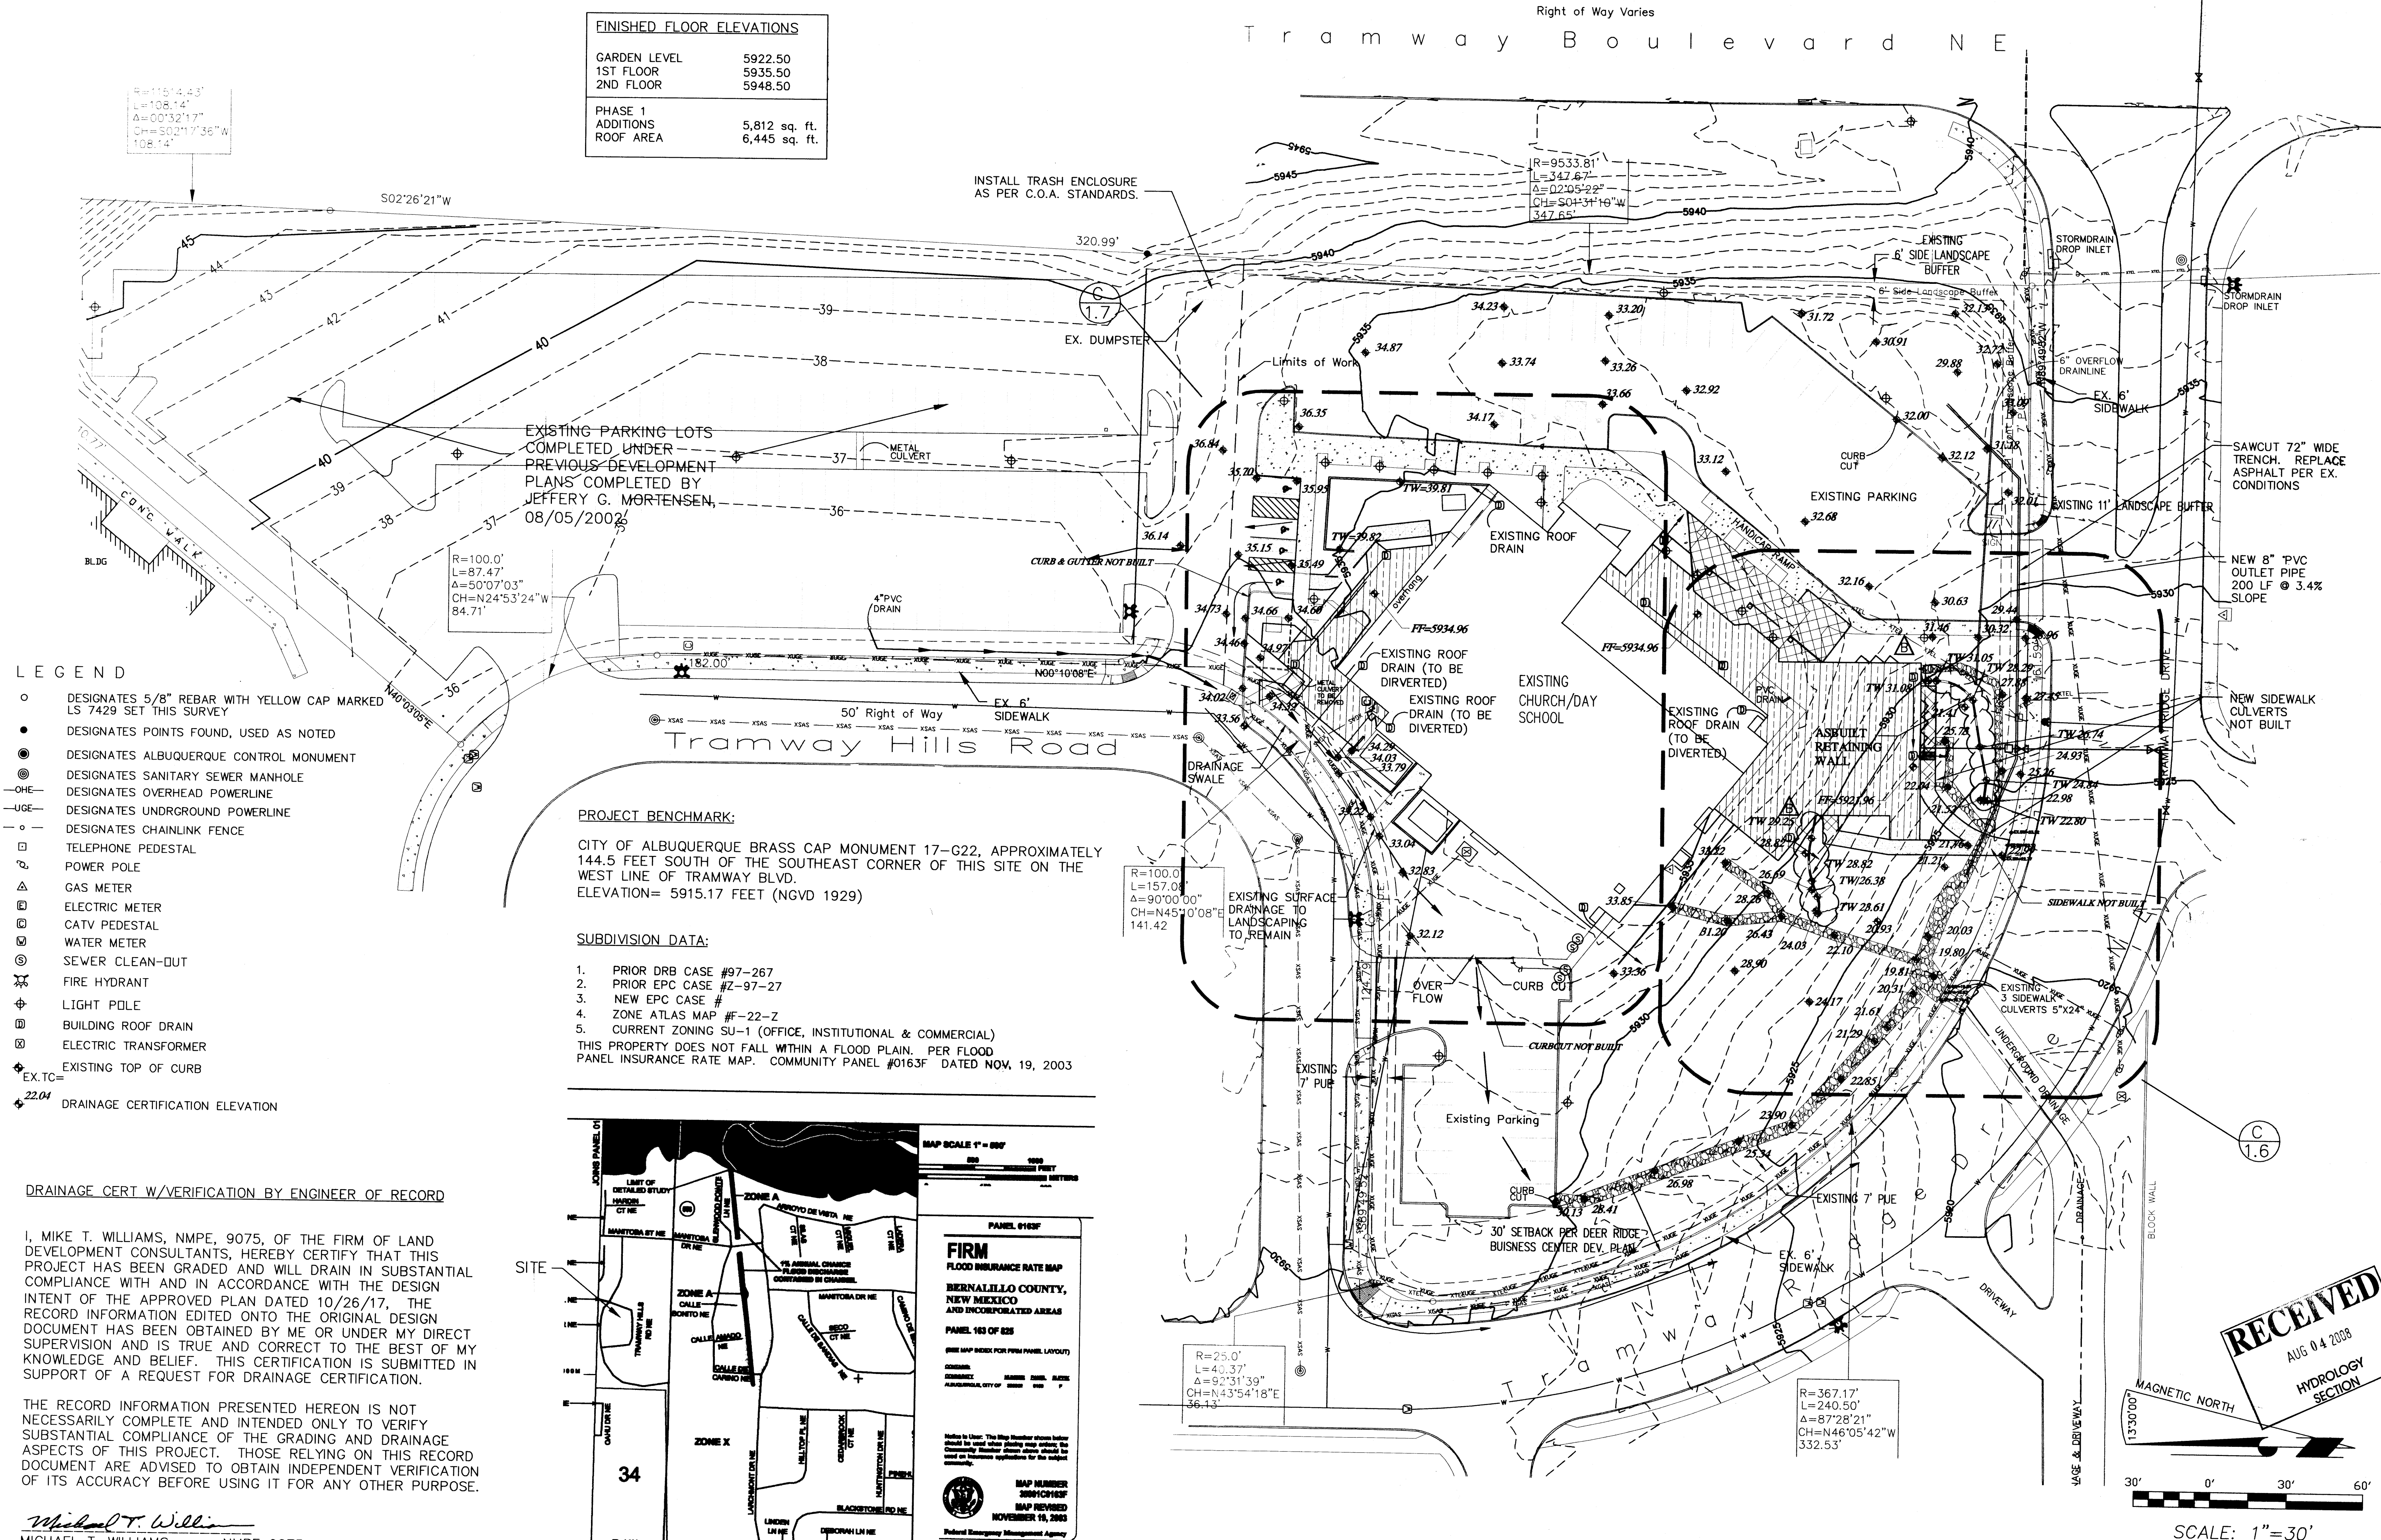

- LEGEND**
- DESIGNATES 5/8" REBAR WITH YELLOW CAP MARKED LS 7429 SET THIS SURVEY
 - DESIGNATES POINTS FOUND, USED AS NOTED
 - ⊙ DESIGNATES ALBUQUERQUE CONTROL MONUMENT
 - OHE— DESIGNATES OVERHEAD POWERLINE
 - UGE— DESIGNATES UNDERGROUND POWERLINE
 - DESIGNATES CHAINLINK FENCE
 - TELEPHONE PEDESTAL
 - ⊕ POWER POLE
 - △ GAS METER
 - ⊞ ELECTRIC METER
 - ⊞ CATV PEDESTAL
 - ⊞ WATER METER
 - ⊞ SEWER CLEAN-OUT
 - ⊞ FIRE HYDRANT
 - ⊞ LIGHT POLE
 - ⊞ BUILDING ROOF DRAIN
 - ⊞ ELECTRIC TRANSFORMER
 - ⊞ EX.TC= EXISTING TOP OF CURB
 - ⊞ 22.04 DRAINAGE CERTIFICATION ELEVATION

PROJECT BENCHMARK:
CITY OF ALBUQUERQUE BRASS CAP MONUMENT 17-G22, APPROXIMATELY 144.5 FEET SOUTH OF THE SOUTHEAST CORNER OF THIS SITE ON THE WEST LINE OF TRAMWAY BLVD.
ELEVATION= 5915.17 FEET (NGVD 1929)

- SUBDIVISION DATA:**
1. PRIOR DRB CASE #97-267
 2. PRIOR EPC CASE #Z-97-27
 3. NEW EPC CASE #
 4. ZONE ATLAS MAP #F-22-Z
 5. CURRENT ZONING SU-1 (OFFICE, INSTITUTIONAL & COMMERCIAL)
- THIS PROPERTY DOES NOT FALL WITHIN A FLOOD PLAIN. PER FLOOD PANEL INSURANCE RATE MAP. COMMUNITY PANEL #0163F DATED NOV, 19, 2003

DRAINAGE CERT W/VERIFICATION BY ENGINEER OF RECORD


I, MIKE T. WILLIAMS, NMPE, 9075, OF THE FIRM OF LAND DEVELOPMENT CONSULTANTS, HEREBY CERTIFY THAT THIS PROJECT HAS BEEN GRADED AND WILL DRAIN IN SUBSTANTIAL COMPLIANCE WITH AND IN ACCORDANCE WITH THE DESIGN INTENT OF THE APPROVED PLAN DATED 10/26/17, THE RECORD INFORMATION EDITED ONTO THE ORIGINAL DESIGN DOCUMENT HAS BEEN OBTAINED BY ME OR UNDER MY DIRECT SUPERVISION AND IS TRUE AND CORRECT TO THE BEST OF MY KNOWLEDGE AND BELIEF. THIS CERTIFICATION IS SUBMITTED IN SUPPORT OF A REQUEST FOR DRAINAGE CERTIFICATION.

THE RECORD INFORMATION PRESENTED HEREON IS NOT NECESSARILY COMPLETE AND INTENDED ONLY TO VERIFY SUBSTANTIAL COMPLIANCE OF THE GRADING AND DRAINAGE ASPECTS OF THIS PROJECT. THOSE RELYING ON THIS RECORD DOCUMENT ARE ADVISED TO OBTAIN INDEPENDENT VERIFICATION OF ITS ACCURACY BEFORE USING IT FOR ANY OTHER PURPOSE.

Michael T. Williams
MICHAEL T. WILLIAMS, NMPE 9075


7/29/08
DATE:

APPROVED BY THE EXECUTIVE COMMITTEE ON

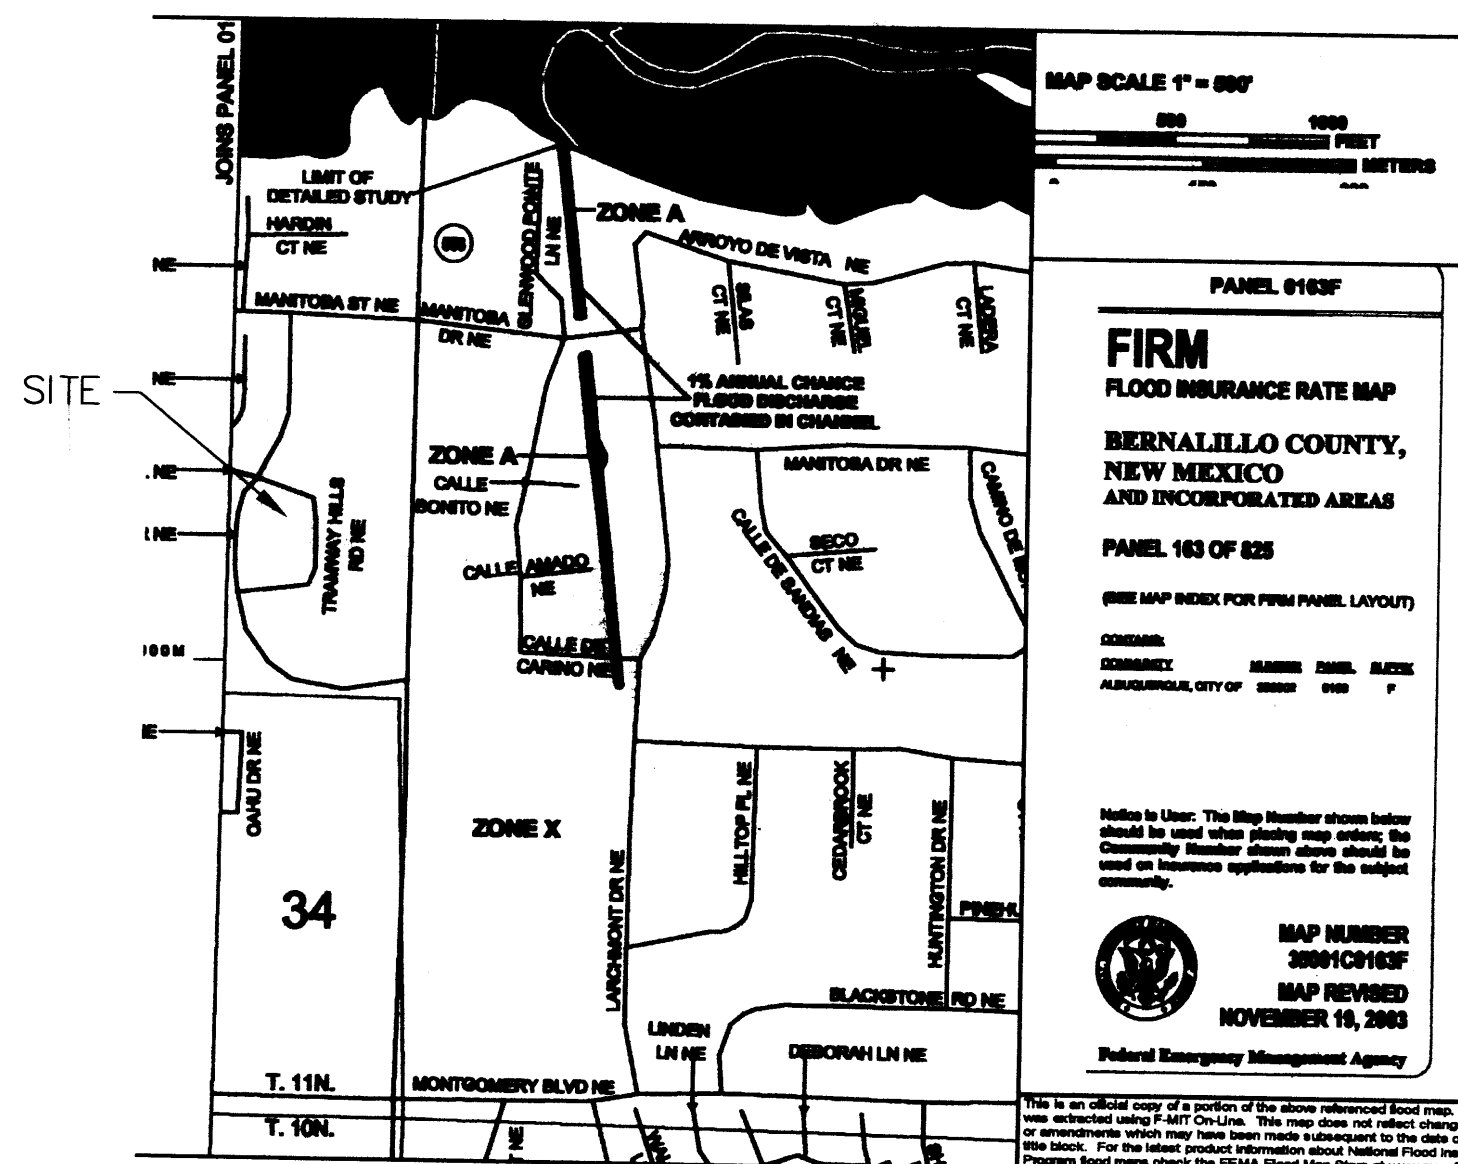

FINAL - AS-BUILT PLAN

Tramway Community Church
Addition and Remodel
4800 Tramway Ridge Dr N E
Albuquerque, New Mexico

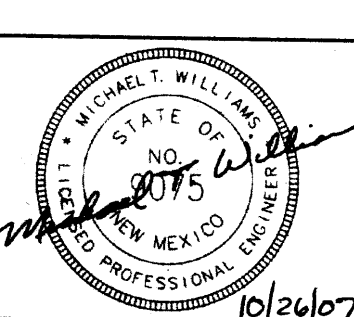

SHEET TITLE:

OVERALL
GRADING &
DRAINAGE
PLAN

JOB NUMBER:
0406

DATE:
05/23/07

REVISIONS:
A. Per DRB Review 6/28/07
B. ASBUILT 7/08/08

SHEET:

C-1.5

R+B
DORMAN and BREEN
RICHARD DORMAN F.A.I.A.
LAURENCE BREEN A.I.A.
ALBUQUERQUE, NM 505-299-5940 SANTA FE, NM 505-982-9196

SCALE: 1"=30'

RECEIVED
AUG 04 2008
HYDROLOGY
SECTION

MAGNETIC NORTH

30' 0' 30' 60'

133000

DRIVEWAY

UNDERGROUND DRAINAGE

EXISTING 5" SIDEWALK CULVERTS 5"x24"

EXISTING 7" PUE

EXISTING 6" SIDEWALK

EXISTING 6" SIDEWALK


EXISTING 6" SIDEWALK

EXISTING 6" SIDEWALK

EXISTING 6" SIDEWALK

Tramway Boulevard NE

Right of Way Varies

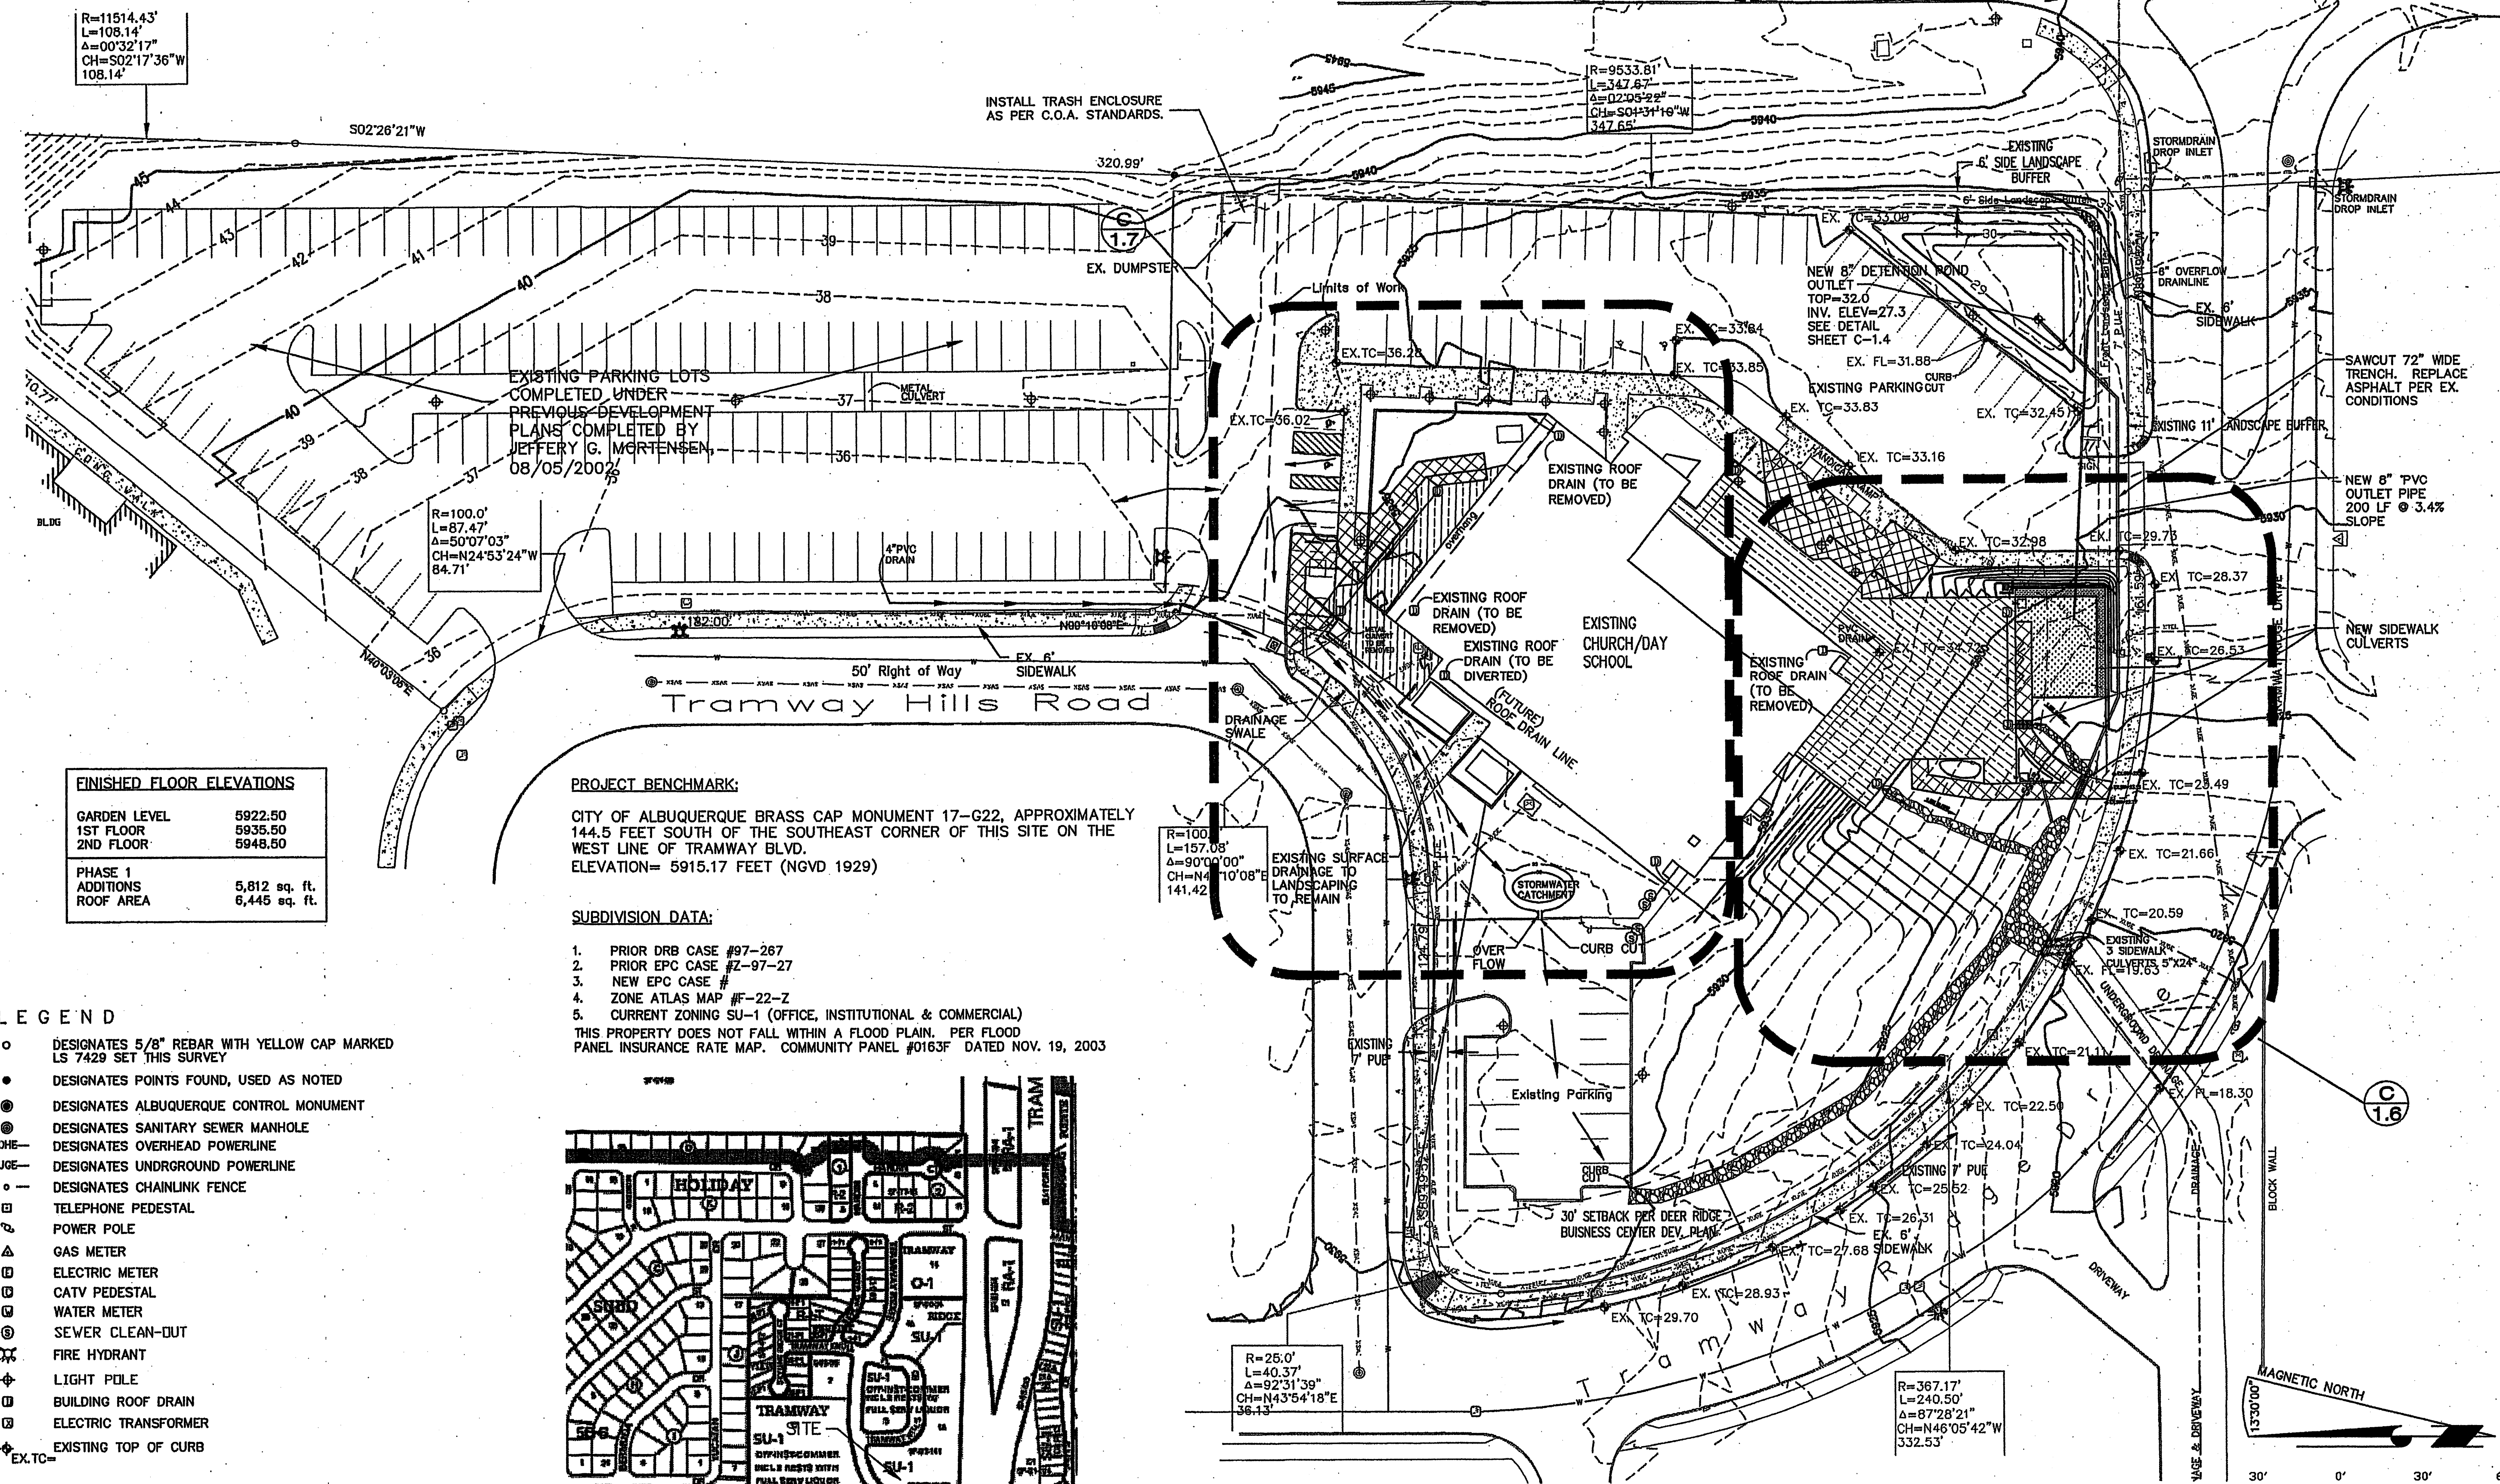

FINISHED FLOOR ELEVATIONS	
GARDEN LEVEL	5922.50
1ST FLOOR	5935.50
2ND FLOOR	5948.50
PHASE 1	
ADDITIONS	5,812 sq. ft.
ROOF AREA	6,445 sq. ft.

PROJECT BENCHMARK:


CITY OF ALBUQUERQUE BRASS CAP MONUMENT 17-G22, APPROXIMATELY 144.5 FEET SOUTH OF THE SOUTHEAST CORNER OF THIS SITE ON THE WEST LINE OF TRAMWAY BLVD.
ELEVATION= 5915.17 FEET (NGVD 1929)

SUBDIVISION DATA:

1. PRIOR DRB CASE #97-267
 2. PRIOR EPC CASE #Z-97-27
 3. NEW EPC CASE #
 4. ZONE ATLAS MAP #F-22-Z
 5. CURRENT ZONING SU-1 (OFFICE, INSTITUTIONAL & COMMERCIAL)
- THIS PROPERTY DOES NOT FALL WITHIN A FLOOD PLAIN. PER FLOOD PANEL INSURANCE RATE MAP. COMMUNITY PANEL #0163F DATED NOV. 19, 2003

LEGEND


- DESIGNATES 5/8" REBAR WITH YELLOW CAP MARKED LS 7429 SET THIS SURVEY
- DESIGNATES POINTS FOUND, USED AS NOTED
- ⊙ DESIGNATES ALBUQUERQUE CONTROL MONUMENT
- DESIGNATES SANITARY SEWER MANHOLE
- DESIGNATES OVERHEAD POWERLINE
- DESIGNATES UNDERGROUND POWERLINE
- DESIGNATES CHAINLINK FENCE
- ⊙ TELEPHONE PEDESTAL
- ⊙ POWER POLE
- ⊙ GAS METER
- ⊙ ELECTRIC METER
- ⊙ CATV PEDESTAL
- ⊙ WATER METER
- ⊙ SEWER CLEAN-OUT
- ⊙ FIRE HYDRANT
- ⊙ LIGHT POLE
- ⊙ BUILDING ROOF DRAIN
- ⊙ ELECTRIC TRANSFORMER
- ⊙ EX.TC= EXISTING TOP OF CURB

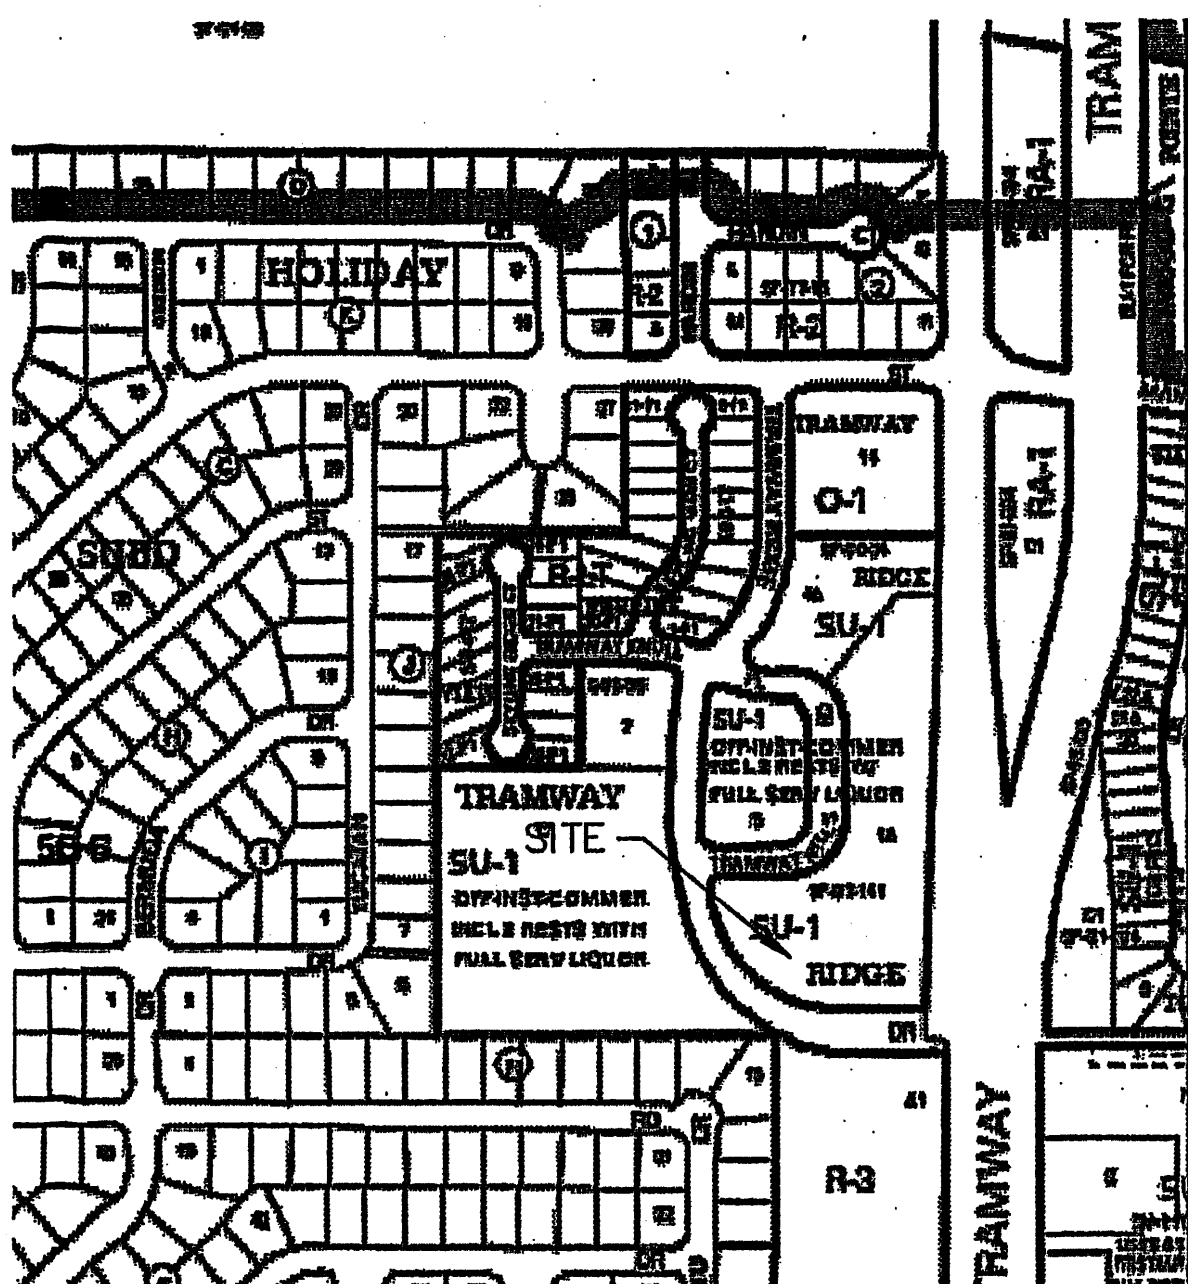

SURVEYOR'S CERTIFICATE

I HEREBY CERTIFY THAT THIS TOPOGRAPHIC SURVEY MEETS THE MINIMUM STANDARDS OF THE UNITED STATES NATIONAL MAP ACCURACY STANDARDS AND WAS COMPLETED BY ME OR UNDER MY DIRECT SUPERVISION, UTILIZING CITY OF ALBUQUERQUE MONUMENTAL FIELD SURVEYING WAS COMPLETED UTILIZING GLOBAL POSITIONING SYSTEM SURVEYING EQUIPMENT WITH ACTUAL GROUND ELEVATION, EXISTING STRUCTURES AND UTILITIES AS SHOWN

RICHARD BORGO HMRPLS NO. 7429

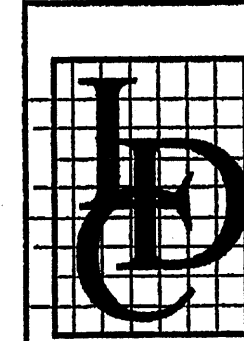


LAND DEVELOPMENT CONSULTANTS IIc
AN ASSOCIATE FIRM OF WILLIAMS & BECK INC.

PROFESSIONAL CIVIL ENGINEERS,
ENVIRONMENTAL ENGINEERS
& LAND SURVEYORS


5620 S. SAN FRANCISCO DRIVE NE,
ALBUQUERQUE, NEW MEXICO 87109
PHONE: (505) 797-4120 FAX: (505) 821-0392
E-MAIL: ldc_11c@msm.com

DORMAN and BREEN

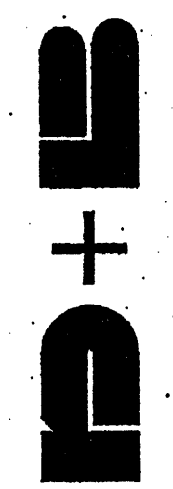

LAURENCE BREEN A.L.A.
RICHARD DORMAN F.A.L.A.
ALBUQUERQUE, NM 505-299-5940 SANTA FE, NM 505-982-9196

Tramway Community Church
Addition and Remodel
4800 Tramway Ridge Dr N E
Albuquerque, New Mexico

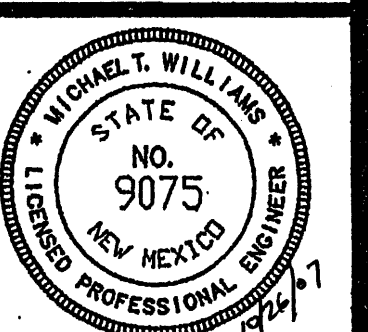

OVERALL GRADING & DRAINAGE PLAN


JOB NUMBER:
0406

DATE:
05/23/07

REVISIONS:
A. Per DRB Review

DATE:
6/28/07

C-1.5

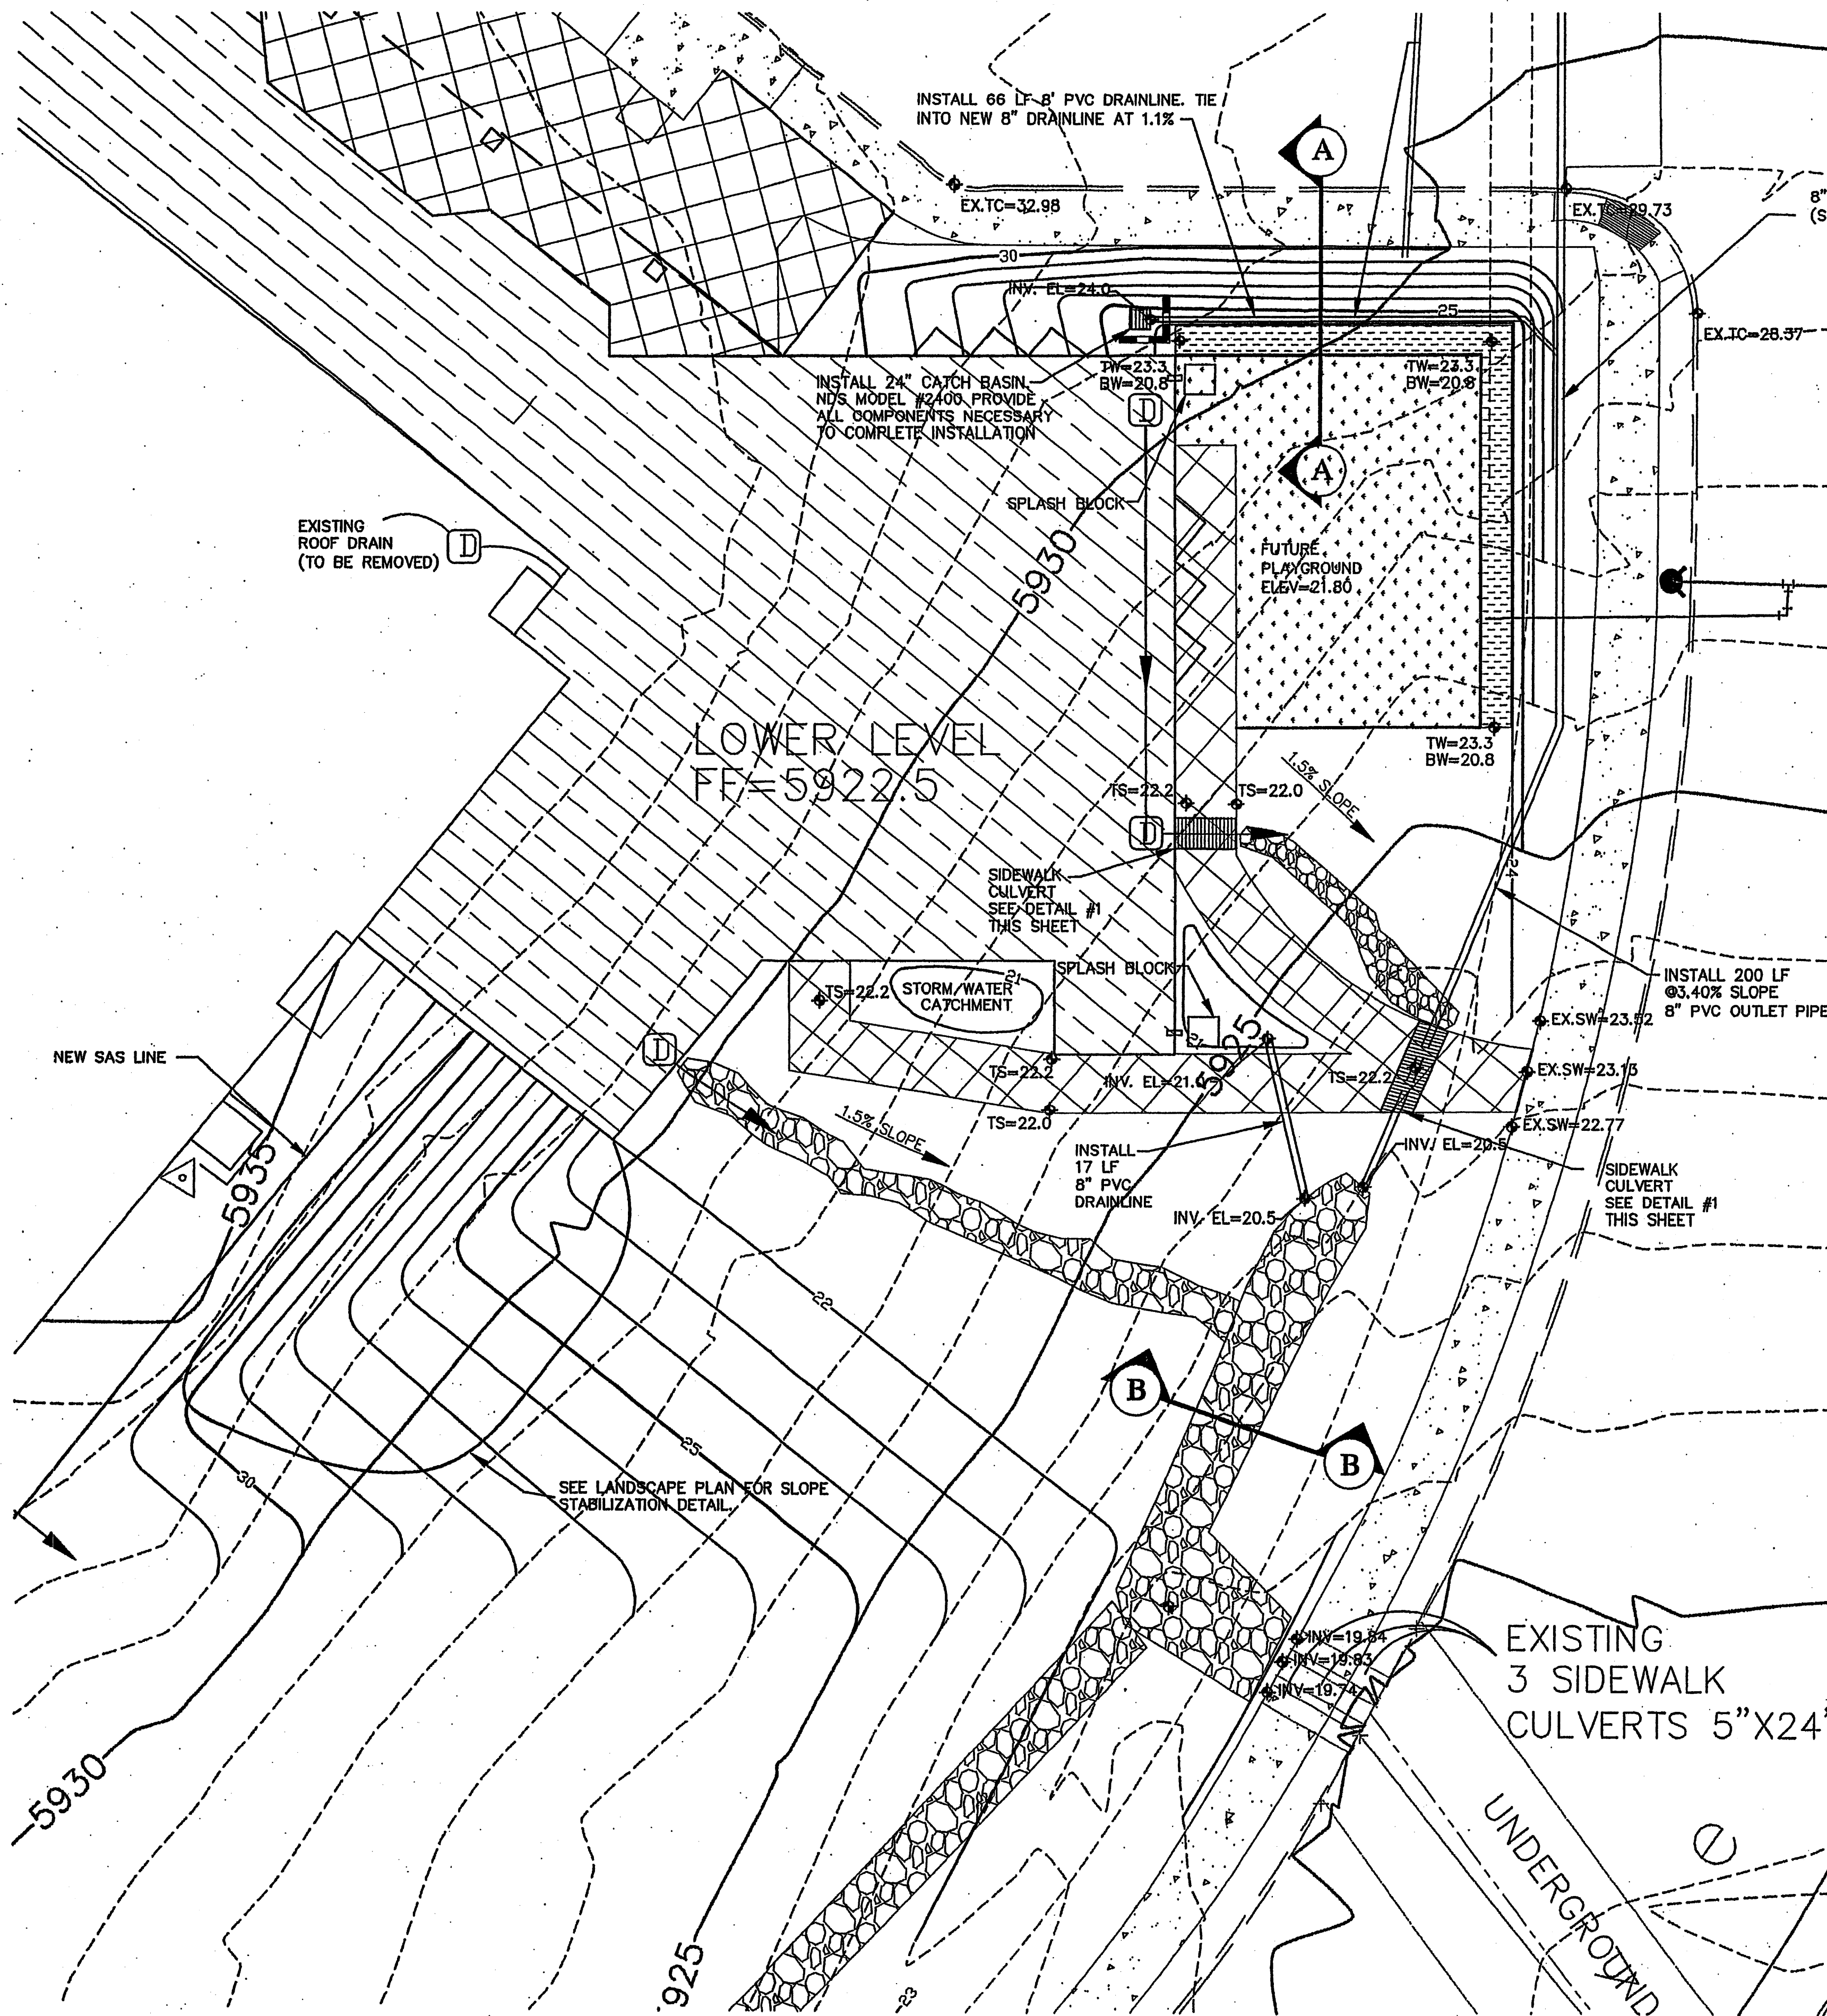

FINISH FLOOR ELEVATIONS






GARDEN LEVEL 5922.50
1ST. FLOOR LEVEL 5935.50
2ND. FLOOR LEVEL 5948.50

PHASE I
ADDITIONS = 5812 SQ.FT.
ROOF AREA = 6,445 SQ.FT.

SURVEYOR'S CERTIFICATE

I HEREBY CERTIFY THAT THIS TOPOGRAPHIC SURVEY MEETS THE MINIMUM STANDARDS OF THE UNITED STATES NATIONAL MAP ACCURACY STANDARDS AND WAS COMPLETED BY ME OR UNDER MY DIRECT SUPERVISION, UTILIZING CITY OF ALBUQUERQUE MONUMENTATION. FIELD SURVEYING WAS COMPLETED UTILIZING GLOBAL POSITIONING SYSTEM SURVEYING EQUIPMENT WITH ACTUAL GROUND ELEVATION, EXISTING STRUCTURES AND UTILITIES AS SHOWN.

RICHARD BORDEL
NMRPLS NO. 7429

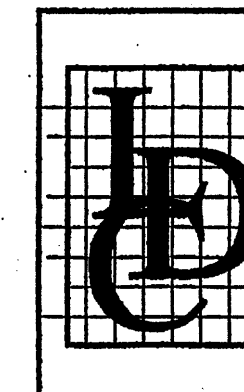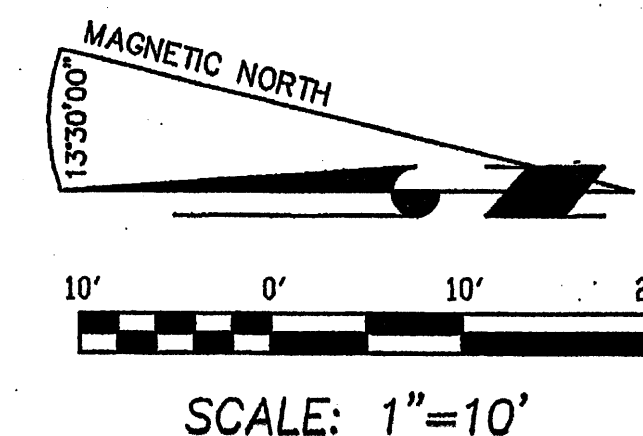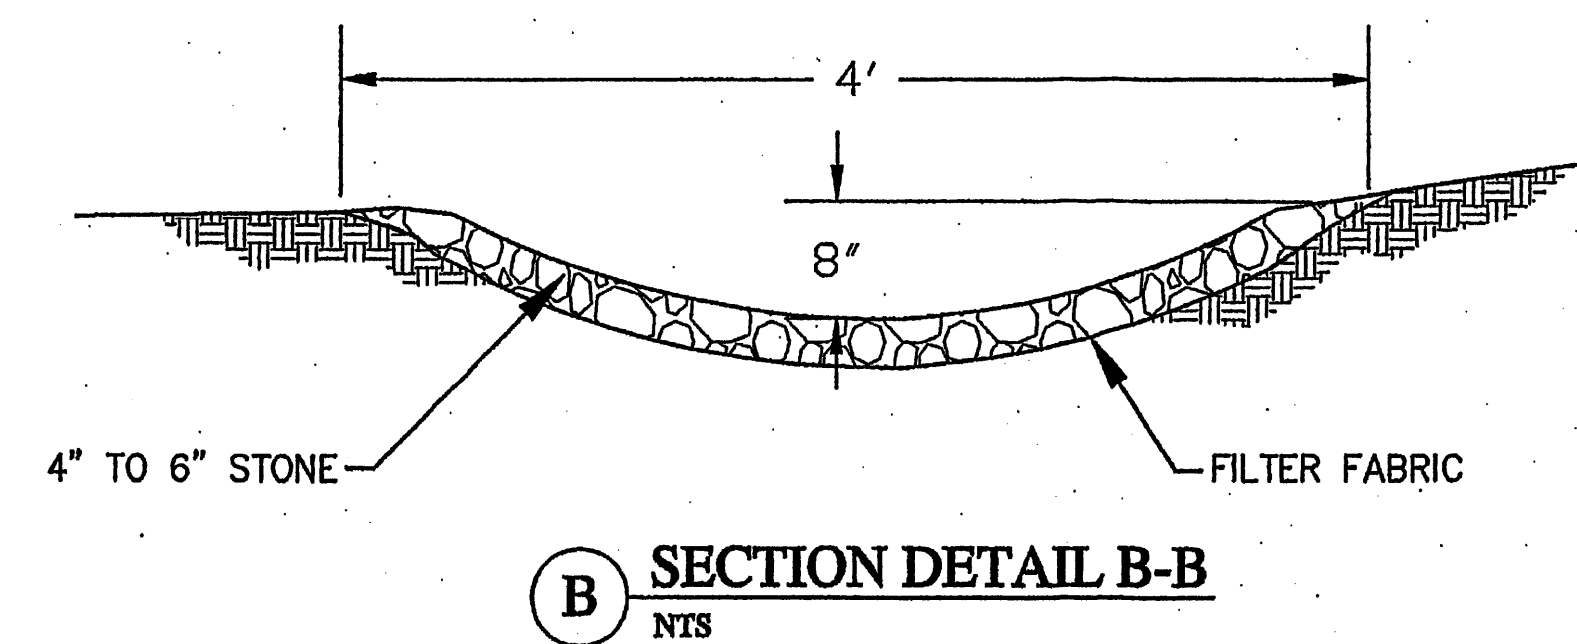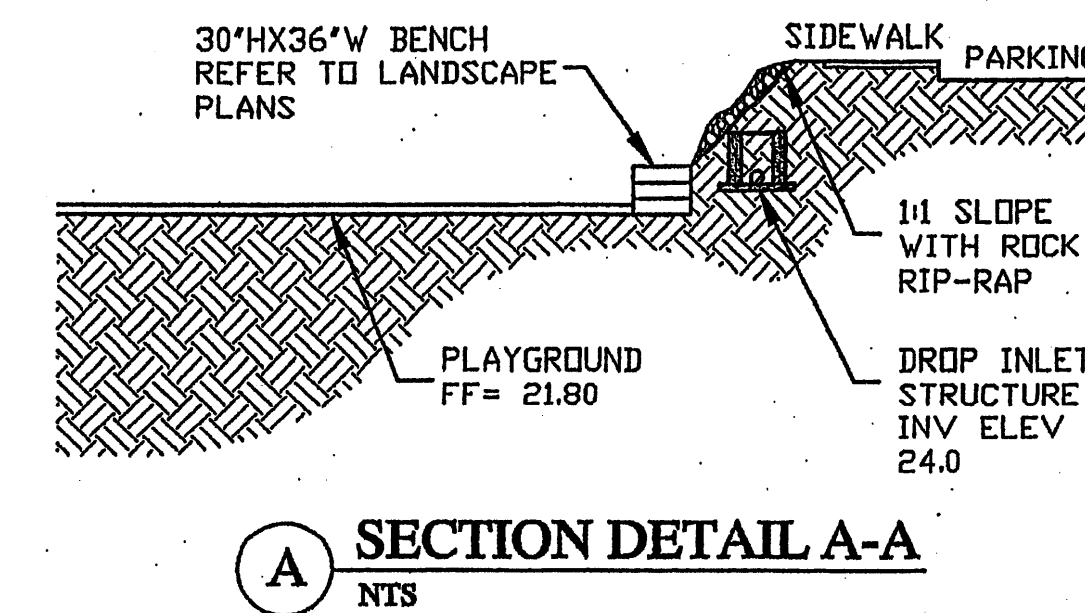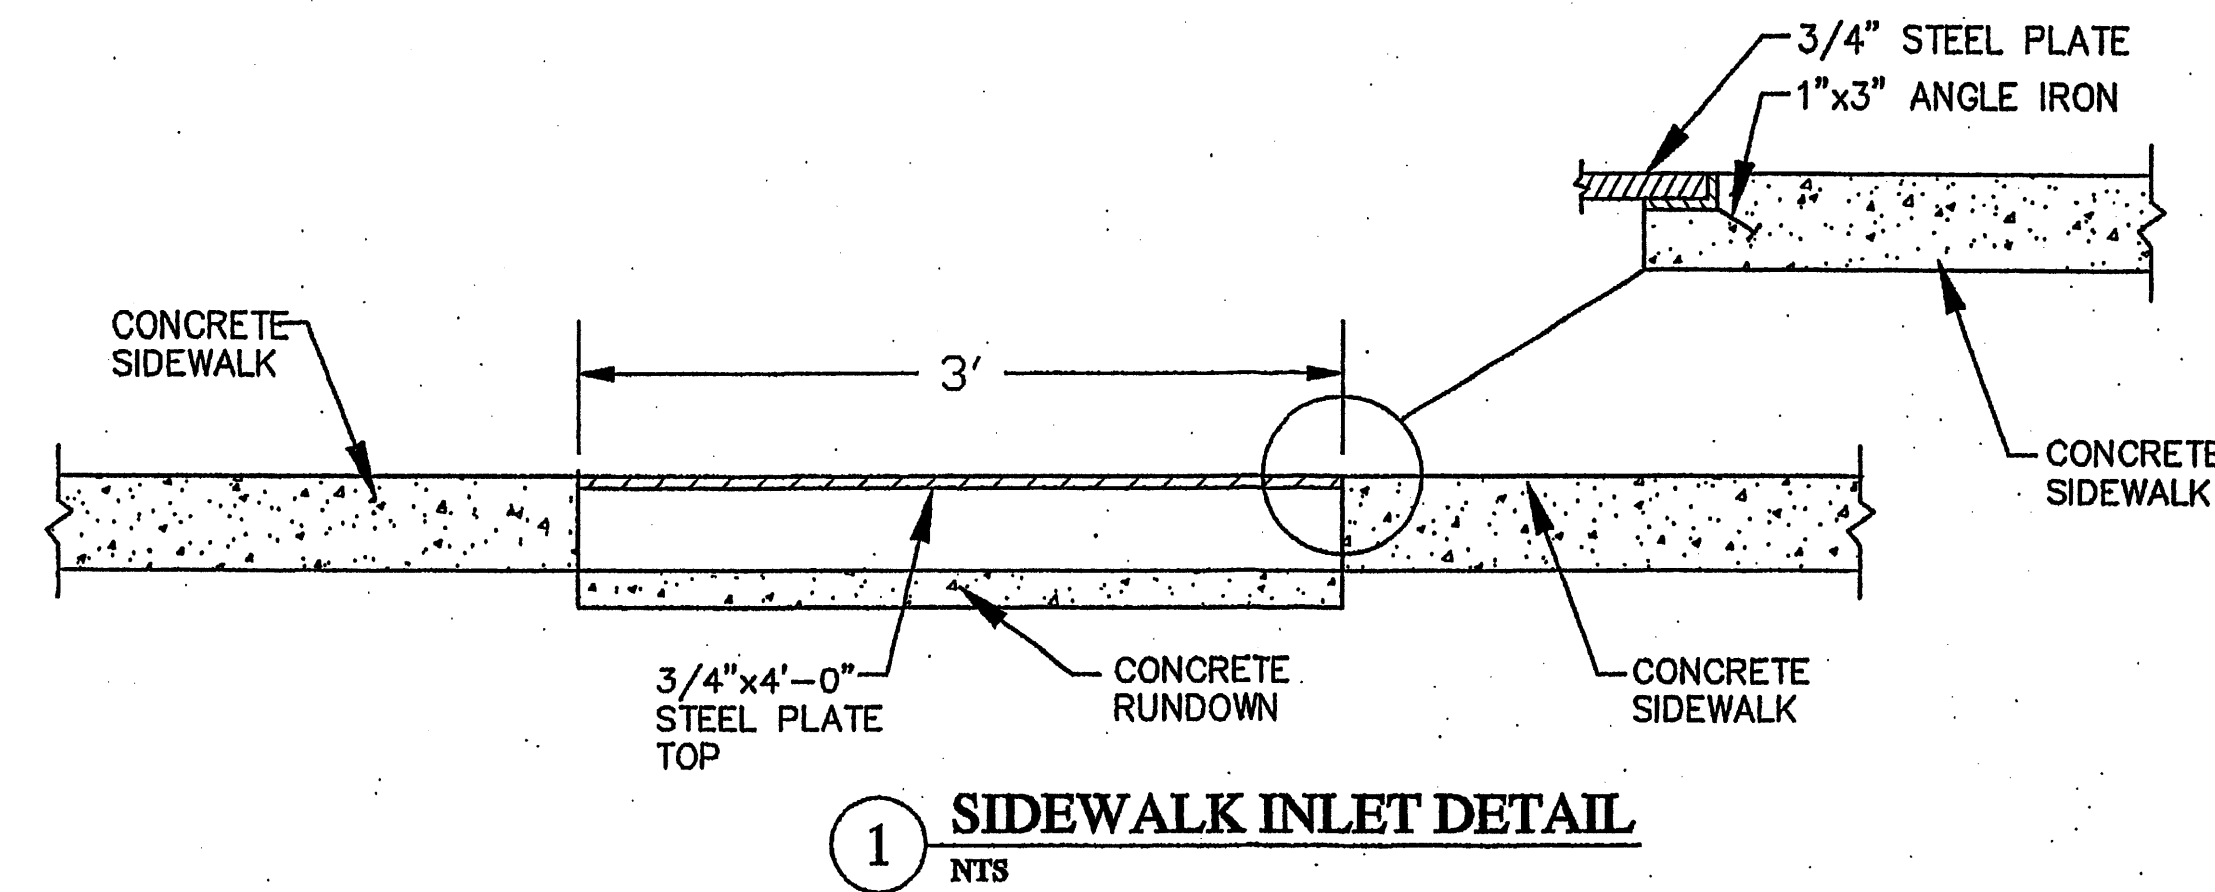


LAND DEVELOPMENT CONSULTANTS II
AN ASSOCIATE FIRM OF WILLIAMS & BECK, INC.
PROFESSIONAL CIVIL ENGINEERS,
ENVIRONMENTAL ENGINEERS
& LAND SURVEYORS
5620 S. SAN FRANCISCO DRIVE NE,
ALBUQUERQUE, NEW MEXICO 87109
PHONE: (505) 797-4120 FAX: (505) 821-0392
E-MAIL: ldc_jlc@wbl.com

DORMAN and BREEN

R + B

RICHARD DORMAN F.A.I.A.
ALBUQUERQUE, NM 505-289-5940
LAURENCE BREEN A.I.A.
SANTA FE, NM 505-982-9196

Tramway Community Church
Addition and Remodel
4800 Tramway Ridge Dr N E
Albuquerque, New Mexico

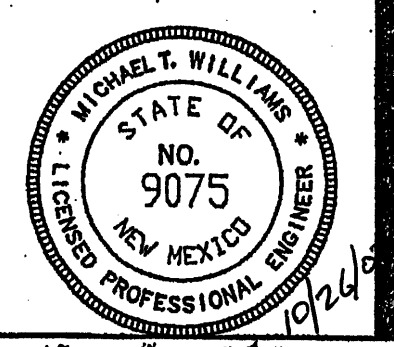

SHEET TITLE

GRADING &
DRAINAGE
DETAIL 1

JOB NUMBER
0406

DATE
05/23/07

REVISIONS:
A. Revised/DRB review 6/28/07

DATE

DATE


DATE

DATE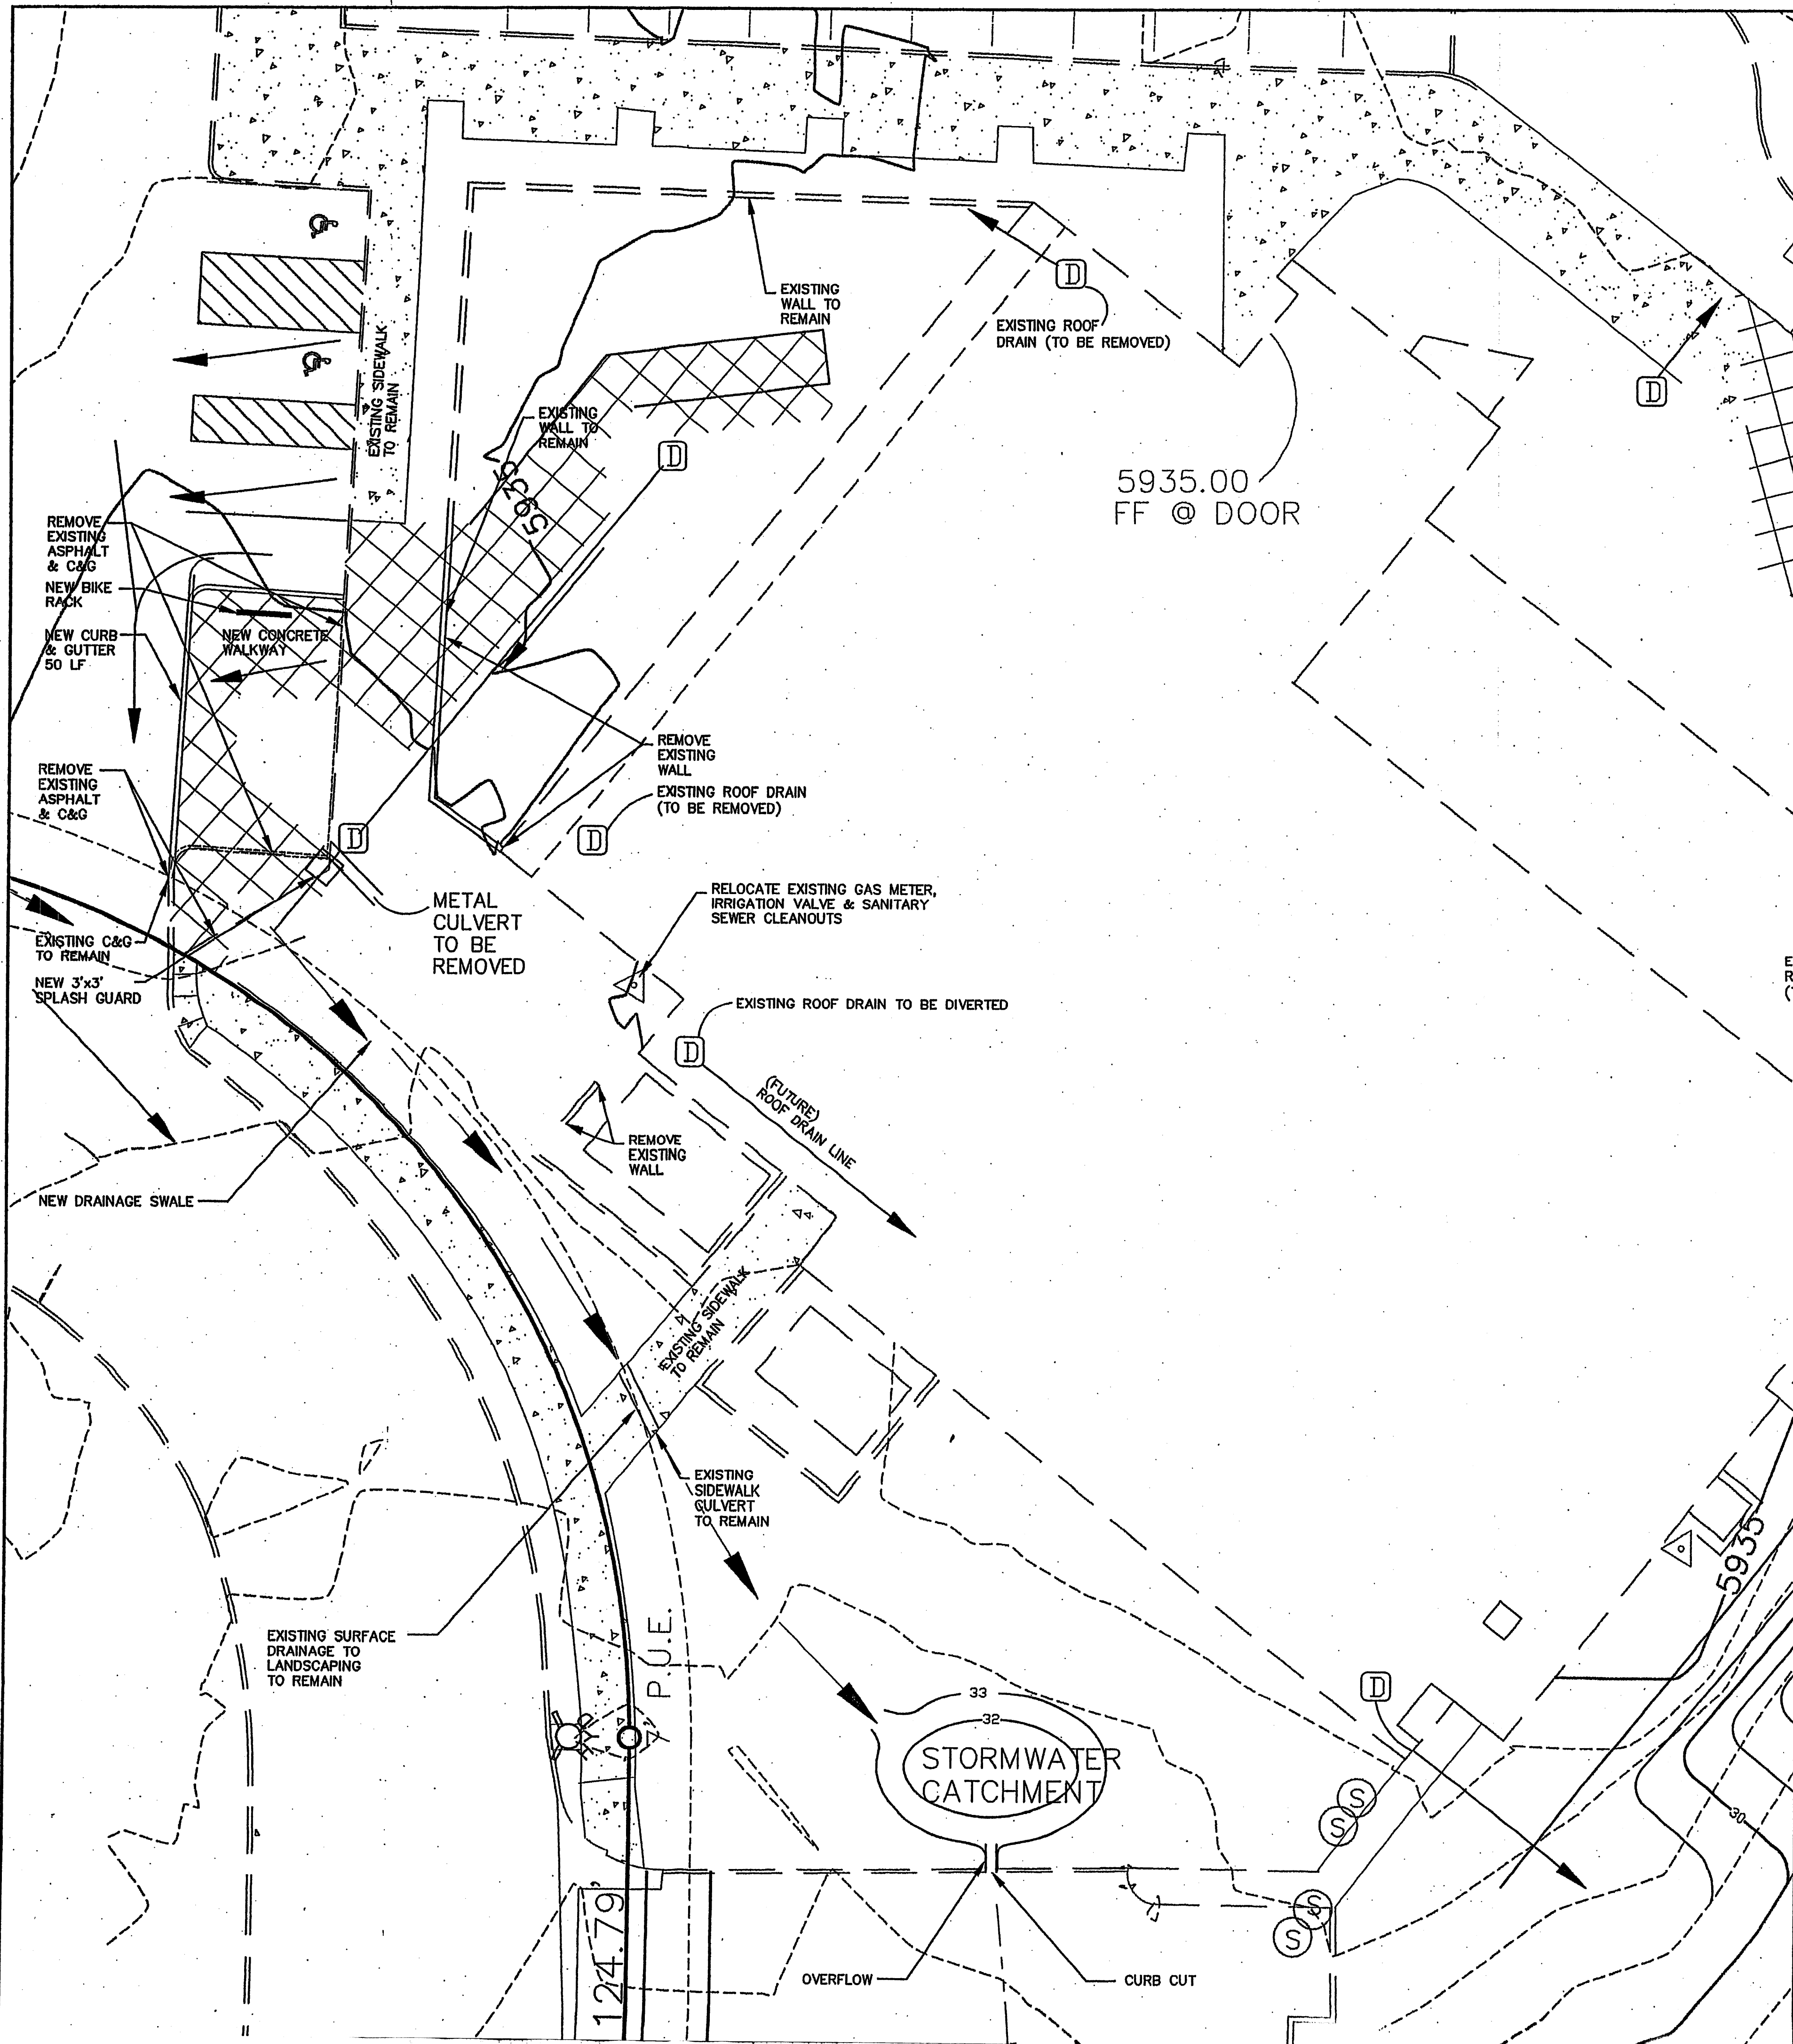

LEGEND

- DESIGNATES 5/8" REBAR WITH YELLOW CAP MARKED
LS 7429 SET THIS SURVEY
- DESIGNATES POINTS FOUND, USED AS NOTED
- ⊙ DESIGNATES ALBUQUERQUE CONTROL MONUMENT
- ⊙ DESIGNATES SANITARY SEWER MANHOLE
- OHE— DESIGNATES OVERHEAD POWERLINE
- UG— DESIGNATES UNDERGROUND POWERLINE
- DESIGNATES CHAINLINK FENCE
- TELEPHONE PEDESTAL
- △ POWER POLE
- △ GAS METER
- ELECTRIC METER
- CATV PEDESTAL
- WATER METER
- ⊙ SEWER CLEAN-OUT
- ⊙ FIRE HYDRANT
- ⊙ LIGHT POLE
- ⊙ BUILDING ROOF DRAIN
- ⊙ ELECTRIC TRANSFORMER
- ⊙ EXISTING TOP OF CURB
- DRAINAGE FLOW DIRECTION

CONSTRUCTION NOTES:

THE DESIGN OF PLANTERS AND LANDSCAPED AREAS IS NOT PART OF THIS PLAN. ALL PLANTERS AND LANDSCAPED AREAS ADJACENT TO THE BUILDING(S) SHALL BE PROVIDED WITH POSITIVE DRAINAGE TO AVOID AND PONDING ADJACENT TO THE STRUCTURE. FOR CONSTRUCTION DETAILS, REFER TO LANDSCAPING PLAN.

BACKFILL COMPACTION SHALL BE ACCORDING TO ALBUQUERQUE CITY STANDARD FOR RESIDENTIAL STREET USE.

MAINTENANCE OF THESE FACILITIES SHALL BE THE RESPONSIBILITY OF THE OWNER OF THE PROPERTY SERVED.

ALL CONSTRUCTION WITHIN PUBLIC RIGHT-OF-WAYS SHALL BE PERFORMED IN ACCORDANCE WITH APPLICABLE CITY OF ALBUQUERQUE STANDARDS AND PROCEDURES.

ALL WORK ON THIS PROJECT SHALL BE PERFORMED IN ACCORDANCE WITH APPLICABLE FEDERAL, STATE AND LOCAL LAWS, RULES AND REGULATIONS CONCERNING CONSTRUCTION SAFETY AND HEALTH.

PRIOR TO CONSTRUCTION, THE CONTRACTOR SHALL EXCAVATE AND VERIFY THE HORIZONTAL AND VERTICAL LOCATION OF ALL POTENTIAL OBSTRUCTIONS. SHOULD A CONFLICT EXIST, THE CONTRACTOR SHALL NOTIFY THE ENGINEER IN WRITING SO THAT THE CONFLICT CAN BE RESOLVED WITH A MINIMUM AMOUNT OF DELAY. THE CONTRACTOR SHALL BE RESPONSIBLE FOR ALL INTERPRETATIONS IT MAKES WITHOUT FIRST CONTACTING THE ENGINEER AS REQUIRED ABOVE.

TWO (2) WORKING DAYS PRIOR TO ANY EXCAVATION, CONTRACTOR MUST CONTACT NEW MEXICO ONE CALL SYSTEM 280-1990 (ALBUQUERQUE AREA), 1-800-321-ALERT(2537) (STATEWIDE), FOR LOCATION OF EXISTING UTILITIES.

IF ANY UTILITY LINES, PIPELINES OR UNDERGROUND UTILITY LINES ARE SHOWN ON THESE DRAWINGS, THEY ARE SHOWN IN APPROXIMATE MANNER ONLY AND SUCH LINES MAY EXIST WHERE NONE ARE SHOWN. IN ANY SUCH EXISTING LINES ARE SHOWN, THE LOCATION IS BASED UPON INFORMATION PROVIDED BY THE OWNER OF SAID UTILITY AND THE INFORMATION MAY BE INCOMPLETE OR MAY BE OBSOLETE BY THE TIME CONSTRUCTION COMMENCES. THE ENGINEER HAS CONDUCTED ONLY PRELIMINARY INVESTIGATION OF THE LOCATION, DEPTH, SIZE OR TYPE OF EXISTING UTILITY LINE, PIPELINES OR UNDERGROUND UTILITY LINES. THIS INVESTIGATION IS NOT CONCLUSIVE AND MAY NOT BE COMPLETE. THEREFORE, MAKES NO REPRESENTATION PERTAINING THERETO AND ASSUMES NO RESPONSIBILITY OR LIABILITY THEREOF. THE CONTRACTOR SHALL INFORM ITSELF IF NOT BE COMPLETE, THEREOF MAKES NO REPRESENTATION PERTAINING THERETO AND ASSUMES NO RESPONSIBILITY OR LIABILITY THEREOF. THE CONTRACTOR SHALL INFORM ITSELF OF THE LOCATION OF ANY UTILITY LINE, PIPELINE OR UNDERGROUND UTILITY LINE IN OR NEAR THE AREA OF THE WORK IN ADVANCE OF AND DURING EXCAVATION WORK. THE CONTRACTOR IS FULLY RESPONSIBLE FOR ANY AND ALL DAMAGE CAUSED BY ITS FAILURE TO LOCATE, IDENTIFY AND PRESERVE AND ALL EXISTING UTILITIES, PIPELINES AND UNDERGROUND UTILITY LINE. IN PLANNING AND CONDUCTING EXCAVATION, THE CONTRACTOR SHALL COMPLY WITH STATE REGULATION, IF ANY, PERTAINING TO THE LOCATION OF THESE LINES AND FACILITIES.

DRAINAGE CONTROL MEASURES:

THE CONTRACTOR SHALL ENSURE THAT NO SOIL ERODES FROM THE SITE INTO PUBLIC RIGHT OF WAY OR ONTO PRIVATE PROPERTY.

THE CONTRACTOR SHALL PROMPTLY CLEAN UP ANY MATERIAL EXCAVATED WITHIN THE PUBLIC RIGHT OF WAY SO THAT THE EXCAVATED MATERIAL IS NOT SUSCEPTIBLE TO BEING WASHED DOWN THE STREET.


THE CONTRACTOR SHALL SECURE "TOPSOIL DISTURBANCE PERMIT" PRIOR TO BEGINNING CONSTRUCTION.

ANY AREAS OF EXCESS DISTURBANCE (TRAFFIC ACCESS, STORAGE YARD, EXCAVATED MATERIAL, ETC.) SHALL BE RE-SEEDING ACCORDING TO C.O.A. SPECIFICATION 1012 "NATIVE GRASS SEEDING".

SURVEYOR'S CERTIFICATE

I HEREBY CERTIFY THAT THIS TOPOGRAPHIC SURVEY MEETS THE MINIMUM STANDARDS OF THE UNITED STATES NATIONAL MAP ACCURACY STANDARDS AND WAS COMPLETED BY ME OR UNDER MY DIRECT SUPERVISION, UTILIZING CITY OF ALBUQUERQUE MONUMENTATION. FIELD SURVEYING WAS COMPLETED UTILIZING GLOBAL POSITIONING SYSTEM SURVEYING EQUIPMENT WITH ACTUAL GROUND ELEVATION, EXISTING STRUCTURES AND UTILITIES AS SHOWN.


RICHARD BORGER
NMRPLS NO. 7429

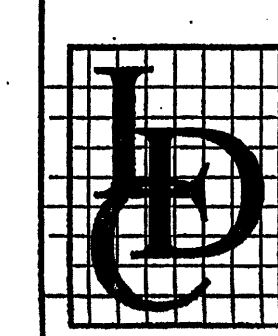

LAND DEVELOPMENT CONSULTANTS IIc
AN ASSOCIATE FIRM OF WILLIAMS & BECK Inc.
PROFESSIONAL CIVIL ENGINEERS,
ENVIRONMENTAL ENGINEERS
& LAND SURVEYORS
5620 B. SAN FRANCISCO DRIVE NE,
ALBUQUERQUE, NEW MEXICO 87109
PHONE: (505) 797-4120 FAX: (505) 821-0392
E-MAIL: ldc_11c@msn.com

DORMAN and BREEN
RICHARD DORMAN F.A.I.A.
LAURENCE BREEN F.A.I.A.
ALBUQUERQUE, NM 505-298-5940 SANTA FE, NM 505-982-9196

**Tramway Community Church
Addition and Remodel
4800 Tramway Ridge Dr N E
Albuquerque, New Mexico**

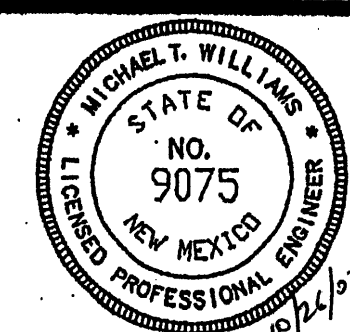

SHEET TITLE:

**GRADING &
DRAINAGE
DETAIL 2**

JOB NUMBER:
0406

DATE:
05/23/07

REVISIONS: DATE:
A. Revised/DRB Review 5/23/07

SHEET:

C-1.7

SUBDIVISION DATA:

1. PRIOR DRB CASE #97-267
2. PRIOR EPC CASE #2-97-27
3. NEW EPC CASE #07EPC00441/00443
4. ZONE ATLAS MAP #22-2
5. CURRENT ZONING SU-1 (OFFICE, INSTITUTIONAL & COMMERCIAL)

THIS PROPERTY DOES NOT FALL WITHIN A FLOOD PLAIN. PER FLOOD PANEL INSURANCE RATE MAP, COMMUNITY PANEL #0163F DATED NOV. 19, 2003

BUILDING AREA SUMMARY

LOT AREA 3.9380 ACRES OR 171,539.28 s.f.

PHASED BUILDING AREA/GROSS FIRST FLOOR AREAS (FOOTPRINT)

EXISTING PHASE I 15,305 s.f.
PHASE I 5,812 s.f.
PHASE II 2,043 s.f.
PHASE III 1,200 s.f.
PHASE IV 12,151 s.f.
TOTAL 36,511 s.f.

SECOND FLOOR AREA
EXISTING 2,943 s.f.
PHASE I 6,430 s.f.
TOTAL 9,373 s.f.

GARDEN LEVEL AREA
PHASE I 12,300 s.f.
TOTAL AREA 68,184 s.f.

MAXIMUM PLANNED BUILDING TO LOT DENSITY = 21.2 %
FAR=0.34

Tramway Boulevard NE

Right of Way Varies

DRAWING INDEX

- C-1 SITE DEVELOPMENT PLAN FOR SUBDIVISION & BUILDING PERMIT
- C-2 GRADING & DRAINAGE
- C-2.1 DRAINAGE PLANS AND CALCULATIONS
- C-3 STORM WATER MANAGEMENT PLAN
- C-4 UTILITY PLAN
- A-1.0 EXTERIOR ELEVATIONS
- LS-02 LANDSCAPE PLAN

Project Number: 1004735

Application Number: 07DRB-70022 + 70023

This plan is consistent with the specific Site Development Plan approved by the Environmental Planning Commission (EPC), dated May 17, 2007 and the Findings and Conditions in the Official Notification of Decision are satisfied.

Is an Infrastructure List Required? () Yes ☒ No
If yes, then a set of approved DRC plans with a work order is required for any construction within Public Right-of-Way or for construction of public improvements.

Traffic Engineering/Transportation Division Date 6-13-07
Water Utility Department Date 6-13-07
Parks and Recreation Department Date 6-13-07
City Engineer Date 6-13-07
Environmental Health Department (conditional) Date
Solid Waste Management Date 6/11/07
DRB Chairperson/Planning Department Date 6/13/07

LEGEND

- DESIGNATES 5/8" REBAR WITH YELLOW CAP MARKED LS 7429 SET THIS SURVEY
- DESIGNATES POINTS FOUND, USED AS NOTED
- DESIGNATES ALBUQUERQUE CONTROL MONUMENT
- DESIGNATES SANITARY SEWER MANHOLE
- DESIGNATES OVERHEAD POWERLINE
- DESIGNATES UNDERGROUND POWERLINE
- DESIGNATES CHAINLINK FENCE
- TELEPHONE PEDESTAL
- POWER POLE
- GAS METER
- ELECTRIC METER
- CATV PEDESTAL
- WATER METER
- SEWER CLEAN-OUT
- FIRE HYDRANT
- LIGHT POLE
- BUILDING ROOF DRAIN
- ELECTRIC TRANSFORMER

TOP OF CURB

APPROVED/DISAPPROVED

HYDRANT(S) ONLY

SIGNATURE & DATE

PROJECT # 1004735

DRB # 07DRB 70022

DRB # 07DRB 70023

DATE: APRIL 2007

SHEET NO. C-1

DRAWN BY: CW

JUL 23 2008

HYDROLOGY SECTION

LAND DEVELOPMENT CONSULTANTS, LLC

An Associated Firm of Williams & Beck, Inc.

5620 B. SAN FRANCISCO DRIVE NE,

ALBUQUERQUE, NEW MEXICO 87109

PHONE: (505) 797-4120 FAX: (505) 821-0392

E-MAIL: lde_jl@lmc.com


PROJECT FOR:

TRAMWAY COMMUNITY CHURCH

ADDITION AND REMODEL

4800 TRAMWAY RIDGE DR. NE

ALBUQUERQUE NEW MEXICO 87111

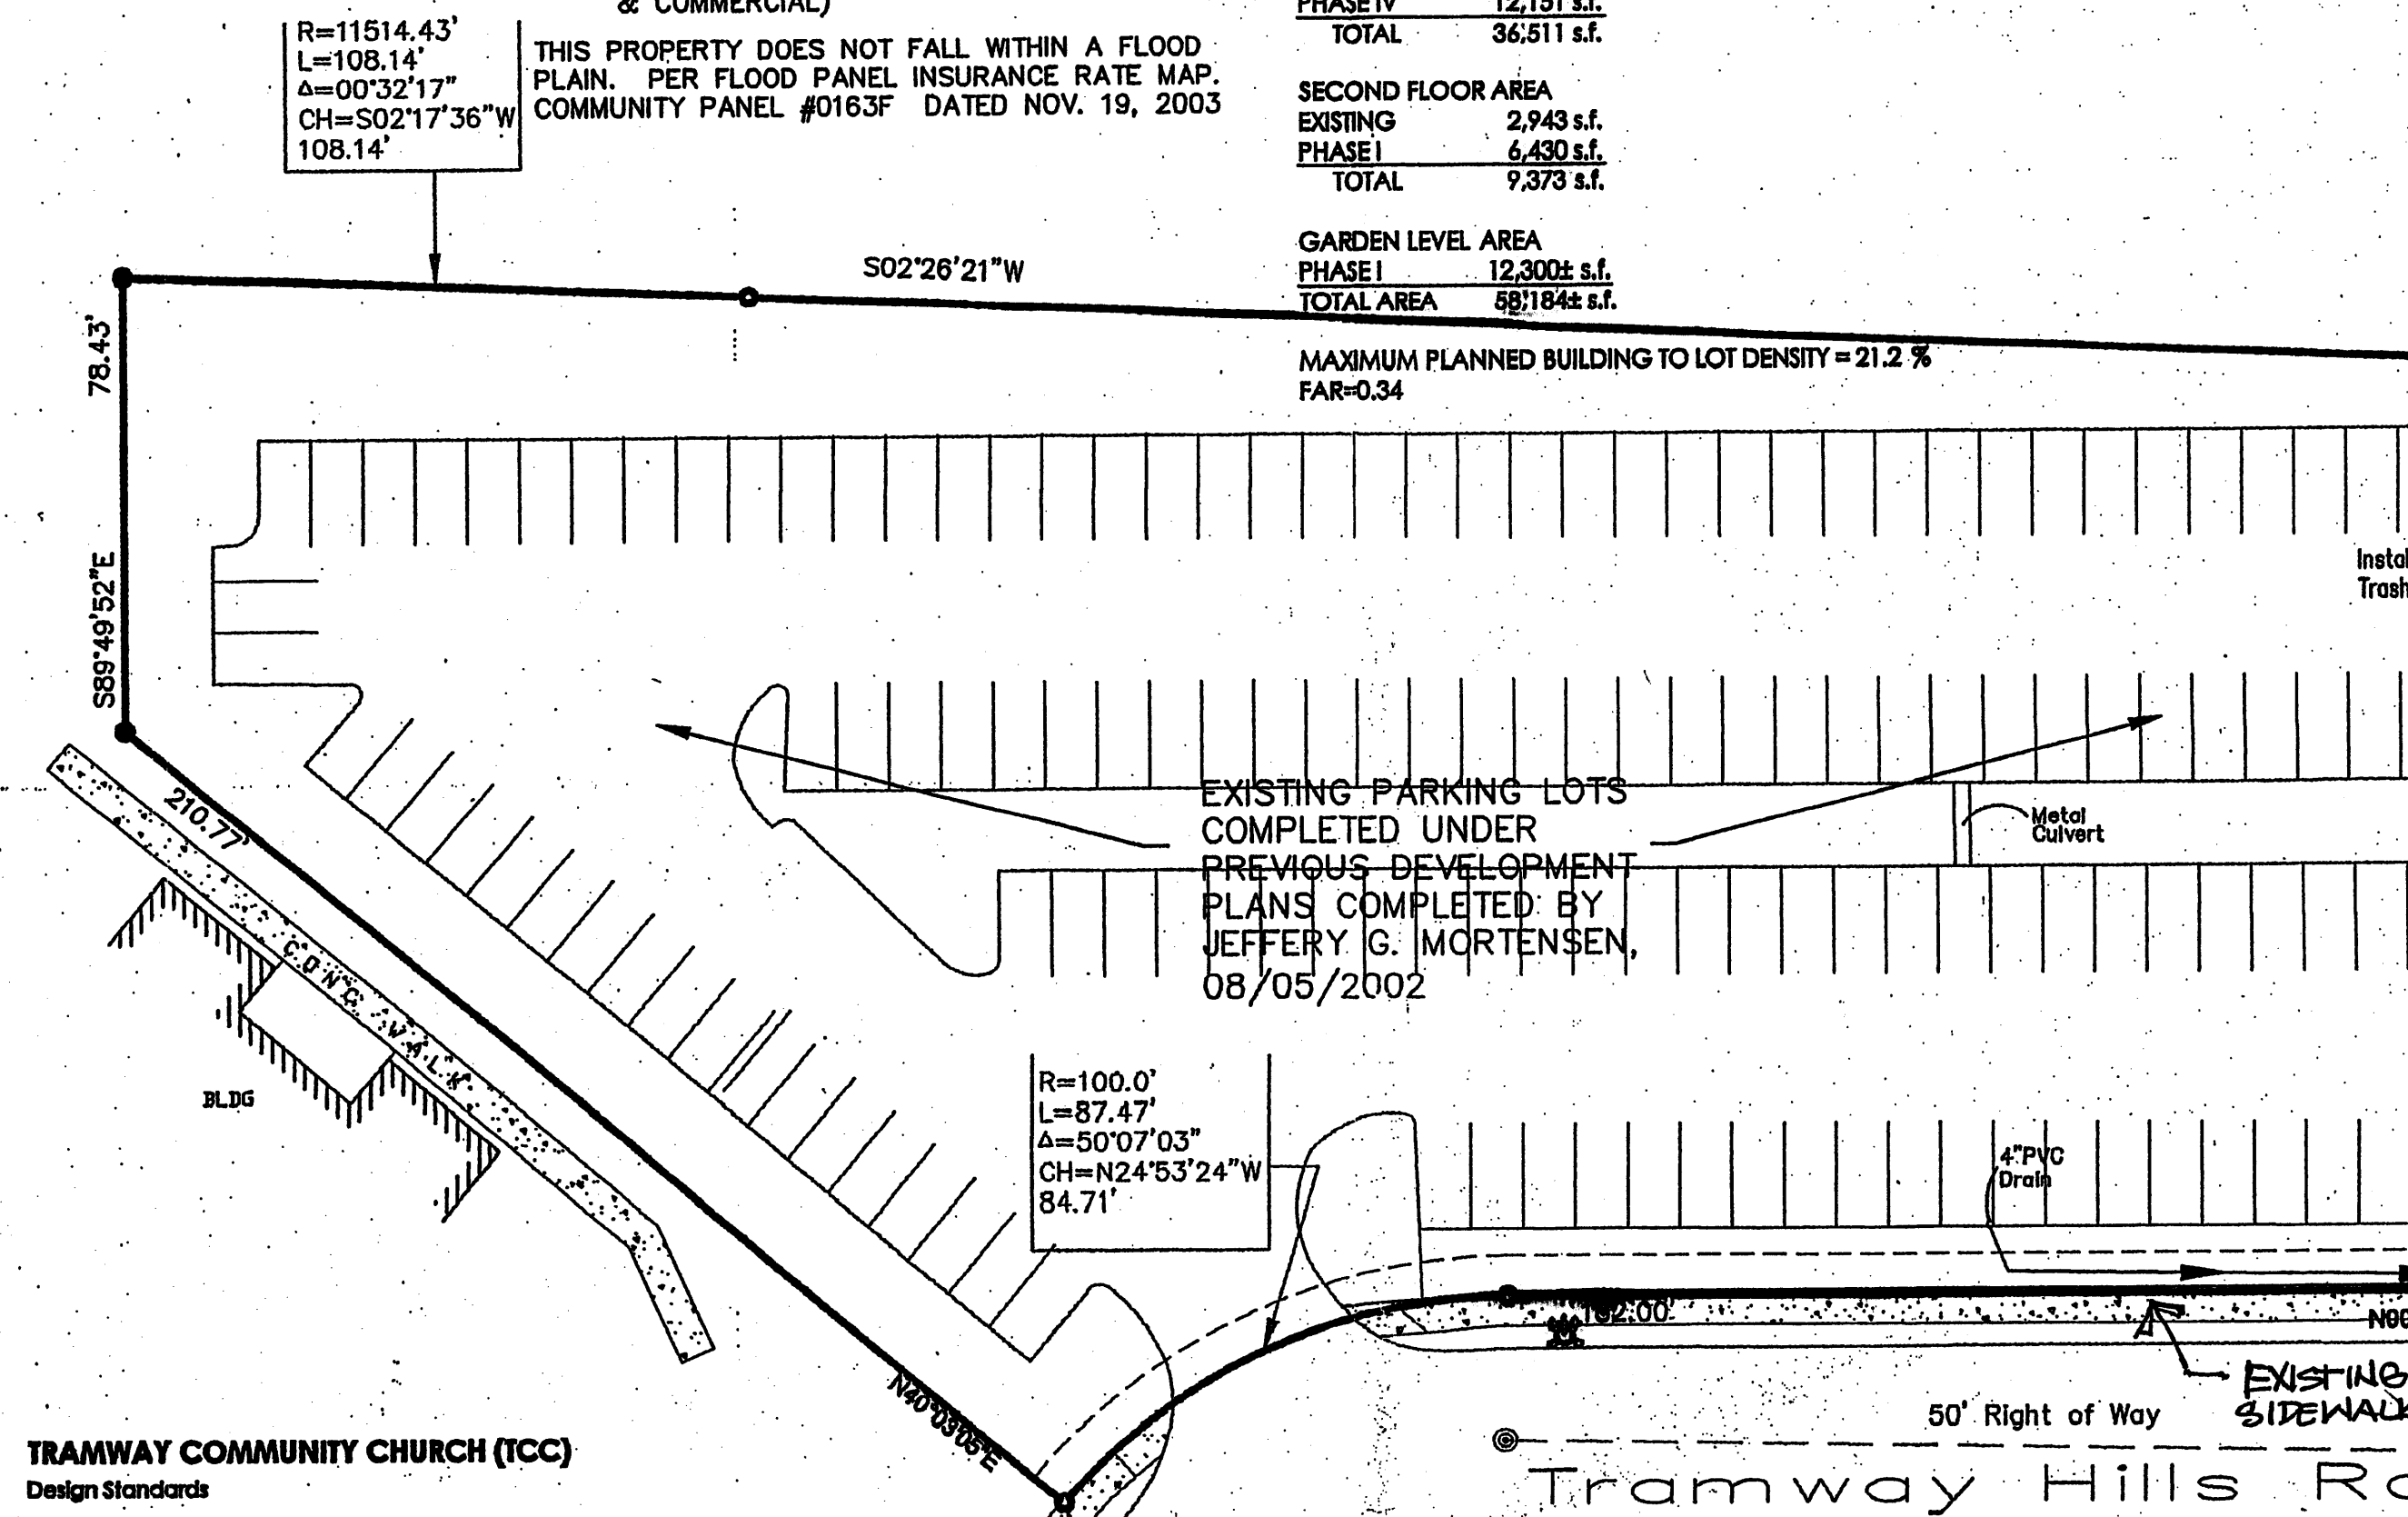

TRAMWAY COMMUNITY CHURCH (TCC)

Design Standards

Intentions

These design standards have been set forth as a statement for the City of Albuquerque Environmental Planning Commission to allow delegation for administrative approval of future phases to the existing Tramway Community Church site and building. These standards are to maintain the architectural and landscaping style, elements, masonry, finishes, materials, colors, textures and pedestrian circulation, lighting, and signage. By applying these standards, it ensures that future phases maintain the same high quality and visual appearance as to that which exists.

Section A - Architectural Standards

The existing building design is classified as a contemporary style with low-angled pitched and flat roofs. Elements of future building design shall be:

- Cementitious or synthetic finish to match existing
- Earth tone colors for cementitious or synthetic finish
- Clear and/or tinted glazing to match existing
- Aluminum storefront in profile and color to match existing
- Metal roofing to match existing profile and color
- Colored or textured concrete

The maximum building height shall be 40 feet of the ridge line above the existing ground floor of elevation 5935.5' as approved in 1997 for this facility in case 2-97-27 and DRB# 97-267.

The maximum floor area ratio shall be 0.4 as stated in case 2-97-27 and DRB# 97-267.

Section B - Screening and Walls/Fences Standards

The following items shall be screened from view by architectural elements or landscaping elements and of sufficient height to conceal from pedestrian view:

- Mechanical equipment
- Trash storage
- Material storage

Screening and walls/fences shall be constructed only of the following materials:

- Decorative masonry units
- Concrete masonry units with earth tone cementitious or synthetic finish
- Cedar fencing
- Coyote fencing

Section C - Landscaping Standards

All landscaping shall be done of the same type of plants and materials to match:


- Plant species
- Mulching
- Density
- Plant size, new planting to be minimum size per industry standards with maturity to match existing.
- Walls, benches, planters, railings, etc.

The following is the plant palette:

BOTANICAL NAME	COMMON NAME
<i>Rubia ambigua</i>	Purple robe locust
<i>Gleditsia triacanthos</i>	Honey Locust
<i>Forsythia viridissima</i>	New Mexico olive
<i>Chilopsis linearis</i>	Desert willow
<i>Pinus edulis</i>	Pinon pine
<i>Elaeagnus pungens</i>	Silverberry
<i>Shrubs</i>	
<i>Coloreaster glaucophyllus</i>	Gray cotoneaster
<i>Chrysothamnus nauseosus</i>	Chamisa
<i>Folgia parvifolia</i>	Apache plume
<i>Pinus flexilis</i>	Three leaf sumac
<i>Spartium junceum</i>	Sprinklebroom
<i>Caryopteris cloniformis</i>	Blue mist
<i>Perovskia atriplicifolia</i>	Russian sage
<i>Rosa rugosa</i>	Rosemary
<i>Rapistrum indicum</i>	Indian Hawthorn
<i>Alfalfa strans</i>	Golden grass
<i>Hesperaloe parviflora</i>	Red yucca
<i>Lavandula angustifolia</i>	English lavender
<i>Pinus jeffreyi</i>	Scout pine
<i>Potentilla fruticosa</i>	Shrubby cinquefoil
<i>Artemisia</i>	Big sage

All planting shall be done in accordance with City of Albuquerque Landscaping Regulations and per those indicated on the submitted Landscape Plan.

Street trees for future phases will be installed with that phase. Until that time, the landscaping shall remain native planting per current conditions.

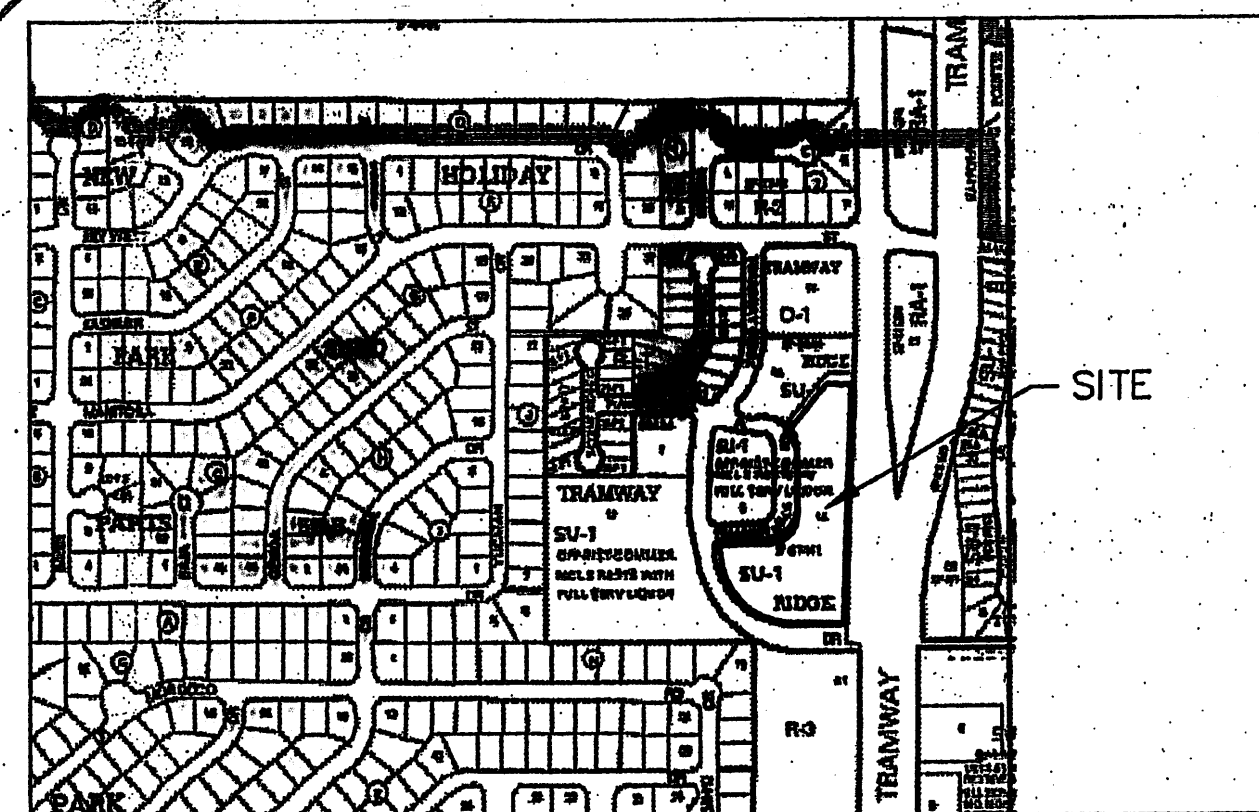

VICINITY MAP SCALE 1"=5'

The landscaping theme shall use existing plant types that are currently on site. High water using plants from the existing planting palette shall be substituted with low water use plants. Native plants shall be used in undeveloped areas to match existing planting.

Section D - Parking & Circulation

The current parking count is 221 spaces which permits a seating capacity of 884 based on the current City Parking Regulations of one space for each 4 seats of Sanatorium. Current seating is approximately 300 seats. Future phases shall be designed in conjunction with the number of parking spaces.

Current vehicular circulation onto the site is from 4 entrances/exits. The main entrance is off of Tramway Ridge Drive NE. This entrance is approximately 180 feet from Tramway Boulevard NE. Existing secondary entrance/exits are along Tramway Hills Road NE. The Western most entrance/exit is a single parking lot. Two other entrance/exits are located along the Eastern side of Tramway Hills Road NE. None of the future phases shall modify the entrances/exits.

Existing pedestrian circulation pattern is from the parking area North of the facility to the East side of the building. This pattern will change very little as the main entrance to the facility will remain in the vicinity of the current location. Pedestrian circulation pattern in the future shall be maintained by the use of sidewalks, landscaping, and other amenities to direct the pedestrian to the entrance(s).

Section E - Lighting

Existing parking lot lighting consists of 28' tall pole lights with 'shoebox' fixtures. All future parking lot pole lights shall match the existing pole lights in appearance, style, color, and to be limited to a maximum height of 20 feet from top of grade.

Additional exterior lighting shall consist of:

- Bollards along pedestrian pathways
- Wall sconces/pots on the building
- Under rafter lighting at entrances and/or architectural features
- Ground uplighting

All new lighting shall be designed in accordance with the State of New Mexico Dark Sky Regulations.

Section F - Signage

All new signage shall be consistent with existing signage. All current signage complies and shall comply with City of Albuquerque Signage Ordinance. Signage changes shall be submitted to the City for approval and permitting.

A monument sign shall be located at the main entry off of Tramway Ridge Drive NE. No monument signage is planned for future phases.

Existing building signage is comprised of individual, metal letters. Existing building signage shall be removed and relocated on new phase. Future building signage shall match existing in type and color. All signage shall comply with City of Albuquerque Signage Ordinance.

Existing sign is approximately 6'-4" long, 8'-4" high and 2'-8" wide of masonry construction. Finish is stucco of same material and color as main building. Incorporated on both sides of the sign is the Church logo and name.

PLAT OF LOT 1-A BEING A REPLAT OF LOTS 1, 2, 3-A & 6 OF TRAMWAY RIDGE WITHIN THE ELENA GALLEGOS GRANT PROJECTED SECTION 34, T11N., R4E., N.M.P.M AS RECORDED IN THE RECORDS OF BERNALILLO COUNTY CLERKS OFFICE, VOLUME 97C FOLIO 217

BEARINGS ARE NEW MEXICO STATE PLANE GRID BEARINGS (CENTRAL ZONE)

PLAT OF SURVEY PREPARED BY RICHARD V. HALL N.M.R.P.L.S. #7264 DATED 06/02/1997

CITY OF ALBUQUERQUE
"SOLID WASTE"
MANAGEMENT DEPARTMENT
APPROVED

30' 0' 30' 60'

SCALE: 1"=30'

RECEIVED
JUL 23 2008

LAND DEVELOPMENT CONSULTANTS, LLC
An Associated Firm of Williams & Beck, Inc.
5620 B. SAN FRANCISCO DRIVE NE,
ALBUQUERQUE, NEW MEXICO 87109
PHONE: (505) 797-4120 FAX: (505) 821-0392
E-MAIL: lde_jl@lmc.com

TITLE
SITE DEVELOPMENT PLAN FOR
SUBDIVISION & BUILDING PERMIT
CITY OF ALBUQUERQUE, BERNALILLO COUNTY, NEW MEXICO
PROJECT FOR:
TRAMWAY COMMUNITY CHURCH
ADDITION AND REMODEL
4800 TRAMWAY RIDGE DR. NE
ALBUQUERQUE NEW MEXICO 87111
JOB # 07-7001
DATE: APRIL 2007
DRAWN BY: CW
SHEET NO. C-1