



City of Albuquerque

P.O. BOX 1293 ALBUQUERQUE, NEW MEXICO 87103

July 8, 1994

Stephen L. Crawford
Community Sciences Corp.
P.O. Box 1328
Corrales, NM 87048

RE: REVISED ENGINEER CERTIFICATION FOR FAIRWAY MANOR UNIT 2
(G10-D3E) CERTIFICATION STATEMENT DATED 6/27/94.

Dear Mr. Crawford:

Based on the information provided on your June 27, 1994 resubmittal, the above referenced site acceptable for Financial Guarantee release and Engineer Certification.

If I can be of further assistance, please feel free to contact me at 768-2667.

Sincerely,

Bernie J. Montoya, CE
Engineering Associate

BJM/d1/WPHYD/436

c: Andrew Garcia
LyndaMichelle DeVanti
File



City of Albuquerque

P.O. BOX 1293 ALBUQUERQUE, NEW MEXICO 87103

December 14, 1993

Doug Hughes, P.E.
Community Sciences Corp.
P.O. Box 1329
Corrales, NM 87048

RE: DRAINAGE REPORT FOR FAIRWAY MANOR (G10-D3E) ENGINEER'S STAMP
DATED NOVEMBER 5, 1993 Project 4776.90.

Dear Mr. Hughes:

Based on the information provided on the referenced submittal received November 8, 1993, the report is acceptable for Work Order approval.

Please be advised that Work Order approval is required for the water block reconstruction at Vista Alegre Street. This reconstruction must also be certified as complete along with the subdivision prior to financial guarantee release.

If you should have any questions, please do not hesitate to call me at 768-2650.

Cordially,

Gilbert Aldaz, PE & PS
City/County Floodplain Administrator


xc: Alan Martinez
LyndaMichelle DeVanti, DRC
File

wp+436

PUBLIC WORKS DEPARTMENT

INLET CAPACITIES CALCULATIONS


- 1) DOUBLE "A", SINGLE GRATE, DOUBLE THROAT INLET NO. 102.2
SUMP CONDITION. STA. 2+22.44 "VISTA DEL SVR"

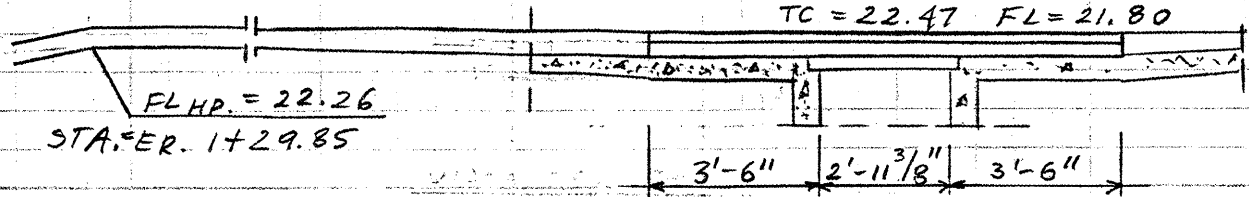

$$Q = CA \sqrt{2gH} \quad C = 0.66 \quad g = 32.2$$

$$EL. 22.26 \text{ CONTROLES.} \Rightarrow EL_{HP} = 22.26.$$

ELLP CALC.

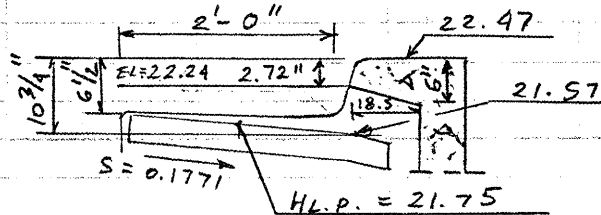

$$Q_{100} = 7.29 \text{ CFS}$$

$$Q_{DESIGN} = 7.29 / 2 = 3.65 \text{ CFS}$$

(ONE ON EACH SIDE OF ROAD)

$$H = EL_{HP} - ELLP = 22.26 - 21.75 = 0.51 \text{ LF.}$$

GRATE OPENING CALC.

$$A_{TOTAL} = 4.56 \text{ SF.}$$

$$A_{GRATE \text{ FRAME OBSTRUCTION}} = 0.46 \text{ SF}$$

$$A_{GRATE} = 4.56 - 0.46 = 4.10 \text{ S.F.}$$

OPTION NO. 1

USED 100% GRATE CAPACITY AND NO CURB
OPENING.

$$Q_1 = 0.66 \times 4.10 \times \sqrt{2 \times 32.2 \times 0.51} = 15.51 \text{ CFS}$$

OPTION NO. 2

USE 60% OF GRATE CAPACITY TO ACCOUNT FOR
CLOGGING AND CURB OPENING CAPACITY.
GRATE CAPACITY

$$Q_{GR} = 15.51 \times 0.6 = 9.31 \text{ CFS.}$$

CURB OPENING CAPACITY CALC.

$$L = 2'-11\frac{3}{8}" + (3'-6") \times 2 = 9.95 \text{ LF}$$

$$h = 22.47 - 21.57 - (2.72 : 12) = 0.67$$

$$A = 9.95 \times 0.67 = 6.67 \text{ S.F.}$$

$$H = 22.26 - (21.57 + 0.34) = 0.42$$

$$Q_{\text{CURB OP.}} = 0.66 \times 6.67 \times \sqrt{2 \times 32.2 \times 0.42} = 22.89 \text{ CFS.}$$

$$Q_2 = 9.31 + 22.89 = 32.20 \text{ CFS}$$


TAKE OPTION NO. 1.

TOTAL DOUBLE "A" INLET CAPACITY = 15.51 CFS.


INFLOW FROM "VISTA DEL SUR" IS $7.29 : 2 = 3.65 \text{ CFS}$ PER EACH STORM DRAIN INLET

(FLOW) 3.65 CFS < 15.51 CFS. (CAPACITY.)

- 2.) INLET 101.2 STA 15+46.02 "SAN BENITO ST."
INLET TYPE DOUBLE "C" - SUMP CONDITION

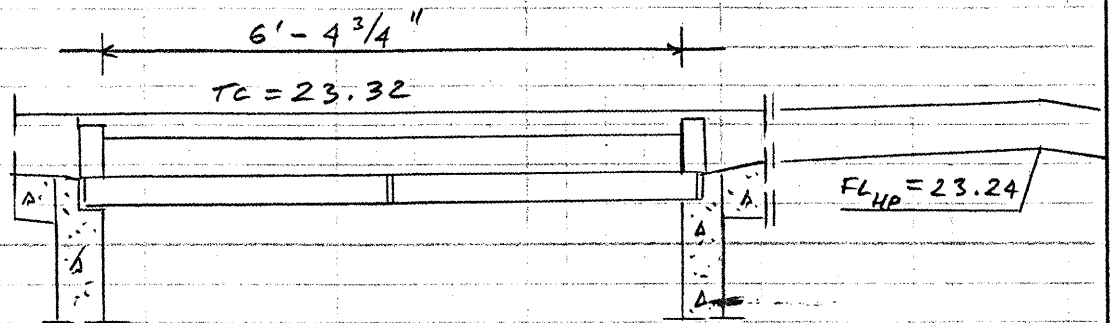

$$EL = 23.24 \text{ CONTROLS} \Rightarrow EL_{HP} = 23.24.$$

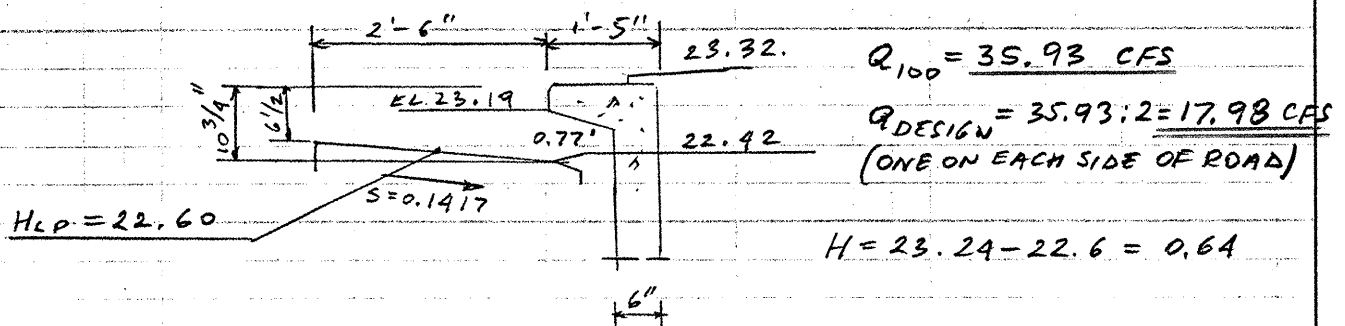

GRATE OPENING CALC.

$$A_{GRATE} = 4.10 \times 2 = 8.20 \text{ SF.}$$

OPTION 1

USED 100% GRATE CAPACITY AND NO CURB OPENING.

$$Q_1 = 0.66 \times 8.20 \sqrt{2 \times 32.2 \times 0.64} = 34.75 \text{ CFS.}$$

OPTION 2

USED 60% OF GRATE CAPACITY TO ACCOUNT FOR CLOGGING AND CURB OPENING CAPACITY.
GRATE CAP.

$$Q_{GR} = 34.75 \times 0.6 = 20.85 \text{ CFS.}$$

TOTAL FROM "SAN BENITO ST." IS $35.93 : 2 = 17.98 \text{ CFS}$

TAKE 60% OF GRATE CAPACITY W/O OPENING.

$$(FLOW) 17.98 \text{ CFS} < 20.85 \text{ CFS (CAPACITY)}$$

Outlet Structure File: FAIR .STR

POND-2 Version: 4.01
Date Executed: 11-09-1993

S/N: 88020607
Time Executed: 14:49:28

Outflow Rating Table for Structure #01
WEIR-XY Weir - Defined by X, Y Coordinates

***** INLET CONTROL ASSUMED *****

Elevation (ft)	Q (cfs)	Computation	Messages
22.16	0.0	E = Y min= 22.16	
22.19	0.0	W(ft)= 2.381	Max. D(ft)= .03
22.22	0.1	W(ft)= 4.762	Max. D(ft)= .06
22.25	0.2	W(ft)= 7.142	Max. D(ft)= .09
22.28	0.4	W(ft)= 9.523	Max. D(ft)= .12
22.31	0.6	W(ft)= 11.904	Max. D(ft)= .15
22.34	1.0	W(ft)= 14.285	Max. D(ft)= .18
22.37	1.5	W(ft)= 16.665	Max. D(ft)= .21
22.40	2.1	W(ft)= 19.046	Max. D(ft)= .24
22.43	2.8	W(ft)= 21.427	Max. D(ft)= .27
22.46	3.6	W(ft)= 23.808	Max. D(ft)= .3
22.49	4.6	W(ft)= 26.189	Max. D(ft)= .33
22.52	5.7	W(ft)= 28.569	Max. D(ft)= .36
22.55	6.9	W(ft)= 30.95	Max. D(ft)= .39
22.58	8.3	W(ft)= 33.331	Max. D(ft)= .42
22.61	9.9	W(ft)= 35.712	Max. D(ft)= .45
22.64	11.6	W(ft)= 38.092	Max. D(ft)= .48
22.67	13.6	W(ft)= 40.473	Max. D(ft)= .51
22.70	15.6	W(ft)= 42.854	Max. D(ft)= .54
22.73	18.3	W(ft)= 42.864	Max. D(ft)= .57
22.76	21.1	W(ft)= 42.873	Max. D(ft)= .6
22.79	24.1	W(ft)= 42.883	Max. D(ft)= .63
22.82	27.1	W(ft)= 42.892	Max. D(ft)= .66
22.85	30.3	W(ft)= 42.902	Max. D(ft)= .69
22.88	33.6	W(ft)= 42.911	Max. D(ft)= .72
22.91	37.1	W(ft)= 42.921	Max. D(ft)= .75
22.94	40.6	W(ft)= 42.93	Max. D(ft)= .78
22.97	44.2	W(ft)= 42.94	Max. D(ft)= .81
23.00	48.0	W(ft)= 42.949	Max. D(ft)= .84
23.03	51.8	W(ft)= 42.959	Max. D(ft)= .87
23.06	55.7	W(ft)= 42.968	Max. D(ft)= .9
23.09	59.8	W(ft)= 42.978	Max. D(ft)= .93
23.12	63.9	W(ft)= 42.987	Max. D(ft)= .96
23.15	68.1	W(ft)= 42.997	Max. D(ft)= .99
23.16	0.0	E = or > E2=23.16	

Wier Capacity
at Cul de sac
entrance
 $Q_{100} = 43.25 \text{ cfs}$

Outlet Structure File: FAIR .STR

POND-2 Version: 4.01

S/N: 88020607

Date Executed: 11-09-1993

Time Executed: 14:49:28

>>>>> Structure No. 01 <<<<<
(Input Data)

WEIR-XY

Weir - Defined by X, Y Coordinates

E1 (ft) =22.16 E2 (ft) =23.16

X dist.(ft)	Y elev.(ft)
-----	-----
0	23.16
.1	22.7
42.9	22.16
43	23.16

DRAINAGE COVENANT

This Drainage Covenant, between Fairway Manor Limited Partnership
a New Mexico Limited Partnership
("Owner"), whose address is 6400 Uptown #200 W, Albuquerque, NM 87110, and
the City of Albuquerque, New Mexico municipal corporation ("City"), whose
address is P.O. Box 1293, Albuquerque, New Mexico 87103, is made in
Albuquerque, Bernalillo County, New Mexico and is entered into as of the date
Owner signs this Covenant.

1. Recital. Owner is the owner of certain real property described as:
Tract X, El Rancho Atrisco North
in Bernalillo County, New Mexico (the "Property").

Pursuant to City ordinances, regulations and other applicable laws, the
Owner is required to construct and maintain certain Drainage Facilities on the
Property, and the parties wish to enter into this Agreement to establish the
obligations and responsibilities of the parties.

2. Description and Construction of Drainage Facilities. Owner shall
construct the following "Drainage Facility" within the Property at Owner's
sole expense in accordance with the standards, plans and specifications
approved by the City pursuant to Drainage File No. G10/D3-E:
Temporary Desiltation Pond, Deversion Berm & Inlet Control Structure as shown on
Sheets 5 & 11 of City Proj. #4776.90

The Drainage Facility is more particularly described in the attached
Exhibit A. The Owner will not permit the Drainage Facility to constitute a
hazard to the health or safety of the general public.

3. Maintenance of Drainage Facility. The Owner will maintain the Drainage
Facility at Owner's cost in accordance with the approved Drainage Report and
plans.

4. City's Right of Entry. The City has the right to enter upon the
Property at any time and perform whatever inspection, maintenance or repair of
the Drainage Facility it deems appropriate, without liability to the Owner.

5. Demand for Construction or Repair. The City may send written notice
("Notice") to the Owner requiring the Owner to construct or repair the
Drainage Facility within 60 days ("Deadline") of receipt of the Notice, as
provided in Section 11, and the Owner will comply promptly with the
requirements of the Notice. The Owner will perform all required work by the
Deadline, at Owner's sole expense.

6. Failure to Perform by Owner and Emergency Work by City. If the Owner
fails to comply with the terms of the Notice by the Deadline, or if the City
determines that an emergency condition exists, the City may perform the work
itself. The City may assess the Owner for the cost of the work and for any
other expenses or damages which result from Owner's failure to perform. The
Owner agrees promptly to pay the City the amount assessed. If the Owner fails
to pay the City within thirty (30) days after the City gives the Owner written
notice of the amount due, the City may impose a lien against Owner's Property
for the total resulting amount.

(Approved by Legal Dept.
as to form only 06/90)

7. Liability of City for Repair after Notice or as a Result of Emergency. The City shall not be liable to the Owner for any damages resulting from the City's repair or maintenance following notice to the Owner as required in this agreement or in an emergency unless the damages are the result of the reckless conduct or gross negligence of the City.

8. Indemnification. Owner agrees to indemnify and save the City, its officials, agents and employees harmless from all claims, actions, suits and proceedings arising out of or resulting from the Owner's negligent maintenance, construction, repair or use of the Drainage Facility. To the extent, if at all, Section 56-7-1 NMSA 1978 is applicable to this Agreement, this Agreement to indemnify will not extend to liability, claims, damages, losses or expenses, including attorney's fees, arising out of (1) the preparation or approval of maps, drawings, opinions, reports, surveys, change orders, designs or specifications by the indemnitee, or the agents or employees of the indemnitee; or (2) the giving of or the failure to give direction or instructions by the indemnitee, where such giving or failure to give directions or instructions is the primary cause of bodily injury to persons or damage to property.

9. Cancellation of Agreement and Release of Covenant. This Agreement may be released if the Drainage Facility is no longer required for the protection of the public health, safety and welfare by the City filing a "Notice of Release" with the Bernalillo County Clerk. The Notice of Release must be signed by the City's Chief Administrative Officer, or his designee, and the approval of the City Hydrologist must be endorsed thereon.

10. Assessment. Nothing in this agreement shall be construed to relieve the Owner, his heirs, assigns, and successors from an assessment against Owner's Property for improvements to the property under a duly authorized and approved Special Assessment District. The parties specifically agree that the value of the Drainage Facility will not reduce the amount assessed by the City.

11. Notice. For purposes of given formal written notice to the Owner, Owner's address is:

6400 Uptown Blvd, Suite 200 W
Albuquerque, NM 87110

Notice may be given to the Owner either in person or by mailing the notice by regular U.S. mail, postage paid. Notice will be considered to have been received by the Owner within three days after the notice is mailed if there is no actual evidence of receipt. The Owner may change Owner's address by given written notice of the change by Certified Mail, return receipt requested, to the City Public Works Department, P.O. Box 1293, Albuquerque, New Mexico, 87103.

12. Term. This Agreement shall continue until terminated by the City pursuant to Section 9 above.

(Approved by Legal Dept.
as to form only 06/90)

13. Binding on Owner's Property. The covenants and obligations of the Owner said forth herein shall be binding on Owner, its heirs, personal representatives, assigns and successors and on Owner's Property and shall constitute covenants running the Owner's Property until released by the City.

14. Entire Agreement. This Agreement contains the entire agreement of the parties and supercedes any and all other agreements or understanding, oral or written, whether previous to the execution hereof or contemporaneous herewith regarding this subject matter.

15. Changes to Agreement. Changes to this Agreement are not binding unless made in writing, signed by both parties.

16. Construction and Severability. If any part of this Agreement is held to be invalid or unenforceable, the remainder of the Agreement will remain valid and enforceable if the remainder is reasonably capable of completion.

17. Captions. The captions to the sections or paragraphs of this Agreement are not part of this Agreement and will not affect the meaning or construction of any of its provisions.

OWNER: Fairway Manor Limited Partnership
By Argus Development Company
Its General Partner
By: Ben F. Spencer
Its: President, Argus Development
Dated: 11-11-93

STATE OF NEW MEXICO)
) ss
COUNTY OF SANDOVAL)

The foregoing instrument was acknowledged before me this 11TH day of NOVEMBER, 1993, [by name of person:] Ben F. Spencer, [title or capacity, for instance "president" or "owner":] * of [Subdivider:] Fairway Manor Limited Partnership.

* President of Argus Development Co., Inc.
General Partner


[Signature]
Notary Public

My Commission Expires:
3-25-97

CITY OF ALBUQUERQUE:

Approved:

By: _____
Title: _____
Dated: _____

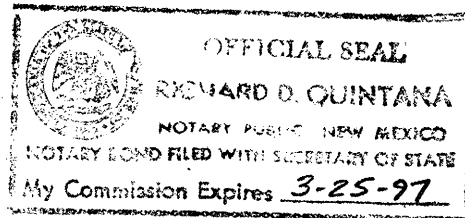

(EXHIBIT A ATTACHED)

(Approved by Legal Dept.
as to form only 06/90)

UNIT TWO


UNIT ONE

AMAFCA RINCONADA CHANI

5125

5120

5130

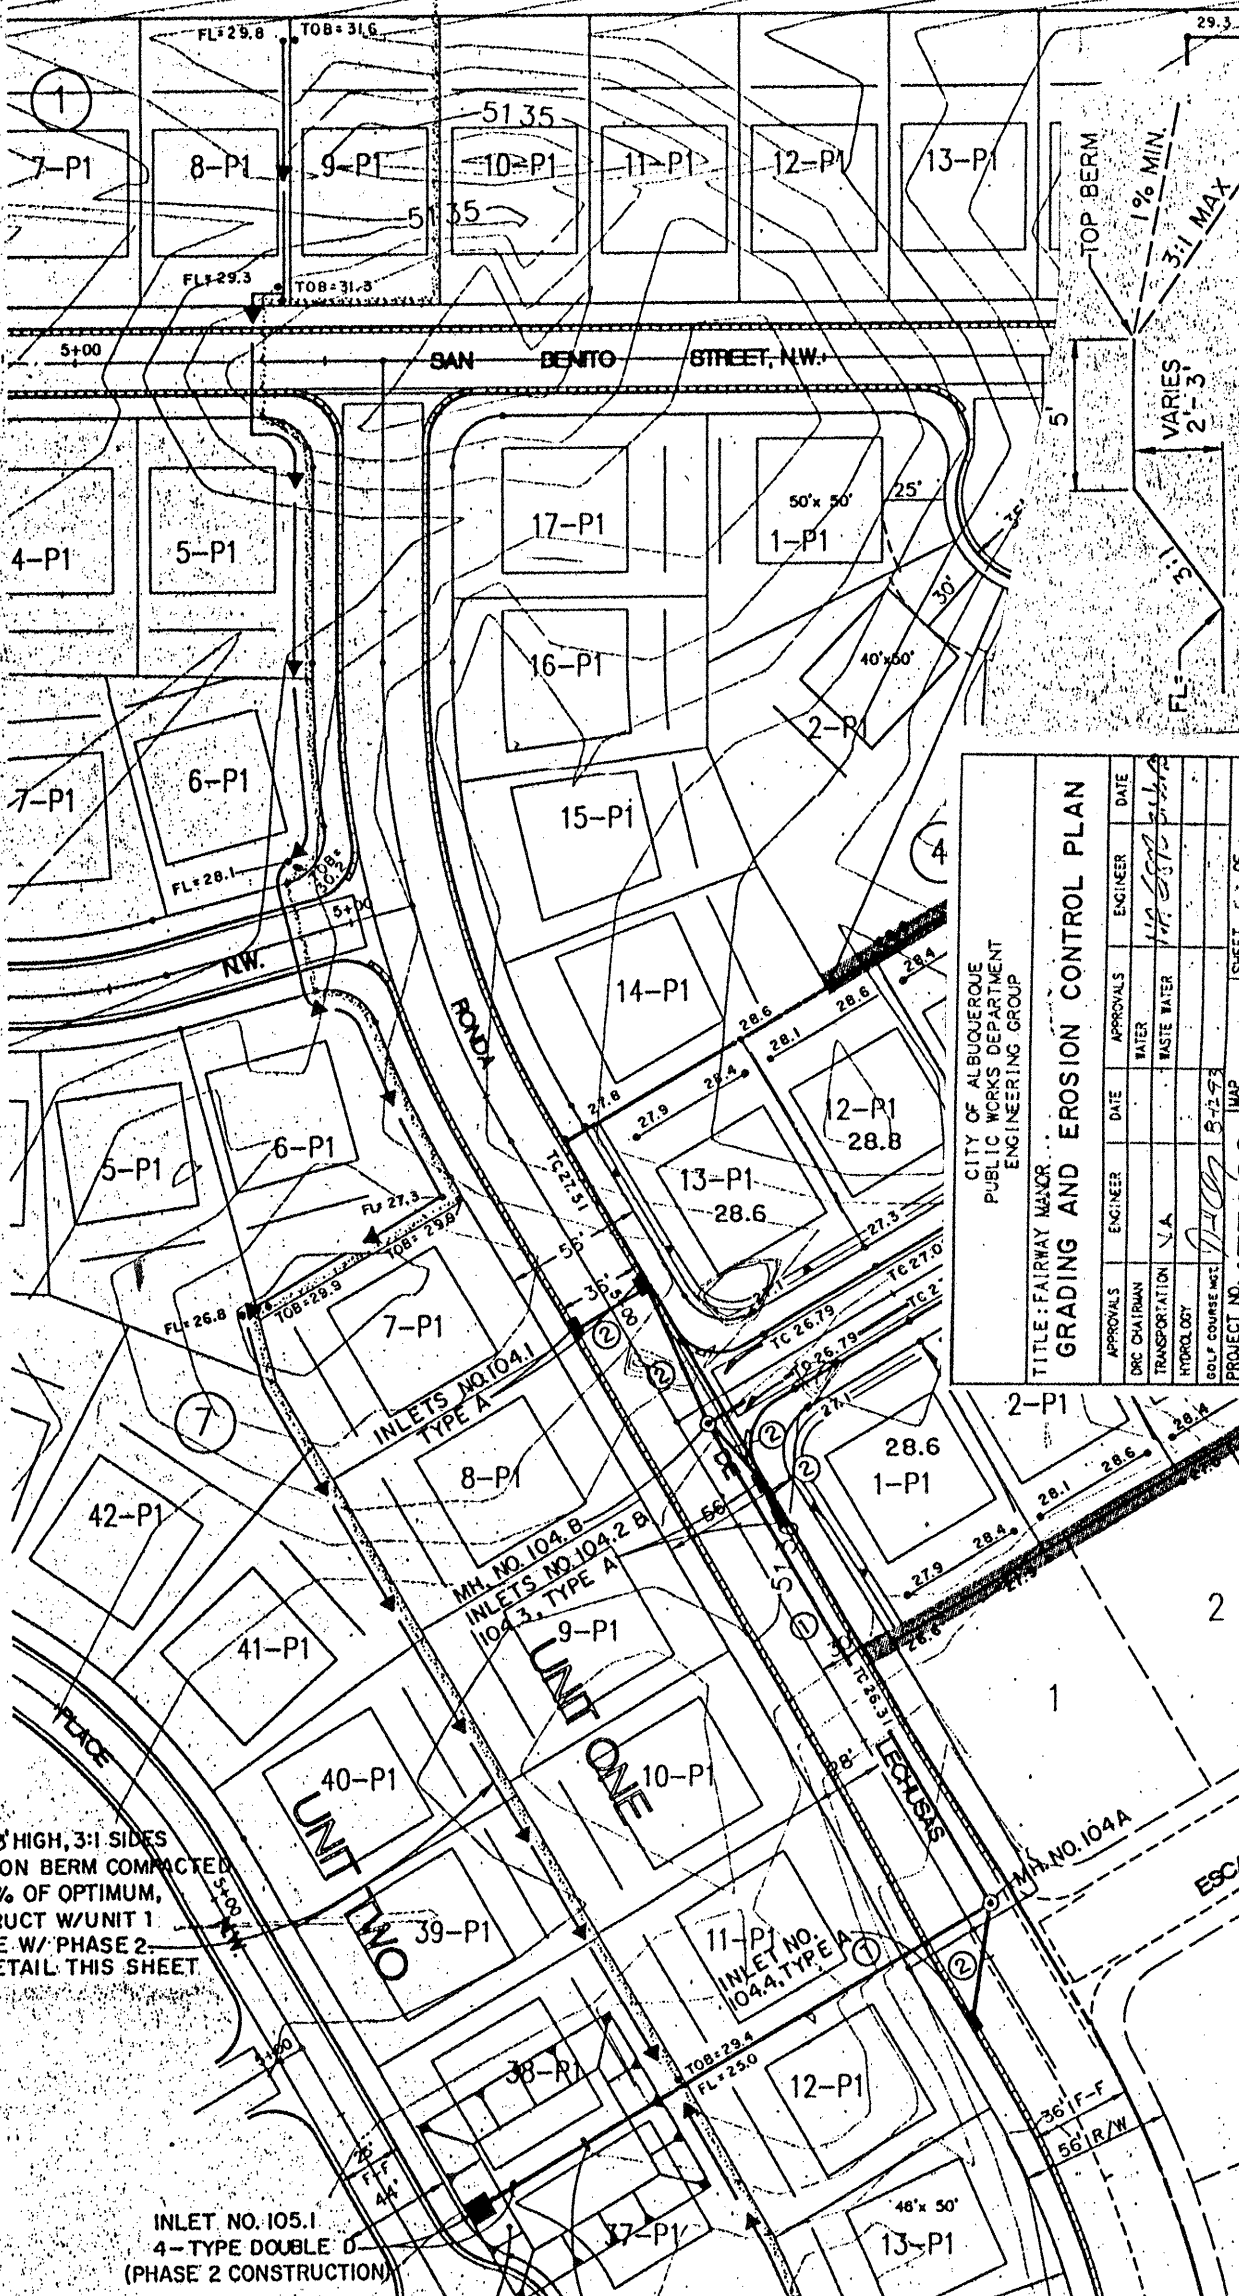

TOP BERM

1% MIN

3:1 MAX

VARIES

2'-3'

TEMPORARY DIVERSION BERM

NTS

CITY OF ALBUQUERQUE PUBLIC WORKS DEPARTMENT ENGINEERING GROUP					
TITLE: FAIRWAY MAJOR...					
GRADING AND EROSION CONTROL PLAN					
APPROVALS	ENGINEER	DATE	APPROVALS	ENGINEER	DATE
DRG CHAIRMAN			WATER		
TRANSPORTATION			WASTE WATER		
HYDROLOGY					
GOLF COURSE MGMT					
PROJECT NO.	477690	MAP NO.	G-10	SHEET OF	5 23

TEMP 2'-3' HIGH, 3:1 SIDES
DIVERSION BERM COMPACTED
TO 90% OF OPTIMUM,
CONSTRUCT W/ UNIT 1
REMOVE W/ PHASE 2
SEE DETAIL THIS SHEET

INLET NO. 105.1
4-TYPE DOUBLE O
(PHASE 2 CONSTRUCTION)

80' x 90' TEMP. DESILTATION
POND 6' DEEP, 3:1 SIDES
CONSTRUCT W/ UNIT 1, REMOVE
W/ PHASE 2 CONSTRUCTION

END 36" RCP
PHASE 1 CONSTRUCTION
INSTALL INLET STRUCTURE
SEE SHEET 11

"EXHIBIT A" 1 of 2

DRAINAGE COVENANT

This Drainage Covenant, between Fairway Manor Limited Partnership ("Owner"), whose address is 6400 Uptown #200W, Albuquerque, NM 87110, and the City of Albuquerque, New Mexico municipal corporation ("City"), whose address is P.O. Box 1293, Albuquerque, New Mexico 87103, is made in Albuquerque, Bernalillo County, New Mexico and is entered into as of the date Owner signs this Covenant.

1. Recital. Owner is the owner of certain real property described as: Tract D, El Rancho Atrisco de los Santos; filed 6-25-82; Vol C19, Folio 181 in Bernalillo County, New Mexico (the "Property").

Pursuant to City ordinances, regulations and other applicable laws, the Owner is required to construct and maintain certain Drainage Facilities on the Property, and the parties wish to enter into this Agreement to establish the obligations and responsibilities of the parties.

2. Description and Construction of Drainage Facilities. Owner shall construct the following "Drainage Facility" within the Property at Owner's sole expense in accordance with the standards, plans and specifications approved by the City pursuant to Drainage File No. G10/D3-E.
Fairway Manor Subdivision, Unit 1, Sheets 22 and 23 attached hereto as Exhibit A
Specifically the temporary pond and outfall control structure. (City Proj. #4776.90)

The Drainage Facility is more particularly described in the attached Exhibit A. The Owner will not permit the Drainage Facility to constitute a hazard to the health or safety of the general public.

3. Maintenance of Drainage Facility. The Owner will maintain the Drainage Facility at Owner's cost in accordance with the approved Drainage Report and plans.

4. City's Right of Entry. The City has the right to enter upon the Property at any time and perform whatever inspection, maintenance or repair of the Drainage Facility it deems appropriate, without liability to the Owner.

5. Demand for Construction or Repair. The City may send written notice ("Notice") to the Owner requiring the Owner to construct or repair the Drainage Facility within 30 days ("Deadline") of receipt of the Notice, as provided in Section 11, and the Owner will comply promptly with the requirements of the Notice. The Owner will perform all required work by the Deadline, at Owner's sole expense.

6. Failure to Perform by Owner and Emergency Work by City. If the Owner fails to comply with the terms of the Notice by the Deadline, or if the City determines that an emergency condition exists, the City may perform the work itself. The City may assess the Owner for the cost of the work and for any other expenses or damages which result from Owner's failure to perform. The Owner agrees promptly to pay the City the amount assessed. If the Owner fails to pay the City within thirty (30) days after the City gives the Owner written notice of the amount due, the City may impose a lien against Owner's Property for the total resulting amount.

(Approved by Legal Dept.
as to form only 06/90)

7. Liability of City for Repair after Notice or as a Result of Emergency. The City shall not be liable to the Owner for any damages resulting from the City's repair or maintenance following notice to the Owner as required in this agreement or in an emergency unless the damages are the result of the reckless conduct or gross negligence of the City.

8. Indemnification. Owner agrees to indemnify and save the City, its officials, agents and employees harmless from all claims, actions, suits and proceedings arising out of or resulting from the Owner's negligent maintenance, construction, repair or use of the Drainage Facility. To the extent, if at all, Section 56-7-1 NMSA 1978 is applicable to this Agreement, this Agreement to indemnify will not extend to liability, claims, damages, losses or expenses, including attorney's fees, arising out of (1) the preparation or approval of maps, drawings, opinions, reports, surveys, change orders, designs or specifications by the indemnitee, or the agents or employees of the indemnitee; or (2) the giving of or the failure to give direction or instructions by the indemnitee, where such giving or failure to give directions or instructions is the primary cause of bodily injury to persons or damage to property.

9. Cancellation of Agreement and Release of Covenant. This Agreement may be released if the Drainage Facility is no longer required for the protection of the public health, safety and welfare by the City filing a "Notice of Release" with the Bernalillo County Clerk. The Notice of Release must be signed by the City's Chief Administrative Officer, or his designee, and the approval of the City Hydrologist must be endorsed thereon.

10. Assessment. Nothing in this agreement shall be construed to relieve the Owner, his heirs, assigns, and successors from an assessment against Owner's Property for improvements to the property under a duly authorized and approved Special Assessment District. The parties specifically agree that the value of the Drainage Facility will not reduce the amount assessed by the City.

11. Notice. For purposes of given formal written notice to the Owner, Owner's address is:

6400 Uptown Blvd. Suite #200W
Albuquerque, NM 87110

Notice may be given to the Owner either in person or by mailing the notice by regular U.S. mail, postage paid. Notice will be considered to have been received by the Owner within three days after the notice is mailed if there is no actual evidence of receipt. The Owner may change Owner's address by given written notice of the change by Certified Mail, return receipt requested, to the City Public Works Department, P.O. Box 1293, Albuquerque, New Mexico, 87103.

12. Term. This Agreement shall continue until terminated by the City pursuant to Section 9 above.

13. Binding on Owner's Property. The covenants and obligations of the Owner said forth herein shall be binding on Owner, its heirs, personal representatives, assigns and successors and on Owner's Property and shall constitute covenants running the Owner's Property until released by the City.

14. Entire Agreement. This Agreement contains the entire agreement of the parties and supercedes any and all other agreements or understanding, oral or written, whether previous to the execution hereof or contemporaneous herewith regarding this subject matter.

15. Changes to Agreement. Changes to this Agreement are not binding unless made in writing, signed by both parties.

16. Construction and Severability. If any part of this Agreement is held to be invalid or unenforceable, the remainder of the Agreement will remain valid and enforceable if the remainder is reasonably capable of completion.

17. Captions. The captions to the sections or paragraphs of this Agreement are not part of this Agreement and will not affect the meaning or construction of any of its provisions.

OWNER: FAIRWAY MANOR Limited PARTNERSHIP
by ARGUS Development Company
ITS General PARTNER
By: Ben F. Spencer
Its: President
Dated: 11/2/93

STATE OF New Mexico)
COUNTY OF Bernalillo) ss

The foregoing instrument was acknowledged before me this 2nd day of November, 1993, [by name of person:] Ben F. Spencer, [title or capacity, for instance "president" or "owner":] * of [Subdivider:] Fairway Manor Limited Partnership.

Notary Public

My Commission Expires: 4-21-95

* President of Argus Development Co., Inc., General Partner


CITY OF ALBUQUERQUE:

Approved:

By: _____
Title: _____
Dated: _____


(EXHIBIT A ATTACHED)


(Approved by Legal Dept.
as to form only 06/90)

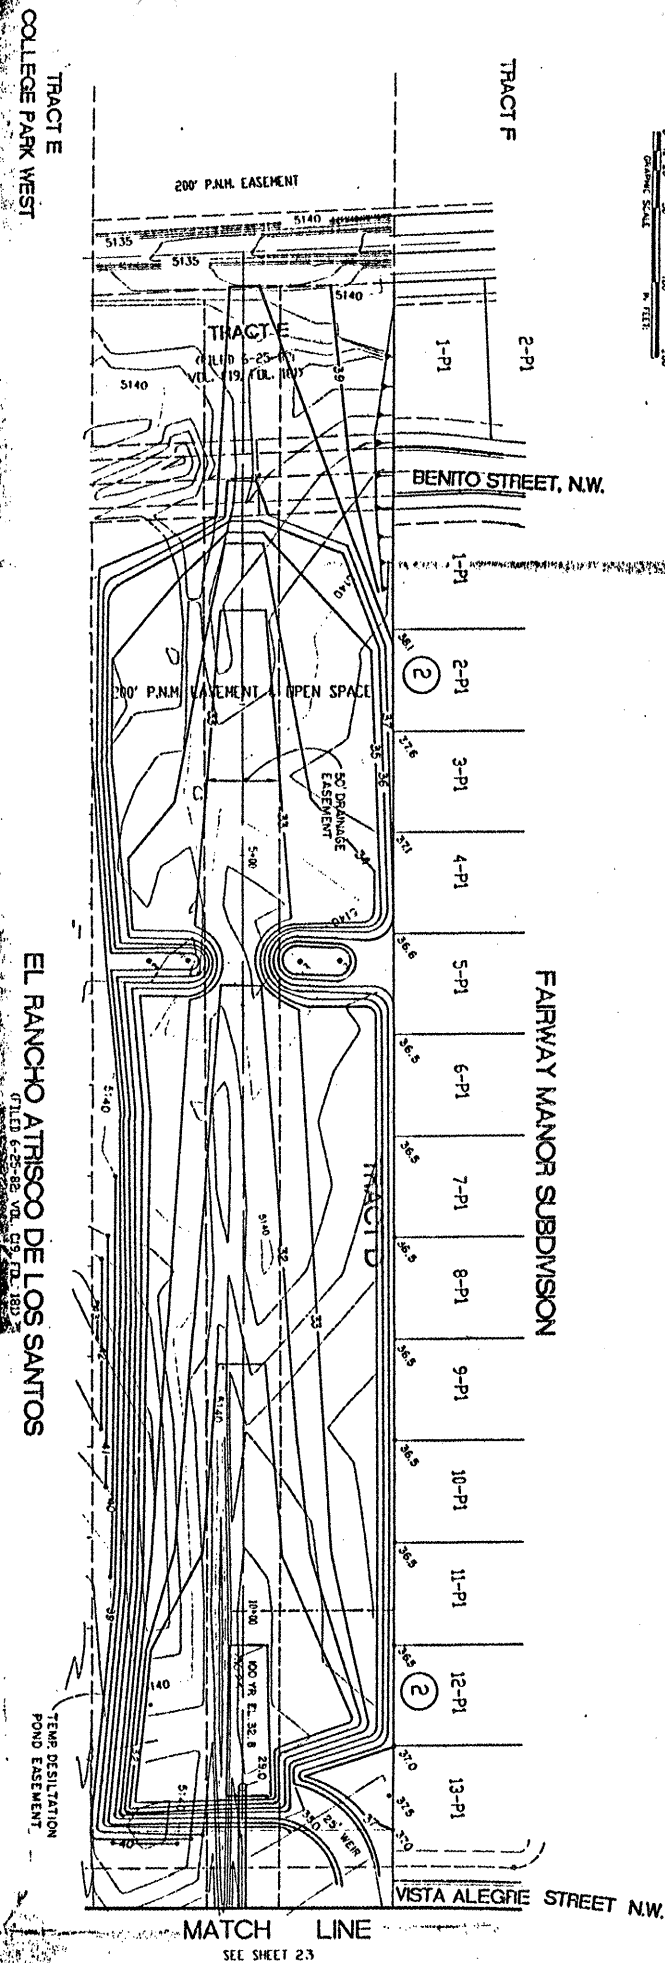

TOP HALF #22


SURVEY INFORMATION			BENCH MARKS		AS BUILT INFORMATION	
FIELD NOTES						
NO.	BY	DATE				
1.			THAT STA. IS A STANDARD A.C.S. BRASS TABLET STAMPED "2.09".		CONTRACTOR	
2.			SET IN A 2" IRON PIPE 1' ABOVE GROUND, STA. IS LOCATED ON		STAMP BY DATE	
3.			TOP OF VOLCANIC OUTCROP. TO REACH THIS STA. BEGIN AT 1.40		MEASURED BY DATE	
4.			AND COORS RD., PROCEED NORTH ON COORS 0.4 MI. TO CURWAY		VERIFY LOCATION BY DATE	
5.			RD., WEST ON CURWAY RD. 0.7 MI. TO END OF PAVEMENT,		CORRECTED BY DATE	
6.			CONTINUE WEST ON DIRT ROAD TO TOP OF DAM, ALONG NORTH		MICRO-FILM INFORMATION	
7.			BANK 0.6 MI. TO DIRT CROSSROAD, NORTH ON DIRT ROAD 0.5 MI.		RECORDED BY DATE	
8.			THE STA. IS ABOUT 600 WEST OF THIS POINT.		NO.	

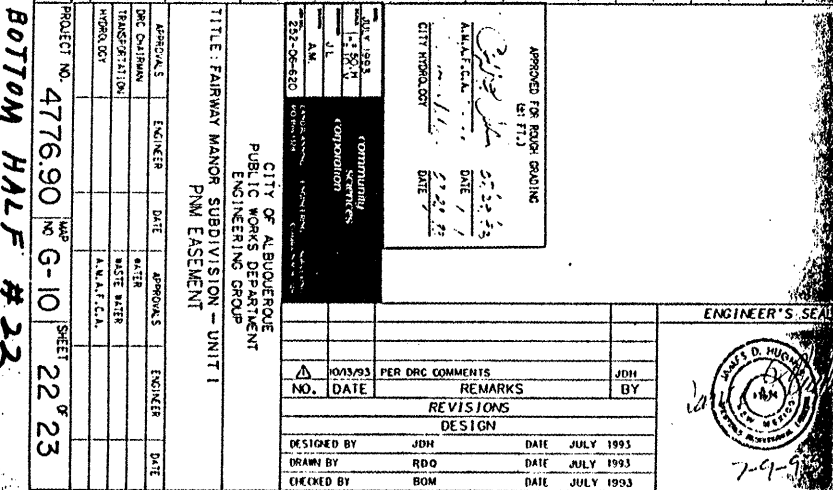

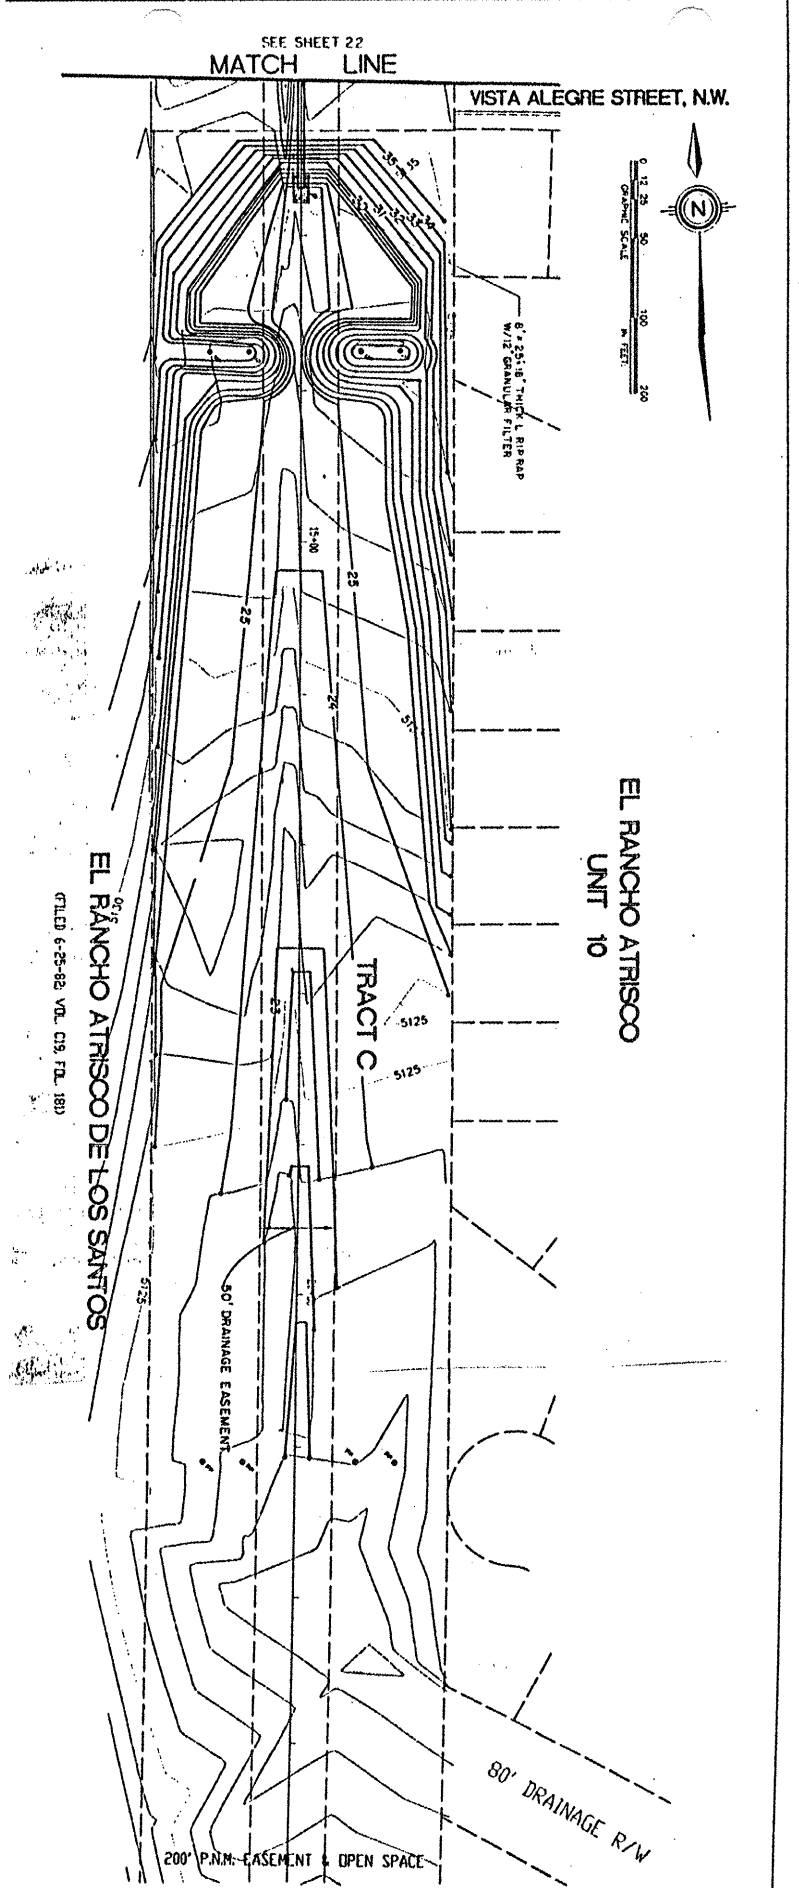

TOP HALF # 23

OFFSITE DRAINAGE AREA MAP
SCALE: 1" = 800'

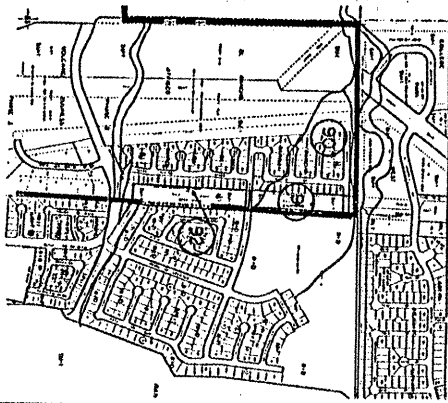

SURVEY INFORMATION			BENCH MARKS		AS BUILT INFORMATION	
FIELD NOTES					CONTRACTOR	
NO.	BY	DATE	THAT STA. IS A STANDARD A.C.S. BRASS TABLET STAMPED 2.09 SET IN A 2" IRON PIPE 1" ABOVE GROUND. STA. IS LOCATED ON TOP OF VOLCANIC OUTCROP. TO REACH THIS STA. BEGIN AT L-40 AND COORS. RD. PROCEED NORTH ON COORS 0.4 MI. TO OURAY RD. WEST ON OURAY RD. 0.7 MI. TO END OF PAVEMENT, CONTINUE WEST ON DIRT ROAD TO TOP OF DAM, ALONG NORTH BANK 0.8 MI. TO DIRT CROSSROAD, NORTH ON DIRT ROAD 0.5 MI. THE STA. IS ABOUT 600' WEST OF THIS POINT. ELEVATION = 6334.50 FEET		DATE	DATE
					INSPECTED BY	DATE
					ACCEPTANCE BY	DATE
					FIELD	DATE
					VERIFICATION BY	DATE
					CORRECTED BY	DATE
					MICRO-FILM INFORMATION	
					RECORDED BY	DATE
					NO.	DATE



EXHIBIT A 4 of 4

PERMANENT EASEMENT

Grant of Permanent Easement, between a Fairway Manor Limited Partnership ("Grantor"), whose address is 6400 Uptown #200W, Albuquerque, NM 87110 and the City of Albuquerque, a New Mexico municipal corporation ("City"), whose address is P.O. Box 1293, Albuquerque, New Mexico, 87103.

Grantor grants to the City an exclusive, permanent easement ("Easement") in, over, upon and across the real property described on Exhibit "A" attached hereto ("Property") for the construction, installation, maintenance, repair, modification, replacement and operation of drainage channel together with the right to remove trees, bushes, undergrowth and any other obstacles upon the Property if the City determines they interfere with the appropriate use of this Easement.

Grantor covenants and warrants that Grantor is the owner in fee simple of the Property, that Grantor has a good lawful right to convey the Property or any part thereof and that Grantor will forever warrant and defend the title to the Property against all claims from all persons or entities.

The grant and other provisions of this Easement constitute covenants running with the land for the benefit of the City and its successors and assigns until terminated.

WITNESS my hand and seal this 2ND day of NOVEMBER, 1993.

GRANTOR:


(Individual)

GRANTOR: FAIRWAY MANOR LIMITED PARTNERSHIP
BY: ARGUS Development Company
ITS General PARTNER

By: Bruce Spencer

Its: PRESIDENT

(Corporation or Partnership)

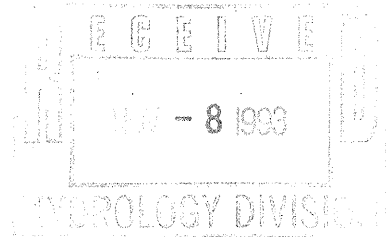

INDIVIDUAL

STATE OF _____)
COUNTY OF _____) SS

The foregoing instrument was acknowledged before me this _____
day of _____, 199__, by _____.

Notary Public

My Commission Expires:

CORPORATION

STATE OF _____)
COUNTY OF _____) SS

The foregoing instrument was acknowledged before me this _____
day of _____, 199__, by _____,
of _____, a _____ corporation, on behalf
of the corporation.

Notary Public

My Commission Expires:

PARTNERSHIP

STATE OF NEW MEXICO)
COUNTY OF SANDOVAL) SS

The foregoing instrument was acknowledged before me this 11TH
day of NOVEMBER, 1993, by BEN F. SPENSER, partner(s), on
behalf of FAIRWAY HAND *a partnership.
LIMITED PARTNERSHIP

* PRESIDENT OF ARGUS DEV. CO., INC.
GENERAL PARTNER
My Commission Expires: _____

Notary Public

(EXHIBIT "A" ATTACHED)

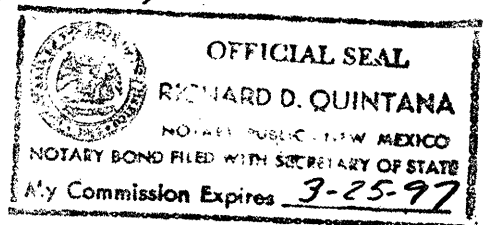


EXHIBIT "A"
1.40 ACRE PORTION
OF TRACT "C", EL RANCHO ATRISCO DE LOS SANTOS
SITUATE WITHIN THE TOWN OF ATRISCO GRANT
PROJECTED SECTION 3, T.10 N., R.2 E, N.M.P.M.
CITY OF ALBUQUERQUE,
BERNALILLO COUNTY, NEW MEXICO


LEGAL DESCRIPTION:

AN EASEMENT FOR DRAINAGE WITHIN THE TOWN OF ATRISCO GRANT "PROJECTED" SECTION 3, TOWNSHIP 10 NORTH, RANGE 2 EAST, NEW MEXICO PRINCIPAL MERIDIAN, CITY OF ALBUQUERQUE, BERNALILLO COUNTY, NEW MEXICO COMPRISING A PORTION OF TRACT "C" OF EL RANCHO ATRISCO DE LOS SANTOS AS THE SAME IS SHOWN AND DESIGNATED ON THE PLAT FILED FOR RECORD IN THE OFFICE OF THE COUNTY CLERK OF BERNALILLO COUNTY, NEW MEXICO ON JUNE 25, 1982 IN VOLUME C-19, FOLIO 181 SAID EASEMENT BEING A STRIP OF LAND FIFTY (50) FEET IN WIDTH, BEING 25 FEET ON EACH SIDE OF THE FOLLOWING DESCRIBED CENTER LINE:

BEGINNING AT A POINT ON THE SOUTHERLY RIGHT-OF-WAY LINE OF VISTA ALEGRE STREET N.W. (60' R/W) SAID POINT BEING THE NORTHEAST CORNER OF SAID TRACT "C" OF EL RANCHO ATRISCO DE LOS SANTOS; THENCE ALONG SAID SOUTHERLY RIGHT-OF-WAY LINE N87°15'51"W, 100.00 FEET; TO THE TRUE PLACE OF BEGINNING OF THE EASEMENT HEREIN DESCRIBED; THENCE, LEAVING THE SOUTHERLY RIGHT-OF-WAY LINE OF VISTA ALEGRE STREET N.W. S02°44'09"W, 1231.45 FEET TO A POINT ON THE NORTHERLY RIGHT-OF-WAY LINE OF OURAY ROAD N.W. (86' R/W) SAID POINT BEING THE TERMINUS OF THE EASEMENT HEREIN DESCRIBED.

SURVEYOR'S CERTIFICATION:

I, C.A. SPIROCK, HEREBY AFFIRM THAT I AM A DULY QUALIFIED REGISTERED PROFESSIONAL SURVEYOR UNDER THE LAWS OF THE STATE OF NEW MEXICO AND DO CERTIFY THAT THIS DESCRIPTION WAS PREPARED BY ME OR UNDER MY DIRECT SUPERVISION AND SHOWS ACCURATE DIMENSIONS AND LAND AREA. I FURTHER CERTIFY THAT THIS DESCRIPTION MEETS THE "MINIMUM STANDARD FOR LAND SURVEYS" SET FORTH BY THE STATE OF NEW MEXICO AND IS TRUE AND CORRECT TO THE BEST OF MY KNOWLEDGE AND BELIEF.

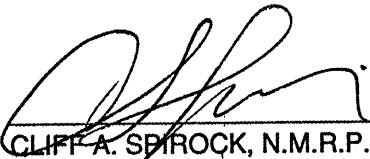

CLIFF A. SPIROCK, N.M.R.P.S. #4972

11/11/93
DATE

SEE ATTACHED EXHIBIT "A-1"



EXHIBIT "A-1",
 1.40 ACRE PORTION
 OF TRACT "C", EL RANCHO ATRISCO DE LOS SANTOS
 SITUATE WITHIN THE TOWN OF ATRISCO GRANT
 PROJECTED SECTION 3, T.10 N., R.2 E, N.M.P.M.
 CITY OF ALBUQUERQUE,
 BERNALILLO COUNTY, NEW MEXICO

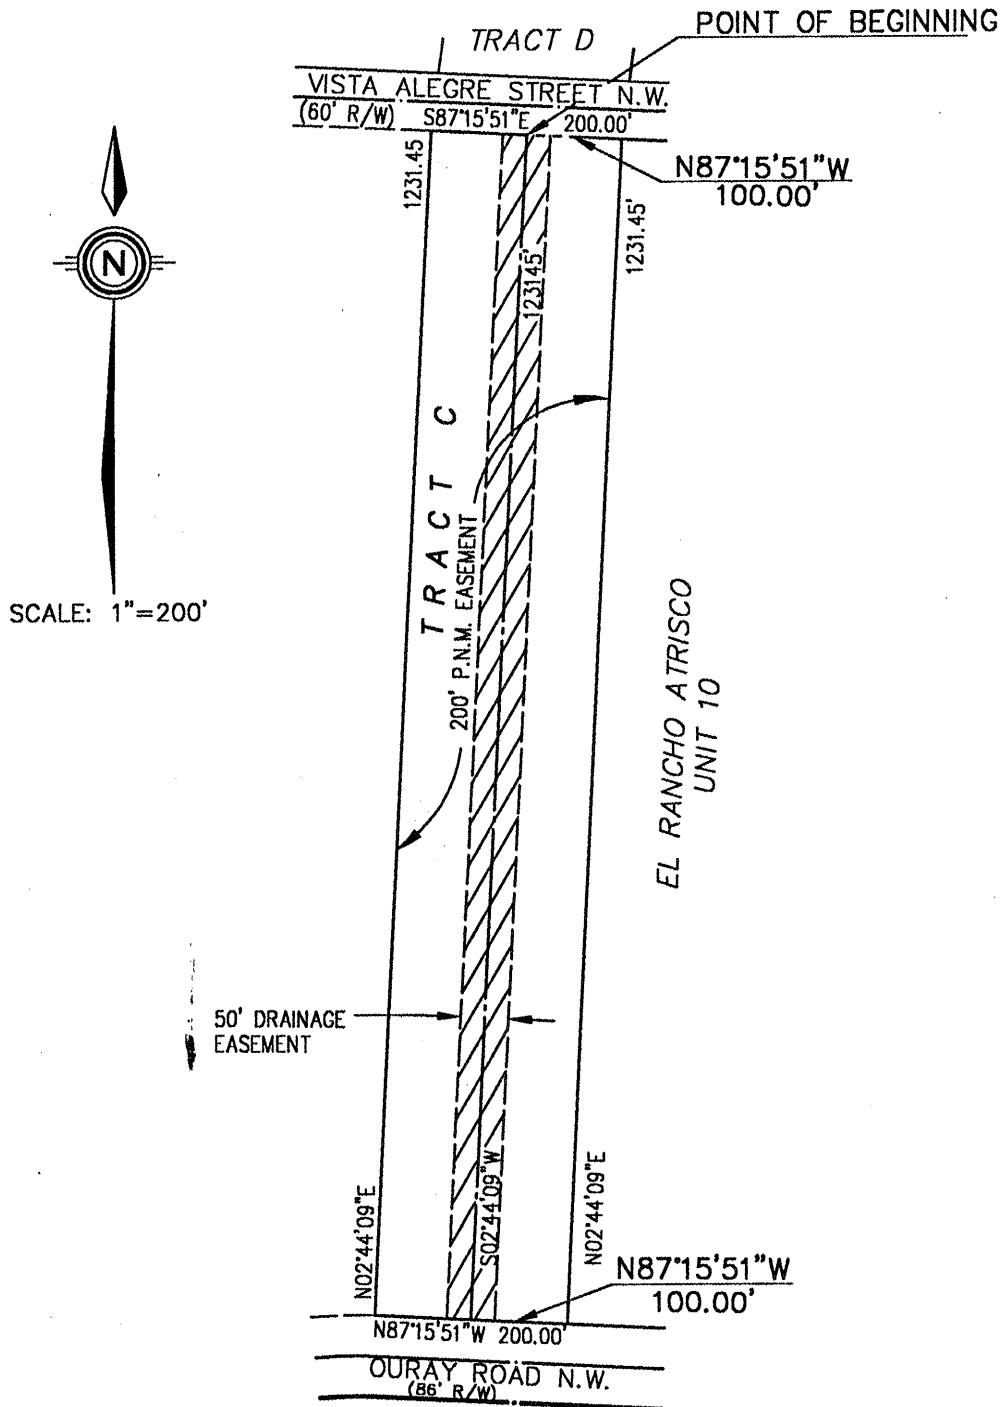

PERMANENT EASEMENT

Fairway Manor Limited Partnership
Grant of Permanent Easement, between a New Mexico Limited Partnership
("Grantor"), whose address is 6400 Uptown #200W, Albuquerque, NM 87110
and the City of Albuquerque, a New Mexico municipal corporation
("City"), whose address is P.O. Box 1293, Albuquerque, New Mexico,
87103.

Grantor grants to the City an exclusive, permanent easement
("Easement") in, over, upon and across the real property described
on Exhibit "A" attached hereto ("Property") for the construction,
installation, maintenance, repair, modification, replacement and
operation of drainage channel
together with the right to remove trees, bushes, undergrowth and any
other obstacles upon the Property if the City determines they
interfere with the appropriate use of this Easement.

Grantor covenants and warrants that Grantor is the owner in fee
simple of the Property, that Grantor has a good lawful right to
convey the Property or any part thereof and that Grantor will
forever warrant and defend the title to the Property against all
claims from all persons or entities.

The grant and other provisions of this Easement constitute
covenants running with the land for the benefit of the City and its
successors and assigns until terminated.

WITNESS my hand and seal this 2nd day of November, 1993.

GRANTOR:

(Individual)

GRANTOR: FAIRWAY MANOR Limited Partnership
BY: ARBUS Development Company
its General Partner

By: Burt Spencer

Its: PRESIDENT

(Corporation or Partnership)

INDIVIDUAL

STATE OF _____)
COUNTY OF _____) ss

The foregoing instrument was acknowledged before me this _____
day of _____, 199__, by _____.

Notary Public

My Commission Expires:

CORPORATION

STATE OF _____)
COUNTY OF _____) ss

The foregoing instrument was acknowledged before me this _____
day of _____, 199__, by _____,
of _____, a _____ corporation, on behalf
of the corporation.

Notary Public

My Commission Expires:

PARTNERSHIP

STATE OF New Mexico)
COUNTY OF Bernalillo) ss

The foregoing instrument was acknowledged before me this 2nd
day of November, 1993, by Don F. Spencer, *partner(s), on
behalf of Fairway Manor Limited, a partnership.
Partnership

Beth L. Jansen
Notary Public

My Commission Expires:
4-21-95

(EXHIBIT "A" ATTACHED)

*President of
Argus Development
Co, Inc., General
Partner

EXHIBIT "A"
1.03 ACRE PORTION
OF TRACT "D", EL RANCHO ATRISCO DE LOS SANTOS
SITUATE WITHIN THE TOWN OF ATRISCO GRANT
PROJECTED SECTION 3, T.10 N., R.2 E, N.M.P.M.
CITY OF ALBUQUERQUE,
BERNALILLO COUNTY, NEW MEXICO


LEGAL DESCRIPTION:

AN EASEMENT FOR DRAINAGE WITHIN THE TOWN OF ATRISCO GRANT "PROJECTED" SECTION 3, TOWNSHIP 10 NORTH, RANGE 2 EAST, NEW MEXICO PRINCIPAL MERIDIAN, CITY OF ALBUQUERQUE, BERNALILLO COUNTY, NEW MEXICO COMPRISING A PORTION OF TRACT "D" OF EL RANCHO ATRISCO DE LOS SANTOS SUBDIVISION AS THE SAME IS SHOWN AND DESIGNATED ON THE PLAT FILED FOR RECORD IN THE OFFICE OF THE COUNTY CLERK OF BERNALILLO COUNTY, NEW MEXICO ON JUNE 25, 1982 IN VOLUME C-19, FOLIO 181 SAID EASEMENT BEING A STRIP OF LAND FIFTY (50) FEET IN WIDTH, BEING 25 FEET ON EACH SIDE OF THE FOLLOWING DESCRIBED CENTER LINE:

BEGINNING AT A POINT ON THE SOUTHERLY RIGHT-OF-WAY LINE OF SAN BENITO STREET N.W. (50' R/W) SAID POINT BEING THE NORTHEAST CORNER OF SAID TRACT "D" OF EL RANCHO ATRISCO DE LOS SANTOS; THENCE ALONG SAID SOUTHERLY RIGHT-OF-WAY LINE N89°46'46"W, 100.04 FEET; TO THE TRUE PLACE OF BEGINNING OF THE EASEMENT HEREIN DESCRIBED; THENCE, LEAVING THE SOUTHERLY RIGHT-OF-WAY LINE OF SAN BENITO STREET S02°44'21"W, 896.85 FEET TO A POINT ON THE NORTHERLY RIGHT-OF-WAY-LINE OF VISTA ALEGRE STREET N.W. (60' R/W) SAID POINT BEING THE TERMINUS OF THE EASEMENT HEREIN DESCRIBED.

SURVEYOR'S CERTIFICATION:

I, C.A. SPIROCK, HEREBY AFFIRM THAT I AM A DULY QUALIFIED REGISTERED PROFESSIONAL SURVEYOR UNDER THE LAWS OF THE STATE OF NEW MEXICO AND DO CERTIFY THAT THIS DESCRIPTION WAS PREPARED BY ME OR UNDER MY DIRECT SUPERVISION AND SHOWS ACCURATE DIMENSIONS AND LAND AREA. I FURTHER CERTIFY THAT THIS DESCRIPTION MEETS THE "MINIMUM STANDARD FOR LAND SURVEYS" SET FORTH BY THE STATE OF NEW MEXICO AND IS TRUE AND CORRECT TO THE BEST OF MY KNOWLEDGE AND BELIEF.

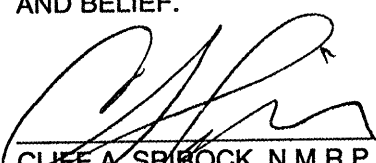
CLIFF A. SPIROCK, N.M.R.P.S. #4972

SEE ATTACHED EXHIBIT "A-1"

11/4/93
DATE



EXHIBIT "A-1",
1.03 ACRE PORTION
OF TRACT "D", EL RANCHO ATRISCO DE LOS SANTOS
SITUATE WITHIN THE TOWN OF ATRISCO GRANT
PROJECTED SECTION 3, T.10 N., R.2 E, N.M.P.M.
CITY OF ALBUQUERQUE,
BERNALILLO COUNTY, NEW MEXICO

POINT OF BEGINNING

TRACT E

SAN BENITO STREET N.W.

(50' R/W)

589°46'46"E

200.19

100.04'

892.44

901.24'

896.85'

TRACT D

200' P.N.M. EASEMENT

50' DRAINAGE
EASEMENT

EL RANCHO ATRISCO NORTH

N02°44'09"E

S02°44'21"W

N02°44'21"E

N87°15'51"W


100.00'

200.00

VISTA ALEGRE STREET N.W.

(60' R/W)

TRACT C

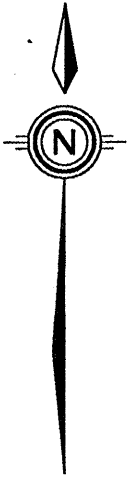

SCALE: 1"=100'

PERMANENT EASEMENT

Grant of Permanent Easement, between a Fairway Manor Limited Partnership
("Grantor"), whose address is 6400 Uptown #200W, Albuquerque, NM 87110
and the City of Albuquerque, a New Mexico municipal corporation
("City"), whose address is P.O. Box 1293, Albuquerque, New Mexico,
87103.

Grantor grants to the City an exclusive, permanent easement
("Easement") in, over, upon and across the real property described
on Exhibit "A" attached hereto ("Property") for the construction,
installation, maintenance, repair, modification, replacement and
operation of drainage channel
together with the right to remove trees, bushes, undergrowth and any
other obstacles upon the Property if the City determines they
interfere with the appropriate use of this Easement.

Grantor covenants and warrants that Grantor is the owner in fee
simple of the Property, that Grantor has a good lawful right to
convey the Property or any part thereof and that Grantor will
forever warrant and defend the title to the Property against all
claims from all persons or entities.

The grant and other provisions of this Easement constitute
covenants running with the land for the benefit of the City and its
successors and assigns until terminated.

WITNESS my hand and seal this 2ND day of NOVEMBER, 1993.

GRANTOR:

(Individual)

GRANTOR: FAIRWAY MANOR Limited PARTNERSHIP
BY: ARGUS Development Company
ITS General PARTNER

By: Burt Spencer

Its: PRESIDENT

(Corporation or Partnership)

INDIVIDUAL

STATE OF _____)
) ss
COUNTY OF _____)

The foregoing instrument was acknowledged before me this _____
day of _____, 199__, by _____.

Notary Public

My Commission Expires:

CORPORATION

STATE OF _____)
) ss
COUNTY OF _____)

The foregoing instrument was acknowledged before me this _____
day of _____, 199__, by _____,
of _____, a _____ corporation, on behalf
of the corporation.

Notary Public

My Commission Expires:

PARTNERSHIP

STATE OF New Mexico)
) ss
COUNTY OF Bernalillo)

The foregoing instrument was acknowledged before me this 2nd
day of November, 1993, by Ben F. Spencer, *partner(s), on
behalf of Fairway Manor Limited Partnership, a partnership.

Burt L. Spencer
Notary Public

My Commission Expires:
4-21-95

(EXHIBIT "A" ATTACHED)

* President of
Argus Development Co., Inc.,
General Partner of ~~Fairway~~

EXHIBIT "A"
0.11 ACRE PORTION
OF TRACT "E", EL RANCHO ATRISCO PHASE II
SITUATE WITHIN THE TOWN OF ATRISCO GRANT
PROJECTED SECTION 3, T.10 N., R.2 E, N.M.P.M.
CITY OF ALBUQUERQUE,
BERNALILLO COUNTY, NEW MEXICO


LEGAL DESCRIPTION:

AN EASEMENT FOR DRAINAGE WITHIN THE TOWN OF ATRISCO GRANT "PROJECTED" SECTION 3, TOWNSHIP 10 NORTH, RANGE 2 EAST, NEW MEXICO PRINCIPAL MERIDIAN, CITY OF ALBUQUERQUE, BERNALILLO COUNTY, NEW MEXICO COMPRISING A PORTION OF TRACT "E" OF EL RANCHO ATRISCO DE LOS SANTOS SUBDIVISION AS THE SAME IS SHOWN AND DESIGNATED ON THE PLAT FILED FOR RECORD IN THE OFFICE OF THE COUNTY CLERK OF BERNALILLO COUNTY, NEW MEXICO ON JUNE 25, 1982 IN VOLUME C-19, FOLIO 181 SAID EASEMENT BEING A STRIP OF LAND FIFTY (50) FEET IN WIDTH, BEING 25 FEET ON EACH SIDE OF THE FOLLOWING DESCRIBED CENTER LINE:

BEGINNING AT A POINT ON THE SOUTHERLY RIGHT-OF-WAY LINE OF A.M.A.F.C.A. RINCONADA CHANNEL (50' R/W) AS THE SAME IS SHOWN AND DESIGNATED ON THE CORRECTED REPLAT OF COLLEGE PARK WEST FILED IN THE OFFICE OF COUNTY CLERK OF BERNALILLO COUNTY, ON MAY 28, 1984 IN VOLUME C-19, FOLIO 30 SAID POINT BEING THE NORTHEAST CORNER OF SAID TRACT "E" OF EL RANCHO ATRISCO DE LOS SANTOS; THENCE ALONG SAID SOUTHERLY RIGHT-OF-WAY LINE N89°46'46"W, 100.15 FEET; TO THE TRUE PLACE OF BEGINNING OF THE EASEMENT HEREIN DESCRIBED; THENCE, LEAVING THE SAID SOUTHERLY RIGHT-OF-WAY LINE RINCONADA CHANNEL S02°44'09"W, 100.10 FEET TO A POINT ON THE NORTHERLY RIGHT-OF-WAY-LINE OF SAN BENITO STREET N.W. (50' R/W) SAID POINT BEING THE TERMINUS OF THE EASEMENT LINE HEREIN DESCRIBED.

SURVEYOR'S CERTIFICATION:

I, C.A. SPIROCK, HEREBY AFFIRM THAT I AM A DULY QUALIFIED REGISTERED PROFESSIONAL SURVEYOR UNDER THE LAWS OF THE STATE OF NEW MEXICO AND DO CERTIFY THAT THIS DESCRIPTION WAS PREPARED BY ME OR UNDER MY DIRECT SUPERVISION AND SHOWS ACCURATE DIMENSIONS AND LAND AREA. I FURTHER CERTIFY THAT THIS DESCRIPTION MEETS THE "MINIMUM STANDARD FOR LAND SURVEYS" SET FORTH BY THE STATE OF NEW MEXICO AND IS TRUE AND CORRECT TO THE BEST OF MY KNOWLEDGE AND BELIEF.

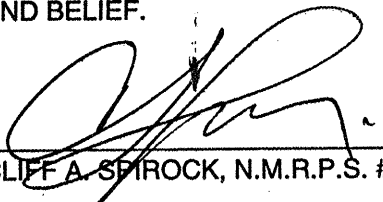
CLIFF A. SPIROCK, N.M.R.P.S. #4972

11/11/93
DATE


SEE ATTACHED EXHIBIT "A-1"



EXHIBIT "A-1",
0.11 ACRE PORTION
OF TRACT "E", EL RANCHO ATRISCO DE LOS SANTOS
SITUATE WITHIN THE TOWN OF ATRISCO GRANT
PROJECTED SECTION 3, T.10 N., R.2 E, N.M.P.M.
CITY OF ALBUQUERQUE,
BERNALILLO COUNTY, NEW MEXICO



SCALE: 1"=100'

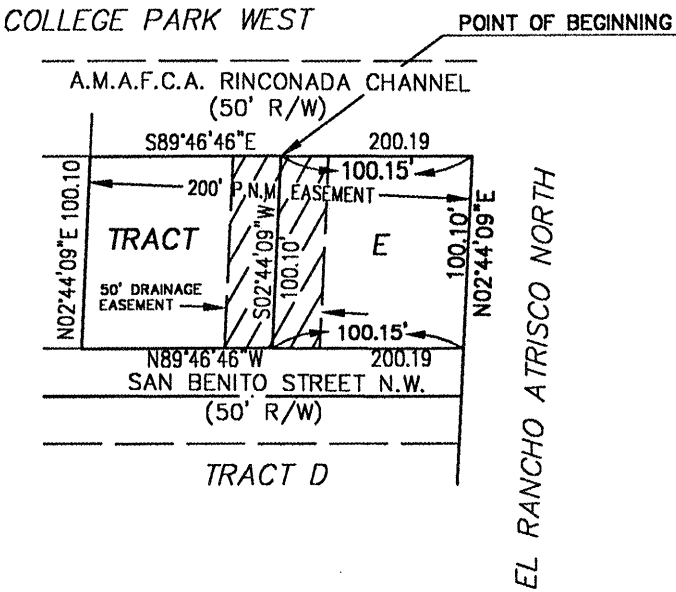

I. PURPOSE AND SCOPE

Argus Development Company is currently planning for the development of Fairway Manor Subdivision. The proposed development consists of approximately 34.46 acres and is to be subdivided into 166 lots.

This report presents an overall Drainage Management and Grading Plan for approval by the City of Albuquerque in order that subsequent subdivision and development may commence.

II. SITE DESCRIPTION AND HISTORY

The site is located north of Vista Alegre Street and south of the AMAFCA Rinconada Channel as indicated on the Vicinity Map following the Tables in this report. This is the completion of El Rancho Atrisco Phase III.

The site slopes from west to east, is not in any flood plain, and is comprised of the Bluepoint Series BCC Type "A" according to the "Drainage Management Plan El Rancho Atrisco, Unit 7" prepared by Denney-Tibljias-McLean and Associates, Inc. This report was also used for off-site drainage to the south and the drainage channel capacity at the south end of Vista del Sur. The "Drainage Management Plan for El Rancho Atrisco Phase III" prepared by Denney-Tibljias-McLean was used for the side weir capacity in Ronda de Lechusas at the Ladera Channel.

III. DESIGN CRITERIA

A. Flood Control Regulations

The drainage plan presented in this report has been designed to comply with AMAFCA resolution 80-15, which requires that proposed land development projects be designed such that no flooding of private properties will occur during any storm up to and including the 100-year frequency event. Additionally, this drainage plan has been designed to comply with current "City of Albuquerque Drainage Ordinance" and Chapter 22 of the Development Process Manual (DPM), and subsequently adopted general policies of the City of Albuquerque.

1. 100-year storm:
 - a. Stormwater flow depth not to exceed the top of curb in any street.
 - b. Jump depth to be contained within right-of-way.
2. 10-year storm:
 - a. Local street - velocity times depth less than 6.5
 - b. Arterial streets:
 - i. Flow not to exceed a depth of 0.50
 - ii. Velocity times depth less than 6.5
 - iii. One driving lane in each direction free of stormwater

B. Engineering Parameters

In accordance with AMAFCA criteria, all hydrological analysis is based on the 100-year frequency, 6-hour duration storm, as represented in Section 22.2, Hydrology, of the "Development Process Manual, Volume 2, Design Criteria for the City of Albuquerque, New Mexico, January, 1993".

Ten-year, 6-hour values were also used for subcatchments, in accordance with City drainage policies regarding street flow.

The four rainfalls pertinent to the study are as follows:

	<u>10-Year</u>	<u>100-Year</u>
One-Hour	1.26"	1.88"
Six-Hour	1.47"	2.21"

IV. COMPUTATIONAL PROCEDURES

The analysis approach follows standard engineering practice. Key points of confluence were selected and the associated individual and aggregate contributing basins were subsequently defined.

Hydrological computations were accomplished by means of the March 1992 version of AHYMO Computer Program as developed by AMAFCA. The input parameters and resulting flows for the basins are summarized on Table 1. Summary and detailed AHYMO printouts are contained in Appendix A.

Times of concentration were estimated using the Upland Method and then converted to times to peak (Lg), in accordance with the above referenced Section 22.2 which also establishes the minimum time of concentration as 12 minutes.

Flow characteristics for conveyance swales, channels, and streets were analyzed based on the Manning equation for uniform flow. Streets are assumed to have a 2% cross slope from lip of gutter to crown and curb and gutter per City of Albuquerque Standard Details. Finished grade at the right-of-way is 0.33' above top of curb.

V. OFF-SITE DRAINAGE

No off-site drainage enters this site due to grading of the PNM Easement, however; on-site drainage will flow in Vista del Sur and Ronda de Lechusas south of the new development. The "Unit 7" Report previously mentioned indicates a flow of 25.6 cfs exiting our site from Vista del Sur and 13 cfs at Ronda de Lechusas. The Vista del Sur flow will be decreased to 9.23 cfs from areas 102.3 and 103 (see Conceptual Grading and Drainage Plan at the end of this report). The concrete rundown capacity at the end of Vista de Sur was checked by adding the 9.23 cfs to the "Unit 7" Report flow of 36.4 cfs. This combined flow of 45.63 cfs is within the rundowns capacity of 55.2 cfs.

The street flow capacity for Ronda de Lechusas was checked using HEC-2. The "Unit 7" report's flow of 49.8 cfs will produce a flow depth of 0.69'. The flow exiting our site will be increased from 13 cfs to 19 cfs. This net flow of 55.81 cfs at the Ladera Channel, with a flow depth of 0.72' and a sub-critical velocity of 3.14 fps, will be contained within the right-of-way. Additional height will be added to the existing water blocks along Ronda de

Lechusas (See Schematic preceding "TABLES") to protect property on adjacent streets. Using the coefficient (C=4.1 "Open Channel Flow" by: Henderson) from the "Phase III" Report previously mentioned, the weir will have a flow depth of 0.49' on each side.

A diversion swale and temporary desiltation pond is to be constructed through the PNM easement to protect the development from off-site drainage to the west. This area will drain to the Ladera Channel until future development west of the PNM easement diverts the flow to the AMAFCA Rinconada Channel. At this time, the temporary desiltation pond will be removed and the swale will serve only the easement.

VI. ON-SITE DRAINAGE

The on-site drainage will be contained with street flow. Flow from drainage areas 101, 102.1, 102.2, 104, and 105 will be collected in a storm drain and discharged into the AMAFCA Rinconada Channel via a 20' drainage right-of-way at the northeast corner of the subdivision. Watershed area 103 will flow to Sol Poniente Road and then combine with area 102.3 in Vista del Sure. Ronda de Lechusas will serve as the collector street for drainage area 104.1. Emergency overflow channels will protect the areas around the sumps. The two sumps in San Benito Street and Vista del Sur will have emergency overflow ability to the cul-de-sac at the intersections of those two streets.

VII. EROSION CONTROL

Control of excessive soil erosion into City streets and drainage improvements during construction will be accomplished by use of temporary lot line, water-trap berms. These will be windrowed into place following mass grading operations and left in place until each home is constructed and sold. The Conceptual Grading Plan at the end of this report illustrates the dimensions of these berms, and they will be located along those boundaries of each lot which are common to City rights-of-way or public easements.

TABLE 1
FUTURE DEVELOPMENT CONDITIONS

TABLE 2

STREET FLOW CHARACTERISTICS

STREET	LOCATION	Q100	ST. WIDTH	% SLOPE	Dn	Vn	AREA	TOPWID	F	Dc	Vc
LOMA PEDREGOSA	1+00-5+65	2.06	25' MOUNT	0.50	0.21	1.23	1.68	18.93	0.73	0.19	1.61
	5+65-END	4.12	25' MOUNT	0.50	0.26	1.45	2.84	24.75	0.75	0.24	1.85
LA VIENTA	ALL OF ST	2.57	25' MOUNT	0.50	0.22	1.30	1.98	20.61	0.74	0.20	1.68
	1+00-5+69	11.56	25' MOUNT	0.50	0.36	2.15	5.39	26.25	0.84	0.34	2.43
JAL PL.	5+69-6+59	25.69	26' STAND	0.50	0.54	2.94	8.75	26.28	0.90	0.52	3.19
	ALL OF ST	13.70	25' MOUNT	0.53	0.38	2.34	5.86	26.25	0.87	0.36	2.59
SIERRA RICA	1+00-3+85	5.75	25' MOUNT	0.57	0.28	1.70	3.38	25.79	0.83	0.26	1.97
	3+85-END	6.10	25' MOUNT	0.50	0.29	1.67	3.65	25.89	0.78	0.27	2.01
ESCARPA	1+00-3+55	6.65	25' MOUNT	0.50	0.30	1.74	3.82	25.96	0.80	0.28	2.06
	3+55-END	3.96	25' MOUNT	0.53	0.26	1.47	2.70	24.12	0.77	0.23	1.83
VISTA DEL SUR	1+00-5+60	7.29	25' MOUNT	0.50	0.31	1.79	4.07	26.05	0.80	0.28	2.13
	1+00-6+23	8.99	26' STAND	0.60	0.38	2.04	4.41	26.19	0.88	0.36	2.28
SAN BENITO	6+23-11+58	17.98	26' STAND	0.60	0.46	2.68	6.71	26.24	0.93	0.45	2.83
	11+58-15+40	35.96	26' STAND	0.60	0.62	3.35	10.74	26.31	0.92	0.60	3.53
RONDA	1+00-5+00	18.45	36' STAND	0.50	0.49	2.26	8.17	36.25	0.84	0.46	2.58
	5+00-7+55	5.70	36' STAND	0.40	0.34	1.62	3.52	25.96	0.78	0.31	2.03
	7+55-13+19	19.01	40' STAND	0.40	0.51	2.05	9.28	40.26	0.75	0.47	2.53
	CHANNEL	55.81	40' STAND	0.40	0.72	3.14	17.76	40.34	0.83	0.67	3.58
	EXISTING	49.80	40' STAND	0.40	0.69	3.01	16.57	40.34	0.83	0.64	3.46

10 YEAR POST-DEVELOPMENT - SUMMARY PRINTOUT

AHYMO SUMMARY TABLE (AHYMO392) - AMAFCA VERSION OF HYMO - MARCH, 1992
INPUT FILE = FAIR10PO.DAT

RUN DATE (MON/DAY/YR) = 07/07/1993
USER NO. = J_HUGHES.S92

COMMAND	HYDROGRAPH IDENTIFICATION	FROM ID NO.	TO ID NO.	AREA (SQ MI)	PEAK DISCHARGE (CFS)	RUNOFF VOLUME (AC-FT)	RUNOFF (INCHES)	TIME TO PEAK (HOURS)	CFS PER ACRE	PAGE = 1	NOTATION
*S	FAIRWAY MANOR - 10 YEAR POST DEVELOPMENT										
START											TIME= .00
RAINFALL TYPE= 1											RAIN6= 1.470
*S	FAIRWAY MANOR - 100 YEAR POST DEVELOPMENT										
COMPUTE NM HYD	101.00	-	1	.01680	20.68	.664	.74122	1.499	1.924	PER IMP=	45.80
COMPUTE NM HYD	102.10	-	2	.00120	1.49	.047	.74122	1.499	1.935	PER IMP=	45.80
COMPUTE NM HYD	102.20	-	3	.00340	4.19	.134	.74122	1.499	1.927	PER IMP=	45.80
COMPUTE NM HYD	104.00	-	4	.01330	16.38	.526	.74123	1.499	1.924	PER IMP=	45.80
COMPUTE NM HYD	105.00	-	5	.01200	14.78	.474	.74122	1.499	1.924	PER IMP=	45.80
*S	ON-SITE FLOW IN RONDA DE LACHUSAS										
ADD HYD	105.10	4& 5	6	.02530	31.15	1.000	.74120	1.499	1.924		
*S	AREAS 101, 102.1, 102.2, 104, & 105 DRAIN NORTH TO THE LA RINCONADA CHANNEL										
ADD HYD	101.11	1& 6	1	.04210	51.83	1.664	.74120	1.499	1.924		
ADD HYD	101.12	1& 3	1	.04550	56.03	1.799	.74120	1.499	1.924		
*S	TOTAL FLOW TO THE LA RINCONADA CHANNEL										
ADD HYD	101.12	1& 2	1	.04670	57.51	1.846	.74119	1.499	1.924		
COMPUTE NM HYD	103.00	-	3	.00310	3.82	.123	.74123	1.499	1.927	PER IMP=	45.80
COMPUTE NM HYD	102.30	-	4	.00120	1.49	.047	.74122	1.499	1.935	PER IMP=	45.80
*S	FLOW EXITING SITE AT VISTA DEL SUR										
ADD HYD	105.10	3& 4	2	.00430	5.31	.170	.74109	1.499	1.929		
COMPUTE NM HYD	104.10	-	3	.00570	7.02	.225	.74122	1.499	1.925	PER IMP=	45.80
*S	ONSITE FLOW EXITING AT RONDA DE LECHUSAS										
COMPUTE NM HYD	90.00	-	8	.02130	3.40	.096	.08473	1.532	.250	PER IMP=	.00
COMPUTE NM HYD	91.00	-	9	.00790	1.28	.036	.08473	1.532	.253	PER IMP=	.00
*S	TOTAL INFLOW INTO POND										
ADD HYD	90.10	8& 9	10	.02920	4.68	.132	.08472	1.532	.251		
*S	ROUTE HYDROGRAPH THRU POND										
ROUTE RESERVOIR	90.11	10	13	.02920	.97	.132	.08472	1.865	.052	AC-FT=	.075
COMPUTE NM HYD	92.00	-	11	.00790	1.28	.036	.08473	1.532	.253	PER IMP=	.00
ADD HYD	90.20	13&11	12	.03710	2.01	.168	.08471	1.565	.085		
FINISH											

100 YEAR POST-DEVELOPMENT - SUMMARY PRINTOUT

AHYMO SUMMARY TABLE (AHYMO392) - AMAFCA VERSION OF HYMO - MARCH, 1992
INPUT FILE = FAIR99PO.DAT

RUN DATE (MON/DAY/YR) = 07/07/1993
USER NO. = J_HUGHES.S92

COMMAND	HYDROGRAPH IDENTIFICATION	FROM ID NO.	TO ID NO.	AREA (SQ MI)	PEAK DISCHARGE (CFS)	RUNOFF VOLUME (AC-FT)	RUNOFF (INCHES)	TIME TO PEAK (HOURS)	CFS PER ACRE	PAGE = 1	NOTATION
*S FAIRWAY MANOR - 100 YEAR POST DEVELOPMENT											
START											
RAINFALL TYPE= 1											
COMPUTE NM HYD	101.00	-	1	.01680	35.96	1.211	1.35139	1.499	3.344	PER IMP=	45.80
COMPUTE NM HYD	102.10	-	2	.00120	2.58	.086	1.35139	1.499	3.363	PER IMP=	45.80
COMPUTE NM HYD	102.20	-	3	.00340	7.29	.245	1.35139	1.499	3.350	PER IMP=	45.80
COMPUTE NM HYD	104.00	-	4	.01330	28.47	.959	1.35139	1.499	3.345	PER IMP=	45.80
COMPUTE NM HYD	105.00	-	5	.01200	25.69	.865	1.35139	1.499	3.345	PER IMP=	45.80
*S ON-SITE FLOW IN RONDA DE LACHUSAS											
ADD HYD	105.10	4& 5	6	.02530	54.16	1.823	1.35137	1.499	3.345		
*S AREAS 101, 102.1, 102.2, 104, & 105 DRAIN NORTH TO THE LA RINCONADA CHANNEL											
ADD HYD	101.11	1& 6	1	.04210	90.12	3.034	1.35137	1.499	3.345		
ADD HYD	101.12	1& 3	1	.04550	97.41	3.279	1.35137	1.499	3.345		
*S TOTAL FLOW TO THE LA RINCONADA CHANNEL											
ADD HYD	101.12	1& 2	1	.04670	99.99	3.366	1.35136	1.499	3.345		
COMPUTE NM HYD	103.00	-	3	.00310	6.65	.223	1.35139	1.499	3.351	PER IMP=	45.80
COMPUTE NM HYD	102.30	-	4	.00120	2.58	.086	1.35139	1.499	3.363	PER IMP=	45.80
*S FLOW EXITING SITE AT VISTA DEL SUR											
ADD HYD	105.10	3& 4	2	.00430	9.23	.310	1.35127	1.499	3.354		
COMPUTE NM HYD	104.10	-	3	.00570	12.21	.411	1.35139	1.499	3.347	PER IMP=	45.80
*S ONSITE FLOW EXITING AT RONDA DE LECHUSAS											
COMPUTE NM HYD	90.00	-	8	.02130	17.78	.506	.44534	1.532	1.304	PER IMP=	.00
COMPUTE NM HYD	91.00	-	9	.00790	6.66	.188	.44534	1.532	1.317	PER IMP=	.00
*S TOTAL INFLOW INTO POND											
ADD HYD	90.10	8& 9	10	.02920	24.44	.694	.44533	1.532	1.308		
*S ROUTE HYDROGRAPH THRU POND											
ROUTE RESERVOIR	90.11	10	13	.02920	5.77	.694	.44533	1.832	.309	AC-FT=	.415
COMPUTE NM HYD	92.00	-	11	.00790	6.66	.188	.44534	1.532	1.317	PER IMP=	.00
ADD HYD	90.20	13&11	12	.03710	9.99	.881	.44532	1.598	.421		
FINISH											

10 YEAR POST-DEVELOPMENT - DETAILED PRINTOUT

AHYMO PROGRAM (AHYMO392) - AMAPCA VERSION OF HYMO - MARCH, 1992
RUN DATE (MON/DAY/YR) = 07/07/1993
START TIME (HR:MIN:SEC) = 10:56:20 USER NO.= J_HUGHES.S92
INPUT FILE = FAIR10PO.DAT

*S FAIRWAY MANOR - 10 YEAR POST DEVELOPMENT

START TIME=0.0 HR PUNCH CODE=0

RAINFALL TYPE=1 RAIN QUARTER=0.0
RAIN ONE=1.26 IN RAIN SIX=1.47 IN
RAIN DAY=1.77 IN DT=0.0333 HRS

COMPUTED 6-HOUR RAINFALL DISTRIBUTION BASED ON NOAA ATLAS 2 - PEAK AT 1.40 HR.

DT = .033300 HOURS			END TIME = 5.994000 HOURS			
.0000	.0010	.0020	.0030	.0040	.0051	.0062
.0073	.0085	.0096	.0108	.0121	.0133	.0147
.0160	.0174	.0188	.0203	.0218	.0234	.0250
.0267	.0284	.0303	.0322	.0342	.0362	.0384
.0407	.0431	.0457	.0491	.0529	.0568	.0650
.0839	.1129	.1546	.2117	.2868	.3826	.5019
.6476	.7875	.8450	.8933	.9362	.9752	1.0111
1.0444	1.0755	1.1047	1.1322	1.1581	1.1825	1.2057
1.2276	1.2485	1.2682	1.2869	1.3047	1.3095	1.3133
1.3169	1.3203	1.3236	1.3267	1.3297	1.3326	1.3354
1.3380	1.3406	1.3431	1.3456	1.3479	1.3502	1.3525
1.3546	1.3567	1.3588	1.3608	1.3628	1.3647	1.3666
1.3685	1.3703	1.3720	1.3738	1.3755	1.3771	1.3788
1.3804	1.3820	1.3835	1.3851	1.3866	1.3881	1.3895
1.3910	1.3924	1.3938	1.3952	1.3965	1.3979	1.3992
1.4005	1.4018	1.4031	1.4043	1.4056	1.4068	1.4080
1.4092	1.4104	1.4116	1.4127	1.4139	1.4150	1.4161
1.4172	1.4183	1.4194	1.4205	1.4216	1.4226	1.4237
1.4247	1.4257	1.4267	1.4277	1.4287	1.4297	1.4307
1.4317	1.4326	1.4336	1.4345	1.4354	1.4364	1.4373
1.4382	1.4391	1.4400	1.4409	1.4418	1.4427	1.4435
1.4444	1.4453	1.4461	1.4470	1.4478	1.4486	1.4495
1.4503	1.4511	1.4519	1.4527	1.4535	1.4543	1.4551
1.4559	1.4567	1.4574	1.4582	1.4590	1.4597	1.4605
1.4612	1.4620	1.4627	1.4634	1.4642	1.4649	1.4656
1.4663	1.4671	1.4678	1.4685	1.4692	1.4699	

*S FAIRWAY MANOR - 100 YEAR POST DEVELOPMENT

COMPUTE NM HYD ID=1 HYD NO=101.0 DA=0.0168 SQ MI
PER A=0.0 PER B=27.1 PER C=27.1 PER D=45.8
TP=-0.1333 HR MASS RAIN=-1

K = .072649HR TP = .133300HR K/TP RATIO = .545000 SHAPE CONSTANT, N = 7.106420
UNIT PEAK = 30.378 CFS UNIT VOLUME = .9990 B = 526.28 P60 = 1.2600
AREA = .007694 SQ MI IA = .10000 INCHES INF = .04000 INCHES PER HOUR
RUNOFF COMPUTED BY INITIAL ABSTRACTION/INFILTRATION NUMBER METHOD - DT = .033300

K = .124821HR TP = .133300HR K/TP RATIO = .936388 SHAPE CONSTANT, N = 3.776847
UNIT PEAK = 23.226 CFS UNIT VOLUME = .9997 B = 340.01 P60 = 1.2600
AREA = .009106 SQ MI IA = .42500 INCHES INF = 1.04000 INCHES PER HOUR
RUNOFF COMPUTED BY INITIAL ABSTRACTION/INFILTRATION NUMBER METHOD - DT = .033300

PRINT HYD

ID=1 CODE=1

PARTIAL HYDROGRAPH 101.00

RUNOFF VOLUME = .74122 INCHES = .6641 ACRE-FEET
PEAK DISCHARGE RATE = 20.68 CFS AT 1.499 HOURS BASIN AREA = .0168 SQ. MI.

COMPUTE NM HYD

ID=2 HYD NO=102.1 DA=0.0012 SQ MI
PER A=0.0 PER B=27.1 PER C=27.1 PER D=45.8
TP=-0.1333 HR MASS RAIN=-1

K = .072649HR TP = .133300HR K/TP RATIO = .545000 SHAPE CONSTANT, N = 7.106420
UNIT PEAK = 2.1698 CFS UNIT VOLUME = .9941 B = 526.28 P60 = 1.2600
AREA = .000550 SQ MI IA = .10000 INCHES INF = .04000 INCHES PER HOUR
RUNOFF COMPUTED BY INITIAL ABSTRACTION/INFILTRATION NUMBER METHOD - DT = .033300

K = .124821HR TP = .133300HR K/TP RATIO = .936388 SHAPE CONSTANT, N = 3.776847
UNIT PEAK = 1.6590 CFS UNIT VOLUME = .9918 B = 340.01 P60 = 1.2600
AREA = .000650 SQ MI IA = .42500 INCHES INF = 1.04000 INCHES PER HOUR
RUNOFF COMPUTED BY INITIAL ABSTRACTION/INFILTRATION NUMBER METHOD - DT = .033300

PRINT HYD

ID=2 CODE=1

PARTIAL HYDROGRAPH 102.10

RUNOFF VOLUME = .74122 INCHES = .0474 ACRE-FEET
PEAK DISCHARGE RATE = 1.49 CFS AT 1.499 HOURS BASIN AREA = .0012 SQ. MI.

COMPUTE NM HYD

ID=3 HYD NO=102.2 DA=0.0034 SQ MI
PER A=0.0 PER B=27.1 PER C=27.1 PER D=45.8
TP=-0.1333 HR MASS RAIN=-1

K = .072649HR TP = .133300HR K/TP RATIO = .545000 SHAPE CONSTANT, N = 7.106420
UNIT PEAK = 6.1479 CFS UNIT VOLUME = .9975 B = 526.28 P60 = 1.2600
AREA = .001557 SQ MI IA = .10000 INCHES INF = .04000 INCHES PER HOUR
RUNOFF COMPUTED BY INITIAL ABSTRACTION/INFILTRATION NUMBER METHOD - DT = .033300

K = .124821HR TP = .133300HR K/TP RATIO = .936388 SHAPE CONSTANT, N = 3.776847
UNIT PEAK = 4.7004 CFS UNIT VOLUME = .9974 B = 340.01 P60 = 1.2600
AREA = .001843 SQ MI IA = .42500 INCHES INF = 1.04000 INCHES PER HOUR
RUNOFF COMPUTED BY INITIAL ABSTRACTION/INFILTRATION NUMBER METHOD - DT = .033300

PRINT HYD

ID=3 CODE=1

PARTIAL HYDROGRAPH 102.20

RUNOFF VOLUME = .74122 INCHES = .1344 ACRE-FEET
PEAK DISCHARGE RATE = 4.19 CFS AT 1.499 HOURS BASIN AREA = .0034 SQ. MI.

*

COMPUTE NM HYD ID=4 HYD NO=104.0 DA=0.0133 SQ MI
PER A=0.0 PER B=27.1 PER C=27.1 PER D=45.8
TP=-0.1333 HR MASS RAIN=-1

K = .072649HR TP = .133300HR K/TP RATIO = .545000 SHAPE CONSTANT, N = 7.106420
UNIT PEAK = 24.049 CFS UNIT VOLUME = .9989 B = 526.28 P60 = 1.2600
AREA = .006091 SQ MI IA = .10000 INCHES INF = .04000 INCHES PER HOUR
RUNOFF COMPUTED BY INITIAL ABSTRACTION/INFILTRATION NUMBER METHOD - DT = .033300

K = .124821HR TP = .133300HR K/TP RATIO = .936388 SHAPE CONSTANT, N = 3.776847
UNIT PEAK = 18.387 CFS UNIT VOLUME = .9995 B = 340.01 P60 = 1.2600
AREA = .007209 SQ MI IA = .42500 INCHES INF = 1.04000 INCHES PER HOUR
RUNOFF COMPUTED BY INITIAL ABSTRACTION/INFILTRATION NUMBER METHOD - DT = .033300

PRINT HYD ID=4 CODE=1

PARTIAL HYDROGRAPH 104.00

RUNOFF VOLUME = .74123 INCHES = .5258 ACRE-FEET
PEAK DISCHARGE RATE = 16.38 CFS AT 1.499 HOURS BASIN AREA = .0133 SQ. MI.

COMPUTE NM HYD ID=5 HYD NO=105.0 DA=0.012 SQ MI
PER A=0.0 PER B=27.1 PER C=27.1 PER D=45.8
TP=-0.1333 HR MASS RAIN=-1

K = .072649HR TP = .133300HR K/TP RATIO = .545000 SHAPE CONSTANT, N = 7.106420
UNIT PEAK = 21.698 CFS UNIT VOLUME = .9988 B = 526.28 P60 = 1.2600
AREA = .005496 SQ MI IA = .10000 INCHES INF = .04000 INCHES PER HOUR
RUNOFF COMPUTED BY INITIAL ABSTRACTION/INFILTRATION NUMBER METHOD - DT = .033300

K = .124821HR TP = .133300HR K/TP RATIO = .936388 SHAPE CONSTANT, N = 3.776847
UNIT PEAK = 16.590 CFS UNIT VOLUME = .9994 B = 340.01 P60 = 1.2600
AREA = .006504 SQ MI IA = .42500 INCHES INF = 1.04000 INCHES PER HOUR
RUNOFF COMPUTED BY INITIAL ABSTRACTION/INFILTRATION NUMBER METHOD - DT = .033300

PRINT HYD ID=5 CODE=1

PARTIAL HYDROGRAPH 105.00

RUNOFF VOLUME = .74122 INCHES = .4744 ACRE-FEET
PEAK DISCHARGE RATE = 14.78 CFS AT 1.499 HOURS BASIN AREA = .0120 SQ. MI.

*S ON-SITE FLOW IN RONDA DE LACHUSAS
ADD HYD ID=6 HYD NO=105.1 ID I=4 ID II=5
PRINT HYD ID=6 CODE=1

PARTIAL HYDROGRAPH 105.10

RUNOFF VOLUME = .74120 INCHES = 1.0001 ACRE-FEET

PEAK DISCHARGE RATE = 31.15 CFS AT 1.499 HOURS BASIN AREA = .0253 SQ. MI.

*S AREAS 101, 102.1, 102.2, 104, & 105 DRAIN NORTH TO THE LA RINCONADA CHANNEL
ADD HYD ID=1 HYD NO=101.11 ID I=1 ID II=6
PRINT HYD ID=1 CODE=1

PARTIAL HYDROGRAPH 101.11

RUNOFF VOLUME = .74120 INCHES = 1.6642 ACRE-FEET
PEAK DISCHARGE RATE = 51.83 CFS AT 1.499 HOURS BASIN AREA = .0421 SQ. MI.

ADD HYD ID=1 HYD NO=101.12 ID I=1 ID II=3
PRINT HYD ID=1 CODE=1

PARTIAL HYDROGRAPH 101.12

RUNOFF VOLUME = .74120 INCHES = 1.7986 ACRE-FEET
PEAK DISCHARGE RATE = 56.03 CFS AT 1.499 HOURS BASIN AREA = .0455 SQ. MI.

*S TOTAL FLOW TO THE LA RINCONADA CHANNEL
ADD HYD ID=1 HYD NO=101.12 ID I=1 ID II=2
PRINT HYD ID=1 CODE=1

PARTIAL HYDROGRAPH 101.12

RUNOFF VOLUME = .74119 INCHES = 1.8461 ACRE-FEET
PEAK DISCHARGE RATE = 57.51 CFS AT 1.499 HOURS BASIN AREA = .0467 SQ. MI.

*

COMPUTE NM HYD ID=3 HYD NO=103.0 DA=0.0031 SQ MI
PER A=0.0 PER B=27.1 PER C=27.1 PER D=45.8
TP=-0.1333 HR MASS RAIN=-1

K = .072649HR TP = .133300HR K/TP RATIO = .545000 SHAPE CONSTANT, N = 7.106420
UNIT PEAK = 5.6054 CFS UNIT VOLUME = .9972 B = 526.28 P60 = 1.2600
AREA = .001420 SQ MI IA = .10000 INCHES INF = .04000 INCHES PER HOUR
RUNOFF COMPUTED BY INITIAL ABSTRACTION/INFILTRATION NUMBER METHOD - DT = .033300

K = .124821HR TP = .133300HR K/TP RATIO = .936388 SHAPE CONSTANT, N = 3.776847
UNIT PEAK = 4.2857 CFS UNIT VOLUME = .9971 B = 340.01 P60 = 1.2600
AREA = .001680 SQ MI IA = .42500 INCHES INF = 1.04000 INCHES PER HOUR
RUNOFF COMPUTED BY INITIAL ABSTRACTION/INFILTRATION NUMBER METHOD - DT = .033300

PRINT HYD ID=3 CODE=1

PARTIAL HYDROGRAPH 103.00

RUNOFF VOLUME = .74123 INCHES = .1225 ACRE-FEET
PEAK DISCHARGE RATE = 3.82 CFS AT 1.499 HOURS BASIN AREA = .0031 SQ. MI.

COMPUTE NM HYD ID=4 HYD NO=102.3 DA=0.0012 SQ MI
PER A=0.0 PER B=27.1 PER C=27.1 PER D=45.8
TP=-0.1333 HR MASS RAIN=-1

K = .072649HR TP = .133300HR K/TP RATIO = .545000 SHAPE CONSTANT, N = 7.106420
UNIT PEAK = 2.1698 CFS UNIT VOLUME = .9941 B = 526.28 P60 = 1.2600
AREA = .000550 SQ MI IA = .10000 INCHES INF = .04000 INCHES PER HOUR
RUNOFF COMPUTED BY INITIAL ABSTRACTION/INFILTRATION NUMBER METHOD - DT = .033300

K = .124821HR TP = .133300HR K/TP RATIO = .936388 SHAPE CONSTANT, N = 3.776847
UNIT PEAK = 1.6590 CFS UNIT VOLUME = .9918 B = 340.01 P60 = 1.2600
AREA = .000650 SQ MI IA = .42500 INCHES INF = 1.04000 INCHES PER HOUR
RUNOFF COMPUTED BY INITIAL ABSTRACTION/INFILTRATION NUMBER METHOD - DT = .033300

PRINT HYD ID=4 CODE=1

PARTIAL HYDROGRAPH 102.30

RUNOFF VOLUME = .74122 INCHES = .0474 ACRE-FEET
PEAK DISCHARGE RATE = 1.49 CFS AT 1.499 HOURS BASIN AREA = .0012 SQ. MI.

*S FLOW EXITING SITE AT VISTA DEL SUR
ADD HYD ID=2 HYD NO=105.1 ID I=3 ID II=4
PRINT HYD ID=2 CODE=1

PARTIAL HYDROGRAPH 105.10

RUNOFF VOLUME = .74109 INCHES = .1700 ACRE-FEET
PEAK DISCHARGE RATE = 5.31 CFS AT 1.499 HOURS BASIN AREA = .0043 SQ. MI.

* *****
COMPUTE NM HYD ID=3 HYD NO=104.1 DA=0.0057 SQ MI
PER A=0.0 PER B=27.1 PER C=27.1 PER D=45.8
TP=-0.1333 HR MASS RAIN=-1

K = .072649HR TP = .133300HR K/TP RATIO = .545000 SHAPE CONSTANT, N = 7.106420
UNIT PEAK = 10.307 CFS UNIT VOLUME = .9982 B = 526.28 P60 = 1.2600
AREA = .002611 SQ MI IA = .10000 INCHES INF = .04000 INCHES PER HOUR
RUNOFF COMPUTED BY INITIAL ABSTRACTION/INFILTRATION NUMBER METHOD - DT = .033300

K = .124821HR TP = .133300HR K/TP RATIO = .936388 SHAPE CONSTANT, N = 3.776847
UNIT PEAK = 7.8801 CFS UNIT VOLUME = .9986 B = 340.01 P60 = 1.2600
AREA = .003089 SQ MI IA = .42500 INCHES INF = 1.04000 INCHES PER HOUR
RUNOFF COMPUTED BY INITIAL ABSTRACTION/INFILTRATION NUMBER METHOD - DT = .033300

*S ONSITE FLOW EXITING AT RONDA DE LECHUSAS
PRINT HYD ID=3 CODE=1

PARTIAL HYDROGRAPH 104.10

RUNOFF VOLUME = .74122 INCHES = .2253 ACRE-FEET
PEAK DISCHARGE RATE = 7.02 CFS AT 1.499 HOURS BASIN AREA = .0057 SQ. MI.

* *****

COMPUTE NM HYD ID=8 HYD NO=90.0 DA=0.0213 SQ MI
PER A=100. PER B=0. PER C=0. PER D=0.
TP=-0.1349 HR MASS RAIN=-1

K = .181211HR TP = .134900HR K/TP RATIO = 1.343299 SHAPE CONSTANT, N = 2.679055
UNIT PEAK = 40.187 CFS UNIT VOLUME = .9987 B = 254.52 P60 = 1.2600
AREA = .021300 SQ MI IA = .65000 INCHES INF = 1.67000 INCHES PER HOUR
RUNOFF COMPUTED BY INITIAL ABSTRACTION/INFILTRATION NUMBER METHOD - DT = .033300

PRINT HYD ID=8 CODE=1

OUTFLOW HYDROGRAPH REACH 90.00

RUNOFF VOLUME = .08473 INCHES = .0963 ACRE-FEET
PEAK DISCHARGE RATE = 3.40 CFS AT 1.532 HOURS BASIN AREA = .0213 SQ. MI.

COMPUTE NM HYD ID=9 HYD NO=91.0 DA=0.0079 SQ MI
PER A=100. PER B=0. PER C=0. PER D=0.
TP=-0.1333 HR MASS RAIN=-1

K = .179062HR TP = .133300HR K/TP RATIO = 1.343299 SHAPE CONSTANT, N = 2.679055
UNIT PEAK = 15.084 CFS UNIT VOLUME = .9981 B = 254.52 P60 = 1.2600
AREA = .007900 SQ MI IA = .65000 INCHES INF = 1.67000 INCHES PER HOUR
RUNOFF COMPUTED BY INITIAL ABSTRACTION/INFILTRATION NUMBER METHOD - DT = .033300

PRINT HYD ID=9 CODE=1

OUTFLOW HYDROGRAPH REACH 91.00

RUNOFF VOLUME = .08473 INCHES = .0357 ACRE-FEET
PEAK DISCHARGE RATE = 1.28 CFS AT 1.532 HOURS BASIN AREA = .0079 SQ. MI.

*S TOTAL INFLOW INTO POND

ADD HYD ID=10 HYD NO=90.1 ID I=8 ID II=9
PRINT HYD ID=10 CODE=1

OUTFLOW HYDROGRAPH REACH 90.10

RUNOFF VOLUME = .08472 INCHES = .1319 ACRE-FEET
PEAK DISCHARGE RATE = 4.68 CFS AT 1.532 HOURS BASIN AREA = .0292 SQ. MI.

PUNCH HYD ID=10
*S ROUTE HYDROGRAPH THRU POND
ROUTE RESERVOIR ID=13 HYD NO=90.11 INFLOW ID=10 CODE=5

OUTFLOW (CFS)	STORAGE (AC FT)	ELEV (FT)
0.0	0.00	29.50
0.6	0.01	30.00
0.8	0.04	30.50
1.0	0.08	31.00
1.2	0.15	31.50
3.2	0.23	32.00
5.2	0.34	32.50
6.2	0.47	33.00
6.6	0.63	33.50
7.0	0.84	34.00
7.8	1.09	34.50

* * * * *

TIME (HRS)	INFLOW (CFS)	ELEV (FEET)	VOLUME (AC-FT)	OUTFLOW (CFS)
.00	.00	29.50	.000	.00
.17	.00	29.50	.000	.00
.33	.00	29.50	.000	.00
.50	.00	29.50	.000	.00
.67	.00	29.50	.000	.00
.83	.00	29.50	.000	.00
1.00	.00	29.50	.000	.00
1.17	.00	29.50	.000	.00
1.33	.00	29.50	.000	.00
1.50	4.36	30.12	.017	.65
1.67	2.88	30.77	.062	.91
1.83	1.15	30.93	.075	.97
2.00	.46	30.90	.072	.96
2.16	.33	30.80	.064	.92
2.33	.25	30.70	.056	.88
2.50	.18	30.59	.047	.83
2.66	.13	30.46	.038	.79
2.83	.10	30.32	.029	.73
3.00	.07	30.18	.021	.67
3.16	.05	30.04	.013	.62
3.33	.04	29.80	.006	.36
3.50	.03	29.65	.003	.18
3.66	.02	29.58	.002	.09
3.83	.02	29.54	.001	.05
4.00	.01	29.52	.000	.03
4.16	.01	29.52	.000	.02
4.33	.01	29.51	.000	.01
4.50	.00	29.51	.000	.01
4.66	.00	29.50	.000	.01
4.83	.00	29.50	.000	.00

PEAK DISCHARGE = .975 CFS - PEAK OCCURS AT HOUR 1.86

MAXIMUM WATER SURFACE ELEVATION = 30.937

MAXIMUM STORAGE = .0749 AC-FT INCREMENTAL TIME= .033300HRS

PRINT HYD ID=13 CODE=1

OUTFLOW HYDROGRAPH REACH 90.11

RUNOFF VOLUME = .08472 INCHES = .1319 ACRE-FEET

PEAK DISCHARGE RATE = .97 CFS AT 1.865 HOURS BASIN AREA = .0292 SQ. MI.

COMPUTE NM HYD ID=11 HYD NO=92.0 DA=0.0079 SQ MI
PER A=100. PER B=0. PER C=0. PER D=0.
TP=-0.1333 HR MASS RAIN=-1

K = .179062HR TP = .133300HR K/TP RATIO = 1.343299 SHAPE CONSTANT, N = 2.679055
UNIT PEAK = 15.084 CFS UNIT VOLUME = .9981 B = 254.52 P60 = 1.2600
AREA = .007900 SQ MI IA = .65000 INCHES INF = 1.67000 INCHES PER HOUR
RUNOFF COMPUTED BY INITIAL ABSTRACTION/INFILTRATION NUMBER METHOD - DT = .033300

PRINT HYD ID=11 CODE=1

OUTFLOW HYDROGRAPH REACH 92.00

RUNOFF VOLUME = .08473 INCHES = .0357 ACRE-FEET
PEAK DISCHARGE RATE = 1.28 CFS AT 1.532 HOURS BASIN AREA = .0079 SQ. MI.

ADD HYD ID=12 HYD NO=90.2 ID I=13 ID II=11
PRINT HYD ID=12 CODE=1

OUTFLOW HYDROGRAPH REACH 90.20

RUNOFF VOLUME = .08471 INCHES = .1676 ACRE-FEET
PEAK DISCHARGE RATE = 2.01 CFS AT 1.565 HOURS BASIN AREA = .0371 SQ. MI.

FINISH

NORMAL PROGRAM FINISH END TIME (HR:MIN:SEC) = 10:56:28

100 YEAR POST-DEVELOPMENT - DETAILED PRINTOUT

AHYMO PROGRAM (AHYMO392) - AMAFCA VERSION OF HYMO - MARCH, 1992
 RUN DATE (MON/DAY/YR) = 07/07/1993
 START TIME (HR:MIN:SEC) = 10:53:19 USER NO.= J_HUGHES.S92
 INPUT FILE = FAIR99PO.DAT

*S FAIRWAY MANOR - 100 YEAR POST DEVELOPMENT

START TIME=0.0 HR PUNCH CODE=0

RAINFALL TYPE=1 RAIN QUARTER=0.0
 RAIN ONE=1.88 IN RAIN SIX=2.21 IN
 RAIN DAY=2.66 IN DT=0.0333 HRS

COMPUTED 6-HOUR RAINFALL DISTRIBUTION BASED ON NOAA ATLAS 2 - PEAK AT 1.40 HR.

DT = .033300 HOURS			END TIME = 5.994000 HOURS			
.0000	.0016	.0033	.0050	.0067	.0084	.0102
.0121	.0140	.0159	.0179	.0199	.0220	.0242
.0264	.0287	.0310	.0334	.0360	.0385	.0412
.0440	.0469	.0499	.0530	.0563	.0597	.0633
.0671	.0711	.0753	.0805	.0860	.0919	.1042
.1322	.1756	.2379	.3230	.4350	.5779	.7560
.9734	1.1822	1.2679	1.3399	1.4039	1.4621	1.5157
1.5654	1.6119	1.6554	1.6964	1.7350	1.7716	1.8061
1.8388	1.8699	1.8994	1.9273	1.9539	1.9612	1.9669
1.9724	1.9777	1.9826	1.9874	1.9920	1.9964	2.0007
2.0048	2.0088	2.0126	2.0164	2.0200	2.0235	2.0270
2.0303	2.0336	2.0368	2.0399	2.0429	2.0459	2.0488
2.0517	2.0545	2.0572	2.0599	2.0625	2.0651	2.0677
2.0702	2.0726	2.0750	2.0774	2.0798	2.0821	2.0843
2.0866	2.0888	2.0909	2.0931	2.0952	2.0973	2.0993
2.1014	2.1034	2.1054	2.1073	2.1092	2.1112	2.1130
2.1149	2.1167	2.1186	2.1204	2.1222	2.1239	2.1257
2.1274	2.1291	2.1308	2.1325	2.1341	2.1358	2.1374
2.1390	2.1406	2.1422	2.1438	2.1453	2.1469	2.1484
2.1499	2.1514	2.1529	2.1544	2.1558	2.1573	2.1587
2.1602	2.1616	2.1630	2.1644	2.1658	2.1671	2.1685
2.1699	2.1712	2.1725	2.1739	2.1752	2.1765	2.1778
2.1791	2.1803	2.1816	2.1829	2.1841	2.1854	2.1866
2.1878	2.1891	2.1903	2.1915	2.1927	2.1939	2.1950
2.1962	2.1974	2.1986	2.1997	2.2009	2.2020	2.2031
2.2043	2.2054	2.2065	2.2076	2.2087	2.2098	

* *****
 COMPUTE NM HYD ID=1 HYD NO=101.0 DA=0.0168 SQ MI
 PER A=0.0 PER B=27.1 PER C=27.1 PER D=45.8
 TP=-0.1333 HR MASS RAIN=-1

K = .072649HR TP = .133300HR K/TP RATIO = .545000 SHAPE CONSTANT, N = 7.106420
 UNIT PEAK = 30.378 CFS UNIT VOLUME = .9990 B = 526.28 P60 = 1.8800
 AREA = .007694 SQ MI IA = .10000 INCHES INF = .04000 INCHES PER HOUR
 RUNOFF COMPUTED BY INITIAL ABSTRACTION/INFILTRATION NUMBER METHOD - DT = .033300

K = .118398HR TP = .133300HR K/TP RATIO = .888205 SHAPE CONSTANT, N = 3.993616
 UNIT PEAK = 24.232 CFS UNIT VOLUME = .9999 B = 354.74 P60 = 1.8800
 AREA = .009106 SQ MI IA = .42500 INCHES INF = 1.04000 INCHES PER HOUR
 RUNOFF COMPUTED BY INITIAL ABSTRACTION/INFILTRATION NUMBER METHOD - DT = .033300

PRINT HYD

ID=1 CODE=1

PARTIAL HYDROGRAPH 101.00

RUNOFF VOLUME = 1.35139 INCHES = 1.2108 ACRE-FEET
PEAK DISCHARGE RATE = 35.96 CFS AT 1.499 HOURS BASIN AREA = .0168 SQ. MI.

COMPUTE NM HYD

ID=2 HYD NO=102.1 DA=0.0012 SQ MI
PER A=0.0 PER B=27.1 PER C=27.1 PER D=45.8
TP=-0.1333 HR MASS RAIN=-1

K = .072649HR TP = .133300HR K/TP RATIO = .545000 SHAPE CONSTANT, N = 7.106420
UNIT PEAK = 2.1698 CFS UNIT VOLUME = .9941 B = 526.28 P60 = 1.8800
AREA = .000550 SQ MI IA = .10000 INCHES INF = .04000 INCHES PER HOUR
RUNOFF COMPUTED BY INITIAL ABSTRACTION/INFILTRATION NUMBER METHOD - DT = .033300

K = .118398HR TP = .133300HR K/TP RATIO = .888205 SHAPE CONSTANT, N = 3.993616
UNIT PEAK = 1.7309 CFS UNIT VOLUME = .9930 B = 354.74 P60 = 1.8800
AREA = .000650 SQ MI IA = .42500 INCHES INF = 1.04000 INCHES PER HOUR
RUNOFF COMPUTED BY INITIAL ABSTRACTION/INFILTRATION NUMBER METHOD - DT = .033300

PRINT HYD

ID=2 CODE=1

PARTIAL HYDROGRAPH 102.10

RUNOFF VOLUME = 1.35139 INCHES = .0865 ACRE-FEET
PEAK DISCHARGE RATE = 2.58 CFS AT 1.499 HOURS BASIN AREA = .0012 SQ. MI.

COMPUTE NM HYD

ID=3 HYD NO=102.2 DA=0.0034 SQ MI
PER A=0.0 PER B=27.1 PER C=27.1 PER D=45.8
TP=-0.1333 HR MASS RAIN=-1

K = .072649HR TP = .133300HR K/TP RATIO = .545000 SHAPE CONSTANT, N = 7.106420
UNIT PEAK = 6.1479 CFS UNIT VOLUME = .9975 B = 526.28 P60 = 1.8800
AREA = .001557 SQ MI IA = .10000 INCHES INF = .04000 INCHES PER HOUR
RUNOFF COMPUTED BY INITIAL ABSTRACTION/INFILTRATION NUMBER METHOD - DT = .033300

K = .118398HR TP = .133300HR K/TP RATIO = .888205 SHAPE CONSTANT, N = 3.993616
UNIT PEAK = 4.9041 CFS UNIT VOLUME = .9978 B = 354.74 P60 = 1.8800
AREA = .001843 SQ MI IA = .42500 INCHES INF = 1.04000 INCHES PER HOUR
RUNOFF COMPUTED BY INITIAL ABSTRACTION/INFILTRATION NUMBER METHOD - DT = .033300

PRINT HYD

ID=3 CODE=1

PARTIAL HYDROGRAPH 102.20

RUNOFF VOLUME = 1.35139 INCHES = .2451 ACRE-FEET
PEAK DISCHARGE RATE = 7.29 CFS AT 1.499 HOURS BASIN AREA = .0034 SQ. MI.

* *****
COMPUTE NM HYD ID=4 HYD NO=104.0 DA=0.0133 SQ MI
PER A=0.0 PER B=27.1 PER C=27.1 PER D=45.8
TP=-0.1333 HR MASS RAIN=-1

K = .072649HR TP = .133300HR K/TP RATIO = .545000 SHAPE CONSTANT, N = 7.106420
UNIT PEAK = 24.049 CFS UNIT VOLUME = .9989 B = 526.28 P60 = 1.8800
AREA = .006091 SQ MI IA = .10000 INCHES INF = .04000 INCHES PER HOUR
RUNOFF COMPUTED BY INITIAL ABSTRACTION/INFILTRATION NUMBER METHOD - DT = .033300

K = .118398HR TP = .133300HR K/TP RATIO = .888205 SHAPE CONSTANT, N = 3.993616
UNIT PEAK = 19.184 CFS UNIT VOLUME = .9997 B = 354.74 P60 = 1.8800
AREA = .007209 SQ MI IA = .42500 INCHES INF = 1.04000 INCHES PER HOUR
RUNOFF COMPUTED BY INITIAL ABSTRACTION/INFILTRATION NUMBER METHOD - DT = .033300

PRINT HYD ID=4 CODE=1

PARTIAL HYDROGRAPH 104.00

RUNOFF VOLUME = 1.35139 INCHES = .9586 ACRE-FEET
PEAK DISCHARGE RATE = 28.47 CFS AT 1.499 HOURS BASIN AREA = .0133 SQ. MI.

COMPUTE NM HYD ID=5 HYD NO=105.0 DA=0.012 SQ MI
PER A=0.0 PER B=27.1 PER C=27.1 PER D=45.8
TP=-0.1333 HR MASS RAIN=-1

K = .072649HR TP = .133300HR K/TP RATIO = .545000 SHAPE CONSTANT, N = 7.106420
UNIT PEAK = 21.698 CFS UNIT VOLUME = .9988 B = 526.28 P60 = 1.8800
AREA = .005496 SQ MI IA = .10000 INCHES INF = .04000 INCHES PER HOUR
RUNOFF COMPUTED BY INITIAL ABSTRACTION/INFILTRATION NUMBER METHOD - DT = .033300

K = .118398HR TP = .133300HR K/TP RATIO = .888205 SHAPE CONSTANT, N = 3.993616
UNIT PEAK = 17.309 CFS UNIT VOLUME = .9997 B = 354.74 P60 = 1.8800
AREA = .006504 SQ MI IA = .42500 INCHES INF = 1.04000 INCHES PER HOUR
RUNOFF COMPUTED BY INITIAL ABSTRACTION/INFILTRATION NUMBER METHOD - DT = .033300

PRINT HYD ID=5 CODE=1

PARTIAL HYDROGRAPH 105.00

RUNOFF VOLUME = 1.35139 INCHES = .8649 ACRE-FEET
PEAK DISCHARGE RATE = 25.69 CFS AT 1.499 HOURS BASIN AREA = .0120 SQ. MI.

*S ON-SITE FLOW IN RONDA DE LACHUSAS
ADD HYD ID=6 HYD NO=105.1 ID I=4 ID II=5
PRINT HYD ID=6 CODE=1

PARTIAL HYDROGRAPH 105.10

RUNOFF VOLUME = 1.35137 INCHES = 1.8234 ACRE-FEET
PEAK DISCHARGE RATE = 54.16 CFS AT 1.499 HOURS BASIN AREA = .0253 SQ. MI.

*S AREAS 101, 102.1, 102.2, 104, & 105 DRAIN NORTH TO THE LA RINCONADA CHANNEL
ADD HYD ID=1 HYD NO=101.11 ID I=1 ID II=6
PRINT HYD ID=1 CODE=1

PARTIAL HYDROGRAPH 101.11

RUNOFF VOLUME = 1.35137 INCHES = 3.0343 ACRE-FEET
PEAK DISCHARGE RATE = 90.12 CFS AT 1.499 HOURS BASIN AREA = .0421 SQ. MI.

ADD HYD ID=1 HYD NO=101.12 ID I=1 ID II=3
PRINT HYD ID=1 CODE=1

PARTIAL HYDROGRAPH 101.12

RUNOFF VOLUME = 1.35137 INCHES = 3.2793 ACRE-FEET
PEAK DISCHARGE RATE = 97.41 CFS AT 1.499 HOURS BASIN AREA = .0455 SQ. MI.

*S TOTAL FLOW TO THE LA RINCONADA CHANNEL
ADD HYD ID=1 HYD NO=101.12 ID I=1 ID II=2
PRINT HYD ID=1 CODE=1

PARTIAL HYDROGRAPH 101.12

RUNOFF VOLUME = 1.35136 INCHES = 3.3658 ACRE-FEET
PEAK DISCHARGE RATE = 99.99 CFS AT 1.499 HOURS BASIN AREA = .0467 SQ. MI.

* *****
COMPUTE NM HYD ID=3 HYD NO=103.0 DA=0.0031 SQ MI
PER A=0.0 PER B=27.1 PER C=27.1 PER D=45.8
TP=-0.1333 HR MASS RAIN=-1

K = .072649HR TP = .133300HR K/TP RATIO = .545000 SHAPE CONSTANT, N = 7.106420
UNIT PEAK = 5.6054 CFS UNIT VOLUME = .9972 B = 526.28 P60 = 1.8800
AREA = .001420 SQ MI IA = .10000 INCHES INF = .04000 INCHES PER HOUR
RUNOFF COMPUTED BY INITIAL ABSTRACTION/INFILTRATION NUMBER METHOD - DT = .033300

K = .118398HR TP = .133300HR K/TP RATIO = .888205 SHAPE CONSTANT, N = 3.993616
UNIT PEAK = 4.4714 CFS UNIT VOLUME = .9975 B = 354.74 P60 = 1.8800
AREA = .001680 SQ MI IA = .42500 INCHES INF = 1.04000 INCHES PER HOUR
RUNOFF COMPUTED BY INITIAL ABSTRACTION/INFILTRATION NUMBER METHOD - DT = .033300

PRINT HYD ID=3 CODE=1

PARTIAL HYDROGRAPH 103.00

RUNOFF VOLUME = 1.35139 INCHES = .2234 ACRE-FEET
PEAK DISCHARGE RATE = 6.65 CFS AT 1.499 HOURS BASIN AREA = .0031 SQ. MI.

COMPUTE NM HYD ID=4 HYD NO=102.3 DA=0.0012 SQ MI
PER A=0.0 PER B=27.1 PER C=27.1 PER D=45.8
TP=-0.1333 HR MASS RAIN=-1

K = .072649HR TP = .133300HR K/TP RATIO = .545000 SHAPE CONSTANT, N = 7.106420
UNIT PEAK = 2.1698 CFS UNIT VOLUME = .9941 B = 526.28 P60 = 1.8800
AREA = .000550 SQ MI IA = .10000 INCHES INF = .04000 INCHES PER HOUR
RUNOFF COMPUTED BY INITIAL ABSTRACTION/INFILTRATION NUMBER METHOD - DT = .033300

K = .118398HR TP = .133300HR K/TP RATIO = .888205 SHAPE CONSTANT, N = 3.993616
UNIT PEAK = 1.7309 CFS UNIT VOLUME = .9930 B = 354.74 P60 = 1.8800
AREA = .000650 SQ MI IA = .42500 INCHES INF = 1.04000 INCHES PER HOUR
RUNOFF COMPUTED BY INITIAL ABSTRACTION/INFILTRATION NUMBER METHOD - DT = .033300

PRINT HYD ID=4 CODE=1

PARTIAL HYDROGRAPH 102.30

RUNOFF VOLUME = 1.35139 INCHES = .0865 ACRE-FEET
PEAK DISCHARGE RATE = 2.58 CFS AT 1.499 HOURS BASIN AREA = .0012 SQ. MI.

*S FLOW EXITING SITE AT VISTA DEL SUR
ADD HYD ID=2 HYD NO=105.1 ID I=3 ID II=4
PRINT HYD ID=2 CODE=1

PARTIAL HYDROGRAPH 105.10

RUNOFF VOLUME = 1.35127 INCHES = .3099 ACRE-FEET
PEAK DISCHARGE RATE = 9.23 CFS AT 1.499 HOURS BASIN AREA = .0043 SQ. MI.

* *****
COMPUTE NM HYD ID=3 HYD NO=104.1 DA=0.0057 SQ MI
PER A=0.0 PER B=27.1 PER C=27.1 PER D=45.8
TP=-0.1333 HR MASS RAIN=-1

K = .072649HR TP = .133300HR K/TP RATIO = .545000 SHAPE CONSTANT, N = 7.106420
UNIT PEAK = 10.307 CFS UNIT VOLUME = .9982 B = 526.28 P60 = 1.8800
AREA = .002611 SQ MI IA = .10000 INCHES INF = .04000 INCHES PER HOUR
RUNOFF COMPUTED BY INITIAL ABSTRACTION/INFILTRATION NUMBER METHOD - DT = .033300

K = .118398HR TP = .133300HR K/TP RATIO = .888205 SHAPE CONSTANT, N = 3.993616
UNIT PEAK = 8.2216 CFS UNIT VOLUME = .9988 B = 354.74 P60 = 1.8800
AREA = .003089 SQ MI IA = .42500 INCHES INF = 1.04000 INCHES PER HOUR
RUNOFF COMPUTED BY INITIAL ABSTRACTION/INFILTRATION NUMBER METHOD - DT = .033300

*S ONSITE FLOW EXITING AT RONDA DE LECHUSAS
PRINT HYD ID=3 CODE=1

PARTIAL HYDROGRAPH 104.10

RUNOFF VOLUME = 1.35139 INCHES = .4108 ACRE-FEET
PEAK DISCHARGE RATE = 12.21 CFS AT 1.499 HOURS BASIN AREA = .0057 SQ. MI.

* *****
COMPUTE NM HYD ID=8 HYD NO=90.0 DA=0.0213 SQ MI
PER A=100. PER B=0. PER C=0. PER D=0.
TP=-0.1349 HR MASS RAIN=-1

K = .165393HR TP = .134900HR K/TP RATIO = 1.226044 SHAPE CONSTANT, N = 2.903816
UNIT PEAK = 43.245 CFS UNIT VOLUME = .9993 B = 273.88 P60 = 1.8800
AREA = .021300 SQ MI IA = .65000 INCHES INF = 1.67000 INCHES PER HOUR
RUNOFF COMPUTED BY INITIAL ABSTRACTION/INFILTRATION NUMBER METHOD - DT = .033300

PRINT HYD ID=8 CODE=1

OUTFLOW HYDROGRAPH REACH 90.00

RUNOFF VOLUME = .44534 INCHES = .5059 ACRE-FEET
PEAK DISCHARGE RATE = 17.78 CFS AT 1.532 HOURS BASIN AREA = .0213 SQ. MI.

COMPUTE NM HYD ID=9 HYD NO=91.0 DA=0.0079 SQ MI
PER A=100. PER B=0. PER C=0. PER D=0.
TP=-0.1333 HR MASS RAIN=-1

K = .163432HR TP = .133300HR K/TP RATIO = 1.226044 SHAPE CONSTANT, N = 2.903816
UNIT PEAK = 16.232 CFS UNIT VOLUME = .9988 B = 273.88 P60 = 1.8800
AREA = .007900 SQ MI IA = .65000 INCHES INF = 1.67000 INCHES PER HOUR
RUNOFF COMPUTED BY INITIAL ABSTRACTION/INFILTRATION NUMBER METHOD - DT = .033300

PRINT HYD ID=9 CODE=1

OUTFLOW HYDROGRAPH REACH 91.00

RUNOFF VOLUME = .44534 INCHES = .1876 ACRE-FEET
PEAK DISCHARGE RATE = 6.66 CFS AT 1.532 HOURS BASIN AREA = .0079 SQ. MI.

*S TOTAL INFLOW INTO POND
ADD HYD ID=10 HYD NO=90.1 ID I=8 ID II=9
PRINT HYD ID=10 CODE=1

OUTFLOW HYDROGRAPH REACH 90.10

RUNOFF VOLUME = .44533 INCHES = .6935 ACRE-FEET
PEAK DISCHARGE RATE = 24.44 CFS AT 1.532 HOURS BASIN AREA = .0292 SQ. MI.

PUNCH HYD ID=10
*S ROUTE HYDROGRAPH THRU POND
ROUTE RESERVOIR ID=13 HYD NO=90.11 INFLOW ID=10 CODE=5

OUTFLOW (CFS)	STORAGE (AC FT)	ELEV (FT)
0.0	0.00	29.50
0.6	0.01	30.00
0.8	0.04	30.50
1.0	0.08	31.00
1.2	0.15	31.50
3.2	0.23	32.00
5.2	0.34	32.50
6.2	0.47	33.00
6.6	0.63	33.50
7.0	0.84	34.00
7.8	1.09	34.50

* * * * *

TIME (HRS)	INFLOW (CFS)	ELEV (FEET)	VOLUME (AC-FT)	OUTFLOW (CFS)
.00	.00	29.50	.000	.00
.17	.00	29.50	.000	.00
.33	.00	29.50	.000	.00
.50	.00	29.50	.000	.00
.67	.00	29.50	.000	.00
.83	.00	29.50	.000	.00
1.00	.00	29.50	.000	.00
1.17	.00	29.50	.000	.00
1.33	.00	29.50	.000	.00
1.50	23.74	31.40	.136	1.16
1.67	14.17	32.61	.369	5.42
1.83	5.21	32.79	.415	5.77
2.00	2.33	32.67	.383	5.53
2.16	1.64	32.48	.336	5.13
2.33	1.17	32.28	.291	4.30
2.50	.84	32.09	.250	3.57
2.66	.60	31.91	.216	2.84
2.83	.43	31.74	.188	2.16
3.00	.30	31.61	.167	1.64
3.16	.22	31.51	.151	1.23
3.33	.16	31.41	.138	1.16
3.50	.11	31.31	.124	1.12
3.66	.08	31.21	.110	1.08
3.83	.06	31.11	.096	1.05
4.00	.04	31.02	.083	1.01
4.16	.03	30.87	.070	.95
4.33	.02	30.72	.057	.89
4.50	.01	30.57	.046	.83
4.66	.01	30.41	.035	.77
4.83	.01	30.25	.025	.70
5.00	.00	30.10	.016	.64
5.16	.00	29.88	.008	.46
5.33	.00	29.67	.003	.20
5.49	.00	29.57	.001	.09
5.66	.00	29.53	.001	.04
5.83	.00	29.51	.000	.02
5.99	.00	29.51	.000	.01
6.16	.00	29.50	.000	.00

PEAK DISCHARGE = 5.773 CFS - PEAK OCCURS AT HOUR 1.83

MAXIMUM WATER SURFACE ELEVATION = 32.787

MAXIMUM STORAGE = .4145 AC-FT INCREMENTAL TIME= .033300HRS

PRINT HYD

ID=13 CODE=1

OUTFLOW HYDROGRAPH REACH 90.11

RUNOFF VOLUME = .44533 INCHES = .6935 ACRE-FEET
PEAK DISCHARGE RATE = 5.77 CFS AT 1.832 HOURS BASIN AREA = .0292 SQ. MI.

COMPUTE NM HYD

ID=11 HYD NO=92.0 DA=0.0079 SQ MI
PER A=100. PER B=0. PER C=0. PER D=0.
TP=-0.1333 HR MASS RAIN=-1

K = .163432HR TP = .133300HR K/TP RATIO = 1.226044 SHAPE CONSTANT, N = 2.903816
UNIT PEAK = 16.232 CFS UNIT VOLUME = .9988 B = 273.88 P60 = 1.8800
AREA = .007900 SQ MI IA = .65000 INCHES INF = 1.67000 INCHES PER HOUR
RUNOFF COMPUTED BY INITIAL ABSTRACTION/INFILTRATION NUMBER METHOD - DT = .033300

PRINT HYD

ID=11 CODE=1

OUTFLOW HYDROGRAPH REACH 92.00

RUNOFF VOLUME = .44534 INCHES = .1876 ACRE-FEET
PEAK DISCHARGE RATE = 6.66 CFS AT 1.532 HOURS BASIN AREA = .0079 SQ. MI.

ADD HYD

ID=12 HYD NO=90.2 ID I=13 ID II=11

PRINT HYD

ID=12 CODE=1

OUTFLOW HYDROGRAPH REACH 90.20

RUNOFF VOLUME = .44532 INCHES = .8811 ACRE-FEET
PEAK DISCHARGE RATE = 9.99 CFS AT 1.598 HOURS BASIN AREA = .0371 SQ. MI.

FINISH

NORMAL PROGRAM FINISH

END TIME (HR:MIN:SEC) = 10:53:27

[1] INLET NUMBER 104.1
 [2] COMBINATION GRATE & CURB INLET ON A CONTINUOUS GRADE
 [3] STATION
 [4] PEAK DISCHARGE IS 9.23 (cfs)
 [7] APPROACH GUTTER ' N 'VALUE .017
 [8] GUTTER LONGITUDINAL SLOPE .005 (ft/ft)
 [9] PAVEMENT CROSS SLOPE .02 (ft/ft)
 [10] WIDTH OF GUTTER IS 2 (ft)
 [11] GUTTER CROSS SLOPE IS .0625 (ft/ft)
 [12] WIDTH OF LOCAL DEPRESSION IS 2 (ft.)
 [13] AMOUNT OF LOCAL DEPRESSION IS 2.75 (in.)
 [14] WIDTH OF GRATE IS 2 (ft.)
 [15] LENGTH OF GRATE IS 3.33 (ft.)

Enter number of item you want to change or
 enter a 0 if all items are ok.?

PROJECT 25206

HEC12 Version: V2.30 User S/N: 77010133

Run Date: 06-18-1993

=====

INLET NUMBER 104.1	LENGTH 7.5	STATION
--------------------	------------	---------

TOTAL PEAK DISCHARGE = 9.23 (cfs)

GUTTER SLOPE = 0.0050 FT/FT PAVEMENT CROSS SLOPE = 0.0200 FT/FT

SPREAD	W	W/T	SW	SW/SX	Eo	a	S'W	SE
18.95	2.0	0.11	0.0625	3.1	0.29	3.8	0.157	0.066

XXXXXXXXXXXX COMBINATION GRATE CURB INLET ON A GRADE XXXXXXXXXXXX
 SLOT INTERCEPTS 3.43 CFS GRATE INTERCEPTS 3.79 CFS
 CFS INTERCEPTED= 7.22 CFS CARRYOVER= 2.01

Handwritten: $Q = 6.5 \text{ cfs}$

```

[ 1 ] INLET NUMBER 104.2
[ 2 ] COMBINATION GRATE & CURB INLET ON A CONTINUOUS GRADE
[ 3 ] STATION
[ 4 ] PEAK DISCHARGE IS 8.34 (cfs)
[ 7 ] APPROACH GUTTER ' N 'VALUE .017
[ 8 ] GUTTER LONGITUDINAL SLOPE .005 (ft/ft)
[ 9 ] PAVEMENT CROSS SLOPE .02 (ft/ft)
[10 ] WIDTH OF GUTTER IS 2 (ft)
[11 ] GUTTER CROSS SLOPE IS .0625 (ft/ft)
[12 ] WIDTH OF LOCAL DEPRESSION IS 2 (ft.)
[13 ] AMOUNT OF LOCAL DEPRESSION IS 2.75 (in.)
[14 ] WIDTH OF GRATE IS 2 (ft.)
[15 ] LENGTH OF GRATE IS 3.33 (ft.)

```

Enter number of item you want to change or
enter a 0 if all items are ok.?

```

=====
INLET NUMBER 104.2          LENGTH 7.5          STATION

```

TOTAL PEAK DISCHARGE = 8.34 (cfs)

GUTTER SLOPE = 0.0050 FT/FT

PAVEMENT CROSS SLOPE = 0.0200 FT/FT

SPREAD	W	W/T	SW	SW/SX	Eo	a	S'W	SE
18.21	2.0	0.11	0.0625	3.1	0.30	3.8	0.157	0.068

```

XXXXXXXXXXXX COMBINATION GRATE CURB INLET ON A GRADE XXXXXXXXXXXX
SLOT INTERCEPTS 3.27 CFS          GRATE INTERCEPTS 3.45 CFS
CFS INTERCEPTED= 6.72            CFS CARRYOVER= 1.62

```

```

[ 1 ] INLET NUMBER 104.3
[ 2 ] COMBINATION GRATE & CURB INLET ON A CONTINUOUS GRADE
[ 3 ] STATION
[ 4 ] PEAK DISCHARGE IS 1.62 (cfs)
[ 7 ] APPROACH GUTTER ' N 'VALUE .017
[ 8 ] GUTTER LONGITUDINAL SLOPE .005 (ft/ft)
[ 9 ] PAVEMENT CROSS SLOPE .02 (ft/ft)
[10 ] WIDTH OF GUTTER IS 2 (ft)
[11 ] GUTTER CROSS SLOPE IS .0625 (ft/ft)
[12 ] WIDTH OF LOCAL DEPRESSION IS 2 (ft.)
[13 ] AMOUNT OF LOCAL DEPRESSION IS 2.75 (in.)
[14 ] WIDTH OF GRATE IS 2 (ft.)
[15 ] LENGTH OF GRATE IS 3.33 (ft.)

```

Enter number of item you want to change or
enter a 0 if all items are ok.?

```

=====
INLET NUMBER 104.3          LENGTH  7.5          STATION

```

TOTAL PEAK DISCHARGE = 1.62 (cfs)

GUTTER SLOPE = 0.0050 FT/FT PAVEMENT CROSS SLOPE = 0.0200 FT/FT

SPREAD	W	W/T	SW	SW/SX	Eo	a	S'W	SE
9.32	2.0	0.21	0.0625	3.1	0.57	3.8	0.157	0.109

```

XXXXXXXXXXXX COMBINATION GRATE CURB INLET ON A GRADE XXXXXXXXXXXX
SLOT INTERCEPTS 1.36 CFS          GRATE INTERCEPTS 0.26 CFS
CFS INTERCEPTED= 1.62             CFS CARRYOVER= 0.00

```

[1] INLET NUMBER 104.4
 [2] COMBINATION GRATE & CURB INLET ON A CONTINUOUS GRADE
 [3] STATION
 [4] PEAK DISCHARGE IS 5.7 (cfs)
 [7] APPROACH GUTTER ' N 'VALUE .017
 [8] GUTTER LONGITUDINAL SLOPE .005 (ft/ft)
 [9] PAVEMENT CROSS SLOPE .02 (ft/ft)
 [10] WIDTH OF GUTTER IS 2 (ft)
 [11] GUTTER CROSS SLOPE IS .0625 (ft/ft)
 [12] WIDTH OF LOCAL DEPRESSION IS 2 (ft.)
 [13] AMOUNT OF LOCAL DEPRESSION IS 2.75 (in.)
 [14] WIDTH OF GRATE IS 2 (ft.)
 [15] LENGTH OF GRATE IS 3.33 (ft.)

Enter number of item you want to change or
 enter a 0 if all items are ok.?

=====

INLET NUMBER 104.4	LENGTH 7.5	STATION
--------------------	------------	---------

TOTAL PEAK DISCHARGE = 5.70 (cfs)

GUTTER SLOPE = 0.0050 FT/FT

PAVEMENT CROSS SLOPE = 0.0200 FT/FT

SPREAD	W	W/T	SW	SW/SX	Eo	a	S'W	SE
15.68	2.0	0.13	0.0625	3.1	0.35	3.8	0.157	0.075

XXXXXXXXXX COMBINATION GRATE CURB INLET ON A GRADE XXXXXXXXXXXX
SLOT INTERCEPTS 2.71 CFS GRATE INTERCEPTS 2.36 CFS
CFS INTERCEPTED= 5.08 CFS CARRYOVER= 0.62

Plots 22.3
Q intercepts = 5 cfs
total
OK

[1] INLET NUMBER 105.1
 [2] GRATE INLET IN A SUMP
 [3] STATION
 [4] PEAK DISCHARGE FOR FIRST SIDE IS 25.69 (cfs)
 PEAK DISCHARGE FOR OTHER SIDE IS 0 (cfs)
 TOTAL PEAK DISCHARGE IS 25.69 (cfs)
 [7] APPROACH GUTTER ' N 'VALUE .017
 [8] GUTTER LONGITUDINAL SLOPE .005 (ft/ft)
 [9] PAVEMENT CROSS SLOPE .001 (ft/ft)
 [10] WIDTH OF GUTTER IS 6.7 (ft)
 [11] GUTTER CROSS SLOPE IS .001 (ft/ft)
 [12] WIDTH OF LOCAL DEPRESSION IS 6.7 (ft.)
 [13] AMOUNT OF LOCAL DEPRESSION IS 2.75 (in.)

Enter number of item you want to change or
 enter a 0 if all items are ok.?

=====

INLET NUMBER 105.1	LENGTH 10.8	STATION
--------------------	-------------	---------

TOTAL PEAK DISCHARGE = 25.69 (cfs)

GUTTER SLOPE = 0.0050 FT/FT PAVEMENT CROSS SLOPE = 0.0010 FT/FT

SPREAD AT A SLOPE OF .005 (ft./ft.) IS %186.08 (ft.)

XXXXXXXXXXXX GRATE INLET IN A SUMP XXXXXXXXXXXX

DEPTH OF WATER (ft) = 0.77 SPREAD (ft) = %772.99

Grate operates as A WEIR

PIPE CAPACITY CALCULATIONS

FAIRWAY MANOR STORM DRAIN HGL

STATION	STRUCTURE	DIAM (in)	Q	AREA	VEL	K	Sf (%)	LENGTH	ANGLE (degrees)	Hf	Hb	Hj	Hmh	Ht	TOTAL LOSS	HGL (dn)	HGL (up)	PIPE INVERT	PIPE SOFFIT	HV	EGL (dn)	EGL (up)	JUNCTION DIA 3	ANGLE
	CHANNEL																16.00	9.78	13.78	0.98		16.98		
		48	99.99	12.56	7.96	1435.70	0.49	32.54		0.16					0.16									
	MH#102.1C								40.36		0.13		0.05	0.00	0.18	16.16	16.34	10.13	14.13	0.98	17.14	17.32		
		48	99.99	12.56	7.96	1435.70	0.49	91.52		0.44					0.44									
	MH#102.1B								32.90		0.12		0.05	0.01	0.22	16.78	17.05	10.76	14.76	0.93	17.77	17.99	24.00	65.18
		48	97.41	12.56	7.76	1435.70	0.46	58.73		0.27			0.05	0.01	0.27									
	1+00.00	MH#102.1A							52.41		0.14		0.05	0.01	0.31	17.32	17.77	11.04	15.04	0.80	18.26	18.57	24.00	45.00
		48	90.12	12.56	7.18	1435.70	0.39	132.60		0.52				0.52										
	15+65.30	MH#101E							0.00		0.00		0.04	0.05	0.60	18.29	19.40	11.35	15.35	0.29	19.09	19.69	24.00	90.00
		48	54.16	12.56	4.31	1435.70	0.14	400.13		0.57				0.57										
	11+65.17	MH#101D							90.00		0.06		0.01	0.04	0.11	19.97	19.88	12.75	16.25	0.49	20.26	20.37		
		42	54.16	9.62	5.63	1005.59	0.29	72.79		0.21					0.21									
	6+60.80	MH#101C							21.01		0.05		0.02	0.00	0.07	20.09	20.16	13.05	16.55	0.49	20.58	20.66		
		42	54.16	9.62	5.63	1005.59	0.29	111.74		0.32					0.32									
	5+51.79	MH#101B							24.10		0.05		0.02	0.00	0.08	20.49	20.56	13.42	16.92	0.49	20.98	21.05		
		42	54.16	9.62	5.63	1005.59	0.29	86.71		0.25					0.25									
	4+67.41	MH#101A							14.48		0.04		0.02	0.00	0.06	20.81	20.88	13.74	17.24	0.49	21.31	21.37		
		42	54.16	9.62	5.63	1005.59	0.29	357.95		1.04					1.04									
	5+59.06	MH#104B							90.00		0.10		0.02	0.02	0.87	21.92	22.98	15.07	18.07	0.29	22.41	23.28	24.00	98.00
		36	30.77	7.07	4.36	666.65	0.21	222.44		0.47					0.47									
	7+81.50	MH#104A							90.00		0.06		0.01	0.01	0.20	23.46	23.74	15.80	18.80	0.21	23.75	23.95	24.00	135.00
		36	25.69	7.07	3.64	666.65	0.15	232.40		0.35					0.35									
	6+45.37	INLET#105.1							0.00		0.00		0.01	0.02	0.03	24.09	24.32	17.10	20.10	0.00	24.29	24.32		

DRAINAGE AREA 102.1

[illegible]

DRAINAGE AREA 102.2

[illegible]

DRAINAGE AREA 101

[illegible]

DRAINAGE AREA 104

5-59.06	M/H#104B									16.07	18.07								
		24	14.44	3.14	4.60	226.11	0.41	59.61		0.24		0.24							
5-00.00	INLET 104.1L							90.00		0.07	0.25	0.02	18.31	23.79	17.14	19.14	0.08	18.31	23.87
		24	7.22	3.14	2.30	226.11	0.10	36.00		0.04		0.04						24.00	90.00
5-00.00	INLET 104.1R							0.00		0.00		0.00	0.01	23.83	23.92	18.08	20.08	0.00	23.91
													0.01					23.92	

5-59.06	MH#104B									16.07	18.07		18.07			
		24	8.34	3.14	2.66	226.11	0.14	31.53				0.04				
5-89.56	INLET 104.2							15.00				0.01	0.11	0.01	0.01	
		24	1.62	3.14	0.52	226.11	0.01	15.00				0.00				
6-04.56	INLET 104.3							0.00				0.00	0.00	0.00	0.00	

[illegible]

TEMPORARY POND OUTLET STRUCTURE ORIFICE

Outlet Structure File: FAIRWAY .STR

POND-2 Version: 4.01 S/N: 88020607
Date Executed: 07-07-1993 Time Executed: 11:05:39

Outflow Rating Table for Structure #01
ORIFICE Orifice - Based on Area and Datum Elevation

Elevation (ft)	Q (cfs)	Computation Messages
29.50	0.0	E < E1=30
30.00	0.0	H = 0.0
30.50	0.6	H = .5
31.00	0.8	H = 1.0
31.50	1.0	H = 1.5
32.00	1.2	H = 2.0
32.50	1.3	H = 2.5
32.80	1.4	H = 2.8
33.00	1.5	H = 3.0
33.50	1.6	H = 3.5
34.00	1.7	H = 4.0
34.50	1.8	H = 4.5
35.00	0.0	E = or > E2=35

C = .62 A = .17 sq.ft.

H (ft) = Table elev. - Datum elev. (30 ft)

Q (cfs) = C * A * $\sqrt{2g * H}$

12" CMP RISER

Outlet Structure File: FAIRWAY .STR

POND-2 Version: 4.01 S/N: 88020607
Date Executed: 07-07-1993 Time Executed: 11:05:39

Outflow Rating Table for Structure #03
STAND PIPE Stand Pipe with weir or orifice flow

***** INLET CONTROL ASSUMED *****

Elevation (ft)	Q (cfs)	Computation Messages
29.50	0.0	E = or > E2=35.0
30.00	0.0	E = or > E2=35.0
30.50	0.0	E = or > E2=35.0
31.00	0.0	E = or > E2=35.0
31.50	0.0	E = or > E2=35.0
32.00	0.0	Transition: H = 0.0
32.50	1.9	Transition: H = .5
32.80	3.0	Transition: H = .8
33.00	3.8	Transition: H = 1.0
33.50	4.6	Orifice: H = 1.5
34.00	5.3	Orifice: H = 2.0
34.50	6.0	Orifice: H = 2.5
35.00	0.0	E = or > E2=35.0

Weir Cw = 2.7 Weir length = 3.141593 ft
Orifice Co = .6 Orifice area = .7853982 sq.ft.
 $Q \text{ (cfs)} = (Cw * L * H^{1.5}) \text{ or } (Co * A * \sqrt{2 * g * H})$
Transition interpolated between elev. 32 and 33 ft
Weir equation = Orifice equation @ elev.= 32.44583 ft

June 21, 1993

Mr. Gilbert Aldaz, P.E.
Public Works Section
Hydrology Department
P. O. Box 1293
Albuquerque, New Mexico 87103

Re: Fairway Manor - Variance Request


Dear Mr. Aldaz:

As we discussed Thursday afternoon, June 17th, the revised drainage plan for Fairway Manor redirects a large portion of the onsite stormwater back to the north into the Rinconada Channel. This subdivision will still discharge about 12 cfs (100 yr. flow) to the south down Ronda De Lechusas where the Unit 7 drainage plan showed only 6 cfs coming from this site in its undeveloped condition. Drainage from this proposed subdivision will be limited to runoff from those lots which front on the existing portions of Ronda De Lechusas and Vista Alegre, since those streets already have established grades on them.

From the Unit 7 Report, there is an existing flow at the downstream end of Ronda De Lechusas of 49.8 cfs which produces a sub-critical street flow depth of 0.69' (as-built geometry as previously documented is 40'F-F @ 0.40%). We are now proposing a total flow of 55.81 cfs at that same location which will produce a new street flow depth of 0.72'.

Please allow this depth as it is an insignificant increase and the only portions of Fairway Manor contributing flows are those lots which front on already constructed streets which drain to Ronda De Lechusas.

Very truly yours,

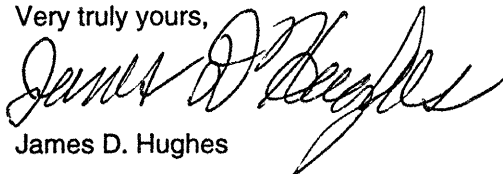

James D. Hughes

JDH/bjn

Enclosures: Revised Infrastructure List

CSC#252-06-610-JUN-045.LET

FAIRWAY MANOR SUBDIVISION - UNIT 1

CITY OF ALBUQUERQUE, BERNALILLO COUNTY, NEW MEXICO

GRADING CERTIFICATION

FAIRWAY MANOR UNIT 1

GRADING AND DRAINAGE INSPECTION NOTES (INSPECTION 5-10-94)

AS BUILT SURVEY WAS CONDUCTED APRIL 5, 1994, BY COMMUNITY SCIENCES CORPORATION (CSC) AS INDICATED HEREIN. DRAINAGE INSPECTION WAS CONDUCTED ON MAY 10, 1994 BY CSC. THE FOLLOWING GENERAL OBSERVATIONS WERE MADE DURING THE DRAINAGE INSPECTION:


DRAINAGE INSPECTION (5-10-94)

1. GRADING OF THE 200' PNM EASEMENT ON THE WEST SIDE OF UNIT 2 AND SOUTH OF VISTA ALEGRE WAS COMPLETE IN SUBSTANTIAL COMPLIANCE WITH THE APPROVED PLAN. THE 24" PIPE UNDER VISTA ALEGRE WAS NOT INSTALLED, AND THE LADERA WEST UNITS 3 & 4 DEVELOPMENT TO THE WEST HAS BEEN COMPLETELY GRADED TO DIVERT THAT OFF-SITE FLOW AWAY FROM THE PNM EASEMENT. AS A RESULT SOME VERY INFREQUENT PONDING MAY RESULT WITHIN THE 50' PERMANENT DRAINAGE EASEMENT. THE LACK OF THE PLANNED DISCHARGE PIPE IS OF NO SIGNIFICANT CONSEQUENCES SINCE THE ONLY AREA DRAINING TO THIS LOCATION IS THE PNM EASEMENT ITSELF. SINCE THE OFF-SITE AREA TO THE WEST HAS BEEN DIVERTED AWAY FROM THE PNM EASEMENT, THE NEED FOR THE TEMPORARY PONDING EASEMENT AND PRIVATE MAINTENANCE THEREOF NO LONGER EXISTS.
2. IN THE PROCESS OF CONSTRUCTING UNIT 1, UNIT 2 WAS ALSO GRADED IN ACCORDANCE WITH THE APPROVED PLAN.
3. GRADING OF THE AMAFCA RW ON THE NORTH SIDE OF UNIT 1 APPEARED TO BE COMPLETED IN SUBSTANTIAL COMPLIANCE WITH THE APPROVED PLAN INCLUDING THE COMPLETION OF THE RETAINING WALLS ON THE NORTH SIDE OF LOTS 27 AND 28 BLOCK 1.
4. SUBJECT TO ROUTINE CONSTRUCTION OF BLOCK GARDEN WALLS ON TOP OF THE DEVELOPER PROVIDED RETAINING WALLS, ALL DEVELOPER REQUIRED PRIVATE RETAINING WALLS ARE IN SUBSTANTIAL CONFORMANCE WITH THE APPROVED GRADING PLANS. EXCEPT AS DESCRIBED IN NOTE 5 BELOW.
5. THE RETAINING WALLS BETWEEN LOTS 17 AND 18, BLOCK 6 AND LOTS 38 AND 37, BLOCK 1 WERE NOT INSTALLED BECAUSE THE AS-BUILT GRADING OF THE HOUSE PADS DID NOT REQUIRE THE RETAINING WALLS TO MEET GRADING AND DRAINAGE DESIGN CRITERIA. SEE THE CLOUDED AREA OF SHEET 3 OF 3 FOR FINAL SWALE AND YARD GRADING.

I, STEPHEN L. CRAWFORD, DO HEREBY CERTIFY THAT, TO THE BEST OF MY KNOWLEDGE, THE GRADING AND DRAINAGE OF THIS SUBDIVISION IS IN SUBSTANTIAL COMPLIANCE WITH THE APPROVED GRADING PLAN. SUBJECT TO THE CONSIDERATIONS IN THE NOTES ABOVE.

Stephen L. Crawford
STEPHEN L. CRAWFORD

6-27-94
DATE

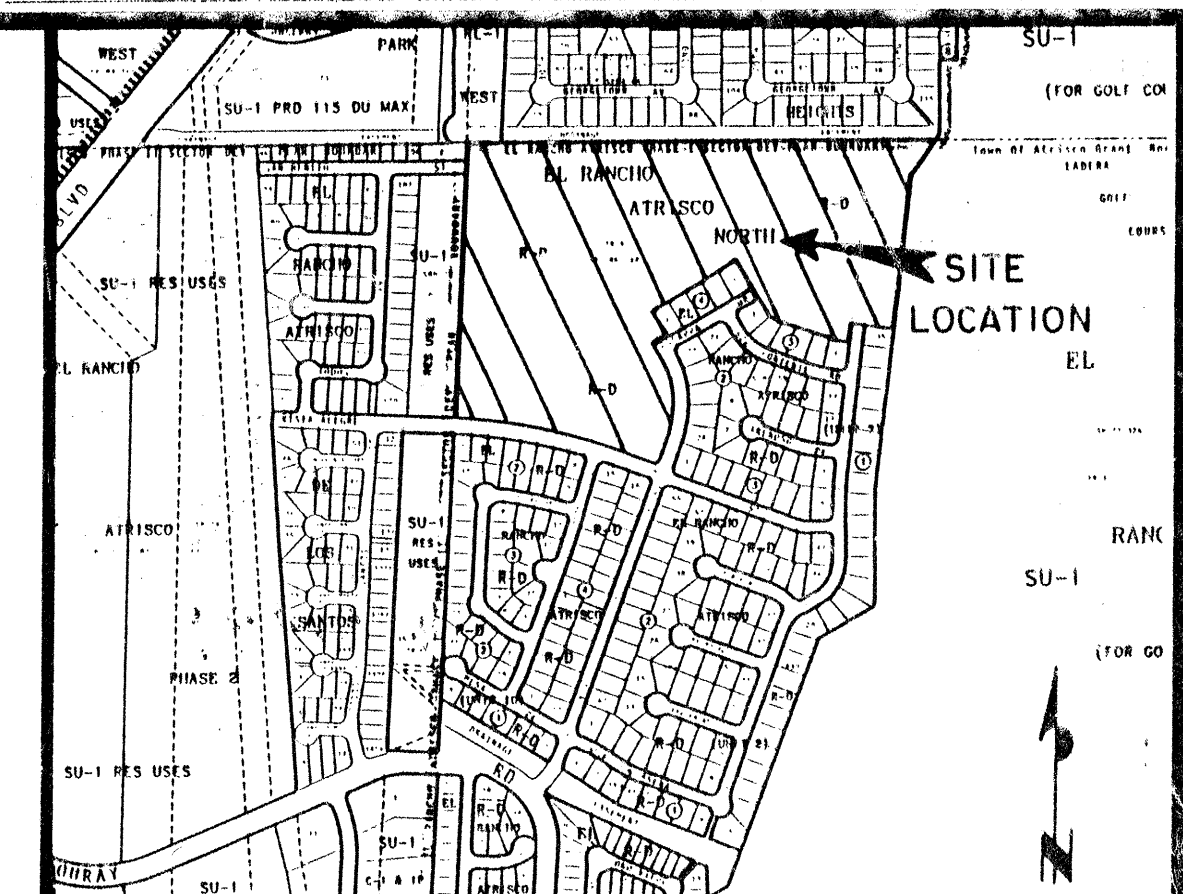

VICINITY MAP


LEGEND

AS BUILT = 82.4-82.0

REV.	SHEETS	CITY ENGINEER	DATE	USER DEPARTMENT	DATE	USER DEPARTMENT	DATE

ENGINEER'S SEAL	DATE: APRIL 1994	community sciences corporation	APPROVED FOR CONSTRUCTION
	SCALE: AS NOTED		CITY ENGINEER
	DRAWN: JDH		DATE
	252-06-640		
PROJECT NO.	4776.90	SHEET 1 OF 3	

LADERA HEIGHTS SUBDIVISION
(REPLAT OF COLLEGE PARK ADDITION - UNIT 2)
(FILED 8-30-78, VOL. 06, FOL. 155)

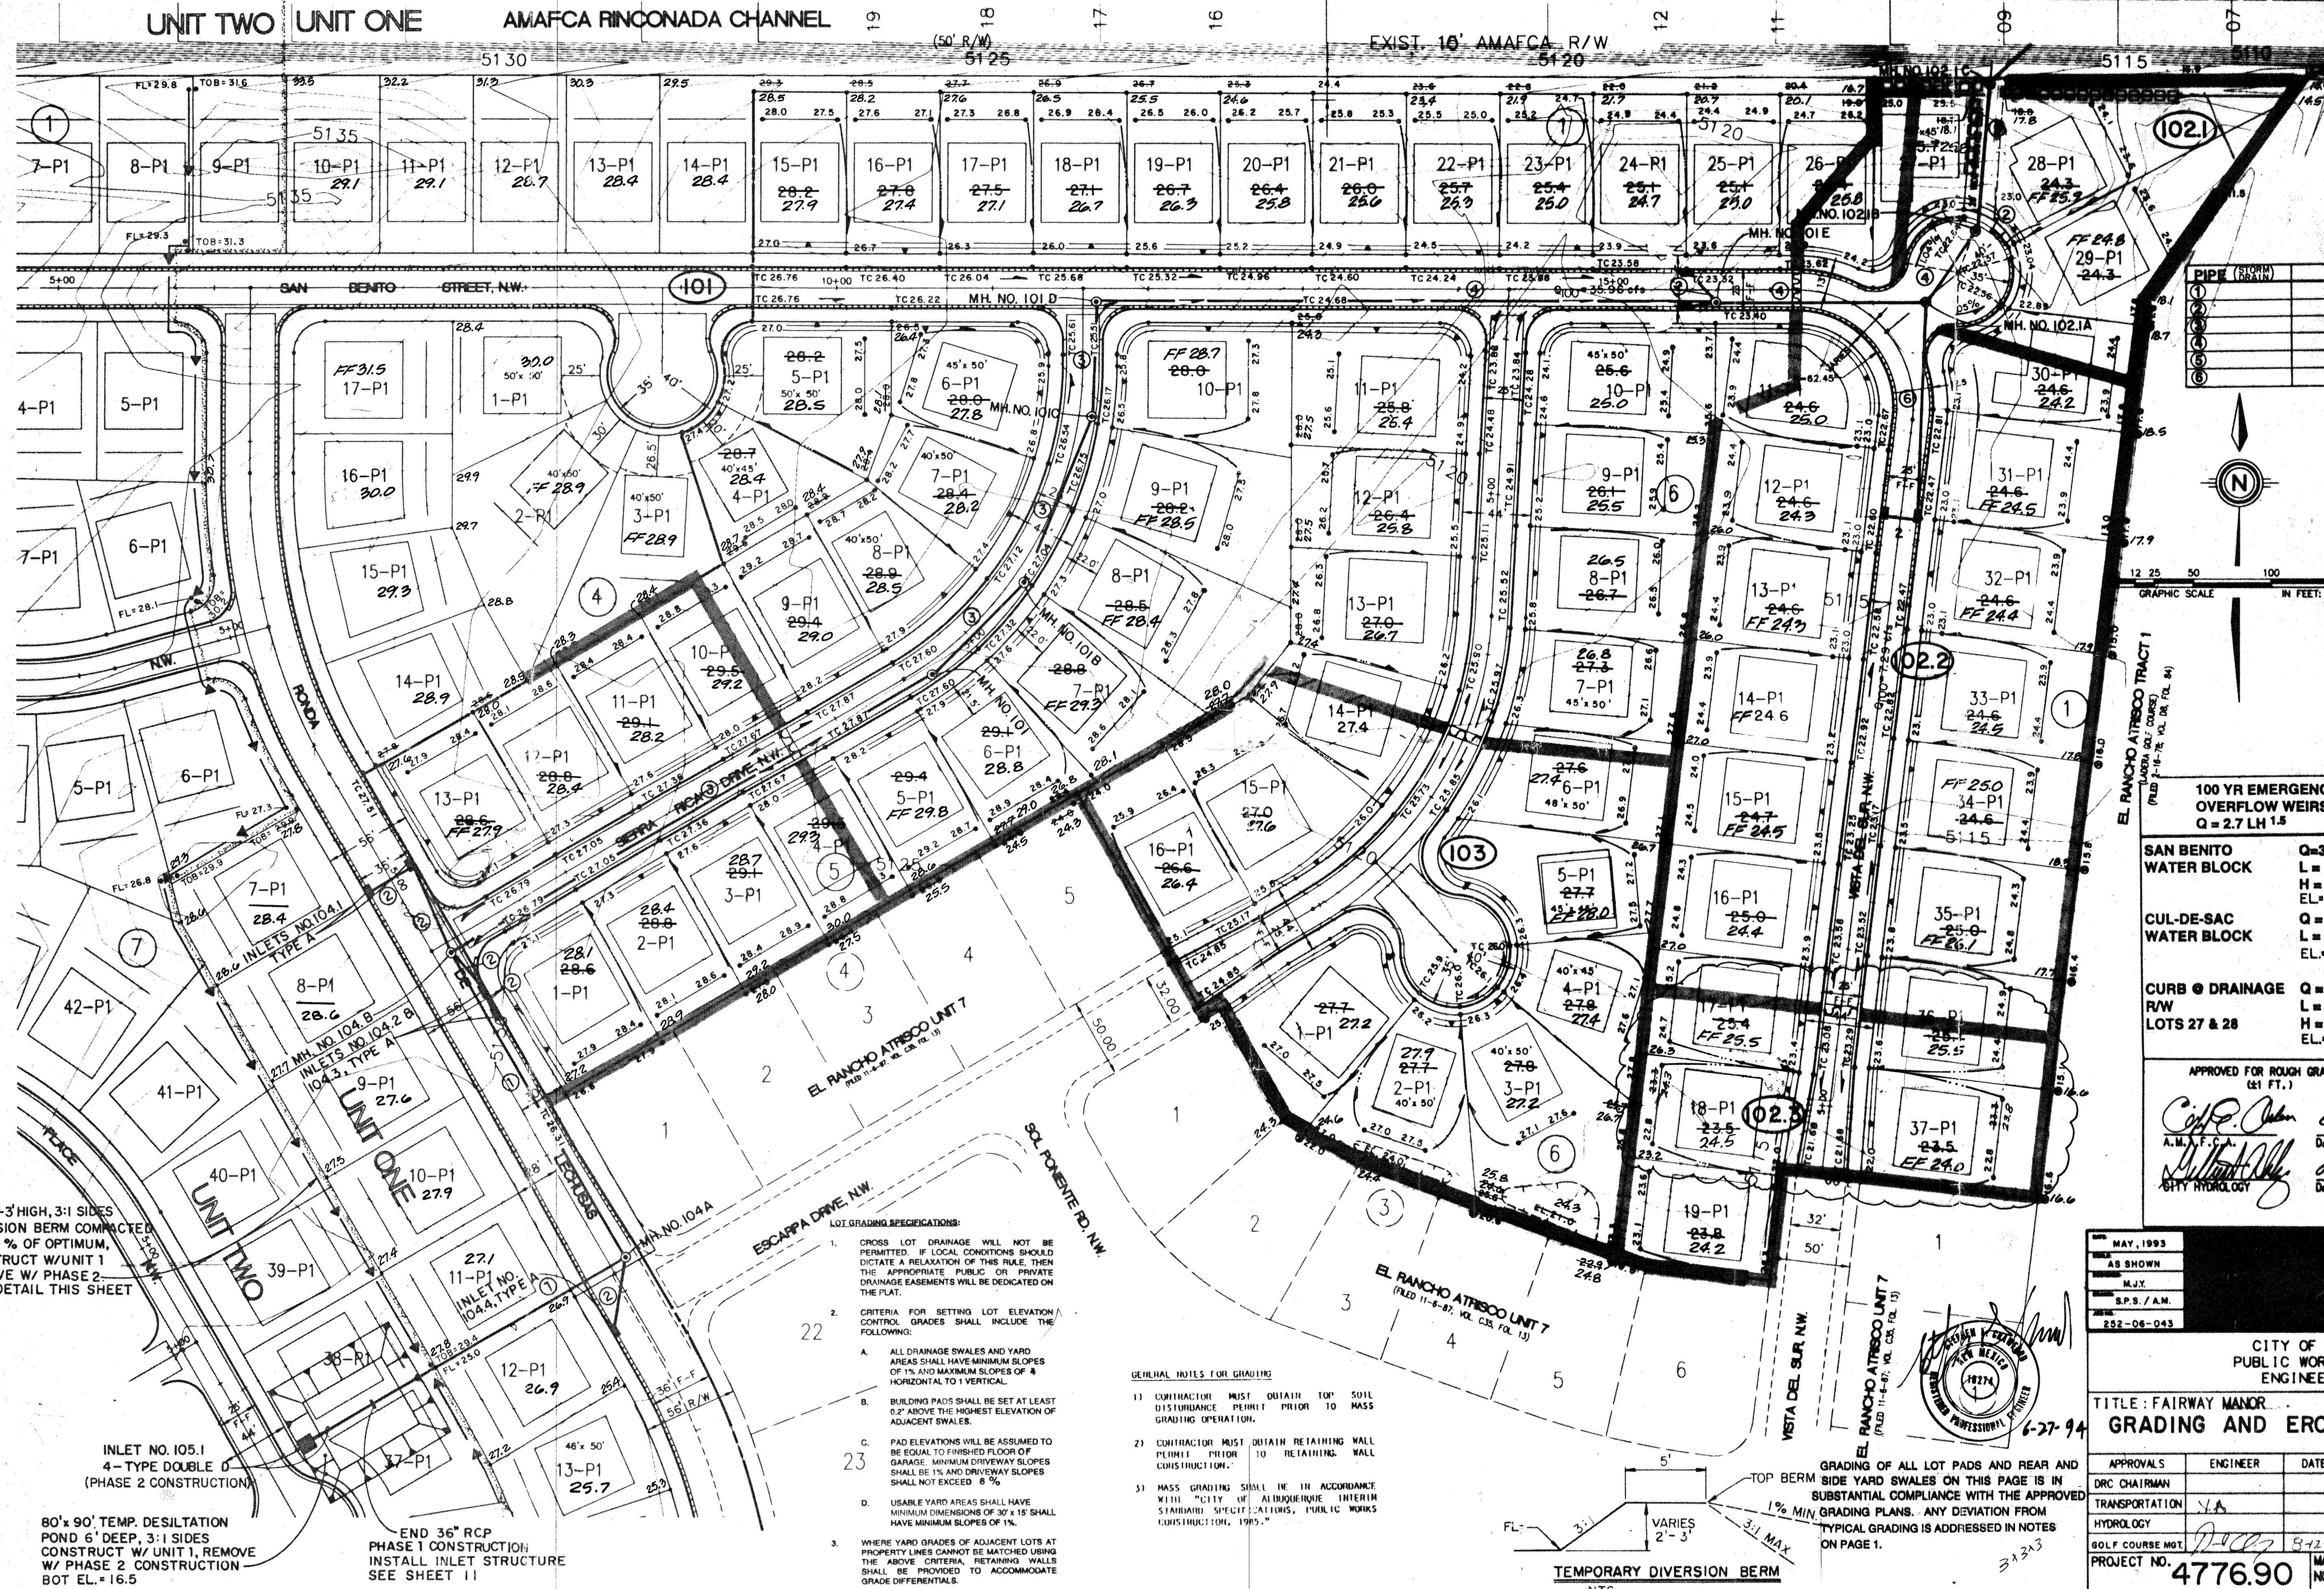

TEMP 2'-3" HIGH, 3:1 SIDES
DIVERSION BERM CONNECTED
TO 90% OF OPTIMUM,
CONSTRUCT W/ UNIT 1
REMOVE W/ PHASE 2
SEE DETAIL THIS SHEET

INLET NO. 105.1
4" TYPE DOUBLE D
(PHASE 2 CONSTRUCTION)

80' x 90' TEMP. DESILTATION
POND 6' DEEP, 3:1 SIDES
CONSTRUCT W/ UNIT 1, REMOVE
W/ PHASE 2 CONSTRUCTION
BOT EL. = 16.5


END 36" RCP
PHASE 1 CONSTRUCTION
INSTALL INLET STRUCTURE
SEE SHEET 11

LOT GRADING SPECIFICATIONS:

- CROSS LOT DRAINAGE WILL NOT BE PERMITTED. IF LOCAL CONDITIONS SHOULD DICTATE A RELAXATION OF THIS RULE, THEN THE APPROPRIATE PUBLIC OR PRIVATE DRAINAGE EASEMENTS WILL BE DEDICATED ON THE PLAT.
- CRITERIA FOR SETTING LOT ELEVATION/CONTROL GRADES SHALL INCLUDE THE FOLLOWING:
 - ALL DRAINAGE SWALES AND YARD AREAS SHALL HAVE MINIMUM SLOPES OF 1% AND MAXIMUM SLOPES OF 4% HORIZONTAL TO 1 VERTICAL.
 - BUILDING PADS SHALL BE SET AT LEAST 0.2' ABOVE THE HIGHEST ELEVATION OF ADJACENT SWALES.
 - PAD ELEVATIONS WILL BE ASSUMED TO BE EQUAL TO FINISHED FLOOR OF GARAGE. MINIMUM DRIVEWAY SLOPES SHALL BE 1% AND DRIVEWAY SLOPES SHALL NOT EXCEED 8%.
 - USABLE YARD AREAS SHALL HAVE MINIMUM DIMENSIONS OF 30' x 15' SHALL HAVE MINIMUM SLOPES OF 1%.
- WHERE YARD GRADES OF ADJACENT LOTS AT PROPERTY LINES CANNOT BE MATCHED USING THE ABOVE CRITERIA, RETAINING WALLS SHALL BE PROVIDED TO ACCOMMODATE GRADE DIFFERENTIALS.


GENERAL NOTES FOR GRADING

- CONTRACTOR MUST OBTAIN TOP SOIL DISTURBANCE PERMIT PRIOR TO MASS GRADING OPERATION.
- CONTRACTOR MUST OBTAIN RETAINING WALL PERMIT PRIOR TO RETAINING WALL CONSTRUCTION.
- MASS GRADING SHALL BE IN ACCORDANCE WITH "CITY OF ALBUQUERQUE INTERIM STANDARD SPECIFICATIONS, PUBLIC WORKS CONSTRUCTION, 1993."

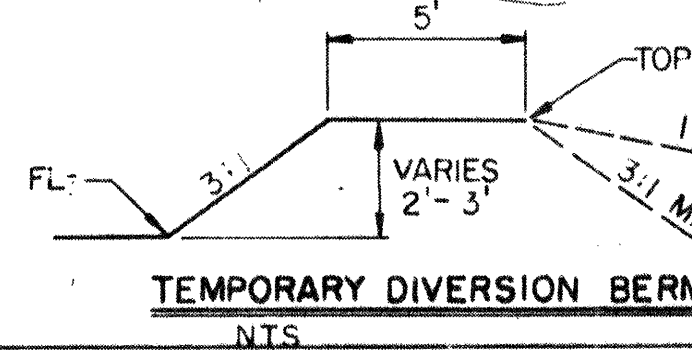

GRADING OF ALL LOT PADS AND REAR AND SIDE YARD SWALES ON THIS PAGE IS IN SUBSTANTIAL COMPLIANCE WITH THE APPROVED 1% MIN. GRADING PLANS. ANY DEVIATION FROM TYPICAL GRADING IS ADDRESSED IN NOTES ON PAGE 1.

PIPE (NORTH)	SIZE
1	36"
2	24"
3	42"
4	48"
5	48"
6	24"

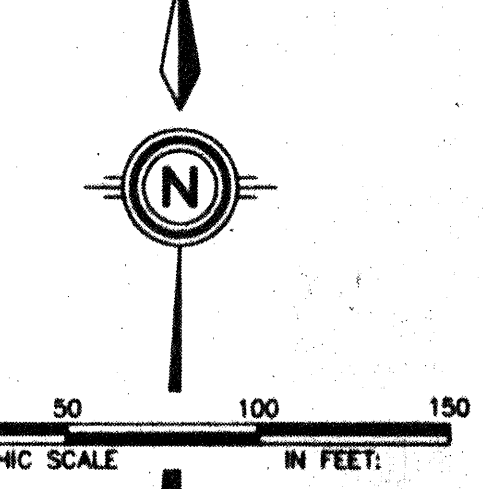

100 YR EMERGENCY
OVERFLOW WEIRS
Q = 2.7 LH 1.5

SAN BENITO
WATER BLOCK
Q = 35.96 cfs
L = 28'
H = 0.64'
EL. = 23.69

CUL-DE-SAC
WATER BLOCK
Q = 43.25 cfs
L = 43.5'
EL. = 22.97

CURB & DRAINAGE
Q = 45.83 cfs
L = 20'
H = 0.90'
EL. = 22.87

APPROVED FOR ROUGH GRADING
(51 FT.)

C. P. Johnson 07/29/93
A.M. 11-1-93
John P. Johnson 07/29/93
CITY HYDROLOGIST

MAY, 1993
AS SHOWN
M.J.T.
S.P.S. / A.M.
252-06-043

CITY OF ALBUQUERQUE
PUBLIC WORKS DEPARTMENT
ENGINEERING GROUP

TITLE: FAIRWAY MANOR
GRADING AND EROSION CONTROL PLAN

APPROVALS	ENGINEER	DATE	APPROVALS	ENGINEER	DATE
DRC CHAIRMAN			WATER		
TRANSPORTATION			WASTE WATER		
HYDROLOGY					
GOLF COURSE MGT.					
PROJECT NO. 4776.90	MAP NO. G-10	SHEET 3 OF 3			

AS BUILT INFORMATION		SURVEY INFORMATION		ENGINEER'S SEAL		REVISIONS		DESIGN		DATE	
CONTRACTOR	DATE	NO.	DATE	NO.	DATE	NO.	DATE	NO.	DATE	NO.	DATE
THE STATION IS A STANDARD AS BUILT STATION SET IN A 2" IRON PIPE 1 FT. ABOVE GRADE. STA. IS LOCATED ON TOP OF A VOLCANIC OUTCROP. TO REACH THIS STA. BEGIN AT 140' & CROSS NW. WEST ON GRADY RD. 0.7 MILE TO END OF FIREWALL. CONTINUE WEST ON DIRT RD. TO TOP OF DAM ALONG NORTH BANK 0.8 MILE TO DIRT CROSS ROAD NORTH ON DIRT ROAD 0.5 MILE. THE STATION IS ABOUT 800 FT. WEST OF THIS POINT.											
MICRO-FILM INFORMATION		DATE		DATE		DATE		DATE		DATE	
ELEVATION = 5334.50 FT.											