



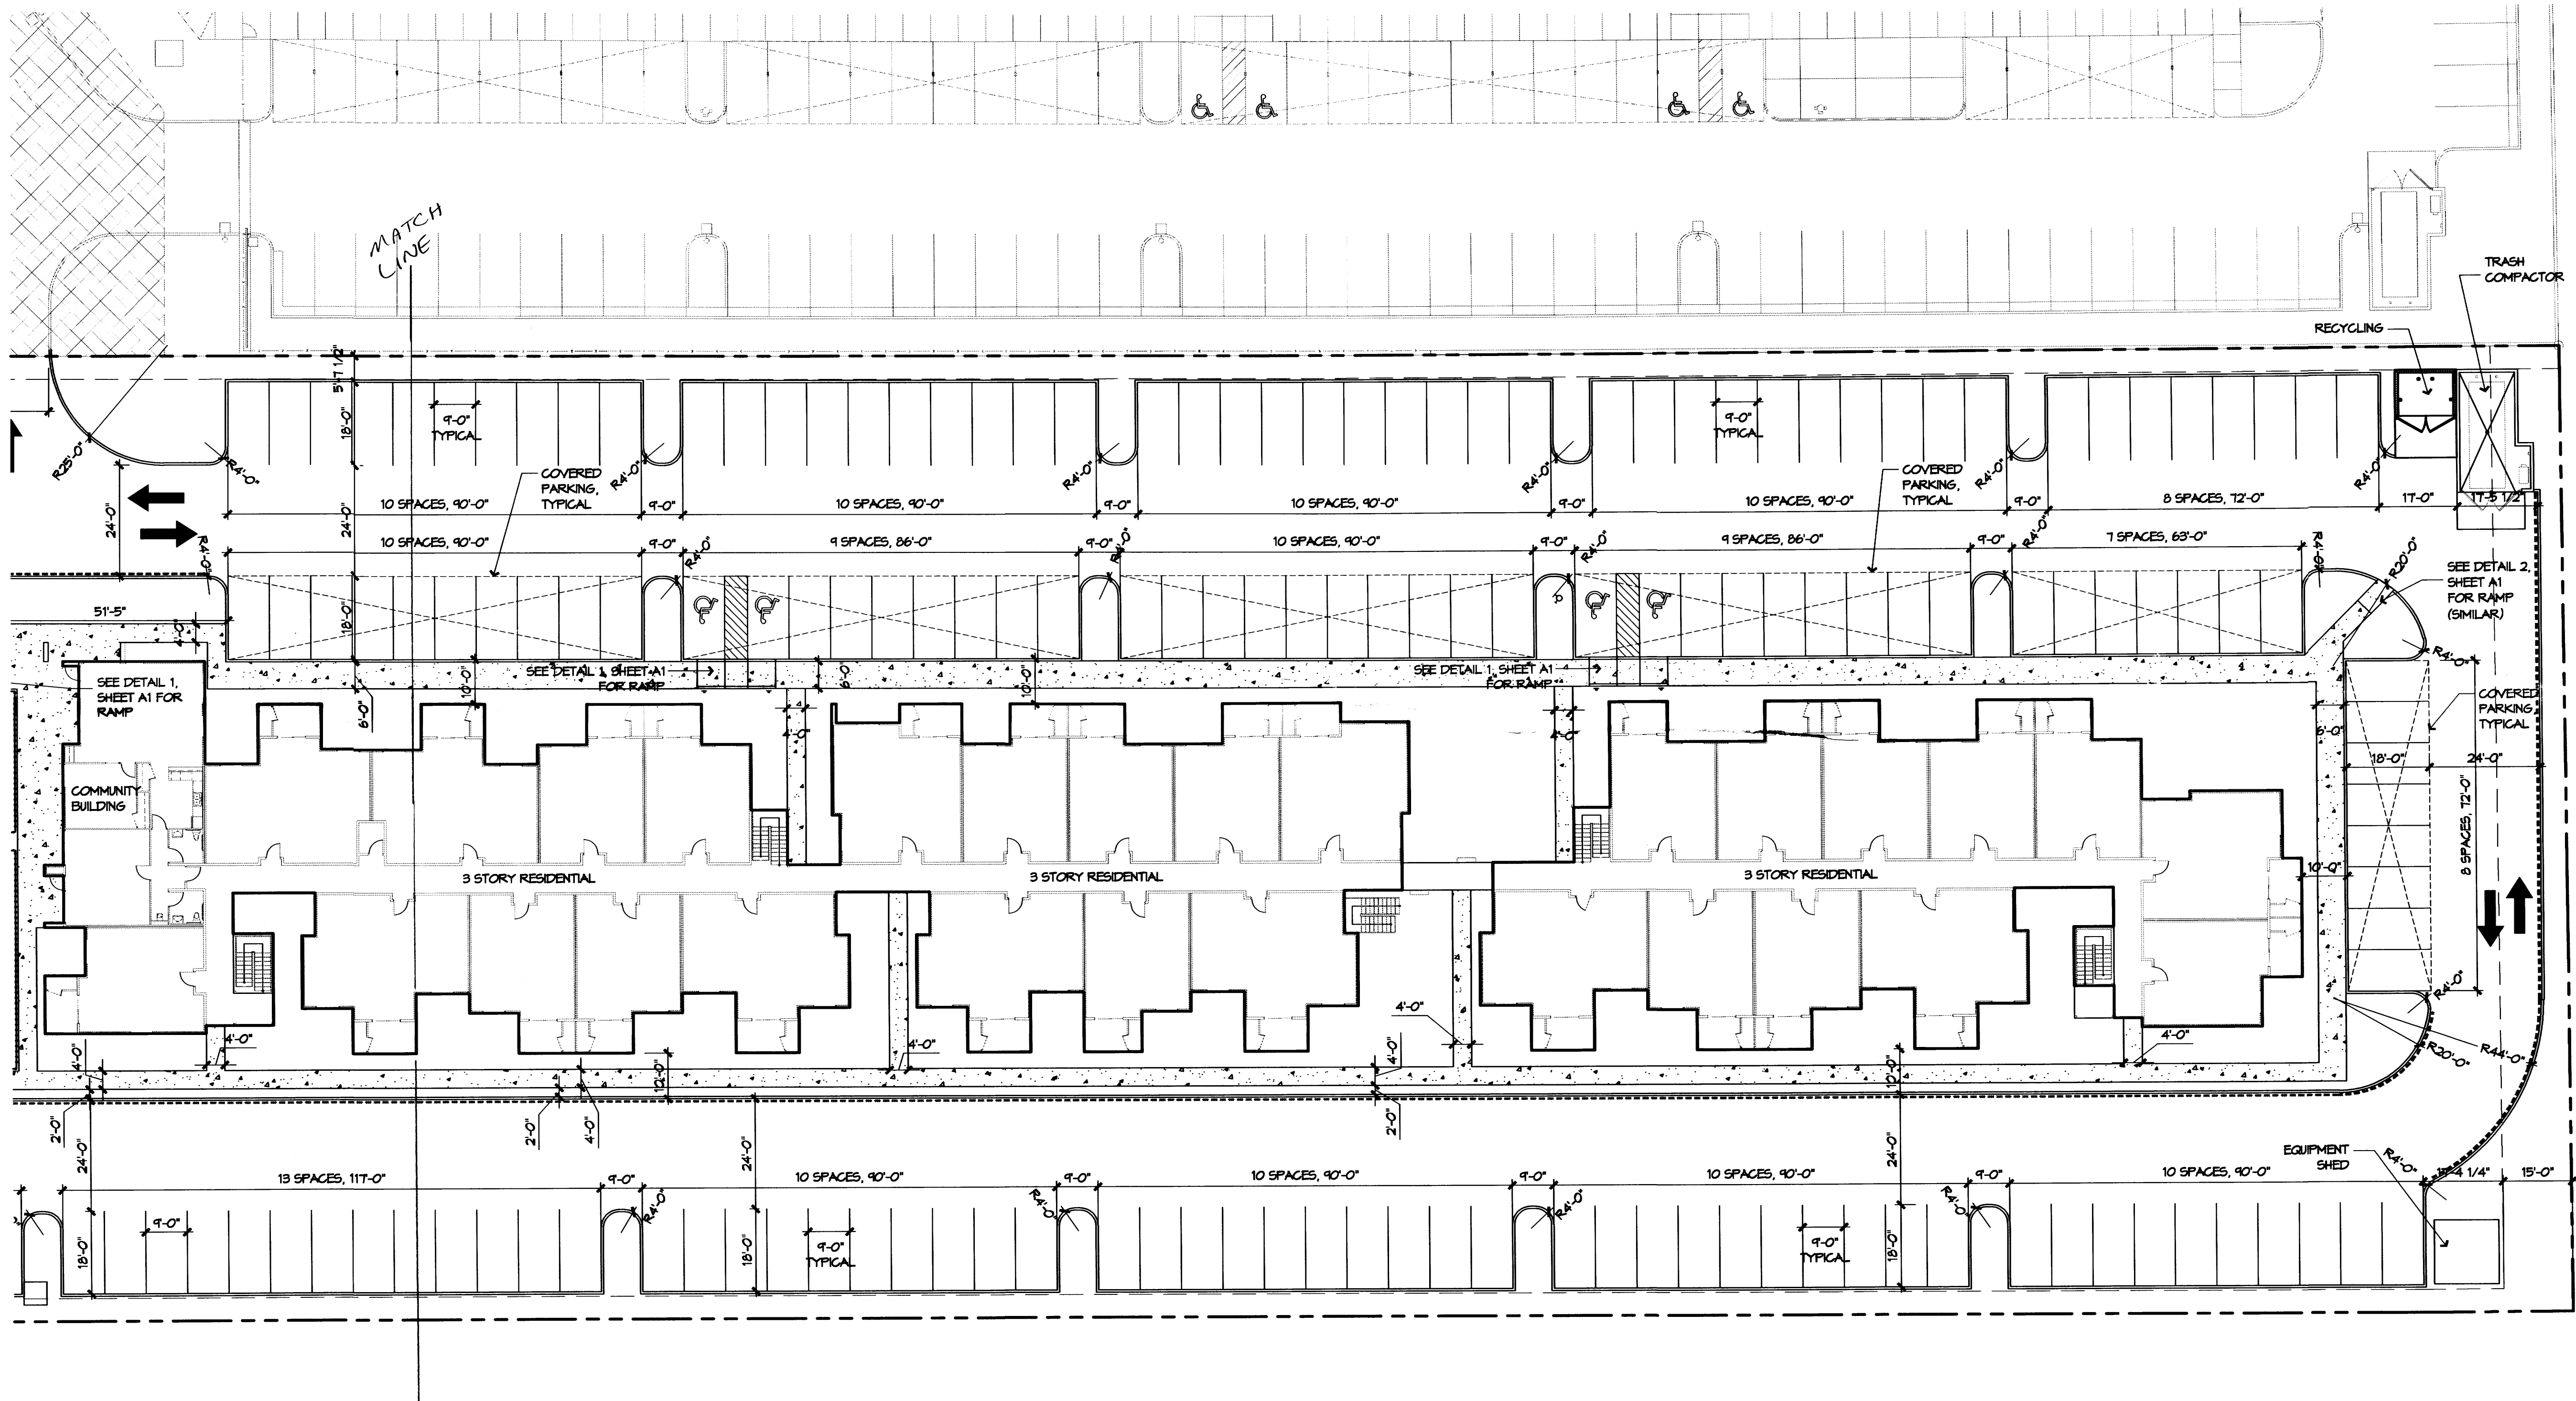


**Ladera Vista Apartments**  
**H.S. Rental Properties, Inc.**  
3608 Ladera Drive  
Albuquerque, NM

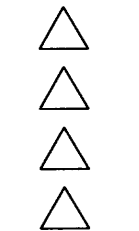


**ENLARGED SITE PLAN**


1" = 20'-0"

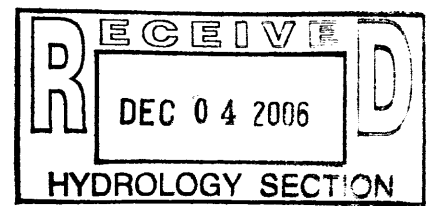


# LEGEND

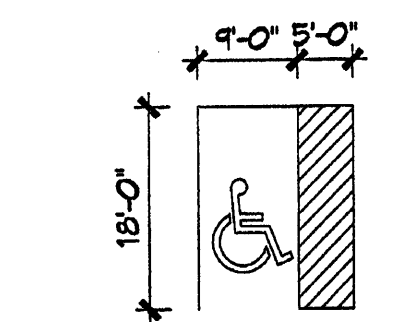


Accessible Parking Space for Car; 5'-0" Access Aisle; White Int'l HC Symbol; 4" solid spaced striping spaced at 45°; sloped 1% to 2%

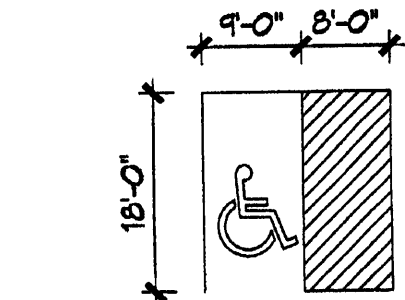


Accessible Parking Space for Van; 8'-0" Access Aisle; White Int'l HC Symbol; 4" solid spaced striping spaced at 45°; sloped 1% to 2%

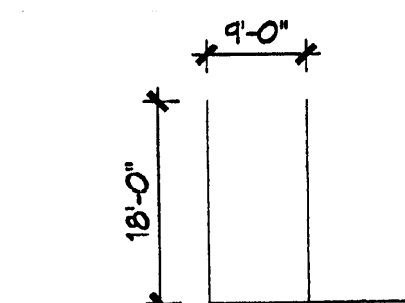

Typical Parking Space

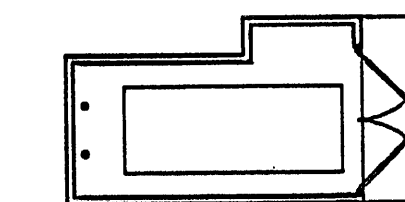


Compactor (truck access req.)

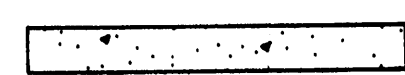


Proposed Sidewalk, typ.




Property Boundary

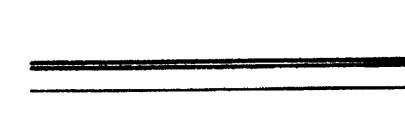

New Standard Concrete Curb & Gutter per COA std. det. 2415A

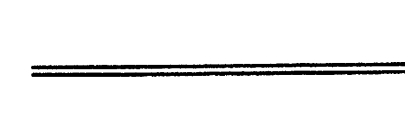


New Concrete Header Curb per COA std. det. 2415B

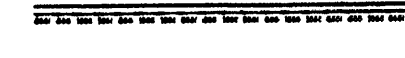

Fine Lane - Paint curb red




Direction of Traffic Flow

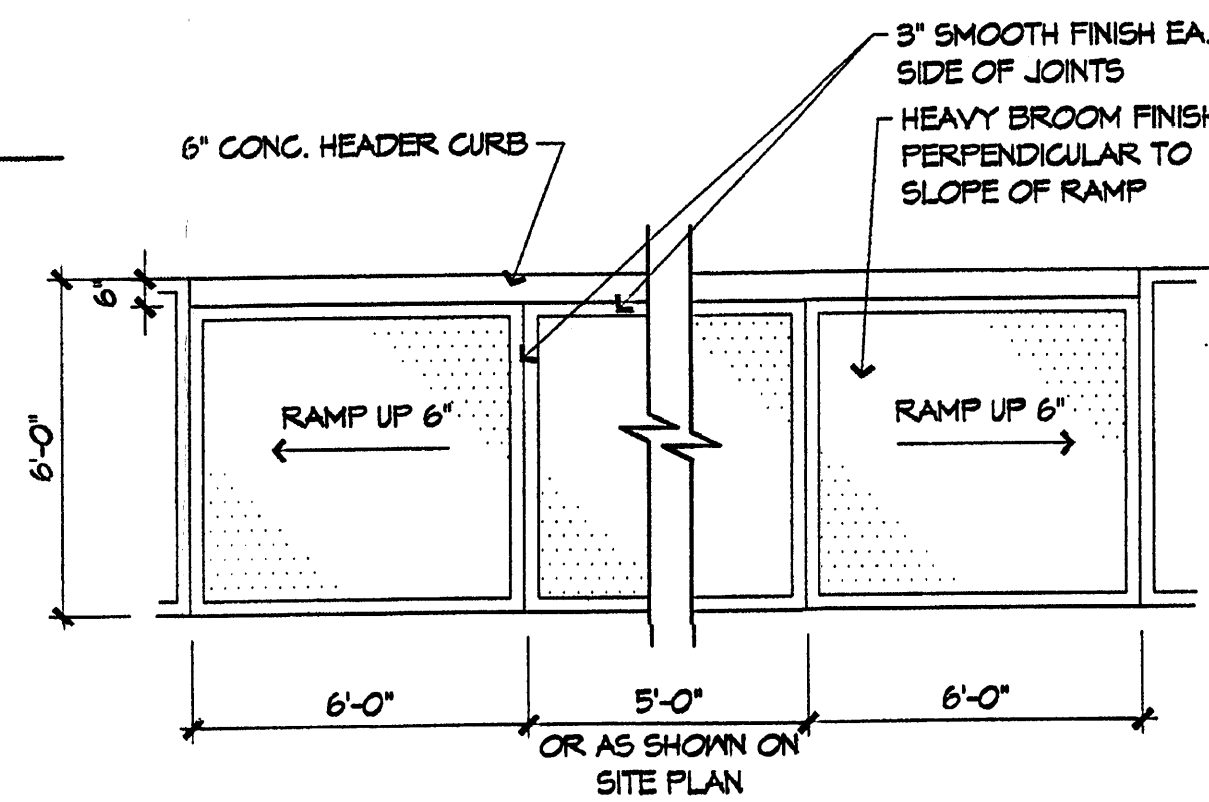

1 CURB ACCESS RAMP

1/4" = 1'-0"

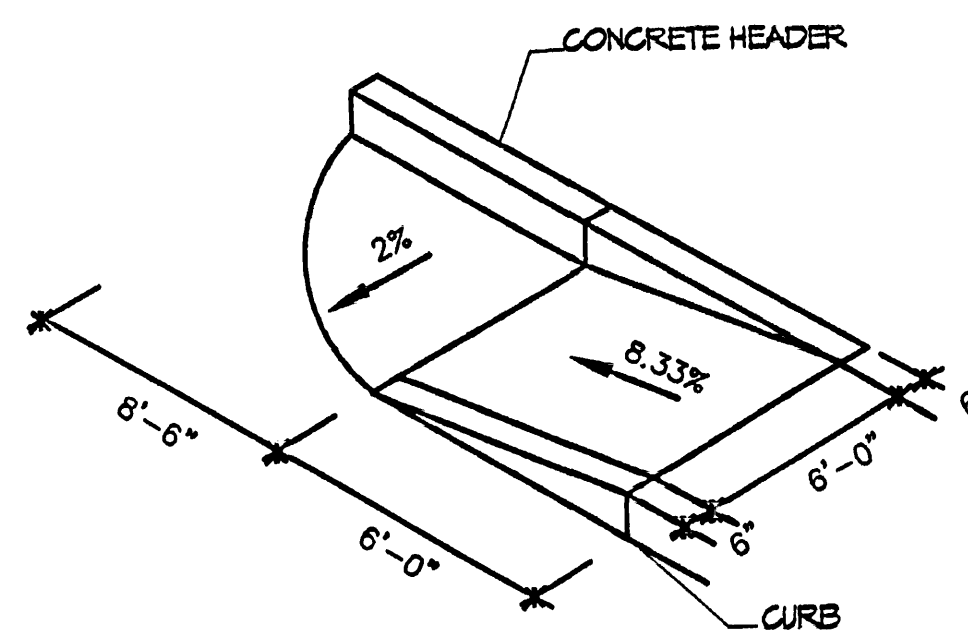

2 DIRECTIONAL HANDICAP RAMP

NTS

## PROJECT LOCATION

LOCATION: ALBUQUERQUE, NEW MEXICO

LEGAL DESCRIPTION: TRACT NUMBERED/LETTERED FIVE - A (5-A) OF THE TOWN OF ATRISCO GRANT, AS THE SAME IS SHOWN AND DESIGNATED ON THE PLAT THEREOF, FILED IN THE OFFICE OF THE COUNTY CLERK OF BERNALILLO COUNTY, NEW MEXICO, ON SEPTEMBER 18, 1926, IN PLAT BOOK C81 PAGE 125, ZONE: R-2: HOUSES, TOWNHOUSES, AND MEDIUM DENSITY APARTMENTS.

ZONE MAP PAGE: 6-11-Z  
SITE AREA: 4.2466 ACRES = 184,991 SQ. FT.

## PARKING ANALYSIS

### APPLICABLE CODES:

COMPREHENSIVE CITY ZONING CODE, REVISED & UPDATED THROUGH MAY, 2006 (ABQ CCZC)

PARKING REQUIRED, PER 14-6-3-1 (24) (a) & (b)

48 UNITS @ 1.5/ 1 BATH UNIT	=	147 SPACES
24 UNITS @ 2/ 2 BATH UNIT	=	50 SPACES
COMMUNITY BUILDING @ 1 PER 200 SF	=	9 SPACES
SUBTOTAL	=	214 SPACES
10% TRANSIT REDUCTION	=	-21 SPACES

TOTAL = 193 SPACES


PARKING PROVIDED: = 193 SPACES

ACCESSIBLE PARKING REQUIRED: 101-300 SPACES = 8 SPACES WITH 1 VAN SPACE


ACCESSIBLE PARKING PROVIDED: 8 SPACES WITH 1 VAN SPACE

## TRAFFIC IMPACT STUDY

SEE ATTACHED COVER LETTER FOR TRAFFIC IMPACT STUDY APPLICABLE TO MEDIAN IMPROVEMENTS CONSTRUCTED UNDER CITY WORK ORDER #175661. (APPLIES TO MAIN ENTRY TO ADJOINING SITE/ACCESS EASEMENT) NOTE THAT THIS TRAFFIC IMPACT STUDY ASSUMED 160 DWELLING UNITS FOR THIS PROJECT. ACTUAL NUMBER OF DWELLING UNITS FOR THIS PROJECT IS 121.

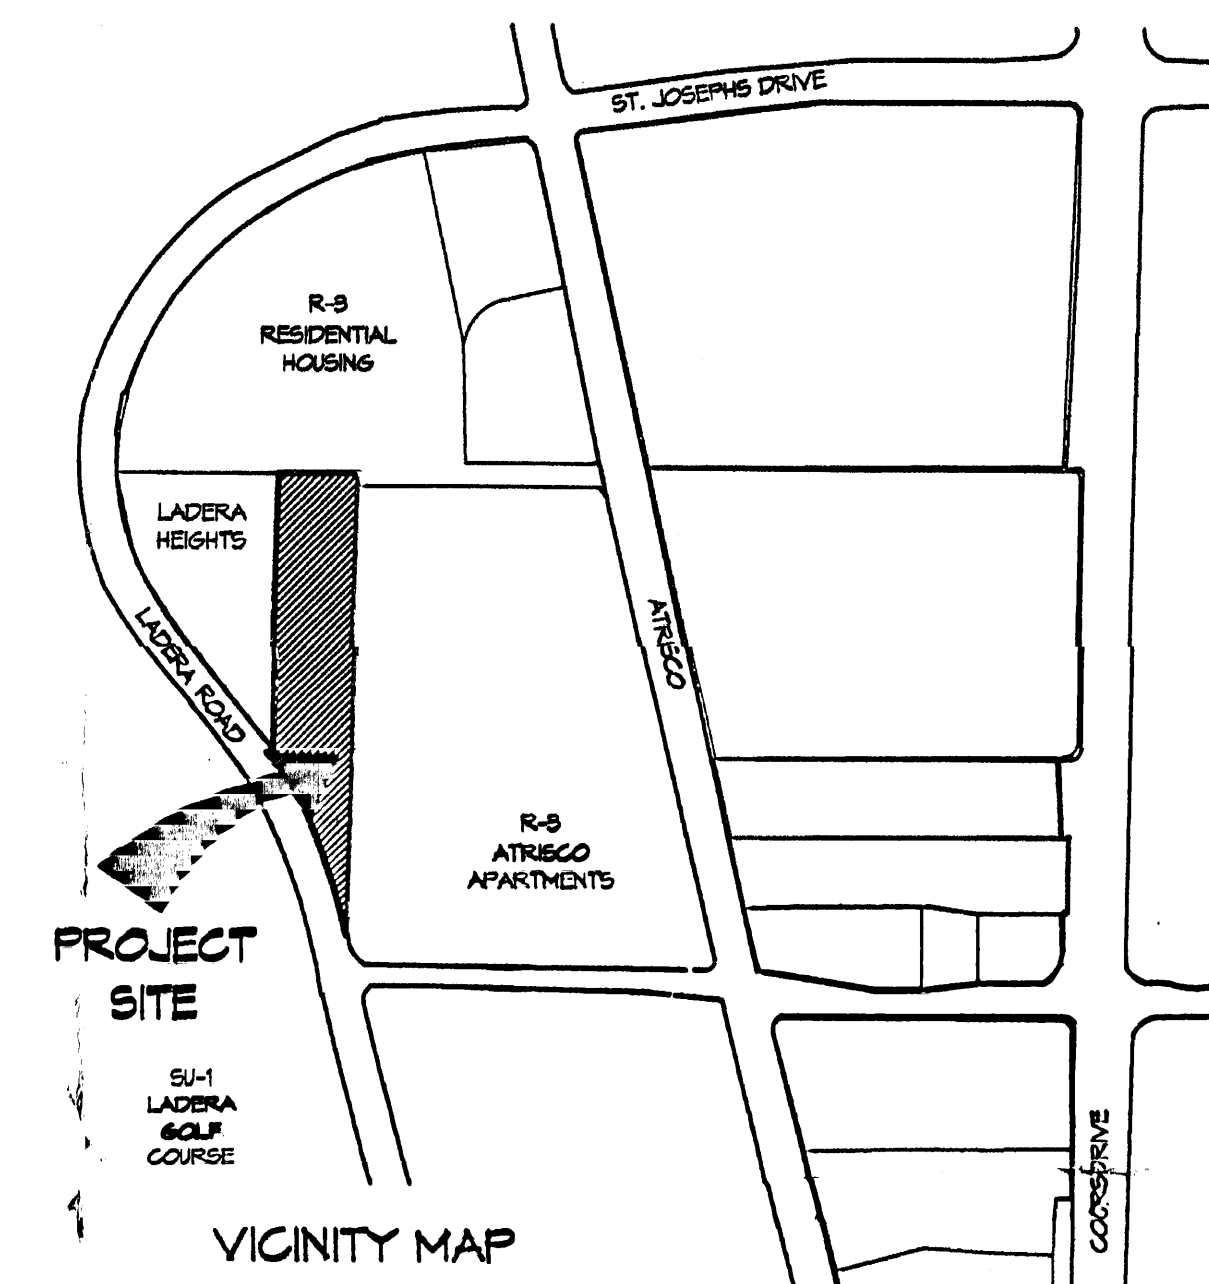

VICINITY MAP

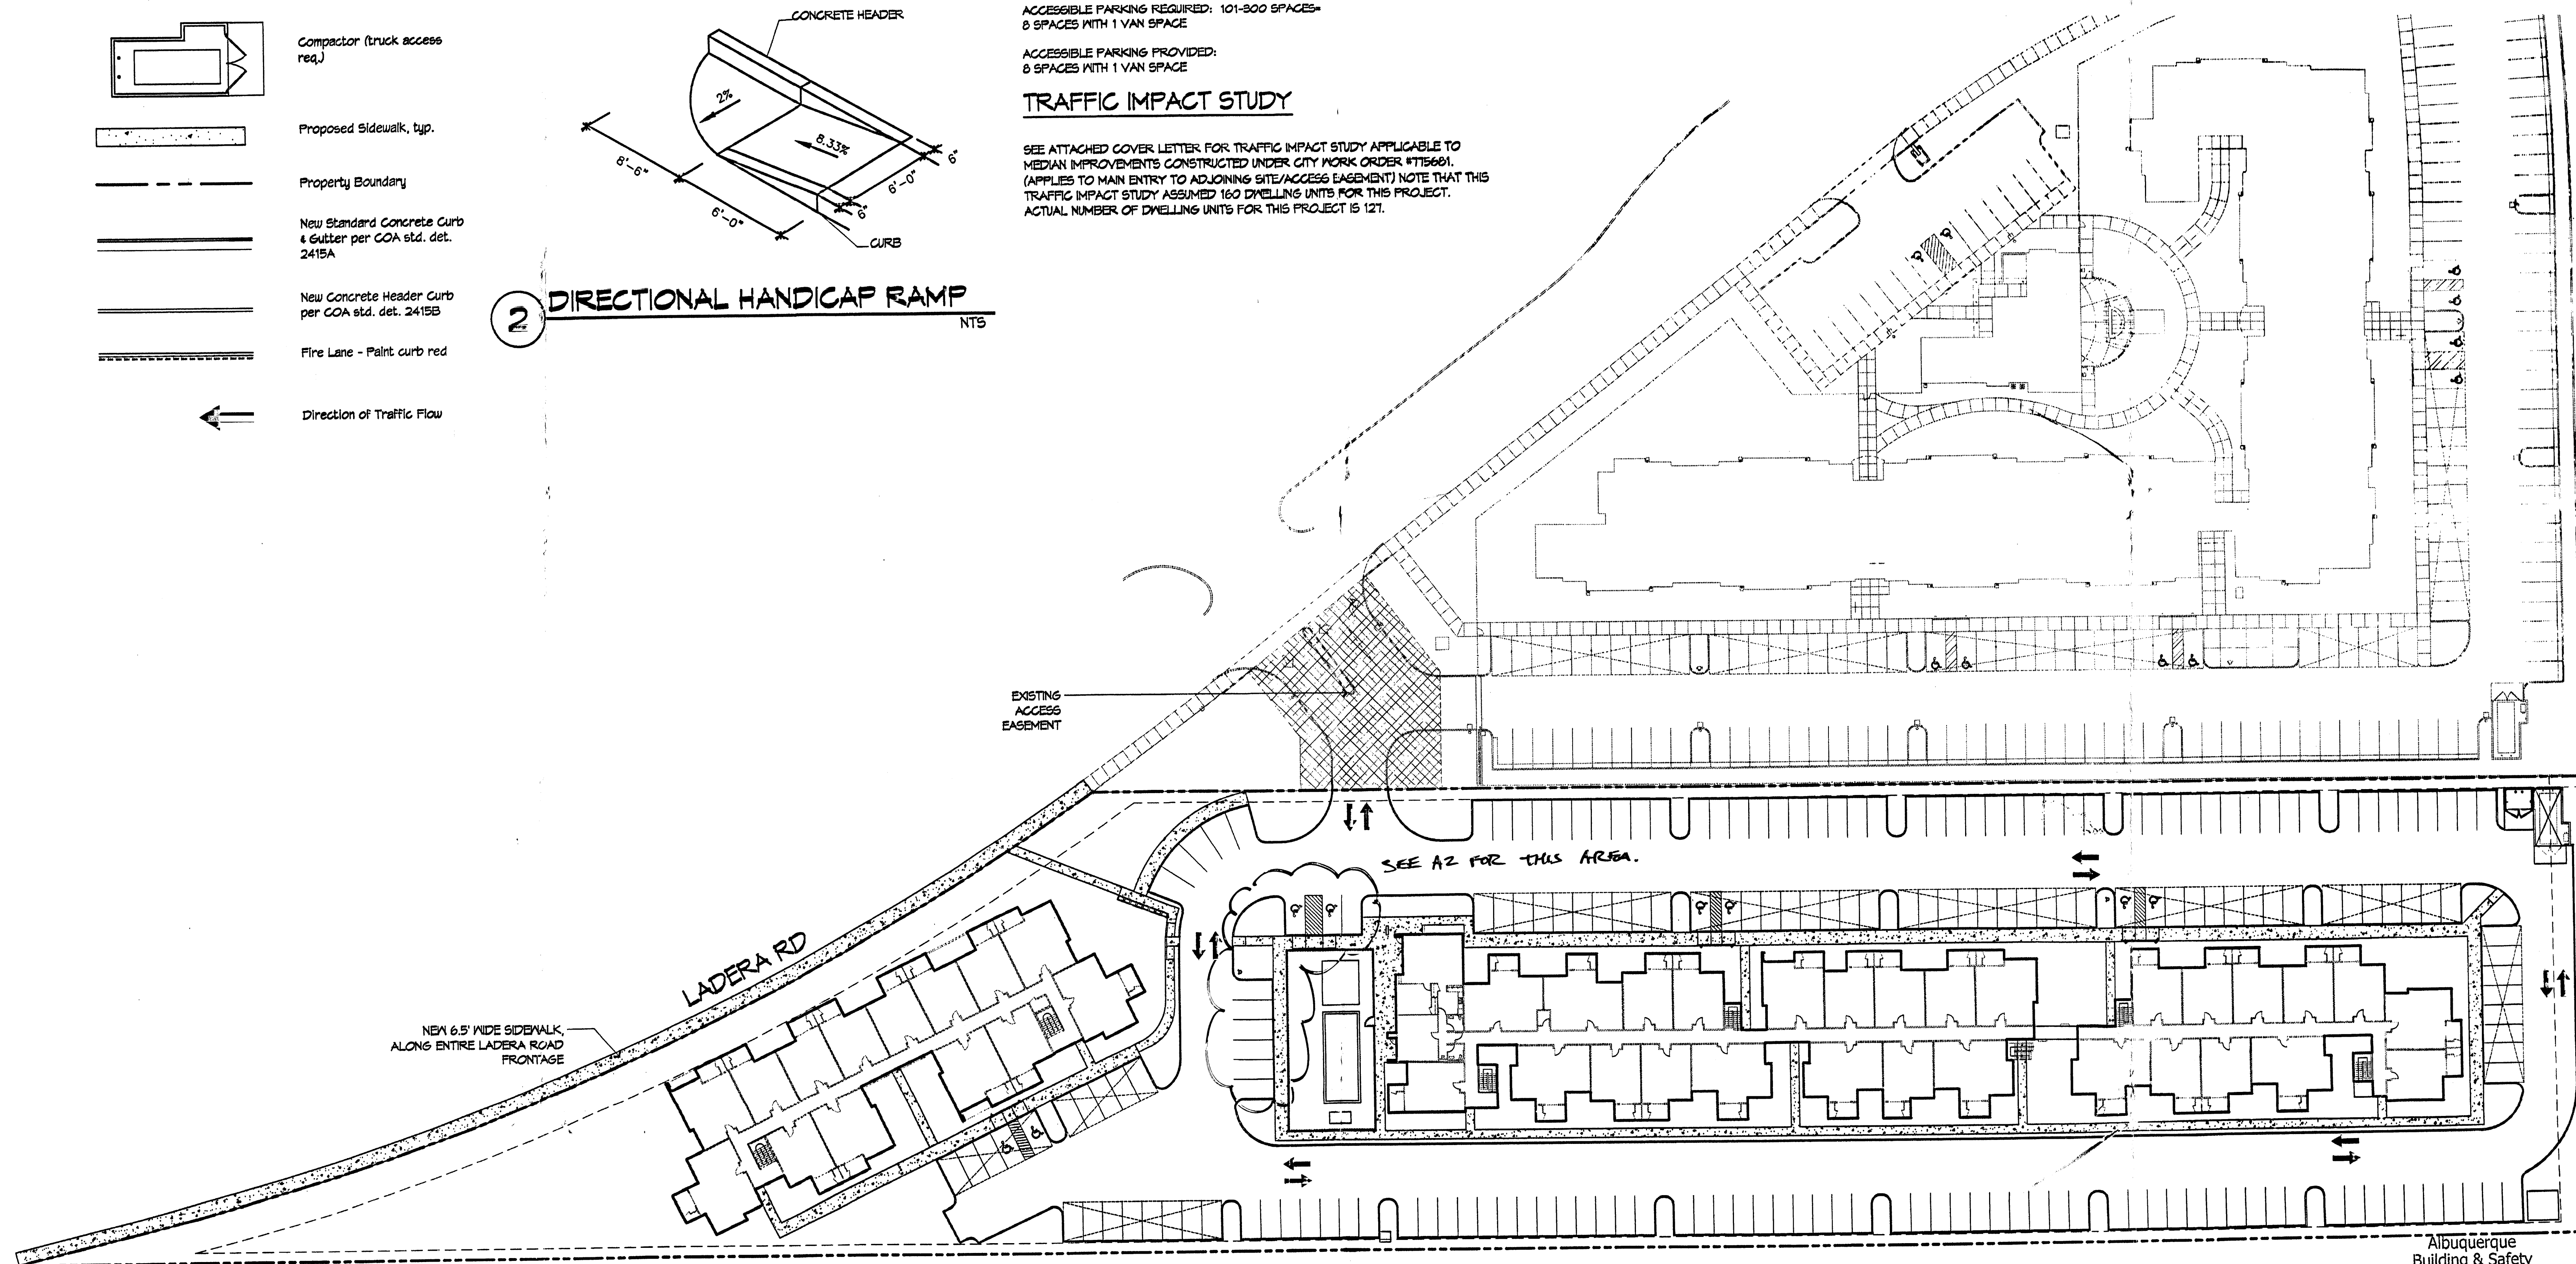

Albuquerque Building & Safety  
MAR - 5 2007

I.B.C.  
Plan Check Section

1" = 40'-0"

RECEIVED  
DEC 4 2006  
HYDROLOGY SECTION

RECEIVED  
AUG 29 2008  
HYDROLOGY SECTION




## OVERALL SITE PLAN

architecture  
interiors  
landscape  
planning  
engineering

Dekker  
Perich  
Sabatini

7601 Jefferson NE Suite 100  
Albuquerque, NM 87109  
505 761-9700  
fax 761-4222  
dps@dpsdesign.org

ARCHITECT

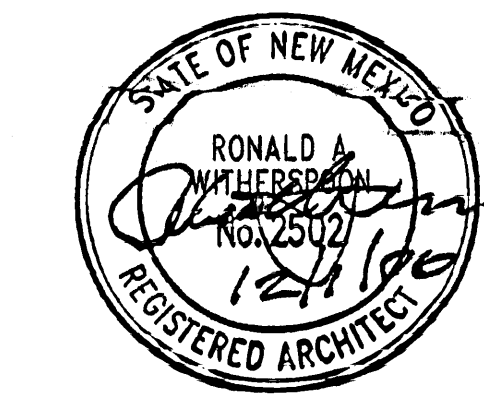

ENGINEER

PROJECT

Ladera Vista Apartments  
H.S. Rental Properties, Inc.  
3608 Ladera Drive  
Albuquerque, NM


REVISIONS
△
△
△
△

DRAWN BY  
REVIEWED BY  
DATE 12.01.06  
PROJECT NO. 0607  
DRAWING NAME

TRAFFIC CIRCULATION  
LAYOUT FOR  
BUILDING PERMIT  
SHEET 1 OF 3

SHEET NO.  
A1  
OF




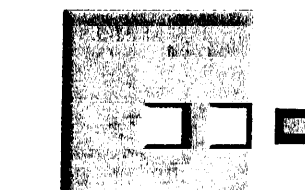

**Dekker  
Perich  
Sabatini**

7601 Jefferson NE Suite 100  
Albuquerque, NM 87109  
505 761-9700  
fax 761-4222  
dps@dpsdesign.org

ARCHITECT

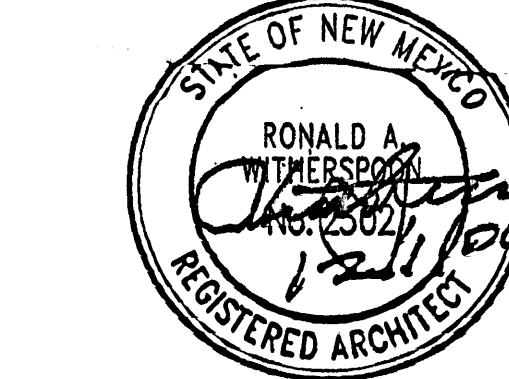

ENGINEER

PROJECT

**Ladera Vista Apartments**  
H.S. Rental Properties, Inc.  
3608 Ladera Drive  
Albuquerque, NM

REVISIONS  
△ **RECEIVED**  
AUG 29 2008  
HYDROLOGY  
SECTION

DRAWN BY  
REVIEWED BY  
DATE 12.01.0  
PROJECT NO. 0607  
DRAWING NAME

**TRAFFIC CIRCULAT  
LAYOUT FOR  
BUILDING PERMIT  
SHEET 2 OF 3**

SHEET NO.

**A2**  
OF

*Terry O. Brown, P.E.*  
P. O. Box 62051  
Albuquerque, NM 87198-2051  
(505) 885-8807 - Voice  
(505) 942-3000 - FAX  
e-mail: tobe@awcp.com

Saturday, October 01, 2005

Wilfred Gallegos  
City of Albuquerque Transportation Development  
600 2nd St NW  
Albuquerque, NM 87102

Re: Ladera Apartments (Ladera Rd. South of Bent Tree Dr.)

Dear Wilfred:

Attached is the required queuing analysis for the proposed south driveway of the proposed Ladera Senior Housing Project located on the east side of Ladera Rd. just south of Bent Tree Dr.

A recent traffic count indicated that the current volumes of traffic on Ladera Rd. are 440 northbound and 500 southbound vehicles during the AM Peak Hour and 290 northbound vehicles and 470 southbound vehicles during the PM Peak Hour.

Included in the Appendix of this study is the trip-generation calculation to determine the number of trips generated by this project during the AM and PM Peak Hour Weekday periods as well as the number of trips generated by the future development to the east. This project is described as the implementation of a 114-unit Senior Housing Development with apartment-like units. The future development will be an approximately 160-unit apartment complex. The trip generation calculations in this study assumed that both developments are classified as apartments (ITE Land Use 220) as defined in the ITE Trip Generation Manual (7th Edition - 2003).

Included in the Appendix of this study are the trip distribution worksheet which forecasts the disbursement of trips generated by this project based on a citywide employment gravity model utilizing a distance inverse relationship. The trip distribution model utilized in this study is based on the Mid-Region Council of Government's Socioeconomic data. Therefore, the trip distribution model utilized in this study is consistent with the Mid-Region Council of Government's model.

The trip distribution analysis indicates that approximately 69% of the traffic generated by this project will be attracted to and from the north on Ladera Rd. and the remaining 41% will be attracted to and from the south on Ladera Rd.

DATA06PROJECTSLadera\_ApartmentalLadera\_Analysis.doc

## TRAFFIC IMPACT STUDY - COVER LETTER

Page 2 of 3  
Wilfred Gallegos  
Saturday, October 01, 2005

Re: Ladera Apartments (Ladera Rd. South of Bent Tree Dr.)

Based on the above data, an unsignalized intersection analysis was performed for both proposed driveways on the project utilizing HICAP 2.0 (version 2) software. The HICAP 2.0 software utilizes methodology established by the Highway Capacity Manual (2000 Edition) to analyze unsignalized intersections and driveways.

The results of the analysis indicated that the average delay that is projected for the 2007 BUILD Conditions at the south driveway of this project will be no more than approximately 21.8 seconds. This is an average value, and it is conceivable and probable that some vehicles will experience more delay and some will experience less delay. However, it becomes unlikely that a significant percentage of exiting vehicles will experience more than twice the average delay. Therefore, it can be reasonably projected that there will not be a significant percentage of vehicles that experience more than a 44 second delay. Utilizing a three-minute queue in this case is not appropriate.

The HICAP analysis in the Appendix of this study indicates that the queue length for exiting traffic from this project and the future project (sharing Driveway "A") will be 1 vehicle (25 feet) based on 95% probably comfort level. An alternative means of calculating the queue length for exiting traffic at Driveway "A" is to utilize a one-minute, a two-minute, and a three-minute queue length based on the average arrival rate. The following table summarizes the results of those three queuing calculation methods:

Driveway "A"	Volume	Average Arrival Rate (per minute)	Two-Minute Queue	Three-Minute Queue
AM Peak	49	0.8	1.6	2.4
PM Peak	25	0.4	0.8	1.2

As stated earlier, a three-minute queue length is not appropriate for this project. Since the projected delays at the driveway are less than 0.5 minutes, it would be more appropriate to utilize a one or two minute. A two-minute queue length would require a 50 feet deep throat in the driveway. The current design is characterized by a 40 feet deep throat. However, by relocating the driveway to the north a short distance, a 50 feet deep throat can be accomplished.

The southbound left turn volume at Driveway "A" is projected to be approximately 14 vehicles per hour during the 2007 AM Peak Hour Conditions and approximately 74 vehicles per hour during the 2007 PM Peak Hour Conditions. Utilizing the maximum projected volume of 74 vehicles per hour, then a three-minute queue length would be 4 vehicles (or 100 feet).

DATA06PROJECTSLadera\_ApartmentalLadera\_Analysis.doc

Page 3 of 3  
Wilfred Gallegos  
Saturday, October 01, 2005

Re: Ladera Apartments (Ladera Rd. South of Bent Tree Dr.)

This study concludes that the two driveways proposed for this project will operate at acceptable levels-of-service with acceptable delays. This study recommends that a 50-foot deep throat be provided for the exiting traffic at the south driveway. Also this study recommends that a southbound left turn lane on Ladera Rd. be constructed at Driveway "A" at a minimum length of 100 feet plus transition to accommodate the projected 3-minute queue. Since the posted speed limit on Ladera Rd. at this location is 35 MPH, then it is consistent with the Development Process Manual to construct a 100 feet long left turn lane.

Please call if you have questions or need additional information.

Sincerely Yours,

*Terry O. Brown*

Terry O. Brown


cc: Scott McGee, Isaacson & Arfman w/attachments

attachments as noted

Appendix: Vicinity Map  
Preliminary Site Plan for Ladera Senior Housing Project  
Trip Generation Summary Table and Worksheets  
MFCOG Subarea Map  
Trip Distribution Map  
Trip Assignments Maps (% Entering and % Exiting)  
Turning Movement Volumes Summary and Worksheets  
Turning Movement Volumes Maps  
HICAP Unsignalized Intersection Analyses

**TRAFFIC CIRCULATION LAYOUT  
APPROVED**  
*[Signature]* 12/14/06  
Signed Date

DATA06PROJECTSLadera\_ApartmentalLadera\_Analysis.doc

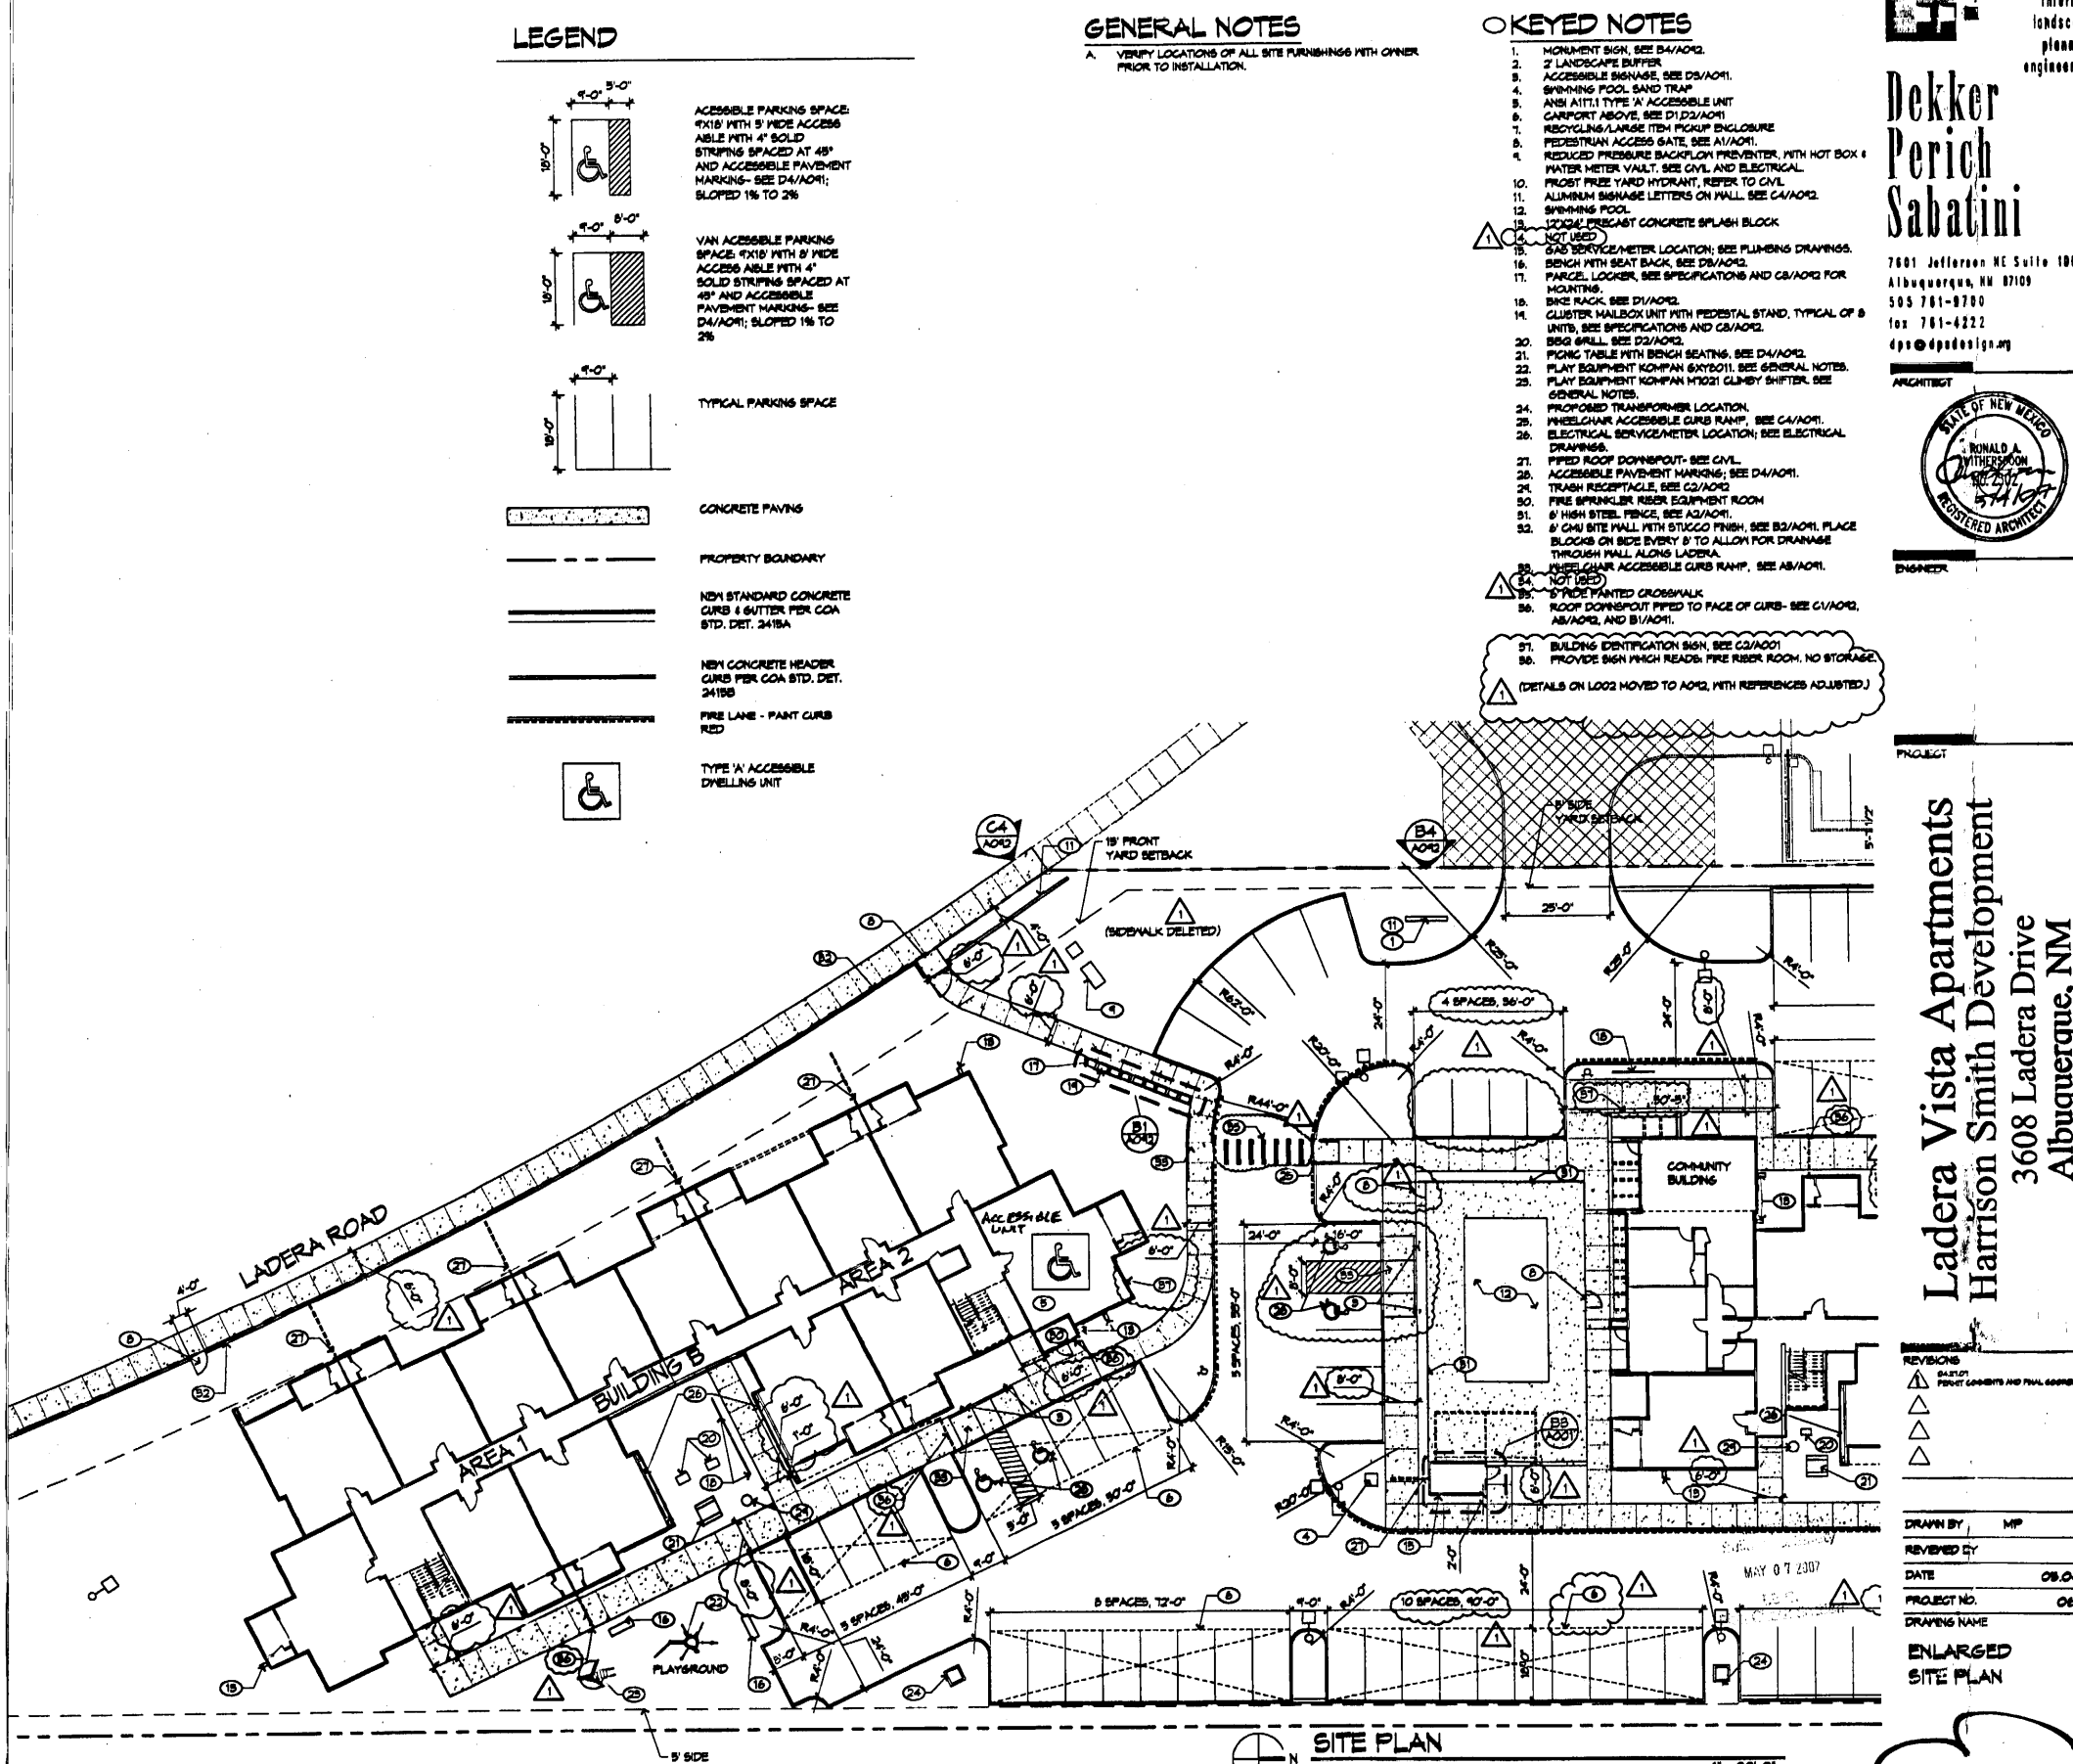

Ladera Vista Apartments  
Harrison Smith Development  
3608 Ladera Drive  
Albuquerque, NM

A002

NEW 6.5' WIDE SIDEWALK  
ALONG ENTIRE LADERA  
ROAD FRONTAGE

3 STORY RESIDENTIAL

MAIL BOXES  
SEE DETAIL 1, SHEET A1  
FOR RAMP (SIMILAR)

SEE DETAIL 1, SHEET A1  
FOR RAMP (SIMILAR)

SHADE STRUCTURE

POOL

COMMUNITY BUILDING

3 STORY RESIDENTIAL

Albuquerque  
Building & Safety  
MAR - 5 2007  
I.B.C.  
Plan Check Section


**ENLARGED SITE PLAN**

**RECEIVED**  
DEC 04 2006  
HYDROLOGY SECTION



**Dekker  
Perich  
Sabatini**

7601 Jefferson NE Suite 100  
Albuquerque, NM 87109  
505 761-9700  
fax 761-4222  
dps@dpsdesign.org

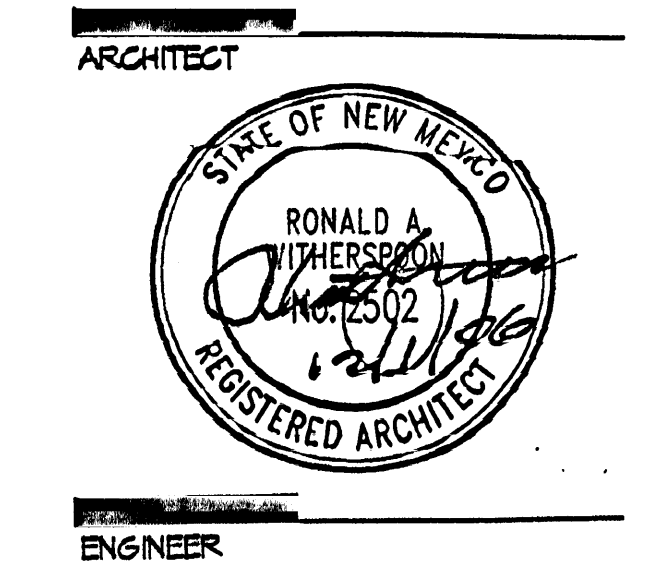

PROJECT

**Ladera Vista Apartments**  
**H.S. Rental Properties, Inc.**  
3608 Ladera Drive  
Albuquerque, NM

REVISIONS  
▲  
▲  
▲  
▲  
**RECEIVED**  
AUG 29 2008  
HYDROLOGY SECTION

DRAWN BY  
REVIEWED BY  
DATE 12.01.04  
PROJECT NO. 0607  
DRAWING NAME


**TRAFFIC CIRCULATION  
LAYOUT FOR  
BUILDING PERMIT**  
SHEET 3 OF 3

SHEET NO. **A3**  
OF


Albuquerque  
Building & Safety  
MAR - 5 2007  
I.B.C.  
Plan Check Section

**ENLARGED SITE PLAN**


**RECEIVED**  
DEC 04 2006  
HYDROLOGY SECTION

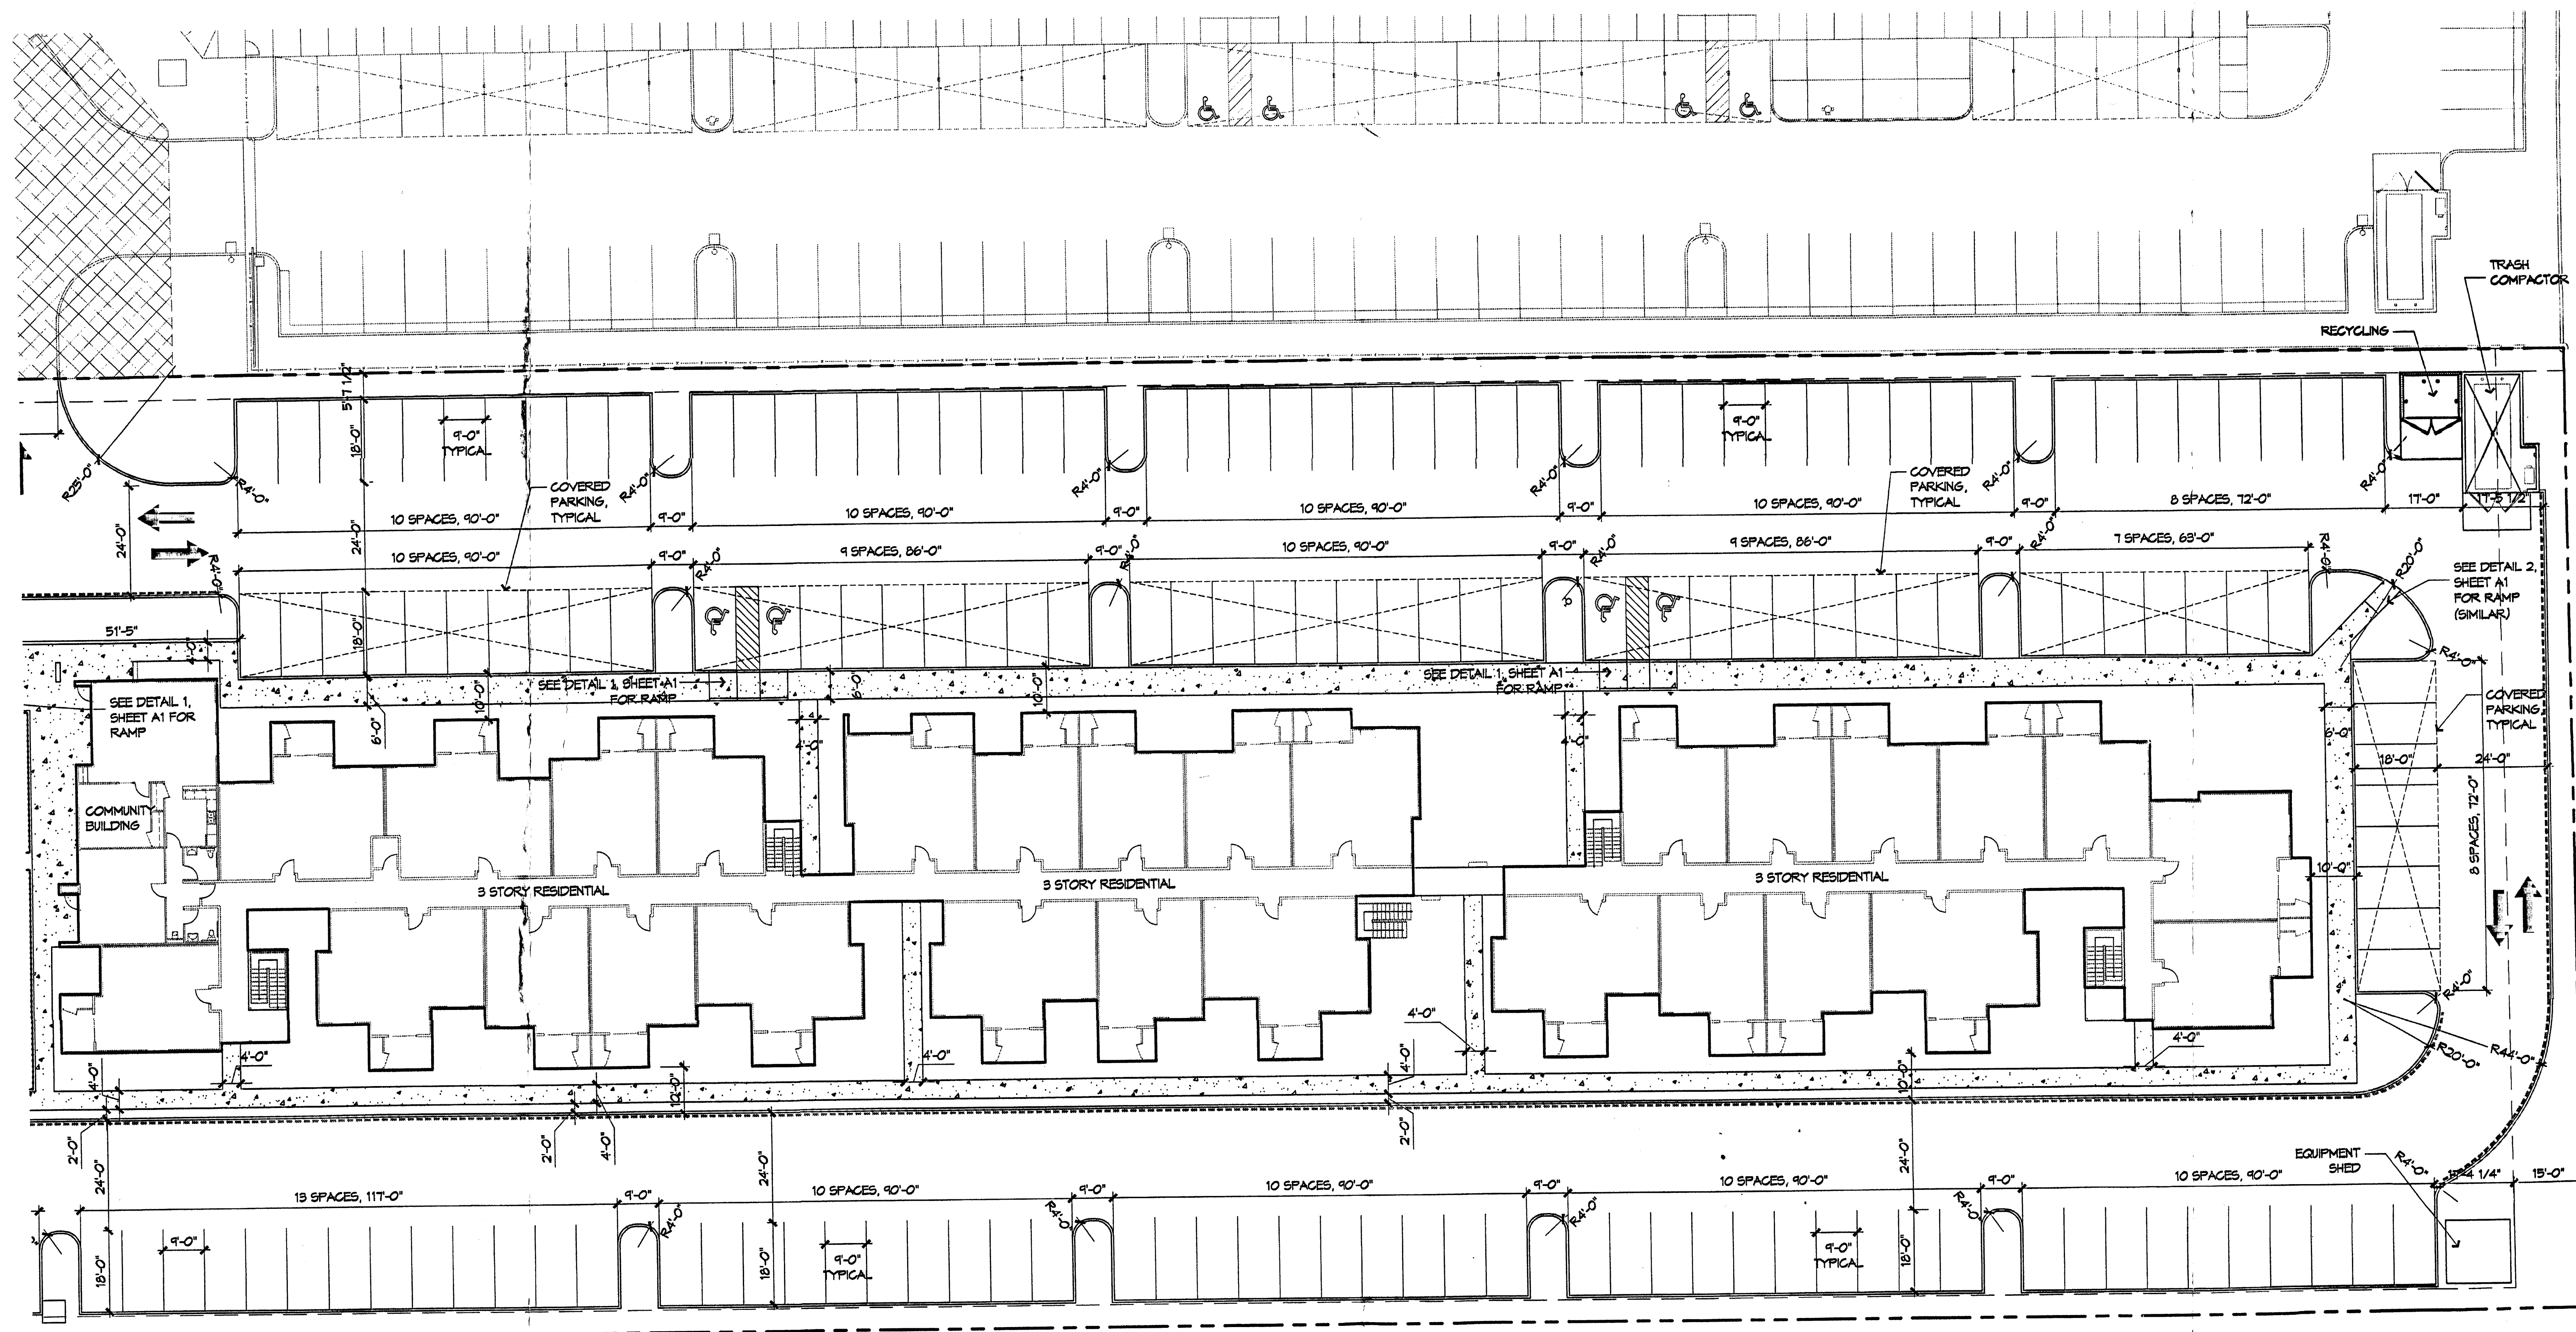


# LEGEND

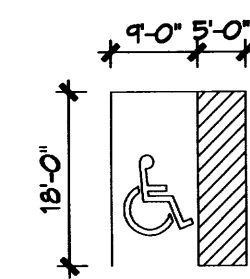


Accessible Parking Space for Car: 5'-0" Access Aisle; White Int'l HC Symbol; 4" solid spaced striping spaced at 45°; sloped 1% to 2%

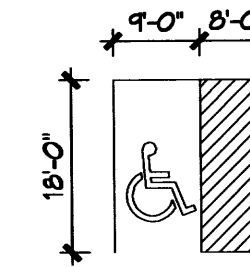


Accessible Parking Space for Van: 8'-0" Access Aisle; White Int'l HC Symbol; 4" solid spaced striping spaced at 45°; sloped 1% to 2%

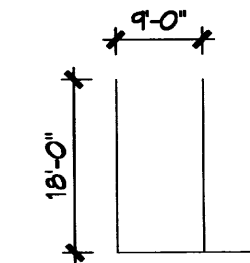

Typical Parking Space

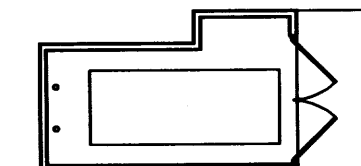


Compactor (truck access req.)

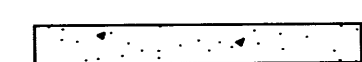

Proposed Sidewalk, typ.




Property Boundary

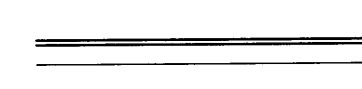

New Standard Concrete Curb & Gutter per COA std. det. 2415A



 New Concrete Header Curb per COA std. det. 2415B




Fire Lane - Paint curb red



Direction of Traffic Flow

## 1 CURB ACCESS RAMP

1/4" = 1'-0"

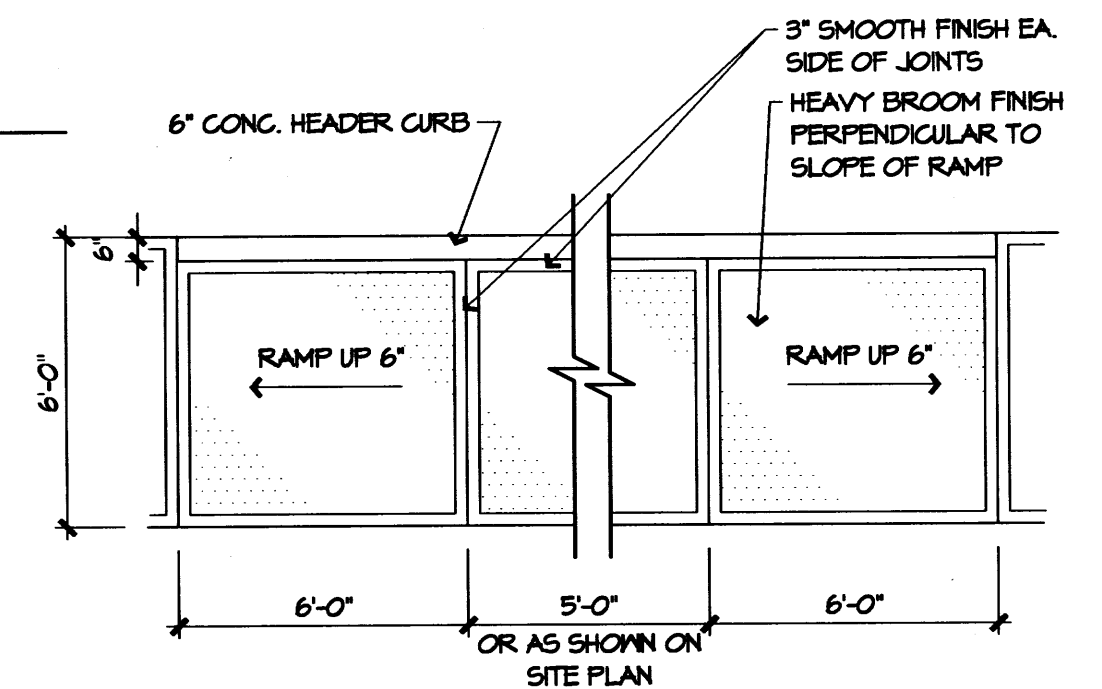

## 2 DIRECTIONAL HANDICAP RAMP

NTS

NTS

# PROJECT LOCATION

LOCATION: ALBUQUERQUE, NEW MEXICO

LEGAL DESCRIPTION: TRACT NUMBERED/LETTERED FIVE - A (5-A) OF THE TOWN OF ATRISCO GRANT, AS THE SAME IS SHOWN AND DESIGNATED ON THE PLAT THEREOF, FILED IN THE OFFICE OF THE COUNTY CLERK OF BERNALILLO COUNTY, NEW MEXICO, ON SEPTEMBER 18, 1986, IN PLAT BOOK C31 PAGE 125 ZONE: R-2: HOUSES, TOWNHOUSES, AND MEDIUM DENSITY APARTMENTS.

ZONE MAP PAGE: 6-11-Z

SITE AREA: 4.2468 ACRES = 184,911 SQ. FT.

# PARKING ANALYSIS

APPLICABLE CODES:

COMPREHENSIVE CITY ZONING CODE, REVISED & UPDATED THROUGH MAY, 2006 (ABQ CCZC)

PARKING REQUIRED, PER 14-6-3-1 (24) (a) & (b)

98 UNITS @ 1.5 / 1 BATH UNIT	=	147 SPACES
24 UNITS @ 2 / 2 BATH UNIT	=	58 SPACES
COMMUNITY BUILDING @ 1 PER 200 SF	=	9 SPACES
SUBTOTAL	=	214 SPACES
10% TRANSIT REDUCTION	=	-21 SPACES

TOTAL = 193 SPACES

PARKING PROVIDED: = 193 SPACES

ACCESSIBLE PARKING REQUIRED: 101-300 SPACES:



8 SPACES WITH 1 VAN SPACE

ACCESSIBLE PARKING PROVIDED:

8 SPACES WITH 1 VAN SPACE


# TRAFFIC IMPACT STUDY

SEE ATTACHED COVER LETTER FOR TRAFFIC IMPACT STUDY APPLICABLE TO MEDIAN IMPROVEMENTS CONSTRUCTED UNDER CITY WORK ORDER #175601. (APPLIES TO MAIN ENTRY TO ADJOINING SITE/ACCESS EASEMENT) NOTE THAT THIS TRAFFIC IMPACT STUDY ASSIGNED 160 DWELLING UNITS FOR THIS PROJECT. ACTUAL NUMBER OF DWELLING UNITS FOR THIS PROJECT IS 121.

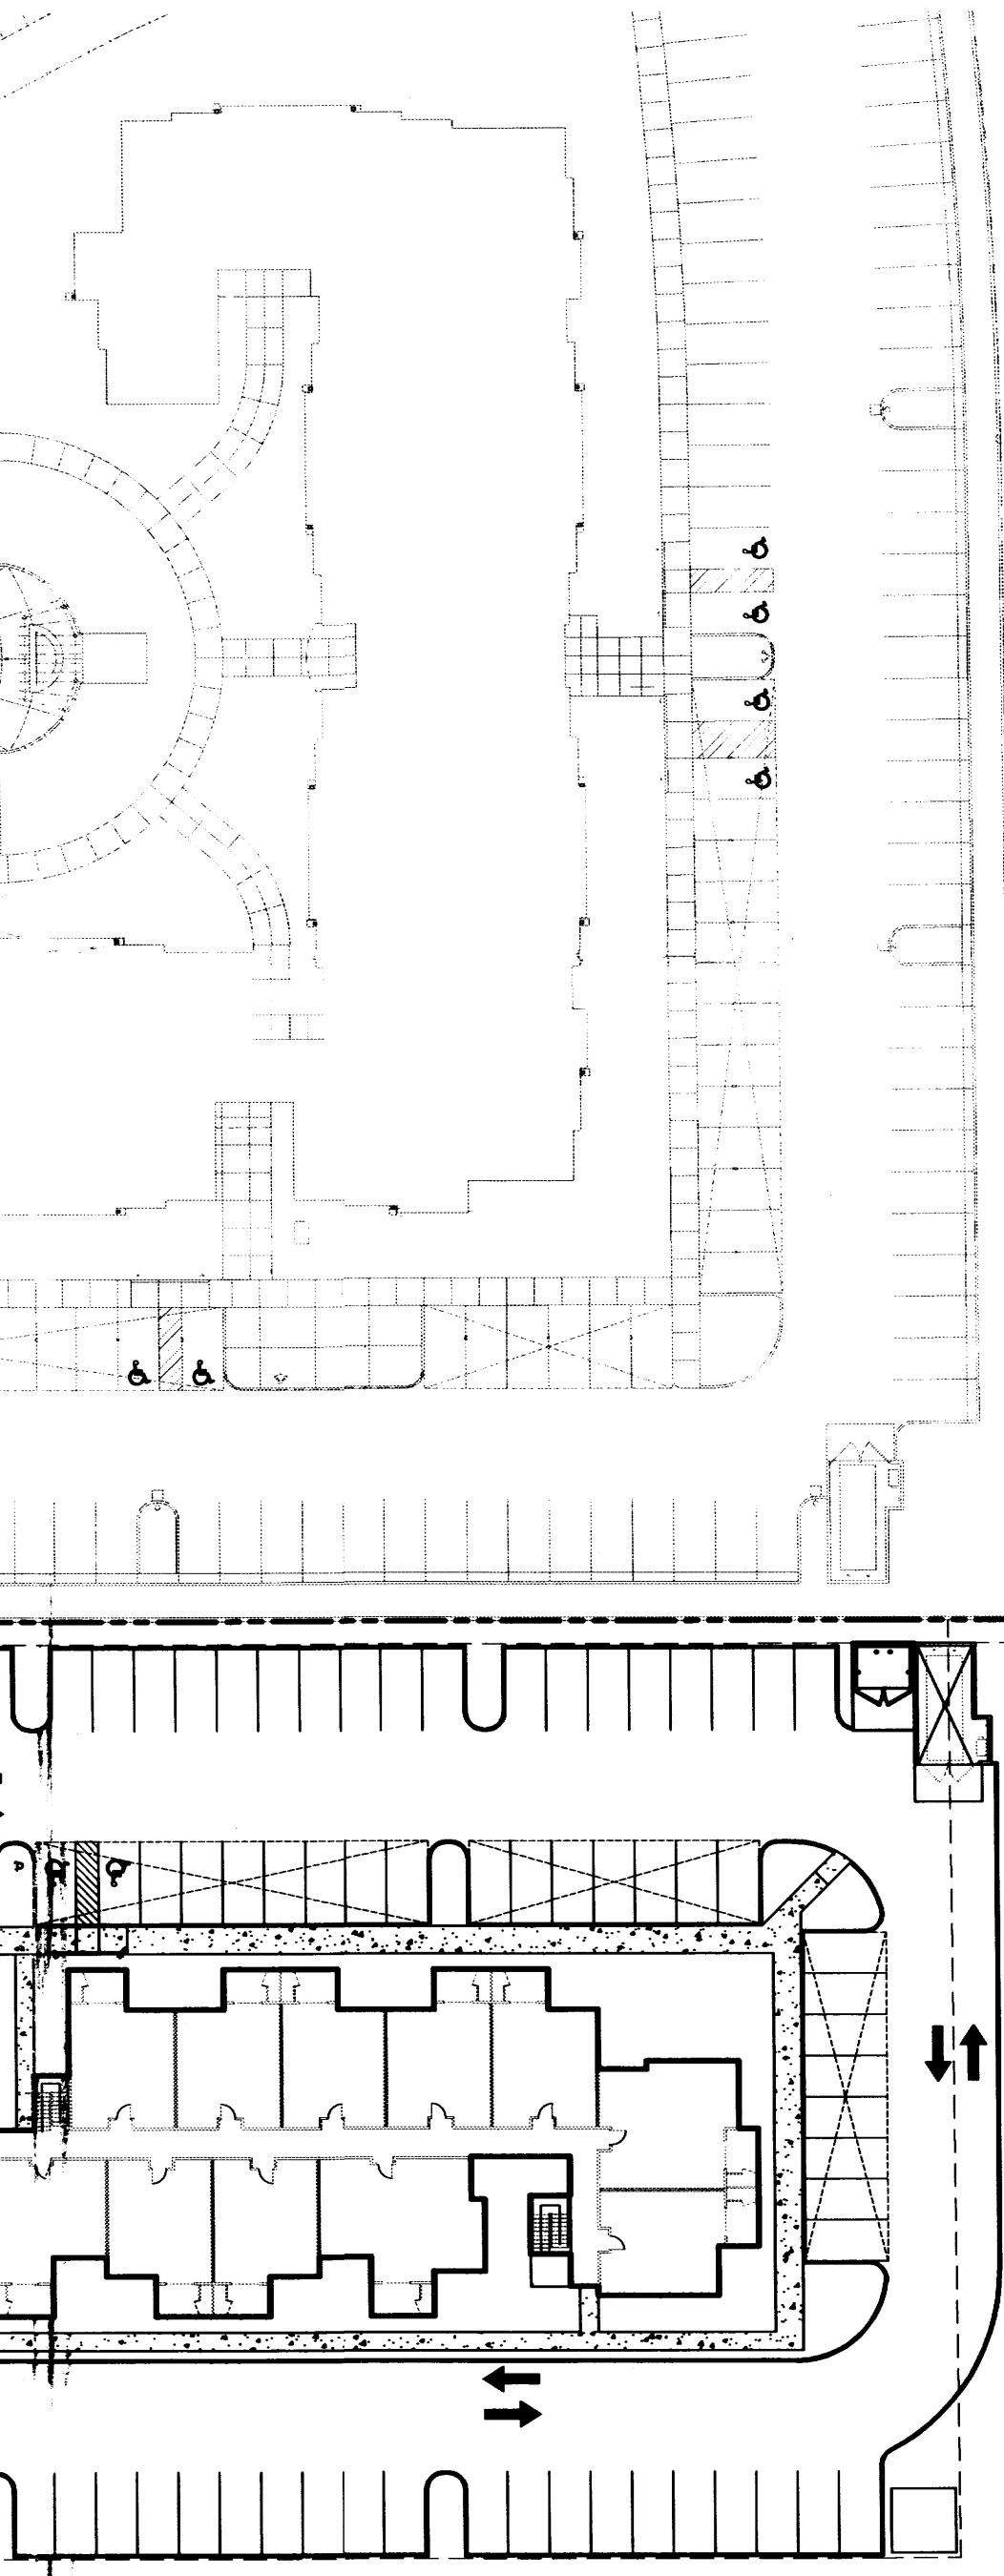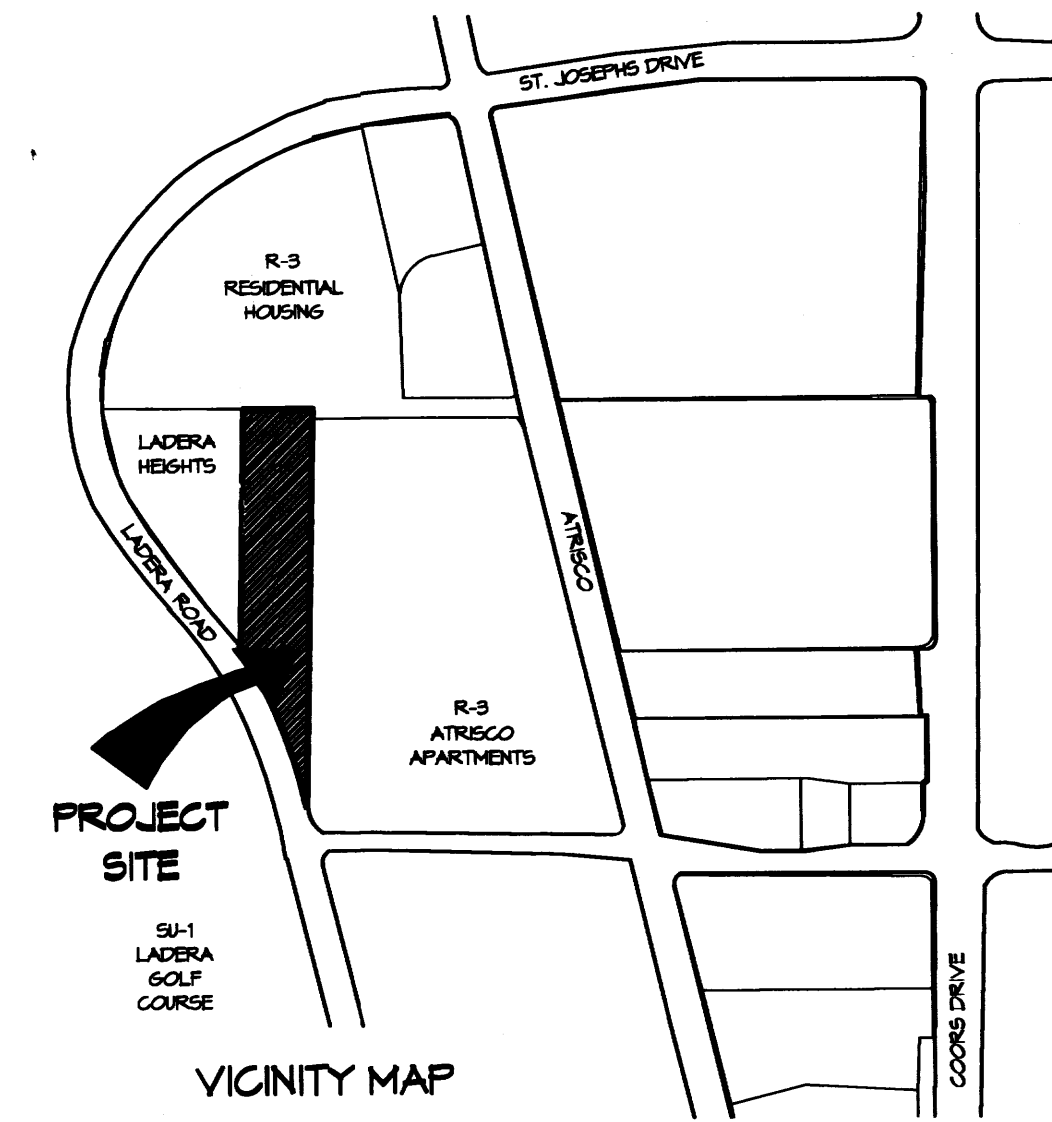

# OVERALL SITE PLAN

1" = 40'-0"

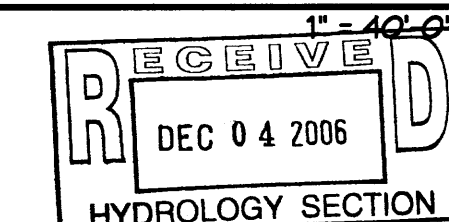

architecture  
interiors  
landscape  
planning  
engineering

**Dekker  
Perich  
Sabatini**

7601 Jefferson NE Suite 100  
Albuquerque, NM 87109  
505 761-9700  
fax 761-4222  
dps@dpsdesign.org

ARCHITECT




ENGINEER

PROJECT

**Ladera Vista Apartments**  
**H.S. Rental Properties, Inc.**  
3608 Ladera Drive  
Albuquerque, NM

REVISIONS

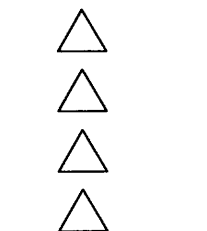

DRAWN BY

REVIEWED BY

DATE

PROJECT NO.

DRAWING NAME

TRAFFIC CIRCULATION

LAYOUT FOR

BUILDING PERMIT

SHEET 1 OF 3

SHEET NO.

OF

A1



Based on the above data, an unsignalized intersection analysis was performed for both proposed driveways on the project utilizing HICAP 2.0 (version 2) software. The HICAP 2.0 software utilizes methodology established by the Highway Capacity Manual (2000 Edition) to analyze unsignalized intersections and driveways.

The results of the analysis indicated that the average delay that is projected for the 2007 BUILD Conditions at the south driveway of this project will be no more than approximately 21.8 seconds. This is an average value, and it is conceivable and probable that some vehicles will experience more delay and some will experience less delay. However, it becomes unlikely that a significant percentage of exiting vehicles will experience more than twice the average delay. Therefore, it can be reasonably projected that there will not be a significant percentage of vehicles that experience more than a 44 second delay. Utilizing a three-minute queue in this case is not appropriate.

The HICAP analysis in the Appendix of this study indicates that the queue length for exiting traffic from this project and the future project (sharing Driveway "A") will be 1 vehicle (25 feet) based on 95% probably comfort level. An alternative means of calculating the queue length for exiting traffic at Driveway "A" is to utilize a one-minute, a two-minute, and a three-minute queue length based on the average arrival rate. The following table summarizes the results of those three queuing calculation methods:

Driveway "A"	Volume	Average Arrival Rate (per minute) One-Minute Queue	Two-Minute Queue	Three-Minute Queue
AM Peak	49	0.8	1.6	2.4
PM Peak	25	0.4	0.8	1.2

As stated earlier, a three-minute queue length is not appropriate for this project. Since the projected delays at the driveway are less than 0.5 minutes, it would be more appropriate to utilize a one or two minute. A two-minute queue length would require a 50 feet deep throat in the driveway. The current design is characterized by a 40 feet deep throat. However, by relocating the driveway to the north a short distance, a 50 feet deep throat can be accomplished.

The southbound left turn volume at Driveway "A" is projected to be approximately 14 vehicles per hour during the 2007 AM Peak Hour Conditions and approximately 74 vehicles per hour during the 2007 PM Peak Hour Conditions. Utilizing the maximum projected volume of 74 vehicles per hour, then a three-minute queue length would be 4 vehicles (or 100 feet).

D:\AT06\PROJECTS\Ladera\_Apartments\Ladera\_Analysis.doc

This study concludes that the two driveways proposed for this project will operate at acceptable levels-of-service with acceptable delays. This study recommends that a 50-foot deep throat be provided for the exiting traffic at the south driveway. Also this study recommends that a southbound left turn lane on Ladera Rd. be constructed at Driveway "A" at a minimum length of 100 feet plus transition to accommodate the projected 3-minute queue. Since the posted speed limit on Ladera Rd. at this location is 35 MPH, then it is consistent with the Development Process Manual to construct a 100 foot long left turn lane.

Please call if you have questions or need additional information.

Sincerely Yours,

Terry O. Brown


Terry O. Brown

cc: Scott McGee, Isaacson & Arfman w/attachments

attachments as noted

Appendix:  
Vicinity Map  
Preliminary Site Plan for Ladera Senior Housing Project  
Trip Generation Summary Table and Worksheets  
MRCOG Subarea Map  
Trip Distribution Map  
Trip Assignments Maps (% Entering and % Exiting)  
Turning Movement Volumes Summary and Worksheets  
Turning Movement Volumes Maps  
HICAP Unsignalized Intersection Analyses

D:\AT06\PROJECTS\Ladera\_Apartments\Ladera\_Analysis.doc

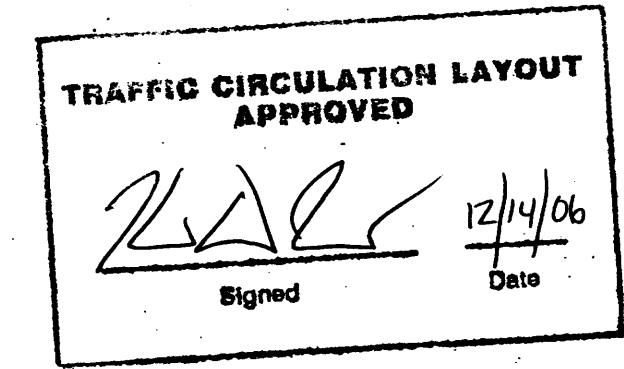

Terry O. Brown, P.E.  
P. O. Box 92051  
Albuquerque, NM 87199-2051  
(505) 883-8807 - Voice  
(505) 942-3800 - FAX  
e-mail: tobe@ewcp.com

Saturday, October 01, 2005

Wilfred Gallegos  
City of Albuquerque Transportation Development  
600 2nd St. NW  
Albuquerque, NM 87102

Re: Ladera Apartments (Ladera Rd. South of Bent Tree Dr.)

Dear Wilfred:

Attached is the required queuing analysis for the proposed south driveway of the proposed Ladera Senior Housing Project located on the east side of Ladera Rd. just south of Bent Tree Dr.

A recent traffic count indicated that the current volumes of traffic on Ladera Rd. are 440 northbound and 500 southbound vehicles during the AM Peak Hour and 290 northbound vehicles and 470 southbound vehicles during the PM Peak Hour.


Included in the Appendix of this study is the trip generation calculation to determine the number of trips generated by this project during the AM and PM Peak Hour Weekday periods as well as the number of trips generated by the future development to the east. This project is described as the implementation of a 114-Unit Senior Housing Development with apartment-like units. The future development will be an approximately 160-unit apartment complex. The trip generation calculations in this study assumed that both developments are classified as apartments (ITE Land Use 220) as defined in the ITE Trip Generation Manual (7th Edition - 2003).

Included in the Appendix of this study are the trip distribution worksheet which forecasts the disbursement of trips generated by this project based on a citywide employment gravity model utilizing a distance inverse relationship. The trip distribution model utilized in this study is based on the Mid-Region Council of Government's Socioeconomic data. Therefore, the trip distribution model utilized in this study is consistent with the Mid-Region Council of Governments model.


The trip distribution analysis indicates that approximately 59% of the traffic generated by this project will be attracted to and from the north on Ladera Rd. and the remaining 41% will be attracted to and from the south on Ladera Rd.

D:\AT06\PROJECTS\Ladera\_Apartments\Ladera\_Analysis.doc


TRAFFIC IMPACT STUDY - COVER LETTER

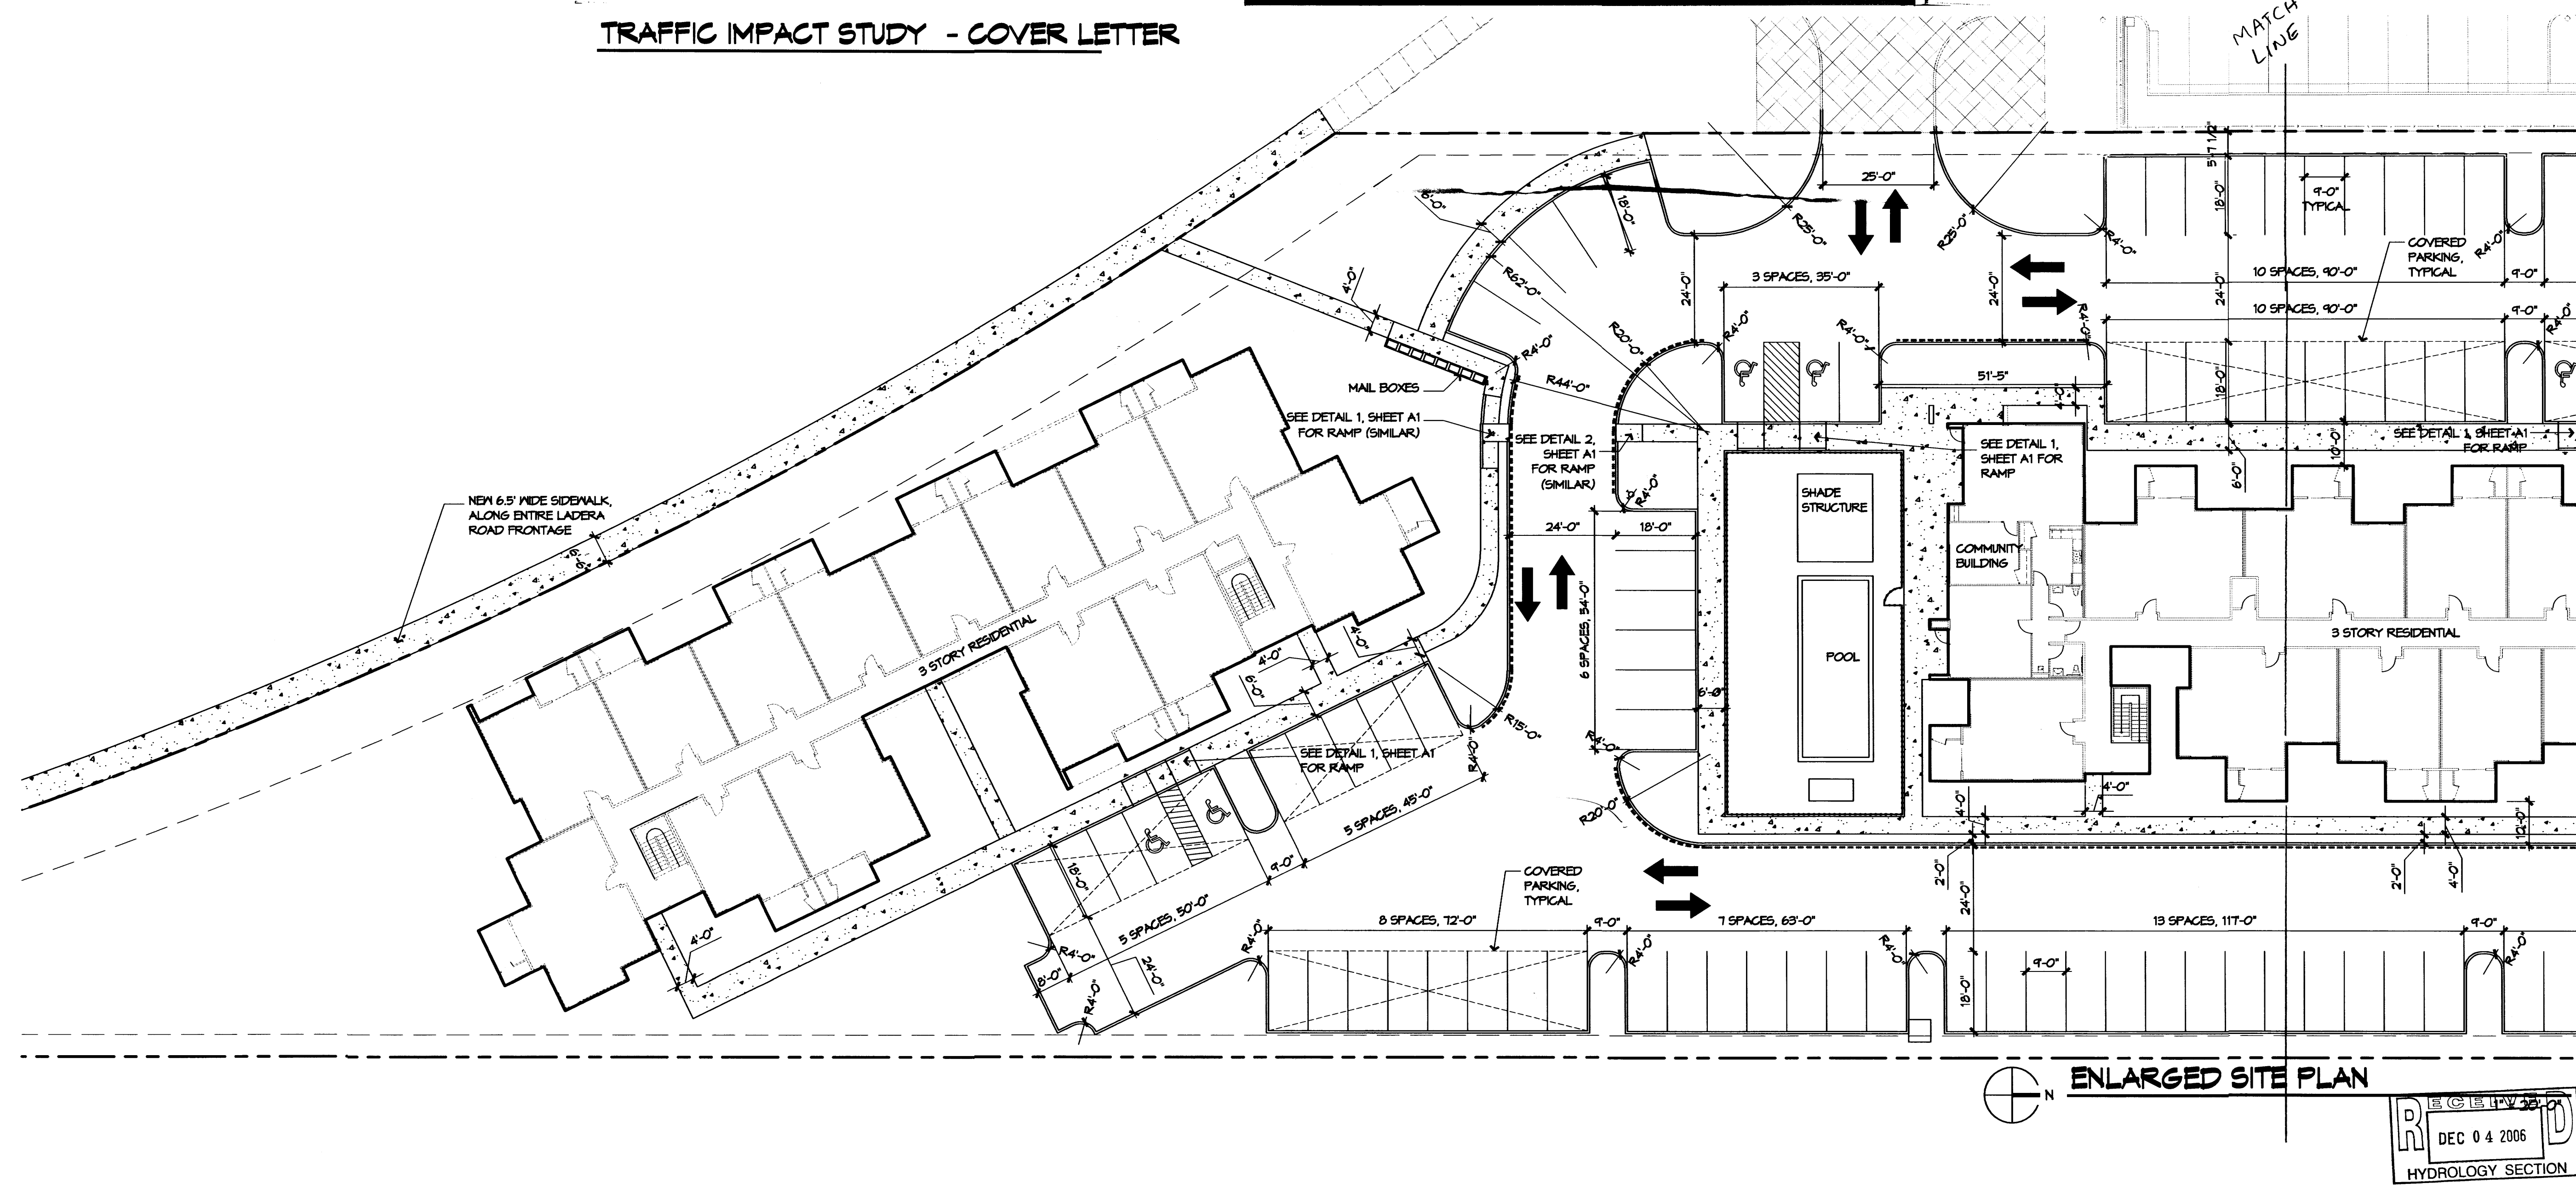

ENLARGED SITE PLAN

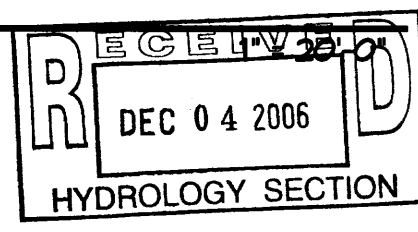




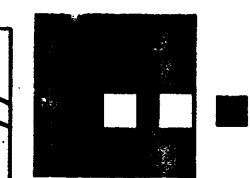

**Dekker  
Perich  
Sabatini**


7601 Jefferson NE Suite 100  
Albuquerque, NM 87109  
505 761-9700  
fax 761-4222  
dps@dpsdesign.org

ARCHITECT

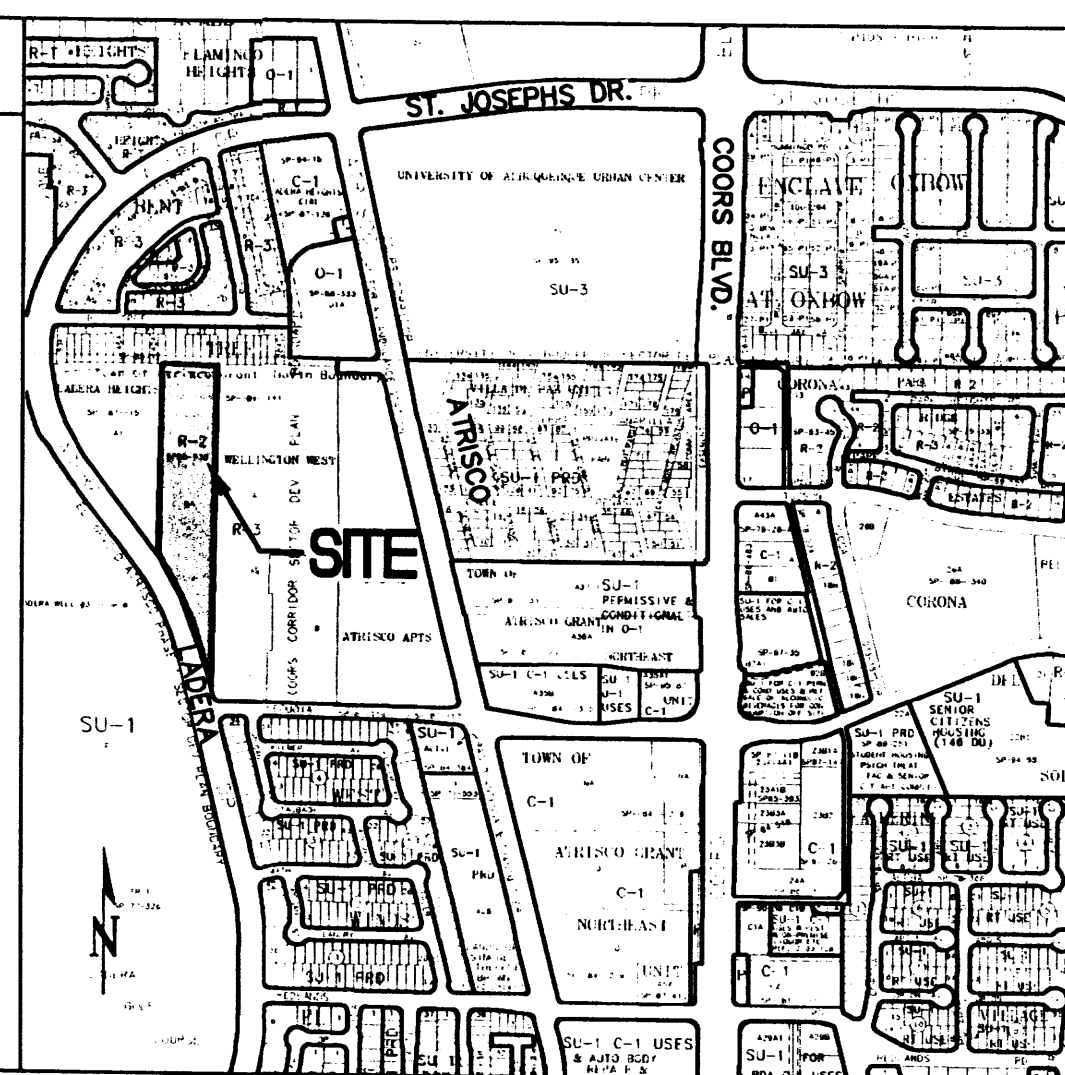

VICINITY MAP 1"=750'±

○ KEYED NOTES	○ KEYED NOTES	○ KEYED NOTES	○ KEYED NOTES
<p>23 CONSTRUCT CONCRETE DUMPSTER PAD AND ENCLOSURE AT ELEVATIONS SHOWN. INSTALL AREA DRAIN AT LOWPOINT OF DUMPSTER PADS.</p> <p>24 INSTALL ADS 12" DIA. END SECTION AT PIPE OPENING.</p>	<p>16 PROVIDE 2' WIDE OPENING IN CURB AT FLOWLINE ELEVATION SHOWN TO PASS LANDSCAPE FLOW TO PAVEMENT.</p> <p>17 CONSTRUCT 2' WIDE CONCRETE ALLEY GUTTER AT ELEVATIONS SHOWN (MIN. SLOPE = 0.5%). SEE SHEET C002 FOR DETAIL.</p> <p>18 CONSTRUCT SITE PRIVACY WALL ALONG SOUTHWEST PROPERTY BOUNDARY. PROVIDE TURNED CMU BLOCKS IN WALL AT 4' O.C. AT GRADE TO PASS SHEETFLOW.</p> <p>19 INSTALL ADS 8" INLINE DRAIN WITH 18" DOMED GRATE AT LOW POINT. EXTEND 8" DRAINLINE TO NEW MANHOLE. PROVIDE 4' DIA. X 12" DEEP COBBLE PAD AROUND INLET FOR EROSION PROTECTION. SEE SHEET C002 FOR ADDITIONAL INFORMATION.</p> <p>20 12" DIA. SCH. 40 PVC STORM DRAIN CONNECTION FROM PRIVATE MANHOLE TO EXISTING LADERA ROAD PUBLIC STORM DRAIN INLET PER C.O.A. STD. DWG. 2237 BY SEPARATE WORK ORDER.</p> <p>21 CONSTRUCT CONCRETE WALK WITH TURNED-DOWN EDGE ADJACENT TO ASPHALT PAVEMENT UNLESS NOTED #4.</p> <p>22 PROVIDE PRECAST CONCRETE SPLASHBLOCK AT ROOF DRAIN SURFACE OUTLETS. GRADE TO DIRECT ROOF DRAINAGE AWAY FROM BUILDING. INSTALL ACO-DRAIN SIDEWALK TRENCH DRAIN WITH PEDESTRIAN GRATE AT EACH ROOF DRAIN OUTLET. SEE DETAIL ON SHEET C002.</p>	<p>9 SWIMMING POOL AREA GRADES SHOWN FOR GENERAL INFORMATION ONLY. SEE ARCHITECTURAL FOR ADDITIONAL INFORMATION.</p> <p>10 CONSTRUCT LANDSCAPED STILLING BASIN AT GRADES SHOWN TO ACCEPT SITE DRAINAGE. FLOW IN EXCESS OF BASIN CAPACITY WILL DISCHARGE TO LADERA ROAD AT OVERFLOW.</p> <p>11 PROVIDE 1' WIDE (BOTTOM WIDTH) 'U' SHAPED CONCRETE CHANNEL THROUGH PARKING ISLAND TO PASS FLOW. MIN. SLOPE = 0.5%.</p> <p>12 CONSTRUCT 2' WIDE (BOTTOM WIDTH) 'U' SHAPED CONCRETE CHANNEL AT ELEVATIONS SHOWN THROUGH MAIN ENTRANCE ISLAND TO PASS FLOW.</p> <p>13 CONSTRUCT 6' WIDE X 6" THICK X 3" DEPRESSED CONCRETE DIP SECTION ACROSS ACCESS DRIVE AT ELEVATIONS SHOWN (FULL LENGTH) TO PASS CONCENTRATED DRAINAGE FROM CHANNEL SOUTH AS SHOWN.</p> <p>14 TWO 24" WIDE (BOTTOM WIDTH) X 8" DEEP COVERED SIDEWALK CULVERT PER C.O.A. STD. DWG. 2236 BY SEPARATE WORK ORDER.</p> <p>15 CONSTRUCT 12" WIDE (BOTTOM WIDTH) X 6" DEEP COVERED SIDEWALK CULVERT TO PASS DISCHARGE.</p>	<p>1 ALL ON-SITE SPOT ELEVATIONS WITHIN PAVEMENT AREAS REPRESENT TOP OF PAVING UNLESS NOTED. ADD 6" TYPICAL FOR TOP OF CURB / TOP OF WALK ELEVATIONS UNLESS NOTED.</p> <p>2 INSTALL ASPHALT PAVING WITH 1% MINIMUM SLOPE (AS SHOWN) TO PREVENT BIRDBATHS AND MAINTAIN POSITIVE DRAINAGE.</p> <p>3 SAWCUT EXISTING ASPHALT AS REQUIRED TO PROVIDE CLEAN BONDING EDGE. PROVIDE SMOOTH TRANSITION BETWEEN EXISTING AND NEW PAVEMENT.</p> <p>4 CONSTRUCT CONCRETE MEDIAN CURB (6" HIGH) AND GUTTER TYPICAL AT ALL CURB LOCATIONS WHICH CARRY CONCENTRATED FLOW. SEE SHEET C002 FOR DETAIL.</p> <p>5 CONSTRUCT HANDICAP PARKING SPACES WITH 2% MAX. SLOPE ALL DIRECTIONS.</p> <p>6 CONSTRUCT HANDICAP ACCESS RAMP - SEE ARCHITECTURAL FOR DETAILS.</p> <p>7 ROOF DRAINAGE DIRECTION. SEE ARCHITECTURAL FOR SPECIFIC RELEASE POINTS.</p> <p>8 PROVIDE 24" WIDE (BOTTOM WIDTH) CURB CUT TO PASS DISCHARGE TO LANDSCAPED STILLING BASIN.</p>

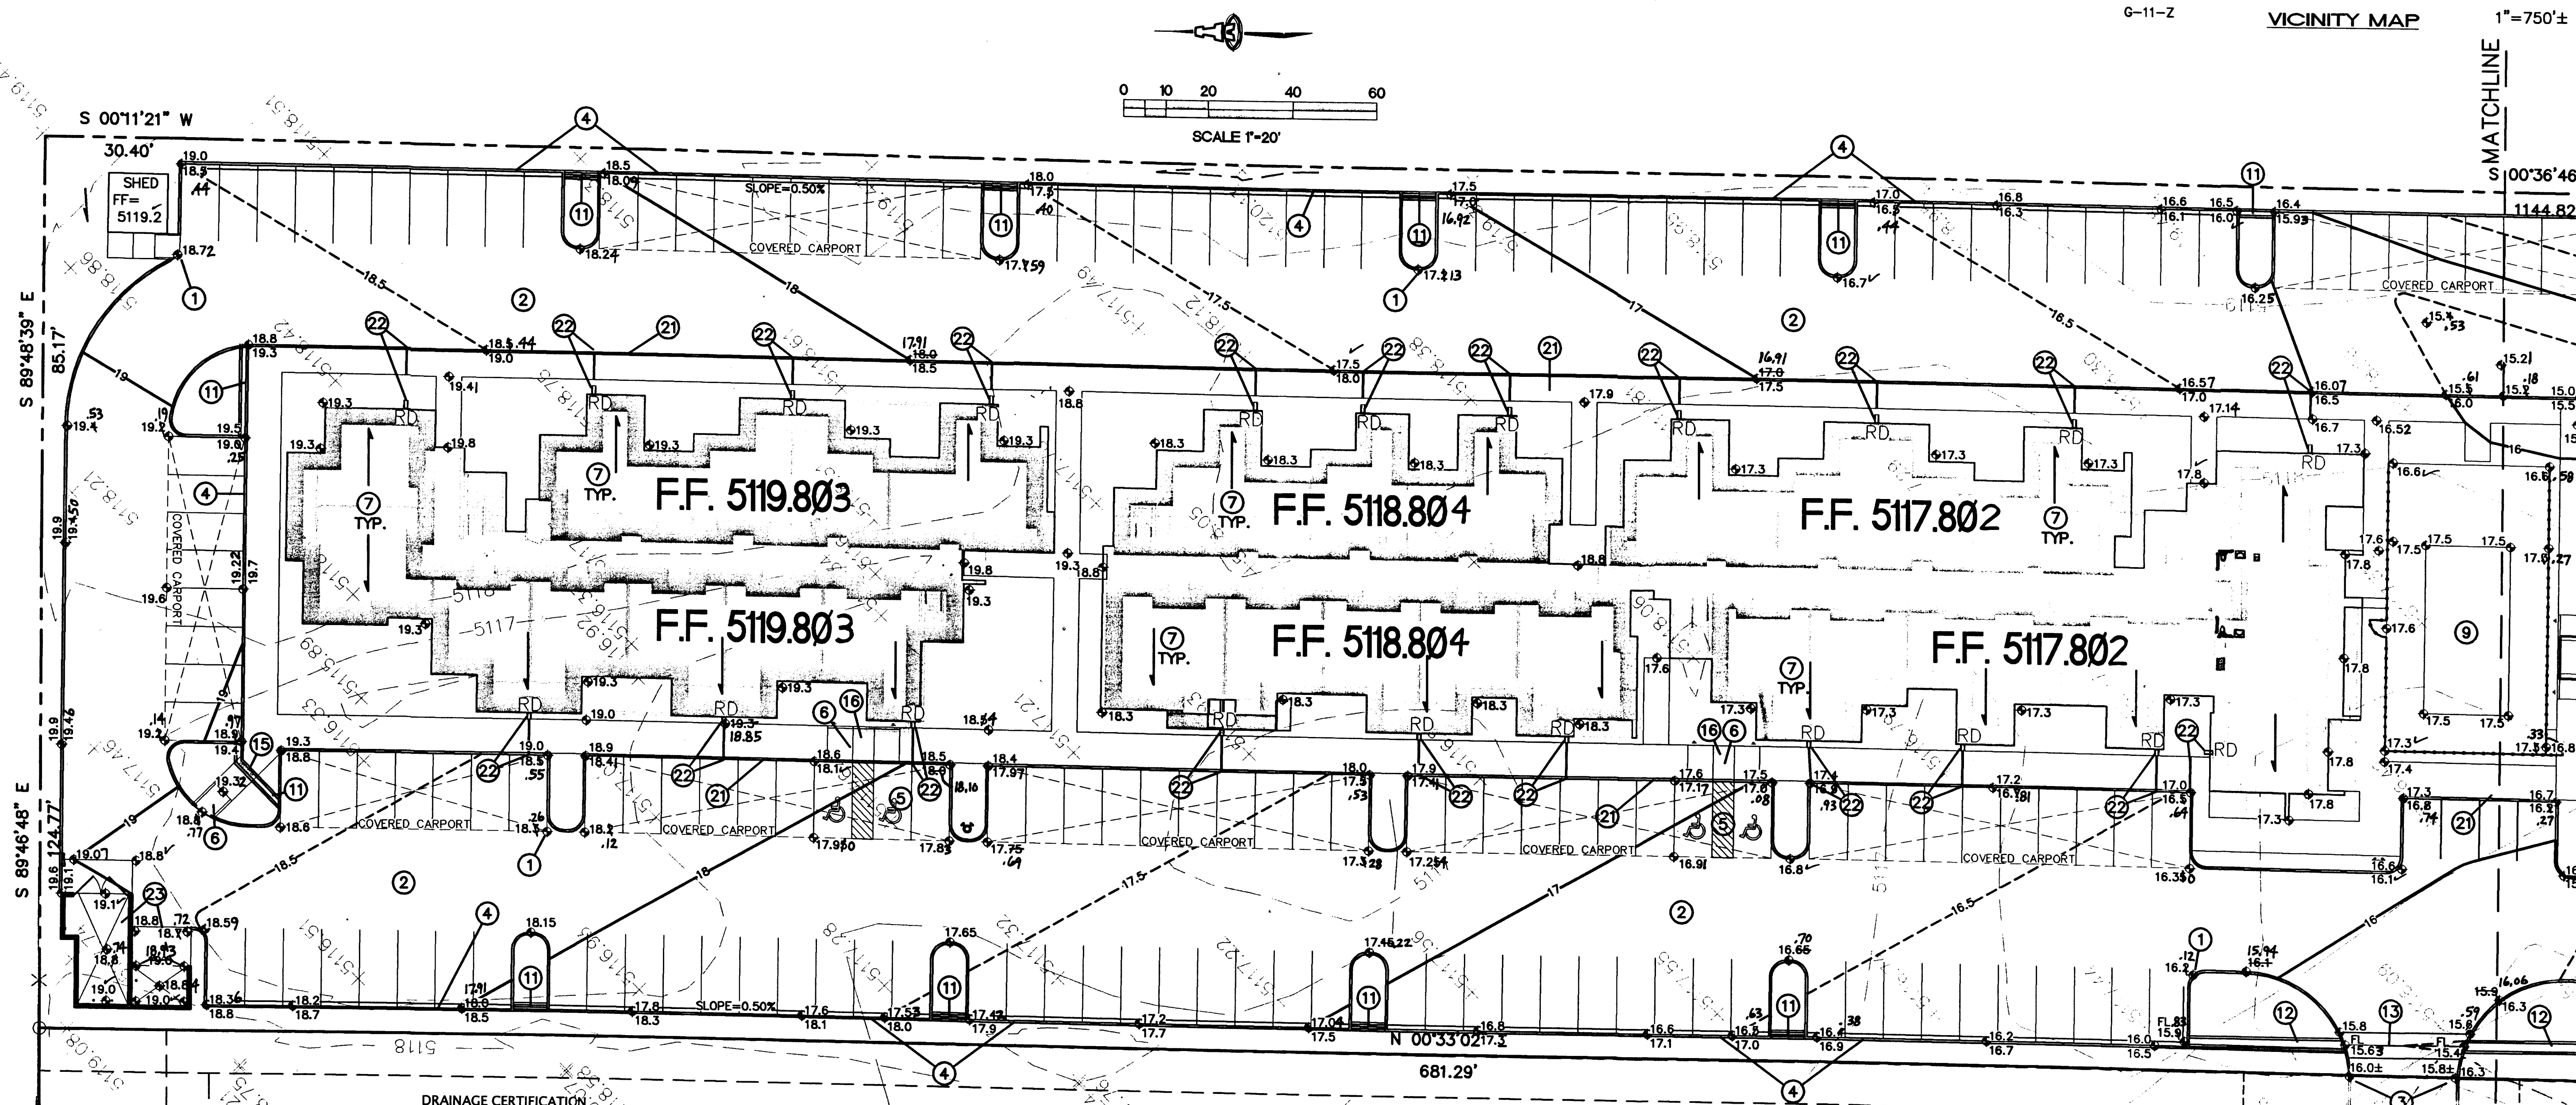

**TEMPORARY C.O.**

I, Scott M. McGee, NMPE 10519, of the firm Isaacson & Arfman, P.A., hereby certify that this project has been graded and will drain in substantial compliance with and in accordance with the design intent of the approved plan dated 05/02/07. The concrete drainage channels shown either side of the entry have been built too narrow and will need to be re-built. The concrete alley gutters shown at the entry and SE of the pool will also need to be installed. The record information edited onto the original design document has been obtained by, Anthony Harris, NMPS 11463, of the firm Harris Surveying, Inc.

The record information presented hereon is not necessarily complete and intended only to verify substantial compliance of the grading and drainage aspects of this project. Those relying on this record document are advised to obtain independent verification of its accuracy before using it for any other purpose.

Scott M. McGee  
NMPE 10519  
Date 5/22/08



**DRAINAGE CERTIFICATION**

I, Scott M. McGee, NMPE 10519, of the firm Isaacson & Arfman, P.A., hereby certify that this project has been graded and will drain in substantial compliance with and in accordance with the design intent of the approved plan dated 05/02/07. The record information edited onto the original design document has been obtained by, Anthony Harris, NMPS 11463, of the firm Harris Surveying, Inc.

The record information presented hereon is not necessarily complete and intended only to verify substantial compliance of the grading and drainage aspects of this project. Those relying on this record document are advised to obtain independent verification of its accuracy before using it for any other purpose.

Scott M. McGee  
NMPE 10519  
Date 8/22/08



PROJECT DATA	
LEGAL DESC.:	LOT 5-A TOWN OF ATRISCO GRANT ALBUQUERQUE, BERNALILLO COUNTY, NEW MEXICO
SURVEYOR:	ANTHONY L. HARRIS, N.M.P.S.#11463 HARRIS SURVEYING, INC. 2412-D MONROE STREET NE, ALBUQUERQUE, NEW MEXICO 87110 TELEPHONE (505) 889-8056
BENCHMARK:	ELEVATIONS ARE BASED ON CITY OF ALBUQUERQUE STATION NO. "10-G11", HAVING AN ELEVATION OF 5114.459
*SEE SHEET C002 FOR LEGEND	

**RECEIVED**  
AUG 22 2008  
HYDROLOGY SECTION


**ISAACSON & ARFMAN, P.A.**  
Consulting Engineering Associates  
128 Monroe Street N.E.  
Albuquerque, New Mexico 87108  
Ph. 505-268-8828 Fax. 505-268-2632  
1579GRD.dwg May 02, 2007

DATE 02.09.07  
PROJECT NO. 06072  
DRAWING NAME  
**GRADING AND DRAINAGE PLAN**  
1 of 2  
SHEET NO.  
**C001**  
OF




**Ladera Vista Apartments**  
Harrison Smith Development  
3608 Ladera Drive  
Albuquerque, NM



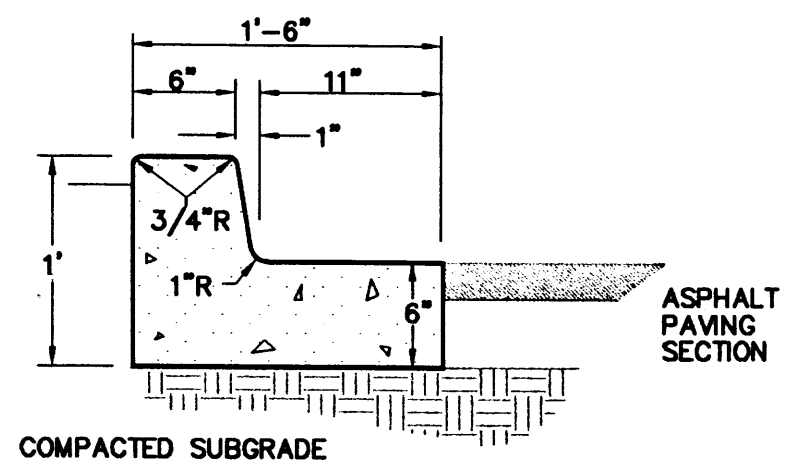


- GENERAL NOTES**
1. PROVIDE CONST. CONTROL JOINTS @ 6' O.C. MAX. AND 1/2" EXPANSION JOINTS @ 48' O.C. MAX.
  2. EDGES SHOULD BE REMOVED WITH 3/8" EDGING TOOL.
  3. MEDIAN C & G REQUIRE FULL FORM ON ALL FACES.

**MEDIAN CURB AND GUTTER**

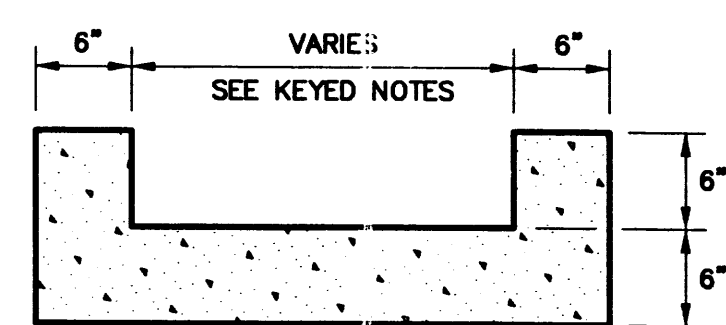


- GENERAL NOTES**
1. PROVIDE CONST CONTROL JOINTS @ 7' O.C. MAX.
  2. EDGES SHOULD BE REMOVED WITH 3/8" EDGING TOOL.

**'U' SHAPED CONC. CHANNEL**

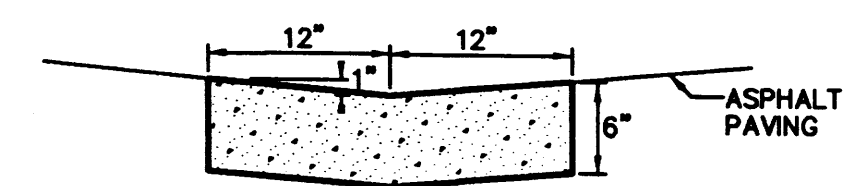

- GENERAL NOTES**
1. PROVIDE CONST CONTROL JOINTS @ 7' O.C. MAX.
  2. EDGES SHOULD BE REMOVED WITH 3/8" EDGING TOOL.


**CONCRETE ALLEY GUTTER**

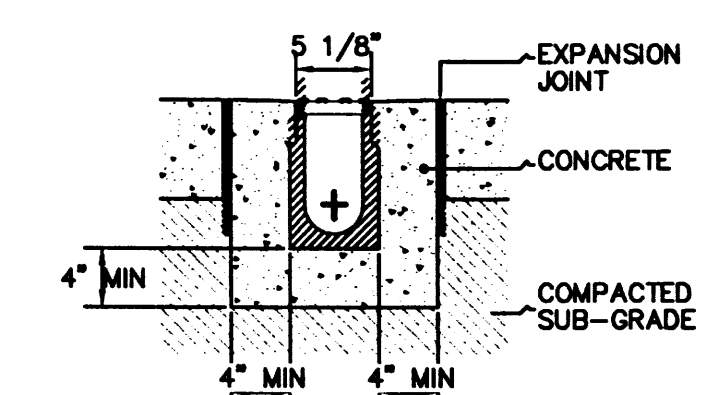

ACO-DRAIN K100S SIDEWALK TRENCH DRAIN (O.A.E.) WITH PEDESTRIAN GRATE. INSTALL PER MANUFACTURER'S SPECIFICATIONS.

**SIDEWALK TRENCH DRAIN**

GENERAL NOTES	LEGEND
A. COORDINATE WORK WITH ARCHITECTURAL PLANS	EXISTING CONTOUR
B. DO NOT SCALE THIS PLAN. IT IS THE CONTRACTOR'S RESPONSIBILITY TO FIELD VERIFY EXISTING CONDITIONS AND THE LOCATIONS OF ALL ITEMS PRIOR TO CONSTRUCTION. REPORT ALL DISCREPANCIES TO THE ARCHITECT AND VERIFY THE ARCHITECT'S INTENT BEFORE PROCEEDING.	PROPOSED CONTOUR
C. WHERE PROPOSED GRADES ARE SHOWN AS '±', TRANSITION TO EXISTING SHALL BE SMOOTH AND LEVEL.	PROPOSED SPOT ELEVATION
D. GRADES SHOWN WITHIN LANDSCAPED AREAS INDICATE TOP OF LANDSCAPE MATERIAL. SUBGRADE TO BE GRADED TO ELEVATION SHOWN MINUS LANDSCAPE MATERIAL THICKNESS.	FLOW ARROW
E. ADJUST RIMS OF EXISTING UTILITY FEATURES AS NECESSARY TO MATCH NEW GRADES. TYPICAL CONTRACTOR TO FIELD VERIFY AND PROTECT ALL EXISTING UTILITIES WITHIN AREA TO BE IMPROVED.	FINISH FLOOR ELEVATION
	SIDEWALK CULVERT
	TOP OF CURB FLOWLINE
	AREA DRAIN
	INVERT ELEVATION
	ROOF DRAIN
	STORM DRAIN LINE

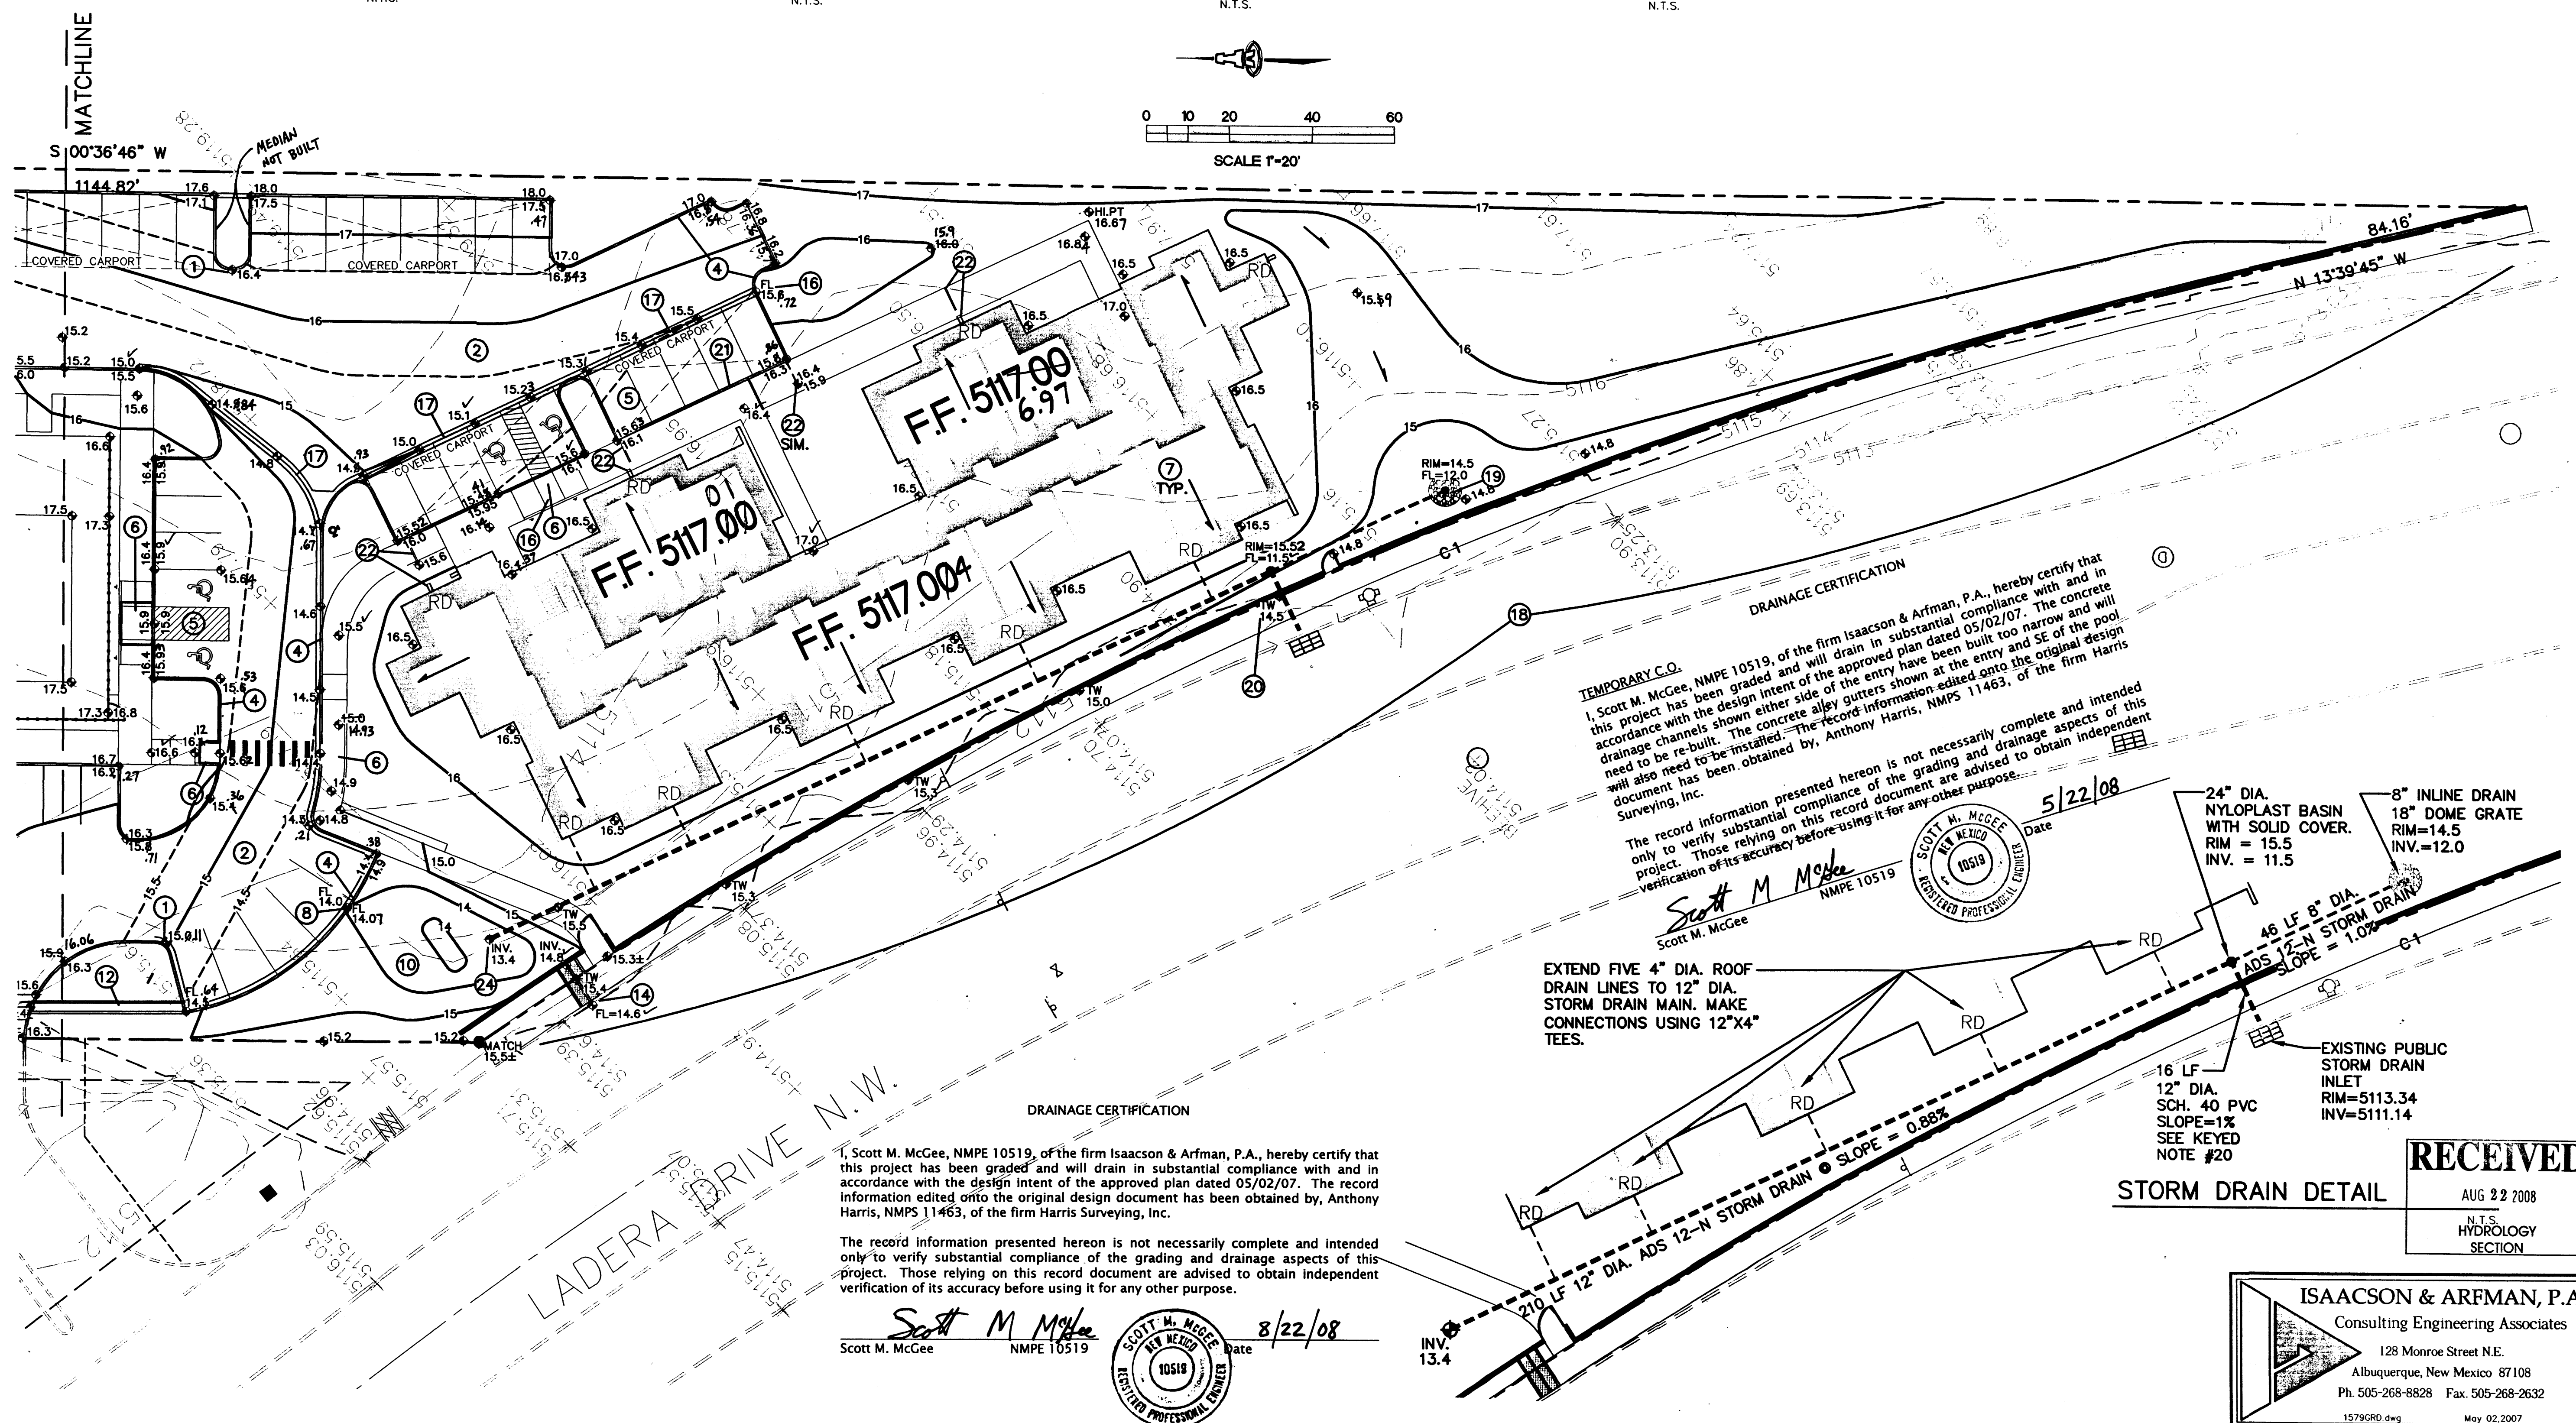

**TEMPORARY C.O.**

I, Scott M. McGee, NMPE 10519, of the firm Isaacson & Arfman, P.A., hereby certify that this project has been graded and will drain in substantial compliance with and in accordance with the design intent of the approved plan dated 05/02/07. The concrete drainage channels shown either side of the entry have been built too narrow and will need to be re-built. The concrete alley gutters shown at the entry and SE of the pool will also need to be installed. The record information edited onto the original design document has been obtained by, Anthony Harris, NMPS 11463, of the firm Harris Surveying, Inc.

The record information presented hereon is not necessarily complete and intended only to verify substantial compliance of the grading and drainage aspects of this project. Those relying on this record document are advised to obtain independent verification of its accuracy before using it for any other purpose.

Scott M. McGee NMPE 10519 Date 5/22/08

I, Scott M. McGee, NMPE 10519, of the firm Isaacson & Arfman, P.A., hereby certify that this project has been graded and will drain in substantial compliance with and in accordance with the design intent of the approved plan dated 05/02/07. The record information edited onto the original design document has been obtained by, Anthony Harris, NMPS 11463, of the firm Harris Surveying, Inc.

The record information presented hereon is not necessarily complete and intended only to verify substantial compliance of the grading and drainage aspects of this project. Those relying on this record document are advised to obtain independent verification of its accuracy before using it for any other purpose.

Scott M. McGee NMPE 10519 Date 8/22/08

ENGINEER

SCOTT M. MCGEE  
NEW MEXICO  
10519  
REGISTERED PROFESSIONAL ENGINEER  
5/2/07

**Ladera Vista Apartments**  
**Harrison Smith Development**  
3608 Ladera Drive  
Albuquerque, NM

REVISIONS

DATE 04/21/07  
REVISION COMMENTS AND FINAL COORDINATION

DRAWN BY MP  
REVIEWED BY  
DATE 02.09.07  
PROJECT NO. 06072  
DRAWING NAME  
GRADING AND DRAINAGE PLAN  
2 of 2

SHEET NO. COO2

**ISAACSON & ARFMAN, P.A.**  
Consulting Engineering Associates  
128 Monroe Street N.E.  
Albuquerque, New Mexico 87108  
Ph. 505-268-8828 Fax. 505-268-2632  
1579GR0.dwg May 02, 2007