



City of Albuquerque

P.O. BOX 1293 ALBUQUERQUE, NEW MEXICO 87103

July 12, 1994

Larry Read
Chavez-Grieves
5639 Jefferson NE
Albuquerque, NM 87109

RE: ENGINEER CERTIFICATION FOR AN ADDITION TO BURGER KING/LADERA PLAZA
(G11-D3D) CERTIFICATION STATEMENT DATED 6/30/94.

Dear Mr. Read:

Based on the information provided on your July 1, 1994 submittal, Engineer Certification for the above referenced site is acceptable.

If I can be of further assistance, please feel free to contact me at 768-2667.

Sincerely,

Bernie J. Montoya, CE
Engineering Associate

BJM/d1/WPHYD/8301

c: Andrew Garcia
File

DRAINAGE INFORMATION

PROJECT TITLE: Burger King/Ladera Plaza ZONE ATLAS/DRNG. FILE #: G-11-7/03A
DRB#: _____ EPC #: _____ WORK ORDER #: _____
LEGAL DESCRIPTION: Drainage basin #4 @ Ladera Shopping Center
CITY ADDRESS: Ladera Shopping Center/ Coors NW
ENGINEERING FIRM: Chavez-Grieves CONTACT: Larry Read
ADDRESS: 5639 Jefferson NE PHONE: 344-4080
OWNER: Burger King Corp. CONTACT: _____
ADDRESS: P.O. Box 520783 Miami, FL PHONE: 305-596-7978
ARCHITECT: _____ CONTACT: _____
ADDRESS: _____ PHONE: _____
SURVEYOR: S & J Enterprises CONTACT: _____
ADDRESS: 3535 Princeton Dr. N.E. PHONE: 884-6234
CONTRACTOR: not known CONTACT: _____
ADDRESS: _____ PHONE: _____

TYPE OF SUBMITTAL:

____ DRAINAGE REPORT
____ DRAINAGE PLAN
____ CONCEPTUAL GRADING & DRAINAGE PLAN
____ GRADING PLAN
____ EROSION CONTROL PLAN
X ENGINEER'S CERTIFICATION
____ OTHER

CHECK TYPE OF APPROVAL SOUGHT:


____ SKETCH PLAT APPROVAL
____ PRELIMINARY PLAT APPROVAL
____ S. DEV. PLAN FOR SUB'D. APPROVAL
____ S. DEV. PLAN FOR BLDG. PRMT. APPROVAL
____ SECTOR PLAN APPROVAL
____ FINAL PLAT APPROVAL
____ FOUNDATION PERMIT APPROVAL
____ BUILDING PERMIT APPROVAL
X CERTIFICATE OF OCCUPANCY APPROVAL
____ GRADING PERMIT APPROVAL
____ PAVING PERMIT APPROVAL
____ S.A.D. DRAINAGE REPORT
____ DRAINAGE REQUIREMENTS
____ OTHER _____ (SPECIFY)

PRE-DESIGN MEETING:

____ YES
X NO
____ COPY PROVIDED

DATE SUBMITTED: July 1, 1994

BY: Larry Read, P.E.

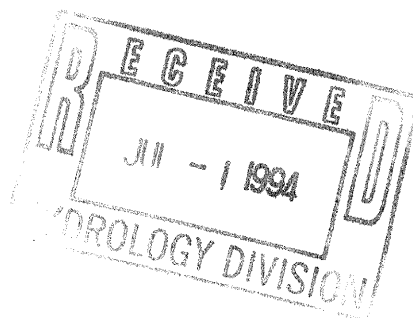

DRAINAGE REPORT
UPDATE OF DRAINAGE BASIN NUMBER 4
BURGER KING PAD SITE
AT LADERA SHOPPING CENTER

Description

The existing Drainage Basin Number 4 at the Ladera Shopping Center is the pad site for Burger King. This development, located at 7101 Coors Boulevard NW, is part of a drainage master plan for the shopping center. The master plan was completed and approved by the City of Albuquerque in 1985. The master plan has also been updated in 1992.

Existing Conditions

The existing basin incorporates approximately 1.08 acres of which all but about 30% is impervious roofs, sidewalks, or paved parking area. The basin (and Burger King pad site) are graded such that no runoff enters from offsite.

The original development incorporated a retention pond along the north and east boundaries of the site. This pond was sized to retain all runoff from the basin from a 100-year, 6-hour storm event. The master plan indicated the required volume to be 6912 cubic feet. The 1985 as-built plans indicate the volume provided in the pond to be about 7200 cubic feet. At some time between 1985 and present, the pond was fitted with 24" diameter beehive storm inlet and storm drain lateral that connects into the storm drain in Coors Boulevard NW. This connection changed the status of the pond from retention to detention.

Proposed Development

The Owner proposed to construct an 1840 square foot, multi-level indoor play land south of the existing building. This addition will connect to the existing building. The surface where the addition is sited to be constructed is currently concrete sidewalk, asphalt paving, or hardscape. The proposed site is located such that the existing drainage pattern is away from the addition on the three exposed sides. The proposed addition will disturb only a few feet of existing sidewalk and asphalt pavement around the perimeter of the new building. This drainage plan update proposes to continue the existing patterns.

Methodology

Since this report is an update of the 1985 master drainage plan, the hydrology methods and coefficients have been used. The peak runoff is estimated using the Rational Method. The volume of runoff generated is estimated using the SCS Method as modified in the City of Albuquerque DPM.

CALCULATIONS:

Area = 1.08 acres
 Precipitation = 2.2 inches (100 year, 6 hour)
 $I = 2.2 \times 2.0 = 4.4 \text{ in./hr. (tc = 12 min)}$

EXISTING ON-SITE CONDITIONS:

LAND TREATMENT	"C" Value	AREA "A" (ACRES)	"C" ² X "A"	"C" ² X "A" / A
Pavement	0.95	0.704	0.6384	0.6384
Roofs	0.90	0.069	0.0823	0.0823
Turf	0.25	0.280	0.0700	0.0700
Gravel	0.40	0.027	0.0108	0.0108
A =	1.08		0.8117	"C"² X "A" = 0.75

$Q_p = 0.75 \text{ cfs} \times 4.4 \times 1.08 = 3.6 \text{ cfs}$
 $Q_p = 3.6 \text{ cfs} \times 0.657 = 2.4 \text{ cfs}$
 Composite CN = 93 (Plate 22.2 C-3)
 Use CN = 74 (Pervious)
 Per Plate 22.2 C-2

Direct Runoff = 1.42"/sf (Plate 22.2 C-4)

$V_{100} = 1.42 \times 1.08 \times 43560 = 5567 \text{ cf}$
 $V_{10} = 5567 \text{ cf} \times 0.657 = 3657 \text{ cf}$

PROPOSED ON-SITE CONDITIONS:


LAND TREATMENT	"C" Value	AREA "A" (ACRES)	"C" ² X "A"	"C" ² X "A" / A
Pavement	0.95	0.672	0.6384	0.6384
Roofs	0.90	0.119	0.1073	0.1073
Turf	0.25	0.239	0.0723	0.0723
A =	1.08		0.8178	"C"² X "A" = 0.76

$Q_p = 0.76 \text{ cfs} \times 4.4 \times 1.08 = 3.6 \text{ cfs}$
 $Q_p = 3.6 \text{ cfs} \times 0.657 = 2.4 \text{ cfs}$
 Composite CN = 94 (Plate 22.2 C-3)
 Use CN = 74 (Pervious)
 Per Plate 22.2 C-2

Direct Runoff = 1.45"/sf (Plate 22.2 C-4)

$V_{100} = 1.45 \times 1.08 \times 43560 = 5685 \text{ cf}$
 $V_{10} = 5685 \text{ cf} \times 0.657 = 3735 \text{ cf}$

HYDROGRAPH

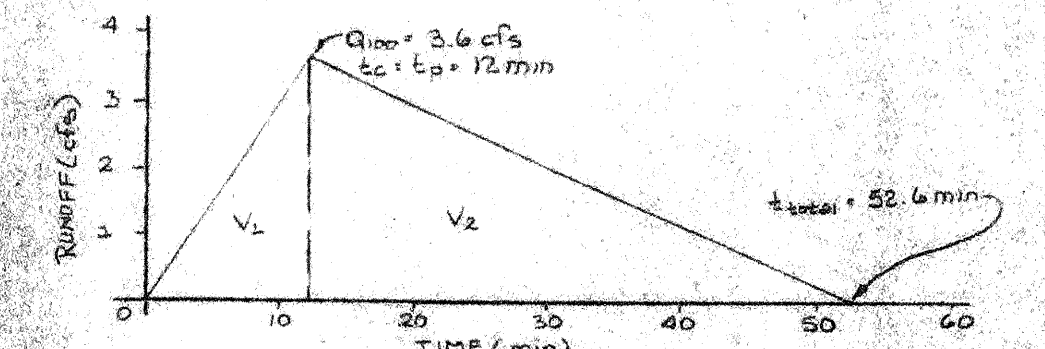


$V_{1/2} = 1/2 \times 12 \times 60 \times 3.6 = 1296 \text{ cf}$

$V_{100} = 1/2 \times 40.6 \times 60 \times 3.6 = 4385 \text{ cf}$

$V_{TOTAL} = 5685 \text{ cf} = V_{100}$ (Proposed)


POND VOLUME PROVIDED = 7144 cf (Per 1985 Master Plan by Chavez-Griesies)
 POND VOLUME REQUIRED = 5685 cf
 EXCESS CAPACITY = 1459 cf

Therefore, no modifications to the existing pond or inlet is required.

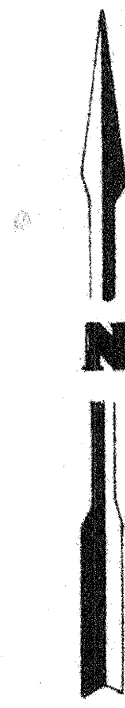


SCALE: 1" = 20'

T.B.M. TOP OF CONC BASE FOR LIGHT POLE EL. 5104.99

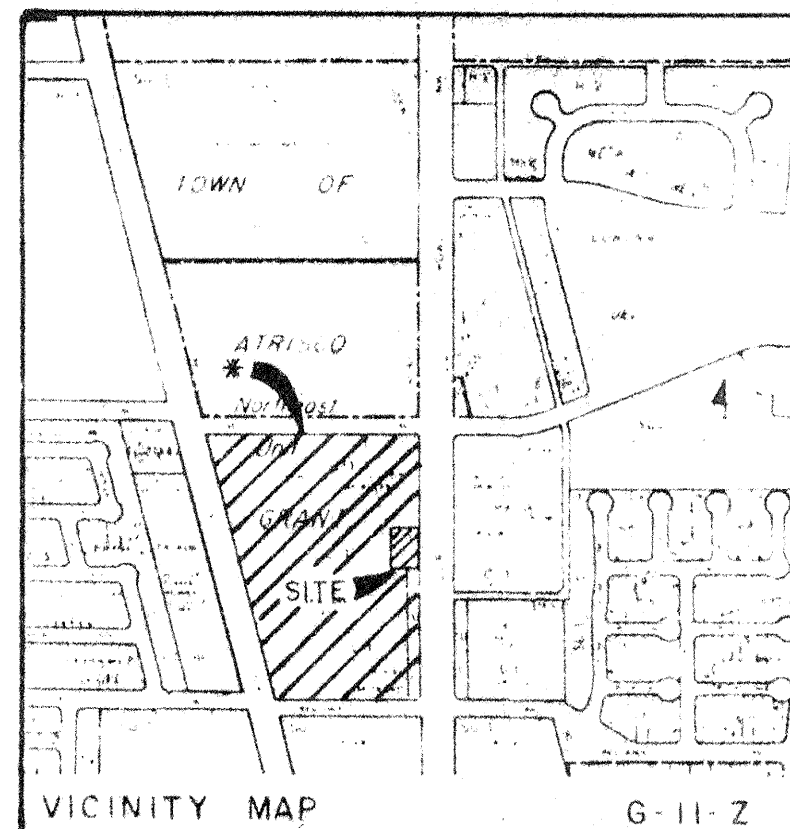

* AREA OF MASTER DRAINAGE PLAN

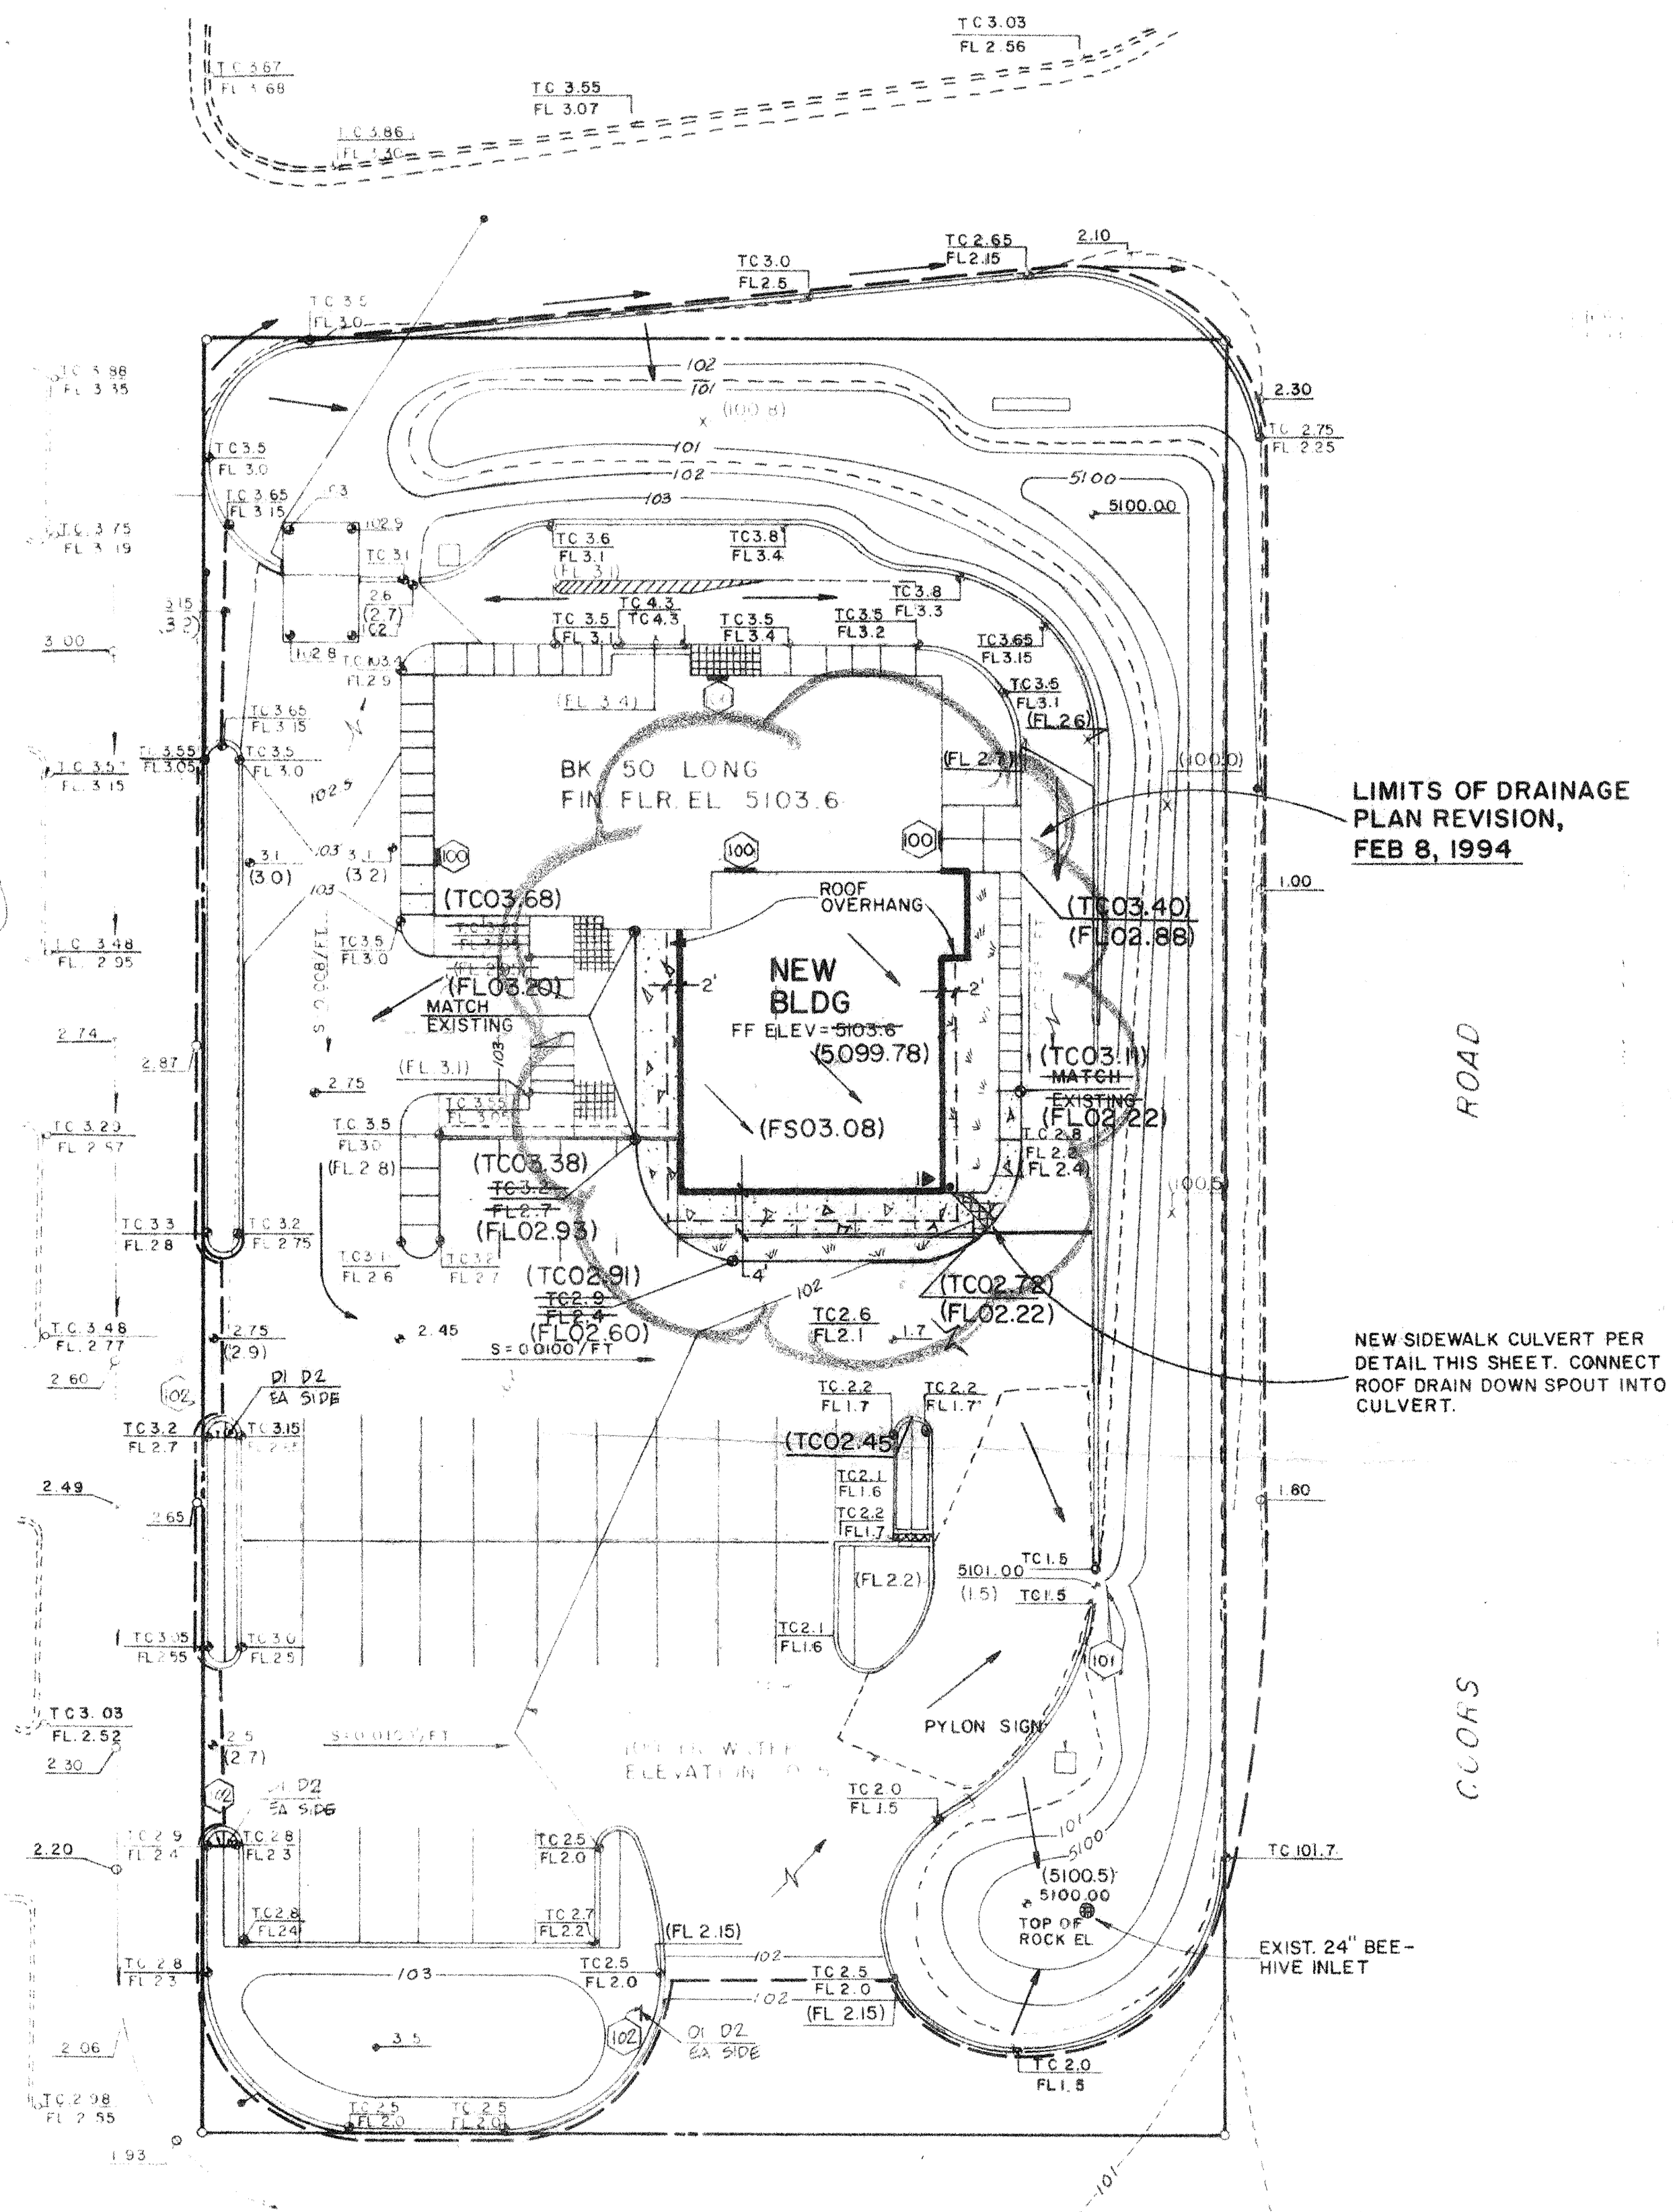

LIMITS OF DRAINAGE PLAN REVISION, FEB 8, 1994

NEW SIDEWALK CULVERT PER DETAIL THIS SHEET. CONNECT ROOF DRAIN DOWN SPOUT INTO CULVERT.

EXIST. 24" BEEHIVE INLET

* AS-BUILT SURVEY PROVIDED BY S&J ENTERPRISES JUNE 21, 1994


**AS BUILT DRAINAGE PLAN
 GRADING AND DRAINAGE PLAN**

I HEREBY CERTIFY THIS DRAINAGE PLAN IS IN SUBSTANTIAL COMPLIANCE WITH THE APPROVED DRAINAGE PLAN.
 SIGNED: *[Signature]*
 DATE: 6/20/94

- 1 6" CONCRETE CURB
- 3 STANDARD CURB NOSING
- 4 9" BARRIER CURB
- 7 TILE PAVER WALK
- 8 BRUSHED CONCRETE WALK
- 9 CONCRETE RAMP EXTERNAL
- 11 HANDICAP PARKING STALL MARKING
- 13 CEDAR TRASH ENCLOSURE (SEE DETAIL)
- 20 PAINTED TRAFFIC ARROW
- 30 ROOF DRAIN FLOVE
- 32 HANDRAIL 5" DIA
- 40 ROOF DRAIN LEADER THROUGH ROOF
- 43 4" WIDE PAINTED STRIPES AT CURB
- 46 4" WIDE PAINTED STRIPES AT DRIVEWAY
- 61 BIKE RACK FOR 4 BIKES
- 64 NEW PAVING TO MATCH EXIST. ELEV.
- 66 EXISTING PAVING TO REMAIN
- 68 EDGE OF EXISTING PAVING
- 69 TRANSFORMER PAD (10' DIA) (SEE DETAIL)
- 75 CONCRETE DRIVE THRU LANE
- 77 LANDSCAPED AREA
- 79 WALK IN BOXES (SEE ARCH)
- 81 GUARD POST AT DRIVE THRU LANE
- 84 4" CONCRETE SIDEWALK
- 86 DOOR OPENING

LEGEND


- 4 SITE NOTE
- BUILDING OR
- NEW CURB
- NEW SIDEWALK
- EXISTING SIDEWALK
- EXISTING DRIVEWAY
- NEW SPOT ELEV.
- EXISTING CONTOUR
- NEW CONTOUR
- AS BUILT ELEVATIONS
- NEW LANDSCAPING
- DRAINAGE BOUNDARY BASIN 4
- (TC02.60) AS-BUILT ELEVATIONS (NEW BLDG)

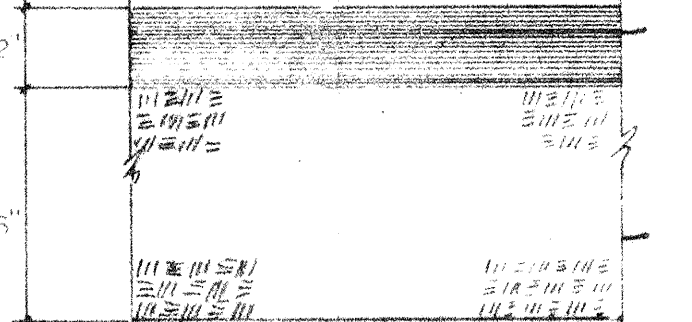


PAVING SECTION

POND VOLUME CALCULATIONS


Volume Required=6142 c.f. (From Approved Drainage Report Prepared By Fred Denny and Associates - Area 4)
 Elev. 101.5 - Area = 8264 s.f. Volume = 3376 c.f.
 Elev. 101.0 - Area = 5240 s.f. Volume = 3768 c.f.
 Elev. 100.0 - Area = 2296 s.f.
 Total Pond Volume Provided = 7144 c.f.

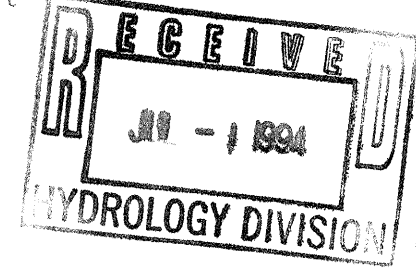

RESTAURANT FOR:

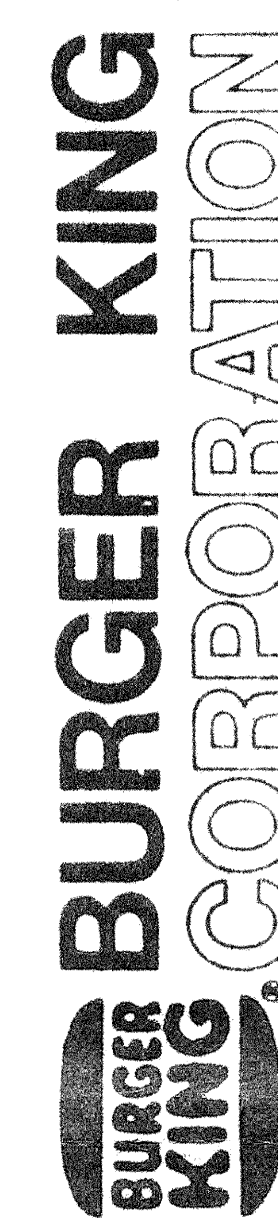

P.O. BOX 520783
 GENERAL MAIL FACILITY
 MIAMI, FL 33152
 PHONE 305 556 7978

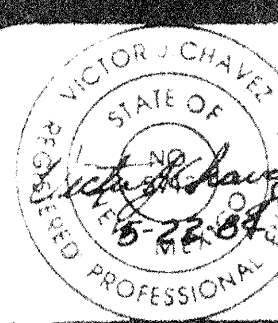

PARKING
 CIVIL ENGINEERING PLANS
 GRADING
 PLAN

C-4