## CITY OF ALBUQUERQUE

Planning Department Alan Varela, Director



Mayor Timothy M. Keller

October 1, 2025

Regina Okoye 8220 SAN PEDRO DR. NE, SUITE 520 Albuquerque, NM 87113

rokoye@modulusarchitects.com

Re: Hope Building Charter School

5310 Sequoia NW

**Traffic Circulation Layout** 

Engineer's Stamp 8/25/25 (G11D051) TRANS-2025-00120

Dear Okoye,

The TCL submittal received 10-1-25 is approved for Building Permit by Transportation. A copy of the stamped and signed plan will be needed for each of the building permit plans. Please keep the original to be used for certification of the site for final C.O. for Transportation.

PO Box 1293

Albuquerque

When the site construction is completed and an inspection for Certificate of Occupancy (C.O.) is requested, use the original City stamped approved TCL for certification. Redline any minor changes and adjustments that were made in the field. A NM registered architect or engineer must stamp, sign, and date the certification TCL along with indicating that the development was built in "substantial compliance" with the TCL. Submit this certification, and the TCL to the <u>ABQ-PLAN</u> for log in and evaluation by Transportation.

NM 87103


Once verification of certification is completed and approved, notification will be made to Building Safety to issue Final C.O. To confirm that a final C.O. has been issued, call Building Safety at 924-3690.

www.cabq.gov

Sincerely,


Sertil A. Kanbar

Sertil Kanbar, PhD,PE,CFM Sr. Engineer, Planning Dept. Development Review Services

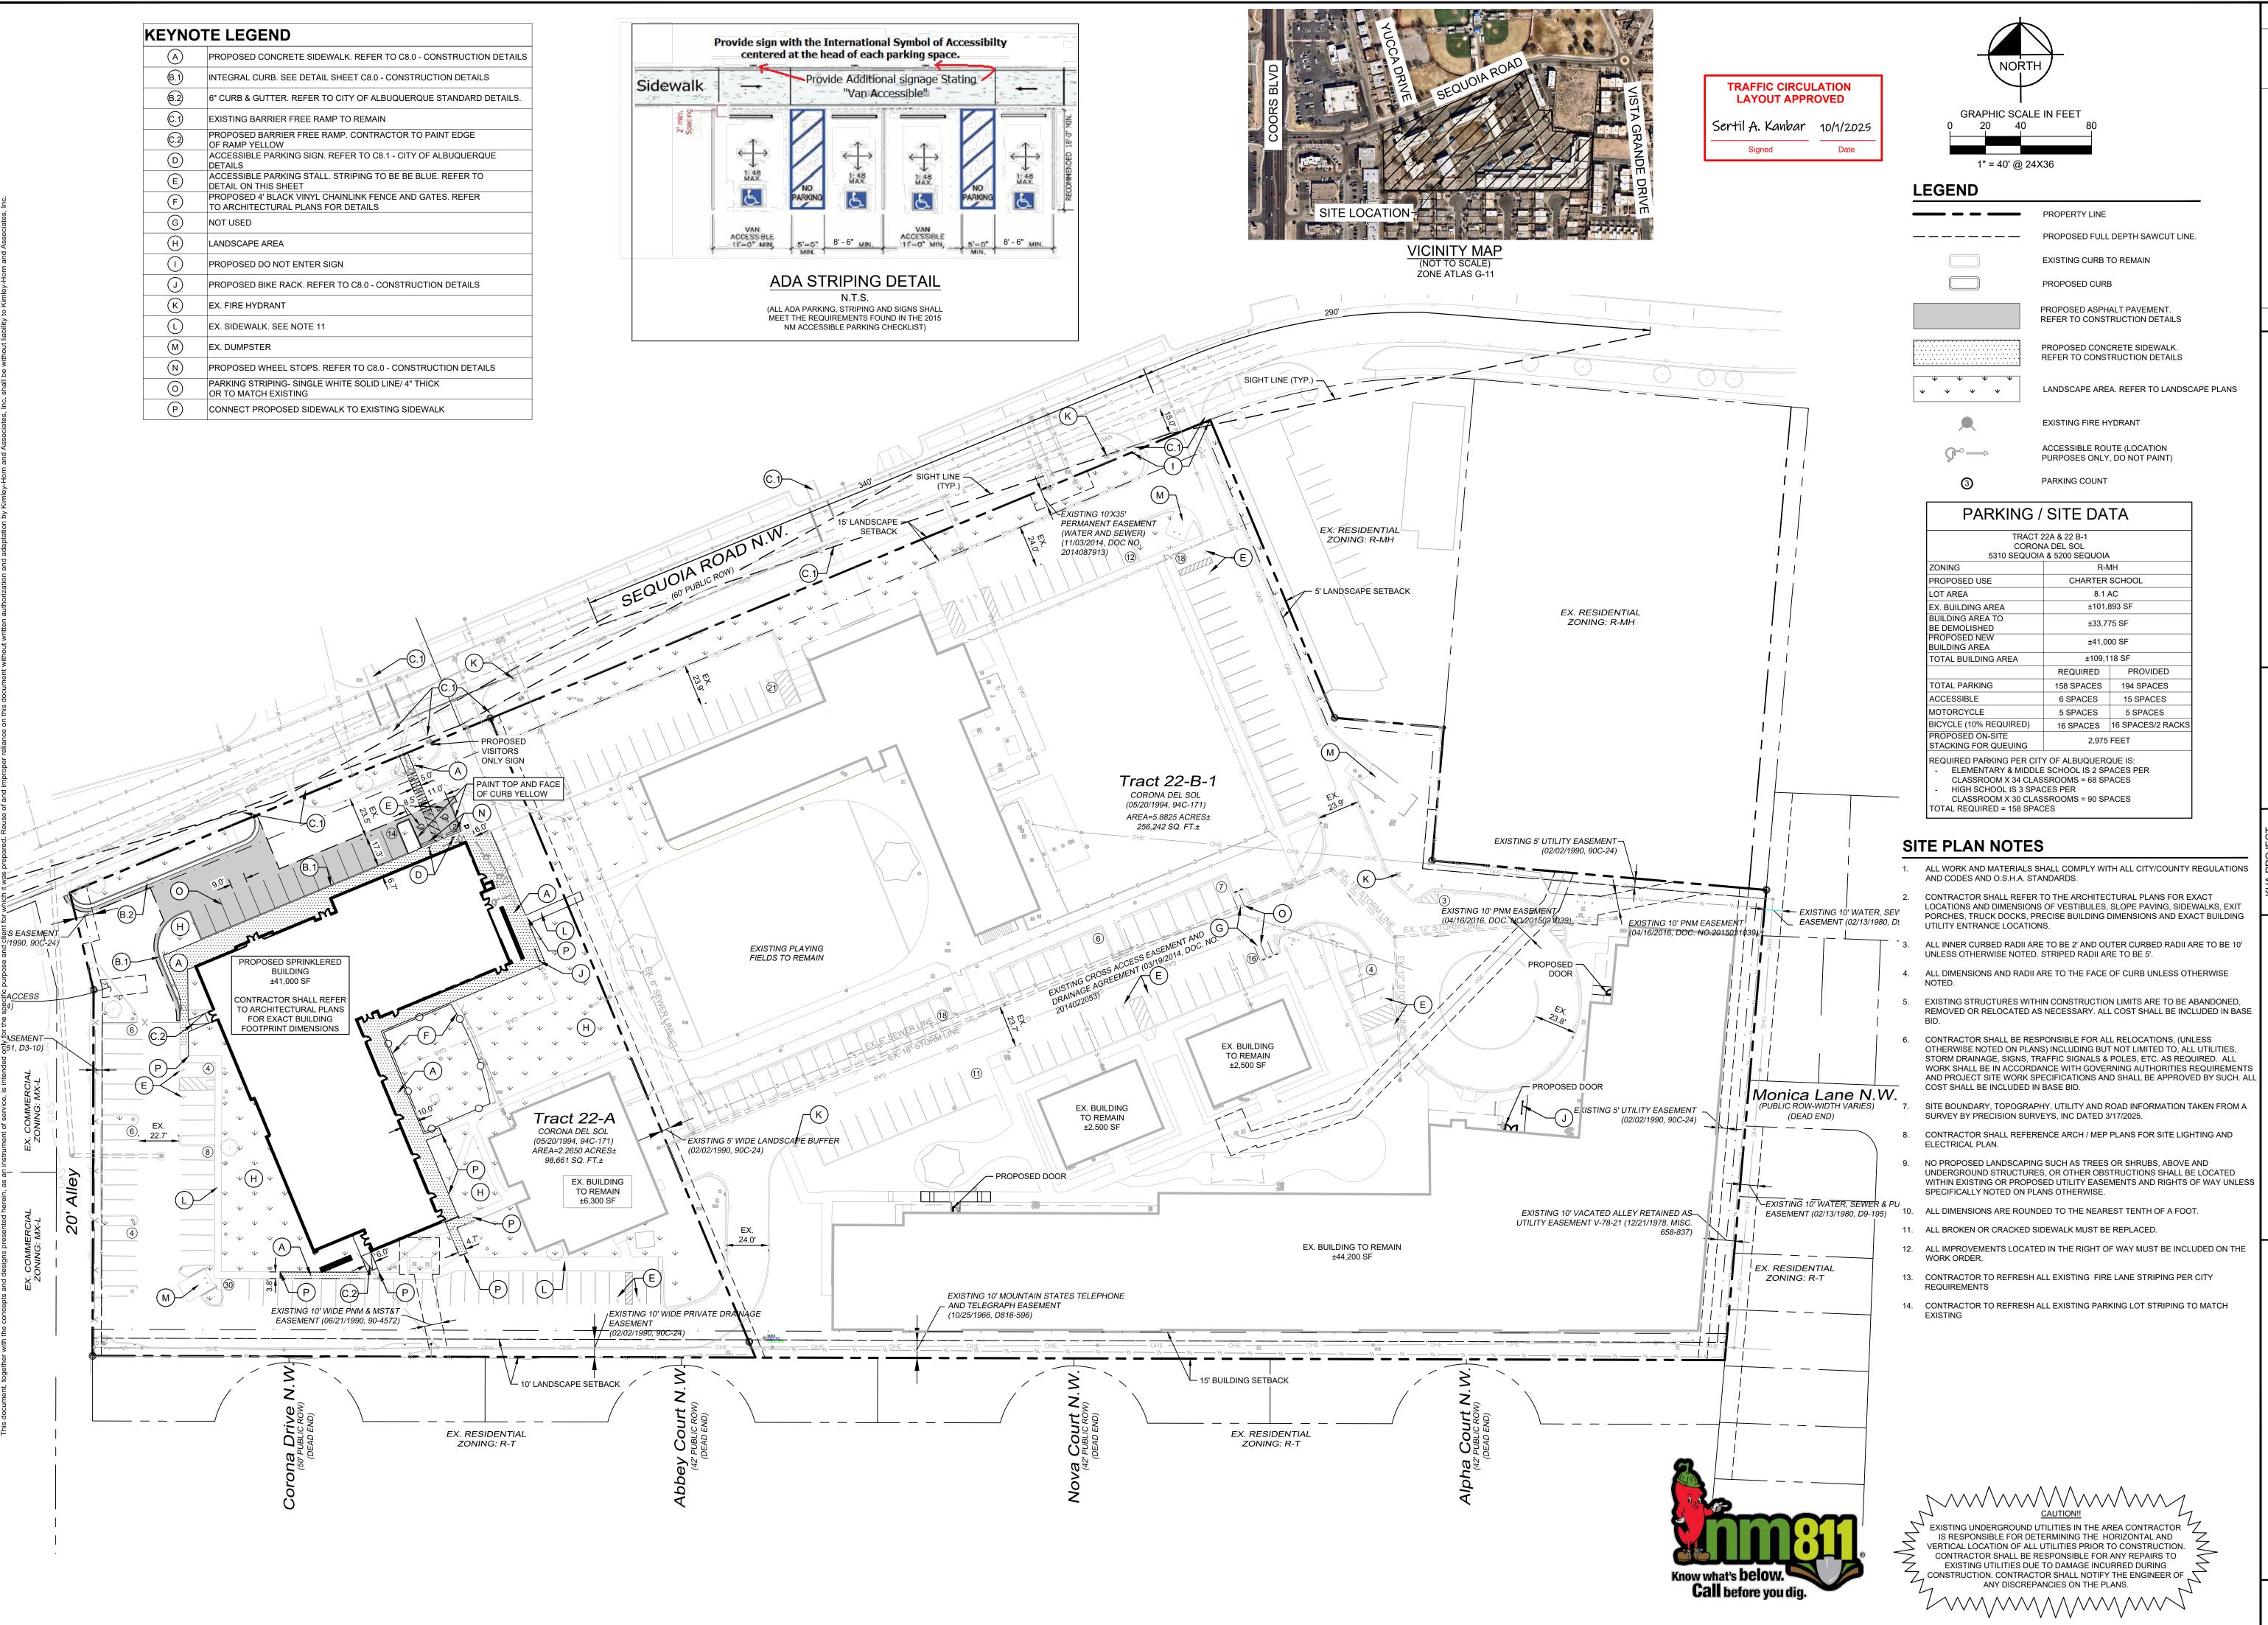


 $\overline{O}$ QΨ 0  $\Box$ 

> SHEET NUMBER C5.0

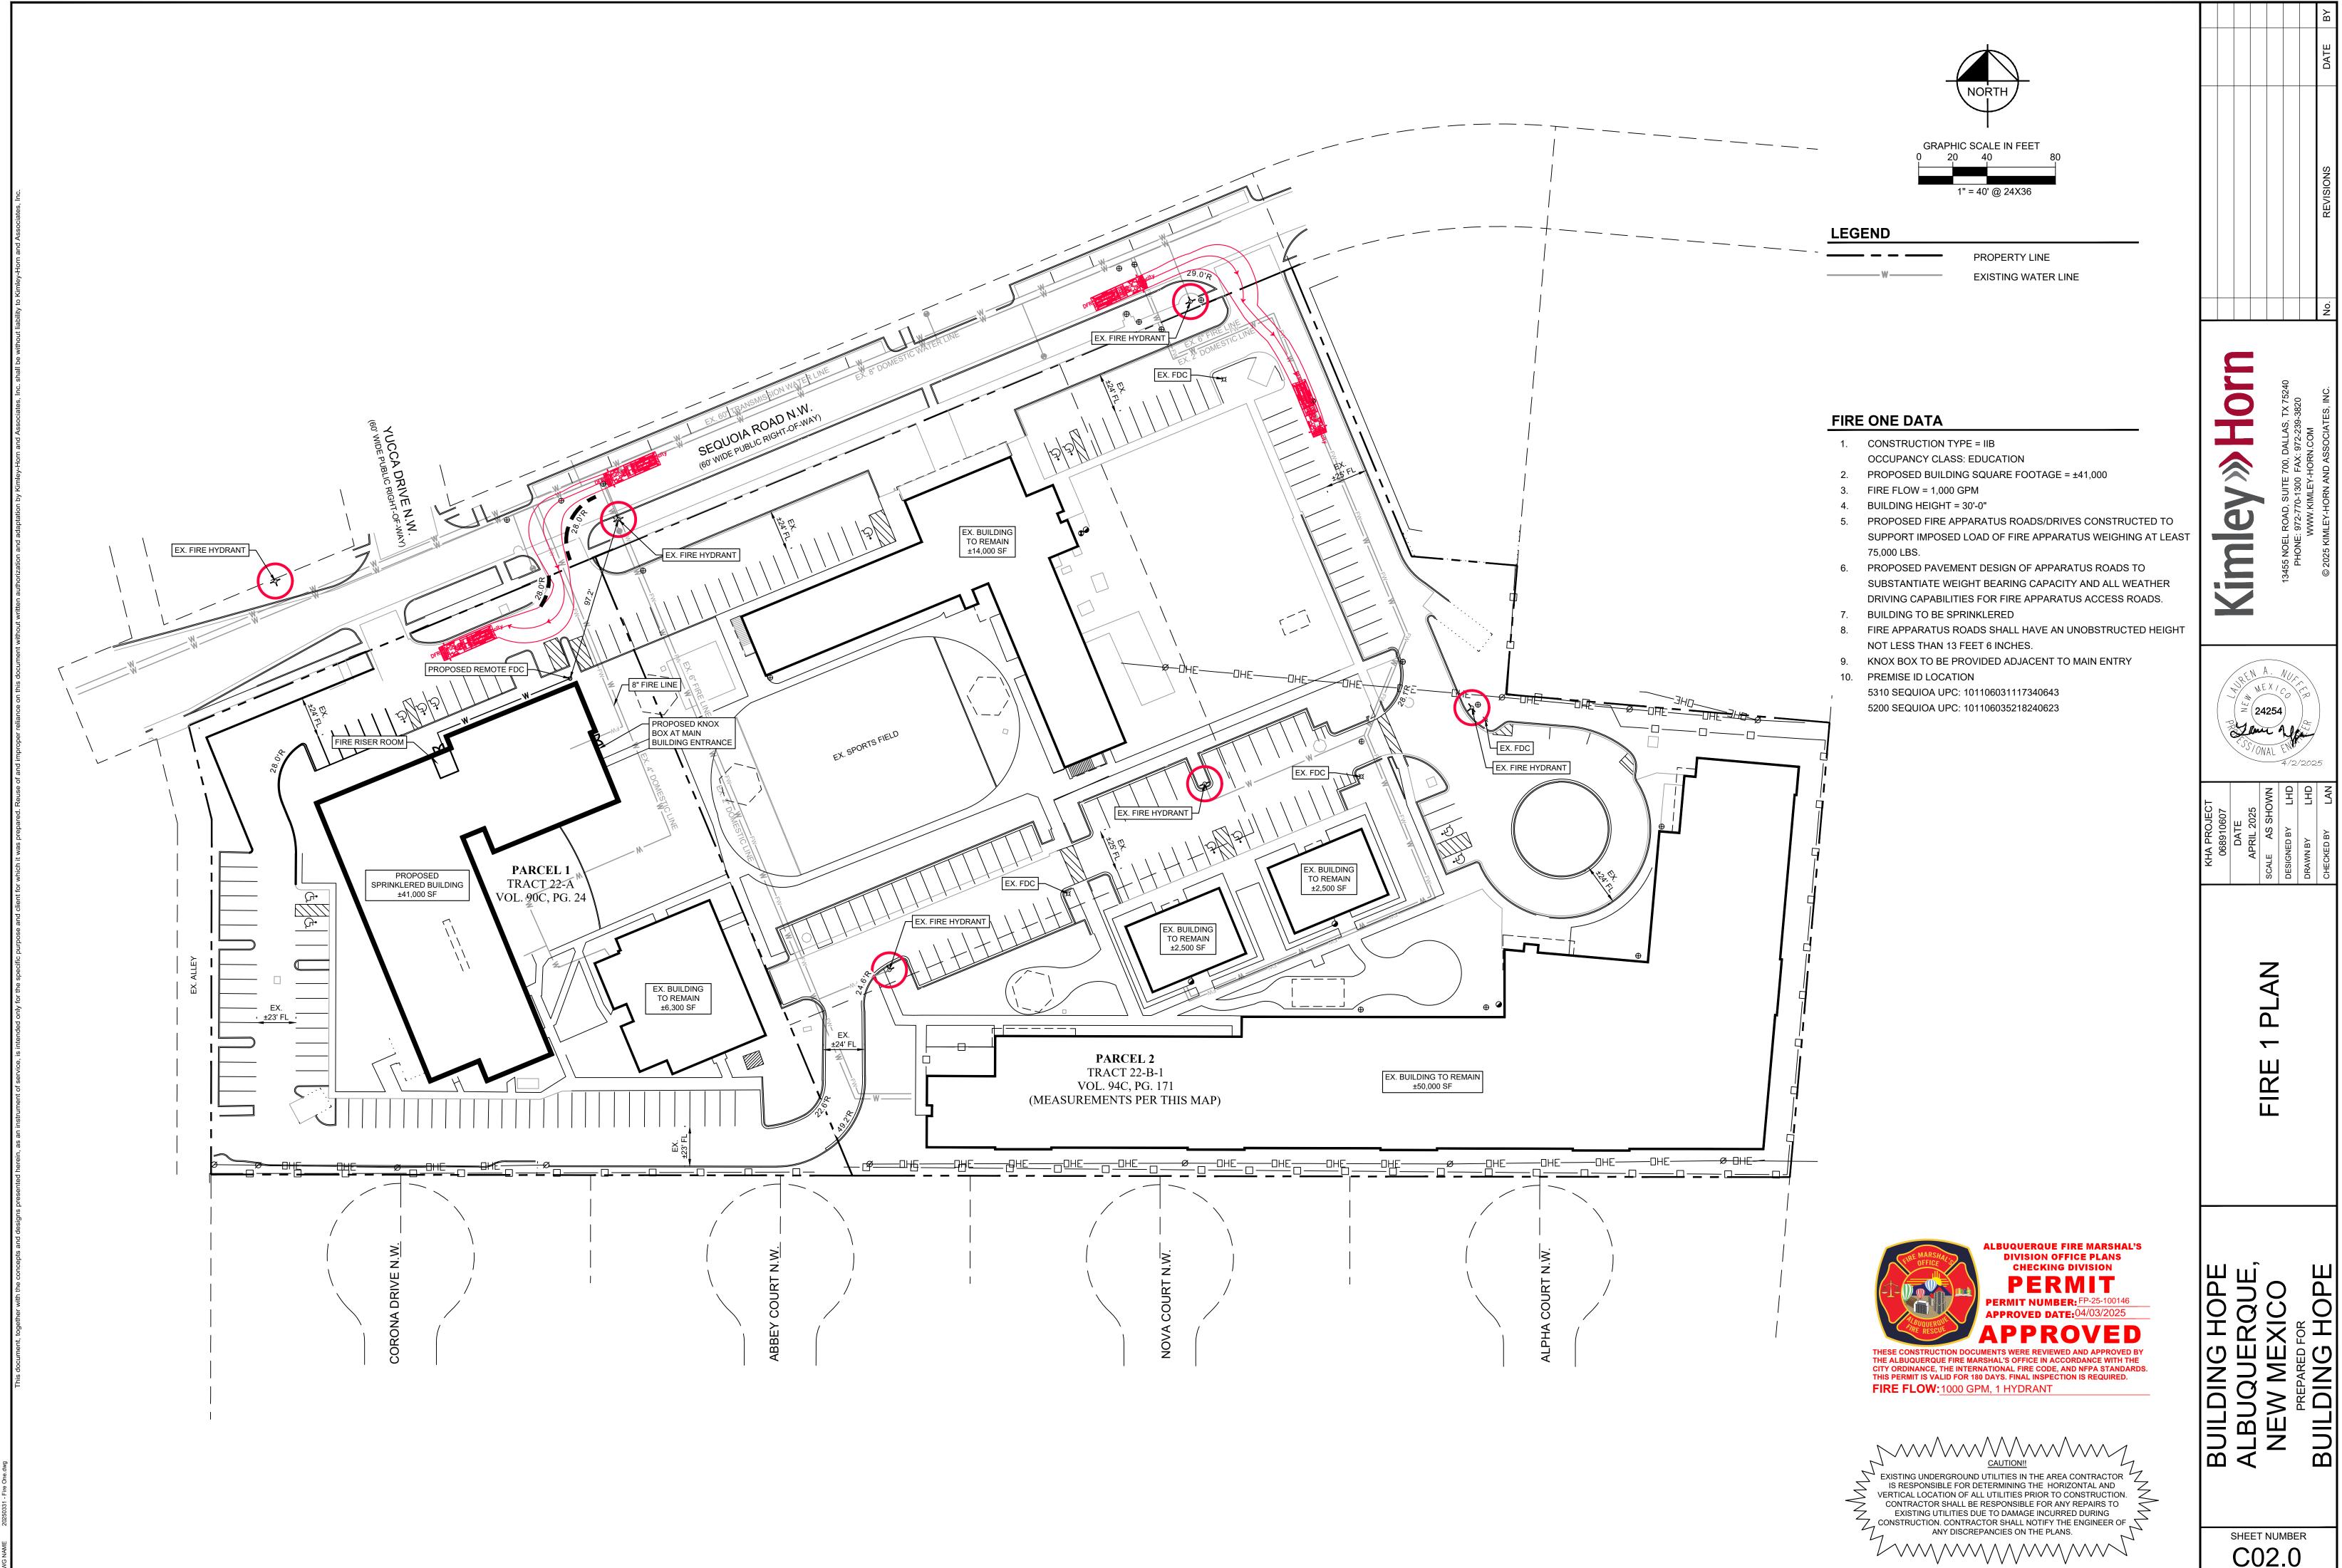

FIRE

SHEET NUMBER C02.0

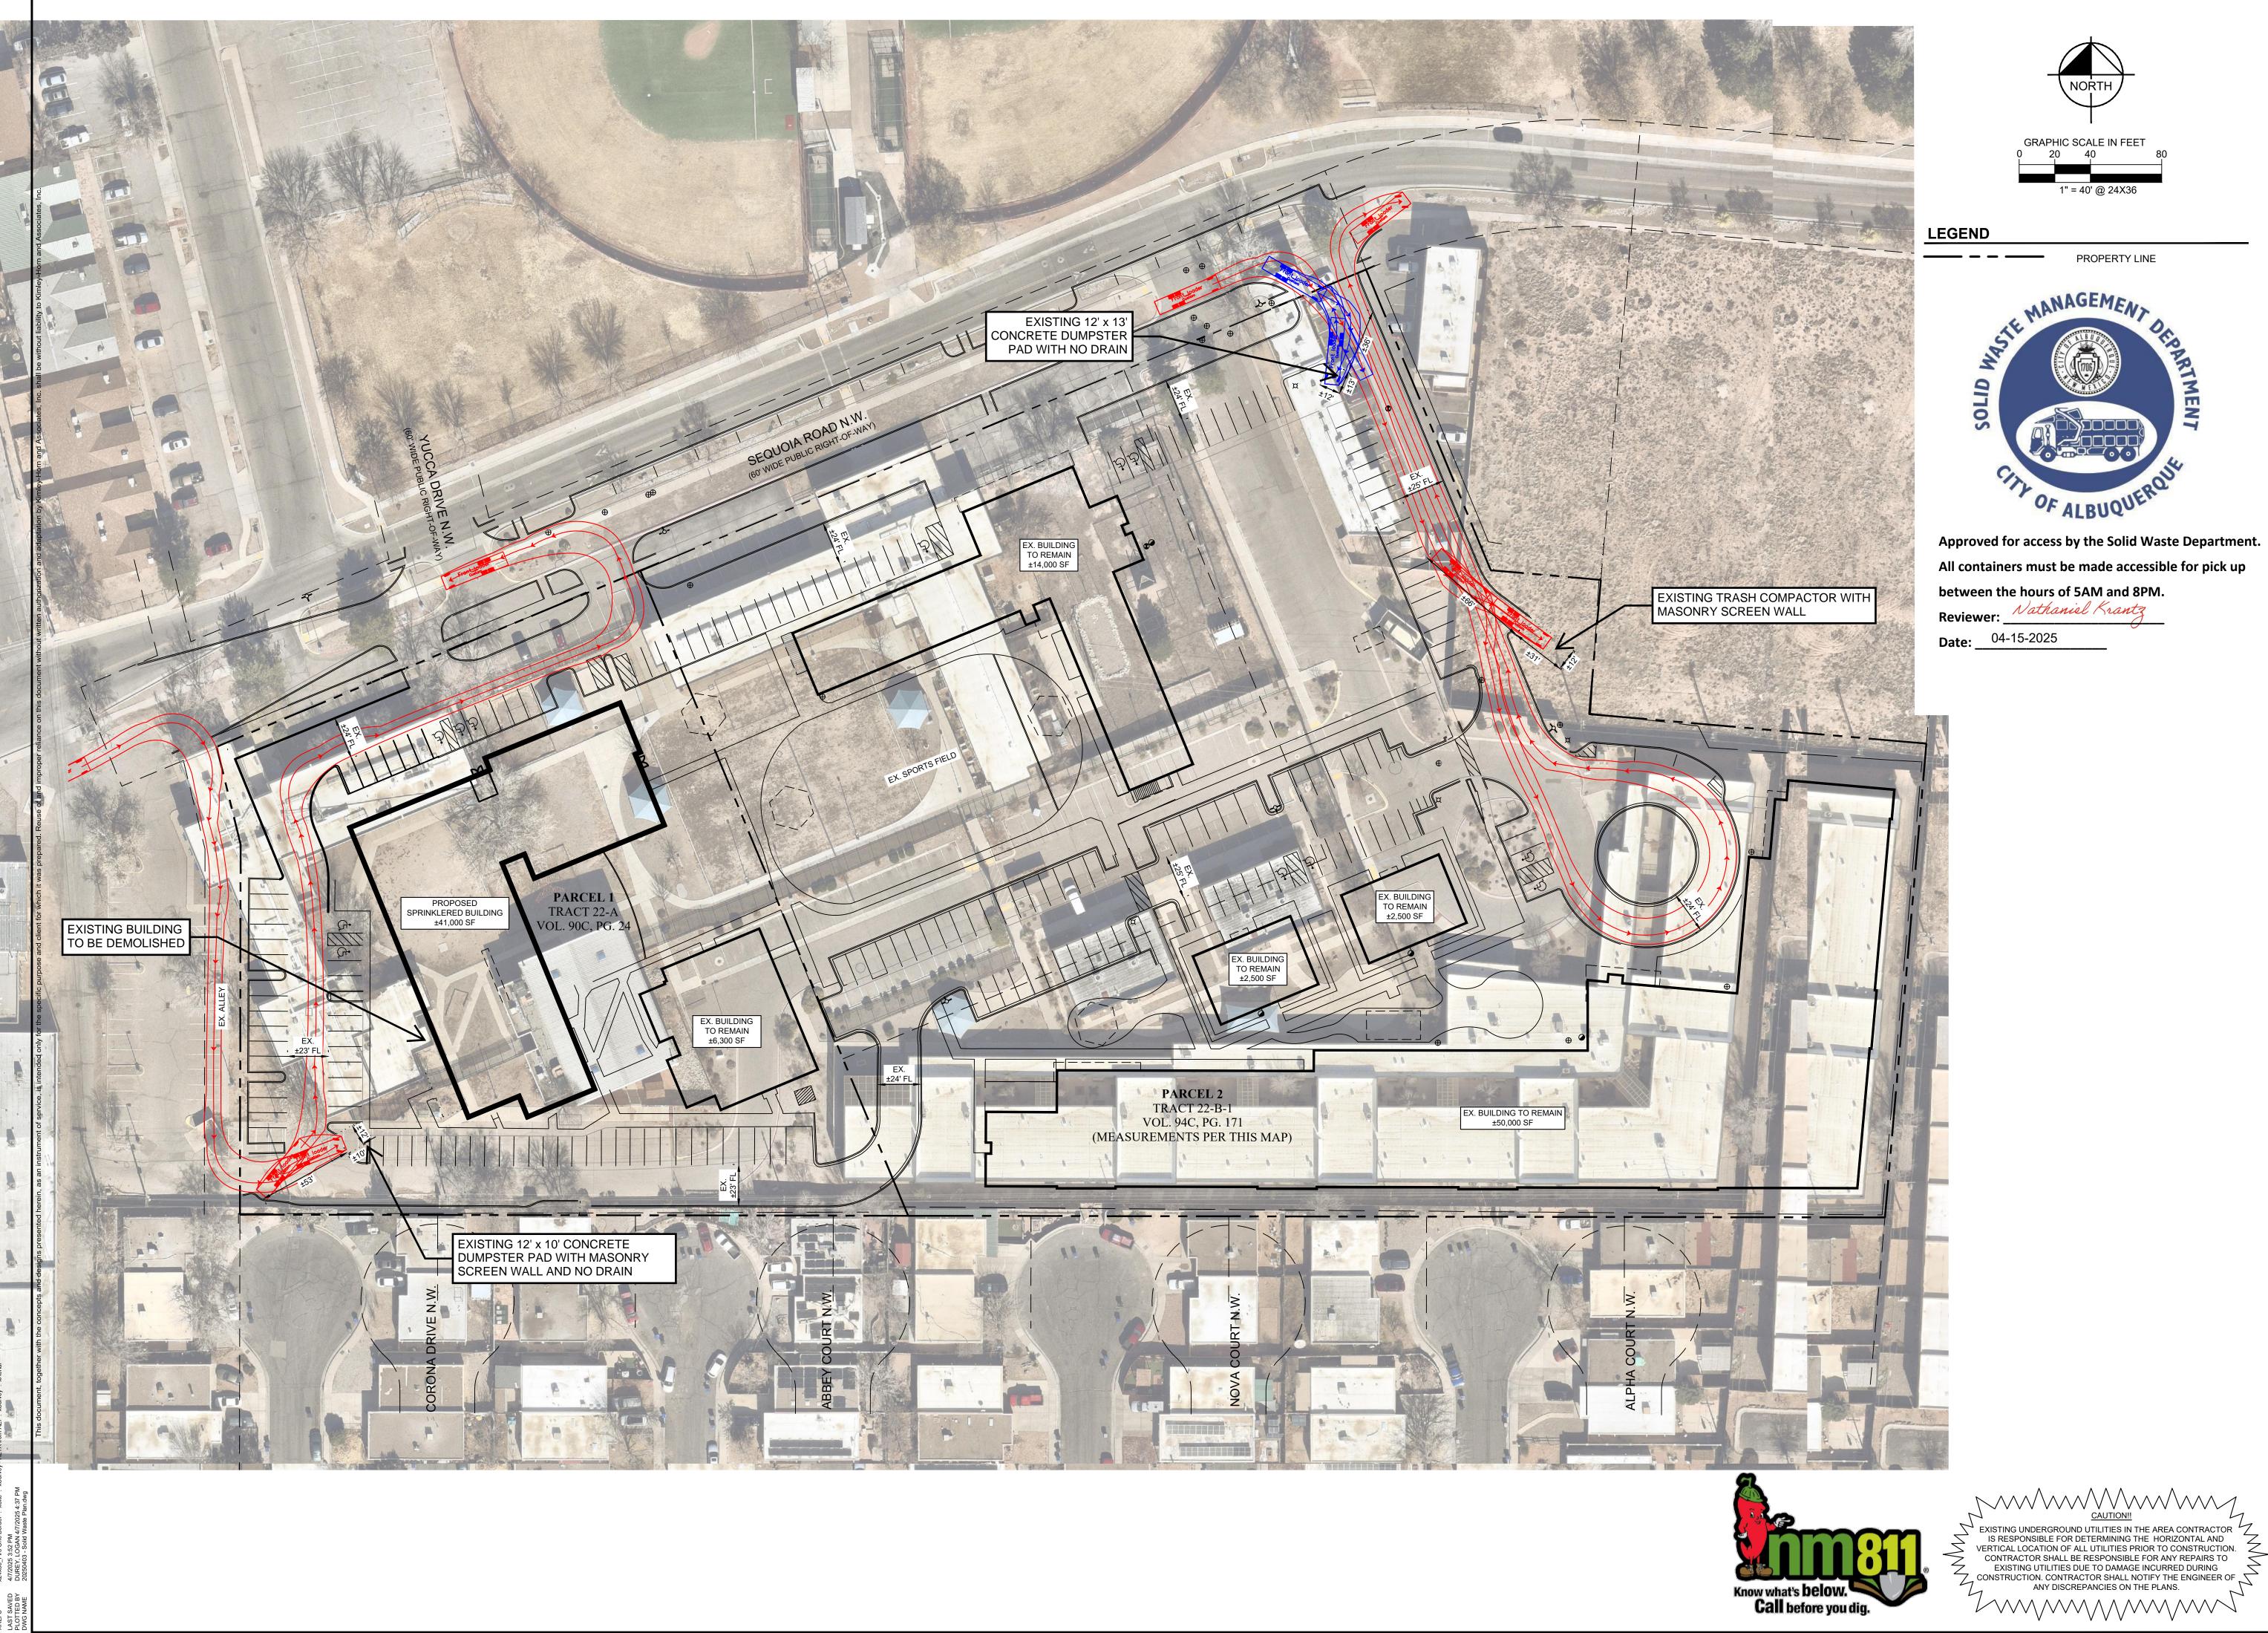



All containers must be made accessible for pick up

ALBUQUERQUE,
NEW MEXICO
PREPARED FOR
BUILDING HOPE

SHEET NUMBER

## CITY OF ALBUQUERQUE

Planning Department Alan Varela – Director



Mayor Timothy M. Keller

September 30, 2025

Keith Christian Kimley Horn 6200 South Syracuse Way Greenwood Village, CO 80111

Re: Building Hope Public Charter School Neighborhood Impact Assessment (G11D051) Engineer's Stamp: September 29, 2025 Trans-2025-00127

Dear Mr. Christian,

The Traffic Impact Study received on September 29, 2025 has been reviewed and is approved by the City of Albuquerque Planning Development Transportation Section.

Required infrastructure improvements per the Study are as follows:

PO Box 1293

1. Coors/St. Josephs, install ITS warning sign for SBL. Modify signal timing and implement LPIs for all ped crossings.

Albuquerque

2. Coors/Tucson, restrict WBL turns. Extend SBL turn lane to provide 55' of additional storage.

NM 87103

- 3. Coors/Sequoia, restripe east leg and extend WBR turn lane as far as possible. Extend SBL turn storage by approximately 500' to meet SAMM. Install ITS queue warning sign for SBL turn. Modify signal timing and implement LPIs for all ped crossings.
- 4. Coors/Redlands, extend SBL turn lane to add approximately 300' more of storage.

www.cabq.gov

- 5. Install school zone signage along Sequoia 200' in advance of either approach to the school per MUTCD standards.
- 6. Install high-visibility crosswalk markings and an RRFB at existing designated crosswalk at Sequoia/Yucca/Drive A.
- 7. Remove existing crosswalk along schools Sequoia frontage between Drives B and C.

The approved Traffic Study is valid for three years. Should significant modifications to the approved development proposal occur, the approved study shall be revised to incorporate the changes.

## CITY OF ALBUQUERQUE

Planning Department Alan Varela – Director



Mayor Timothy M. Keller

If you have any questions, please contact me	at <u>earmijo@cabq.gov</u> or (505) 924-3991
Sincerely,	

Ernest Armijo, P.E.

Principal Engineer, Planning Dept.

Development Review Services

PO Box 1293

Albuquerque

NM 87103

www.cabq.gov