

CITY OF ALBUQUERQUE



June 26, 2016

Mike Balaskovits, PE
Bohannon-Huston
7500 Jefferson St NE Courtyard I
Albuquerque, NM 87109

**Re: Desert Hills Modernization
5310 Sequoia Rd NW
Request Permanent C.O. - Accepted
Engineer's Stamp dated: 6-20-14 (G11D051)
Certification dated: 7-25-16**

Dear Mr. Balaskovits,

Based on the Certification received 7/26/2016, the site is acceptable for release of Certificate of Occupancy by Hydrology.

PO Box 1293

If you have any questions, you can contact me at 924-3695 or Totten Elliott at 924-3982.

Albuquerque

Sincerely,

New Mexico 87103

Rita Harmon, P.E.
Senior Engineer,
Planning Department

www.cabq.gov

TE/RH

C: email Cordova, Camille C.; Miranda, Rachel; Sandoval, Darlene M.; Blocker,
Lois



City of Albuquerque

Planning Department

Development & Building Services Division

DRAINAGE AND TRANSPORTATION INFORMATION SHEET

(REV 02/2013)

Project Title: _____ Building Permit #: _____ City Drainage #: _____

DRB#: _____ EPC#: _____ Work Order#: _____

Legal Description: _____

City Address: _____

Engineering Firm: _____ Contact: _____

Address: _____

Phone#: _____ Fax#: _____ E-mail: _____

Owner: _____ Contact: _____

Address: _____

Phone#: _____ Fax#: _____ E-mail: _____

Architect: _____ Contact: _____

Address: _____

Phone#: _____ Fax#: _____ E-mail: _____

Surveyor: _____ Contact: _____

Address: _____

Phone#: _____ Fax#: _____ E-mail: _____

Contractor: _____ Contact: _____

Address: _____

Phone#: _____ Fax#: _____ E-mail: _____

TYPE OF SUBMITTAL:

- _____ DRAINAGE REPORT
- _____ DRAINAGE PLAN 1st SUBMITTAL
- _____ DRAINAGE PLAN RESUBMITTAL
- _____ CONCEPTUAL G & D PLAN
- _____ GRADING PLAN
- _____ EROSION & SEDIMENT CONTROL PLAN (ESC)
- _____ ENGINEER'S CERT (HYDROLOGY)
- _____ CLOMR/LOMR
- _____ TRAFFIC CIRCULATION LAYOUT (TCL)
- _____ ENGINEER'S CERT (TCL)
- _____ ENGINEER'S CERT (DRB SITE PLAN)
- _____ ENGINEER'S CERT (ESC)
- _____ SO-19
- _____ OTHER (SPECIFY)

CHECK TYPE OF APPROVAL/ACCEPTANCE SOUGHT:


- _____ SIA/FINANCIAL GUARANTEE RELEASE
- _____ PRELIMINARY PLAT APPROVAL
- _____ S. DEV. PLAN FOR SUB'D APPROVAL
- _____ S. DEV. FOR BLDG. PERMIT APPROVAL
- _____ SECTOR PLAN APPROVAL
- _____ FINAL PLAT APPROVAL
- _____ CERTIFICATE OF OCCUPANCY (PERM)
- _____ CERTIFICATE OF OCCUPANCY (TCL TEMP)
- _____ FOUNDATION PERMIT APPROVAL
- _____ BUILDING PERMIT APPROVAL
- _____ GRADING PERMIT APPROVAL
- _____ PAVING PERMIT APPROVAL
- _____ WORK ORDER APPROVAL
- _____ GRADING CERTIFICATION
- _____ SO-19 APPROVAL
- _____ ESC PERMIT APPROVAL
- _____ ESC CERT. ACCEPTANCE
- _____ OTHER (SPECIFY)

WAS A PRE-DESIGN CONFERENCE ATTENDED: _____ Yes _____ No _____ Copy Provided

DATE SUBMITTED: _____ By: _____


Requests for approvals of Site Development Plans and/or Subdivision Plats shall be accompanied by a drainage submittal. The particular nature, location, and scope to the proposed development defines the degree of drainage detail. One or more of the following levels of submittal may be required based on the following:

1. **Conceptual Grading and Drainage Plan:** Required for approval of Site Development Plans greater than five (5) acres and Sector Plans
2. **Drainage Plans:** Required for building permits, grading permits, paving permits and site plans less than five (5) acres
3. **Drainage Report:** Required for subdivision containing more than ten (10) lots or constituting five (5) acres or more
4. **Erosion and Sediment Control Plan:** Required for any new development and redevelopment site with 1-acre or more of land disturbing area, including project less than 1-acre than are part of a larger common plan of development

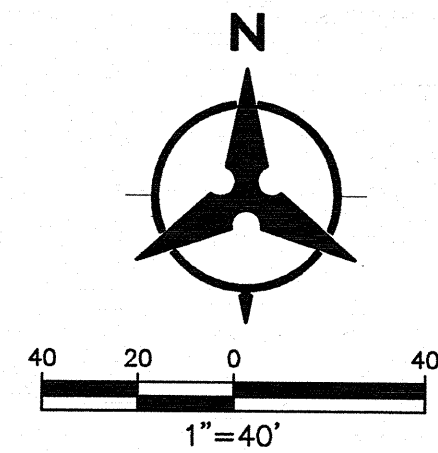


BENCHMARK

1. ALBUQUERQUE SURVEY CONTROL
MONUMENT "8-GH1"
NEW MEXICO STATE PLANE COORDINATES,
CENTRAL ZONE (NAD 83) AS PUBLISHED:
N=1,502,237.438 E=1,505,431.683
DELTA ALPHA= -0° 15' 35.17"
GROUND TO GRID FACTOR= 0.999680082
ELEVATION= 5115.94 (NAVD 88)
2. ONSITE SET CONTROL STATION DATA
MONUMENT "BH 14-253-03" (2" ALUMINUM CAP)
NEW MEXICO STATE PLANE COORDINATES,
CENTRAL ZONE (NAD 83)
N=1,499,525.699 E=1,505,228.451
GROUND TO GRID FACTOR= 0.999680542386
ELEVATION= 5107.243 (NAVD88)

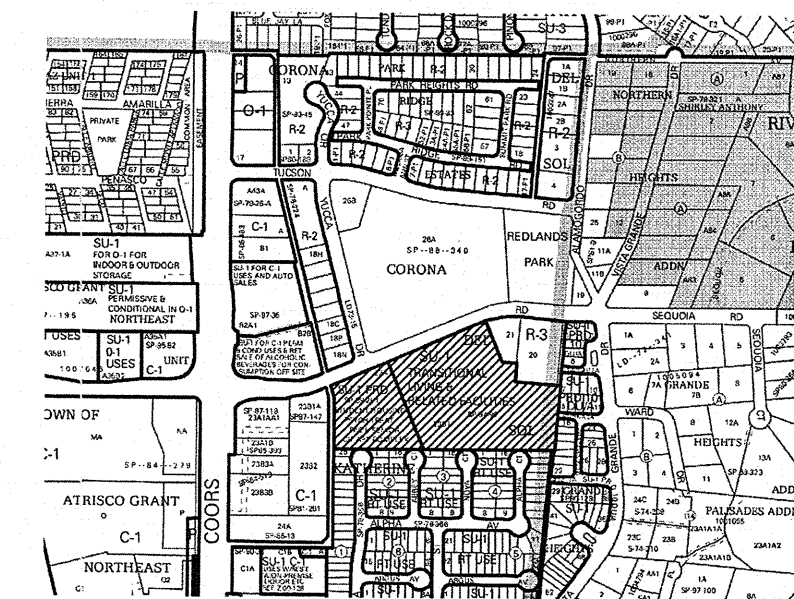

VICINITY MAP
ZONE ATLAS G-11

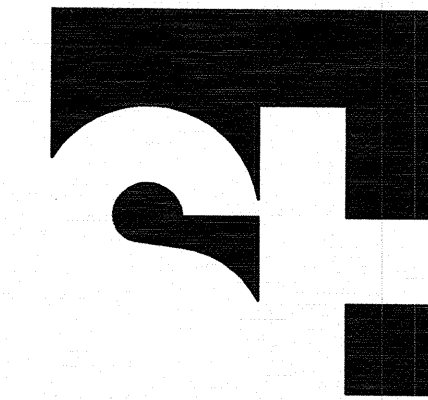

STENGEL-HILL
ARCHITECTURE

613 WEST MAIN STREET
LOUISVILLE, KENTUCKY 40202
502.893.1875
502.893.1876 fax

GRADING KEYED NOTES

1. CONNECT NEW 24" STORM DRAIN CONSTRUCTED UNDER COA PROJECT NUMBER 690283 TO NEW MANHOLE.
2. INSTALL STORM DRAIN MANHOLE PER COA STD DWG 2102
3. INSTALL HDPE (N12 WT. OR APPROVED EQUAL) STORM DRAIN PIPE, SIZE PER PLANS.
4. INSTALL TYPE 'D' STORM DRAIN INLET, PER COA STD DWG 2206; (OR APPROVED NYLOPLAST INLET EQUAL) W/PEDESTRIAN RATED GRATE.
5. INSTALL 24" STORM INLET STRUCTURE (NYLOPLAST OR APPROVED EQUAL) W/ DOMED GRATE.
6. INSTALL 30" STORM INLET STRUCTURE (NYLOPLAST OR APPROVED EQUAL) WITH PEDESTRIAN RATED GRATE
7. PROTECT IN PLACE.
8. INSTALL PRE-FABRICATED STORM DRAIN FITTING, SEE PLANS FOR SIZE.
9. ENSURE SWALE IS GRADED AND COMPLETE PRIOR TO INSTALLATION OF LANDSCAPING. CONTRACTOR SHALL ENSURE NO DRAINAGE ENTERS THE ADJACENT PROPERTY OWNERS TO THE SOUTH AND EAST. GRADES SHOWN ARE TOP OF FINISHED GRADE.
10. INSTALL 24" SIDEWALK CULVERT PER COA STD DWG 2236.
11. INSTALL 24" CURB OPENING PER DETAIL 1, SHEET C4.3
12. INSTALL RIP RAP BLANKET PER DETAIL 2, SHEET C4.3.
13. INSTALL ROOF DRAIN TO WITHIN 5' OF THE BUILDING. SEE PLAN FOR SIZE; SEE PLUMBING PLANS FOR CONTINUATION.
14. MATCH EXISTING HORIZONTALLY & VERTICALLY.
15. INSTALL 4" WIDE CONCRETE VALLEY GUTTER PER DETAIL 3, SHEET C4.3.
16. GRADE AREA TO DRAIN TO NEW INLET. EXISTING COBBLE SHALL BE SALVAGED AND REUSED.
17. SEE TYPICAL COURTYARD GRADING DETAIL 4, SHEET C4.3
18. INSTALL TYPE 'D' H20 LOADING STORM DRAIN INLET, PER COA STD DWG 2206, OR APPROVED EQUAL.

* - NOT ALL KEYNOTES ARE USED ON THIS SHEET

LEGEND

---	PROPERTY LINE
5301	EXISTING CONTOURS
65.23	PROPOSED SPOT ELEVATION TC=TOP OF CURB, FL=FLOW LINE TW=TOP OF WALL, BW=BOTTOM OF WALL EX=EXISTING, TG=TOP OF GRADE
S=2.0%	PROPOSED DIRECTION OF FLOW
~~~~~	WATER BLOCK
---	PROPOSED INDEX CONTOURS
---	PROPOSED INTER CONTOURS
---	PROPOSED CURB & GUTTER
---	EASEMENT
+	PROPOSED LIGHTING
SD	PROPOSED STORM DRAIN LINE
XX XX	AS-BUILT ELEVATION

#### DRAINAGE CERTIFICATION

I, MICHAEL J. BALASKOVITS, NMPE 18187, OF THE FIRM BOHANNAN HUSTON INC., HEREBY CERTIFY THAT THIS PROJECT HAS BEEN GRADED AND WILL DRAIN IN SUBSTANTIAL COMPLIANCE WITH AND IN ACCORDANCE WITH THE DESIGN INTENT OF THE APPROVED PLAN DATED 6-20-14. THE RECORD INFORMATION EDITED ONTO THE ORIGINAL DESIGN DOCUMENT HAS BEEN OBTAINED BY THOMAS D. JOHNSTON, NMPS 14268, OF THE FIRM WAYJOHN SURVEYING. I FURTHER CERTIFY THAT ADDITIONAL MEASURES HAVE BEEN COMPLETED BY THE CONTRACTOR TO CORRECT DEFICIENCIES NOTED BY CITY OF ALBUQUERQUE STAFF DURING THEIR ORIGINAL SITE VISIT. IT WAS DETERMINED BY VISUAL INSPECTION THAT THESE DEFICIENCIES HAVE BEEN ADDRESSED. THIS CERTIFICATION IS SUBMITTED IN SUPPORT OF REINSTATING THE PERMANENT CERTIFICATE OF OCCUPANCE FOR THE RTC BUILDING WHICH WAS RESCINDED JUNE 17, 2016.

THE RECORD INFORMATION PRESENTED HEREON IS NOT NECESSARILY COMPLETE AND INTENDED ONLY TO VERIFY SUBSTANTIAL COMPLIANCE OF THE GRADING AND DRAINAGE ASPECTS OF THIS PROJECT. THOSE RELYING ON THIS RECORD DOCUMENT ARE ADVISED TO OBTAIN INDEPENDENT VERIFICATION OF ITS ACCURACY BEFORE USING IT FOR ANY OTHER PURPOSE.

MICHAEL J. BALASKOVITS, NMPE 18187

7-25-16  
DATE 7-25-2016



#### GENERAL NOTES

1. ALL WORK DETAILED ON THESE PLANS AND PERFORMED UNDER THIS CONTRACT SHALL BE CONSTRUCTED IN ACCORDANCE WITH THE PROJECT SPECIFICATIONS AND THE PROJECT GEOTECHNICAL REPORT, WHERE APPLICABLE, CITY OF ALBUQUERQUE PUBLIC WORKS STANDARDS SHALL APPLY.
2. THE CONTRACTOR SHALL ABIDE BY ALL LOCAL, STATE, AND FEDERAL LAWS, RULES AND REGULATIONS WHICH APPLY TO THE CONSTRUCTION OF THESE IMPROVEMENTS, INCLUDING EPA REQUIREMENTS WITH RESPECT TO STORM WATER DISCHARGE.
3. PRIOR TO CONSTRUCTION, THE CONTRACTOR SHALL FIELD VERIFY THE HORIZONTAL AND VERTICAL LOCATIONS OF ALL POTENTIAL OBSTRUCTIONS INCLUDING ALL UNDERGROUND UTILITIES. SHOULD A CONFLICT EXIST, THE CONTRACTOR SHALL NOTIFY THE CONSTRUCTION OBSERVER OR ENGINEER SO THAT THE CONFLICT CAN BE RESOLVED WITH A MINIMUM AMOUNT OF DELAY.
4. TWO (2) WORKING DAYS PRIOR TO ANY EXCAVATION, THE CONTRACTOR SHALL CONTACT LINE LOCATING SERVICE FOR LOCATION OF EXISTING UTILITIES.
5. ALL ELECTRICAL, TELEPHONE, CABLE TV, GAS AND OTHER UTILITY LINES, CABLES, AND APPURTENANCES ENCOUNTERED DURING CONSTRUCTION THAT REQUIRE RELOCATION, SHALL BE COORDINATED WITH THAT UTILITY. THE CONTRACTOR SHALL BE RESPONSIBLE FOR COORDINATION OF ALL NECESSARY UTILITY ADJUSTMENTS. NO ADDITIONAL COMPENSATION WILL BE ALLOWED FOR DELAYS OR INCONVENIENCES CAUSED BY UTILITY COMPANY WORK CREWS. THE CONTRACTOR MAY BE REQUIRED TO RESCHEDULE HIS ACTIVITIES TO ALLOW UTILITY CREWS TO PERFORM THEIR REQUIRED WORK.
6. THE CONTRACTOR IS RESPONSIBLE FOR PROTECTING ALL EXISTING UTILITY LINES WITHIN THE CONSTRUCTION AREA. ANY DAMAGE TO EXISTING FACILITIES CAUSED BY CONSTRUCTION ACTIVITY SHALL BE REPAIRED OR REPLACED AT THE CONTRACTOR'S EXPENSE AND APPROVED BY THE CONSTRUCTION OBSERVER.
7. CONSTRUCTION ACTIVITY SHALL BE LIMITED TO THE PROPERTY AND/OR PROJECT LIMITS. ANY DAMAGE TO ADJACENT PROPERTIES RESULTING FROM THE CONSTRUCTION PROCESS SHALL BE REPAIRED OR REPLACED AT THE CONTRACTOR'S EXPENSE.
8. OVERNIGHT PARKING OF CONSTRUCTION EQUIPMENT SHALL NOT OBSTRUCT DRIVEWAYS OR DESIGNATED TRAFFIC LINES. THE CONTRACTOR SHALL NOT STORE ANY EQUIPMENT OR MATERIAL WITHIN THE PUBLIC RIGHT-OF-WAY.
9. THE CONTRACTOR SHALL OBTAIN ALL THE NECESSARY PERMITS FOR THE PROJECT PRIOR TO COMMENCING CONSTRUCTION (I.E., BARRICADING, TOPSOIL DISTURBANCE, EXCAVATION PERMITS, EPA STORM WATER PERMITS, ETC.).
10. ALL PROPERTY CORNERS DESTROYED DURING CONSTRUCTION SHALL BE REPLACED AT THE CONTRACTOR'S EXPENSE. ALL PROPERTY CORNERS MUST BE RESET BY A REGISTERED LAND SURVEYOR.
11. THE CONTRACTOR SHALL PREPARE A CONSTRUCTION TRAFFIC CONTROL AND SIGNING PLAN AND OBTAIN APPROVAL OF SUCH PLAN FROM THE CITY OF ALBUQUERQUE, TRAFFIC ENGINEERING DEPARTMENT, PRIOR TO BEGINNING ANY CONSTRUCTION WORK ON OR ADJACENT TO EXISTING STREETS.
12. ALL BARRICADES AND CONSTRUCTION SIGNING SHALL CONFORM TO APPLICABLE SECTIONS OF THE "MANUAL ON UNIFORM TRAFFIC CONTROL DEVICES" (MUTCD), US DEPARTMENT OF TRANSPORTATION, LATEST EDITION.
13. THE CONTRACTOR SHALL MAINTAIN ALL CONSTRUCTION BARRICADES AND SIGNING AT ALL TIMES. THE CONTRACTOR SHALL VERIFY THE PROPER LOCATION OF ALL BARRICADING AT THE END AND BEGINNING OF EACH DAY.
14. THE CONTRACTOR SHALL TAKE ALL STEPS NECESSARY TO CONFORM WITH EPA REQUIREMENTS, INCLUDING COMPLIANCE WITH NPDES PHASE 2 REQUIREMENTS.

#### GRADING NOTES

1. EXCEPT AS PROVIDED HEREIN, GRADING SHALL BE PERFORMED AT THE ELEVATIONS AND IN ACCORDANCE WITH THE DETAILS SHOWN ON THIS PLAN.
2. THE COST FOR REQUIRED CONSTRUCTION DUST AND EROSION CONTROL MEASURES SHALL BE INCIDENTAL TO THE PROJECT COST.
3. ALL WORK RELATIVE TO FOUNDATION CONSTRUCTION, SITE PREPARATION, AND PAVEMENT INSTALLATION, AS SHOWN ON THIS PLAN, SHALL BE CONSTRUCTED IN ACCORDANCE WITH THE "GEOTECHNICAL INVESTIGATION". ALL OTHER WORK SHALL, UNLESS OTHERWISE STATED OR PROVIDED FOR HEREON, BE CONSTRUCTED IN ACCORDANCE WITH THE PROJECT, (FIRST PRIORITY) SPECIFICATIONS, AND/OR THE CITY OF ALBUQUERQUE (COA) STANDARD SPECIFICATIONS FOR PUBLIC WORKS (SECOND PRIORITY).
4. EARTH SLOPES SHALL NOT EXCEED 3 HORIZONTAL TO 1 VERTICAL UNLESS SHOWN OTHERWISE.
5. IT IS THE INTENT OF THESE PLANS THAT THIS CONTRACTOR SHALL NOT PERFORM ANY WORK OUTSIDE OF THE PROPERTY BOUNDARIES EXCEPT AS REQUIRED BY THIS PLAN.
6. THE CONTRACTOR IS TO ENSURE THAT NO SOIL ERODES FROM THE SITE ONTO ADJACENT PROPERTY OR PUBLIC RIGHT-OF-WAY.
7. A DISPOSAL SITE FOR ANY & ALL EXCESS EXCAVATION MATERIAL, AND UNSUITABLE MATERIAL AND/OR A BORROW SITE CONTAINING ACCEPTABLE FILL MATERIAL SHALL BE OBTAINED BY THE CONTRACTOR IN COMPLIANCE WITH APPLICABLE ENVIRONMENTAL REGULATIONS AND APPROVED BY THE OBSERVER. ALL COSTS INCURRED IN OBTAINING A DISPOSAL OR BORROW SITE AND HAUL TO OR FROM SHALL BE CONSIDERED INCIDENTAL TO THE PROJECT AND NO SEPARATE MEASUREMENT OR PAYMENT SHALL BE MADE.
8. PAVING AND ROADWAY GRADES SHALL BE +/- 0.1' FROM PLAN ELEVATIONS. PAD ELEVATION SHALL BE +/- 0.05' FROM BUILDING PLAN ELEVATION.
9. ALL PROPOSED CONTOURS REFLECT TOP OF PAVEMENT ELEVATIONS IN THE PARKING AREA AND MUST BE ADJUSTED FOR MEDIANS AND ISLANDS.
10. VERIFY ALL ELEVATIONS SHOWN ON PLAN FROM BASIS OF ELEVATION CONTROL STATION PRIOR TO BEGINNING CONSTRUCTION.

BID PACKAGE ONE - CONSTRUCTION DOCUMENTS

ACADIA  
HEALTHCARE



OVERALL GRADING AND DRAINAGE PLAN  
NEW RESIDENTIAL TREATMENT CENTER  
DESERT HILLS OF NEW MEXICO  
ALBUQUERQUE, NEW MEXICO

1 COA Comments 2014-06-20  
2 Plan Revisions 2014-06-20


20 JUNE 2014  
AHC1313

C4.0

Bohannon Huston  
www.bhinc.com 800.877.5332



EXISTING DRIVE WAY, STORM DRAIN CONNECTION AND UTILITIES CONSTRUCTED WITHIN THE SEQUOIA R.O.W. WILL BE COMPLETED UNDER COA PROJECT WORK ORDER NUMBER 690283.

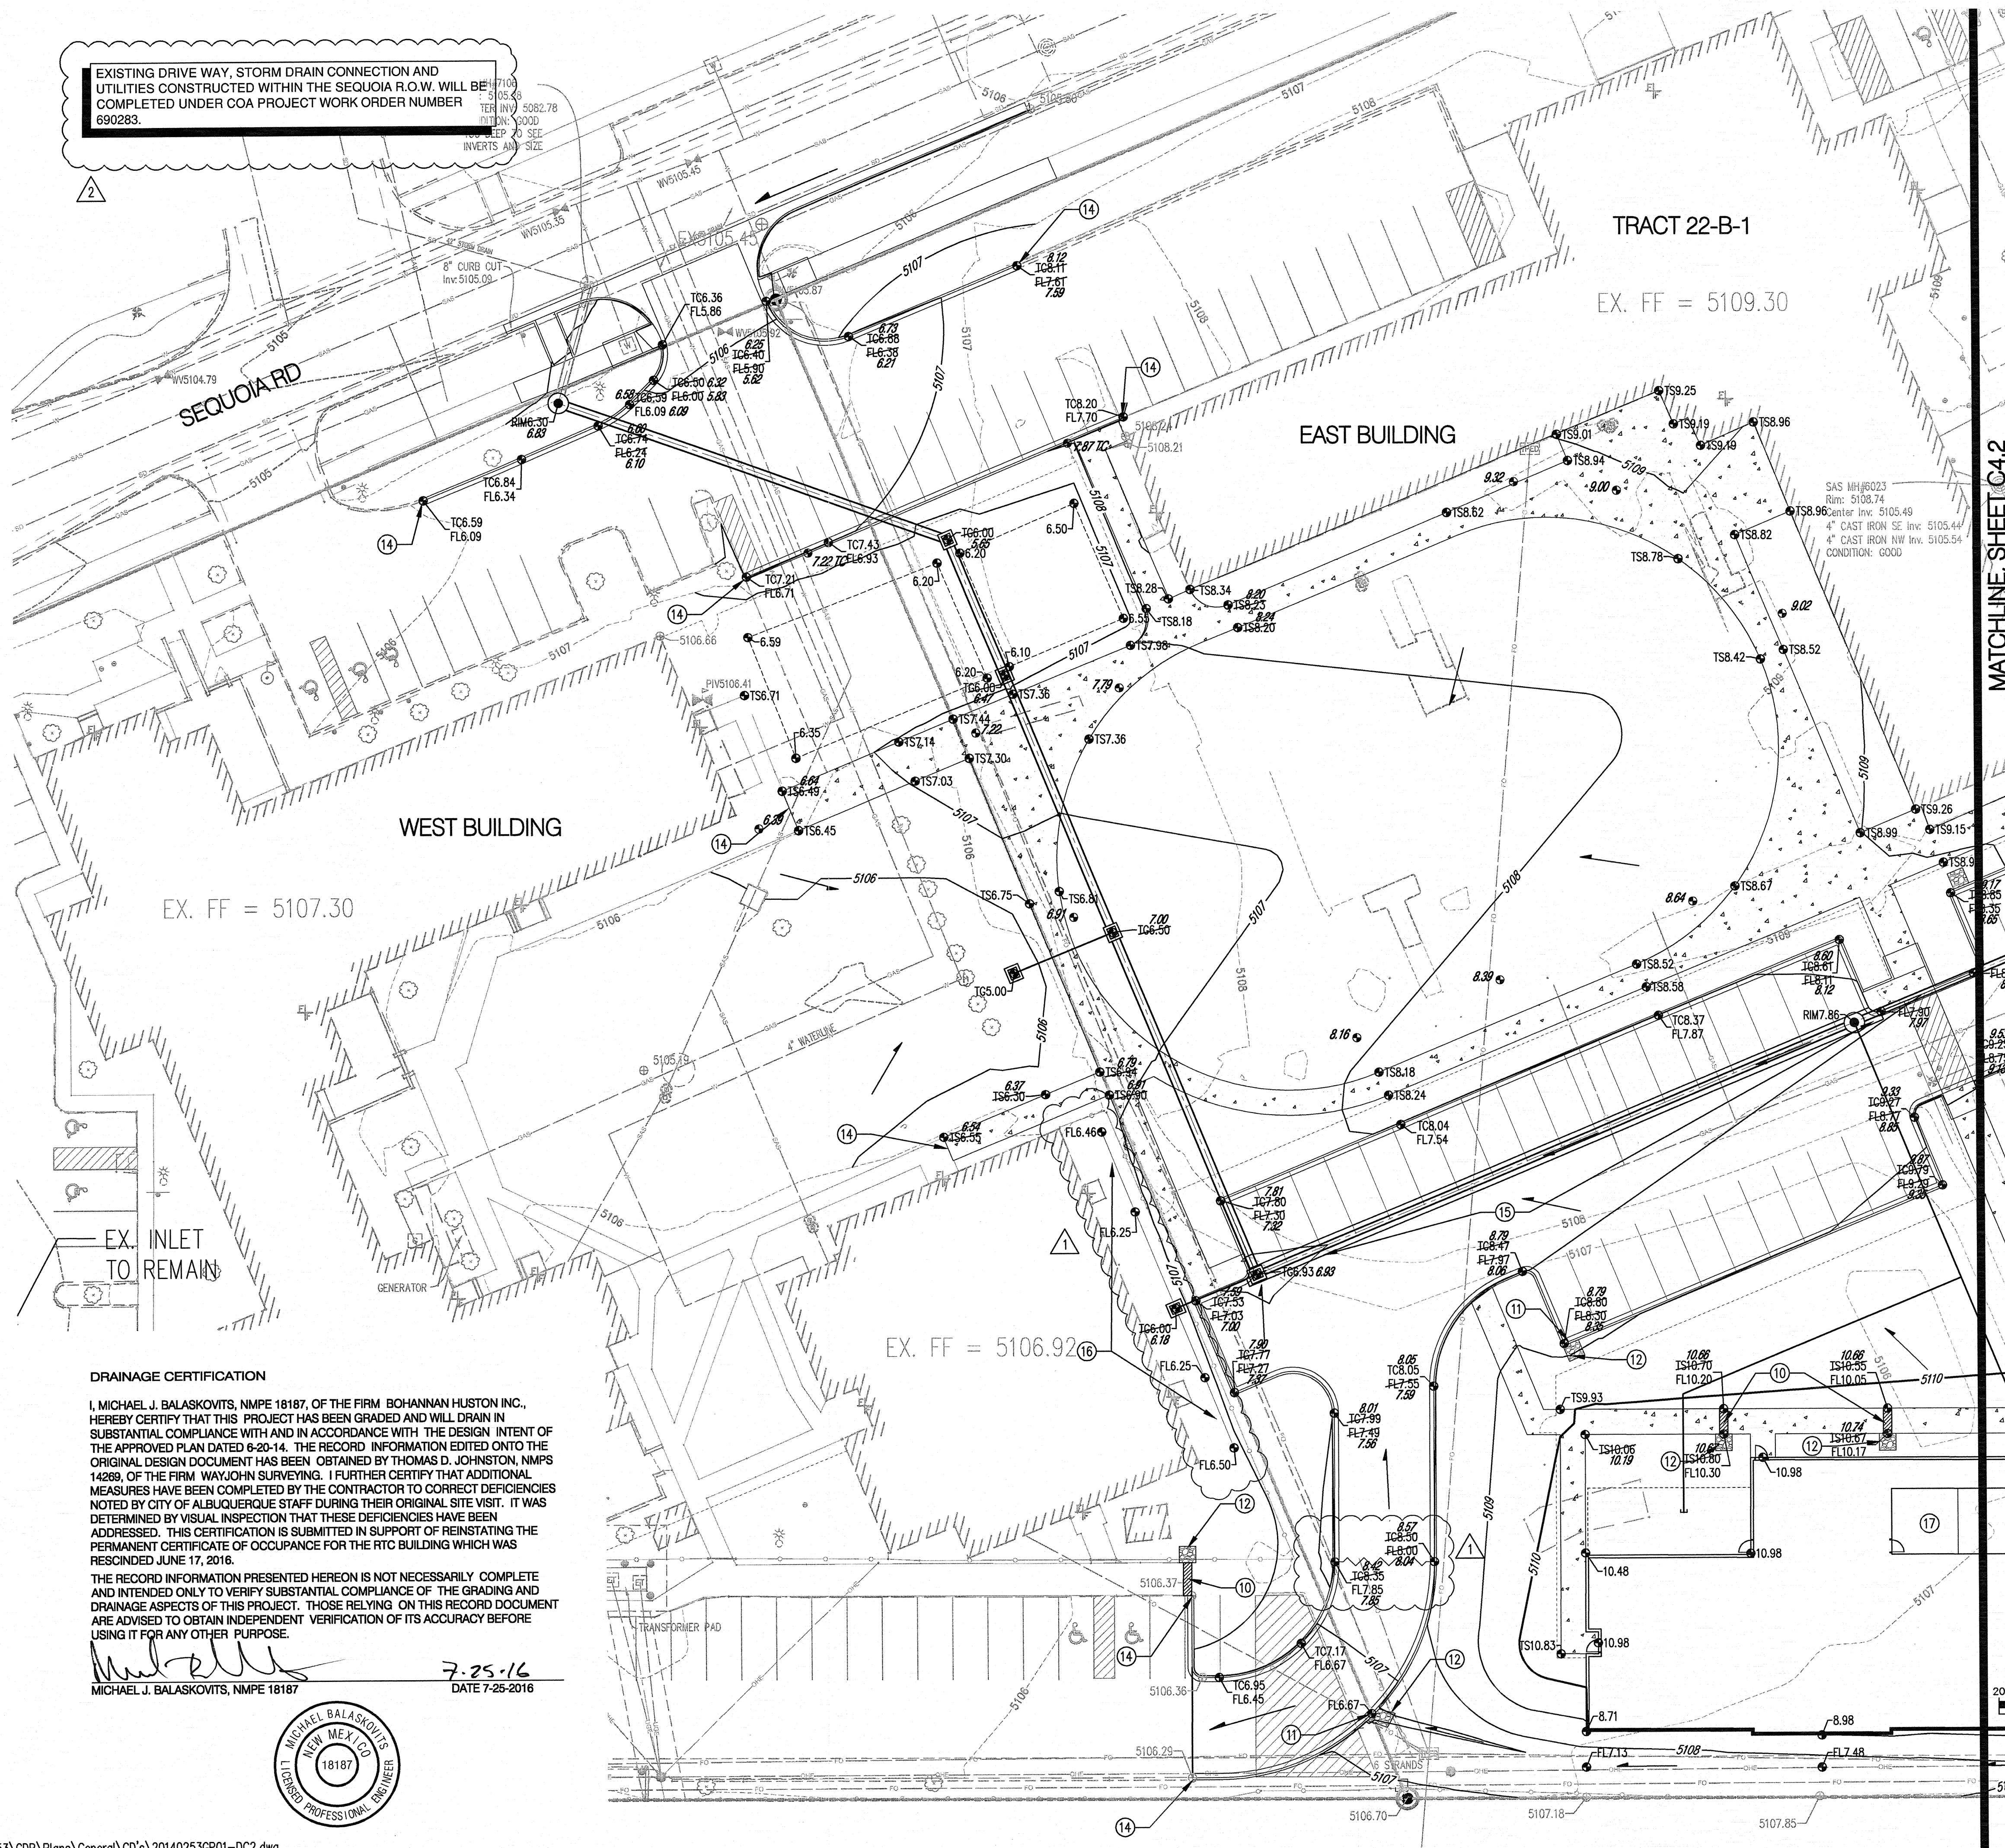

#### DRAINAGE CERTIFICATION

I, MICHAEL J. BALASKOVITS, NMPE 18187, OF THE FIRM BOHANNAN HUSTON INC., HEREBY CERTIFY THAT THIS PROJECT HAS BEEN GRADED AND WILL DRAIN IN SUBSTANTIAL COMPLIANCE WITH AND IN ACCORDANCE WITH THE DESIGN INTENT OF THE APPROVED PLAN DATED 6-20-14. THE RECORD INFORMATION EDITED ONTO THE ORIGINAL DESIGN DOCUMENT HAS BEEN OBTAINED BY THOMAS D. JOHNSTON, NMPS 14269, OF THE FIRM WAYJOHN SURVEYING. I FURTHER CERTIFY THAT ADDITIONAL MEASURES HAVE BEEN COMPLETED BY THE CONTRACTOR TO CORRECT DEFICIENCIES NOTED BY CITY OF ALBUQUERQUE STAFF DURING THEIR ORIGINAL SITE VISIT. IT WAS DETERMINED BY VISUAL INSPECTION THAT THESE DEFICIENCIES HAVE BEEN ADDRESSED. THIS CERTIFICATION IS SUBMITTED IN SUPPORT OF REINSTATING THE PERMANENT CERTIFICATE OF OCCUPANCE FOR THE RTC BUILDING WHICH WAS RESCINDED JUNE 17, 2016.

THE RECORD INFORMATION PRESENTED HEREON IS NOT NECESSARILY COMPLETE AND INTENDED ONLY TO VERIFY SUBSTANTIAL COMPLIANCE OF THE GRADING AND DRAINAGE ASPECTS OF THIS PROJECT. THOSE RELYING ON THIS RECORD DOCUMENT ARE ADVISED TO OBTAIN INDEPENDENT VERIFICATION OF ITS ACCURACY BEFORE USING IT FOR ANY OTHER PURPOSE.

7-25-16  
DATE 7-25-2016

MICHAEL J. BALASKOVITS, NMPE 18187



#### GRADING KEYED NOTES

1. CONNECT NEW 24" STORM DRAIN CONSTRUCTED UNDER COA PROJECT NUMBER 690283 TO NEW MANHOLE.
2. INSTALL STORM DRAIN MANHOLE PER COA STD DWG 2102
3. INSTALL HDPE (N12 WT. OR APPROVED EQUAL) STORM DRAIN PIPE, SIZE PER PLANS.
4. INSTALL TYPE 'D' STORM DRAIN INLET, PER COA STD DWG 2206; (OR APPROVED NYLOPLAST INLET EQUAL) W/PEDESTRIAN RATED GRATE.
5. INSTALL 24" STORM INLET STRUCTURE (NYLOPLAST OR APPROVED EQUAL) W/ DOMED GRATE.
6. INSTALL 30" STORM INLET STRUCTURE (NYLOPLAST OR APPROVED EQUAL) WITH PEDESTRIAN RATED GRATE.
7. PROTECT IN PLACE.
8. INSTALL PRE-FABRICATED STORM DRAIN FITTING, SEE PLANS FOR SIZE.
9. ENSURE SWALE IS GRADED AND COMPLETE PRIOR TO INSTALLATION OF LANDSCAPING. CONTRACTOR SHALL ENSURE NO DRAINAGE ENTERS THE ADJACENT PROPERTY OWNERS TO THE SOUTH AND EAST. GRADES SHOWN ARE TOP OF FINISHED GRADE.
10. INSTALL 24" SIDEWALK CULVERT PER COA STD DWG 2236.
11. INSTALL 24" CURB OPENING PER DETAIL 1, SHEET C4.3
12. INSTALL RIP RAP BLANKET PER DETAIL 2, SHEET C4.3.
13. INSTALL ROOF DRAIN TO WITHIN 5' OF THE BUILDING. SEE PLAN FOR SIZE; SEE PLUMBING PLANS FOR CONTINUATION.
14. MATCH EXISTING HORIZONTALLY & VERTICALLY.
15. INSTALL 4" WIDE CONCRETE VALLEY GUTTER PER DETAIL 3, SHEET C4.3.
16. GRADE AREA TO DRAIN TO NEW INLET. EXISTING COBBLE SHALL BE SALVAGED AND REUSED.
17. SEE TYPICAL COURTYARD GRADING DETAIL 4, SHEET C4.3
18. INSTALL TYPE 'D' H20 LOADING STORM DRAIN INLET, PER COA STD DWG 2206. OR APPROVED EQUAL.

* - NOT ALL KEYNOTES ARE USED ON THIS SHEET

#### NOTE

HDPE PIPE AND FITTINGS SHALL BE INSTALLED AND BACKFILLED PER MANUFACTURER SPECIFICATIONS. CONNECTIONS TO CONCRETE MANHOLES AND CONCRETE DROP INLETS SHALL USE WATER STOP GASKETS AND SHALL BE INSTALLED PER MANUFACTURER'S SPECIFICATIONS

#### NOTE


SIDEWALK CROSS-SLOPES SHALL BE AT A MINIMUM OF 1.0% AND A MAXIMUM OF 2.0%

#### NOTE

CONTRACTOR SHALL ADJUST ALL EXISTING & PROPOSED VALVES, MANHOLES, ETC. TO FINISHED GRADE.


#### LEGEND

---	PROPERTY LINE
---	EXISTING CONTOURS
● 65.23	PROPOSED SPOT ELEVATION TC=TOP OF CURB, FL=FLOW LINE
---	EX=EXISTING, TC=TOP OF GRADE
---	PROPOSED DIRECTION OF FLOW
---	WATER BLOCK
---	TS=TOP OF SIDEWALK, BW=BOTTOM OF WALL
---	PROPOSED INDEX CONTOURS
---	PROPOSED INTER CONTOURS
---	PROPOSED CURB & GUTTER
---	EASEMENT
---	PROPOSED LIGHTING
---	PROPOSED STORM DRAIN LINE
---	AS-BUILT ELEVATION

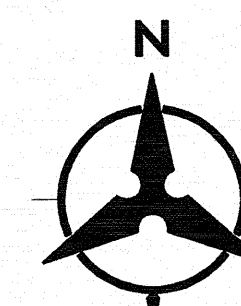

20 10 0 20  
1" = 20'

Bohannon Huston  
www.bhinc.com 800.877.5332

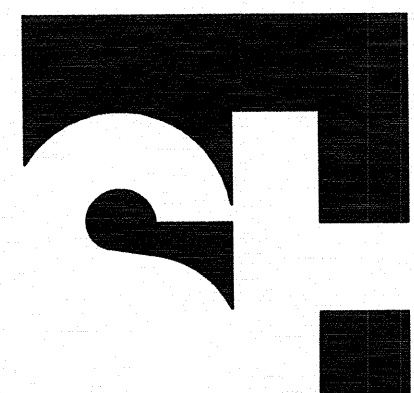

STENGEL-HILL  
ARCHITECTURE

613 WEST MAIN STREET

LOUISVILLE, KENTUCKY 40202

502.893.1875

502.893.1876 fax

ACADIA  
HEALTH CARE



GRADING AND DRAINAGE PLAN  
NEW RESIDENTIAL TREATMENT CENTER  
DESERT HILLS OF NEW MEXICO  
ALBUQUERQUE, NEW MEXICO


COA Comments 2014-06-20  
Plan Revisions 2014-06-20

20 JUNE 2014  
AHC1313

C4.1

BID PACKAGE ONE - CONSTRUCTION DOCUMENTS



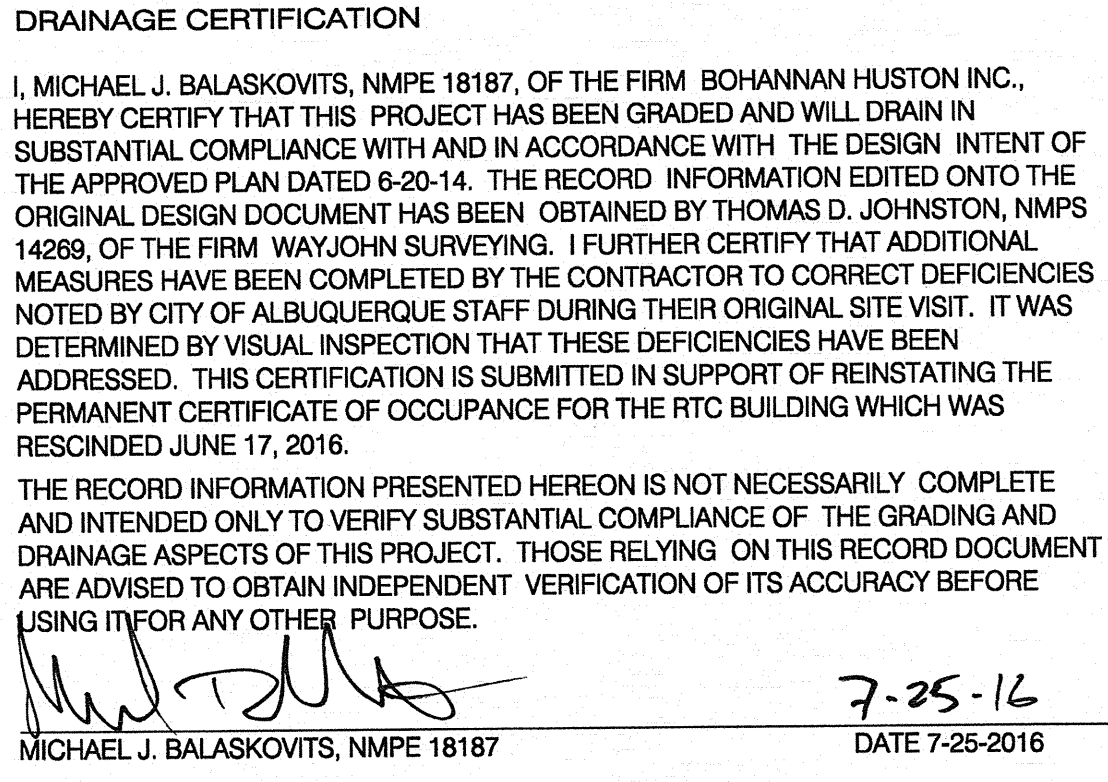


- NOTE**  
CONTRACTOR SHALL ADJUST ALL EXISTING & PROPOSED  
VALVES, MANHOLES, ETC. TO FINISHED GRADE.


## C4.2

# BID PACKAGE ONE - CONSTRUCTION DOCUMENTS




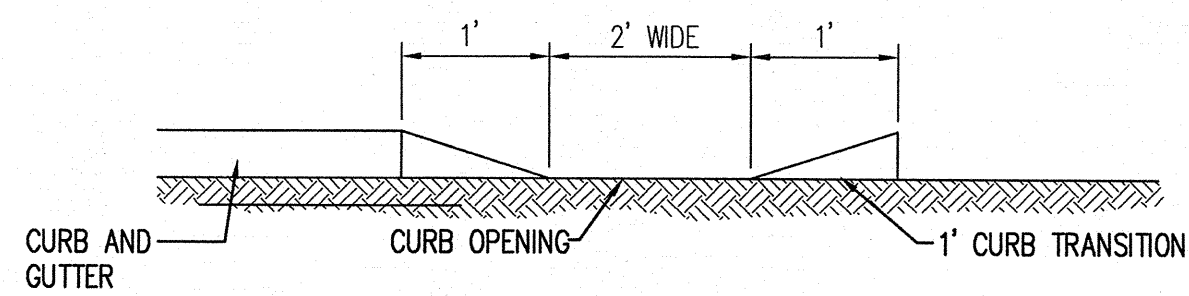


1 TYPICAL CURB CUT  
NTS

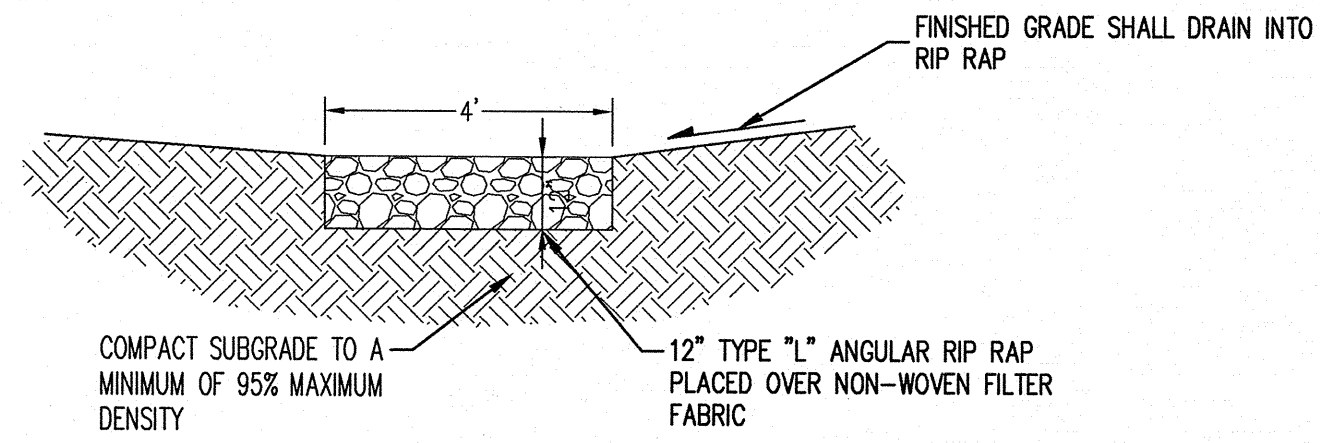

2 RIP RAP BLANKET  
NTS

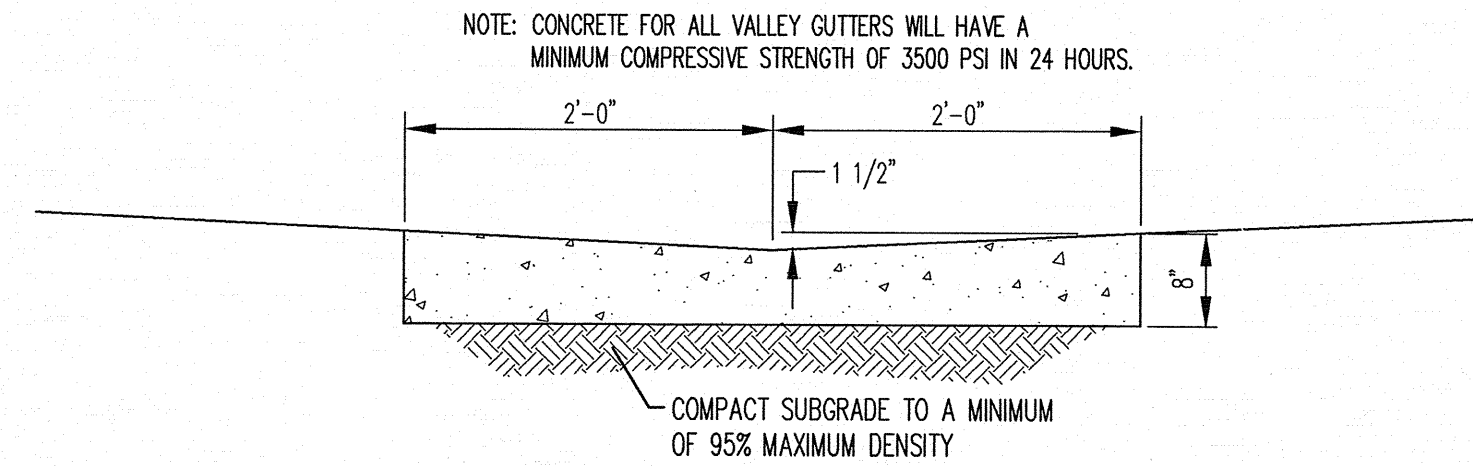

3 CONCRETE VALLEY GUTTER  
NTS

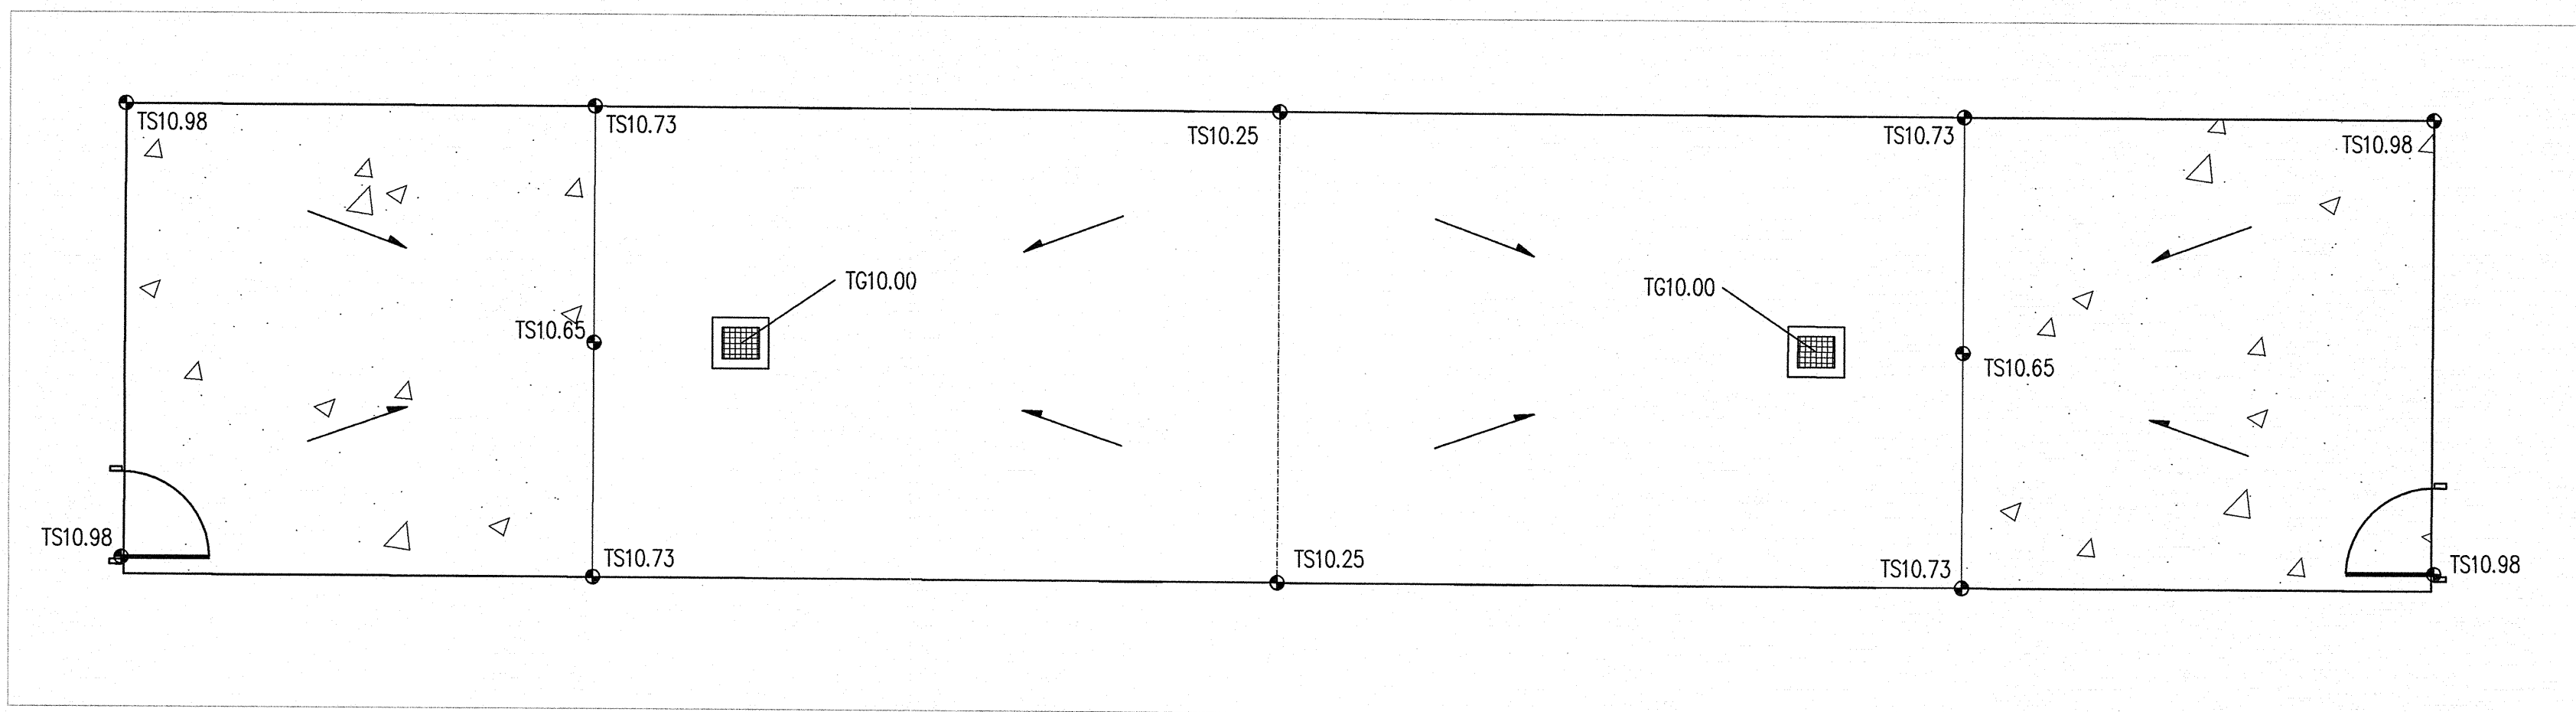

* SEE MECHANICAL / PLUMBING PLAN FOR INLET CONNECTIONS AND DETAILS.

4 TYPICAL COURTYARD GRADING  
1" = 5'

#### DRAINAGE CERTIFICATION

I, MICHAEL J. BALASKOVITS, NMPE 18187, OF THE FIRM BOHANNAN HUSTON INC., HEREBY CERTIFY THAT THIS PROJECT HAS BEEN GRADED AND WILL DRAIN IN SUBSTANTIAL COMPLIANCE WITH AND IN ACCORDANCE WITH THE DESIGN INTENT OF THE APPROVED PLAN DATED 6-20-14. THE RECORD INFORMATION EDITED ONTO THE ORIGINAL DESIGN DOCUMENT HAS BEEN OBTAINED BY THOMAS D. JOHNSTON, NMPS 14269, OF THE FIRM WAYJOHN SURVEYING. I FURTHER CERTIFY THAT ADDITIONAL MEASURES HAVE BEEN COMPLETED BY THE CONTRACTOR TO CORRECT DEFICIENCIES NOTED BY CITY OF ALBUQUERQUE STAFF DURING THEIR ORIGINAL SITE VISIT. IT WAS DETERMINED BY VISUAL INSPECTION THAT THESE DEFICIENCIES HAVE BEEN ADDRESSED. THIS CERTIFICATION IS SUBMITTED IN SUPPORT OF REINSTATING THE PERMANENT CERTIFICATE OF OCCUPANCE FOR THE RTC BUILDING WHICH WAS RESCINDED JUNE 17, 2016.

THE RECORD INFORMATION PRESENTED HEREON IS NOT NECESSARILY COMPLETE AND INTENDED ONLY TO VERIFY SUBSTANTIAL COMPLIANCE OF THE GRADING AND DRAINAGE ASPECTS OF THIS PROJECT. THOSE RELYING ON THIS RECORD DOCUMENT ARE ADVISED TO OBTAIN INDEPENDENT VERIFICATION OF ITS ACCURACY BEFORE USING IT FOR ANY OTHER PURPOSE.

*Michael J. Balaskovits*  
MICHAEL J. BALASKOVITS, NMPE 18187

7-25-16  
DATE 7-25-2016

