CITY OF ALBUQUERQUE

Planning Department Alan Varela, Director



July 12, 2022

Amanda Bishop Interplan LLC c/o Chick-fil-A, Inc. 220 East Central Parkway, Suite 4000 Altamonte Springs, FL 32701

Re: Chick-fil-A 4001 Coors Blvd. NW Traffic Circulation Layout Engineer's Stamp 06-20-22 (G11-D069C)

Dear Mrs. Amanda,

Based upon the information provided in your submittal received 06-23-22, the above referenced plan cannot be approved for Building Permit until the following comments are addressed:

- 1. Please provide a clear site plan.
- Provide shared parking agreement.

PO Box 1293

- 3. Provide drive aisle width.
- 4. Provide the angle, length, and the width for the proposed parking spaces.
- 5. Provide the width for the proposed driveway accesses.

Albuquerque

6. It is not apparent what type of pavement surface is being proposed for the angle parcking spaces at the north side of the drive-thru. A hard driving surface will be required as part of this proposed project for parking area and drive aisles.

NM 87103

7. Tha driveway access at the west side of the site, should be used as an Exit Only. Please provide "DO NOT ENTER" sign on this access.

www.cabq.gov

- 8. All one-way drives shall have "One Way" and "Do Not Enter" signage and pavement markings. Please show detail and location of posted signs and striping.
- 9. Please provide all proposed signs face detailes.
 - 10. Please provide a letter of response for all comments given.

Once corrections are complete resubmit

- 1. The Traffic Circulation Layout
- 2. A Drainage Transportation Information Sheet (DTIS)
- 3. Send an electronic copy of your submittal to PLNDRS@cabq.gov.
- 4. The \$75 re-submittal fee.

for log in and evaluation by Transportation.

If you have any questions, please contact me at (505) 924-3675.

CITY OF ALBUQUERQUE

Planning Department Alan Varela, Director



Sincerely,

Marie Marwa Al-najjar

Associate Engineer, Planning Dept. Development Review Services

via: email \ma C: CO Clerk, File

PO Box 1293

Albuquerque

NM 87103

www.cabq.gov



City of Albuquerque


Planning Department

Development & Building Services Division

DRAINAGE AND TRANSPORTATION INFORMATION SHEET (REV 10/2018)


Project Title:	Building Permit #:		Hydrology File #:		
DRB#:			Work Order#:		
Legal Description:					
City Address:					
Applicant:			Contact		
Address:Phone#:					
Other Contact:					
Address:				_	
Phone#:					
TYPE OF DEVELOPMENT:	PLAT (# of lots)	RESIDENCE _	DRB SITE	ADMIN SITE	
IS THIS A RESUBMITTAL? Y					
DEPARTMENT: TRAFFIC/TI		HYDROLOG	Y/DRAINAGE		
Check all that Apply:			TYPE OF APPROVAL/ACCEPTANCE SOUGHT:		
TYPE OF SUBMITTAL: ENGINEER/ARCHITECT CERTIFICATION PAD CERTIFICATION CONCEPTUAL G & D PLAN GRADING PLAN DRAINAGE MASTER PLAN DRAINAGE REPORT FLOODPLAIN DEVELOPMENT PERMIT APPLIC ELEVATION CERTIFICATE CLOMR/LOMR TRAFFIC CIRCULATION LAYOUT (TCL) TRAFFIC IMPACT STUDY (TIS) OTHER (SPECIFY) PRE-DESIGN MEETING?		BUILDING PERMIT APPROVAL CERTIFICATE OF OCCUPANCY PRELIMINARY PLAT APPROVAL SITE PLAN FOR SUB'D APPROVAL SITE PLAN FOR BLDG. PERMIT APPROVAL FINAL PLAT APPROVAL SIA/ RELEASE OF FINANCIAL GUARANTEI FOUNDATION PERMIT APPROVAL GRADING PERMIT APPROVAL SO-19 APPROVAL PAVING PERMIT APPROVAL GRADING/ PAD CERTIFICATION WORK ORDER APPROVAL CLOMR/LOMR FLOODPLAIN DEVELOPMENT PERMIT OTHER (SPECIFY)			
DATE SUBMITTED:	By:				

FEE PAID:___

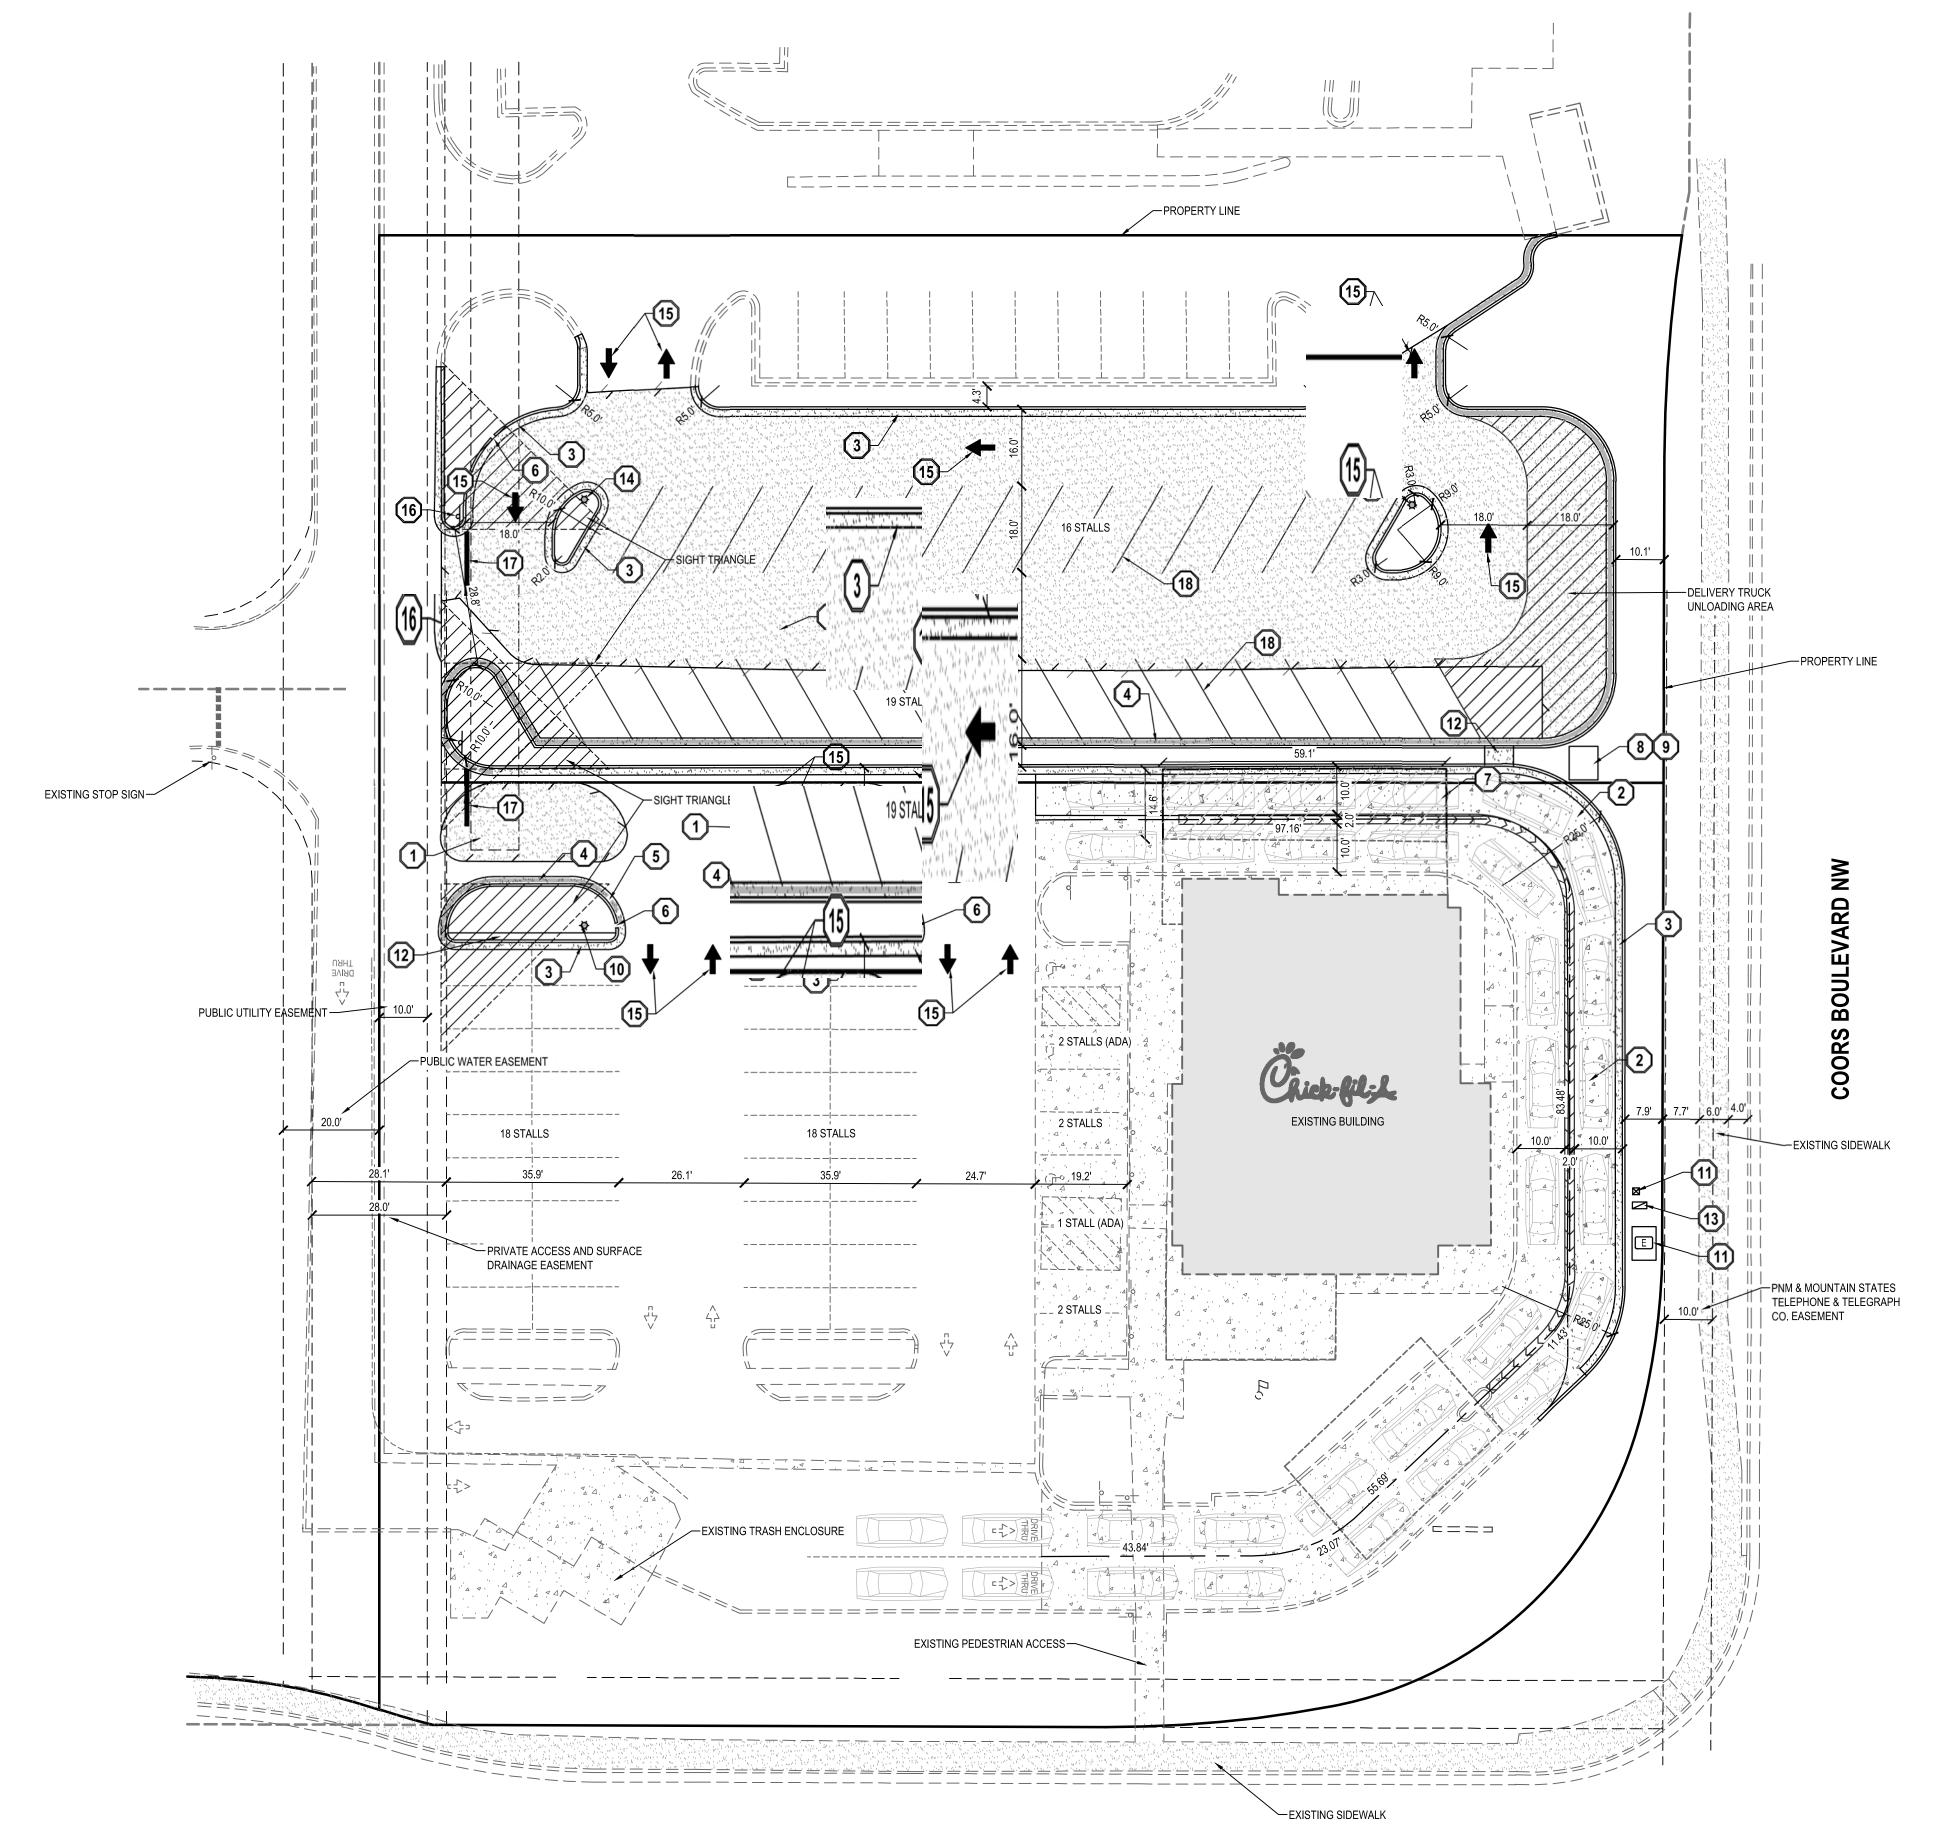



VICINITY MAP

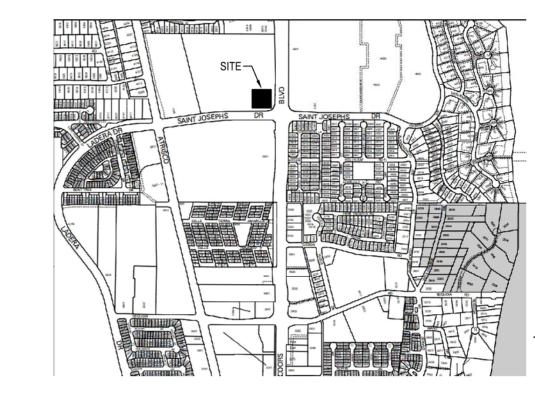

GENERAL NOTES

- 1. ALL WORK TO COMPLY WITH THE GOVERNING AGENCY'S STANDARDS AND SPECIFICATIONS.
- 2. ALL IMPROVEMENTS MUST COMPLY WITH ADA STANDARDS AND RECOMMENDATIONS.
- 3. SEE LANDSCAPE/ARCHITECTURAL PLANS FOR CONCRETE MATERIAL, COLOR, FINISH, AND SCORE PATTERNS THROUGHOUT SITE.
- 4. ALL PAVEMENT MARKINGS SHALL CONFORM TO THE LATEST EDITION OF THE M.U.T.C.D. (MANUAL ON UNIFORM
- 5. ALL SURFACE IMPROVEMENTS DISTURBED BY CONSTRUCTION SHALL BE RESTORED OR REPLACED. INCLUDING TREES AND DECORATIVE SHRUBS, SOD, FENCES, WALLS AND STRUCTURES, WHETHER OR NOT THEY ARE SPECIFICALLY SHOWN ON THE CONTRACT DOCUMENTS.
- 6. NOTIFY ENGINEER OF ANY DISCREPANCIES IN DESIGN OR STAKING BEFORE PLACING CONCRETE OR ASPHALT.
- 7. THE CONTRACTOR IS TO PROTECT AND PRESERVE ALL EXISTING IMPROVEMENTS, UTILITIES, AND SIGNS, ETC UNLESS OTHERWISE NOTED ON THESE PLANS.

PROVIDE, INSTALL AND/OR CONSTRUCT THE FOLLOWING PER THE SPECIFICATIONS GIVEN OR REFERENCED, THE DETAILS NOTED, AND/OR AS SHOWN ON THE CONSTRUCTION DRAWINGS:

- 1) ASPHALT PAVEMENT. SEE DETAIL 1/C-3.0.
- (2) CONCRETE PAVEMENT DRIVE-THRU. SEE DETAIL 2/C-3.0.
- (3) 24" CATCHING CURB AND GUTTER PER DETAIL 3/C-3.0.
- 24" SPILLING CURB AND GUTTER PER DETAIL 3/C-3.0.
- (5) TRANSITION BETWEEN CATCHING AND SPILLING CURB AND GUTTER.
- 6 1' CURB OPENING.
- 7 PROPOSED CANOPY.
- (8) CONCRETE PAD FOR ELECTRICAL EQUIPMENT. SEE ELECTRICAL PLANS FOR ADDITIONAL INFORMATION.
- (9) RELOCATED ELECTRICAL TRANSFORMER. SEE ELECTRICAL PLANS FOR ADDITIONAL INFORMATION.
- RELOCATED LIGHT POLE. SEE ELECTRICAL PLANS FOR ADDITIONAL INFORMATION.
- (11) RELOCATED ELECTRICAL EQUIPMENT. SEE ELECTRICAL PLANS FOR ADDITIONAL INFORMATION.
- (12) CONCRETE SIDEWALK. SEE DETAIL 5/C-3.0.
- RELOCATED COMMUNICATIONS EQUIPMENT. COORDINATE WITH SERVICE PROVIDER.
- PROPOSED LIGHT POLE. SEE ELECTRICAL PLANS FOR ADDITIONAL INFORMATION.
- painted lane-use arrows. See Detail 4/C-3.0.
- 16 "STOP" SIGN.
- 17) 12' SOLID STOP BAR.
- 4" WIDE SOLID PAVEMENT MARKING PER PARKING LOT STRIPING SPECIFICATIONS. SEE 5/C-3.0.

PARKING DATA TABLE				
EXISTING STALLS TO BE REMOVED	4			
PROPOSED STALLS	35			
EXISTING STALLS (TO REMAIN)	40			
EXISTING ADA STALLS (TO REMAIN)	3			
TOTAL STALLS	78			

LEGEND

- EXISTING BOLLARD
- PROPOSED BOLLARD
- EXISTING SIGN PROPOSED SIGN
- EXISTING FLAG POLE
- ———————— EXISTING EDGE OF ASPHALT
- PROPOSED EDGE OF ASPHALT ---- EXISTING STRIPING
- PROPOSED STRIPING
- PROPOSED ASPHALT E EXISTING CURB AND GUTTER
- PROPOSED CURB AND GUTTER PROPOSED REVERSE PAN CURB AND GUTTER

PROPOSED CONCRETE

- TRANSITION TO REVERSE PAN CURB EXISTING CONCRETE
- EXISTING BUILDING





5200 Buffington Rd Atlanta Georgia, 30349-2998

Mark Date By

Mark Date

Mark Date By





SALT LAKE CITY 45 W. 10000 S., Suite 500 Sandy, UT 84070 Phone: 801.255.0529

WWW.ENSIGNENG.COM

Fax: 801.255.4449

STORE CHICK-FIL-A FSU #04107 COORS BLVD.

COORS BLVD NW & ST JOSEPHS DR NW ALBUQUERQUE, NM 87120

SHEET TITLE SITE PLAN


VERSION: ISSUE DATE:

Job No. : <u>11274</u> : <u>04107</u> Store :6/21/22

Drawn By : MM Checked By: DJ


Sheet

C-I.O

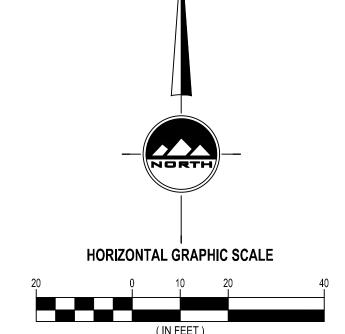


HORZ: 1 inch = 20 ft.



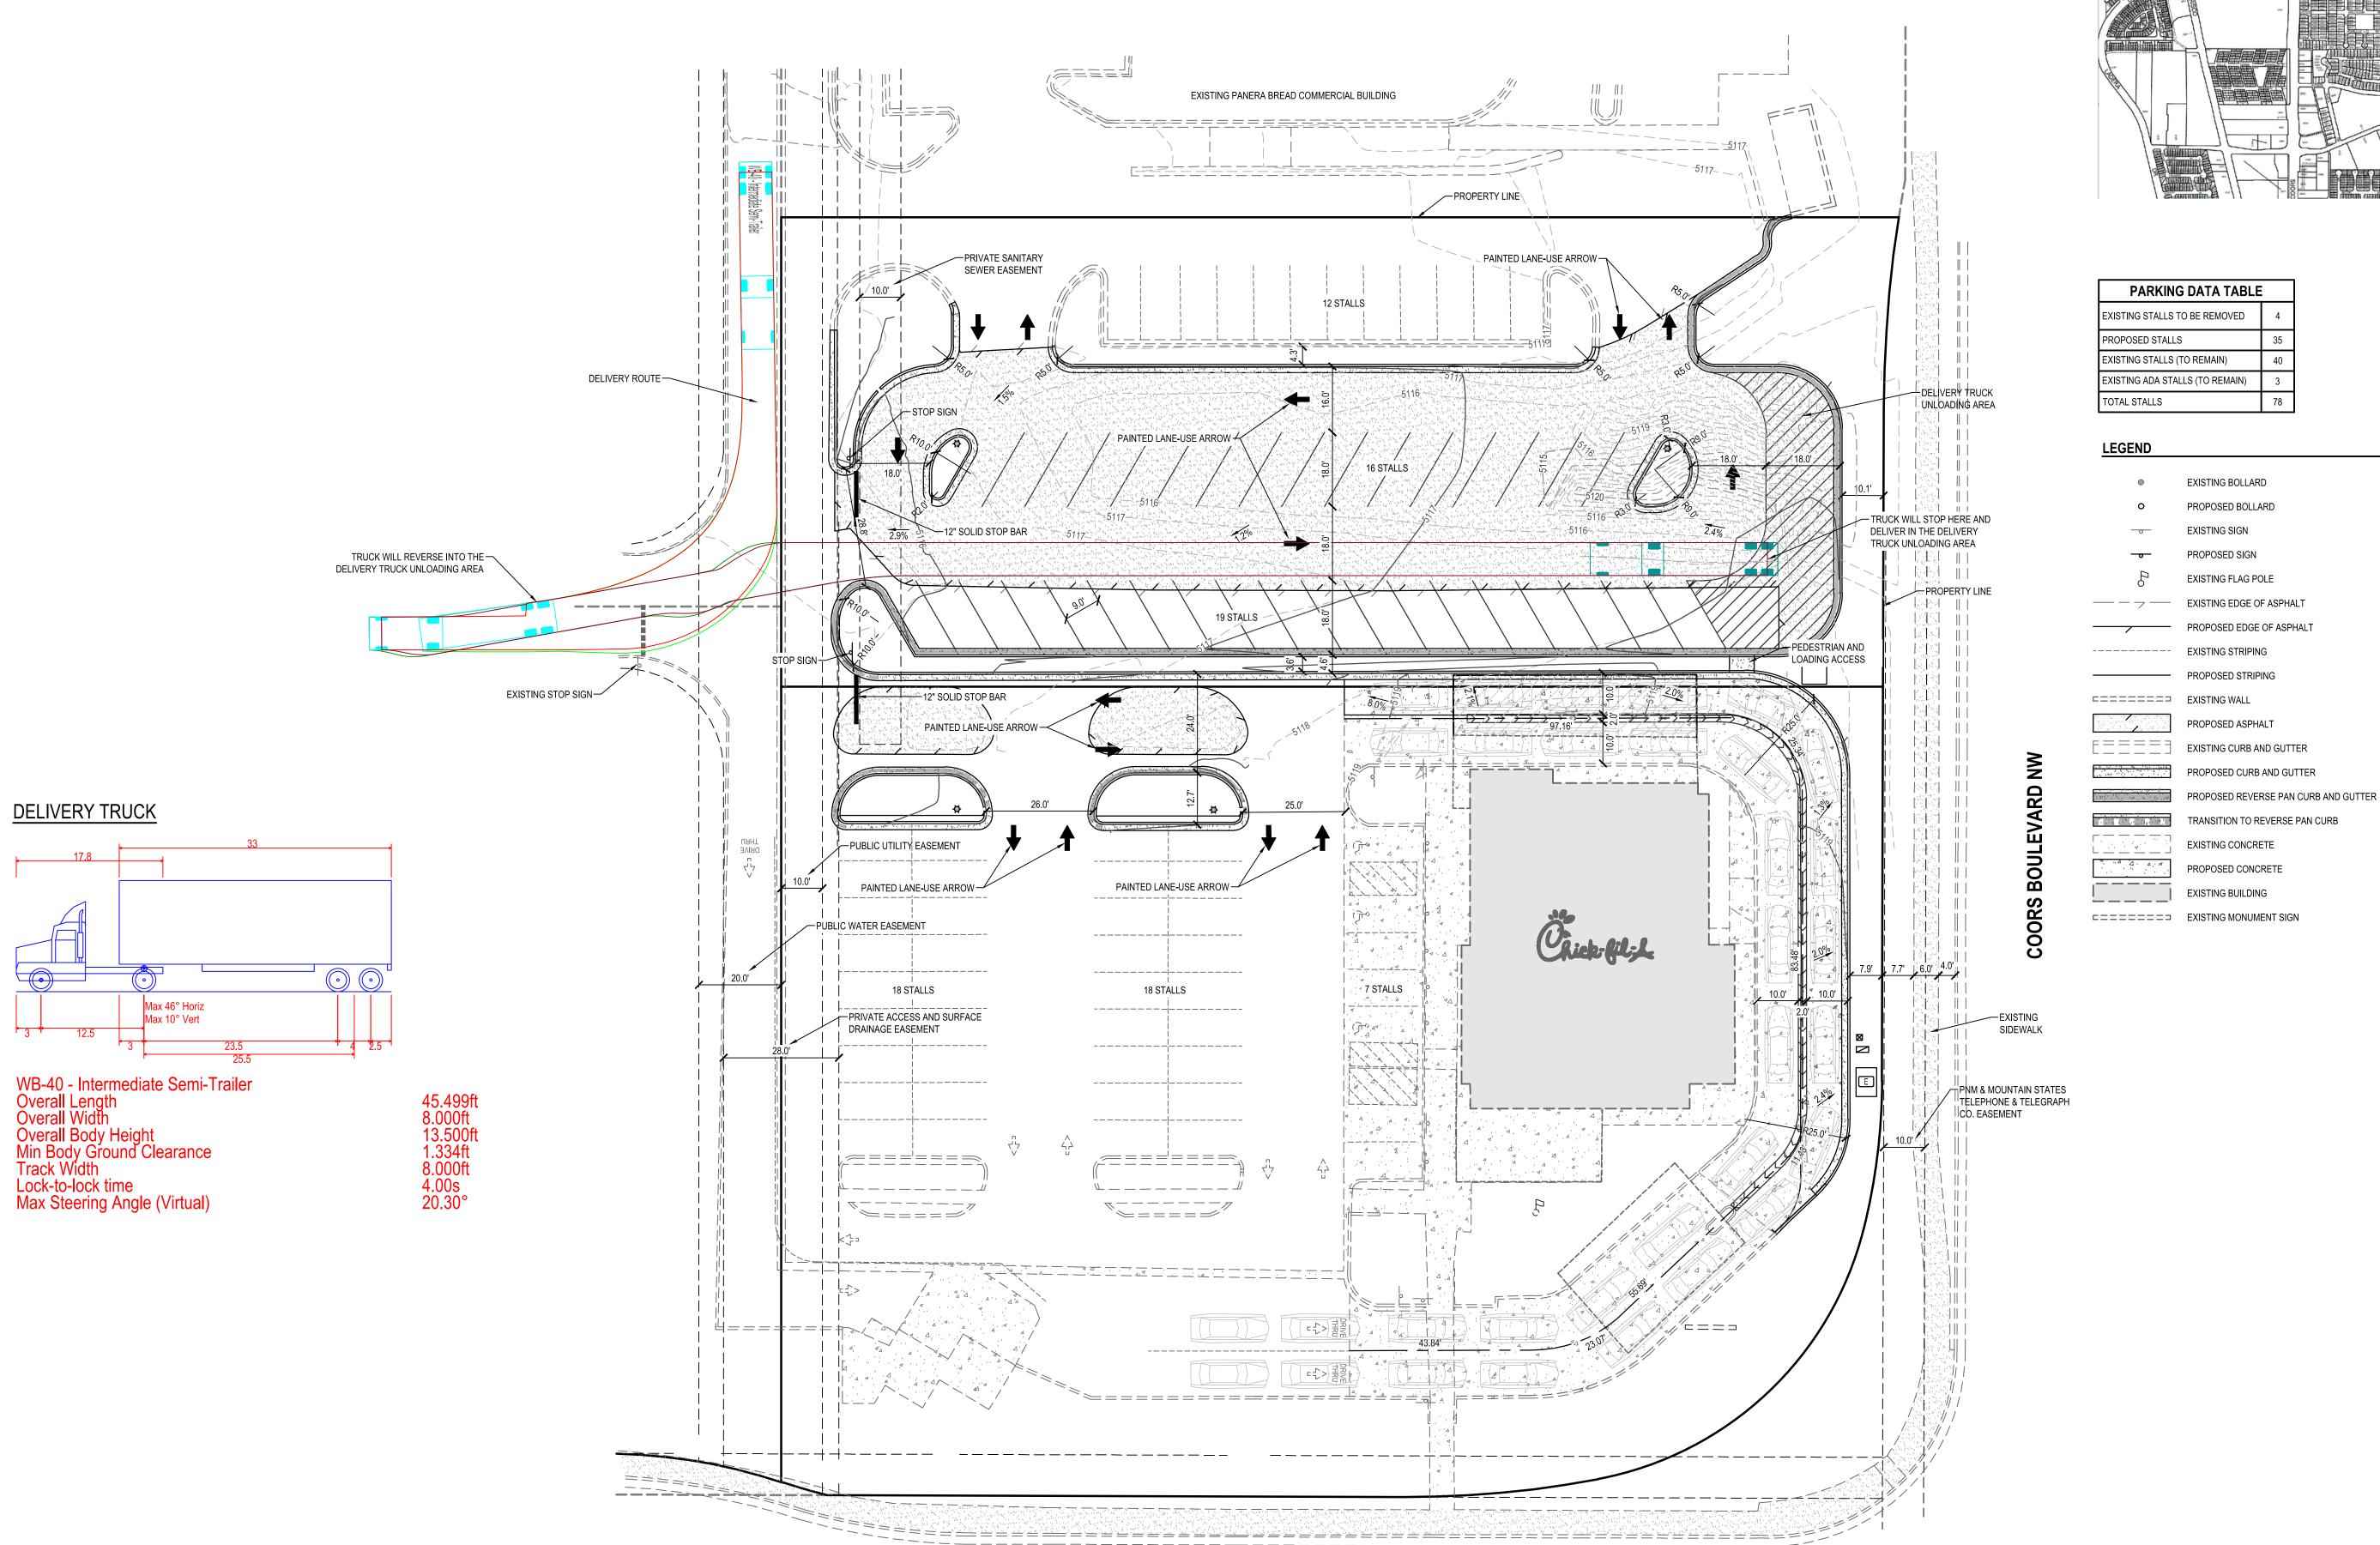

VICINITY MAP

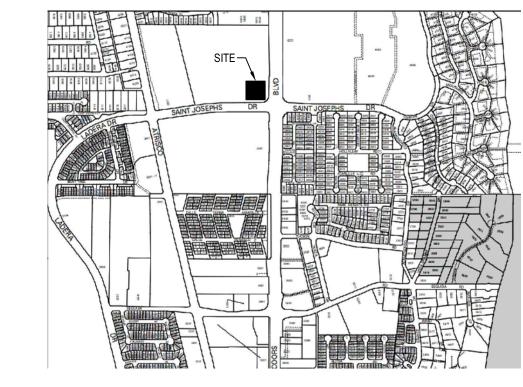

TRANSITION TO REVERSE PAN CURB





5200 Buffington Rd. Atlanta Georgia, 30349-2998

evisions:

Mark Date By

Mark Date By

Mark Date By



SALT LAKE CITY 45 W. 10000 S., Suite 500 Sandy, UT 84070 Phone: 801.255.0529 Fax: 801.255.4449

WWW.ENSIGNENG.COM

STORE CHICK-FIL-A FSU #04107 COORS BLVD.

COORS BLVD NW & ST. JOSEPHS DR NW ALBUQUERQUE, NM

SHEET TITLE TRAFFIC CIRCULATION LAYOUT

VERSION: ISSUE DATE:

Job No. : <u>11274</u> : <u>04107</u> Store :6/21/22 Drawn By : MM

Checked By: DJ

HORIZONTAL GRAPHIC SCALE

HORZ: 1 inch = 20 ft.

Sheet TCL

ST. JOSEPHS DRIVE