CITY OF ALBUQUERQUE

Planning Department Alan Varela, Director



November 29, 2023

David Soule, P.E. Rio Grande Engineering P.O. Box 93924 Albuquerque, NM 87199

RE: 3420 Ward St. NW

Revised Grading and Drainage Plan Engineer's Stamp Date: 08/28/23 Hydrology File: G11D072

Dear Mr. Soule:

PO Box 1293


Based upon the information provided in your submittal received 08/28/2023, the Grading & Drainage Plans **are not** approved for Building Permit and Grading Permit. The following comments need to be addressed for approval of the above referenced project:

Albuquerque

1. Please provide an updated topographic survey. The original Grading & Drainage Plan was approved on June 05, 2020 and earthwork was done. This is what needs to be shown and then show the proposed house and grading.


NM 87103

www.cabq.gov

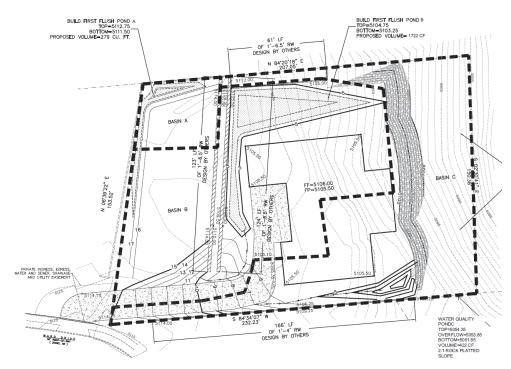

CITY OF ALBUQUERQUE

Planning Department Alan Varela, Director

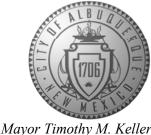

Mayor Timothy M. Keller



If you have any questions, please contact me at 924-3995 or rbrissette@cabq.gov .

Sincerely,

PO Box 1293

Renée C. Brissette, P.E. CFM

Renée C. Brissette

Albuquerque Senior Engineer, Hydrology

Planning Department

NM 87103

www.cabq.gov



City of Albuquerque

Planning Department

Development & Building Services Division

DRAINAGE AND TRANSPORTATION INFORMATION SHEET (REV 6/2018)

Project Title: 3420 WARD NW	3420 WARD NW Building Permit #:		ogy File #:	
RB#: EPC#:		Work (Work Order#:	
Legal Description: LOT 17B, Block	A GRANDE H	EIGHTS		
City Address: 3420 WARD NW				
Applicant:		Contact:		
Address:				
Phone#:				
Other Contact: RIO GRANDE ENGINEERING		Contact:	DAVID SOULE	
Address: PO BOX 93924 ALB NM				
Phone#: 505.321.9099	Fax#: 505.872.0	999 E-mail : da	avid@riograndeengineering.com	
TYPE OF DEVELOPMENT: PLAT				
Check all that Apply:				
DEPARTMENT: HYDROLOGY/ DRAINAGE TRAFFIC/ TRANSPORTATION		YPE OF APPROVAL/ACCEI BUILDING PERMIT APPR CERTIFICATE OF OCCUP	OVAL	
TYPE OF SUBMITTAL: ENGINEER/ARCHITECT CERTIFICATION PAD CERTIFICATION CONCEPTUAL G & D PLAN X GRADING PLAN DRAINAGE REPORT		PRELIMINARY PLAT AP SITE PLAN FOR SUB'D A SITE PLAN FOR BLDG. P FINAL PLAT APPROVAL	APPROVAL ERMIT APPROVAL	
DRAINAGE MASTER PLAN FLOODPLAIN DEVELOPMENT PERMIT A ELEVATION CERTIFICATE CLOMR/LOMR TRAFFIC CIRCULATION LAYOUT (TCL) TRAFFIC IMPACT STUDY (TIS) STREET LIGHT LAYOUT OTHER (SPECIFY) PRE-DESIGN MEETING?	PPLIC	SIA/ RELEASE OF FINAN FOUNDATION PERMIT A GRADING PERMIT APPR SO-19 APPROVAL PAVING PERMIT APPRO GRADING/ PAD CERTIFI WORK ORDER APPROVAL CLOMR/LOMR FLOODPLAIN DEVELOPN	PPROVAL OVAL VAL CATION	
IS THIS A RESUBMITTAL?: X Yes NO REVISED SITE PLAN DATE SUBMITTED:	By:	OTHER (SPECIFY)		
COA STAFF:		TTAL RECEIVED:		

Weighted E Method EROSION CONTROL NOTES: 1. CONTRACTOR IS RESPONSIBLE FOR OBTAINING A TOPSOIL DISTURBANCE 100-Year, 6-hr. PERMIT PRIOR TO BEGINNING WORK. Area | Area | Treatment A | Treatment B | Treatment C | Treatment DWeighted | Volume (sf) (acres) % (acres) % (acres) % (acres) % (acres) (ac-ft) (ac-ft) 2. CONTRACTOR IS RESPONSIBLE FOR MAINTAINING RUN-OFF ON SITE DURING 32998.00 | 0.758 | 25% | 0.189 | 30% | 0.227 | 45% | 0.3409 | 0% | 0.000 | 0.757 | 0.048 CONSTRUCTION. 2362.00 0.054 0% 0 50% 0.027 50% 0.0271 0% 0.000 0.830 0.004 BASIN A 16627.00 0.382 0% 0 29% 0.111 38% 0.145 33% 0.126 1.221 0.039 BASIN B 3. CONTRACTOR IS RESPONSIBLE FOR CLEANING ALL SEDIMENT THAT GETS BASIN C 14009.00 0.322 0% 0 25% 0.080 50% 0.1608 25% 0.080 1.155 0.031 0.98 INTO EXISTING RIGHT-OF-WAY. total 4. REPAIR OF DAMAGED FACILITIES AND CLEANUP OF SEDIMENT ACCUMULATIONS ON ADJACENT PROPERTIES AND IN PUBLIC FACILITIES IS THE RESPONSIBILITY OF THE CONTRACTOR. **Equations:** Weighted E = Ea*Aa + Eb*Ab + Ec*Ac + Ed*Ad / (Total Area) 5. ALL EXPOSED EARTH SURFACES MUST BE PROTECTED FROM WIND AND WATER EROSION PRIOR TO FINAL ACCEPTANCE OF ANY PROJECT. Volume = Weighted D * Total Area Flow = Qa * Aa + Qb * Ab + Qc * Ac + Qd * Ad Where for 100-year, 6-hour storm-zone 1 Qa= 1.29 Ea= 0.44 Eb= 0.67 Qb= 2.03 Qc= 2.87 Ec= 0.99 Ed= 1.97 Qd= 4.37 ONSITE Conditions 100-YEAR 6 HOUR VOLUMES GENERATED RETAINED DISCHARGE RATE (CF) 163 249 BASIN B BASIN C 1691 1348 1722 1.19 CONSTRUCT ALL SWALES AND EROSION PROTECTION (SHOWN HATCHED) BELOW ADJACENT GRADE TO ENDSURE RUNOFF CAN BE CAPTURED AND CONVEYED PROPERLY. TOTAL PROPOSED 1.19 HISTORICAL 1.68 This site is within the the north west sid of albuquerque. The site is to maintain existing patterns and drain to the historical outfall east of the site. The site shall retain on site the increase in flow so the downstream properties experience historical flow rates only. This is accomplished by retaining the flows from basin A and B. Basin C IS allowed to free discharge .98 CFS, which is less than historical BUILD FIRST FLUSH POND B BUILD FIRST FLUSH POND A _TOP=5104.75 TOP=5112.75 BOTTOM=5103.25 BOTTOM=5111.50 PROPOSED VOLUME=:1722 CF PROPOSED VOLUME=279 CU. FT. DESIGN BY OTHERS EARTHEN SWALE LONG TERM MAINTANANCE OF SLOPE SHALL BE REQUIRED

BASIN B

PRIVATE INGRESS, EGRESS, WATER AND SEWER, DRAINAGE NAND UTILITY EASEMENT

×5114.75

FF=5106.00 FP=5105.50

OF 1'-4' RW

DESIGN BY OTHERS

WATER QUALITY

OVERFLOW=5053.85


BOTTOM=5051.85 VOLUME=422 CF

2:1 ROCK PLATTED

TOP=5054.35

PONDC


SLOPE

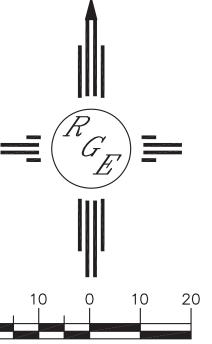


SCALE: 1"=20'

PLACE 2" LAYER OF

GRAVEL AT FLOW LINE

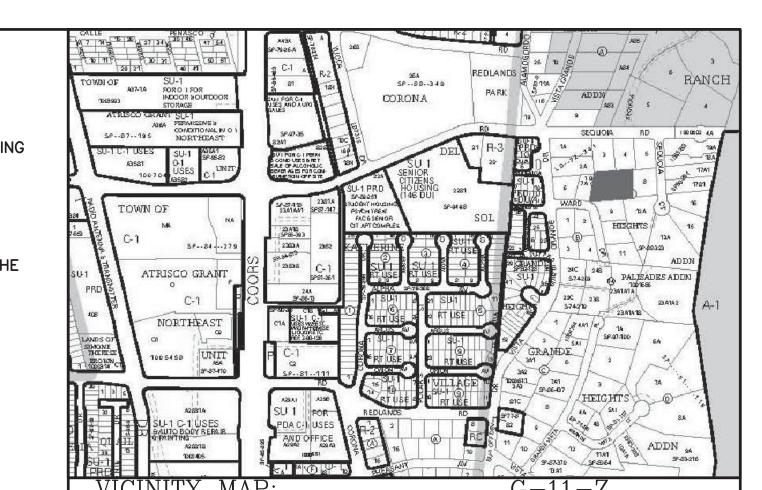

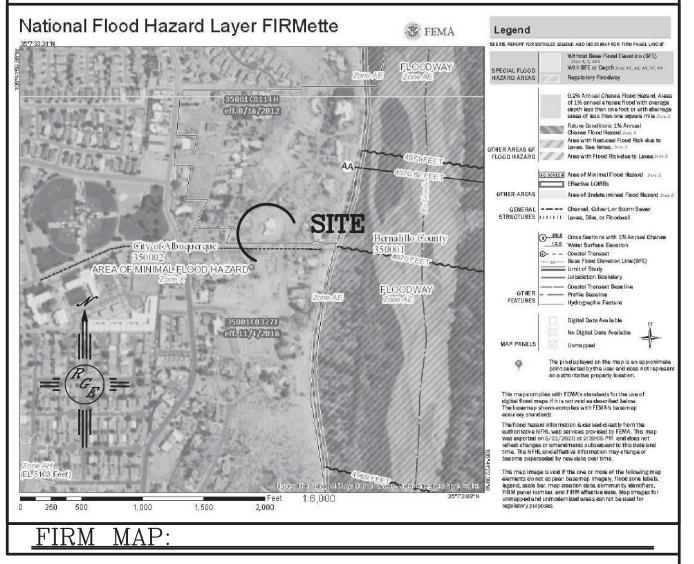

LEGAL DESCRIPTION:

LOT 9, BLK A, WARD HEIGHTS


LEGEND

1. ALL SPOT ELEVATIONS REPRESENT FLOWLINE ELEVATION UNLESS OTHERWISE NOTED.

2. ALL SLOPES SHALL BE 3:1 MAX. AND GRAVEL OR NATIVE SEEDING PRIOR TO

3. ANY PERIMETER WALLS MUST BE PERMITTED SEPARATELY ALL RETAINING WALL DESIGN SHALL BE BY OTHERS.


4. SURVEY INFORMATION PROVIDED BY DYNAMIC CONSTRUCTOIN AND TECHNOLOGY USING NAVD DATUM 1988.

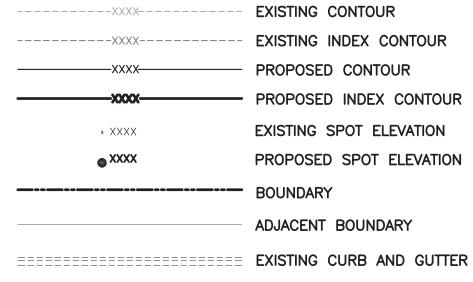

PROPOSED EARTHEN SWALE PROPOSED CONCRETE

PROPOSED GRAVEL

PROPOSED PONDING

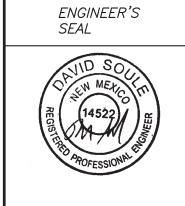

3420 WARD GRADING AND

DRAINAGE PLAN

Rio Grande PO BOX 93924

Lingineering ALBUQUERQUE, NM 87199 (505) 321-9099

8/28/23

P.E. #14522 DAVID SOULE

JOB # 20230045

DRAWN

BY WCWJ

DATE 8-22-23

2102040-LAYOUT-5-27-20

SHEET #

IT SHALL BE THE SOLE RESPONSIBILITY OF THE CONTRACTOR TO CONDUCT ALL NECESSARY FIELD INVESTIGATIONS PRIOR TO ANY EXCAVATION TO DETERMINE THE ACTUAL LOCATION OF UTILITIES & OTHER IMPROVEMENTS.

EXISTING UTILITIES ARE NOT SHOWN.

CAUTION: