



City of Albuquerque

P.O. BOX 1293 ALBUQUERQUE, NEW MEXICO 87103

Ken Schultz
Mayor

UTILITY DEVELOPMENT DIVISION
HYDROLOGY SECTION
(505) 768-2650

January 18, 1988

Charles M. Easterling, P.E.
Easterling & Associates, Inc.
5643 Paradise Boulevard, NW
Albuquerque, New Mexico 87114

RE: REVISED "AS-BUILT" GRADING & DRAINAGE PLAN OF MATTHEW MEADOWS PARK
RECEIVED JANUARY 6, 1988 FOR APPROVAL (G-13/D6A) (W.O. #2861)

Dear Mr. Easterling:

The above referenced submittal, dated January 5, 1988, is approved. Please be advised that all revisions must be provided to this office for review and approval. This plan has been revised three times since the previous approval on December 3, 1986. Your clients need to be aware of this requirement when you are directed to make revisions.

If you have any further questions, call me at 768-2650.

Cordially,

Roger A. Green, P.E.
C.E./Hydrology Section

xc: Dennis Wilkinson, Architect
Sandy Zuschlag, Parks & Rec. Dept.

RAG/bsj




PUBLIC WORKS DEPARTMENT

Walter Nickerson, P.E., City Engineer

ENGINEERING GROUP

Telephone (505) 768-2500

AN EQUAL OPPORTUNITY EMPLOYER

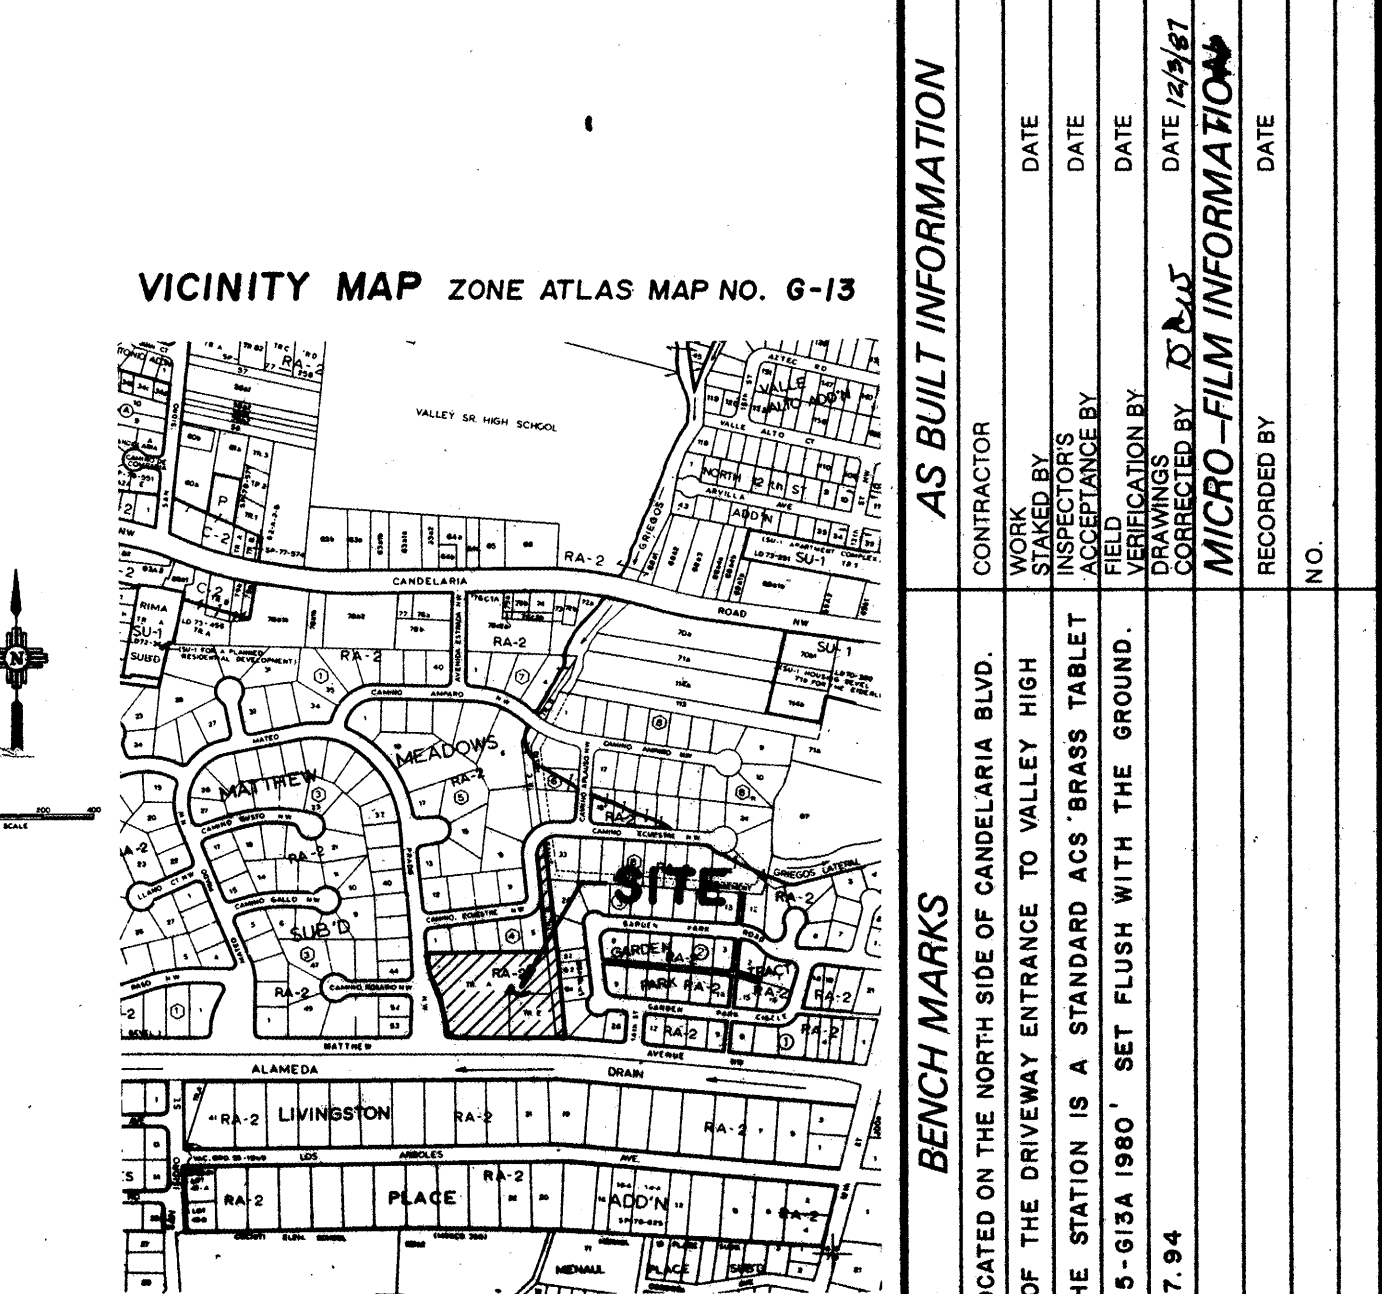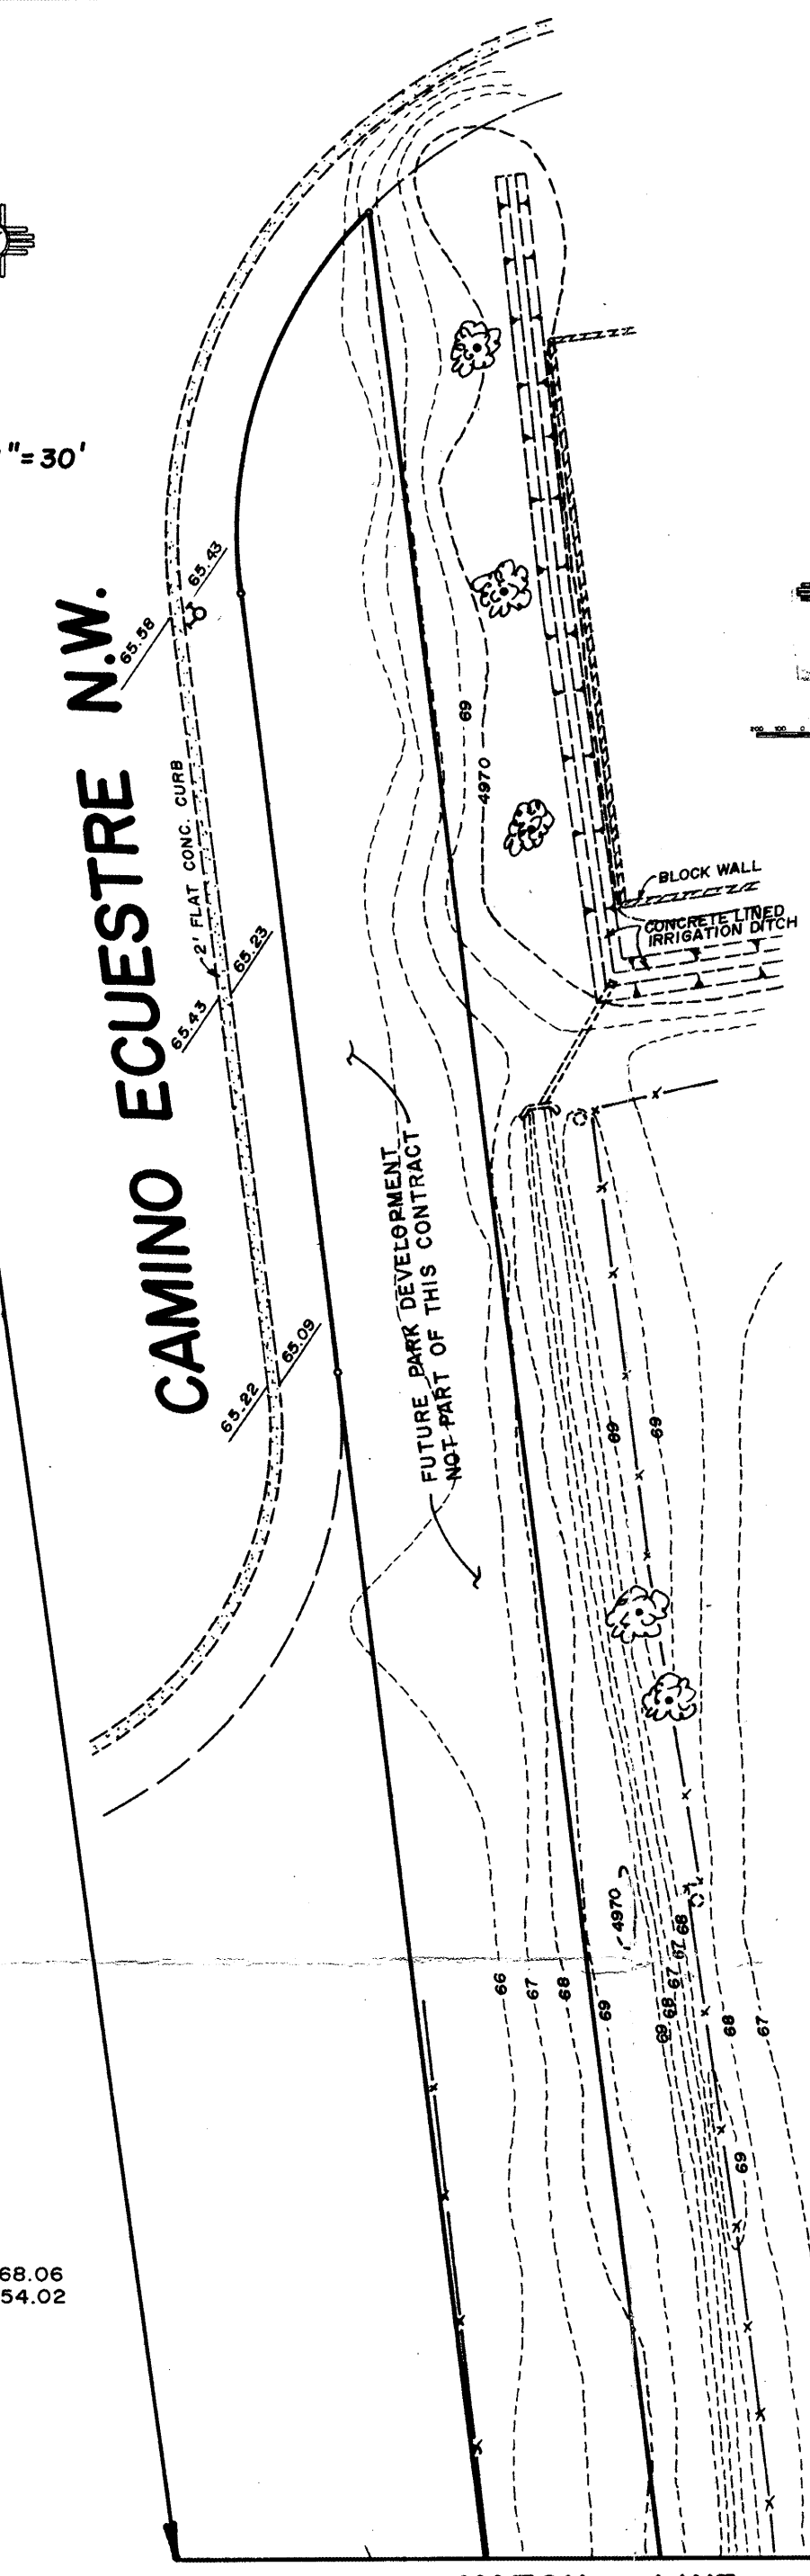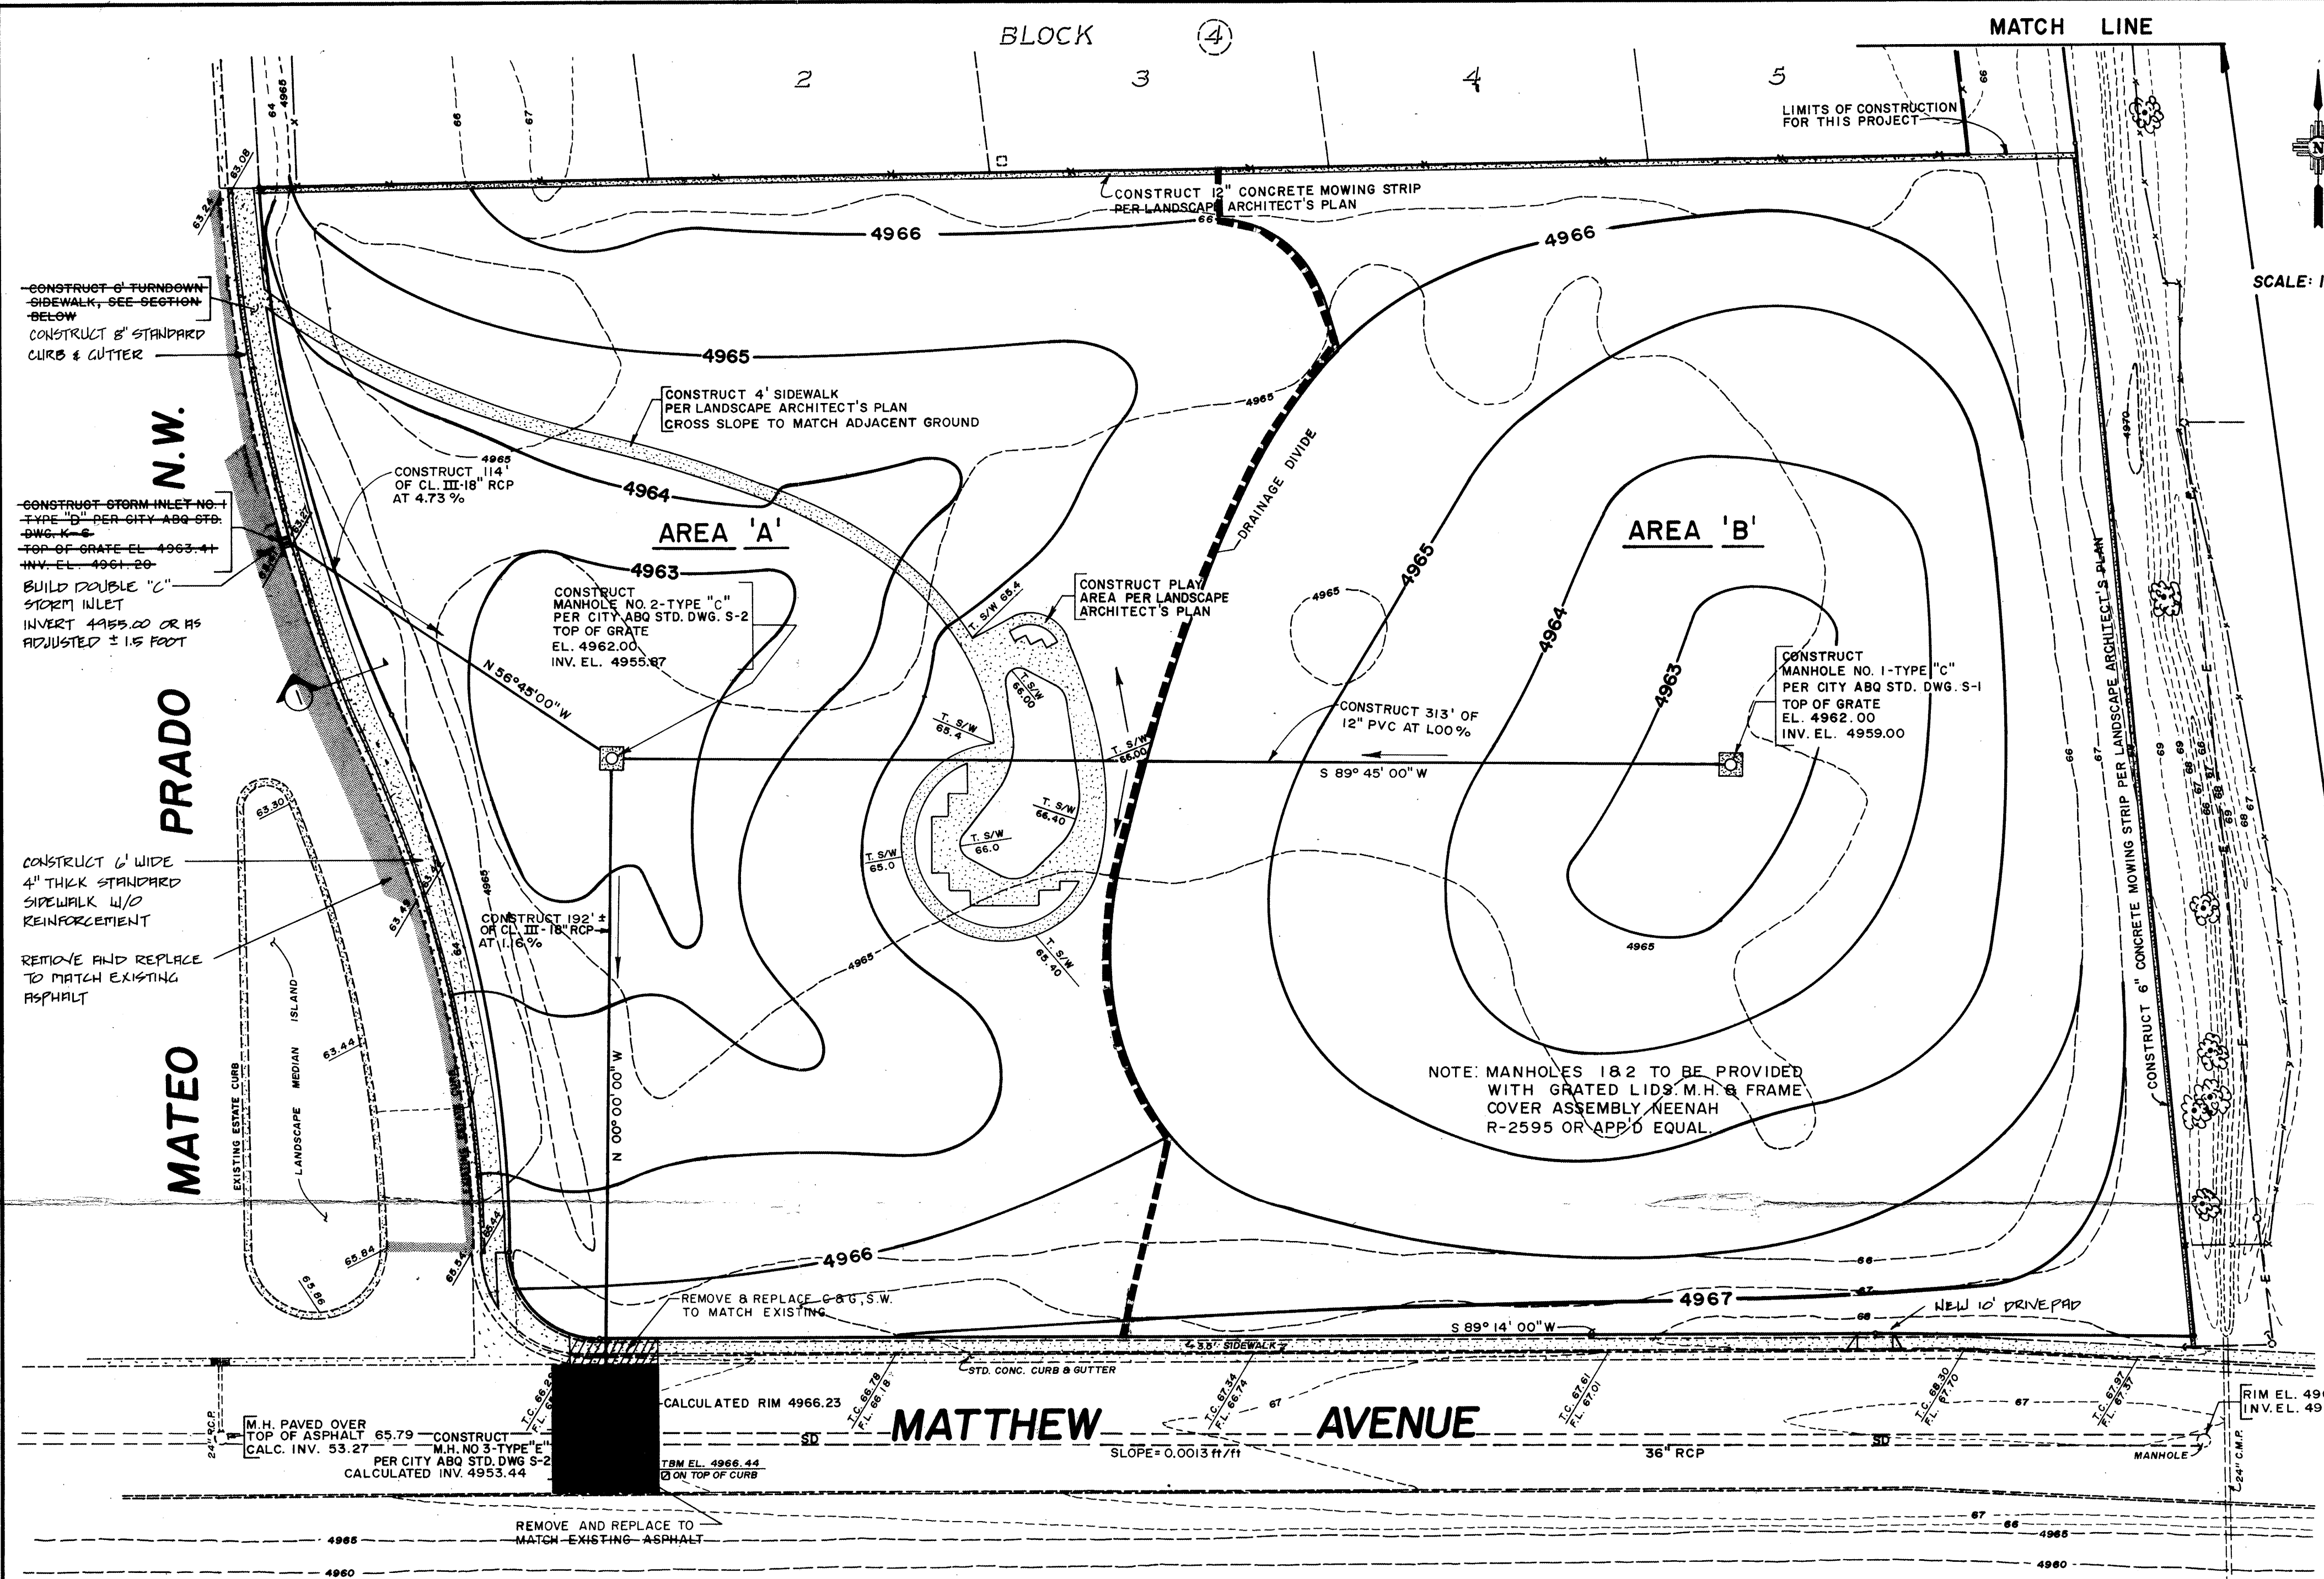



HYDROLOGY														
A.P.	D.A.	H.	S.	L.	Tc	SOIL	%	C.N.	C.	P2	P10	P100	I2	I10
#	AC	FT	FT/FT	FT	MIN	TYPE	IMP		IN	IN	IN	IN	IN/HR	IN/HR
EXISTING	3.6	3.0	.0105	285	3.5	B	0	70	.40	.98	1.4	2.2	2.1	3.1
DEVELOPED	A	1.65	4.0	.0148	270	2.9	B	63	.292	.98	1.4	2.2	2.1	3.1
DEVELOPED	B	1.95	5.0	.0217	230	2.24	B	61	.25	.98	1.4	2.2	2.1	3.1

SOILS INFORMATION FROM SOIL SURVEY, BERNALILLO CO. U.S.D.A., S.C.S.														
DEGREE AND KIND OF LIMITATIONS FOR														
SUITABILITY AS SOURCE OF														
SOIL FEATURES AFFECTING														
HYDROLOGIC SOIL GROUP														
*Gila: GA, GB, GC, GH	Moderate: none	Moderate: seepage	Slight: none	Slight: none	Slight: none	Slight: none	Moderate: low strength	Fair: low strength	Poor: excess fines	Poor: excess fines	Good: none	Seepage: none	Piping: none	B

Gila Series
The Gila series consists of deep, well drained soils that formed in recent alluvium on the flood plains along the Rio Grande and Rio Puerco. Slopes are 0 to 2 percent. The native vegetation is principally alkali sedge, inland saltgrass, vine mesquite, and fourwing saltbush. Elevations range from 4,850 to 6,000 feet. The mean annual precipitation is 7 to 10 inches, the mean annual air temperature is 58° to 60° F, and the frost-free season is 185 to 185 days. Gila soils are associated with Agua, Abasco, Hanta, Vinton, and Brazito soils.

In a representative profile the surface layer is brown loam about 7 inches thick. Next is about 37 inches of stratified brown and light yellowish brown very fine sandy loam and sandy loam. Below this to a depth of 60 inches or more is pale brown sand. The soil is moderately alkaline throughout. Permeability is moderate. Available water capacity is 8 to 11 inches. Effective rooting depth is about 60 inches. Gila soils are used for irrigated alfalfa, row crops, and pasture. They are also used for range, wildlife habitat, watershed, and community development.

Ge-Gila clay loam. This level soil is in the irrigated Rio Grande Valley. It has a profile similar to that described as representative of the series, but the surface layer differs in texture and is about 10 inches thick. In about 1 percent of the mapped area this soil is moderately saline, and in about 0.5 percent it is moderately alkali affected. Slopes are 0 to 1 percent. Included with this soil in mapping are small areas of a Gila soil that has a sandy clay loam surface layer and areas of Brazito fine sandy loam. Turnoff is slow, and the hazard of water erosion is slight. This soil is used for irrigated alfalfa, row crops, and pasture. It is also used for wildlife habitat and community development. Irrigated capability unit I.

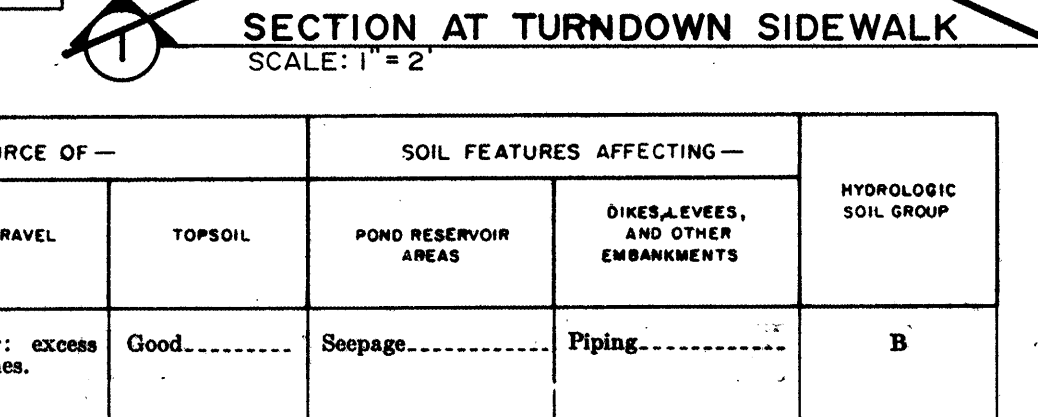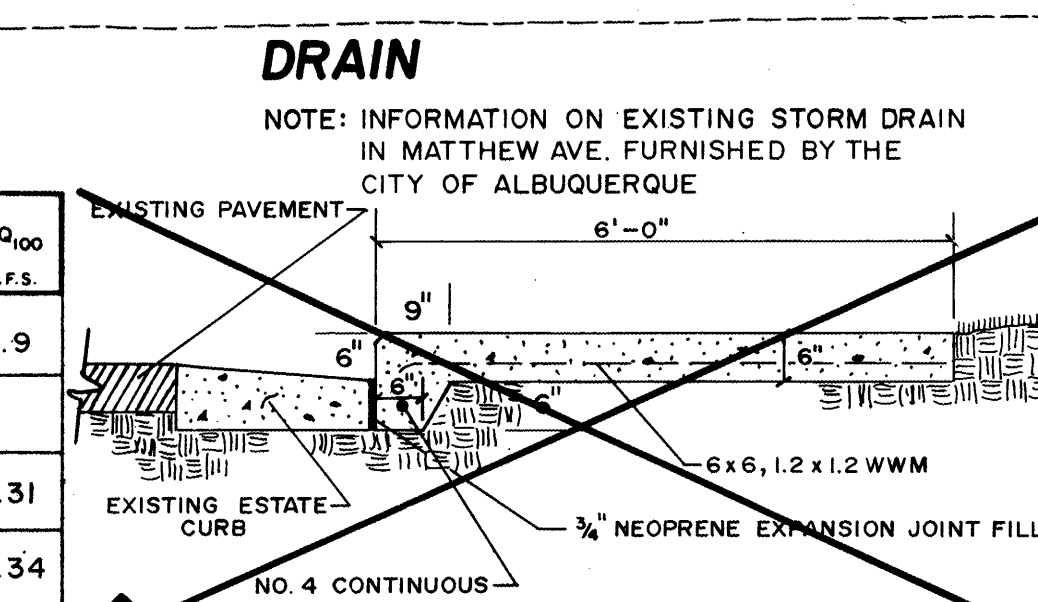

APPROVED FOR DRAINAGE
1-18-88
DATE
Signature: [Signature]
TITLE: [Title]

- NOTES**
1. AN EXCAVATION/CONSTRUCTION PERMIT WILL BE REQUIRED BEFORE BEGINNING ANY WORK WITHIN CITY RIGHT-OF-WAY. AN APPROVED COPY OF THESE PLANS MUST BE SUBMITTED AT THE TIME OF APPLICATION FOR THIS PERMIT.
 2. ALL WORK DETAILED ON THESE PLANS TO BE PERFORMED, EXCEPT AS OTHERWISE STATED OR PROVIDED HEREON, SHALL BE CONSTRUCTED IN ACCORDANCE WITH THE "CITY OF ALBUQUERQUE INTERIM STANDARD SPECIFICATIONS FOR PUBLIC WORKS CONSTRUCTION - 1988 EDITION," CORRECTED FOR GENERAL CONSTRUCTION.
 3. TWO WORKING DAYS PRIOR TO ANY EXCAVATION, CONTRACTOR MUST CONTACT LINE LOCATING SERVICE, 765-1234, FOR LOCATION OF EXISTING UTILITIES.
 4. PRIOR TO CONSTRUCTION, THE CONTRACTOR SHALL EXCAVATE AND VERIFY THE HORIZONTAL AND VERTICAL LOCATIONS OF ALL OBSTRUCTIONS. SHOULD A CONFLICT EXIST, THE CONTRACTOR SHALL NOTIFY THE ENGINEER SO THAT THE CONFLICT CAN BE RESOLVED WITH A MINIMUM AMOUNT OF DELAY.
 5. BACKFILL COMPACTION SHALL BE ACCORDING TO ARTERIAL STREET USE.
 6. MAINTENANCE OF THE FACILITIES SHALL BE THE RESPONSIBILITY OF THE OWNER OF THE PROPERTY SERVED.
 7. ALL UTILITIES AND UTILITY SERVICE LINES SHALL BE INSTALLED PRIOR TO PAVING.
 8. DISPOSAL OF ALL WASTE MATERIAL SHALL BE THE RESPONSIBILITY OF THE CONTRACTOR AS SPECIFIED IN SECTION 1-1.4 OF THE GENERAL CONDITIONS IN THE CITY OF ALBUQUERQUE INTERIM STANDARD SPECIFICATIONS FOR PUBLIC WORKS CONSTRUCTION - 1988 EDITION.
 9. ALL CONCRETE SUPPORTED PAVEMENT SHALL BE CONSTRUCTED ACCORDING TO THE CITY OF ALBUQUERQUE INTERIM STANDARD SPECIFICATIONS FOR PUBLIC WORKS CONSTRUCTION - 1988 EDITION.
 10. OWNERSHIP OF DOCUMENTS: THIS DOCUMENT, AND THE IDEAS AND DESIGNS INCORPORATED HEREIN, AS AN INSTRUMENT OF PROFESSIONAL SERVICE, IS THE PROPERTY OF EASTERLING & ASSOCIATES, INC. AND IS NOT TO BE USED, IN WHOLE OR IN PART, FOR ANY OTHER PROJECT WITHOUT THE WRITTEN AUTHORIZATION OF EASTERLING & ASSOCIATES, INC.
 11. CONSTRUCTION SAFETY: THESE DRAWINGS DO NOT INCLUDE NECESSARY COMPONENTS FOR CONSTRUCTION SAFETY WHICH SHALL REMAIN THE CONTRACTOR'S RESPONSIBILITY.
 12. EROSION CONTROL: THE SITE WILL BE FULLY DEVELOPED IMMEDIATELY. EROSION PROBLEMS GENERATED BY PHASES OF DEVELOPMENT WILL NOT, THEREFORE, BE A PROBLEM.
 13. CONSTRUCTION PHASE: THE CONTRACTOR SHALL EXERCISE REASONABLE CARE DURING CONSTRUCTION TO PREVENT THE MOVEMENT OF SEDIMENT FROM THE SITE INTO THE STREET. LOOSE SOIL STOCKPILES IN THE STREET DURING UTILITY CONNECTION ACTIVITIES SHALL BE PROTECTED FROM BEING CARRIED DOWNSTREAM BY FLOWING WATER IN THE STREET.

CITY OF ALBUQUERQUE
PARKS & RECREATION DEPARTMENT
DESIGN & DEVELOPMENT DIVISION

MATTHEW MEADOWS PARK
Grading & Drainage Plan

APPROVALS	ENGINEER	DATE	APPROVALS	ENGINEER	DATE
City Engineer			Liquid Waste		
A.C.E. Design			Traffic		
A.C.E. Hydrology			Water		

DRAWING NO. 2001 MAP NO. 6-13-210 SHEET 2 OF 1

ENGINEER'S SEAL
EASTERLING & ASSOCIATES
ALBUQUERQUE, NEW MEXICO

REVISIONS

NO.	DATE	REVISIONS
1	1-18-88	GENERAL REVISIONS, NOTES ETC.
2	7-16-87	REVISIONS

AS BUILT INFORMATION

CONTRACTOR	DATE
5-013A - LOCATED ON THE NORTH SIDE OF CANDELARIA BLVD. <td></td>	
6-4 - EAST OF THE DRIVEWAY ENTRANCE TO VALLEY HIGH SCHOOL. THE STATION IS A STANDARD ACS BRASS TABLET <td></td>	
STAMPED '5-013A 1980' SET FLUSH WITH THE GROUND. <td></td>	
ELEV. 4987.94 <td></td>	

MICRO-FILM INFORMATION

RECORDED BY	DATE