

# CITY OF ALBUQUERQUE



Richard J. Berry, Mayor

April 6, 2017

Shawn Biazar  
SBS Construction and Engineering, LLC  
10209 Snowflake Ct. NW  
Albuquerque, NM, 87114

**RE: Commercial & Apartment Building – Phase II  
Grading Plan  
Stamp Date: 3/12/17  
Hydrology File: G14D066**

Dear Mr. Biazar:

PO Box 1293

Based upon the information provided in your submittal received 4/3/2017, the Grading Plan is approved for Building Permit.

Albuquerque

If you have any questions, please contact me at 924-3995 or [rbrissette@cabq.gov](mailto:rbrissette@cabq.gov).

New Mexico 87103

Sincerely,

*Renee C. Brissette*

[www.cabq.gov](http://www.cabq.gov)

Reneé C. Brissette, P.E.  
Senior Engineer, Hydrology  
Planning Department


DRAINAGE MANAGEMENT PLAN

INTRODUCTION  
The purpose of this submittal is to provide a final drainage management plan for the PHASE II of 4419 4th St NW, located at the SWC of 4th St NW and Freeman Ave NW in Albuquerque, NM. The site contains approximately 1.16 acres. A grading and drainage plan was submitted for the Phase I and was approved by Hydrology Department (G14D066).

EXISTING HYDROLOGIC CONDITIONS  
The Phase I is already constructed and all the ponds are built. The grades shown here are as-built grades for the site. All the curb and gutter and asphalt are existing. Phase II on the original plan was shown as just dirt and it was draining to pond B. All the calculation was shown on Phase I grading plan.

PROPOSED HYDROLOGIC CONDITIONS  
The proposed drainage patterns remain the same as original approved grading plan. However the impervious area has changed a little and also pond B was modified to accommodate the foot print of building on Phase II. Please see the ponding calculation and revised Pond B.

FIRST FLUSH CALCULATIONS  
Per the First Flush Calculations on this sheet, the total First Flush Volume required to be collected for the site is 1,258 CF. Per the Water Harvesting Pond Calculations table this sheet, we are actually retaining 3,870.50 CF of flow from the site which is just over 3 times the quantity required.

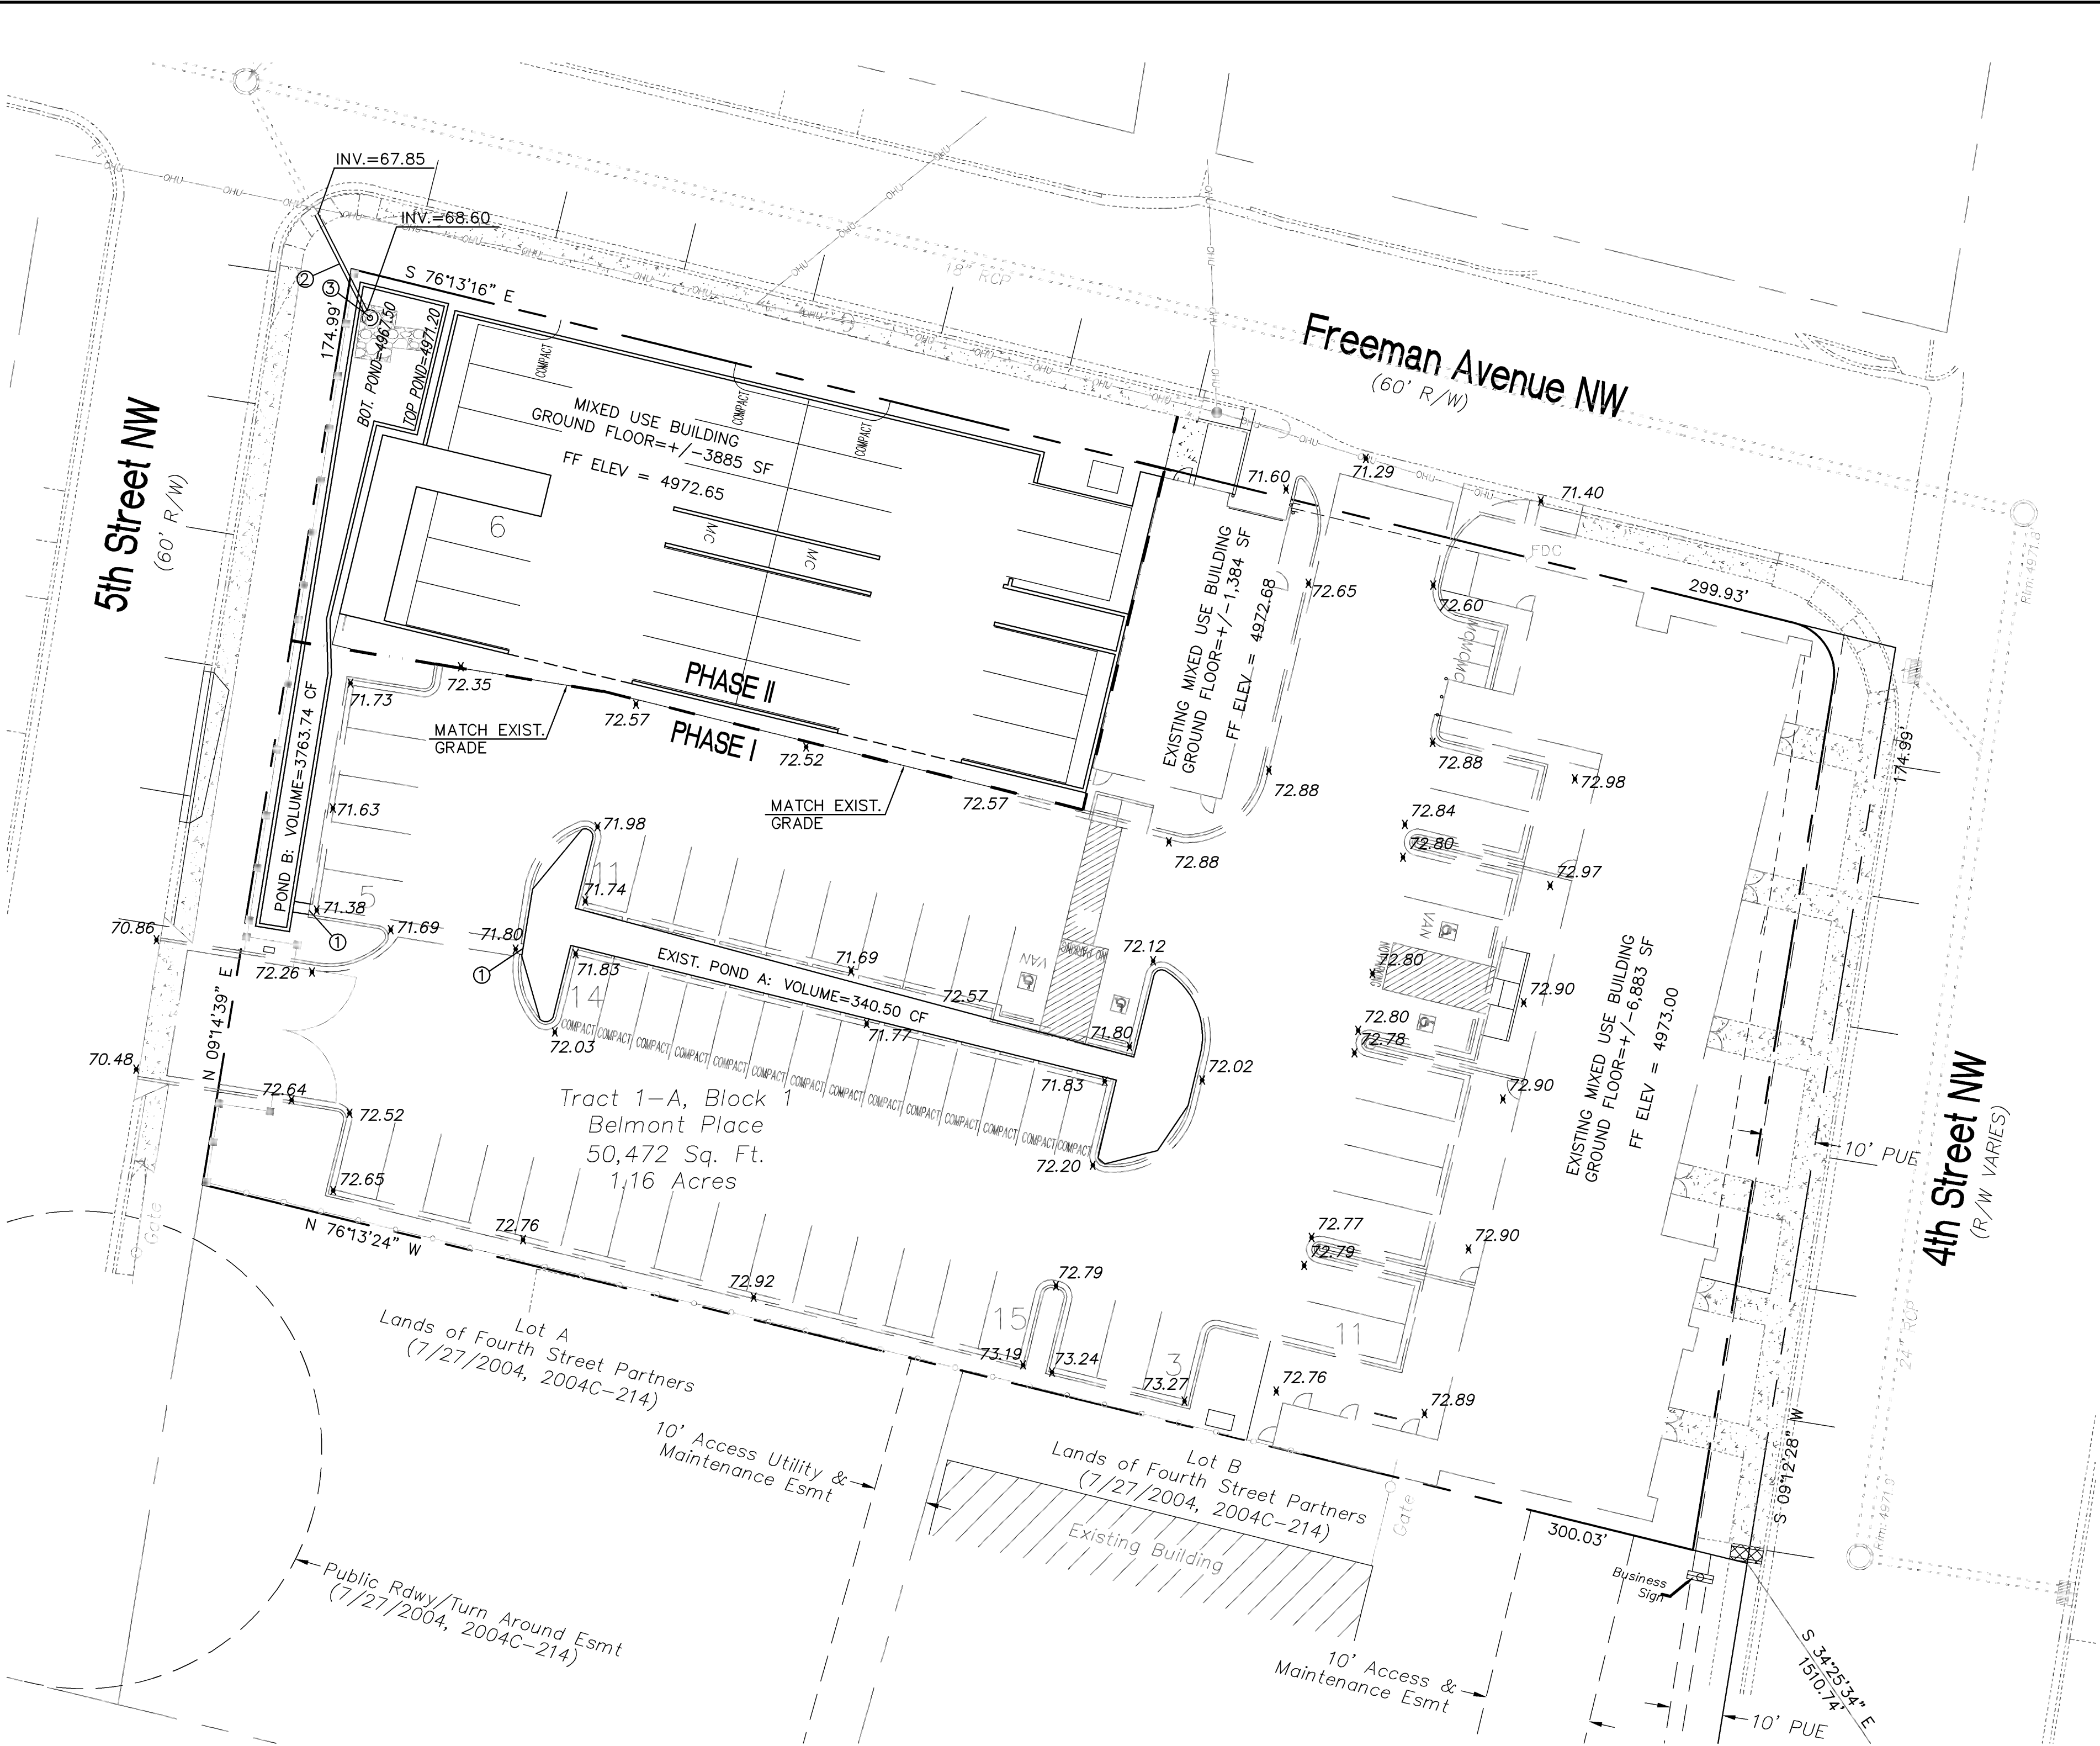

VICINITY MAP:  
LEGAL DESCRIPTION:  
TRACT 1-A, BLOCK 1, BELMONT PLACE  
CONTAINING 60,306.32 S.F. ( 1.16 ACRE ).  
ZONING: SU-2 NFMX

- GENERAL NOTES:
- 1: CONTOUR INTERVAL IS HALF (1.00) FOOT.
  - 2: UTILITIES SHOWN HEREON ARE IN THEIR APPROXIMATE LOCATION BASED ONLY ON ABOVE GROUND EVIDENCE FOUND IN THE FIELD AND AS-BUILT INFORMATION PROVIDED BY THE CLIENT. UTILITIES SHOWN HEREON, WHETHER INDICATED AS ABANDONED OR NOT, SHALL BE VERIFIED BY OTHERS FOR EXACT LOCATION AND/ OR DEPTH PRIOR TO EXCAVATION OR DESIGN CONSIDERATIONS.
  - 3: THIS IS NOT A BOUNDARY SURVEY, BEARINGS ARE ASSUMED, DISTANCES AND FOUND PROPERTY CORNERS ARE FOR INFORMATIONAL PURPOSES ONLY.
  - 4: SLOPES ARE AT 3:1 MAXIMUM.

LEGEND	
	EXISTING CONTOUR (MAJOR)
	EXISTING CONTOUR (MINOR)
	BOUNDARY LINE
	PROPOSED SPOT ELEVATION
	EXISTING GRADE
	EXISTING FLOWLINE ELEVATION
	PROPOSED RETAINING WALL
	BOTTOM OF CHANEL
	TOP OF CURB
	TOP OF ASPHALT
	HIGH POINT
	AS-BUILT GRADES
	AS-BUILT SPOT ELEVATIONS

POND VOLUME REQUIRED  
TOTAL PONDING VOLUME REQUIRED (90TH PERCENTILE/FIRST FLUSH) = 0.34 INCHES x IMPERVIOUS AREA = (0.34/12 x 44,396.00) = 1,257.89 CF

POND CALCULATION  
TOTAL POND AREA PROVIDED =  
PONDING CALCULATIONS:


POND A VOLUME FROM PHASE I= 340.50 CF

POND B: AREA @ TOP = 1,017.20, AREA @ BOTTOM = 1,017.20  
POND VOLUME = (1,017.20+1,017.20)/2\*3.70 = 3,763.64 CF


TOTAL POND VOLUME PROVIDED = 4,104.14 CF

NOTES:

1. EXISTING 12" CURB OPENNING.
2. EXIST. 12" STORM DRAIN PIPE.
3. EXIST. 8" QUICK DRAIN INLET, INV.=68.60, TOP OF QUICK DRAIN INLET=4971.25'.

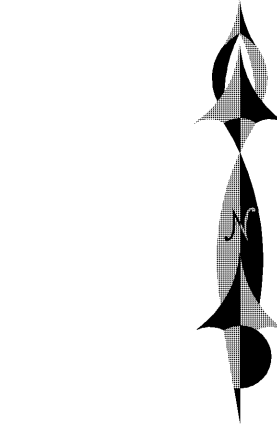

GRAPHIC SCALE

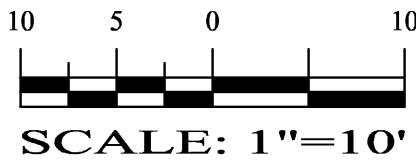

REZA AFGHPOUR  
P.E. #11814

SBS CONSTRUCTION  
AND ENGINEERING, LLC

10209 SNOWFLAKE CT., NW  
ALBUQUERQUE, NEW MEXICO 87114  
(505)899-5570

COMMERCIAL & APARTMENT BUILDING PHASE II  
4419 4TH ST., NW., ALBUQUERQUE, NM 87107  
GRADING PLAN

DRAWING:	DRAWN BY:	DATE:	SHEET #
201601-ST.DWG	SH-B	03-12-2017	1