

CITY OF ALBUQUERQUE



July 21, 2017

Joseph J. Casares, Jr., P.E.
JCII Group, LLC
7225 Arenoso Pl NW
Albuquerque, NM, 87120

**RE: Patz Warehouse
Grading and Drainage Plan
Engineer's Stamp Date 11-1-2016 (File: G14D088)**

Dear Mr. Casares,

Based upon the information provided in your submittal received 7/21/2017, the above referenced Certification received is acceptable for the release of Certificate of Occupancy by Hydrology.

PO Box 1293

If you have any questions, you can contact me at 924-3995 or Totten Elliott at 924-3982.

Albuquerque

Sincerely,


New Mexico 87103

Renee Brissette, P.E.
Senior Engineer, Hydrology
Development and Review Services

www.cabq.gov

TE/RB

C: email Serna, Yvette; Fox, Debi; Tena, Victoria; Sandoval, Darlene M.

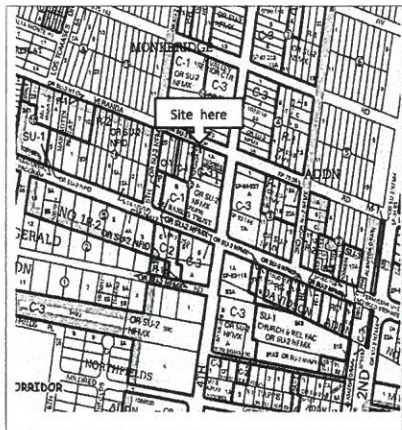

LOCATION MAP

SCALE: 1" = 1000'

ZONE ATLAS MAP G-14-Z

FERMette # 35001C0332G ZONE X PROTECTED BY LEVEE

Patz's Warehouse/Apartment

406 Veranda Rd N.W.

Engineer: Logan Patz EIT

I. EXECUTIVE SUMMARY

THIS PLAN SERVES TO SUPPORT THE PROPOSED DEVELOPMENT FOR LOGAN PATZ. THE SITE IS LOCATED IN THE CITY OF ALBUQUERQUE AND IS LOT: 18 BLOCK: 17 SUBDIVISION: MONKBRIDGE. THE SUBDIVISION IS LOCATED OFF THE FOURTH STREET CORRIDOR NORTH OF 140. THE SITE ADDRESS IS 406 VERANDA RD. THE PROPOSED CONSTRUCTION CONSISTS OF A NEW BUILDING, UTILITIES, GRADING IMPROVEMENTS, PARKING LOT, WALKWAYS, LANDSCAPING AND OTHER AMENITIES AS REQUIRED FOR A FULLY FUNCTIONAL SITE. OFF-SITE CONSTRUCTION WILL INCLUDE SIDEWALK, AND DRIVE PAD. MOST LOTS IN THE SUBDIVISION ARE DEVELOPED INCLUDING THE LOTS SURROUNDING THIS LOT. THE LOTS TO THE SOUTH AND WEST ARE SEPARATED BY CINDERBLOCK WALLS AND THE LOT TO THE EAST IS SEPARATED BY A RAISED 6 INCH CURB. ALSO STREET PAVEMENT, CURB AND GUTTER, PUBLIC UTILITIES ARE IN PLACE. DUE TO THESE DEVELOPMENTS, OFF-SITE STORM WATER SHOULD NOT IMPACT THIS SITE. IT IS PROPOSED THAT STORMWATER GENERATED ON-SITE WILL BE CAPTURED IN RETENTION BASINS ON-SITE TO THE REQUIRED FIRST 0.5 INCH OF RUNOFF AS ALLOWED IN THE AMENDMENTS TO THE DEVELOPMENT PROCESS MANUAL (DPM) SECTION 4, 22.4.3.

II. PROJECT DESCRIPTION

AS SHOWN ON THE LOCATION MAP THE SITE (10,200 SF = APPROXIMATELY 0.23 ACRES) IS LOCATED IN THE CITY OF ALBUQUERQUE AT 406 VERANDA RD. CURRENTLY THE SITE IS UNDEVELOPED.

III. EXISTING CONDITIONS

CURRENTLY THE SITE IS UNDEVELOPED, THERE IS VERY LITTLE TO NO VEGETATION ON THE PROJECT SITE. THE STORMWATER IS CURRENTLY RETAINED ONSITE WHERE THE OLD STRUCTURES WERE REMOVED.

IV. DEVELOPED CONDITIONS

THE PROPOSED ON-SITE CONSTRUCTION CONSISTS OF A NEW BUILDING, UTILITIES, GRADING AND DRAINAGE IMPROVEMENTS, PARKING LOT, WALKWAYS, LANDSCAPING AND OTHER AMENITIES. OFF-SITE CONSTRUCTION WILL INCLUDE SIDEWALK AND DRIVE PAD. IT IS PROPOSED THE STORMWATER GENERATED ON-SITE WILL BE CAPTURED ON-SITE IN THE GRADED RETENTION BASINS. STORMWATER BEYOND THE CHANNELS CAPACITY WILL CONVEY FROM THE DRIVE PAD TO THE STREET.

V. EROSION CONTROL

CURRENTLY NO HARD SURFACES EXIST AT THE SITE. AFTER DEVELOPMENT APPROXIMATELY 69.2% OF THE SITE WILL BE MADE-UP OF ASPHALT AND ROOFTOP. THE PROPOSED CONSTRUCTION WILL INCREASE THE AMOUNT OF IMPERVIOUS AREA. PERMANENT EROSION CONTROL IN THE CHANNELS WILL CONSIST OF VEGETATION AND COBBLE STONE.

VI. WATER QUALITY ENHANCEMENTS

WATER QUALITY ENHANCEMENTS PROPOSED ARE TO RETAIN THE FIRST 0.5 INCH OF A RAIN EVENT ON-SITE AND THE DUMPSTER PAD WILL DRAIN INTO THE WEST POND.

VII. GRADING PLAN

THE GRADING PLAN SHOWS:

1. EXISTING SPOT ELEVATIONS AS TAKEN FROM A RECENT TOPOGRAPHY WITH AN ASSUMED ELEVATION OF 4962.40' AT THE 3/4" ROD FOUND AT THE EAST PROPERTY LINE 90' FROM THE NORTHEAST CORNER.
2. THE PROPOSED GRADES INDICATED BY SPOT ELEVATIONS AND CONTOUR LINES
3. THE LIMITS AND CHARACTER OF THE EXISTING FEATURES
4. THE LIMITS AND CHARACTER OF THE PROPOSED IMPROVEMENTS
5. CONTINUITY BETWEEN EXISTING AND PROPOSED GRADES

IIIIV. CALCULATIONS

THE CALCULATIONS HEREON ANALYZE THE HYDROLOGY FOR THE EXISTING AND DEVELOPED CONDITIONS UPON A 100 YEAR, 24-HOUR RAINFALL EVENT. PROCEDURE FOR 40 ACRES AND SMALLER BASIN, AS SET FORTH IN CHAPTER 22 OF THE DEVELOPMENT PROCESS MANUAL (DPM). VOLUME II, 2015 REVISIONS WAS USED TO QUANTIFY THE PEAK RATE OF DISCHARGE (Q) AND VOLUME (V) OF ON-SITE STORMWATER RUN-OFF. ALL DATA UTILIZED CAN BE FOUND BELOW.

HYDROLOGY ANALYSIS FOR PEAK RATE OF DISCHARGE (Q) AND PEAK VOLUME (V):

SITE CHARACTERISTICS:

DRAINAGE AREA = [SEE PRE AND POST -DEVELOPMENT MAP]

LAND TREATMENT (DPM CH. 22, TABLE A-4)

IMPERVIOUS = D

PERVIOUS = C

PRECIPITATION ZONE = 2 (DPM CH. 22, TABLE A-1)

(Q) = CIA = 100-YR, PEAK DISCHARGE FOR ZONE 2; (TAKEN FROM CHAPTER 22 OF THE DPM VOLUME II TABLE A-11 AND A-10)

PERVIOUS IMPERVIOUS

C = 0.62 C = 0.93

I = 5.05 I = 5.05

100-YR., 24-HOUR VOLUME (V) =

[6-HOUR VOL. +IMPERVIOUS AREA]*[24-HOUR RECIP. - 6 HOUR PRECIP.]

12 IN/FT

FOR ZONE 2:

6 HOUR VOL. = (WEIGHTED EXCESS PRECIPITATION)*(LAND TREATMENT) EXCESS PRECIPITATION FOR 100-YR. 6-HOUR STORM CAN BE FOUND IN TABLE A-8 OF DPM. CH 22.

24-HOUR PRECIPITATION = 2.75 (DPM CH. 22, TABLE A-2)

6-HOUR PRECIPITATION = 2.35 (DPM CH. 22, TABLE A-2)

DRAINAGE AREA - PRE-DEVELOPMENT

10,200 SF = 100% PERVIOUS

ANALYSIS RESULTS

Q = 0.74 CFS (100 YR)

V = 960 CF (100 YR)

DRAINAGE AREA - POST-DEVELOPMENT

3,262.64 SF ROOF RAIN WATER VOLUME WILL BE HARVESTED ON-SITE
Therefore, (10,200 SF - 3,262.64 SF = 6,937.36 SF ~ 0.159 ac)

(10,200 - 3,140 - 3,262.64) = 3,797.36 SF = 54.74% IMPERVIOUS

3,140 SF = 45.26% PERVIOUS

ANALYSIS RESULTS

Q = 0.64 CFS ≤ 0.64 CFS (2.75 CFS/ACRE)

V = 965 CF (576.71 CF WILL BE RETAINED ON-SITE)

HYDRAULIC ANALYSIS FOR CAPACITY (Q) OF SITE DRAINAGE AMENITIES:

STEEL ROOF DRAIN CAPACITY (Q):

PIPE ROUGHNESS (n) = 0.012

PIPE FLOW AREA (A) = 0.196 sf

HYDRAULIC RADIUS (R) = 0.148 ft.

PIPE SLOPE (S) = .0208 ft./ft. (MIN)

Q = (1.49/n)[A](R^0.667)(S^0.5) = 0.98 cfs

RETENTION PONDS AND CHANNEL VOLUME (V) CALCULATIONS:

ALL RETENTION AREAS DESIGNED WITH SLOPE LESS THAN 2H:1V SIDE SLOPES. THE TOTAL VOLUMES ARE CALCULATED AS FOLLOWS;

WEST POND, POLYGONAL CHARACTERISTICS:

BOTTOM PERIMETER AREA = 0.73 SF

TOP PERIMETER AREA = 78.90 SF

DEPTH = 2.0'

V = (1/2)[(78.90 SF + 0.73 SF)(2.0 FT)] = 79.6 CF

WEST CHANNEL: PYRAMID METHOD

NORTHWEST AREA = 2.88 SF

LENGTH ~ 40.6 FT, DEPTH 1.2 FT, WIDTH 4.8 FT

V = [(2.88)(40.6)]/3 = 39 CF

EAST CHANNEL: AVERAGE END AREA METHOD

NORTHWEST, WEST END AREA = 7.5 SF

NORTHWEST, EAST END AREA = 4.8 SF

LENGTH = 20 FT, DEPTHS 1.5' & 1.2, WIDTH 10' & 8'

V = [(7.5 + 4.8)/2](20) = 123 CF

NORTHEAST, NORTH END AREA = 4.8 SF

NORTHEAST, SOUTH END AREA = 1 SF

LENGTH = 110', DEPTHS 1.2' & 0.5' WIDTHS 8' & 4'

V = [(4.8 + 1)/2](45) = 130.5 CF

SOUTHEAST, NORTH END AREA = 1 SF

SOUTHEAST, SOUTH END AREA = 0.08 SF

LENGTH = 110 FT, DEPTH 0.5' & 0.2' WIDTH 4' & 0.4'

V = [(1 + 0.08)/2](110) = 59.4 CF

SOUTHWEST, WEST END AREA = 4.4 SF

SOUTHWEST, EAST END ARE = 4.4 SF

LENGTH = 33 FT, DEPTH 1.0', WIDTH 8.8'

V = [(4.4+4.4)/2](33) = 145 CF

TOTAL RETENTION VOLUME:

[79.6 + 39 + 123 + 130.5 + 59.4 + 145.2] = 576 CF

2 Rain Barrels = 24 CF Storage

IX. STORM WATER CONTROL MEASURES

TO MANAGE THE FIRST 1/4" OF RUN-OFF IN ORDER TO PREVENT A CONCENTRATION OF POLLUTANTS FROM RUNNING OFF-SITE A RETENTION CHANNEL IS PROPOSED ON-SITE. THE VOLUME OF SAID RETENTION CHANNEL IS AS FOLLOWS:

FIRST 1/4" VOL. = SITE AREA X 0.5 INCHES = 425 CF


RETENTION = 576 CF

425 CF (FIRST 1/4") - 576 CF (RETENTION) ≤ 0 (FIRST 1/4" MET)

THE DUMPSTER PAD WILL DRAIN INTO THE WEST POND AREA.

X. CONCLUSION


THIS PLAN SUPPORTS THE PROPOSED DEVELOPMENT. THE PROPOSED STORM DRAINAGE FACILITIES WILL ADEQUATELY RETAIN AND CONVEY STORMWATER GENERATED ON-SITE BY A 100 YEAR, 24-HOUR STORM EVENT. ALSO, IF CONSTRUCTED IN ACCORDANCE WITH THE ASSOCIATED GRADING AND DRAINAGE PLAN, THE SITE HYDRAULICS WILL RETAIN 576.71 CF OF STORMWATER RUN OFF ON-SITE. THIS IS MORE THAN THE REQUIRED RETENTION OF THE FIRST 0.5 INCH OF RAINFALL TO BE CAPTURED IN THE VALLEY AND FLOWS ARE AT 0.635 CFS LESS THAN THE 2.75 CFS/ACRE.

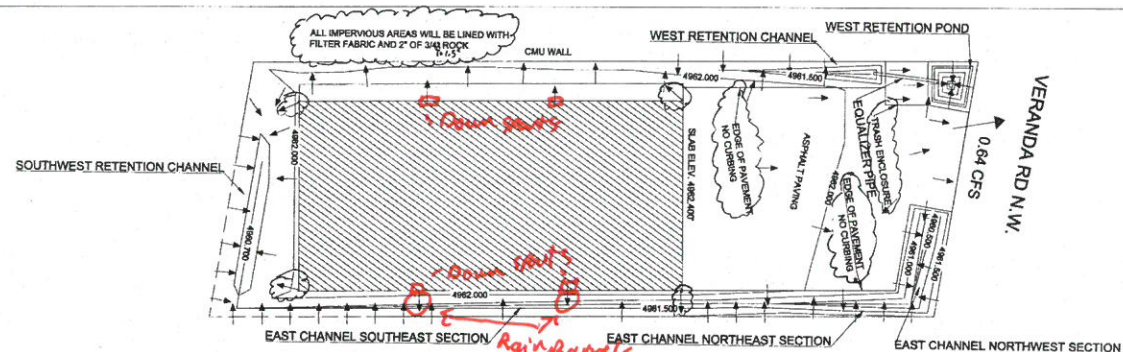

DRAINAGE AREA POST-DEVELOPMENT

MAP SCALE 1" = 20'

NOTE:
ROOF WATER IS
HARVESTED ON-SITE
FROM THE 4
DOWNSPOUTS TO THE
CHANNELS

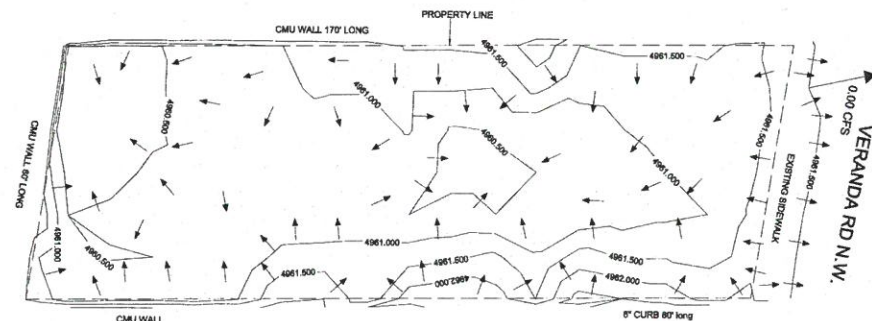

DRAINAGE AREA PRE-DEVELOPMENT

MAP SCALE 1" = 20'

DRAINAGE CERTIFICATION

I, Logan Patz, NMPE 24201, OF THE FIRM Patz Storage, HEREBY CERTIFY THAT THIS PROJECT HAS BEEN GRADED AND WILL DRAIN IN SUBSTANTIAL COMPLIANCE WITH AND IN ACCORDANCE WITH THE DESIGN INTENT OF THE APPROVED PLAN DATED 11-09-16. THE RECORD INFORMATION EDITED ONTO THE ORIGINAL DESIGN DOCUMENT HAS BEEN OBTAINED BY ME OR UNDER MY DIRECT SUPERVISION AS SUPPLEMENTAL DATA TO THE ORIGINAL TOPOGRAPHIC SURVEY PREPARED BY LOGAN PATZ PE AND IS TRUE AND CORRECT TO THE BEST OF MY KNOWLEDGE AND BELIEF. THIS CERTIFICATION IS SUBMITTED IN SUPPORT OF A REQUEST FOR Certificate of Occupancy.

- Two down spouts have been added to the east and west side of the building.
- Two 90-Gallon Rain barrels have been added to the West downspouts.

THE RECORD INFORMATION PRESENTED HEREON IS NOT NECESSARILY COMPLETE AND INTENDED ONLY TO VERIFY SUBSTANTIAL COMPLIANCE OF THE GRADING AND DRAINAGE ASPECTS OF THIS PROJECT. THOSE RELYING ON THIS RECORD DOCUMENT ARE ADVISED TO OBTAIN INDEPENDENT VERIFICATION OF ITS ACCURACY BEFORE USING IT FOR ANY OTHER PURPOSE.

Logan Patz
Logan W. Patz, NMPE 24201

07-21-17
DATE



PATZ - WHAREHOUSE/APPARTMENT
406 VERANDA RD N.W.
DATE: 08-08-2016
PROJECT #: 2016-00557

GRADING & DRAINAGE GENERAL NOTES

1. ALL WORK DETAILED ON THESE PLANS TO BE PERFORMED UNDER THIS CONTRACT. EXCEPT AS OTHERWISE STATED OR PROVIDED FOR HEREON, SHALL BE CONSTRUCTED IN ACCORDANCE WITH THE PROJECT SPECIFICATIONS, AND THE CITY OF ALBUQUERQUE SPECIFICATIONS
2. TWO (2) WORKING DAYS PRIOR TO ANY EXCAVATION, CONTRACTOR MUST CONTACT NEW MEXICO ONE CALL SYSTEM (250-1990), FOR LOCATION OF EXISTING UTILITIES CONTRACTOR IS RESPONSIBLE FOR ANY DAMAGE TO EXISTING UTILITIES.
3. PRIOR TO CONSTRUCTION, THE CONTRACTOR SHALL EXCAVATE AND VERIFY THE HORIZONTAL AND VERTICAL LOCATION OF ALL UTILITIES AND OBSTRUCTIONS. SHOULD A CONFLICT EXIST, THE CONTRACTOR WILL NOTIFY THE OWNER IMMEDIATELY SO THAT THE CONFLICT CAN BE RESOLVED WITH A MINIMUM AMOUNT OF DELAY. THIS WORK IS CONSIDERED INCIDENTAL TO THE PROJECT AND NO DIRECT PAYMENT WILL BE MADE THEREFOR.
4. ALL EXCAVATION SHALL BE GOVERNED BY FEDERAL, STATE, AND LOCAL LAW, RULES AND REGULATIONS CONCERNING CONSTRUCTION SAFETY AND HEALTH, OSHA 29 CFR 1926.650. ALL EXCAVATION, TRENCHING, AND SHORING ACTIVITIES MUST BE CARRIED OUT IN ACCORDANCE WITH OSHA 29 CFR 1926.650 SUBPART P.
5. IT IS THE CONTRACTOR'S RESPONSIBILITY TO KNOW AND COMPLY WITH THE "OCCUPATIONAL SAFETY AND HEALTH ACT OF 1970"
6. CONTRACTOR SHALL SCARIFY TO A DEPTH OF 8" AND RE-COMPACT SUBGRADE TO 95% MAX. DENSITY AS DETERMINED BY ASTM D-1557 UNLESS NOTED OTHERWISE IN GEOTECH REPORT.
7. CONTRACTOR WILL BE RESPONSIBLE FOR FURNISHING BORROW MATERIAL OR HAULING OFF EXCESS MATERIAL THE TRANSPORTATION AND/OR DISPOSAL OF THESE MATERIALS SHALL BE CONSIDERED REUSED MUST BE REMOVED FROM THE PROJECT AREA WITHIN FOUR (4) DAYS OF EXCAVATION.
8. NO SEPARATE PAYMENT WILL BE MADE FOR ANY HAULING OR DISPOSAL OF MATERIAL THE TRANSPORTATION AND/OR DISPOSAL OF MATERIAL SHALL BE CONSIDERED INCIDENTAL TO PROJECT.
9. WHEN ABUTTING NEW CONCRETE TO EXISTING, CUT BACK EXISTING TO A NEAT STRAIGHT LINE AS REQUIRED TO REMOVE ANY BROKEN OR CRACKED CONCRETE, AND MATCH NEW TO EXISTING. NO SEPARATE PAYMENT SHALL BE MADE FOR SAW CUTTING OF EXISTING PAVEMENT OR CONCRETE BUT SHALL BE CONSIDERED INCIDENTAL TO PROJECT. CUTTING OF PAVEMENT OR CONCRETE SHALL BE IN CONFORMANCE WITH PROJECT SPECIFICATIONS.
10. EXERCISE CARE TO AVOID DISTURBING EXISTING, UTILITIES. COORDINATE WITH THE UTILITY COMPANIES FOR ANY REQUIRED RELOCATIONS, AND IN ORDER TO PREVENT ANY SERVICE DISRUPTIONS.
11. CONTRACTOR SHALL PROVIDE REASONABLE ACCESS TO TEMPORARY FACILITIES WITHIN THE PROJECT AREA DURING CONSTRUCTION.
12. WATERING FOR DUST CONTROL, AS REQUIRED, SHALL BE CONSIDERED INCIDENTAL TO CONSTRUCTION AND NO MEASUREMENT OR PAYMENT SHALL BE MADE THEREFOR. CONSTRUCTION AREAS SHALL BE WATERED OR OTHERWISE KEPT DUST FREE. THE CONTRACTOR SHALL USE WATERING EQUIPMENT FOR DUST POLLUTION ABATEMENT AS DIRECTED BY THE OWNER.
13. THE CONTRACTOR IS RESPONSIBLE FOR THE REMOVAL AND DISPOSAL OF ALL DEMOLITION DEBRIS, WORK MATERIAL SHALL BE DISPOSED OF IN A CITY APPROVED WASTE AREA, IN ACCORDANCE WITH ALBUQUERQUE SPECIFICATIONS, SECURED BY AND AT THE EXPENSE OF THE CONTRACTOR.
14. THE CONTRACTOR SHALL REMOVE AND DISPOSE OF ALL ABANDONED UTILITY LINES THAT ARE EXPOSED AS A RESULT OF CONSTRUCTION UNLESS OTHERWISE DIRECTED BY THE ARCHITECT.
15. THE CONTRACTOR AGREES TO TAKE NECESSARY SAFETY PRECAUTIONS AS REQUIRED BY FEDERAL STATE AND LOCAL AUTHORITIES TO PROTECT PEDESTRIANS AND VEHICULAR TRAFFIC IN THE CONSTRUCTION AREA, WHICH INCLUDES BUT ARE NOT LIMITED TO: MAINTAINING ADEQUATE WARNING SIGNS, BARRICADES, LIGHTS, GUARD FENCES, WALK AND BRIDGES.
16. CONTRACTOR SHALL ADJUST CLEANOUT RIMS, VALVE CANS, GRATES AND MH COVER LIDS AS NEEDED TO MATCH FINISHED ELEVATIONS.
17. CONTRACTOR'S YARD AND ANY OTHER AREAS DISTURBED BY THE CONTRACTOR NOT INCLUDED ON THE PLANS, SHALL BE RE-ESTABLISHED TO OWNERS SATISFACTION. THIS WORK SHALL BE CONSIDERED INCIDENTAL TO PROJECT AND NO MEASUREMENT OR PAYMENT WILL BE MADE THEREFOR.
18. CONTRACTOR IS RESPONSIBLE FOR PROVIDING AND ADHERING TO A STORMWATER POLLUTION PREVENTION PLAN AS REQUIRED.
19. SAFETY RAILS ARE REQUIRED AT ALL LOCATIONS ADJACENT TO A PEDESTRIAN WALKWAY WHERE A VERTICAL DROP OF 24" OR MORE EXISTS, OR AS APPLICABLE PER GOVERNING BUILDING CODE.
20. COORDINATE IMPROVEMENTS SHOWN ON THIS PLAN WITH THE ARCHITECT'S SITE PLAN COORDINATE ANY DEPENDENCIES WITH THE OWNER
21. SITE SURVEY IS COORDINATED WITH THE PLOT SURVEY AND TIED TO THE 3/4" ROD FOUND AT THE EDGE OF THE PROPERTY LINE 90' FROM THE NORTHEAST CORNER.
22. GRADES SHOWN ARE FINISHED ELEVATIONS.
23. ALL IMPERVIOUS AREA WILL HAVE FILTER FABRIC WITH 2" OF 3/4" ROCK UNLESS NOTED OTHERWISE.

FACILITIES WITHIN THE ROW NOTICE TO CONTRACTOR (SO-19)

1. AN EXCAVATION PERMIT WILL BE REQUIRED BEFORE BEGINNING ANY WORK WITHIN THE RIGHT-OF-WAY.
2. ALL WORK IN THIS PROJECT SHALL BE PERFORMED IN ACCORDANCE WITH THE APPLICABLE FEDERAL, STATE AND LOCAL LAWS, RULES AND REGULATIONS CONCERNING CONSTRUCTION SAFETY AND HEALTH.
3. TWO WORKING DAYS PRIOR TO ANY EXCAVATION, THE CONTRACTOR MUST CONTACT THE LINE LOCATION SERVICES, NEW MEXICO ONE CALL 260-1990 (NM ONE CALL "811") FOR THE LOCATION OF EXISTING UTILITIES.
4. PRIOR TO CONSTRUCTION, THE CONTRACTOR SHALL EXCAVATE AND VERIFY THE LOCATION OF ALL EXISTING OBSTRUCTIONS. SHOULD A CONFLICT EXIST, THE CONTRACTOR SHALL NOTIFY THE ENGINEER/OWNER SO THAT THE CONFLICT CAN BE RESOLVED WITH MINIMUM AMOUNT OF DELAY.
5. BACKFILL COMPACTION SHALL BE ACCORDING TO STREET USE.
6. MAINTENANCE OF THE FACILITY SHALL BE THE RESPONSIBILITY OF THE OWNER OF THE PROPERTY BEING SERVED.
7. WORK ON ARTERIAL STREETS SHALL BE PERFORMED ON A 24-HOUR BASIS.

SIGNATURE

DATE

DRAINAGE CERTIFICATION


I, Logan Patz, NMPE 24201, OF THE FIRM Patz, Storage, HEREBY CERTIFY THAT THIS PROJECT HAS BEEN GRADED AND WILL DRAIN IN SUBSTANTIAL COMPLIANCE WITH AND IN ACCORDANCE WITH THE DESIGN INTENT OF THE APPROVED PLAN DATED 11-29-16. THE RECORD INFORMATION EDITED ONTO THE ORIGINAL DESIGN DOCUMENT HAS BEEN OBTAINED BY ME OR UNDER MY DIRECT SUPERVISION AS SUPPLEMENTAL DATA TO THE ORIGINAL TOPOGRAPHIC SURVEY PREPARED BY LOGAN PATZ PE AND IS TRUE AND CORRECT TO THE BEST OF MY KNOWLEDGE AND BELIEF. THIS CERTIFICATION IS SUBMITTED IN SUPPORT OF A REQUEST FOR Certificate of Occupancy.

- Two down spouts have been added to the east and west side of the building.
- Two 96-Gallon Rain barrels have been added to the West downspouts.

THE RECORD INFORMATION PRESENTED HEREON IS NOT NECESSARILY COMPLETE AND INTENDED ONLY TO VERIFY SUBSTANTIAL COMPLIANCE OF THE GRADING AND DRAINAGE ASPECTS OF THIS PROJECT. THOSE RELYING ON THIS RECORD DOCUMENT ARE ADVISED TO OBTAIN INDEPENDENT VERIFICATION OF ITS ACCURACY BEFORE USING IT FOR ANY OTHER PURPOSE.

Logan Patz
Logan W. Patz, NMPE 24201

07-21-17
DATE

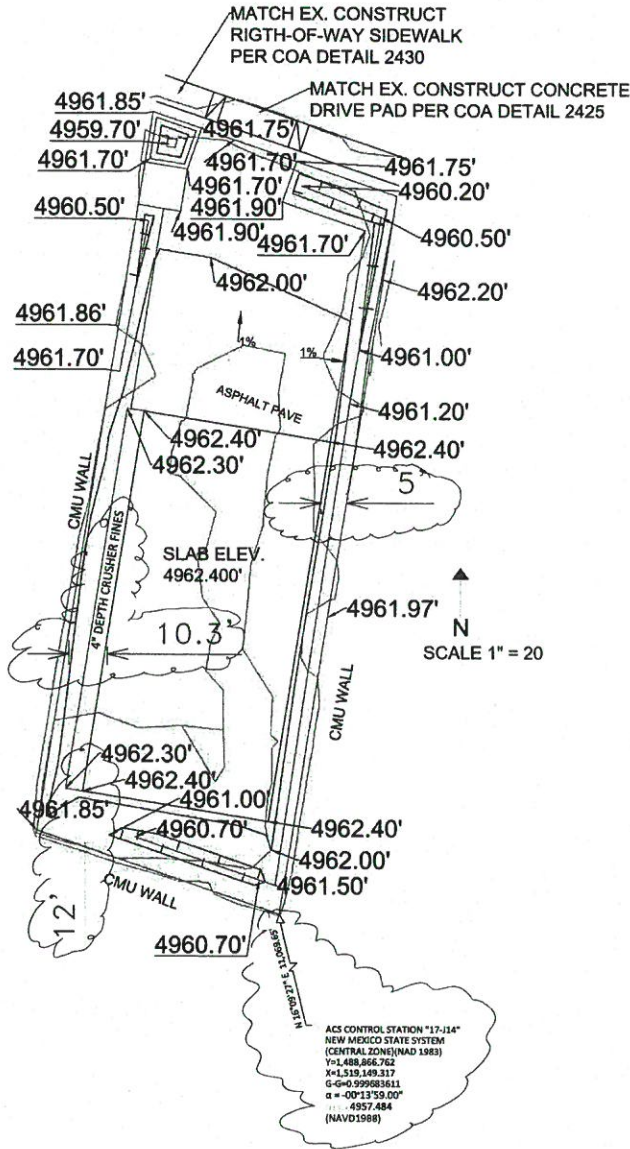

PATZ - WHAREHOUSE/APPARTMENT
406 VERANDA RD N.W.
DATE: 08-08-2016
PROJECT #: 2016-00557



City of Albuquerque

Planning Department
Development & Building Services Division

DRAINAGE AND TRANSPORTATION INFORMATION SHEET (REV 11 2016)

Project Title: Patz Warehouse Building Permit #: 2016-00551 Hydrology File #: G14-D088
DRB#: _____ EPC#: _____ Work Order#: _____
Legal Description: lot 13 Block 17 Subdivision Monk Br. dgr
City Address: 406 Veranda RD, NW 87107

Applicant: Logan Patz Contact: Logan Patz
Address: 7312 Appomattox Pl NE
Phone#: 505-450-3244 Fax#: _____ E-mail: LPatz@LTU.edu
Other Contact: _____ Contact: _____
Address: _____
Phone#: _____ Fax#: _____ E-mail: _____

Check all that Apply:

DEPARTMENT:

☒ HYDROLOGY/ DRAINAGE
☐ TRAFFIC/ TRANSPORTATION

TYPE OF SUBMITTAL:

☒ ENGINEER/ARCHITECT CERTIFICATION
☒ CONCEPTUAL G & D PLAN
☐ GRADING PLAN
☐ DRAINAGE MASTER PLAN
☐ DRAINAGE REPORT
☐ CLOMR/LOMR
☐ TRAFFIC CIRCULATION LAYOUT (TCL)
☐ TRAFFIC IMPACT STUDY (TIS)
☐ OTHER (SPECIFY) _____
☐ PRE-DESIGN MEETING?

TYPE OF APPROVAL/ACCEPTANCE SOUGHT:

☐ BUILDING PERMIT APPROVAL
☒ CERTIFICATE OF OCCUPANCY
☐ PRELIMINARY PLAT APPROVAL
☐ SITE PLAN FOR SUB'D APPROVAL
☐ SITE PLAN FOR BLDG. PERMIT APPROVAL
☐ FINAL PLAT APPROVAL
☐ SIA/ RELEASE OF FINANCIAL GUARANTEE
☐ FOUNDATION PERMIT APPROVAL
☐ GRADING PERMIT APPROVAL
☐ SO-19 APPROVAL
☐ PAVING PERMIT APPROVAL
☐ GRADING/ PAD CERTIFICATION
☐ WORK ORDER APPROVAL
☐ CLOMR/LOMR

IS THIS A RESUBMITTAL?: Yes ☐ No ☒

OTHER (SPECIFY) _____

DATE SUBMITTED: 07-21-14 By: Logan Patz

COA STAFF:

ELECTRONIC SUBMITTAL RECEIVED: _____

FEE PAID: _____