

THE FOLLOWING ARE THE DRAINAGE CALCULATIONS FOR THE MASTER GRADING AND DRAINAGE PLAN INCLUDED HERE TO ASSIST THE REVIEW PROCESS.

DRAINAGE PLAN

The following items concerning the Dorsar Industrial Park Drainage Plan are contained herein:

- Vicinity Map
- Grading Plan
- Drainage Plan

As shown by the Vicinity Map, the site is located between Griegos Road N.W. and Mescalero Road N.W., east of Second Street N.W. and directly west of the A.T. & S.F. Railroad Right-of-Way. At present, the site is undeveloped.

As shown by Panels 119 and 332 of 825 of the National Flood Insurance Program Flood Insurance Rate Maps published by F.E.M.A. for the County of Bernalillo, New Mexico, and Incorporated Areas, dated September 20, 1996, the site does not lie within a designated flood hazard zone. Offsite flows enter the site from the adjacent land to the east, as well as a small amount from the northeast. These offsite flows were calculated to total 2.37 cfs. These flows will not be blocked and will be allowed to pass through the site to their historic outfall. The proposed construction consists of rough grading the site for three future buildings. Also proposed is a 30' face-to-face paved access road with an 8" sanitary sewer line and 6" waterline with services. The road will have a 40' cul-de-sac at the east end.

The Grading Plan shows: 1) existing and proposed grades indicated by spot elevations and contours at 1'0" and 2'0" intervals, 2) supplemental spot elevations, 4) the limit and character of the existing improvements, 3) the limit and character of the proposed improvements, and 5) continuity between existing and proposed grades. As shown by this plan, detention ponding is proposed to mitigate the increase in runoff attributable to the introduction of impervious areas upon the site. The entire site will drain to a pond located at the southwest corner. The pond will drain via an automatic pumping system which will discharge via an existing 4" PVC pump discharge line into an existing private storm drain (forced main). These flows then discharge to an existing storm inlet on the east side of Second Street N.W. The pump has been sized as to allow for the complete evacuation of the developed and offsite V100 within a 24-hour period. The pond has been sized to detain the entire developed V100 for an industrial park scenario, as well as V100 offsite from adjacent properties contributing. The maximum water surface level was calculated to be one foot below the top of berm, allowing a foot of freeboard (the equivalent of 13,445 cubic feet of excess pond volume) before any overflow situations could occur. The pond was located utilizing zoning requirements for R-1 and M-1 zoning per the Comprehensive City Zoning Code. These requirements call for 15' setbacks from existing as well as proposed buildings. In the event that the pumping system were to temporarily fail, the pond has been sized to detain the full volume of runoff discussed above.

The Calculations which appear hereon analyze both the existing and developed conditions for the 100-year, 6-hour rainfall event. The Procedure for 40-acre and Smaller Basins, as set forth in the Revision of Section 22.2, Hydrology of the Development Process Manual, Volume 2, Design Criteria, dated January, 1993, has been used to quantify the peak rate of discharge and volume of runoff generated. As shown by these calculations, runoff volume and peak discharge rate will increase with the proposed development. However, this increase will not negatively impact downstream conditions due to the detention of flows, as previously noted.

Review of Panels 119 and 332 of 825 of the National Flood Insurance Program Flood Insurance Rate Maps indicates flooding with Second Street N.W. This flooding demonstrates limited downstream capacity. This fact was recognized by the previous submittal for this site. This submittal requires the relocation of the existing lift station design and built as a result of the previous submittal. The ability to discharge from this site is a function of the existing private forced main in place. As the site is topographically lower than Second Street N.W., the use of a lift station to convey flows offsite, is thereby necessitated. The calculated rate of discharge, determined by the lift station pump, is 140 GPM or 0.31 cfs. The relocated lift station will continue to discharge through this forced main, which in turn connects into the back of a storm inlet at Second Street N.W.

CALCULATIONS

Site Characteristics

- Precipitation Zone = 2
- $P_{e-100} = P_{360} = 2.35$ in.
- Total Area (A_T) = 140,320 sf; 3.2 ac.
- Existing Land Treatment

Treatment	Area (sf/ac)	%
C	128,320/2.9	91
D	12,000/0.3	09
- Developed Land Treatment

Treatment	Area (sf/ac)	%
B	14,030/0.3	10
D	126,290/2.9	90
- Offsite Basin Land Treatment

Treatment	Area (sf/ac)	%
C	3,500/0.08	15
D	19,550/0.45	85
- Existing Condition

A. Volume

$$E_W = (E_{AA} + E_B A_B + E_C A_C + E_D A_D) / A_T$$

$$E_W = [(1.13)(2.9) + (2.12)(0.3)] / 3.2 = 1.22 \text{ in.}$$

$$V_{100} = (E_W / 12) A_T$$

$$V_{100} = (1.22 / 12) 3.2 = 0.3261 \text{ ac.ft.; } 14,200 \text{ cf}$$

B. Peak Discharge

$$Q_P = Q_{PA} A_A + Q_{PB} A_B + Q_{PC} A_C + Q_{PD} A_D$$

$$Q_P = Q_{100} = (3.14)(2.9) + (4.70)(0.3) = 10.5 \text{ cfs}$$

8. Offsite Basin

A. Volume

$$E_W = (E_{AA} + E_B A_B + E_C A_C + E_D A_D) / A_T$$

$$E_W = [(1.13)(0.08) + (2.12)(0.45)] / 0.53 = 1.97 \text{ in.}$$

$$V_{100} = (E_W / 12) A_T$$

$$V_{100} = (1.97 / 12) 0.53 = 0.0870 \text{ ac.ft.; } 3,790 \text{ cf}$$

B. Peak Discharge

$$Q_P = Q_{PA} A_A + Q_{PB} A_B + Q_{PC} A_C + Q_{PD} A_D$$

$$Q_P = Q_{100} = (3.14)(0.08) + (4.70)(0.45) = 2.37 \text{ cfs}$$

9. Developed Condition

A. Volume

$$E_W = (E_{AA} + E_B A_B + E_C A_C + E_D A_D) / A_T$$

$$E_W = [(1.13)(0.3) + (2.12)(2.9)] / 3.2 = 2.03 \text{ in.}$$

$$V_{100} = (E_W / 12) A_T$$

$$V_{100} = (2.03 / 12) 3.2 = 0.5406 \text{ ac.ft.; } 23,550 \text{ cf}$$

B. Peak Discharge

$$Q_P = Q_{PA} A_A + Q_{PB} A_B + Q_{PC} A_C + Q_{PD} A_D$$

$$Q_P = Q_{100} = (3.14)(0.3) + (4.70)(2.9) = 14.6 \text{ cfs}$$

10. Comparison

- $V_{100} = 23,550 - 14,200 = 9,350 \text{ cf; } 0.2145 \text{ ac.ft. (increase)}$
- $Q_{100} = 14.6 - 10.5 = 4.1 \text{ cfs (increase)}$

11. Pond Calculations

A. Pond Volume

Elev	Area (sf)	Vol (cf)	Vol (cf)	Σ
62	1,880	3,080	3,080	
63	4,280	5,510	8,590	
64	6,740	8,040	16,630	
65	9,340	10,650	27,280	
66	11,960	13,445	40,725	
67	14,930			

100 Yr. W.S.L. at 66 therefore: 1 foot freeboard

B. Required Volume

$$V \sim 100 \sim S (\text{Developed}) + V \sim 100 \sim S (\text{Offsite})$$

$$23,550 + 3,790 = 27,340 = V \sim \text{required} \sim S$$

$$V \sim \text{spond} \sim S > V \sim \text{required} \sim S$$




C. Required Pump Discharge Rate, R

$$R \sim \text{required} \sim S = V \sim 100, \text{ total} \sim S / (3600 \text{ sec/hr} * 24 \text{ hr.})$$


$$R \sim \text{required} \sim S = 27,340 \text{ ft} \sim S3 \sim s / (3600 \text{ sec/hr} * 24 \text{ hr.})$$

$$R \sim \text{required} \sim S = 0.316 \text{ ft} \sim S3 \sim s; 140 \text{ GPM}$$

Therefore: Requires 1.0 HP Hydromatic SPD 100H Submersible Effluent Pump or Approved Equal

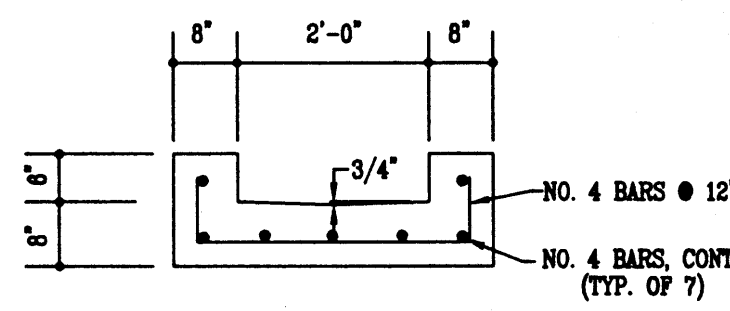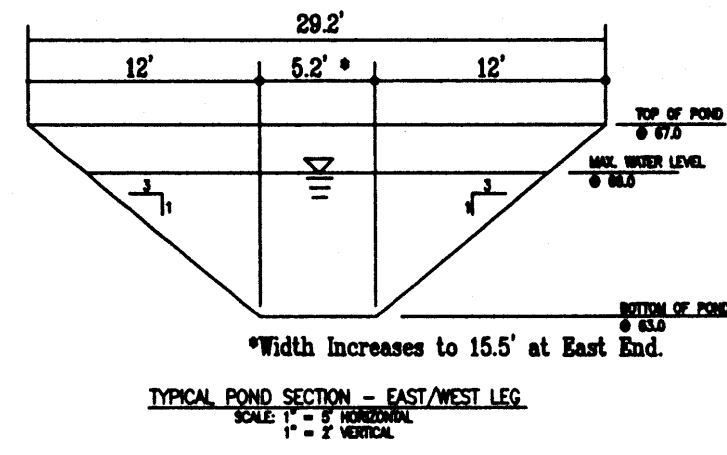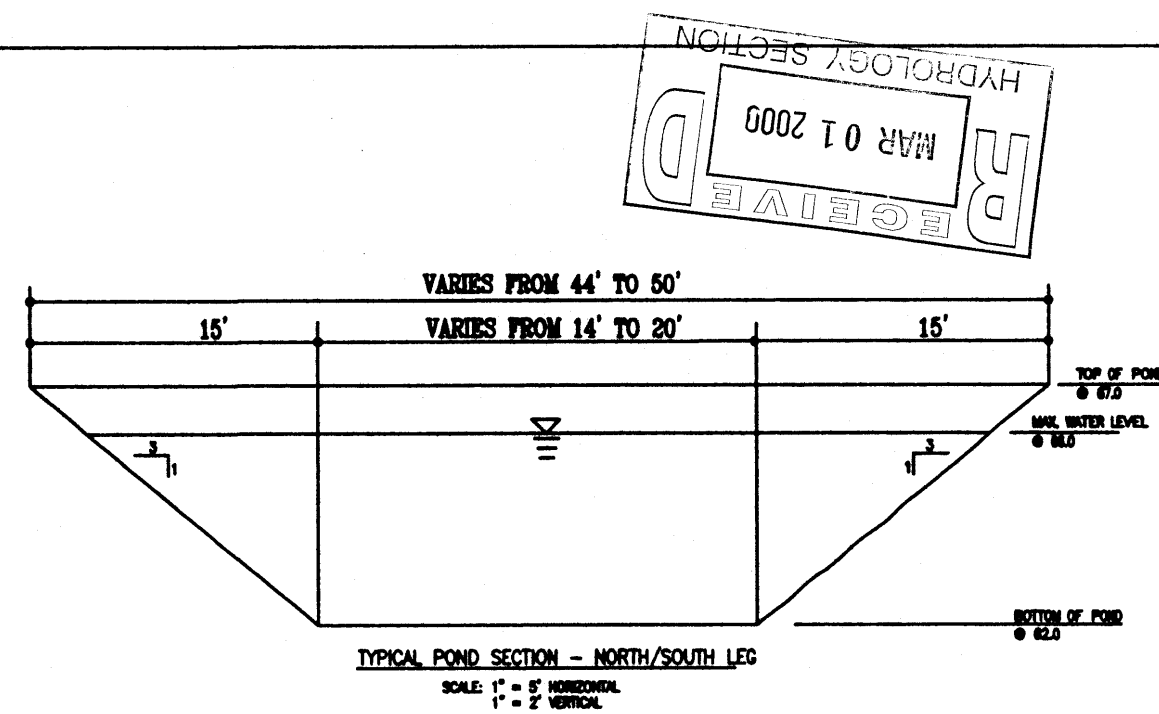

CURVE/TANGENT	DELTA	R	LENGTH
C-1	45°	2'	1.57'
C-2	45°	3'	2.36'
C-3	45°	4'	3.14'
T-1			6.27
T-2			5.65
T-3			7.77
T-4			9.89
T-5			5.84
T-6			4.34
T-7			2.84

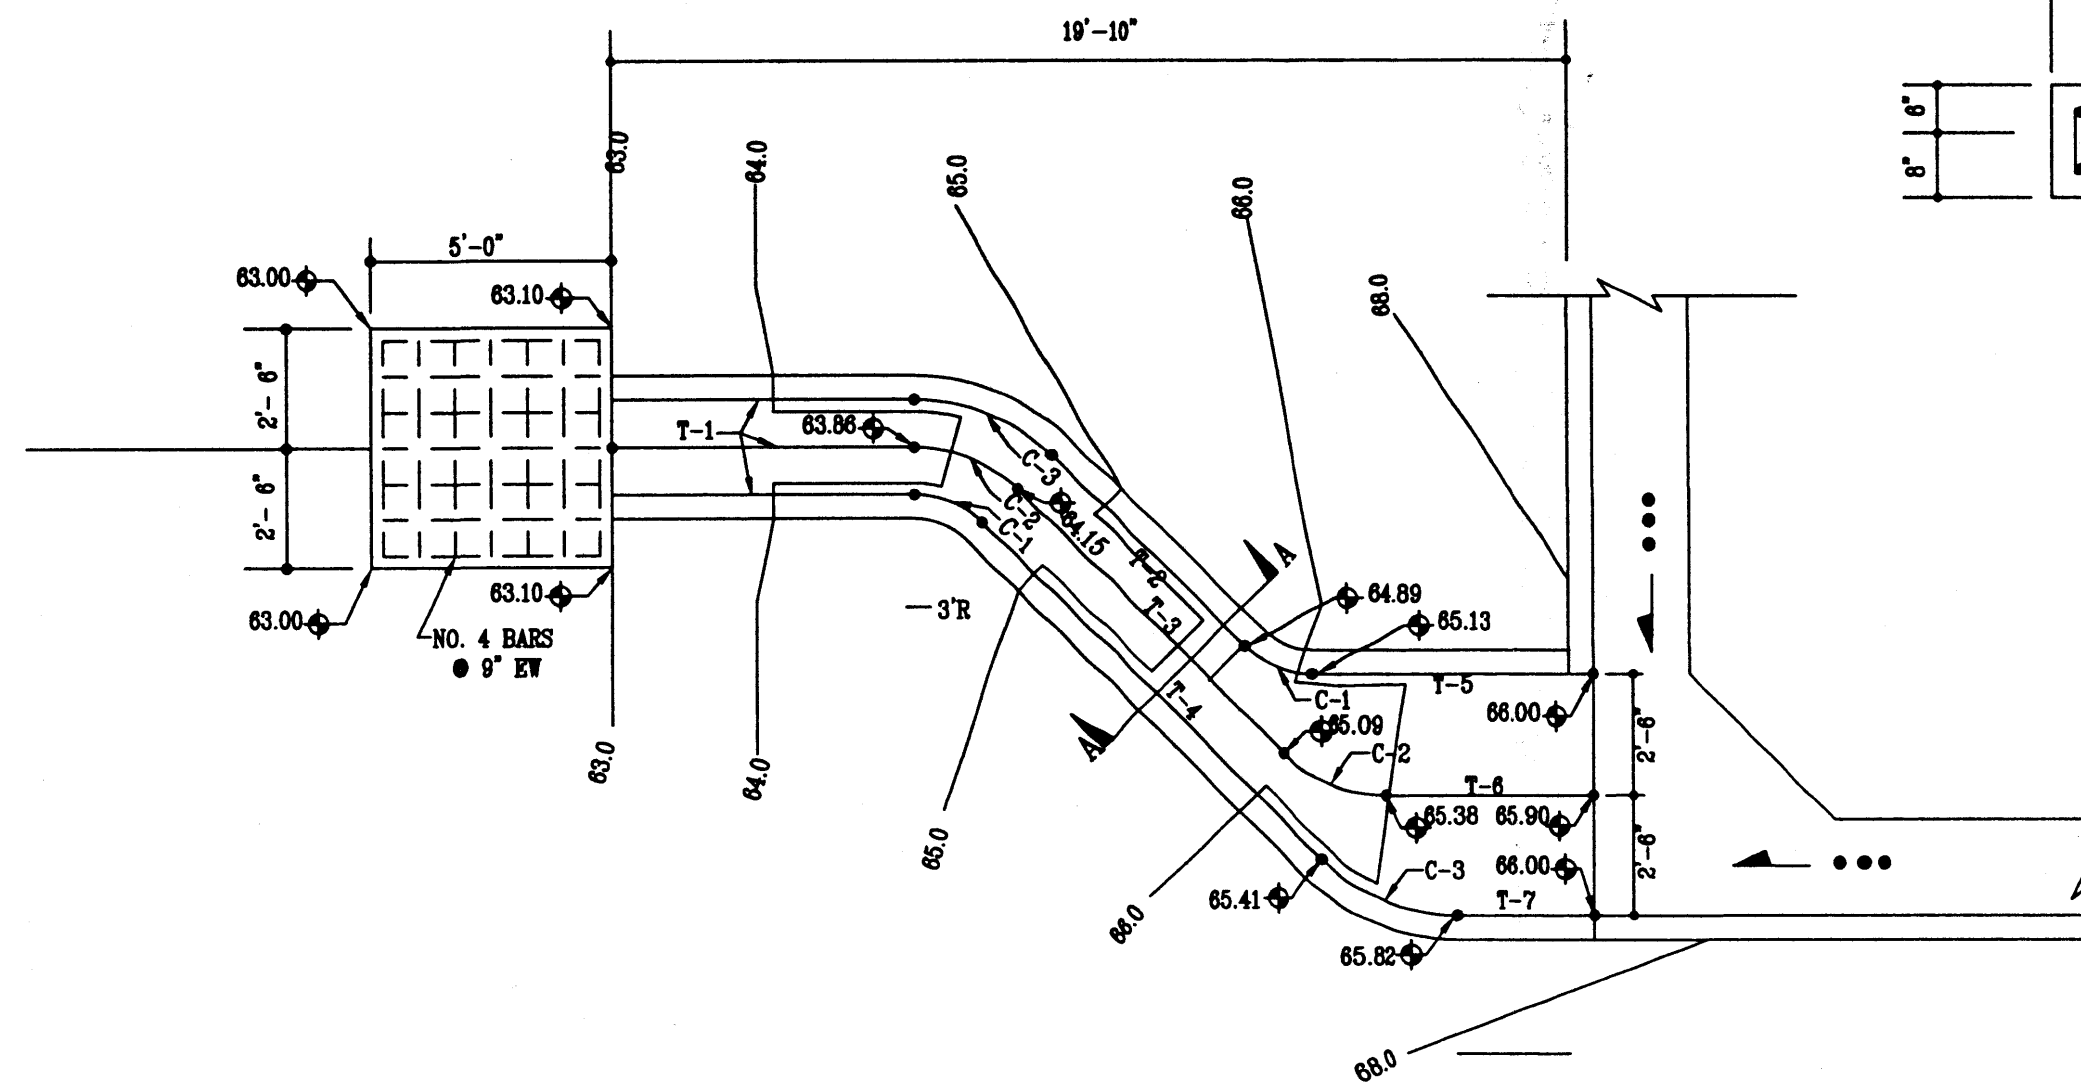

CONCRETE RUNDOWN DETAIL

SCALE: 1/4" = 1' - 0"

CALCULATIONS - THIS PHASE

Percentages of land treatments A and B do not change from the MP calculations.

It was necessary to adjust pond volumes slightly to ensure that the pond has adequate capacity and and was within the prescribed setback limits. The revised pond volume calculations follow:

Elev	Area (sf)	Vol (cf)	Σ Vol (cf)
62	1,939	3,208	3,208
63	4,477	5,762	8,970
64	7,048	8,369	17,339
65	9,690	11,045	28,384
66	12,401	13,791	42,175
67	15,181		

100 Yr. W.S.L. at 66 therefore: 1 foot freeboard

DRAINAGE BASIN "B" - PEAK DISCHARGE:

Drainage Basin "B" flows to the pond through the rundown in the SW corner of the Drainage Basin "A" flows to the pond through previously constructed rundowns. Area of Drainage Basin "B" = 70,750 sf (1.6242 acres).

Area of Drainage Basin "B" = 70,750 sf (1.6242 acres).

$$Q_P = Q_{PB} A_B$$

$$Q_P = 4.70 \times 1.6242 = 7.64 \text{ cfs}$$

RUNDOWN CALCULATIONS:

Calculate entrance width using Weir Equation:

$$Q = C L H^{3/2} \quad C = 3.0 \quad H = 0.67'$$

$$L = Q / (C H^{3/2}) = 7.64 / (3.0 \times 0.67^{3/2}) = 4.60' \text{ (Use 5.0')}$$

Calculate Rundown Channel Capacity using Manning's Equation:




Assume flow depth = 4", 0.33' Width is 2.0'

$$\text{Area} = 2 \times 0.33 = 0.66'$$

$$P = 2 + 2(3.3) = 2.66' \quad R = A/P = 0.66/2.66 = 0.2481$$

$$V = (1.486/n) R^{2/3} S^{1/2} = (1.486 / 0.013) (0.2481)^{2/3} (0.1212)^{1/2} = 15.70 \text{ fps}$$

$$Q = AV = 0.66 \times 15.70 = 10.36 \text{ cfs} > 7.64 \text{ cfs}$$

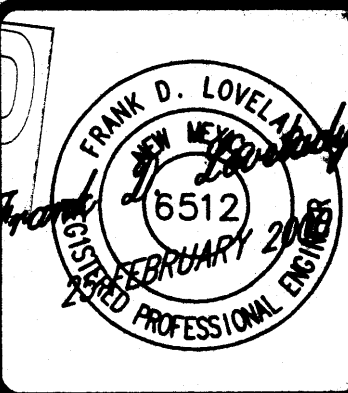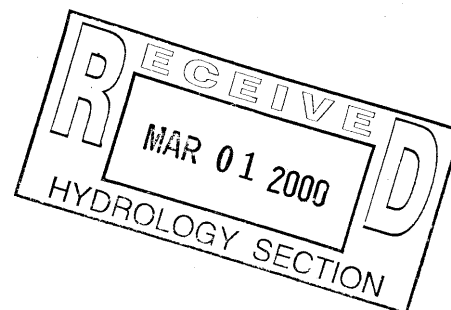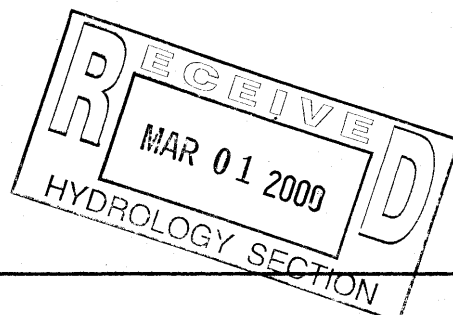


DRAINAGE CALCULATIONS AND DETAILS
SUNLAND INTERNATIONAL NAVASTAR
AT DORSAR INDUSTRIAL PARK
ALBUQUERQUE, NEW MEXICO

FRANK D. LOVELL, P.E.
(505) 345-2287 • Fax (505) 345-2115 • 300 ALAMOSA RD. NW • Albuquerque, NM • 87107

JOB NO:	592
DATE:	FEBRUARY 25, 2000
REVISIONS	


SHEET NO.
2
OF
2

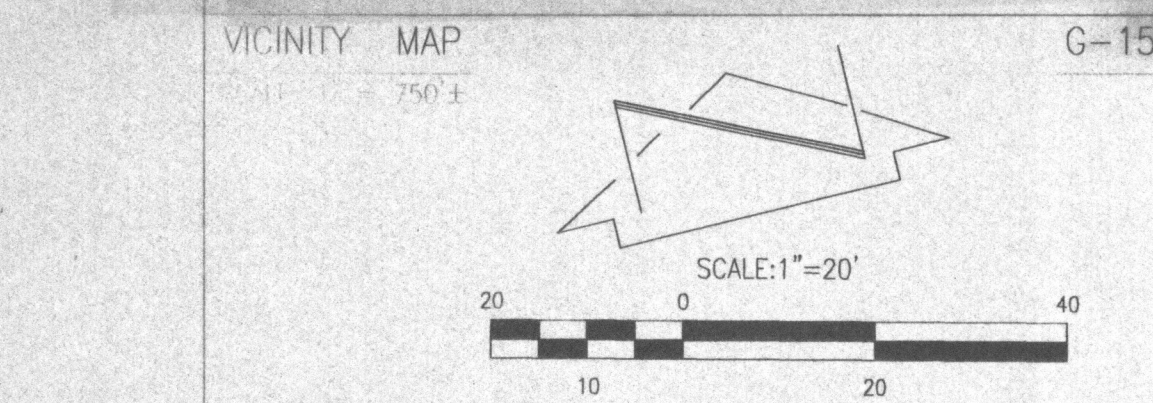



SCALE: 1" = 20'-0"

IP 112 Zone Atlas 3/27

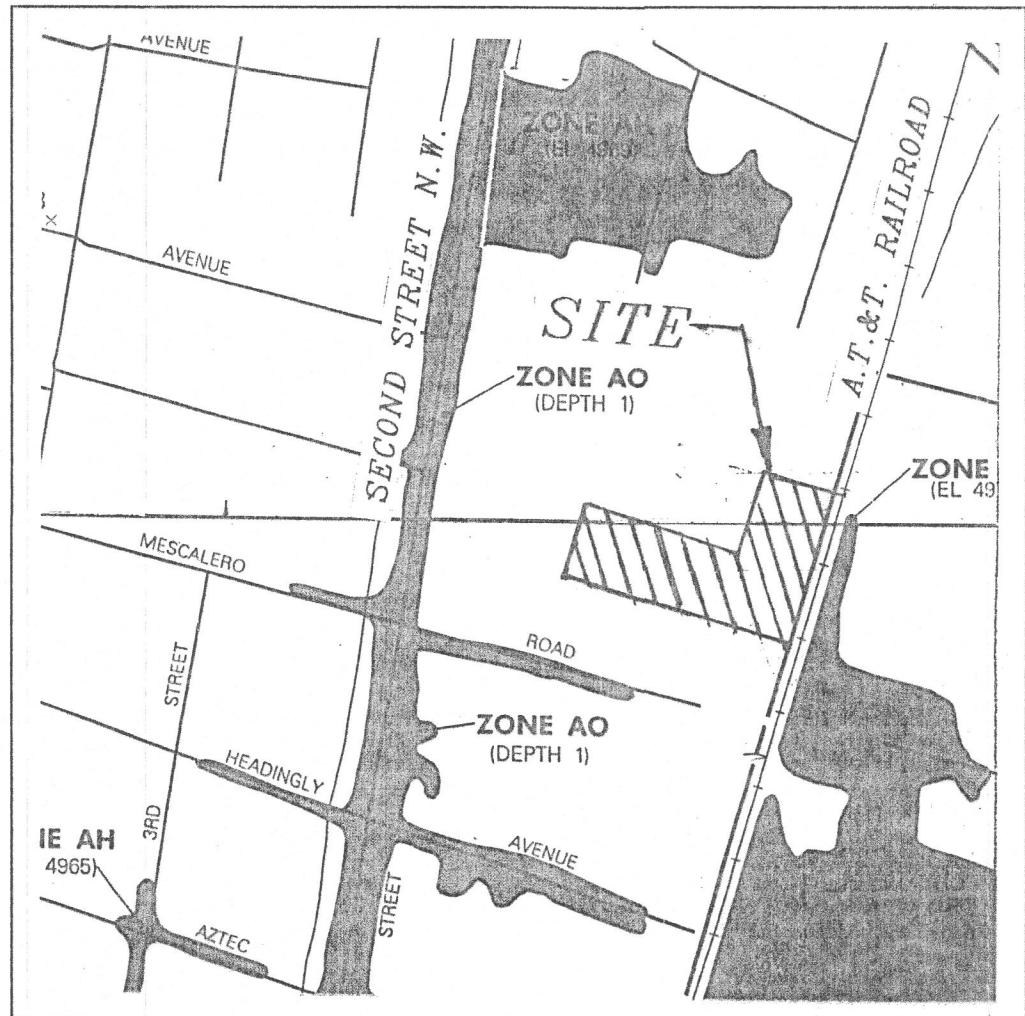

FIRM MAP
SCALE: 1" = 500'

THE FOLLOWING ARE THE DRAINAGE CALCULATIONS FOR THE MASTER GRADING AND DRAINAGE PLAN INCLUDED HERE TO ASSIST THE REVIEW PROCESS.

DRAINAGE PLAN

The following items concerning the Dorsar Industrial Park Drainage Plan are contained herein:

- Vicinity Map
- Grading Plan
- Drainage Plan

As shown by the Vicinity Map, the site is located between Griegos Road N.W. and Mescalero Road N.W., east of Second Street N.W. and directly west of the A.T. & S.F. Railroad Right-of-Way. At present, the site is undeveloped.

As shown by Panels 119 and 332 of 825 of the National Flood Insurance Program Flood Insurance Rate Maps published by F.E.M.A. for the County of Bernalillo, New Mexico, and Incorporated Areas, dated September 20, 1996, the site does not lie within a designated flood hazard zone. Offsite flows enter the site from the adjacent land to the east, as well as a small amount from the northeast. These offsite flows were calculated to total 2.37 cfs. These flows will not be blocked and will be allowed to pass through the site to their historic outfall. The proposed construction consists of rough grading the site for three future buildings. Also proposed is a 30' face-to-face paved access road with an 8" sanitary sewer line and 6" waterline with services. The road will have a 40' cul-de-sac at the east end.

The Grading Plan shows: 1) existing and proposed grades indicated by spot elevations and contours at 1'0" and 2'0" intervals, 2) supplemental spot elevations, 4) the limit and character of the existing improvements, 3) the limit and character of the proposed improvements, and 5) continuity between existing and proposed grades. As shown by this plan, detention ponding is proposed to mitigate the increase in runoff attributable to the introduction of impervious areas upon the site. The entire site will drain to a pond located at the southwest corner. The pond will drain via an automatic pumping system which will discharge via an existing 4" PVC pump discharge line into an existing private storm drain (forced main). These flows then discharge to an existing storm inlet on the east side of Second Street N.W. The pump has been sized as to allow for the complete evacuation of the developed and offsite V100 within a 24-hour period. The pond has been sized to detain the entire developed V100 for an industrial park scenario, as well as V100 offsite from adjacent properties contributing. The maximum water surface level was calculated to be one foot below the top of berm, allowing a foot of freeboard (the equivalent of 13,445 cubic feet of excess pond volume) before any overflow situations could occur. The pond was located utilizing zoning requirements for R-1 and M-1 zoning per the Comprehensive City Zoning Code. These requirements call for 15' setbacks from existing as well as proposed buildings. In the event that the pumping system were to temporarily fail, the pond has been sized to detain the full volume of runoff discussed above.

The Calculations which appear hereon analyze both the existing and developed conditions for the 100-year, 6-hour rainfall event. The Procedure for 40-acre and Smaller Basins, as set forth in the Revision of Section 22.2, Hydrology of the Development Process Manual, Volume 2, Design Criteria, dated January, 1993, has been used to quantify the peak rate of discharge and volume of runoff generated. As shown by these calculations, runoff volume and peak discharge rate will increase with the proposed development. However, this increase will not negatively impact downstream conditions due to the detention of flows, as previously noted.

Review of Panels 119 and 332 of 825 of the National Flood Insurance Program Flood Insurance Rate Maps indicates flooding withling Second Street N.W. This flooding demonstrates limited downstream capacity. This fact was recognized by the previous submittal for this site. This submittal requires the relocation of the existing lift station design and built as a result of the previous submittal. The ability to discharge from this site is a function of the existing private forced main in place. As the site is topographically lower than Second Street N.W., the use of a lift station to convey flows offsite, is thereby necessitated. The calculated rate of discharge, determined by the lift station pump, is 140 GPM or 0.31 cfs. The relocated lift station will continue to discharge through this forced main, which in turn connects into the back of a storm inlet at Second Street N.W.

CALCULATIONS

Site Characteristics

- Precipitation Zone = 2
- $P_{6-100} = P_{360} = 2.35$ in.
- Total Area (A_T) = 140,320 sf; 3.2 ac.
- Existing Land Treatment

Treatment	Area (sf/ac)	%
C	128,320/2.9	91
D	12,000/0.3	09
- Developed Land Treatment

Treatment	Area (sf/ac)	%
B	14,030/0.3	10
D	126,290/2.9	90
- Offsite Basin Land Treatment

Treatment	Area (sf/ac)	%
C	3,500/0.08	15
D	19,550/0.45	85
- Existing Condition

A. Volume

$$E_W = (E_{AA} + E_{AB} + E_{AC} + E_{AD}) / A_T$$

$$E_W = [(1.13)(2.9) + (2.12)(0.3)] / 3.2 = 1.22 \text{ in.}$$

$$V_{100} = (E_W / 12) A_T$$

$$V_{100} = (1.22 / 12) 3.2 = 0.3261 \text{ ac.ft.}; 14,200 \text{ cf}$$

B. Peak Discharge

$$Q_P = Q_{PA}A_A + Q_{PB}A_B + Q_{PC}A_C + Q_{PD}A_D$$

$$Q_P = Q_{100} = (3.14)(2.9) + (4.70)(0.3) = 10.5 \text{ cfs}$$

8. Offsite Basin

A. Volume

$$E_W = (E_{AA} + E_{AB} + E_{AC} + E_{AD}) / A_T$$

$$E_W = [(1.13)(0.08) + (2.12)(0.45)] / 0.53 = 1.97 \text{ in.}$$

$$V_{100} = (E_W / 12) A_T$$

$$V_{100} = (1.97 / 12) 0.53 = 0.0870 \text{ ac.ft.}; 3,790 \text{ cf}$$

B. Peak Discharge

$$Q_P = Q_{PA}A_A + Q_{PB}A_B + Q_{PC}A_C + Q_{PD}A_D$$

$$Q_P = Q_{100} = (3.14)(0.08) + (4.70)(0.45) = 2.37 \text{ cfs}$$

9. Developed Condition

A. Volume

$$E_W = (E_{AA} + E_{AB} + E_{AC} + E_{AD}) / A_T$$

$$E_W = [(1.13)(0.3) + (2.12)(2.9)] / 3.2 = 2.03 \text{ in.}$$

$$V_{100} = (E_W / 12) A_T$$

$$V_{100} = (2.03 / 12) 3.2 = 0.5406 \text{ ac.ft.}; 23,550 \text{ cf}$$

B. Peak Discharge

$$Q_P = Q_{PA}A_A + Q_{PB}A_B + Q_{PC}A_C + Q_{PD}A_D$$

$$Q_P = Q_{100} = (3.14)(0.3) + (4.70)(2.9) = 14.6 \text{ cfs}$$

10. Comparison

- $V_{100} = 23,550 - 14,200 = 9,350 \text{ cf}; 0.2145 \text{ ac.ft. (increase)}$
- $Q_{100} = 14.6 - 10.5 = 4.1 \text{ cfs (increase)}$

11. Pond Calculations

A. Pond Volume

Elev	Area (sf)	Vol (cf)	Vol (cf)	Σ
62	1,880		3,080	
63	4,280	3,080	8,590	
64	6,740	5,510	16,630	
65	9,340	8,040	27,280	
66	11,960	10,650	37,280	
67	14,930	13,445	40,725	

100 Yr. W.S.L. at 66 therefore: 1 foot freeboard

B. Required Volume

$$V \sim s100 \sim S \text{ (Developed)} + V \sim s100 \sim S \text{ (Offsite)}$$

$$23,550 + 3,790 = 27,340 = V \sim s \text{ required} \sim S$$

$$V \sim s \text{ pond} \sim S > V \sim s \text{ required} \sim S$$





C. Required Pump Discharge Rate, R

$$R \sim s \text{ required} \sim S = V \sim s100, \text{ total} \sim S / (3600 \text{ sec/hr} * 24 \text{ hr.})$$

$$R \sim s \text{ required} \sim S = 27,340 \text{ ft} \sim S3 \sim s / (3600 \text{ sec/hr} * 24 \text{ hr.})$$

$$R \sim s \text{ required} \sim S = 0.316 \text{ ft} \sim S3 \sim s/s; 140 \text{ GPM}$$

Therefore: Requires 1.0 HP Hydromatic SPD 100H Submersible Effluent Pump or Approved Equal

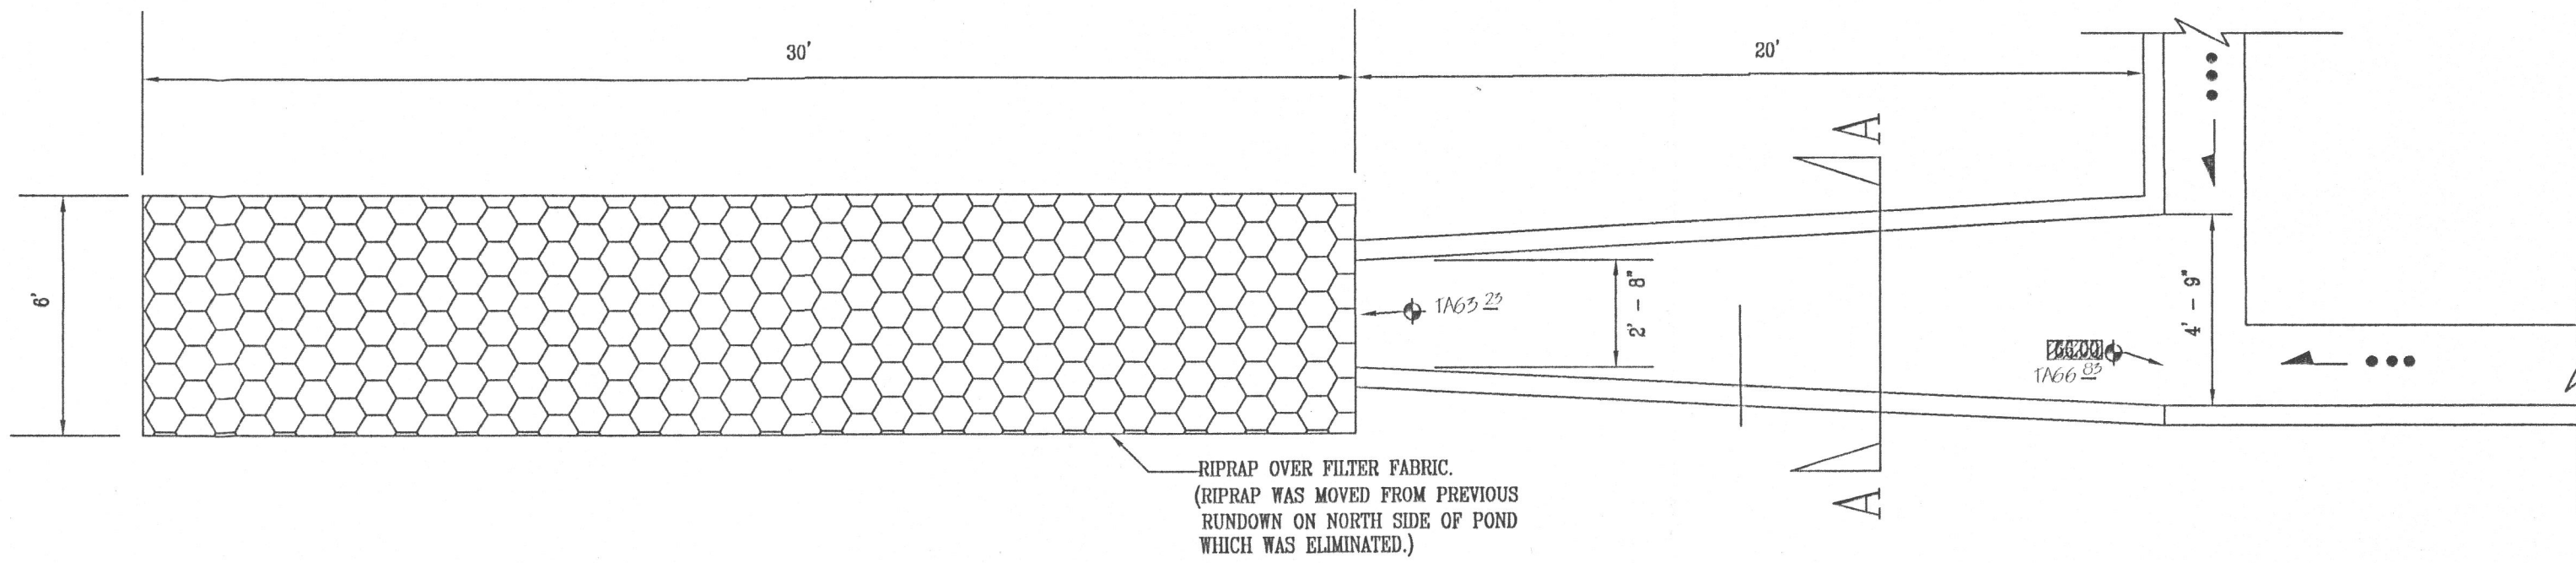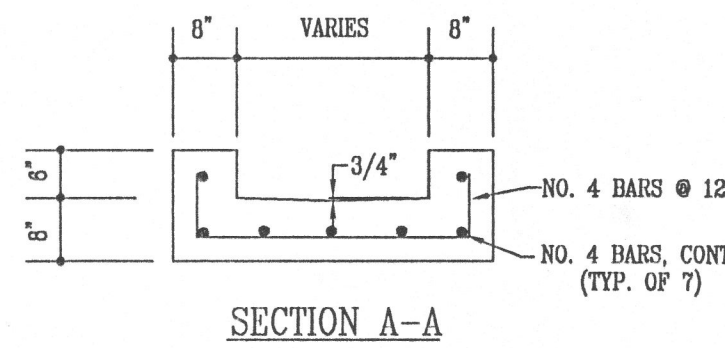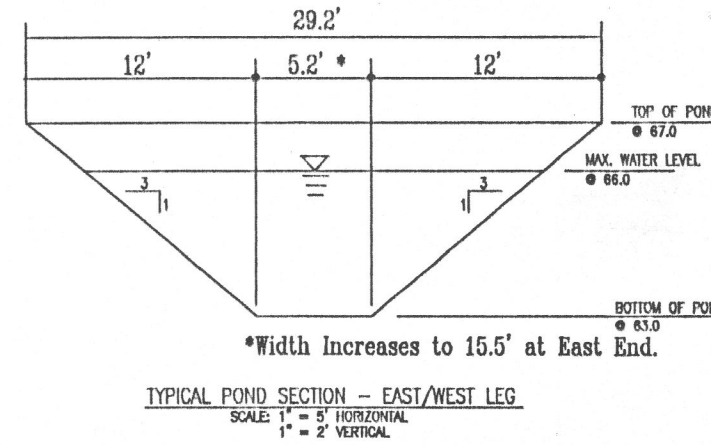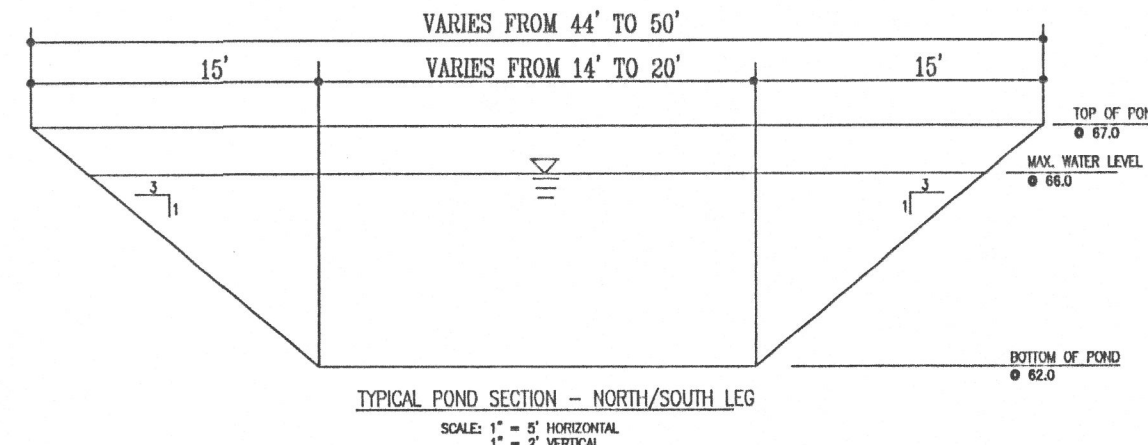

CONCRETE RUNDOWN DETAIL

SCALE: 1/4" = 1' - 0"

CALCULATIONS - THIS PHASE

Percentages of land treatments A and B do not change from the MP calculations.

It was necessary to adjust pond volumes slightly to ensure that the pond has adequate capacity and was within the prescribed setback limits. The revised pond volume calculations follow:

Elev	Area (sf)	Vol (cf)	Σ Vol (cf)
62	1,939		3,208
63	4,477	5,762	8,970
64	7,048	8,369	17,339
65	9,690	11,045	28,384
66	12,401	13,791	42,175
67	15,181		

100 Yr. W.S.L. at 66 therefore: 1 foot freeboard

DRAINAGE BASIN "B" - PEAK DISCHARGE:

Drainage Basin "B" flows to the pond through the rundown in the SW corner of the Drainage Basin "A" flows to the pond through previously constructed rundowns. Area of Drainage Basin "B" = 70,750 sf (1.6242 acres).

Area of Drainage Basin "B" = 70,750 sf (1.6242 acres).

$$Q_P = + Q_{PD}A_D$$

$$Q_P = 4.70 \times 1.6242 = 7.64 \text{ cfs}$$

RUNDOWN CALCULATIONS:

Calculate entrance width using Weir Equation:

$$Q = C L H^{3/2} \quad C = 3.0 \quad H = 0.67'$$

$$L = Q / (C H^{3/2}) = 7.64 / (3.0 \times 0.67^{3/2}) = 4.60' \quad (\text{Use } 4.75') \quad \text{Revised } 11/17/2000$$

Calculate Rundown Channel Capacity using Manning's Equation:

Assume flow depth = 4", 0.33' Width is 2.0'

$$\text{Area} = 2 \times 0.33 = 0.66'$$

$$P = 2 + 2(.33) = 2.66' \quad R = A/P = 0.66/2.66 = 0.2481$$

$$V = (1.486/n) R^{2/3} S^{1/2} = (1.486 / 0.013) (0.2481^{2/3} / 0.1212)^{1/2} = 15.70 \text{ fps}$$

$$Q = AV = 0.66 \times 15.70 = 10.36 \text{ cfs} > 7.64 \text{ cfs}$$

ALTERNATE RUNDOWN - TYPE "VL" RIPRAP:

Calculate Rundown Channel Capacity using Manning's Equation:


Assume flow depth = 3", 0.25' Width is 5.0'

$$\text{Area} = 0.25 \times 5.0 + 0.25 \times 0.25 = 1.31 \text{ SF}$$

$$P = 5.0 + 2(0.35) = 5.7' \quad R = A/P = 1.31/5.7 = 0.2298$$

$$V = (1.486/n) R^{2/3} S^{1/2} = (1.486 / 0.035) (0.2298^{2/3} / 0.1398)^{1/2} = 5.95 \text{ fps}$$

$$Q = AV = 0.66 \times 15.70 = 10.36 \text{ cfs} > 7.64 \text{ cfs}$$

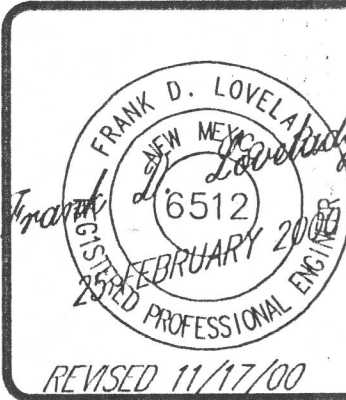

AS-CONSTRUCTED
DRAINAGE CALCULATIONS AND DETAILS
SUNLAND INTERNATIONAL NAVASTAR
AT DORSAR INDUSTRIAL PARK
ALBUQUERQUE, NEW MEXICO
NOV 17 2000
HYDROLOGY SECTION

FRANK D. LOVELL, P.E.
345-2267 • Fax (505) 345-2115 • 300 ALAMOSA RD. NW • Albuquerque, NM • 87107

JOB NO:	592
DATE:	NOVEMBER 17, 2000
REVISIONS	

SHEET NO.
2
OF
2



VICINITY MAP
SCALE: 1" = 750'±

G-15

ENGINEER'S CERTIFICATION:

HAVING FIELD-INSPECTED THE SITE AND HAVING TAKEN SPOT ELEVATIONS AT CRITICAL LOCATIONS, I HEREBY CERTIFY THAT THE AS-CONSTRUCTED FACILITY IS IN SUBSTANTIAL CONFORMANCE WITH THE APPROVED GRADING AND DRAINAGE PLAN WITH ENGINEER'S STAMP DATED FEBRUARY 25, 2000.

Frank D. Lovelady
FRANK D. LOVELADY N.M.P.E. 6512
November 17, 2000
DATE

LEGAL DESCRIPTION

TRACTS 3-A & 3-B OF TRACT 3, DORSAR INDUSTRIAL PARK, ALBUQUERQUE, NM 10/7/95

PROJECT BENCHMARK


A STANDARD NMHS BRASS TABLET, STAMPED "STANMA7-10" SET IN TOP OF A CONCRETE POST PROJECTING 0.1 FT. ABOVE THE GROUND. THE STATION IS LOCATED AT THE INTERSECTION OF SECOND STREET AND MISKALERO RD. N.W. IN THE CENTER OF THE MEDIAN STRIP OF SECOND ST. ELEVATION = 4967.496 FEET (M.S.L.D.)

T.B.M.

T.B.M. #1: THE TOP OF THE S.E. BONNET BOLT OF A FIRE HYDRANT LOCATED NEAR THE NW PROPERTY CORNER AS SHOWN ON THE DRAWING. ELEVATION = 4968.94 FEET (M.S.L.D.)

LEGEND

TC	TOP OF CONCRETE
DIA.	DIAMETER
EA	EDGE OF ASPHALT
E/A	EDGE OF ASPHALT
BR	BOTTOM OF RAMP
L.P.	LIGHT POLE
P.P.	POWER POLE
FL	FLOWLINE
TW	TOP OF WALL
NG	NATURAL GRADE
U/G	UNDERGROUND
OV/H	OVERHEAD
+	EXISTING CONTOUR
68.37	EXISTING SPOT ELEVATION
68.67*	EXISTING SMALL SHRUB
68.70	EXISTING GROUP OF SMALL TREES
68	SAS - EXISTING SANITARY SERVICE
68	W - EXISTING WATERLINE SERVICE
68.67*	AS-CONST. SPOT ELEV.
68.70	NEW SPOT ELEVATION
68	NEW CONTOUR
RD	ROOF FLOW
RD	ROOF DRAIN

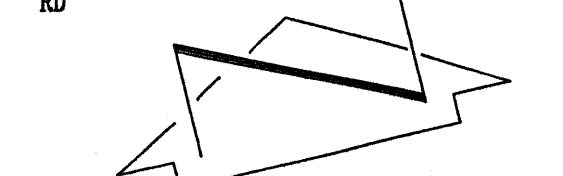

SCALE: 1" = 20'

Construction Notes:

- Two (2) working days prior to any excavation, contractor must contact New Mexico One Call System 260-1990 (Albuquerque Area), 1-800-321-ALERT(2537) (Statewide), for location of existing utilities.
- Prior to construction, the contractor shall excavate and verify the horizontal and vertical location of all potential obstructions. Should a conflict exist, the contractor shall notify the engineer in writing so that the conflict can be resolved with a minimum amount of delay. The Contractor shall be responsible for all interpretations it makes without first contacting the Engineer as required above.
- All work on this project shall be performed in accordance with applicable federal, state and local laws, rules and regulations concerning construction safety and health.
- All construction within public right-of-way shall be performed in accordance with applicable City of Albuquerque Standards and Procedures.
- If any utility lines, pipelines, or underground utility lines are shown in these drawings, they are shown in an approximate manner only, and such lines may exist where none are shown. If any such existing lines are shown, the location is based upon information provided by the owner of said utility, and the information may be incomplete, or may be obsolete by the time construction commences. The engineer has conducted only preliminary investigation of the location, depth, size, or type of existing utility lines, pipelines, or underground utility lines. This investigation is not conclusive, and may not be complete, therefore, makes no representation pertaining thereto, and assumes no responsibility or liability therefor. The contractor shall inform itself of the location of any utility line, pipeline, or underground utility line in or near the area of the work in advance of and during excavation work. The contractor is fully responsible for any and all damage caused by its failure to locate, identify and preserve any and all existing utilities, pipelines, and

underground utility lines. In planning and conducting excavation, the contractor shall comply with state statutes, municipal and local ordinances, rules and regulations, if any, pertaining to the location of these lines and facilities.



- The design of planters and landscaped areas is not part of this plan. All planters and landscaped areas adjacent to the building(s) shall be provided with positive drainage to avoid any ponding adjacent to the structure. For construction details, refer to landscaping plan.

Erosion Control Measures:

- The contractor shall ensure that no soil erodes from the site into public right-of-way or onto private property.
- The contractor shall promptly clean up any material excavated within the public right-of-way so that the excavated material is not susceptible to being washed down the street.
- The contractor shall secure "Topsoil Disturbance Permit" prior to beginning construction.

KEYED NOTES

- (NOT USED).
- ASPHALT PAVING.
- POLE MOUNTED H.C. SIGN - SEE DETAIL 1/C-2, 2' BACK FROM CURBS.
- CURB ALLEY GUTTER W/ 5' STAND-UP CURB EACH SIDE OF ROOF DRAINS.
- CONC. SIDEWALK.
- H.C. ACCESSIBLE CONC. RAMP - SEE 2/C-2.
- 4" WIDE PARKING STRIPING, H.C. SYMBOLS & MARKINGS @ 36" O.C.
- 6" CONC. REFUSE PAD & ENCLOSURES, SEE DETAIL 3/C-2.
- 5'x5' CONCRETE STOOP.
- 6" CONC. APRON - (12' X 5').
- DECORATIVE GRAVEL IN UNDEVELOPED AREAS.
- HANDICAPPED/VAN PARKING SIGN - SEE 1/C-2.
- POLE MOUNTED SITE LIGHTS - SEE ELEC. DWGS.
- CONCRETE RUNDOWN (SEE SHT. 2 OF 2 FOR DETAILS).
- NEW WATER METER - V.I.F.
- RIPRAP RUNDOWN PER CERTIFIED AS-CONSTRUCTED PLAN.
- ROOF DRAIN & SIDEWALK CULVERT.
- ROOF DRAIN AND 24" X 6" CONC. RUNDOWN.

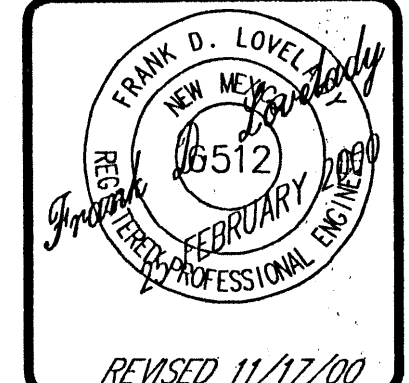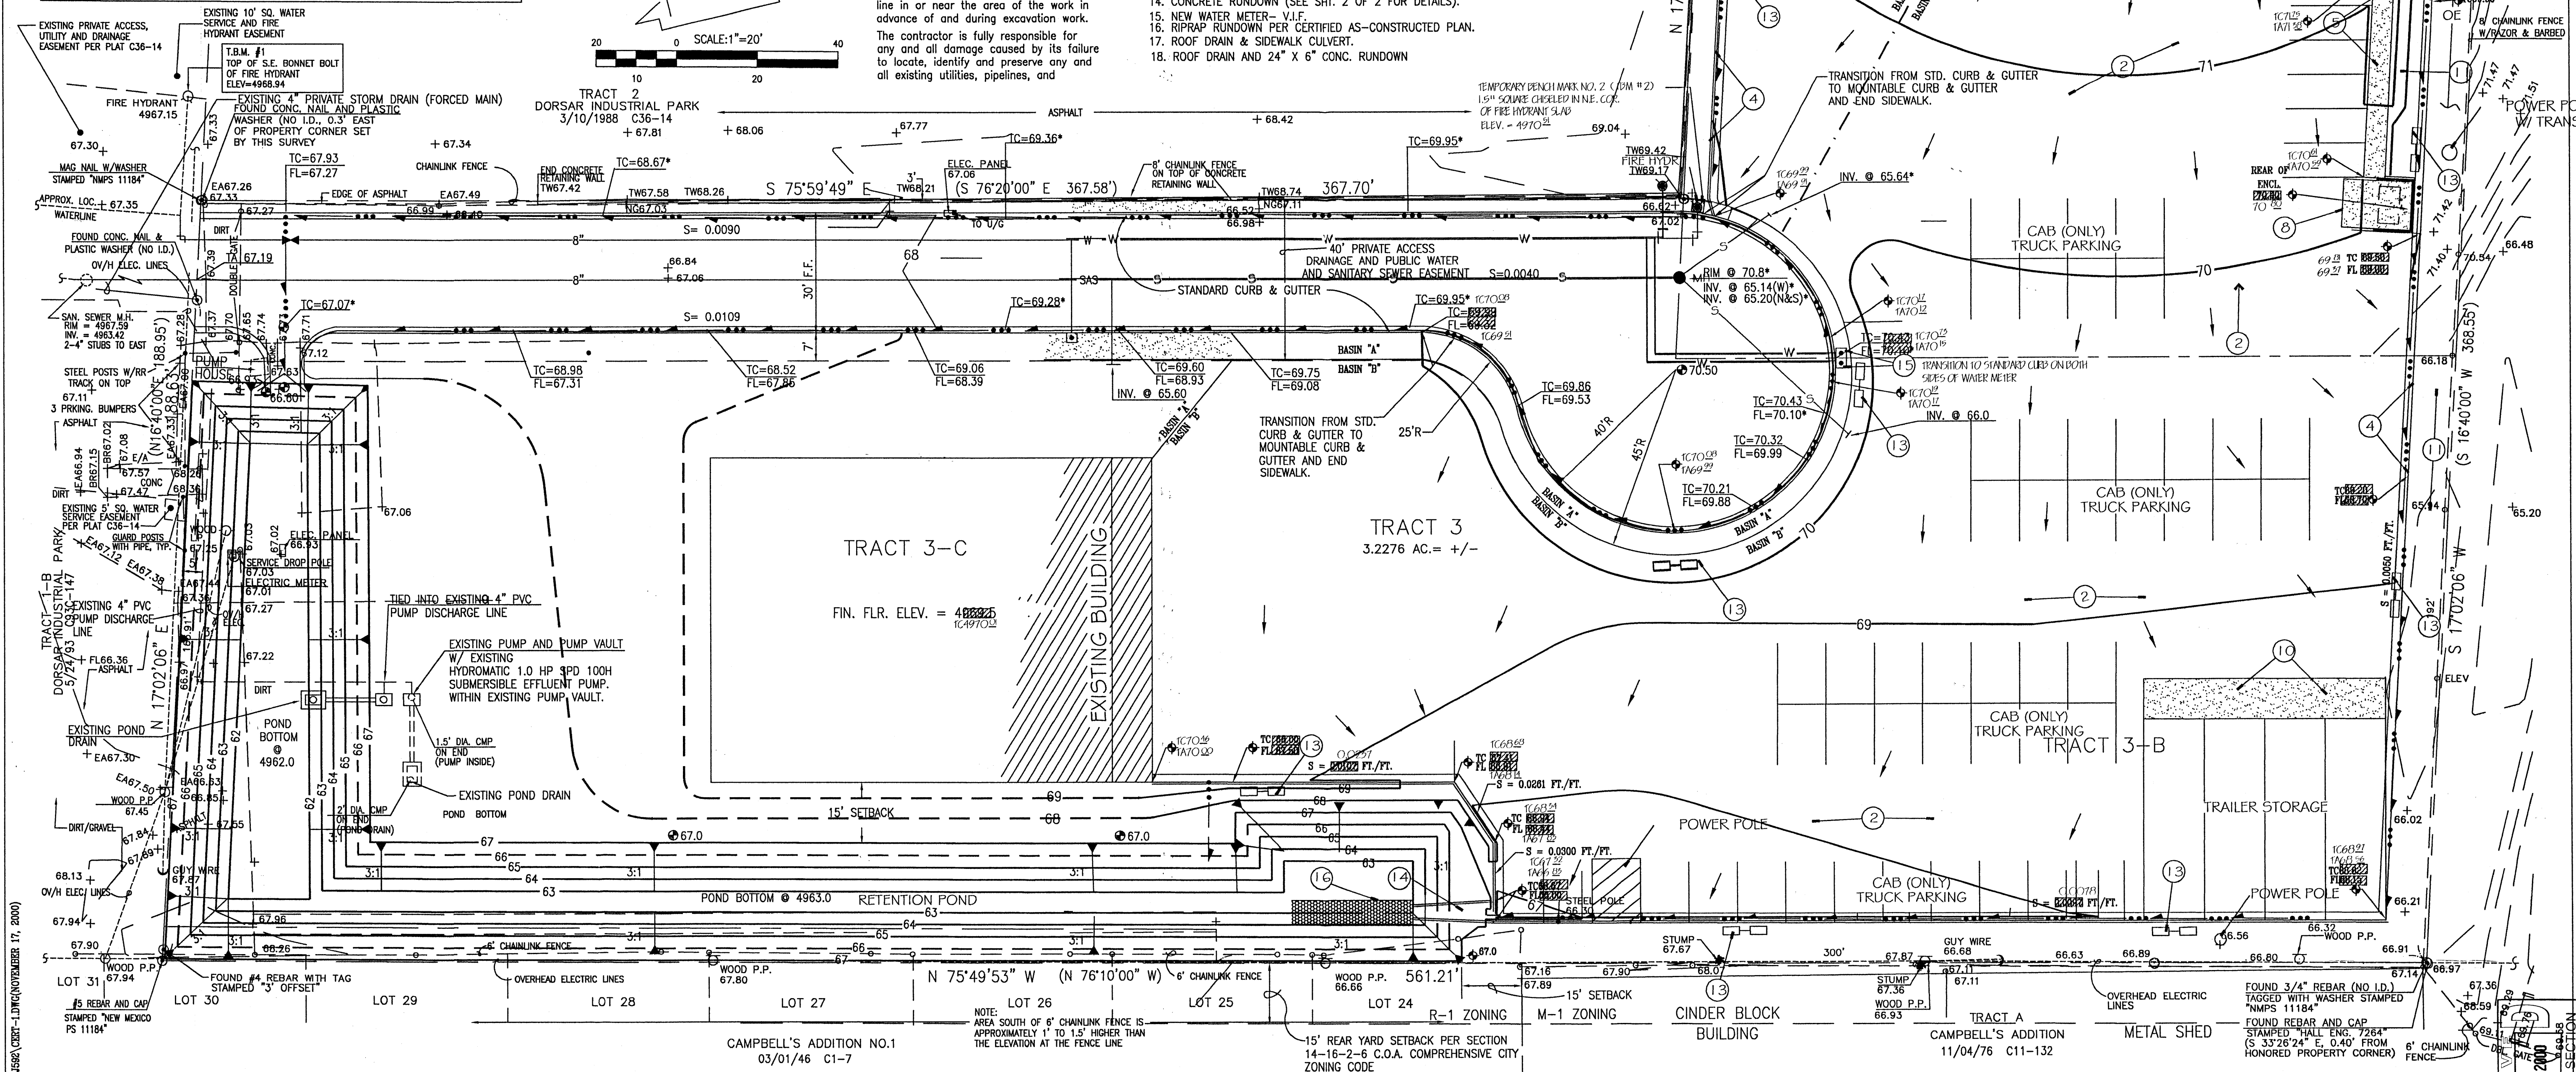

AS-CONSTRUCTED PLAN
GRADING AND DRAINAGE PLAN
SUNLAND INTERNATIONAL NAVAJO
AT DORSAR INDUSTRIAL PARK
ALBUQUERQUE, NEW MEXICO

FRANK D. LOVELADY, P.E.
(505) 345-2267 • Fax (505) 345-2115 • 300 ALAMOSA RD. NW • Albuquerque, NM • 87107

JOB NO:	592
DATE:	NOVEMBER 17, 2000
REVISIONS	

SHEET NO. 1 OF 2