

CITY OF ALBUQUERQUE



Tim Keller, Mayor

December 7, 2017

Donald Duneman, P.E.
Wilson & Company
4900 Lang Ave NE
Albuquerque, NM, 87109

**RE: Rankin Training Facility
720 Rankin Road NE
Request for Permanent C.O. – Accepted
Engineer's Certification Dated 11/30/17
Hydrology File: G15D061**

Dear Mr. Duneman:

PO Box 1293

Based on the Certification received 12/05/17 and site visit on 12/06/17, the site is acceptable for a Permanent Certificate of Occupancy by Hydrology for 720 Rankin Road NE.

Albuquerque

If you have any questions, please contact me at 924-3995 or rbrissette@cabq.gov.

NM 87103

Sincerely,

Renée C. Brissette

www.cabq.gov

Renée C. Brissette, P.E. CFM
Senior Engineer, Hydrology
Planning Department



City of Albuquerque

Planning Department

Development & Building Services Division

DRAINAGE AND TRANSPORTATION INFORMATION SHEET (REV 09/2015)

Project Title: _____ **Building Permit #:** _____ **City Drainage #:** _____

DRB#: _____ **EPC#:** _____ **Work Order#:** _____

Legal Description: _____

City Address: _____

Engineering Firm: _____ **Contact:** _____

Address: _____

Phone#: _____ **Fax#:** _____ **E-mail:** _____

Owner: _____ **Contact:** _____

Address: _____

Phone#: _____ **Fax#:** _____ **E-mail:** _____

Architect: _____ **Contact:** _____

Address: _____

Phone#: _____ **Fax#:** _____ **E-mail:** _____

Other Contact: _____ **Contact:** _____

Address: _____

Phone#: _____ **Fax#:** _____ **E-mail:** _____

Check all that Apply:

DEPARTMENT:

- ☐ HYDROLOGY/ DRAINAGE
☐ TRAFFIC/ TRANSPORTATION
☐ MS4/ EROSION & SEDIMENT CONTROL

TYPE OF SUBMITTAL:

- ☐ ENGINEER/ ARCHITECT CERTIFICATION
- ☐ CONCEPTUAL G & D PLAN
☐ GRADING PLAN
☐ DRAINAGE MASTER PLAN
☐ DRAINAGE REPORT
☐ CLOMR/LOMR
- ☐ TRAFFIC CIRCULATION LAYOUT (TCL)
☐ TRAFFIC IMPACT STUDY (TIS)
☐ EROSION & SEDIMENT CONTROL PLAN (ESC)
- ☐ OTHER (SPECIFY) _____

CHECK TYPE OF APPROVAL/ACCEPTANCE SOUGHT:

- ☐ BUILDING PERMIT APPROVAL
☐ CERTIFICATE OF OCCUPANCY
- ☐ PRELIMINARY PLAT APPROVAL
☐ SITE PLAN FOR SUB'D APPROVAL
☐ SITE PLAN FOR BLDG. PERMIT APPROVAL
☐ FINAL PLAT APPROVAL
☐ SIA/ RELEASE OF FINANCIAL GUARANTEE
☐ FOUNDATION PERMIT APPROVAL
☐ GRADING PERMIT APPROVAL
☐ SO-19 APPROVAL
☐ PAVING PERMIT APPROVAL
☐ GRADING/ PAD CERTIFICATION
☐ WORK ORDER APPROVAL
☐ CLOMR/LOMR
- ☐ PRE-DESIGN MEETING
☐ OTHER (SPECIFY) _____

IS THIS A RESUBMITTAL?: ☐ Yes ☐ No

DATE SUBMITTED: _____ **By:** _____

COA STAFF: _____ ELECTRONIC SUBMITTAL RECEIVED: _____

HYDROLOGY SUMMARY

PROJECT NAME:		Rankin Training Facility												100 YEAR	
JOB NUMBER:		16-600-007-00		AREA		LAND TREATMENTS		Q		VOLUME (ac.ft.)					
BASIN	COND.	DESCRIPTION		(acres)	A	B	C	D	(cfs)	6 HR	24 HR	4 DAY	10 DAY		
ONSITE	EXISTING			2.0200	0.0%	0.0%	0.0%	100.0%	9.49	0.357	0.424	0.5168	0.6262		
ONSITE	DEVELOPED			2.0200	0.0%	0.0%	0.0%	100.0%	9.49	0.357	0.424	0.5168	0.6262		

INPUT DATA:

PRECIP.	RAINFALL DEPTHS (INCHES) AT 100-YEAR STORM				
ZONE	1 HOUR	6 HOUR	24 HOUR	4 DAY	10 DAY
2	2.01	2.35	2.75	3.30	3.95

SITE LOCATION & PROJECT BACKGROUND:

RANKIN TRAINING FACILITY IS LOCATED AT 720 RANKIN ROAD, NE IN ALBUQUERQUE, NEW MEXICO. THE PROPERTY AREA IS 2.02 AC AND INCLUDES A MAIN AND MODULAR BUILDINGS WITH ASPHALT PAVED PARKING LOT. THE PROPOSED IMPROVEMENTS INCLUDES REMOVAL OF EXISTING MODULAR BUILDINGS IN THEIR ENTIRETY AND INSTALLING ASPHALT WHERE MODULAR BUILDINGS WERE LOCATED. EXISTING PAVED PARKING AREAS WILL REMAIN IN THEIR EXISTING CONDITION.

METHODOLOGY:

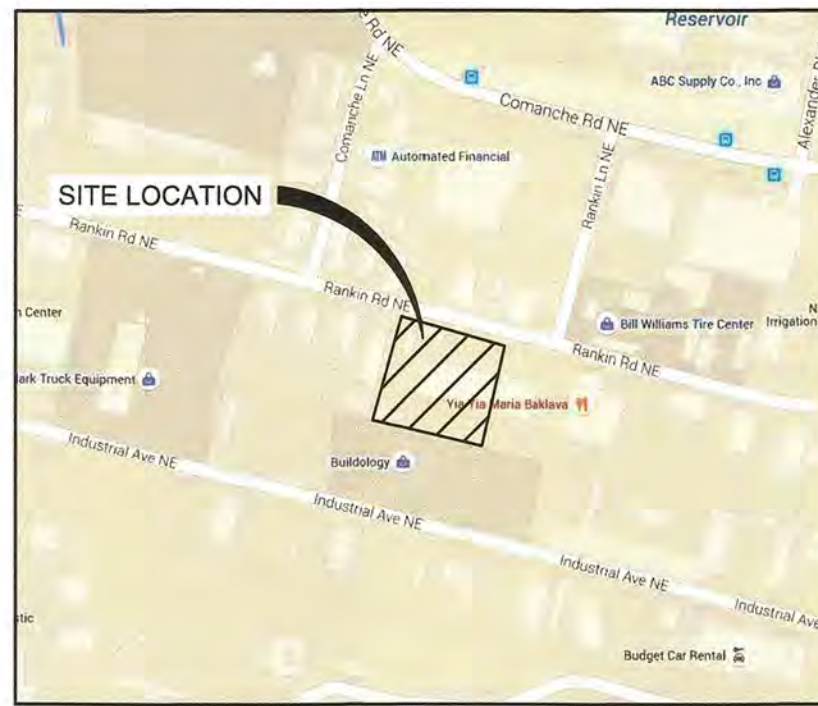
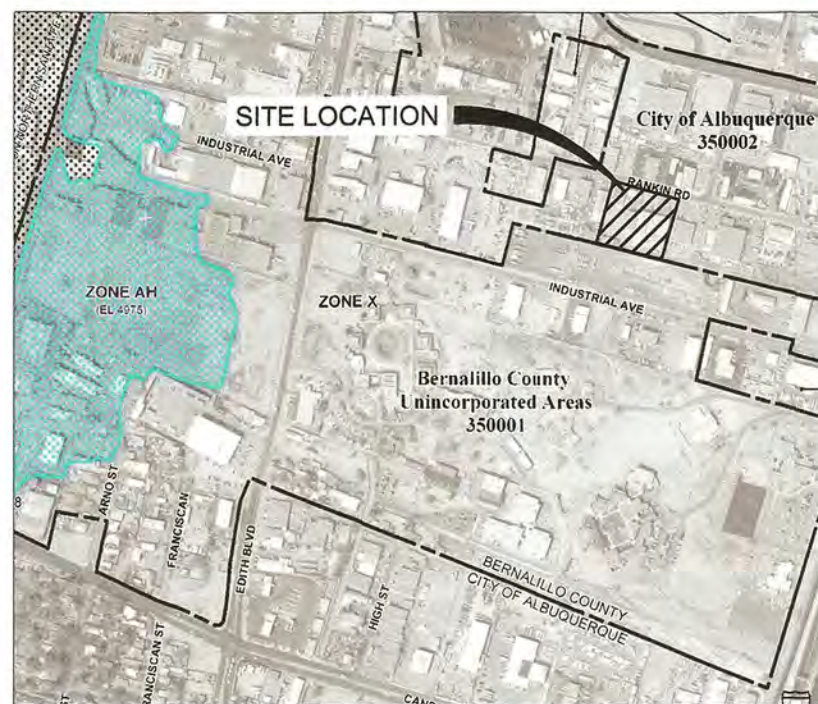
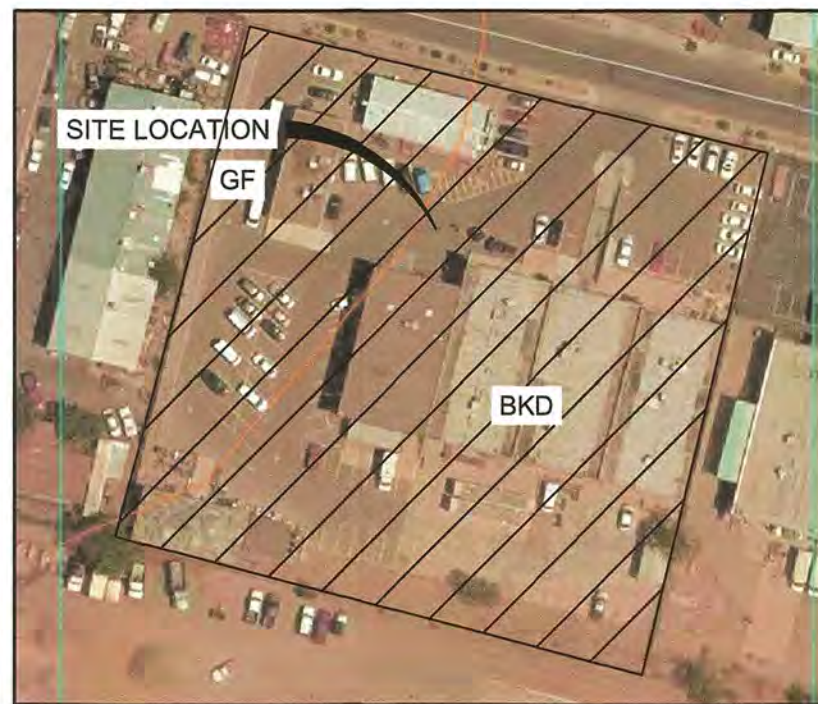
CITY OF ALBUQUERQUE (COA) DEVELOPMENT PROCESS MANUAL (DPM) SECTION 22.2 HYDROLOGY WAS UTILIZED TO CALCULATE EXISTING AND DEVELOPED PEAK RUNOFF AND VOLUME. SEE HYDROLOGY SUMMARY TABLE THIS SHEET.

EXISTING CONDITIONS:

THE EXISTING SITE SLOPES IN A NORTH-WESTERLY DIRECTION AND DRAINS INTO RANKIN ROAD. APPROXIMATELY 1.6 AC OF THE SITE IS COVERED WITH BLUEPOINT-KOKAN ASSOCIATION TYPE SOIL, CLASSIFIED AS HYDROLOGIC SOIL GROUP "A" AND EXCESSIVELY DRAINED. THE REMAINDER OF THE SITE IS COVERED WITH GLA COMPLEX, MODERATELY ALKALI TYPE SOIL CLASSIFIED AS HYDROLOGIC SOIL GROUP "C" AND WELL DRAINED. THE SITE IS LOCATED IN ZONE "X" PER FEMA FLOOD INSURANCE RATE MAP DEFINED AS AREAS WHICH ARE OUTSIDE THE 500-YEAR ANNUAL CHANCE FLOODPLAIN. MAJORITY OF GENERATED RUNOFF SHEET FLOWS TO THE WEST AND ACCUMULATES AT A LOW POINT AT THE EXISTING CURB ALONG THE WEST EDGE OF THE PROPERTY. THE CURB HEIGHT VARIES FROM 6 INCH TO 13 INCHES. A 4 INCH PIPE CONVEYS FLOWS FROM THIS POINT INTO RANKIN ROAD. RUNOFF FROM THE NORTH OF THE PROPERTY ALONG RANKIN ROAD SHEET FLOWS DIRECTLY INTO RANKIN ROAD. THERE ARE NO OFFSITE FLOWS ENTERING THE SITE. THE SITE GENERATES 9.49 CFS IN ITS CURRENT CONDITIONS IN A 100-YR STORM EVENT. SEE HYDROLOGY SUMMARY TABLE.

DEVELOPED CONDITIONS:

THE PROPOSED PARKING IMPROVEMENTS WILL INCLUDE ADA ACCESSIBLE PARKING SPACES AND RAMPS. THE CONCRETE SURFACE AREAS UNDER EXISTING MODULAR BUILDINGS WILL BE PAVED WITH ASPHALT. THE ASPHALT LAND TREATMENT WILL BE IMPERVIOUS WHICH WILL RESULT IN THE SAME AMOUNT OF RUNOFF AS IN THE EXISTING CONDITIONS. THE DEVELOPED DRAINAGE PATTERN WILL BE THE SAME AS THE EXISTING CONDITIONS. THE EXISTING PIPE ALONG THE WEST EDGE OF THE PROPERTY CONVEYS FLOWS TO RANKIN ROAD. THE SITE GENERATES 9.49 CFS IN A 100-YR STORM EVENT IN THE DEVELOPED CONDITIONS WHICH IS THE SAME AS THE EXISTING CONDITIONS. SEE THIS SHEET FOR HYDROLOGY SUMMARY TABLE AND GRADING DETAILS. EROSION AND SEDIMENT CONTROL PLAN IS NOT WARRANTED SINCE THE DISTURBED AREA IS LESS THAN ONE ACRE.

LOCATION
ZONE ATLAS MAP G-15FLOOD INSURANCE RATE MAP
REFERENCE: FLOOD INSURANCE STUDY
PANEL 332 #35001C0332G
SEPT 26, 2008SOILS MAP
REFERENCE: HTTP://WEB Soil SURVEY.NRCS.USDA.GOV3" ASPHALT SP-B 1 LIFT
PER SECTION 116,33612" SUBGRADE PREP
COMPACTED TO 95% MIN
DENSITY PER ASTM D 1557
SECTION 301C4 3" ASPHALT PAVEMENT SECTION
NTS

CERTIFICATE OF SUBSTANTIAL COMPLIANCE OF PLANS

I, DONALD M. DUNEMAN OF THE FIRM WILSON AND COMPANY, A REGISTERED PROFESSIONAL ENGINEER IN THE STATE OF NEW MEXICO, HEREBY CERTIFY, THAT THIS PROJECT HAS BEEN GRADED AND WILL DRAIN IN SUBSTANTIAL COMPLIANCE WITH AND IN ACCORDANCE WITH THE DESIGN INTENT OF THE APPROVED PLAN 11/30/17. I CERTIFY TO THE BEST OF MY KNOWLEDGE AND BELIEF, THAT THE SITE GRADING WAS COMPLETED AS PART OF THIS PROJECT HAS BEEN INSPECTED BY ME OR BY A QUALIFIED PERSON UNDER MY DIRECT SUPERVISION. THIS CERTIFICATION IS SUBMITTED IN SUPPORT OF A REQUEST FOR BUILDING PERMIT. THE RECORD INFORMATION PRESENTED HEREON IS NOT NECESSARILY COMPLETE AND INTENDED ONLY TO VERIFY SUBSTANTIAL COMPLIANCE OF THE GRADING AND DRAINAGE ASPECTS OF THIS PROJECT.

DONALD M. DUNEMAN, P.E. NM 17616

11/30/17
DATE

SURVEYOR'S CERTIFICATE:

I, BENJAMIN M. ARAGON, NEW MEXICO PROFESSIONAL SURVEYOR NO. 15268, DO HEREBY CERTIFY THAT THIS AS-BUILT SURVEY WAS PERFORMED BY ME OR UNDER MY DIRECT SUPERVISION; THAT I AM RESPONSIBLE FOR THIS SURVEY; THAT THIS SURVEY MEETS THE MINIMUM STANDARDS FOR SURVEYING IN NEW MEXICO; AND IS TRUE AND CORRECT TO THE BEST OF MY KNOWLEDGE.

BENJAMIN M. ARAGON NMPS 1526811-30-17
DATE

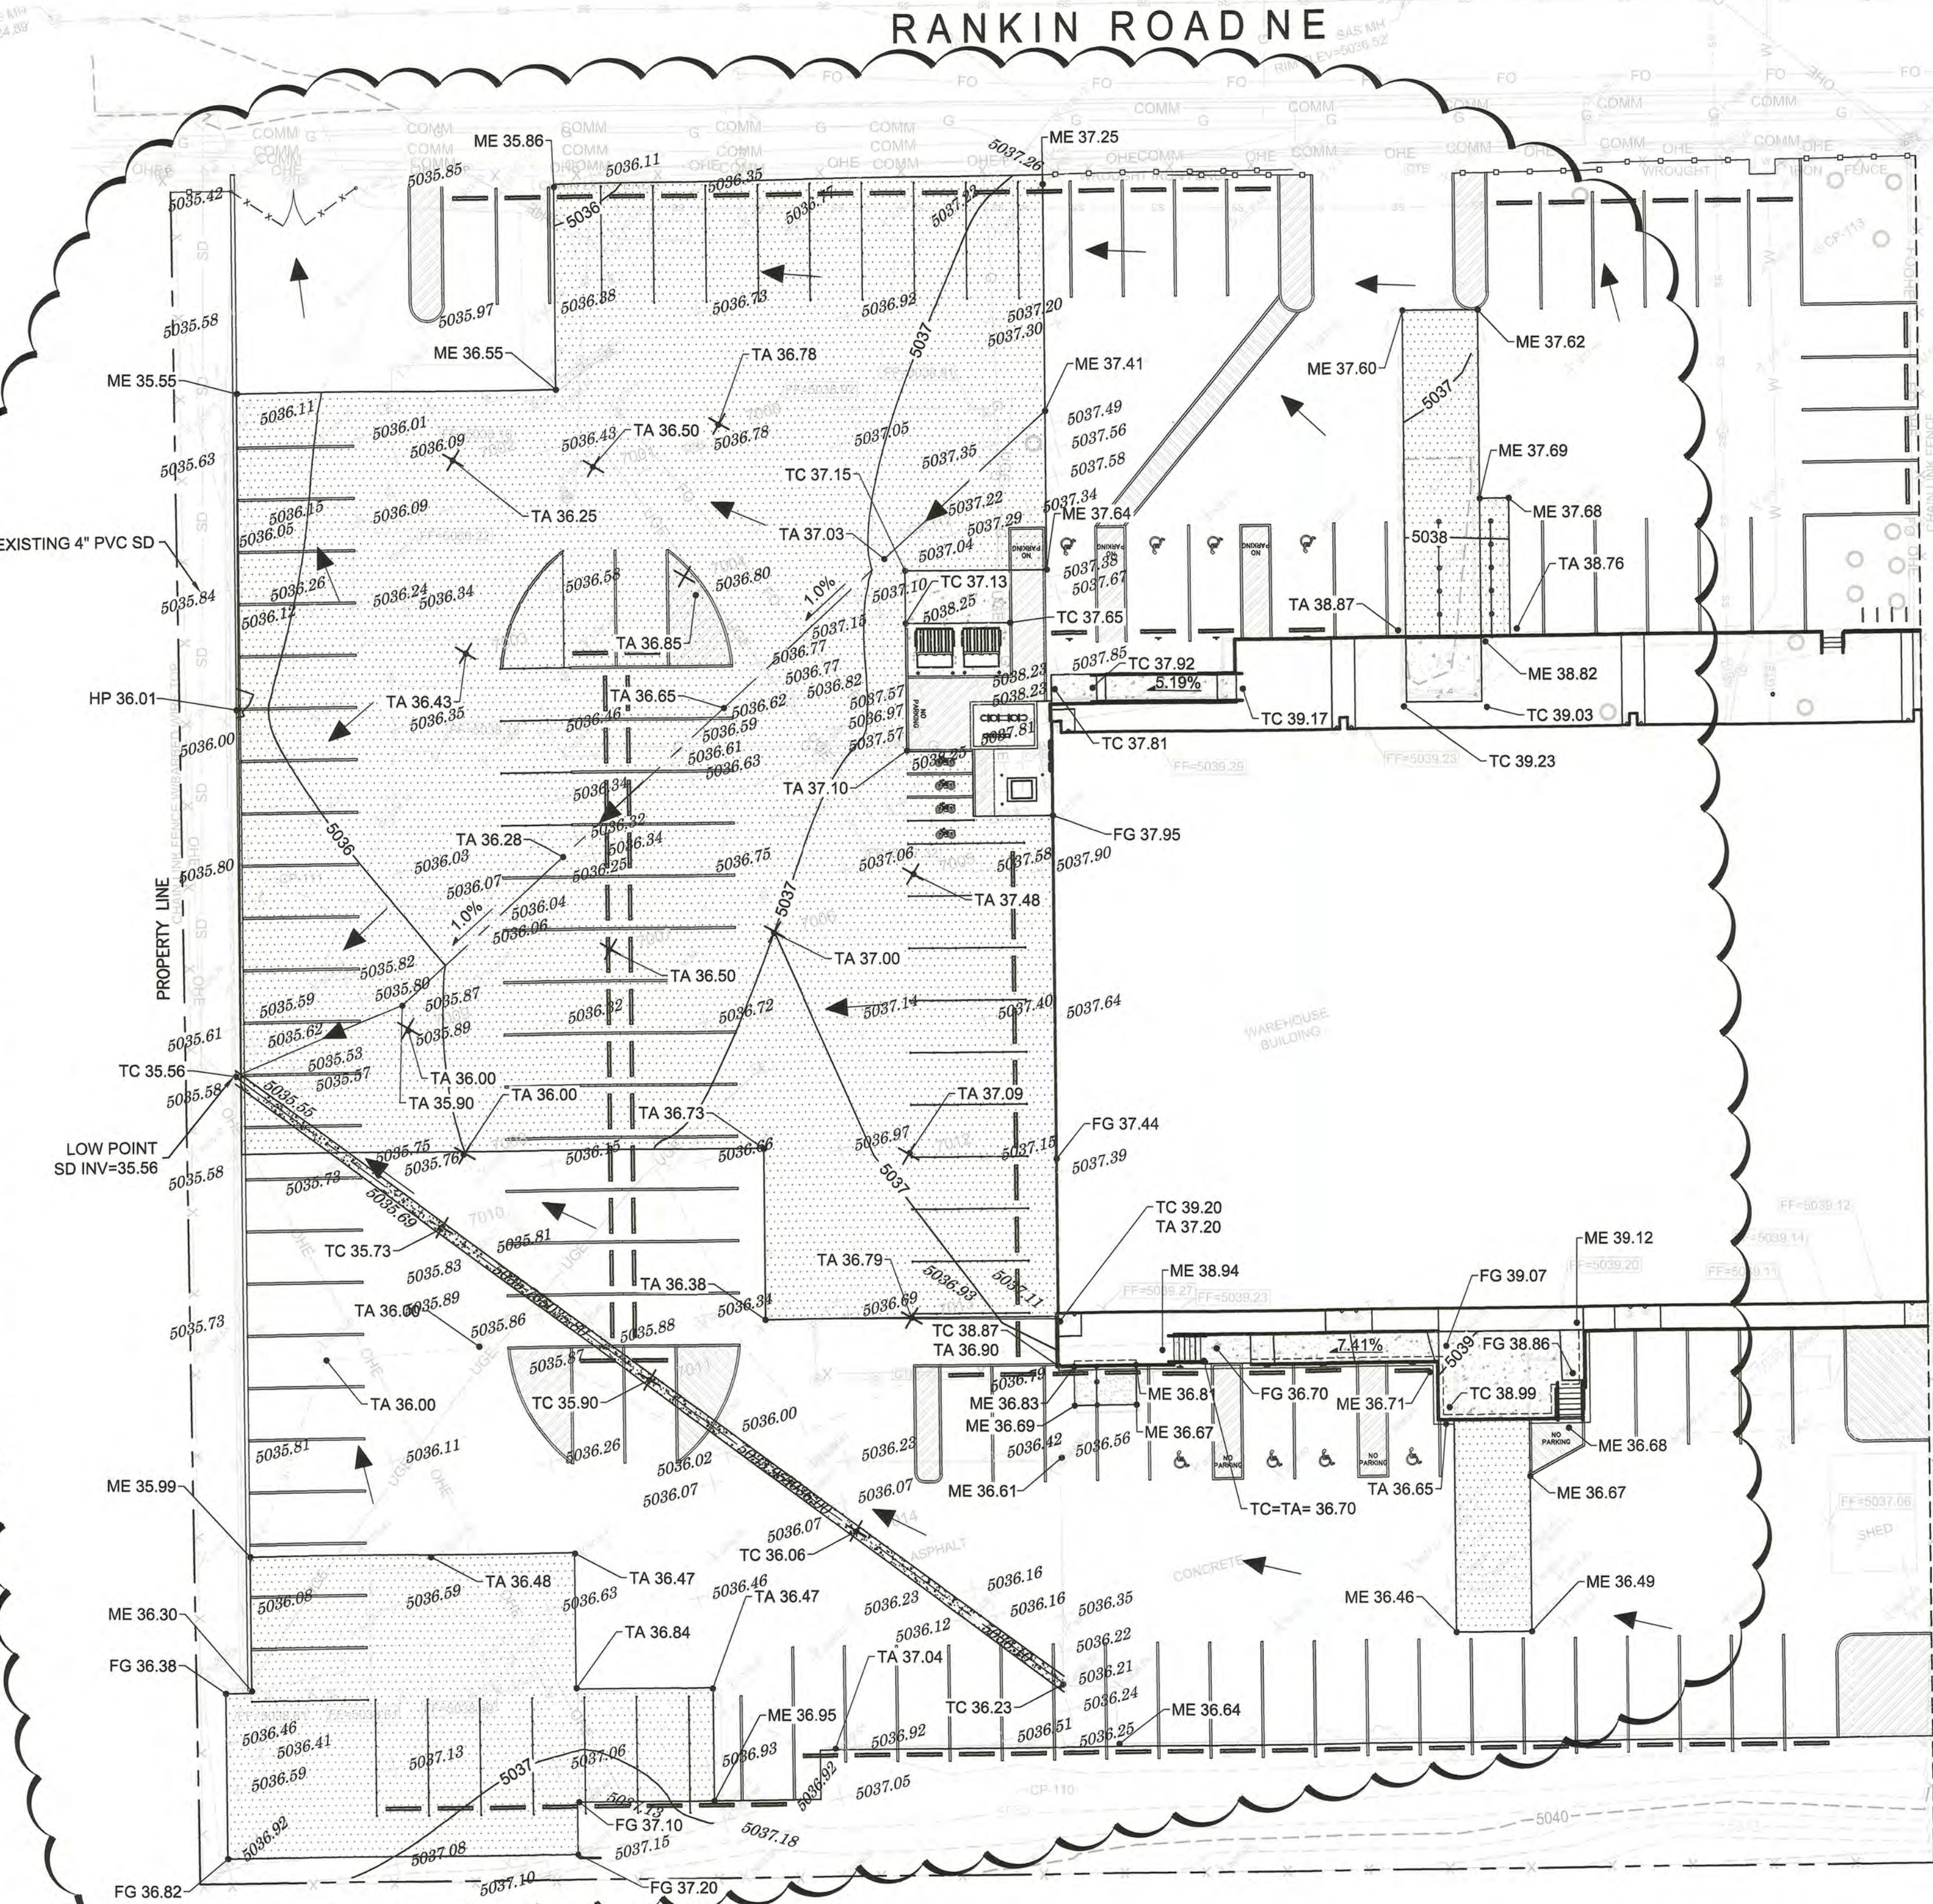
GENERAL NOTES

- REFER TO ARCHITECTURAL SHEETS FOR RETAINING WALL DETAILS

LEGEND

ME	MATCH EXISTING ELEVATION
FG	FINISHED GRADE
TC	TOP OF CONCRETE
TA	TOP OF ASPHALT
	DRAINAGE FLOW PATH
	CONCRETE PAVING

	ASPHALT PAVING. SEE SECTION C4 THIS SHEET
	EXISTING MAJOR CONTOUR
	EXISTING MINOR CONTOUR
	PROPOSED CONTOUR
	ELEVATION, AS-BUILT



A1 GRADING AND DRAINAGE PLAN

SCALE: 1" = 20'

WILSON & COMPANY4800 LANG AVE NE
ALBUQUERQUE, NM 87109
PHONE: 505-243-3499
FAX: 505-243-3553
www.wilsonco.comRANKIN TRAINING FACILITY
SITE RENOVATIONS

720 RANKIN RD. NE ALBUQUERQUE, NEW MEXICO 87107



REVISIONS	
Mark:	Description:
A	10/10/16 ASPHALT

Project #: 16-600-007-00
Date: 02/16/2016
By: Staff
File Name:

SITE GRADING & DRAINAGE PLAN

Sheet of

C-101R