


LAND USE ZONE: M-1
ZONE ATLAS PAGES:
SEISMIC LOCATION

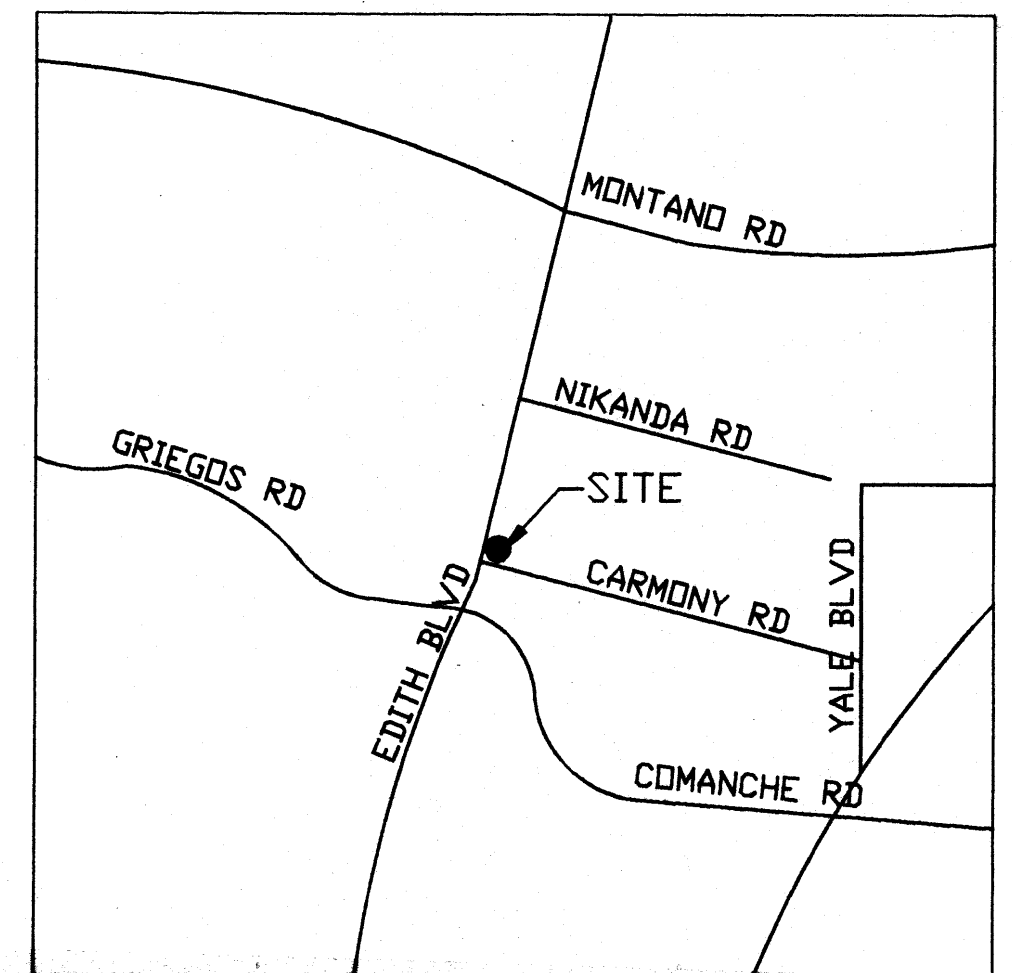

LEGAL DESCRIPTION

Tracts numbered One (1), Two (2), and Three (3) of the LANDS OF LAFARGE, situate within projected Section 4, T10N, R3E, N.M.P.M., Town of Albuquerque, Grant, Bernalillo County, New Mexico as the same are shown and designated on the plat of said Lands filed in the Office of the County Clerk of Bernalillo County, New Mexico, on November 1, 2001, in Book 20014, page 290.

HYDROLOGY NOTES




Charlene Brown

TLC PLUMBING OFFICE

SITE PLAN & TRAFFIC FLOW DIAGRAM

BROWN + WOOTTON
9013 Camino del Sol NE
Albuquerque, NM 87111

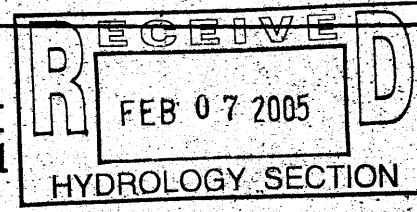


505-797-3383 Phone 505-797-3363 Fax
brownandwootton@msn.com

Designed: CBB	Drawn: JM	Checked: CBB	Sheet: P-1
Scale: 1/8"=1'-0"	Date: 01-05	Job:	

PARKING REQUIREMENTS
NET OFFICE 6724/200 = 34
NET WAREHOUSE - 12960/200 = 7
TOTAL REQUIRED
3 SPACES HC SPACES PROVIDED

PARKING PROVIDED
TOTAL 55
3 HC SPACES

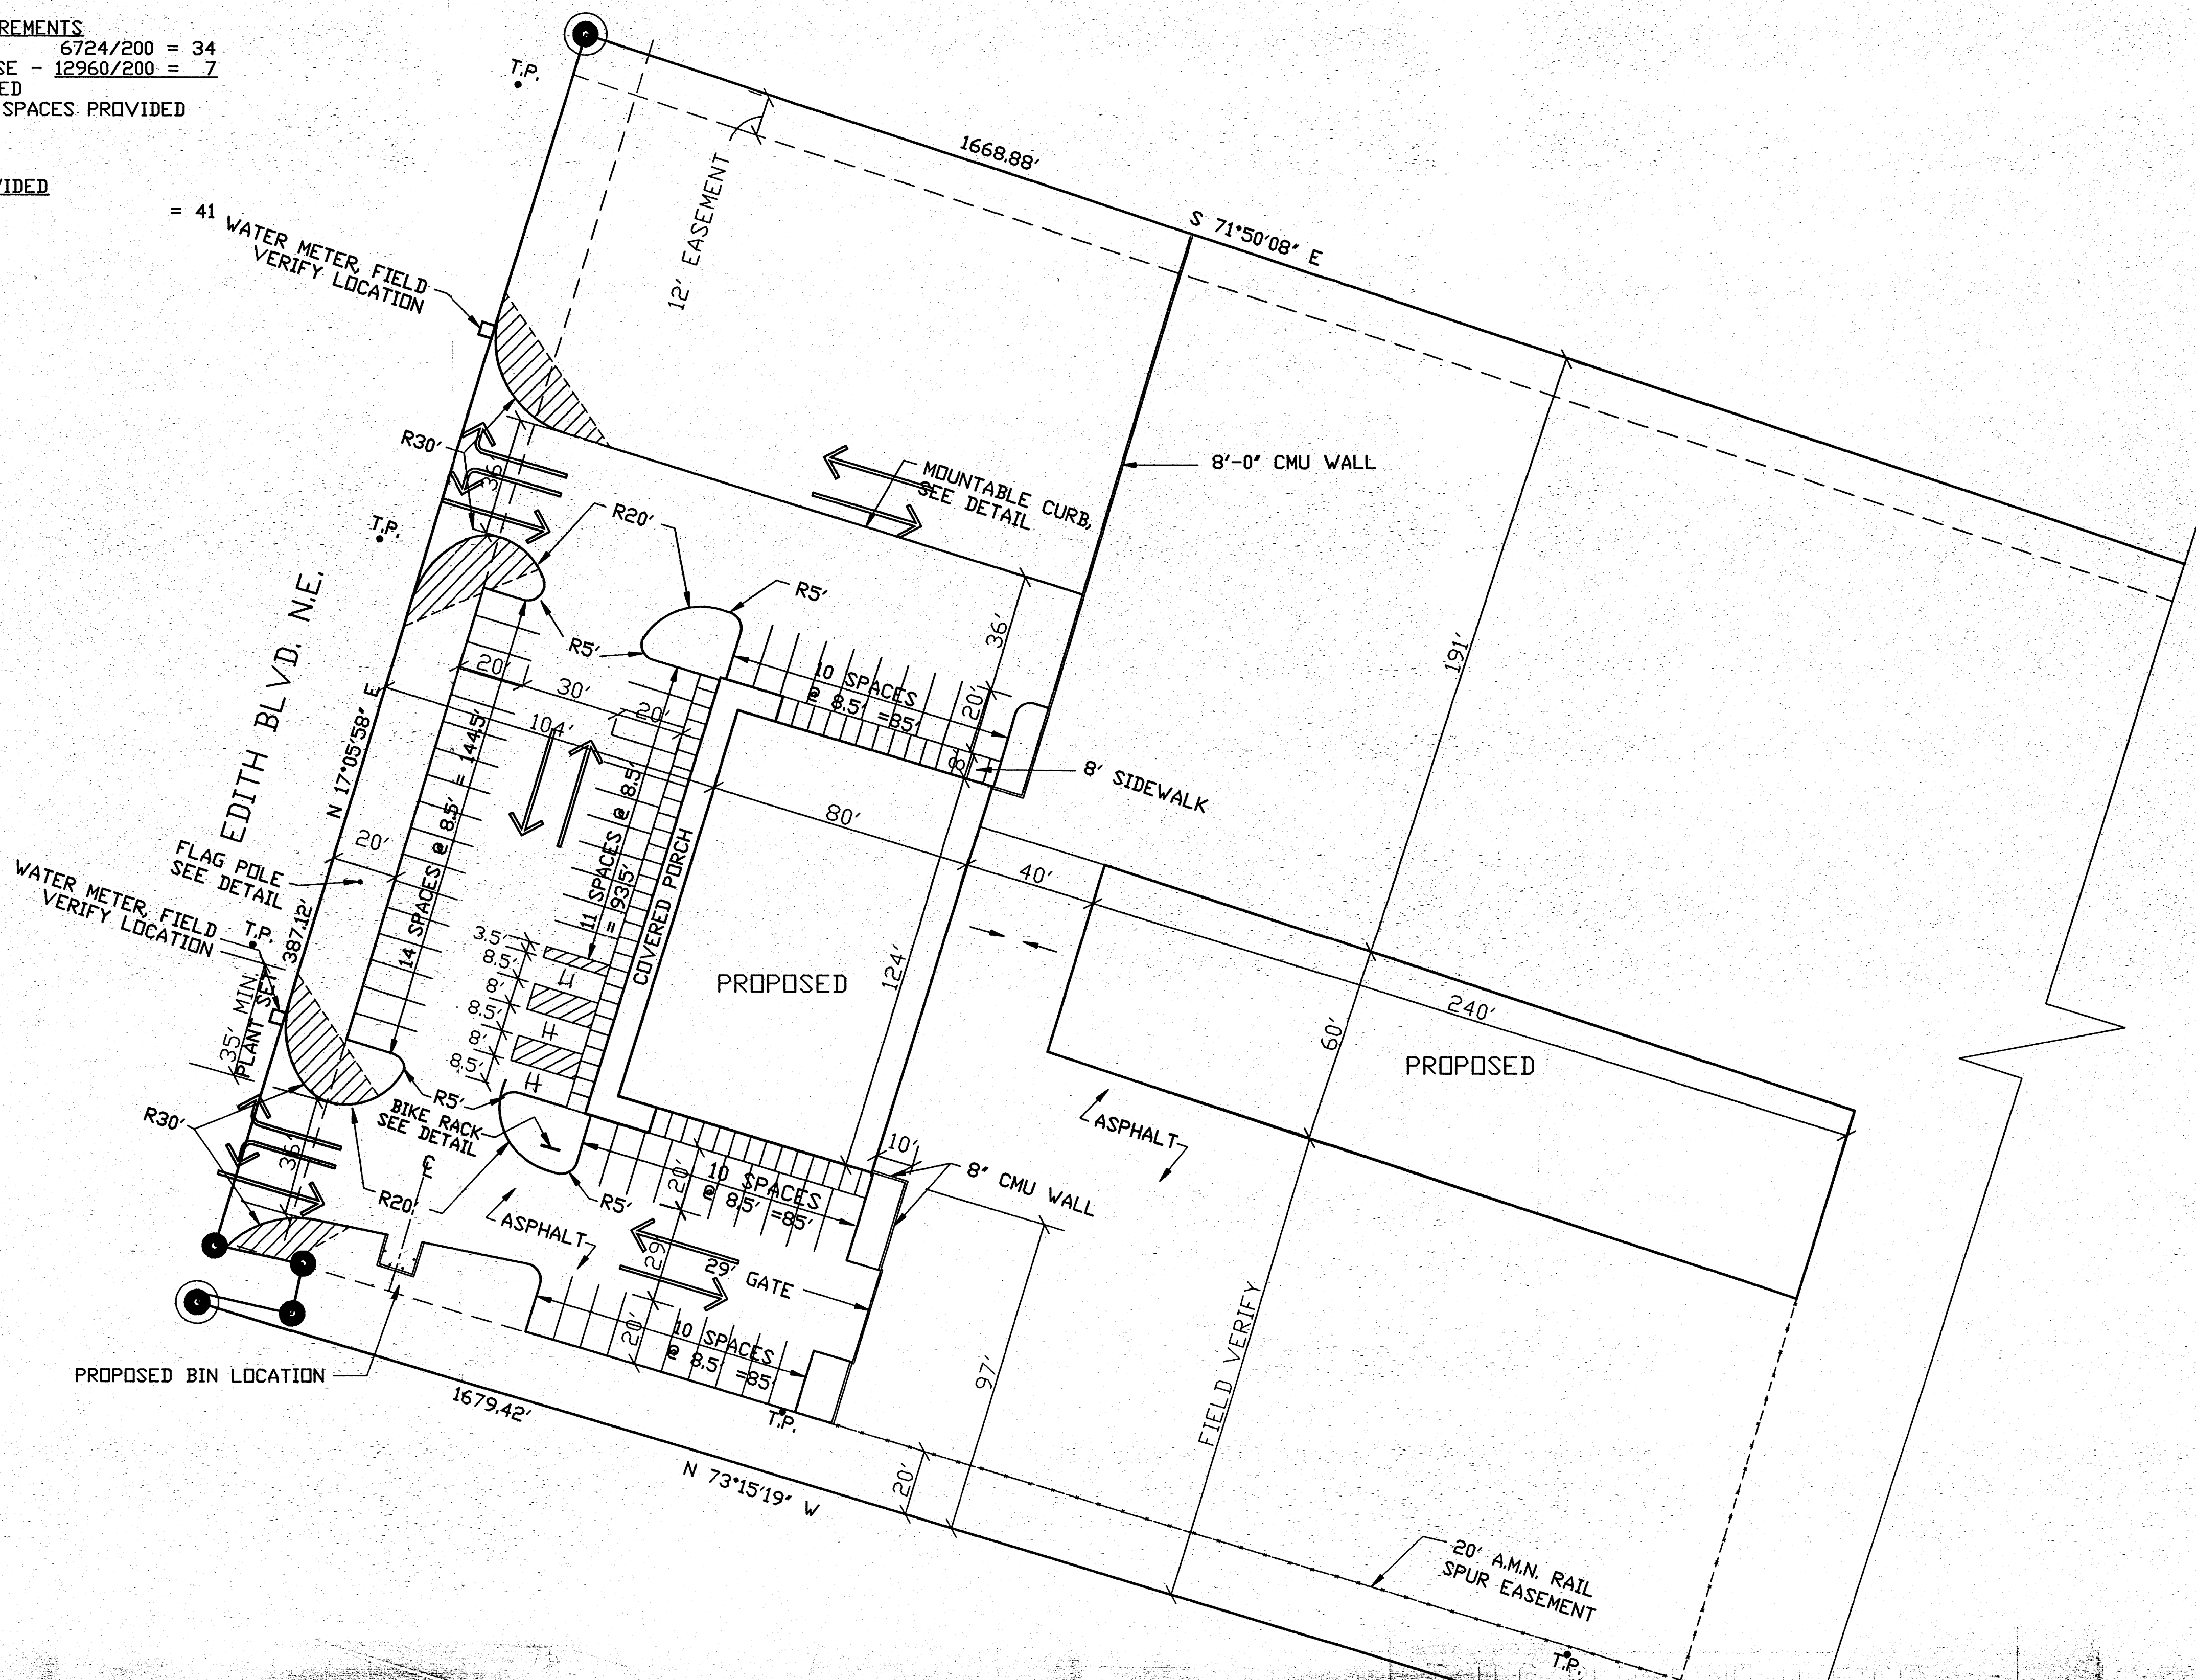


1 SITE PLAN
P-1 SCALE: 1"=30'

BROWN + WOOTTON
9013 Camino del Sol NE
Albuquerque, NM 87111
505-797-3383 Phone 505-797-3363 Fax
brownandwootton@msn.com
Designed: CBB Drawn: JM Checked: CBB
Scale: 1/8"=1'-0" Date: 01-05 Job:


PARKING REQUIREMENTS
 NET OFFICE 6724/200 = 34
 NET WAREHOUSE - 12960/200 = 7
 TOTAL REQUIRED
 3 SPACES HC SPACES PROVIDED

PARKING PROVIDED
 TOTAL 55
 3 HC SPACES

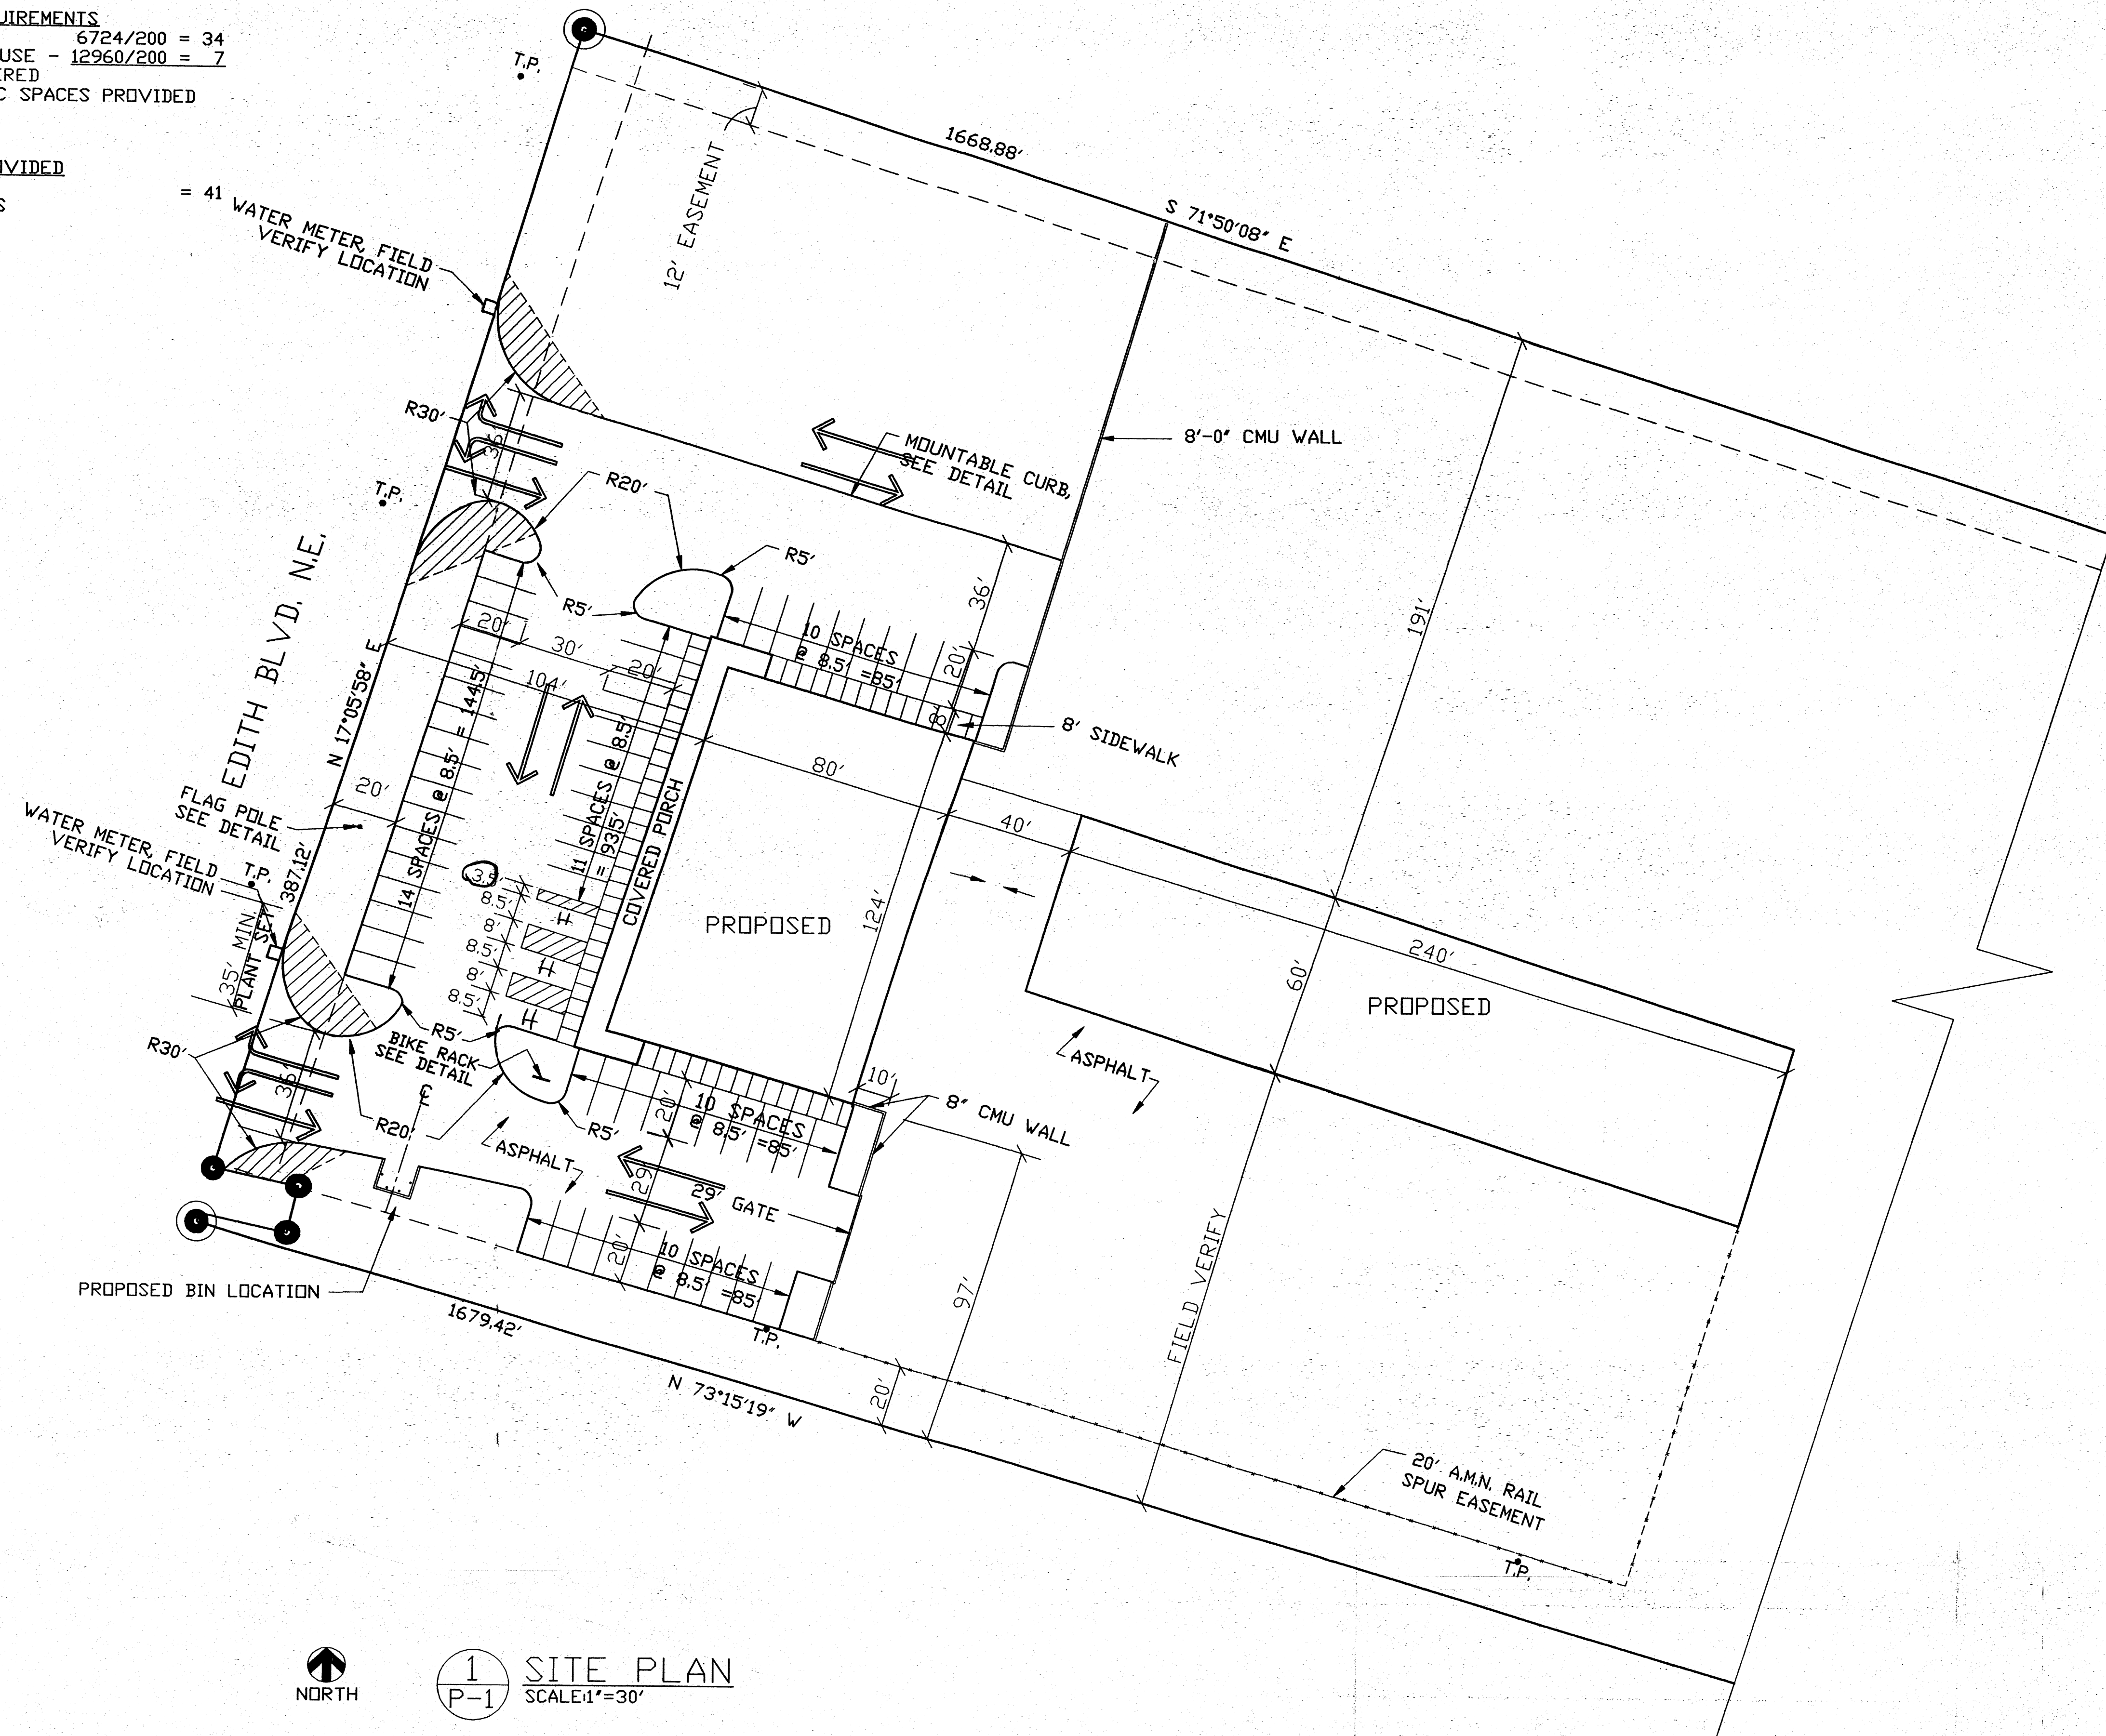



1 SITE PLAN
 P-1 SCALE: 1"=30'

LAND USE ZONE: M-1
ZONE ATLAS PAGES:
SEISMIC LOCATION:

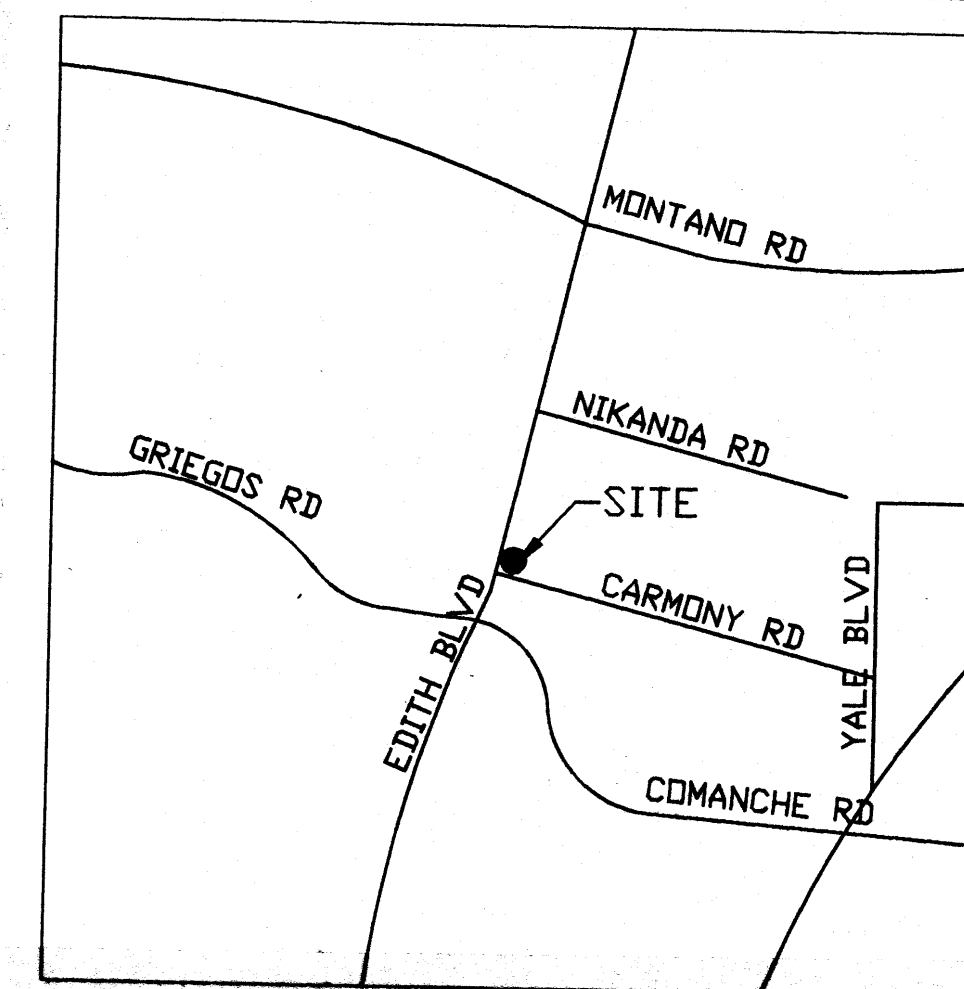

LEGAL DESCRIPTION

Tracts numbered One (1), Two (2), and Three (3) of the LANDS OF LAFARGE, situate within projected Section 4, T10N, R3E, N.M.P.M., Town of Albuquerque Grant, Bernalillo County, New Mexico as the same are shown and designated on the plat of said Lands filed in the Office of the County Clerk of Bernalillo County, New Mexico, on November 1, 2001, in Book 2001C, page 290.

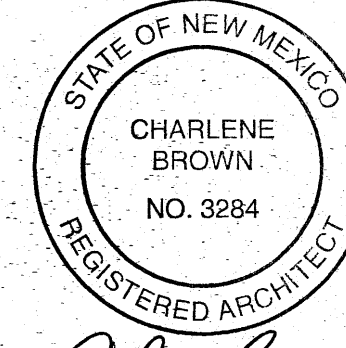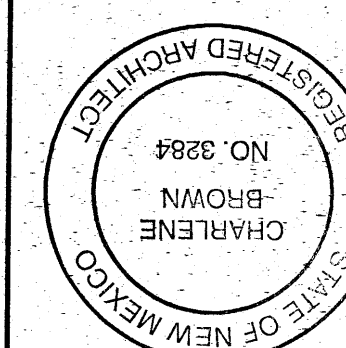


Charlene Brown

TLC PLUMBING OFFICE

SITE PLAN & TRAFFIC FLOW DIAGRAM

BROWN + WOOTTON
 9013 Camino del Sol NE
 Albuquerque, NM 87111

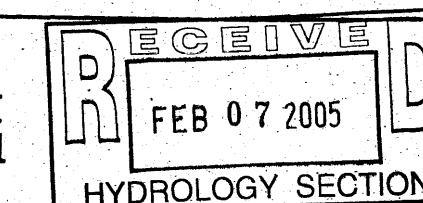


505-797-3383 Phone 505-797-3363 Fax
 brownandwootton@msn.com

Designed: CBB	Drawn: JM	Checked: CBB	Sheet
Scale: 1/8"=1'-0"	Date: 01-05	Job:	P-1

PARKING REQUIREMENTS
 NET OFFICE 6724/200 = 34
 NET WAREHOUSE - 12960/2000 = 7
 TOTAL REQUIRED 41
 3 SPACES HC SPACES PROVIDED


PARKING PROVIDED
 TOTAL 54
 3 HC SPACES

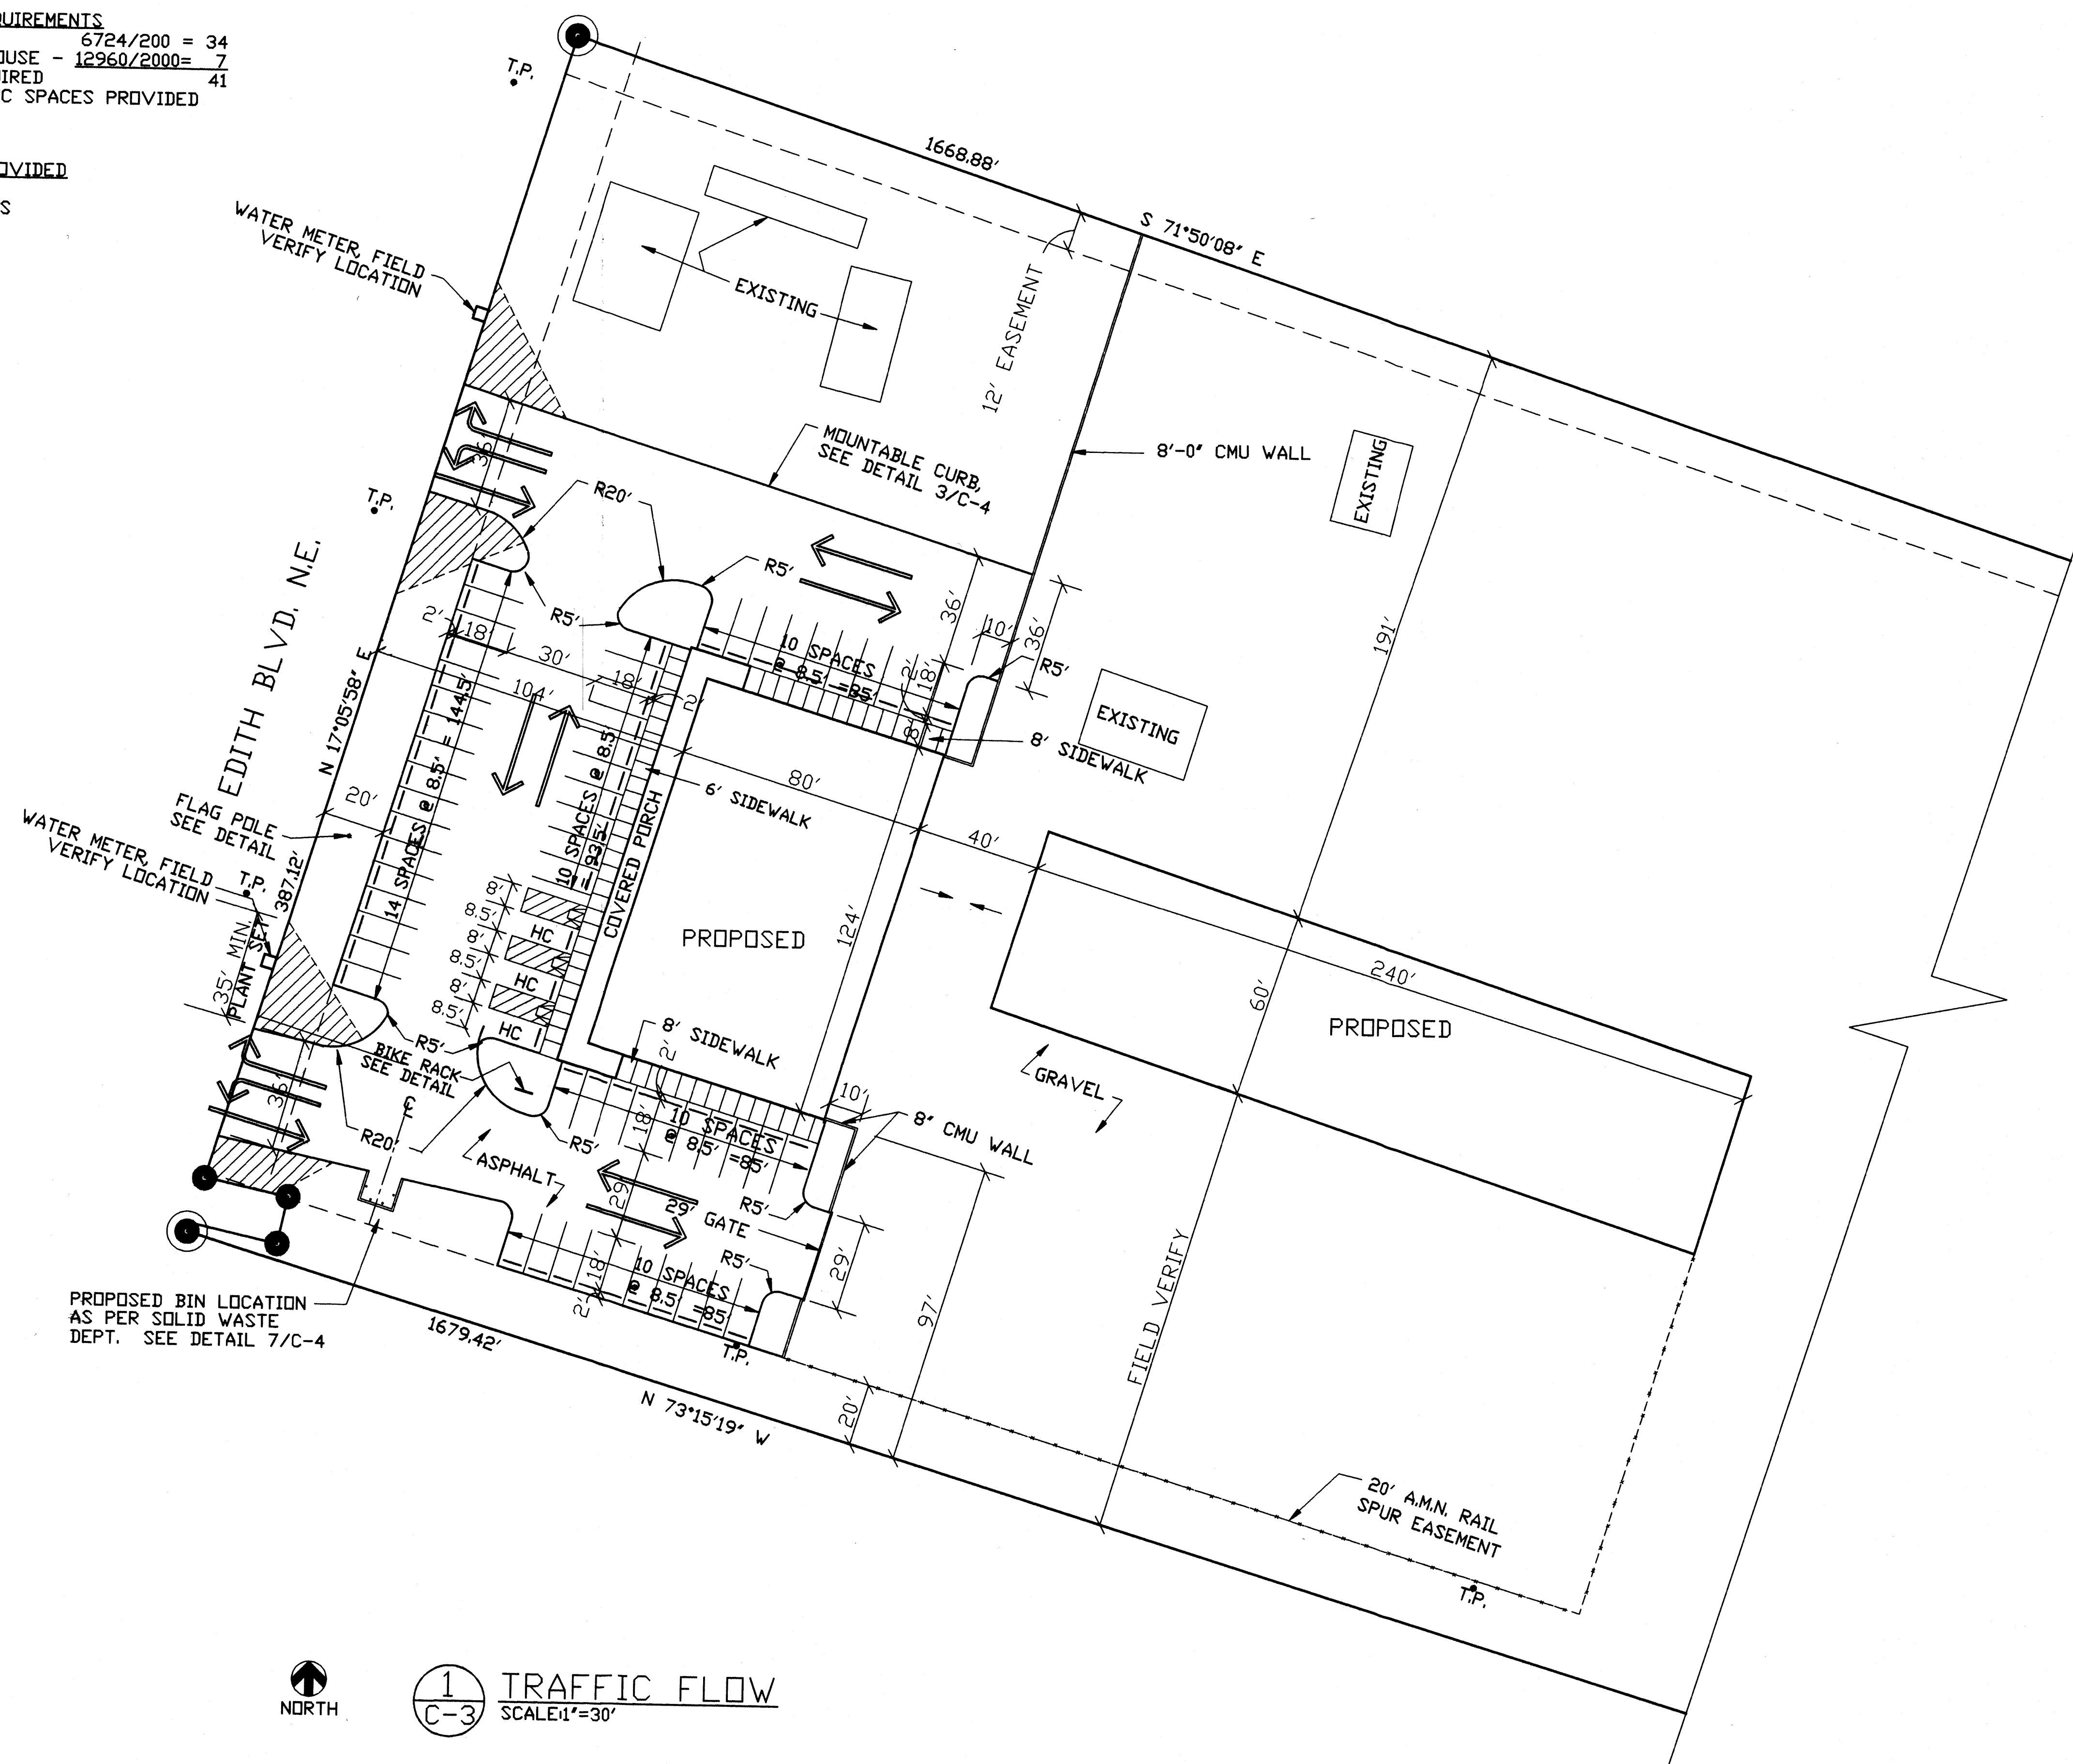

1
C-3

TRAFFIC FLOW
 SCALE 1"=30'




PROJECT LOCATION:
 5030 Edith Blvd NE,
 Albuquerque, NM 87107

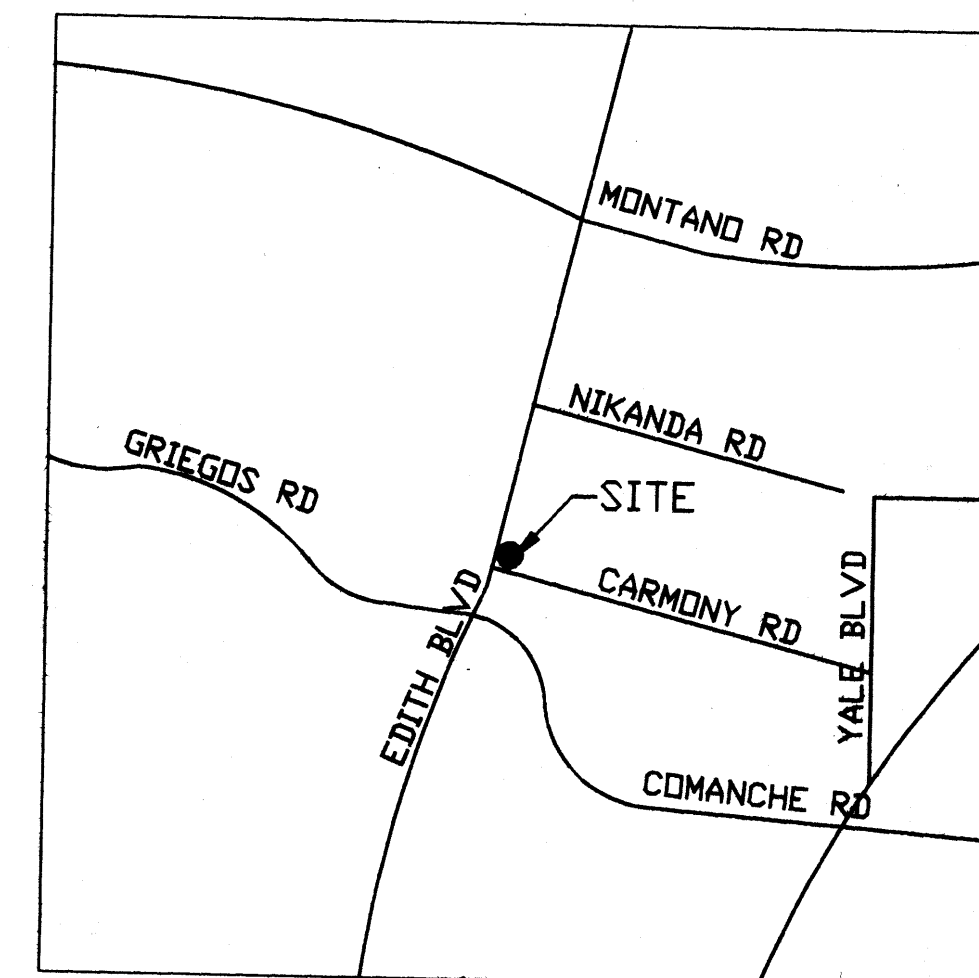

LEGAL DESCRIPTION

Tracts numbered one (1), two (2), and three (3) of the Lands of Lafarge, situate within projected Section 4, T10N, R3E, N.M.P.M., Town of Albuquerque Grant, Bernalillo County, New Mexico, as shown and designated on the plat of said lands filed in the office of the county clerk of Bernalillo, New Mexico, on November 1, 2001, in Book 2001, page 290.

ZONE MAP: G-15

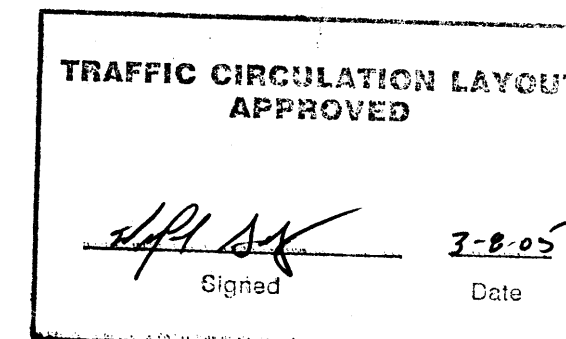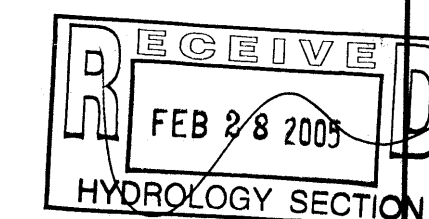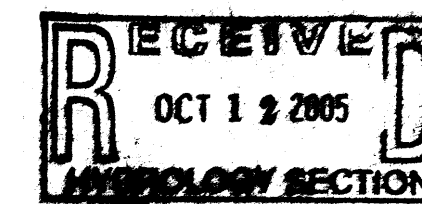


TLC PLUMBING OFFICE

TRAFFIC FLOW INFORMATION

Charlene Brown dba
 BROWN + WOOTTON
 9013 Camino del Sol NE
 Albuquerque, NM 87111

505-797-3383 Phone 505-797-3363 Fax
 brownandwootton@msn.com

Designed: CBB	Drawn: JM	Checked: DA	Sheet
Scale: 1"=30'	Date: 01-05	Job: TLC	C-3

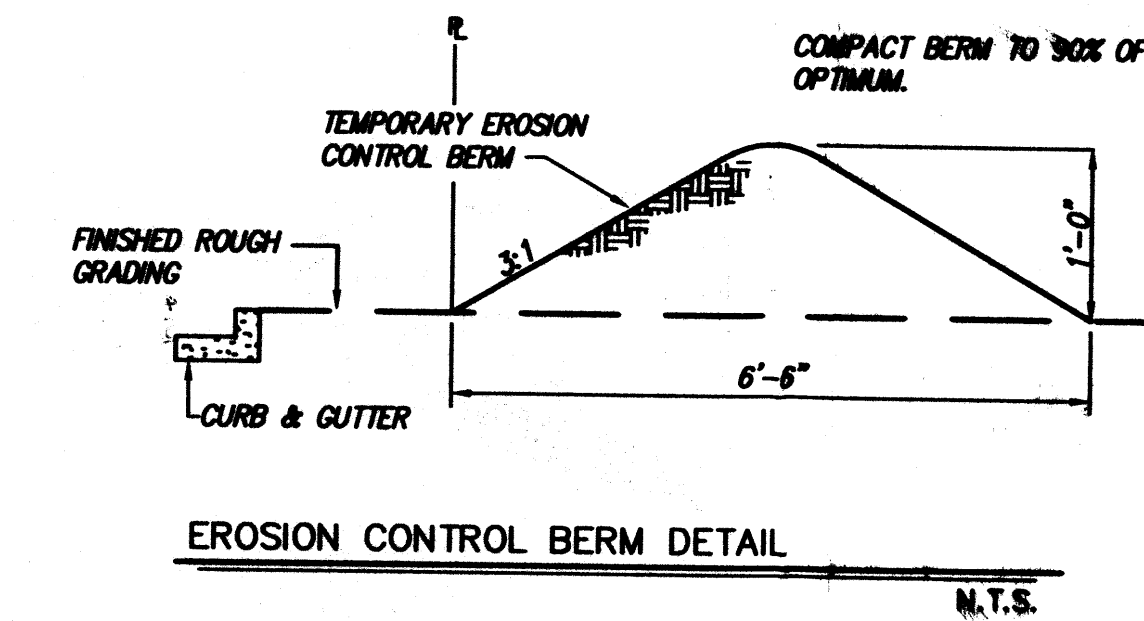

EROSION CONTROL NOTES

1. CONTRACTOR IS RESPONSIBLE FOR OBTAINING A TOPSOIL DISTURBANCE PERMIT PRIOR TO BEGINNING WORK.
2. CONTRACTOR IS RESPONSIBLE FOR KEEPING ALL SEDIMENT OUT OF EXISTING RIGHT-OF-WAY.
3. CONTRACTOR IS RESPONSIBLE FOR CLEANING UP ANY SEDIMENT THAT GETS INTO EXISTING RIGHT-OF-WAY.
4. EROSION CONTROL BERMS ARE REQUIRED AROUND THE ENTIRE SITE.
5. ALL EROSION CONTROL BERMS MUST BE IN PLACE AND ENGINEER CERTIFIED PRIOR TO BUILDING PERMIT RELEASE.

VICINITY MAP ZONE MAP: G-15

ACS BENCHMARK

THE BASIS OF ELEVATIONS FOR THIS SURVEY IS ACS BENCHMARK 9-F15, THE PUBLISHED ELEVATION OF WHICH IS 4983.996, AND IS LOCATED ON TOP OF CONCRETE DROP INLET, ENE QUADRANT OF MONTANO ROAD AND EDITH BOULEVARD NE.

LEGAL DESCRIPTION

Tracts numbered One (1), Two (2), and Three (3) of the LANDS OF LAFARGE, situate within projected Section 4, T10N, R3E, N.M.P.M., Town of Albuquerque Grant, Bernalillo County, New Mexico as the same are shown and designated on the plat of said Lands filed in the Office of the County Clerk of Bernalillo County, New Mexico, on November 1, 2001, in Book 2001C, pages 290.

HYDROLOGY NOTES:

Currently the site is undeveloped but equipment is parked on ~~ward~~ ^{yard} of the site. The existing flow for the entire property is 31.77 cfs for 100% B and 14.73 Ac.

The Property contains a flood zone AO for the entire property as shown on the basin map. The proposed bldgs will not be within that zone.

Per the S.A.D. that was done for this area, the allowable discharge is 80% impervious. The fully developed flow is 60.92 cfs for 80% D and 20% B.

For this project, interim conditions are proposed. The property is 10% D and 90% B which is 35.20 cfs. The developed flow going to the proposed western inlet is 9.62 cfs. The double inlet has capacity for 17.8 cfs. The inlets will take in a combined flow of $9.6 + 17.8 + 17.8 = 45.22$ which is greater than interim conditions of 35.20 cfs.

The 30" pipe west of inlet 1 is sized for full development of 60.92 cfs. The 30" pipe between inlets 1 & 2 is sized for $60.92 - 9.62 = 51.3$ cfs (total developed flow - developed site). The 24" pipe is size for $51.3 / 2 = 25.65$ cfs.

The inlets will take the flow for interim conditions, but additional inlets will be needed when the rest of the site is developed. The pipes are sized for full development.

NOTICE TO CONTRACTOR

1. An excavation/construction permit will be required before beginning work within City right of ways. An approved construction of these plans must be submitted at the time of application for the permit.
2. All work stipulated on these plans to be performed, except as otherwise stated, shall be done in accordance with the standards of the City of Albuquerque Standard Specifications for Public Works Construction" (1988 Edition).
3. Two working days prior to any excavation, Contractor shall contact the Line Locating Service, 505-223-1234, for locating all utilities.
4. Prior to construction, the Contractor shall excavate and verify all horizontal and vertical locations of all existing utilities. Should the Contractor be unable to locate a utility, the Contractor shall notify the Engineer that the utility be resolved with a minimum of 10' clearance.
5. Backfill compaction shall be according to residential standards.
6. Maintenance of these utilities shall be the responsibility of the Owner of the property served.
7. Contractor is responsible for obtaining excavation permit from the City and providing proof of compliance by the City prior to the sign-off for Certificate of Occupancy.

DRAINAGE FACILITIES WITHIN CITY RIGHT OF WAY


Design Approval	HYDROLOGY SECTION	DATE
Inspection Approval	CONSTRUCTION SECTION	DATE
Acceptance	CONSTRUCTION/SECTION/PERMITS	DATE

TLC PLUMBING OFFICE

GRADING & DRAINAGE PLAN

 MARK GOODWIN & ASSOCIATES, P.A.
CONSULTING ENGINEERS
P.O. BOX 90606
ALBUQUERQUE, NEW MEXICO 87199
(505)828-2200, FAX (505)797-9539


Designed: JMM	Drawn: KJS	Checked: DMG	Sheet 1 of 1
Scale: 1" = 40'	Date: 09-04	Job: A04062	


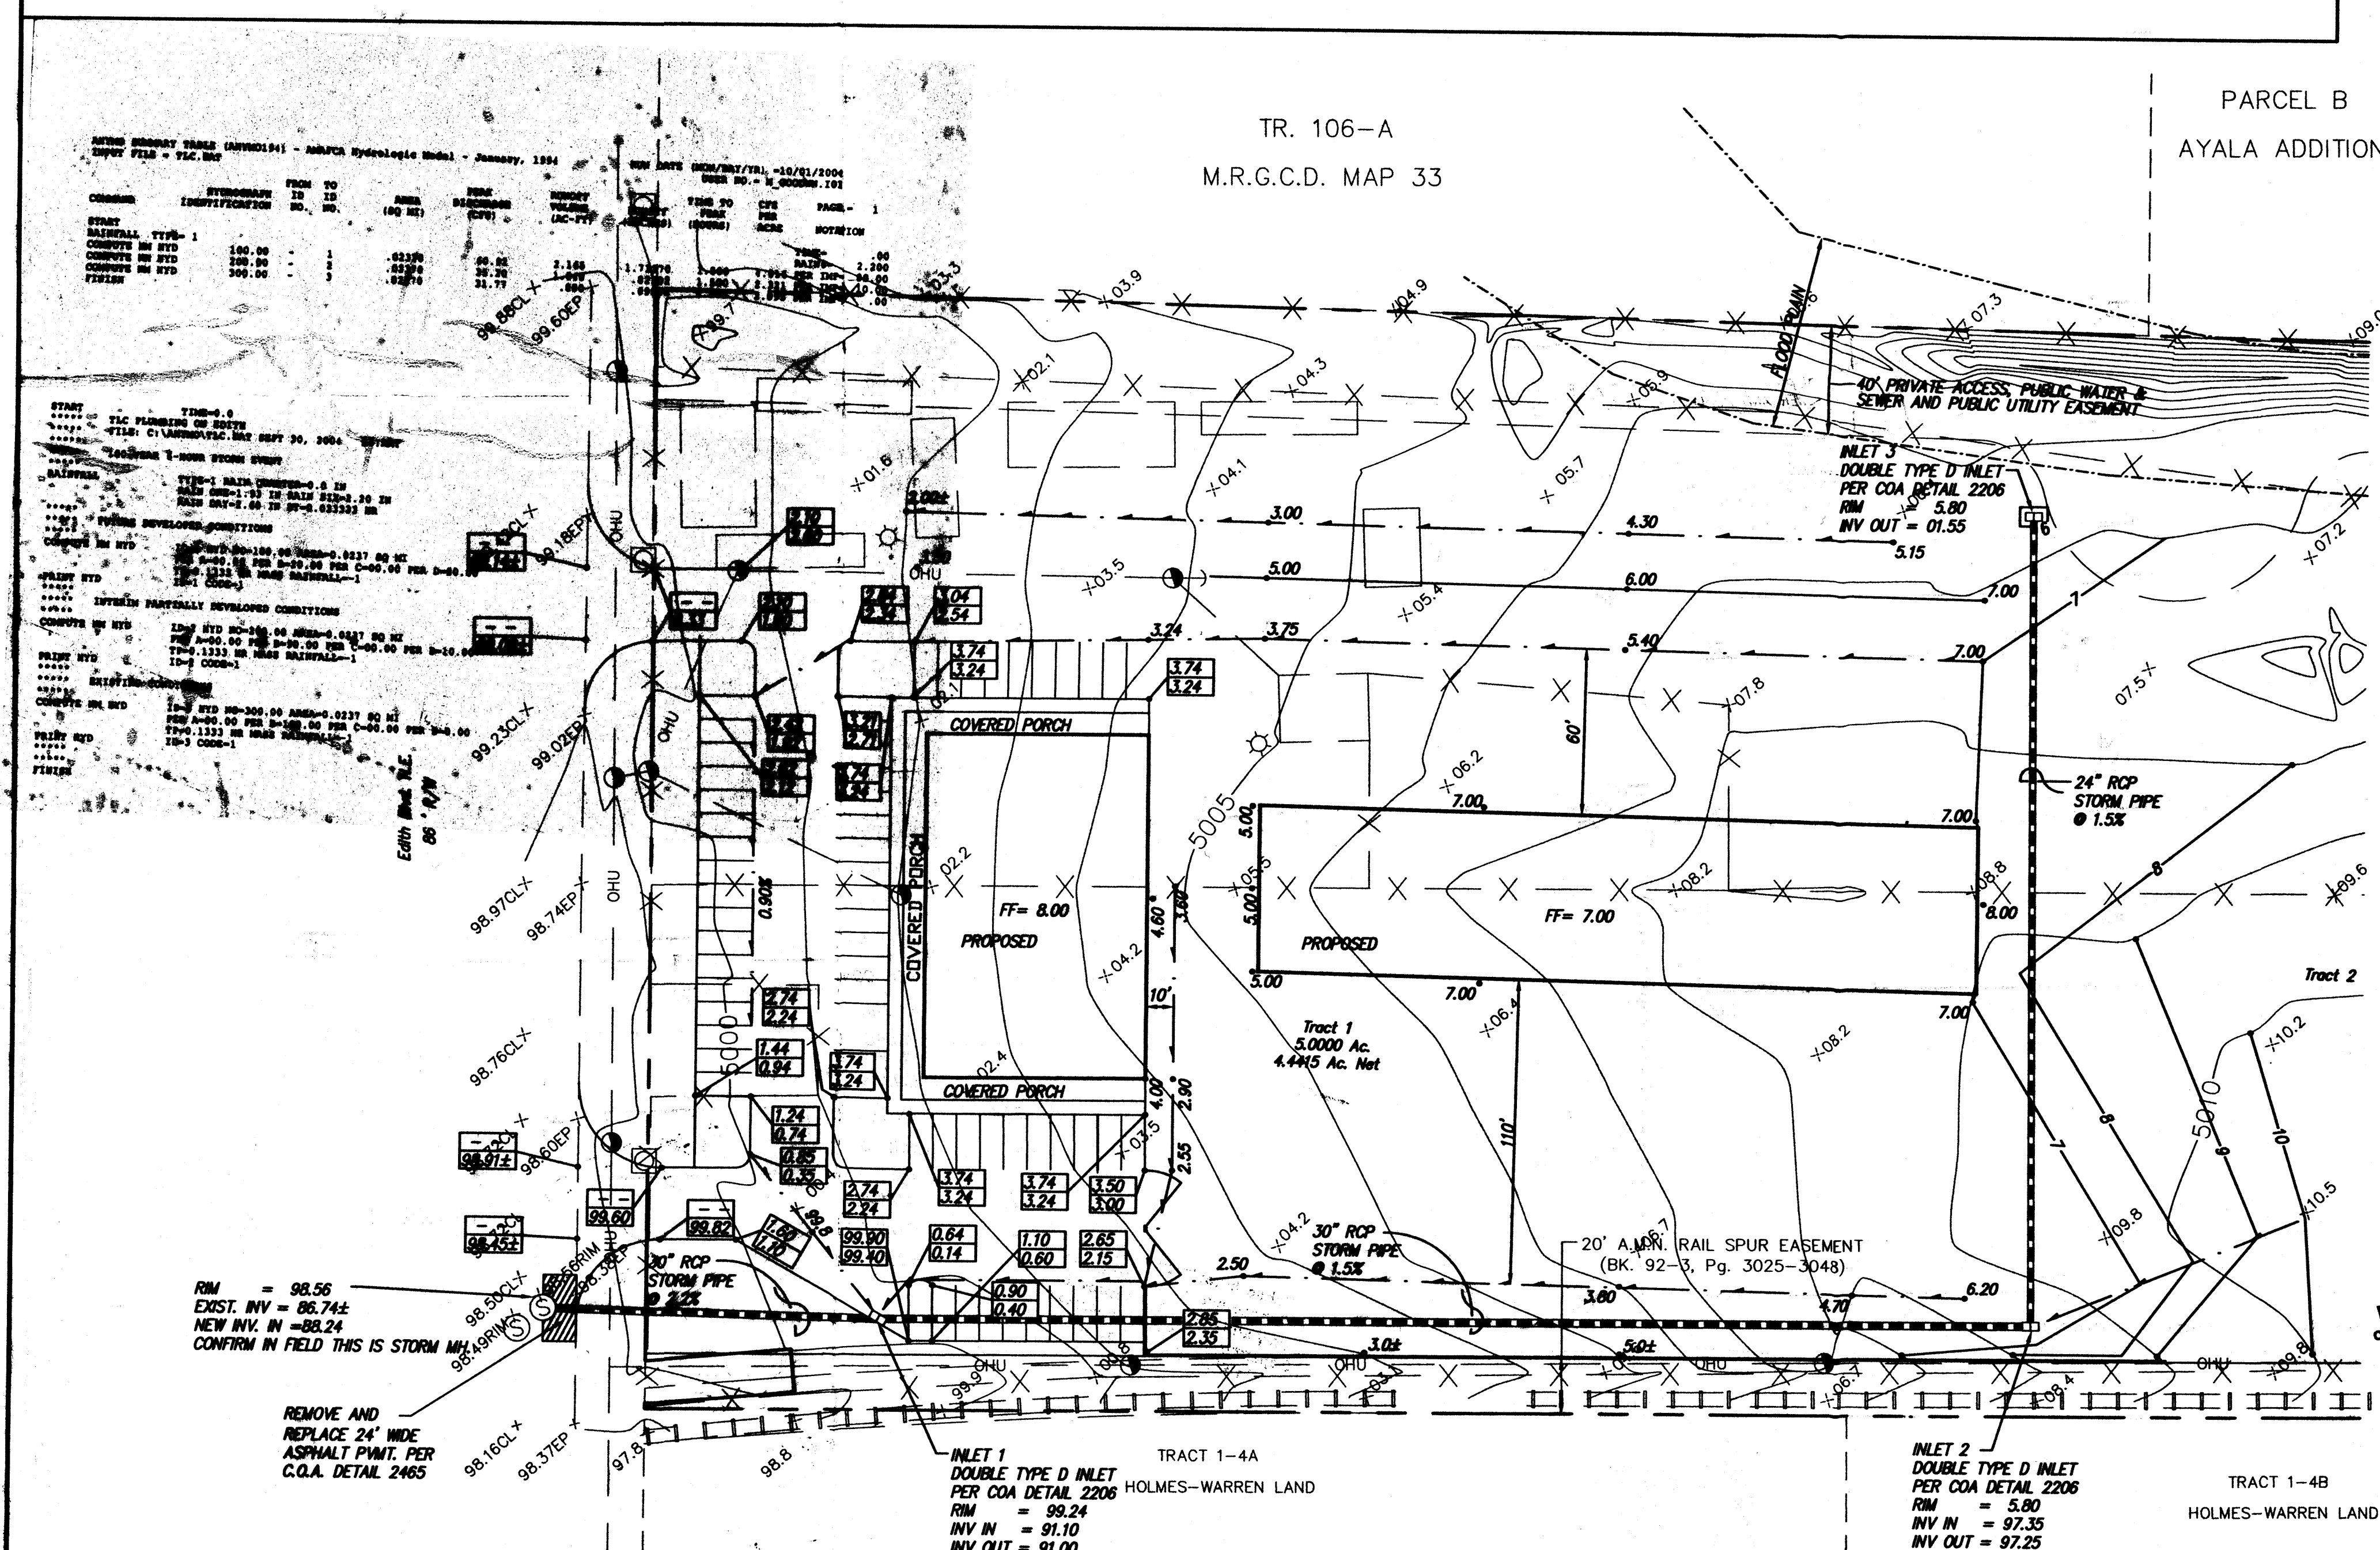


LEGEND

- | | |
|----------------|----------------------------------|
| 5105 | EXISTING CONTOUR (MAJOR) |
| 5104 | EXISTING CONTOUR (MINOR) |
| x 00.00 | EXISTING SPOT ELEVATION |
| | EXISTING ASPHALT CURB |
| | EXISTING CONCRETE CURB |
| ■ | EXISTING UNDERGROUND GAS MARKER |
| ----- | EXISTING WALL OR HEAD WALL |
| ▲ | EXISTING SIGN |
| —X—X—X— | EXISTING FENCE |
| ● | EXISTING SANITARY SEWER MANHOLE |
| ○ | EXISTING CLEANOUT |
| —X— | EXISTING WATER VALVE |
| ⊕ | EXISTING FIRE HYDRANT |
| —E,T&CATV— | EXISTING OVERHEAD UTILITY LINES |
| ●pp | EXISTING POWER POLE |
| — | EXISTING GUYWIRE |
| ■ | EXISTING LIGHT POLE |
| ■ | EXISTING TELEPHONE PEDESTAL |
| ■ | EXISTING UNDERGROUND GAS MARKER |
| ● | EXISTING GAS VALVE/METER |
| ⊙ | EXISTING STORM SEWER MANHOLE |
| ■ | EXISTING DROP INLET |
| ■ ■ ■ | DRAINAGE BASIN BOUNDARY |
| ----- | NEW CONCRETE HEADER CURB |
| —○— | EXISTING CHAINLINK FENCE |
| ----- | PROPOSED FIELD SWALE OR FLOWLINE |
| ▨ | EXISTING SIDEWALK CULVERT |
| FF= 00.88 | FINISH FLOOR ELEVATION |
| .02.02 | NEW SPOT ELEVATION |
| 97.67
97.17 | TOP OF CURB FLOWLINE |
| → | FLOW DIRECTION |
| → | ROOF DRAIN |
- RECEIVE
- 2004

Public Infrastructure shown
on these plans for information
only and not part of approval.
Separate DRC/Permit approval
and Work Order required.

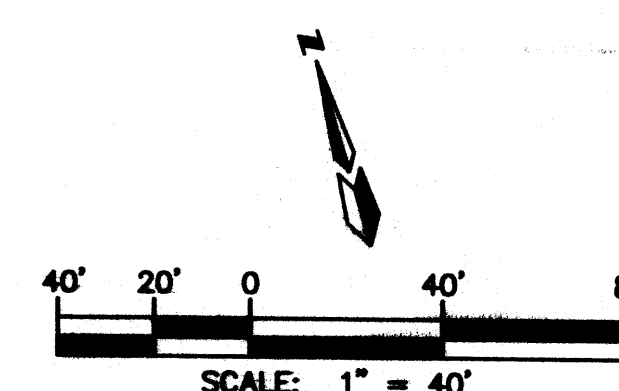

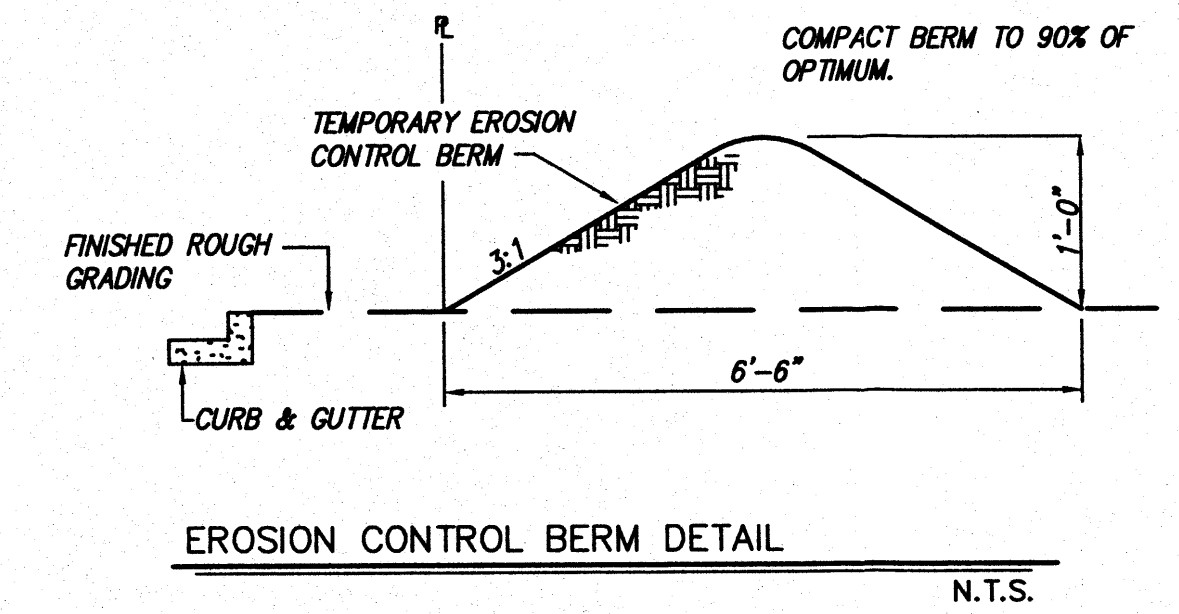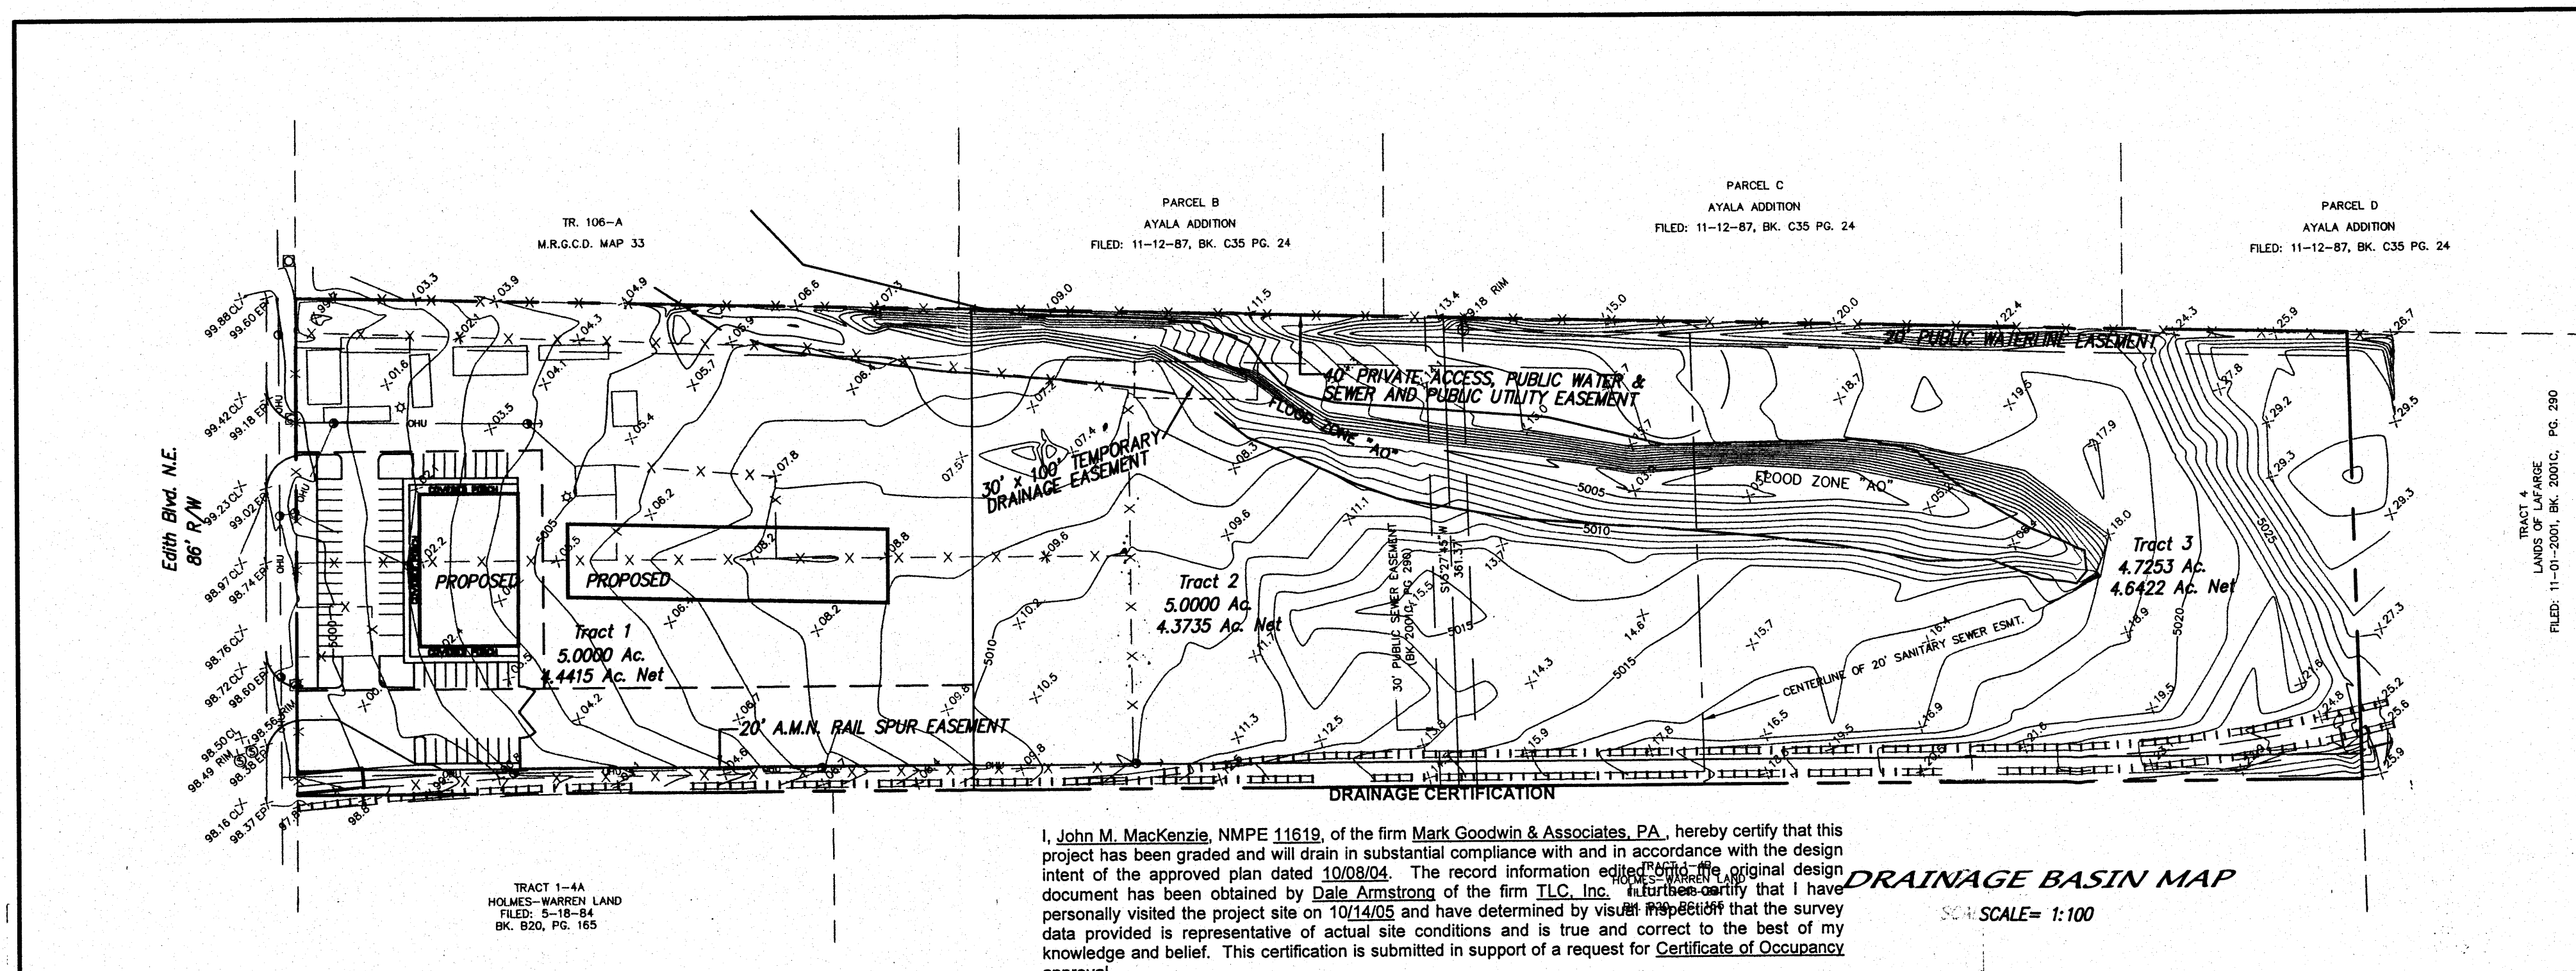

- EROSION CONTROL NOTES**
1. CONTRACTOR IS RESPONSIBLE FOR OBTAINING A TOPSOIL DISTURBANCE PERMIT PRIOR TO BEGINNING WORK.
 2. CONTRACTOR IS RESPONSIBLE FOR KEEPING ALL SEDIMENT OUT OF EXISTING RIGHT-OF-WAY.
 3. CONTRACTOR IS RESPONSIBLE FOR CLEANING UP ANY SEDIMENT THAT GETS INTO EXISTING RIGHT-OF-WAY.
 4. EROSION CONTROL BERMS ARE REQUIRED AROUND THE ENTIRE SITE.
 5. ALL EROSION CONTROL BERMS MUST BE IN PLACE AND ENGINEER CERTIFIED PRIOR TO BUILDING PERMIT RELEASE.



VICINITY MAP ZONE MAP: G-15

ACS BENCHMARK

THE BASIS OF ELEVATIONS FOR THIS SURVEY IS ACS BENCHMARK 9-F15, THE PUBLISHED ELEVATION OF WHICH IS 4983.996, AND IS LOCATED ON TOP OF CONCRETE DROP INLET, ENE QUADRANT OF MONTANO ROAD AND EDITH BOULEVARD NE.

LEGAL DESCRIPTION

Tracts numbered One (1), Two (2), and Three (3) of the LANDS OF LAFARGE, situate within projected Section 4, T10N, R3E, N.M.P.M., Town of Albuquerque Grant, Bernalillo County, New Mexico as the same are shown and designated on the plat of said Lands filed in the Office of the County Clerk of Bernalillo County, New Mexico, on November 1, 2001, in Book 2001C, page 290.

HYDROLOGICAL SUMMARY TABLE (HYDROLOGICAL) - AMERICA Hydrologic Model - January, 1994

INPUT FILE = TLC.DAT

COMMAND	IDENTIFICATION	NO.	AREA (SQ MI)	PEAK DISCHARGE (CFS)	RUNOFF VOLUME (AC-FT)	RUNOFF TIME (HOURS)	TIME TO PEAK (HOURS)	CFS PER ACRE	NOTATION
START	RAINFALL TYPE=1								
COMPUTE NH HYD	100.00	1	.02370	60.92	2.165	1.71270	1.500	4.014	PER IMP= 80.00
COMPUTE NH HYD	200.00	2	.02370	35.20	1.040	1.82305	1.500	2.321	PER IMP= 15.00
COMPUTE NH HYD	300.00	3	.02370	31.77	.880	1.82305	1.533	2.095	PER IMP= .00
FINISH									

RAINFALL

TYPE=1 RAIN QUANT=0.0 IN

RAIN ONE=1.93 IN RAIN SIX=2.20 IN

RAIN DRY=1.65 IN DRY=0.033333 HR

COMPUTE NH HYD

INTERIM DEVELOPED CONDITIONS


INTERIM PARTIALLY DEVELOPED CONDITIONS

EXISTING CONDITIONS

COMPUTE NH HYD

PRINT HYD

FINISH

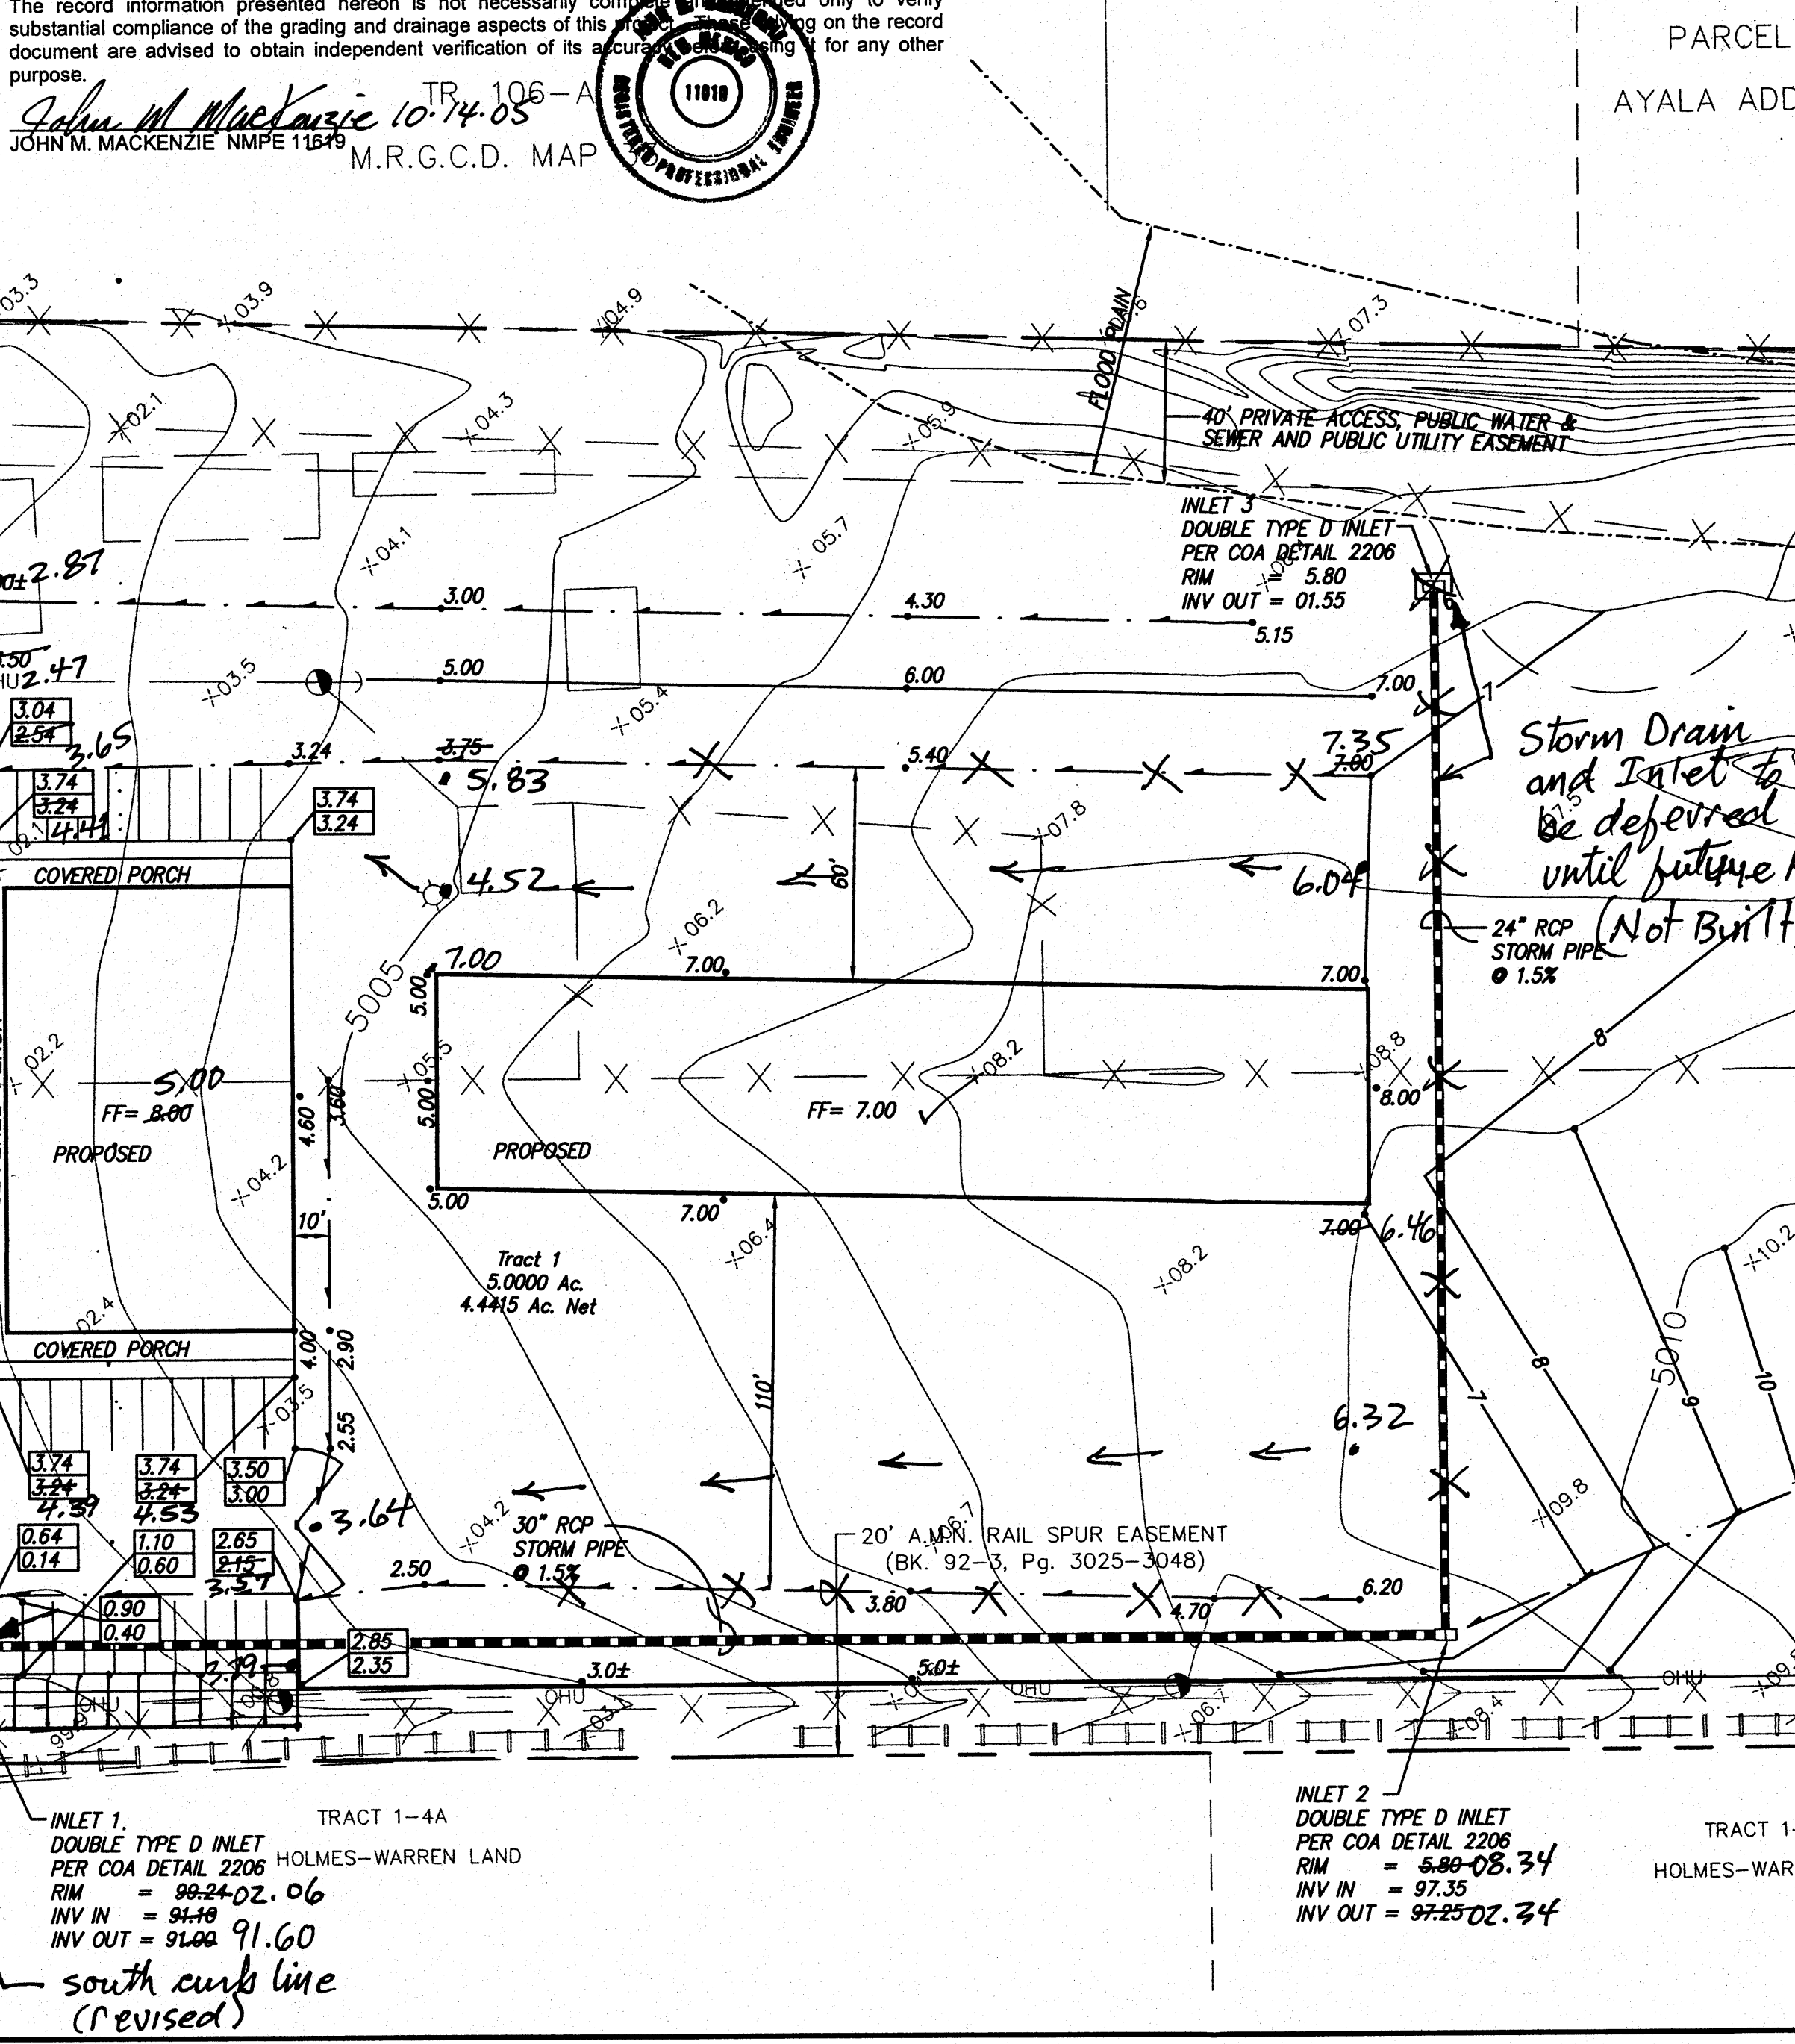

- LEGEND**
- 5105 EXISTING CONTOUR (MAJOR)
 - 5104 EXISTING CONTOUR (MINOR)
 - x 00.00 EXISTING SPOT ELEVATION
 - EXISTING ASPHALT CURB
 - EXISTING CONCRETE CURB
 - EXISTING UNDERGROUND GAS MARKER
 - EXISTING WALL OR HEAD WALL
 - EXISTING SIGN
 - EXISTING FENCE
 - EXISTING SANITARY SEWER MANHOLE
 - EXISTING CLEANOUT
 - EXISTING WATER VALVE
 - EXISTING FIRE HYDRANT
 - EXISTING OVERHEAD UTILITY LINES
 - EXISTING POWER POLE
 - EXISTING GUYWIRE
 - EXISTING LIGHT POLE
 - EXISTING TELEPHONE PEDESTAL
 - EXISTING UNDERGROUND GAS MARKER
 - EXISTING GAS VALVE/METER
 - EXISTING STORM SEWER MANHOLE
 - EXISTING DROP INLET
 - DRAINAGE BASIN BOUNDARY
 - NEW CONCRETE HEADER CURB
 - EXISTING CHAINLINK FENCE
 - PROPOSED FIELD SWALE OR FLOWLINE
 - EXISTING SIDEWALK CULVERT
 - FF= 00.88 FINISH FLOOR ELEVATION
 - .02.02 NEW SPOT ELEVATION
 - 07.67 TOP OF CURB
 - 02.12 FLOWLINE
 - 96.20 AS-BUILT ELEVATION
 - ROOF DRAIN

HYDROLOGY NOTES:

Currently the site is undeveloped but equipment is parked on a third of the site. The existing flow for the entire property is 31.77 cfs for 100% B and 14.73 Ac.

The Property contains a flood zone AO for the entire property as shown on the basin map. The proposed bldgs will not be within that zone.

Per the S.A.D. that was done for this area, the allowable discharge is 80% impervious. The existing developed flow is 60.92 cfs for 80% D and 20% B.

For this project, interim conditions are proposed. The property is 10% D and 90% B which is 35.20 cfs. The developed flow going to the proposed western inlet is 9.62 cfs. The double inlet has capacity for 17.8 cfs. The inlets will take in a combined flow of 9.6+17.8+17.8=45.22 which is greater than interim conditions of 35.20 cfs.

The 30" pipe west of inlet 1 is sized for full development of 60.92 cfs. The 30" pipe between inlets 1 & 2 is sized for 60.92-9.62=51.3 cfs (total developed flow - developed site). The 24" pipe is sized for 51.3 / 2 = 25.65 cfs.

The inlets will take the flow for interim conditions, but additional inlets will be needed when the rest of the site is developed. The pipes are sized for fully developed.

- NOTICE TO CONTRACTOR**
1. An excavation/construction permit will be required before beginning any work within City right of way. An approved copy of these plans must be submitted at the time of application for this permit.
 2. All work detailed on these plans to be performed, except as otherwise stated or provided herein, shall be constructed in accordance with "City of Albuquerque Standard Specifications for Public Works Construction" (1988 Edition).
 3. Two working days prior to any excavation, Contractor must contact the Line Locating Service, 765-1234, for location of existing utilities.
 4. Prior to construction, the Contractor shall excavate and verify the horizontal and vertical locations of all obstructions. Should a conflict exist, the Contractor shall notify the Engineer so that the conflict can be resolved with a minimum of delay.
 5. Backfill compaction shall be according to residential street use.
 6. Maintenance of these facilities shall be the responsibility of the Owner of the property served.
 7. Contractor is responsible for obtaining excavation permit for the S.O. 19 and providing proof of acceptance by the City prior to Hydrology sign-off for Certificate of Occupancy.

DRAINAGE FACILITIES WITHIN CITY RIGHT OF WAY

Design Approval	HYDROLOGY SECTION	DATE
Inspection Approval	CONSTRUCTION SECTION	DATE
Acceptance	CONSTRUCTION/SECTION/PERMITS	DATE

TLC PLUMBING OFFICE

GRADING & DRAINAGE PLAN

MARK GOODWIN & ASSOCIATES, P.A.

CONSULTING ENGINEERS



P.O. BOX 90606

ALBUQUERQUE, NEW MEXICO 87199

(505)828-2200, FAX (505)797-9539



Designed: JMM Drawn: KJS Checked: DMG Sheet 2 of 2

Scale: 1" = 40' Date: 09-04 Job: A04062

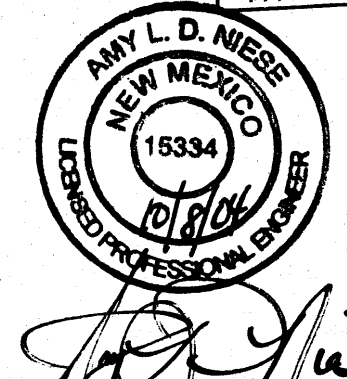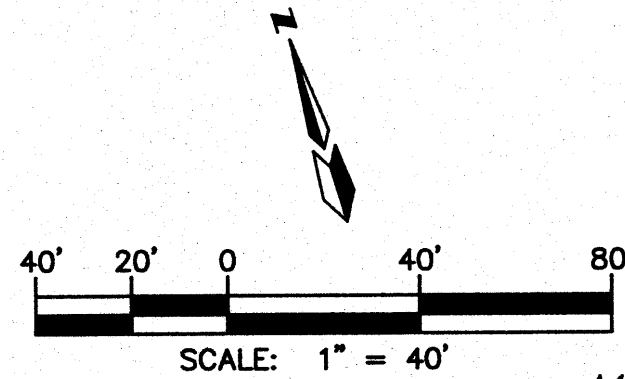

Mark Goodwin

A4062TLC/A4062GD/09-29-04 KJS

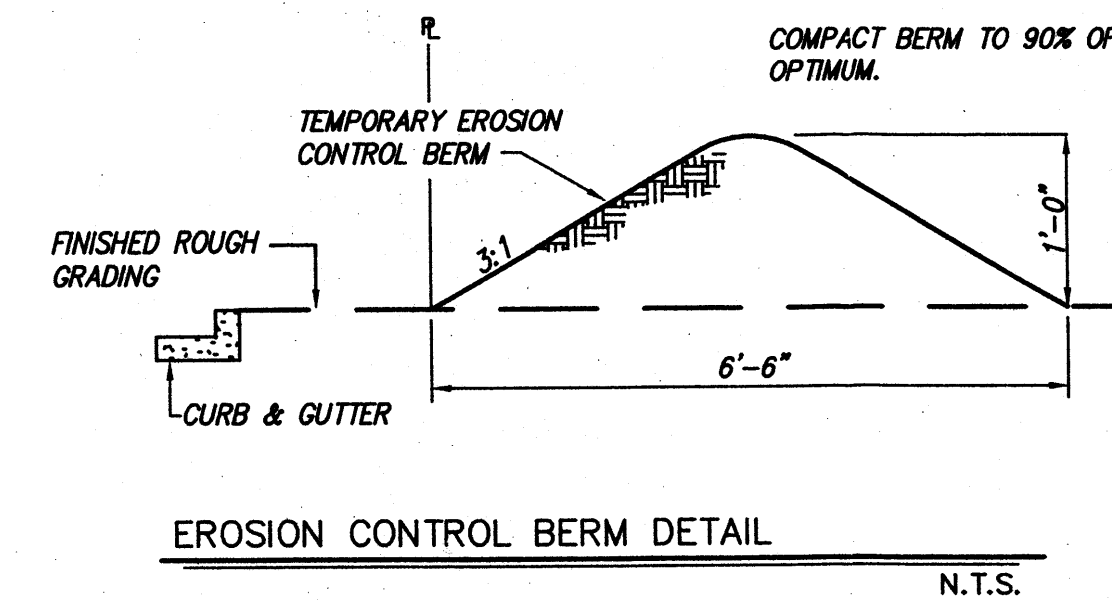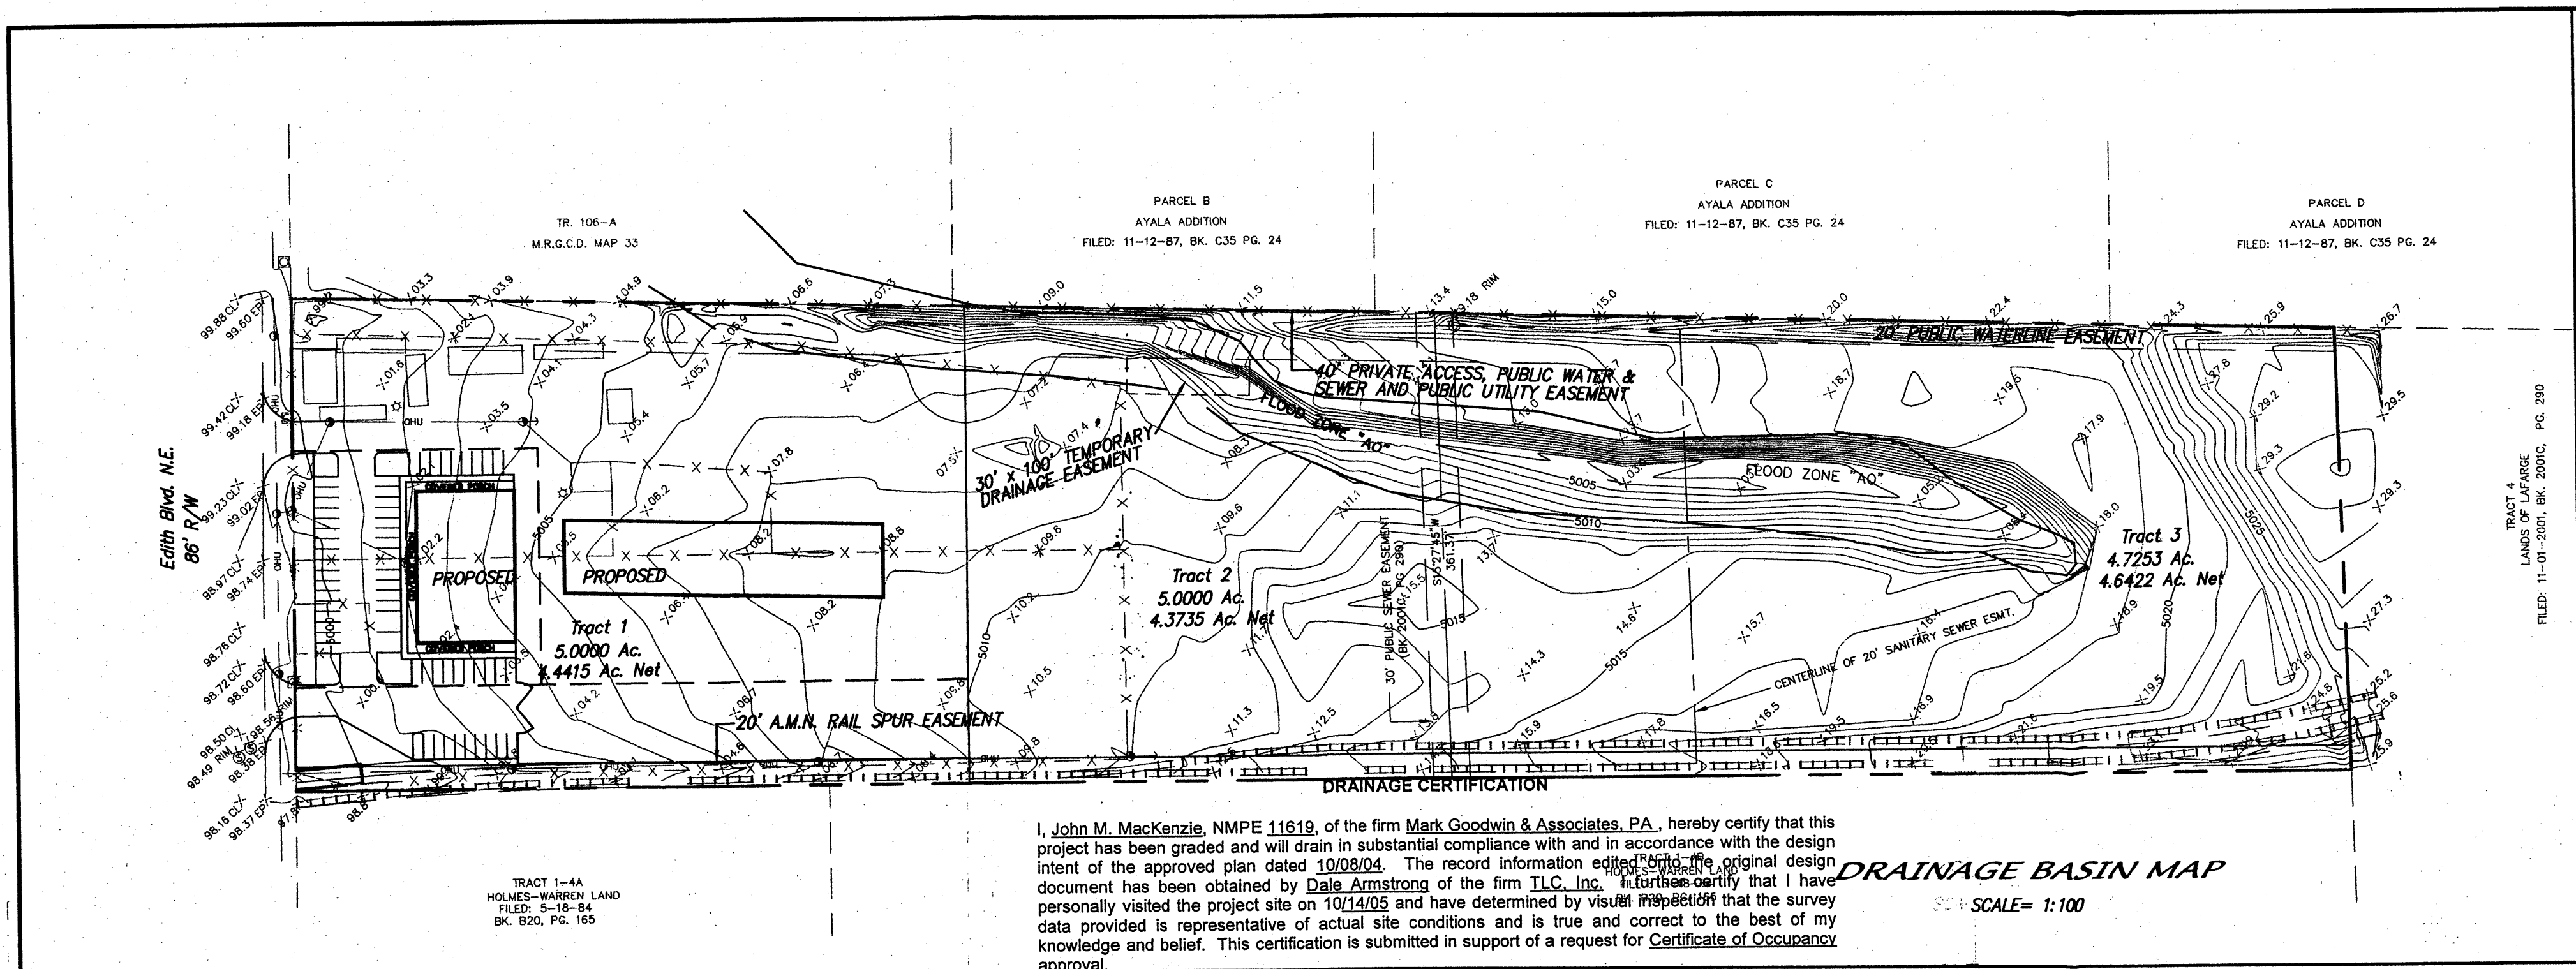

EROSION CONTROL NOTES

- CONTRACTOR IS RESPONSIBLE FOR OBTAINING A TOPSOIL DISTURBANCE PERMIT PRIOR TO BEGINNING WORK.
- CONTRACTOR IS RESPONSIBLE FOR KEEPING ALL SEDIMENT OUT OF EXISTING RIGHT-OF-WAY.
- CONTRACTOR IS RESPONSIBLE FOR CLEANING UP ANY SEDIMENT THAT GETS INTO EXISTING RIGHT-OF-WAY.
- EROSION CONTROL BERMS ARE REQUIRED AROUND THE ENTIRE SITE.
- ALL EROSION CONTROL BERMS MUST BE IN PLACE AND ENGINEER CERTIFIED PRIOR TO BUILDING PERMIT RELEASE.



LEGAL DESCRIPTION

Tracts numbered One (1), Two (2), and Three (3) of the LANDS OF LAFARGE, situate within projected Section 4, T10N, R3E, N.M.P.M., Town of Albuquerque Grant, Bernalillo County, New Mexico as the same are shown and designated on the plat of said Lands filed in the Office of the County Clerk of Bernalillo County, New Mexico, on November 1, 2001, in Book 2001C, page 290.

HYDROLOGY NOTES:

Currently the site is undeveloped but equipment is parked on a third of the site. The existing flow for the entire property is 31.77 cfs for 100% B and 14.73 Ac.

The Property contains a flood zone AO for the entire property as shown on the basin map. The proposed bldgs will not be within that zone.

Per the S.A.D. that was done for this area, the allowable discharge is 80% impervious. The fully developed flow is 60.92 cfs for 80% D and 20% B.

For this project, interim conditions are proposed. The property is 10% D and 90% B which is 35.20 cfs. The developed flow going to the proposed western inlet is 9.62 cfs. The double inlet has capacity for 17.8 cfs. The inlets will take in a combined flow of 9.6+17.8+17.8 = 45.22 which is greater than interim conditions of 35.20 cfs.

The 30" pipe west of inlet 1 is sized for full development of 60.92 cfs. The 30" pipe between inlets 1 & 2 is sized for 60.92-9.62=51.3 cfs (total developed flow - developed site). The 24" pipe is sized for 51.3 / 2 = 25.65 cfs.

The inlets will take the flow for interim conditions, but additional inlets will be needed when the rest of the site is developed. The pipes are sized for fully developed.

NOTICE TO CONTRACTOR

- An excavation/construction permit will be required before beginning any work within City right of way. An approved copy of these plans must be submitted at the time of application for this permit.
- All work detailed on these plans to be performed, except as otherwise stated or provided herein, shall be constructed in accordance with "City of Albuquerque Standard Specifications for Public Works Construction" (1986 Edition).
- Two working days prior to any excavation, Contractor must contact the Line Locating Service, 785-1234, for location of existing utilities.
- Prior to construction, the Contractor shall excavate and verify the horizontal and vertical locations of all obstructions. Should a conflict exist, the Contractor shall notify the Engineer so that the conflict can be resolved with a minimum of delay.
- Backfill compaction shall be according to residential street use.
- Maintenance of these facilities shall be the responsibility of the Owner of the property served.
- Contractor is responsible for obtaining excavation permit for the S.O. 19 and providing proof of acceptance by the City prior to Hydrology sign-off for Certificate of Occupancy.

DRAINAGE FACILITIES WITHIN CITY RIGHT OF WAY

Design Approval	HYDROLOGY SECTION	DATE
Inspection Approval	CONSTRUCTION SECTION	DATE
Acceptance	CONSTRUCTION/SECTION/PERMITS	DATE

TLC PLUMBING OFFICE



GRADING & DRAINAGE PLAN

dmg MARK GOODWIN & ASSOCIATES, P.A.
CONSULTING ENGINEERS
P.O. BOX 90606
ALBUQUERQUE, NEW MEXICO 87199
(505)828-2200, FAX (505)797-9539

Designed: JMM	Drawn: KJS	Checked: DMG	Sheet 1 of 1
Scale: 1" = 40'	Date: 09-04	Job: A04062	

LEGEND

5105	EXISTING CONTOUR (MAJOR)
5104	EXISTING CONTOUR (MINOR)
x 00.00	EXISTING SPOT ELEVATION
---	EXISTING ASPHALT CURB
---	EXISTING CONCRETE CURB
□	EXISTING UNDERGROUND GAS MARKER
---	EXISTING WALL OR HEAD WALL
+	EXISTING SIGN
---	EXISTING FENCE
●	EXISTING SANITARY SEWER MANHOLE
○	EXISTING CLEANOUT
+	EXISTING WATER VALVE
+	EXISTING FIRE HYDRANT
---	EXISTING OVERHEAD UTILITY LINES
●	EXISTING POWER POLE
---	EXISTING GUYWIRE
+	EXISTING LIGHT POLE
+	EXISTING TELEPHONE PEDESTAL
□	EXISTING UNDERGROUND GAS MARKER
+	EXISTING GAS VALVE/METER
+	EXISTING STORM SEWER MANHOLE
+	EXISTING DROP INLET
---	DRAINAGE BASIN BOUNDARY
---	NEW CONCRETE HEADER CURB
---	EXISTING CHAINLINK FENCE
---	PROPOSED FIELD SWALE OR FLOWLINE
---	EXISTING SIDEWALK CULVERT
FF= 00.88	FINISH FLOOR ELEVATION
02.02	NEW SPOT ELEVATION
97.67	TOP OF CURB
97.12	FLOWLINE
96.20	AS-BUILT ELEVATION
---	FLOW DIRECTION
---	ROOF DRAIN

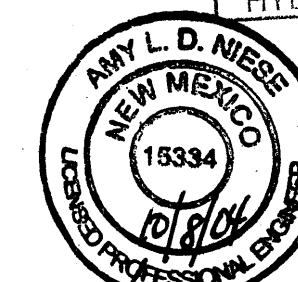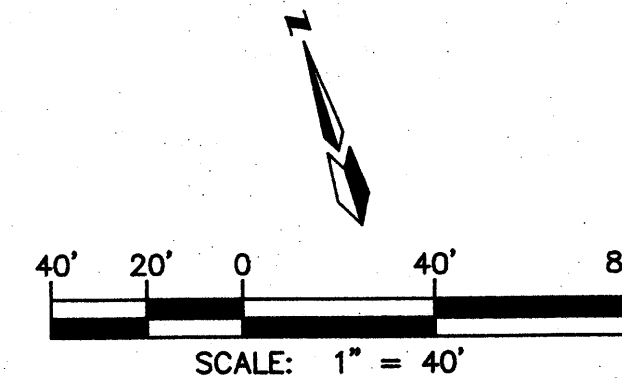

OCT 14 2005
HYDROLOGY SECTION


ANYTIME SUMMARY TABLE (ARH0194) - AMFCA Hydrologic Model - January, 1994
INPUT FILE = TIC.DAT

COMMAND	HYDROGRAPH IDENTIFICATION	FROM NO.	TO NO.	AREA (SQ MI)	PEAK DISCHARGE (CFS)	RUNOFF VOLUME (AC-FT)	RUNOFF TIME (HOURS)	TIME TO PEAK (HOURS)	CFS PER AC	NOTATION
START	RAINFALL TYPE=1	100.00	1	0.02370	60.92	2.185	1.71270	1.500	4.016	RAIN= 2.200
COMPUTE NM HYD		200.00	2	0.02370	35.20	1.040	1.22302	1.500	2.321	PER IMP= 60.00
COMPUTE NM HYD		300.00	3	0.02370	31.77	1.880	1.68442	1.533	2.095	PER IMP= 10.00
FINISH										

TIME=0.0
TIC DRAWING ON EDIT
FILE: C:\VARY\TIC.DAT SEPT 30, 2004 BY:JMM
100-YEAR 6-HOUR STORM EVENT
TYPE=1 RAIN QUANTER=0.0 IN
RAIN ON=1.93 IN RAIN SIX=2.20 IN
RAIN OFF=2.60 IN DT=0.03133 HR
FUTURE DEVELOPED CONDITIONS
ID=1 HYD NO=100.00 AREA=0.0237 SQ MI
PER A=0.00 PER B=20.00 PER C=0.00 PER D=80.00
TP=0.1333 HR MASS RAINFALL=1
ID=1 CODE=1
COMPUTE NM HYD
ID=2 HYD NO=200.00 AREA=0.0237 SQ MI
PER A=0.00 PER B=90.00 PER C=0.00 PER D=10.00
TP=0.1333 HR MASS RAINFALL=1
ID=2 CODE=1
COMPUTE NM HYD
ID=3 HYD NO=300.00 AREA=0.0237 SQ MI
PER A=0.00 PER B=100.00 PER C=0.00 PER D=0.00
TP=0.1333 HR MASS RAINFALL=1
ID=3 CODE=1
COMPUTE NM HYD
EXISTING CONDITIONS
ID=3 CODE=1
COMPUTE NM HYD
FINISH

The record information presented hereon is not necessarily complete and is intended only to verify substantial compliance of the grading and drainage aspects of this project. The record information presented hereon is not a substitute for a professional engineering or surveying plan. The record information presented hereon is not a substitute for a professional engineering or surveying plan. The record information presented hereon is not a substitute for a professional engineering or surveying plan.

John M. MacKenzie 10/14/05
JOHN M. MACKENZIE NMPE 11619
M.R.G.C.D. MAP

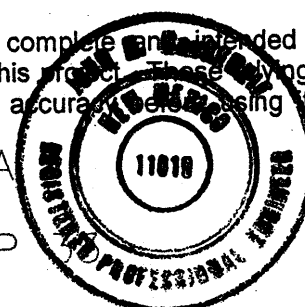

PARCEL B
AYALA ADDITION

Storm Drain and Inlet to be deferred until future Phase (Not Built)

REMOVE AND REPLACE 24" WIDE ASPHALT PAVT. PER C.O.A. DETAIL 2465

New M.H. w/ Slotted Cover
INV. = 90.3
RIM = 90.09

INLET 1, DOUBLE TYPE D INLET PER COA DETAIL 2206
RIM = 99.24-02.06
INV IN = 94.76
INV OUT = 91.60
south curb line (revised)

INLET 2, DOUBLE TYPE D INLET PER COA DETAIL 2206
RIM = 98.80-02.34
INV IN = 97.35
INV OUT = 97.25-02.34

TRACT 1-4B
HOLMES-WARREN LAND



VICINITY MAP ZONE MAP: G-15

T B M (TEMPORARY BENCHMARK)

ACS BENCHMARK

THE BASIS OF ELEVATIONS FOR THIS SURVEY IS ACS BENCHMARK 9-F15, THE PUBLISHED ELEVATION OF WHICH IS 4983.996, AND IS LOCATED ON TOP OF CONCRETE DROP INLET, ENE QUADRANT OF MONTANO ROAD AND EDITH BOULEVARD NE.

LEGAL DESCRIPTION

Tracts numbered One (1), Two (2), and Three (3) of the LANDS OF LAFARGE, situate within projected Section 4, T10N, R3E, N.M.P.M., Town of Albuquerque Grant, Bernalillo County, New Mexico, as shown on the plat of said lands, recorded in the County Clerk's Office of Bernalillo County, New Mexico, on the 10th day of March, 1904, in Book 20, page 230.

LEGEND


- 5105 EXISTING CONTOUR (MAJOR)
- 5104 EXISTING CONTOUR (MINOR)
- x 00.00 EXISTING SPOT ELEVATION
- EXISTING ASPHALT CURB
- EXISTING CONCRETE CURB
- EXISTING UNDERGROUND GAS MARKER
- EXISTING UNDERGROUND GAS VALVE
- EXISTING FENCE
- EXISTING SANITARY SEWER MANHOLE
- EXISTING CLEANOUT
- EXISTING WATER VALVE
- EXISTING FIRE HYDRANT
- E, T & CATV EXISTING OVERHEAD UTILITY LINES
- pp EXISTING POWER POLE
- EXISTING GUYWIRE
- EXISTING LIGHT POLE
- EXISTING TELEPHONE PEDESTAL
- EXISTING UNDERGROUND GAS MARKER
- EXISTING GAS VALVE/METER
- EXISTING STORM SEWER MANHOLE
- EXISTING DROP INLET
- DRAINAGE BASIN BOUNDARY
- NEW CONCRETE HEADER CURB
- EXISTING CHAINLINK FENCE
- PROPOSED FIELD SWALE OR FLOWLINE
- EXISTING SIDEWALK CULVERT
- FINISH FLOW ELEVATION
- NEW SPOT ELEVATION
- TOP OF CURB
- FLOWLINE
- FLOW DIRECTION
- ROOF DRAIN

D2


DRAINAGE BASIN NAME



DIRT

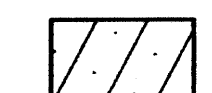

ASPHALT

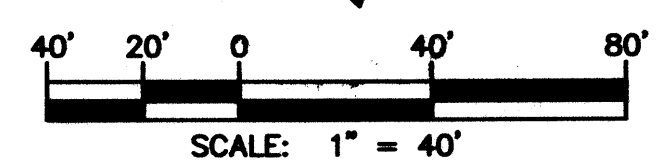


A4062TLC/A4062GD/09-29-04 KJS

TR. 106-A
M.R.G.C.D. MAP 33

PARCEL B
AYALA ADDITION

Edith Blvd. N.E.
88' R/W

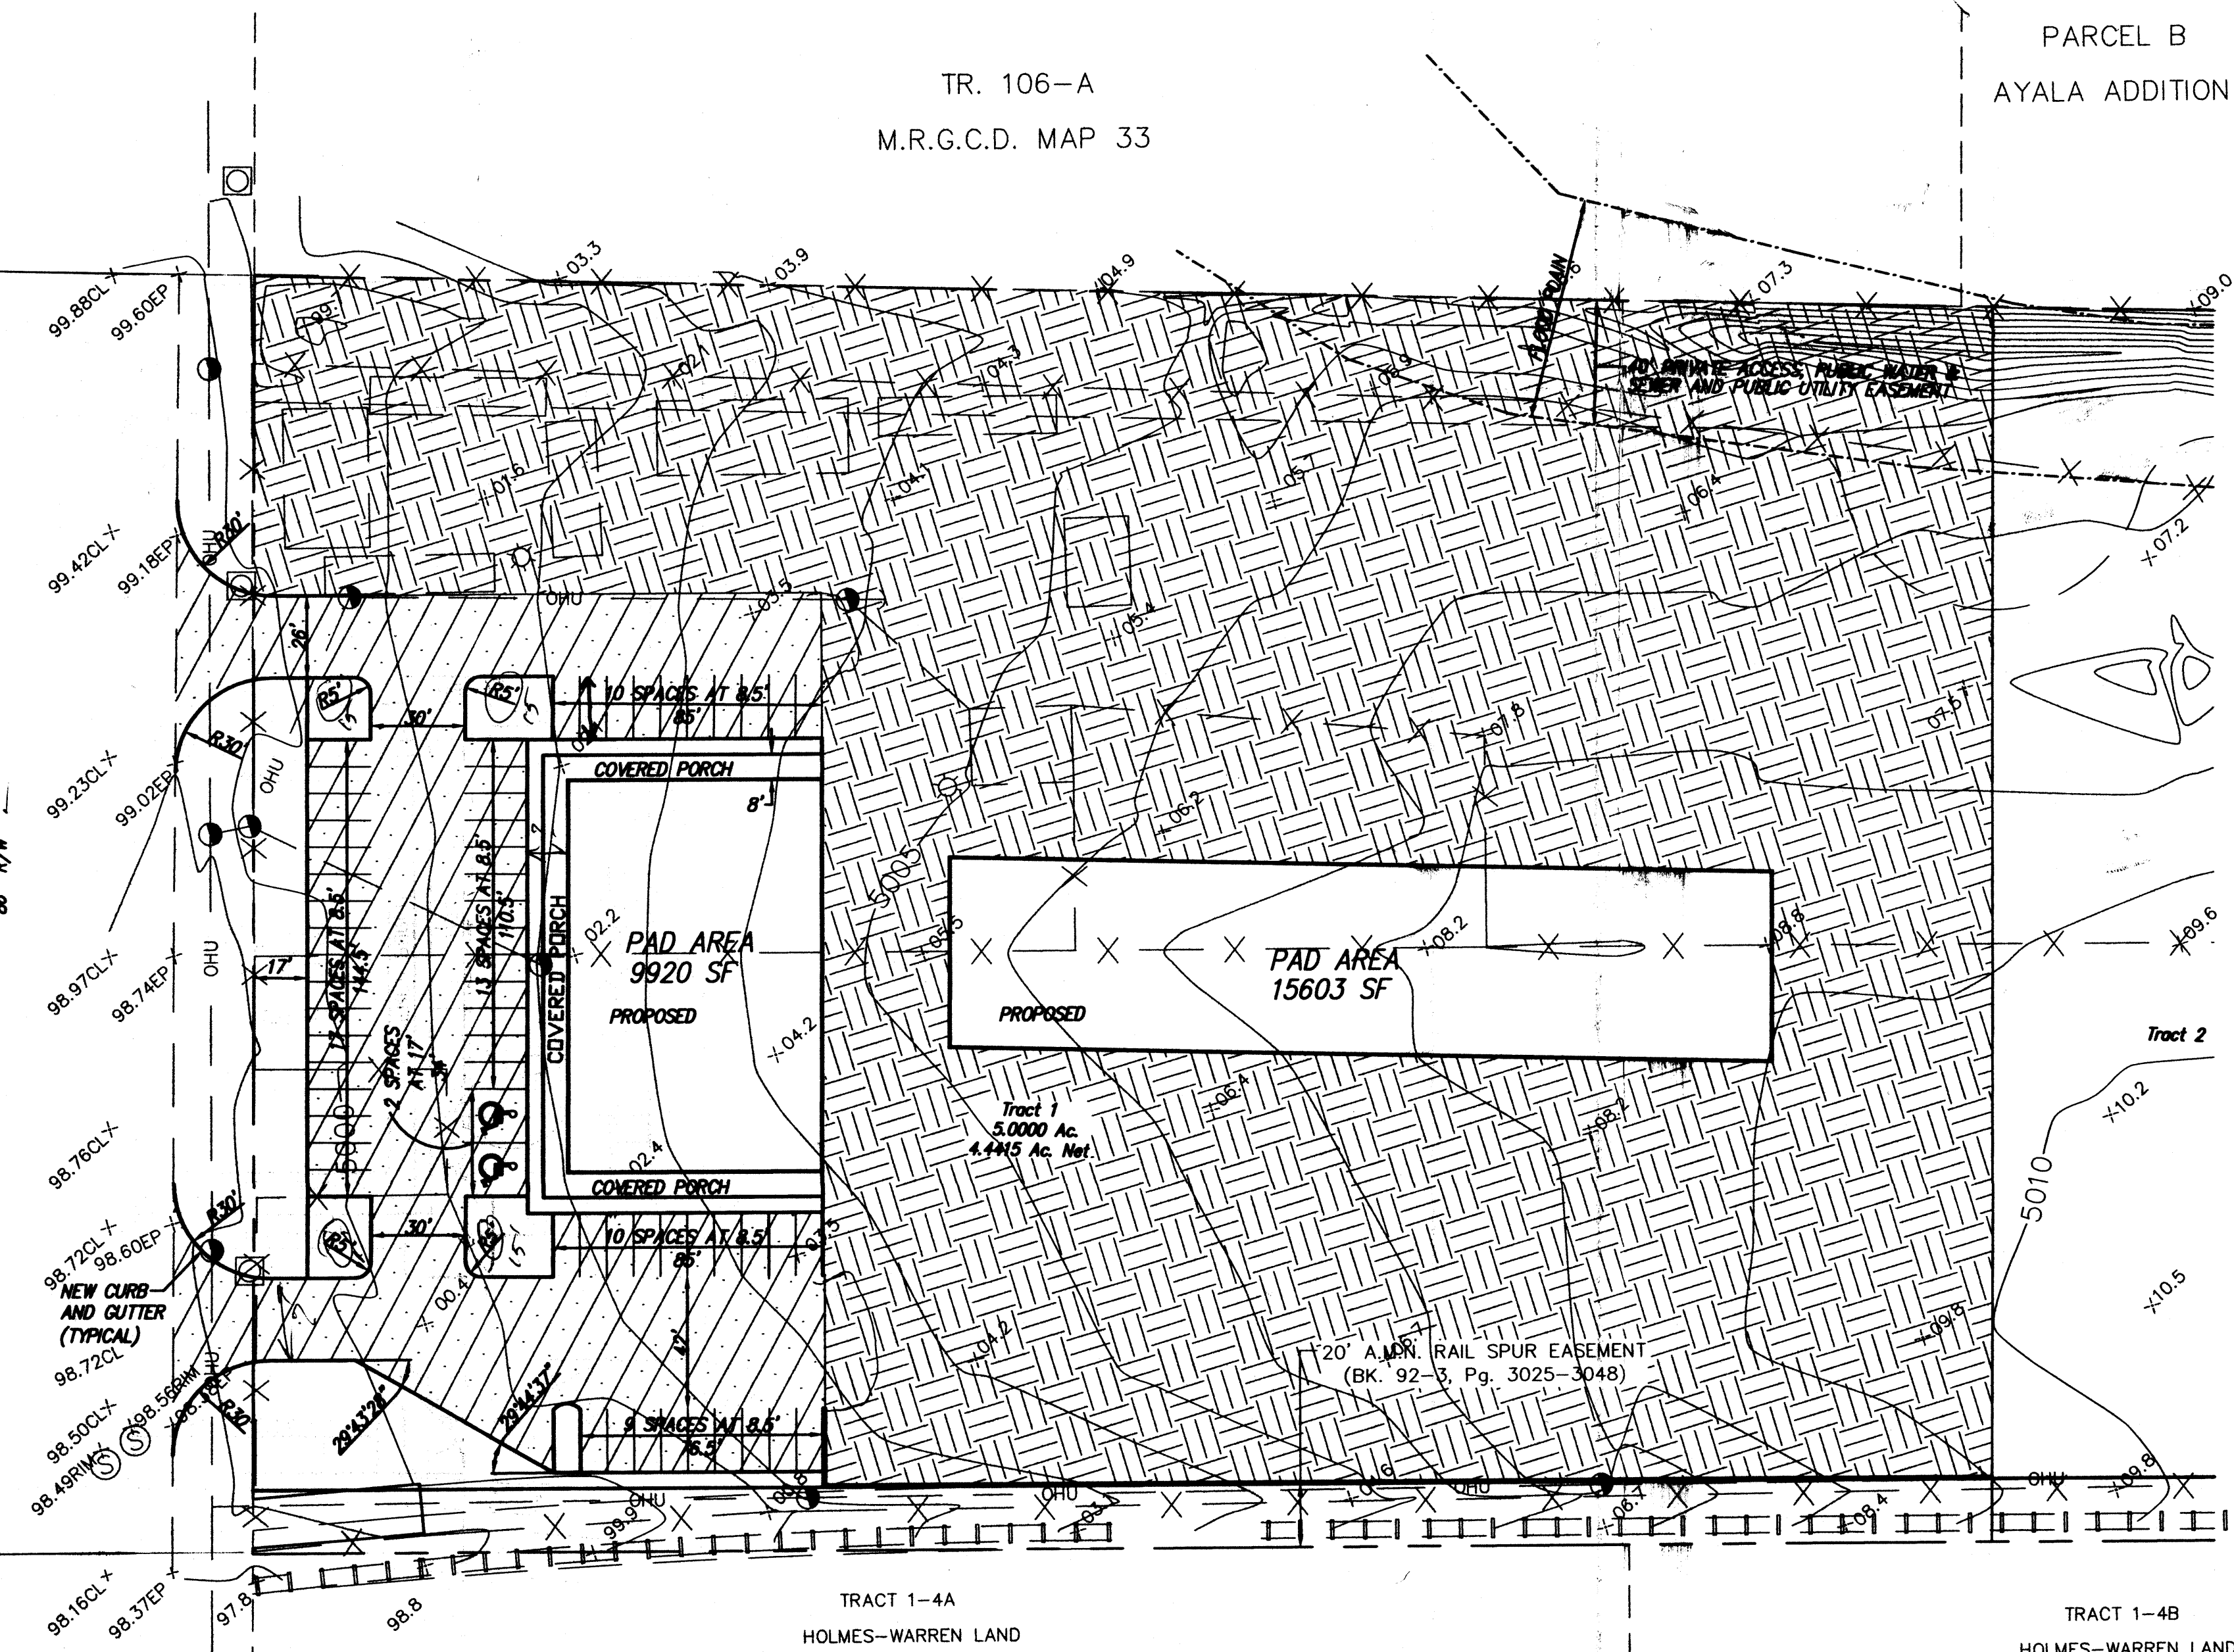

TRACT 1-4A
HOLMES-WARREN LAND

TRACT 1-4B
HOLMES-WARREN LAND


TLC PLUMBING OFFICE
TRAFFIC CONTROL LAYOUT

dmg MARK GOODWIN & ASSOCIATES, P.A.
CONSULTING ENGINEERS
P.O. BOX 90606
ALBUQUERQUE, NEW MEXICO 87199
(505)828-2200, FAX (505)797-9539

Designed: JMM	Drawn: KJS	Checked: DMG	Sheet 1 of 1
Scale: 1" = 40'	Date: 09-04	Job: A04062	


PARKING REQUIREMENTS
 NET OFFICE 6724/200 = 34
 NET WAREHOUSE - 12960/2000 = 7
 TOTAL REQUIRED 41
 3 SPACES HC SPACES PROVIDED

PARKING PROVIDED
 TOTAL 54
 3 HC SPACES

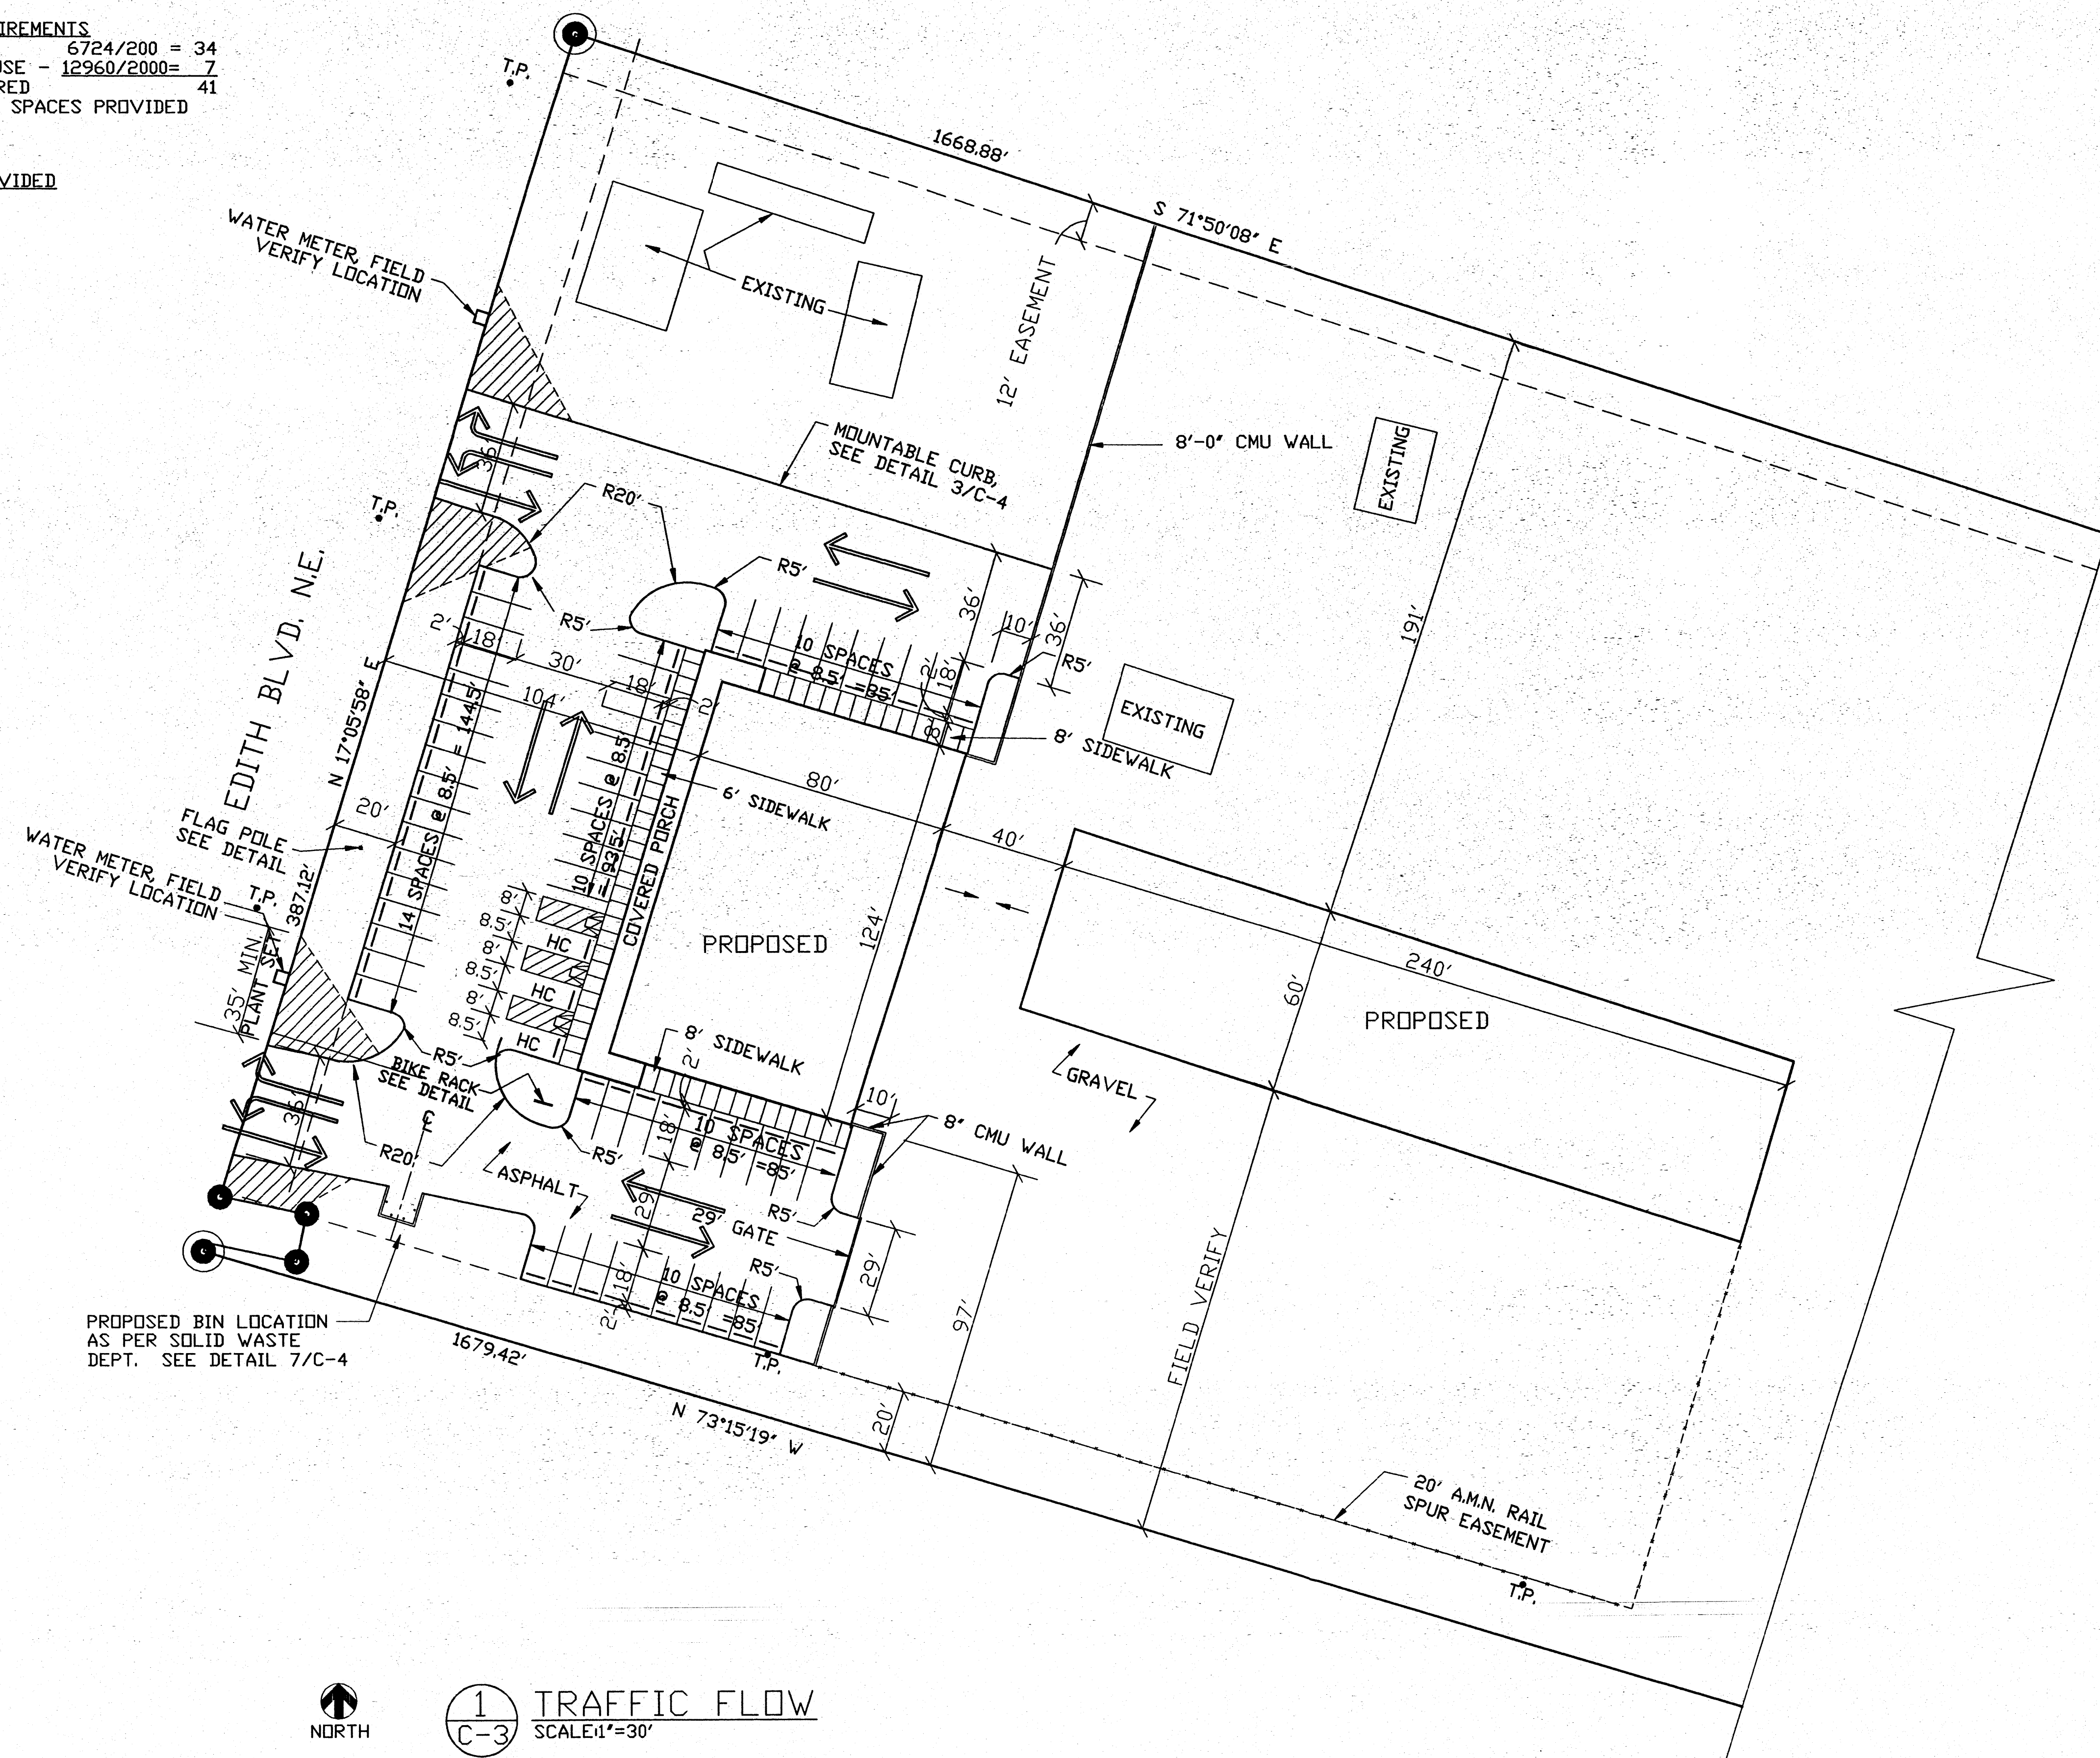

PROJECT LOCATION:

5030 Edith Blvd NE,
 Albuquerque, NM 87107

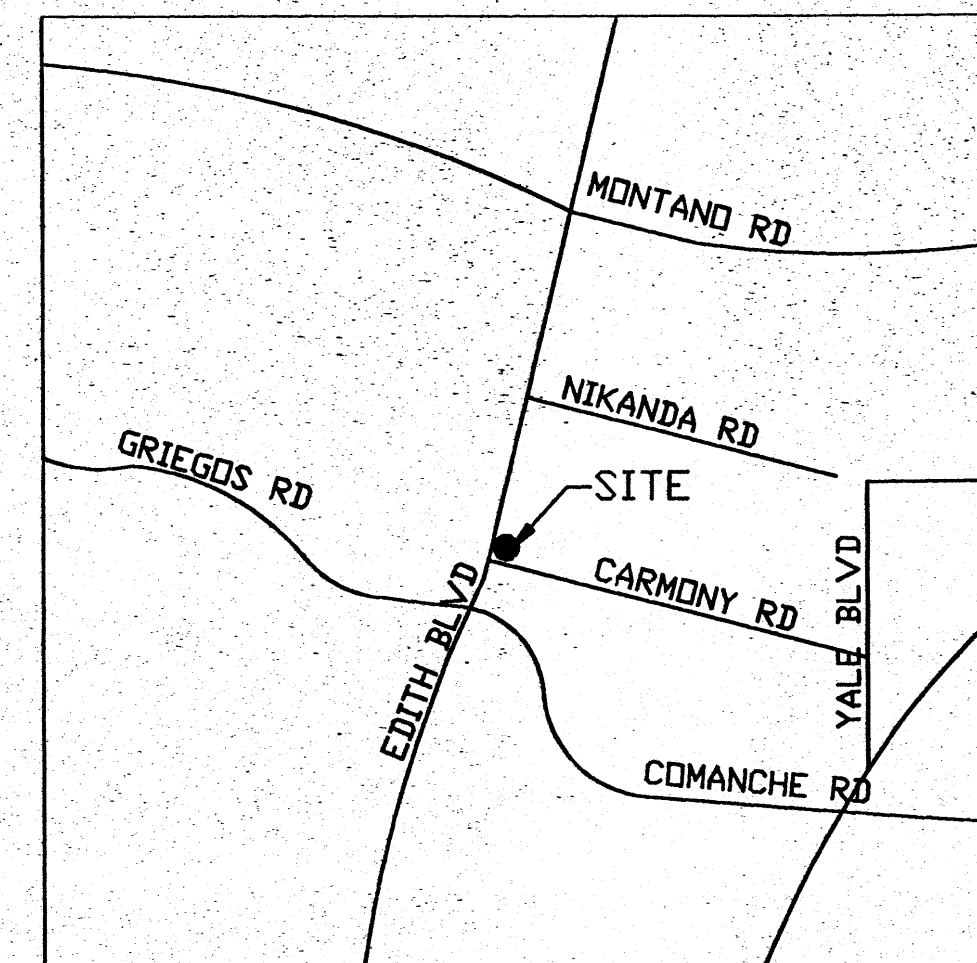


LEGAL DESCRIPTION

Tracts numbered one (1), two (2), and three (3) of the Lands of Lafarge, situate within projected Section 4, T10N, R3E, NMPM, Town of Albuquerque Grant, Bernalillo County, New Mexico, as shown and designated on the plat of said lands filed in the office of the county clerk of Bernalillo, New Mexico, on November 1, 2001, in Book 2001, page 290.

ZONE MAP: G-15

TRAFFIC CIRCULATION LAYOUT
 APPROVED

Signed: *[Signature]* Date: 3-8-05

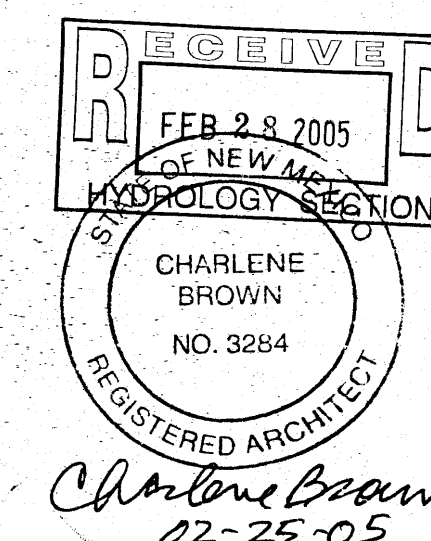

TLC PLUMBING OFFICE

TRAFFIC FLOW INFORMATION

Charlene Brown dba
 BROWN + WOOTTON
 9013 Camino del Sol NE
 Albuquerque, NM 87111

505-797-3383 Phone 505-797-3363 Fax
 brownandwootton@msn.com

Designed: CBB	Drawn: JM	Checked: DA	Sheet
Scale: 1"=30'	Date: 01-05	Job: TLC	C-3