

DRAINAGE INFORMATION SHEET


PROJECT TITLE: LIPS Grading, Drainage & Paving Improvements ZONE ATLAS/DRNG. FILE #: G-16 / 1000
 DRB #: N/A EPC #: N/A WORK ORDER #: N/A
 LEGAL DESCRIPTION: Mexal6 Tract 1 and Hahn Parcel (Parcel 1)
 CITY ADDRESS: 2401 Comanche Rd. NE, Albuquerque, NM 87107
 ENGINEERING FIRM: Easterling & Associates, Inc. CONTACT: R. P. Bohannon
 ADDRESS: 5643 Paradise Blvd. NW PHONE: 898-8021
Albuquerque, NM 87114
 OWNER: United Parcel Service CONTACT: Ron Andreas
 ADDRESS: 2401 Comanche Rd. NE PHONE: 888-1218
Albuquerque, NM 87107
 ARCHITECT: N/A CONTACT: _____
 ADDRESS: _____ PHONE: _____
 SURVEYOR: GeoSurveys CONTACT: Rick Fenecl
 ADDRESS: 500 Circulo Florentia NW PHONE: 344-5330
Albuquerque, NM 87107
 CONTRACTOR: Universal Constructors CONTACT: Gilbert Luna
 ADDRESS: P.O. Box 6008, Sta B PHONE: 884-0400
Albuquerque, NM 87197

TYPE OF SUBMITTAL:

☐ DRAINAGE REPORT
☐ DRAINAGE PLAN
☐ CONCEPTUAL GRADING & DRAINAGE PLAN
☐ GRADING PLAN
☐ EROSION CONTROL PLAN
☒ ENGINEER'S CERTIFICATION
☐ OTHER _____

PRE-DESIGN MEETING:

☐ YES
☐ NO
☐ COPY PROVIDED

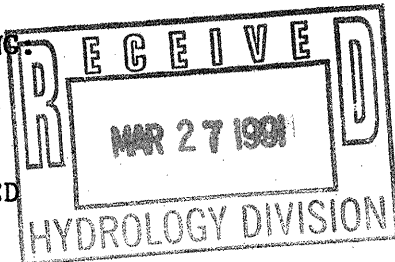

CHECK TYPE OF APPROVAL SOUGHT:

☐ SKETCH PLAT APPROVAL
☐ PRELIMINARY PLAT APPROVAL
☐ S. DEV. PLAN FOR SUB'D. APPROVAL
☐ S. DEV. PLAN FOR BLDG. PERMIT APPROVAL
☐ SECTOR PLAN APPROVAL
☐ FINAL PLAT APPROVAL
☐ FOUNDATION PERMIT APPROVAL
☐ BUILDING PERMIT APPROVAL
☐ CERTIFICATE OF OCCUPANCY APPROVAL
☐ GRADING PERMIT APPROVAL
☐ PAVING PERMIT APPROVAL
☐ S.A.D. DRAINAGE REPORT
☐ DRAINAGE REQUIREMENTS
☒ OTHER As-Built (SPECIFY)

DATE SUBMITTED: 3/26/91
 BY: Ronald P. Bohannon



City of Albuquerque

P.O. BOX 1293 ALBUQUERQUE, NEW MEXICO 87103

June 28, 1994

Richard Vaughn
Richard Vaughn & Associates
3700 Coors NW
Albuquerque, NM 87121

RE: DRAINAGE PLAN FOR A TRUCK WASH TERMINAL @ UNITED PARCEL SERVICE
(G16-D20) ENGINEER'S STAMP DATED 6/21/94.

Dear Mr. Vaughn:

Based on the information provided on your June 22, 1994 submittal, the above referenced site is approved for Building Permit.

Please attach a copy of this approved plan to the construction sets prior to sign-off by Hydrology.

Please be advised that any further development within the U.P.S. parcel will require an updated Master Drainage Plan.

If I can be of further assistance, please feel free to contact me at 768-2667.

Sincerely,

Bernie J. Montoya

Bernie J. Montoya, CE
Engineering Associate

BJM/d1/WPHYD/8622

c: Andrew Garcia
Vera Davis
File

DRAINAGE INFORMATION SHEET

PROJECT TITLE: UNITED PARCEL SERVICE
ALBUQ HUB IMPROVEMENTS ZONE ATLAS/DRNG. FILE #: G-16 Z/A 20

DRB #: _____ EPC #: _____ WORK ORDER #: _____

LEGAL DESCRIPTION: LANDS OF MEXALB CORPORATION PLATS C19-171 + D7-22

CITY ADDRESS: 2401 COMANCHE NE

ENGINEERING FIRM: RICHARD VAUGHN ASSOC. CONTACT: DICK VAUGHN

ADDRESS: 3700 COORS NW PHONE: 831-4511

OWNER: UNITED PARCEL SERVICE, VERA DAVIS CONTACT: VERA DAVIS
4101 McEWEN, SUITE 600

ADDRESS: DALLAS, TX 75244 PHONE: (214) 788-7724

ARCHITECT: NIMS CALVANI CONTACT: JOHN LAYMAN

ADDRESS: 525 SAN PEDRO NE PHONE: 268-6954

SURVEYOR: ESA CONSTRUCTION CONTACT: ANDY LEE

ADDRESS: 3435 GIRARD NE PHONE: 884-2171

CONTRACTOR: ESA CONSTRUCTION CONTACT: ANDY LEE

ADDRESS: 3435 GIRARD NE PHONE: 884-2171

TYPE OF SUBMITTAL:

- ☐ DRAINAGE REPORT
- ☒ DRAINAGE PLAN
- ☐ CONCEPTUAL GRADING & DRAINAGE PLAN
- ☐ GRADING PLAN
- ☐ EROSION CONTROL PLAN
- ☐ ENGINEER'S CERTIFICATION
- ☐ OTHER _____

CHECK TYPE OF APPROVAL SOUGHT:

- ☐ SKETCH PLAT APPROVAL
- ☐ PRELIMINARY PLAT APPROVAL
- ☐ S. DEV. PLAN FOR SUB'D. APPROVAL
- ☐ S. DEV. PLAN FOR BLDG. PERMIT APPROVAL
- ☐ SECTOR PLAN APPROVAL
- ☐ FINAL PLAT APPROVAL
- ☐ FOUNDATION PERMIT APPROVAL
- ☒ BUILDING PERMIT APPROVAL
- ☐ CERTIFICATE OF OCCUPANCY APPROVAL
- ☐ GRADING PERMIT APPROVAL
- ☐ PAVING PERMIT APPROVAL
- ☐ S.A.D. DRAINAGE REPORT
- ☐ DRAINAGE REQUIREMENTS
- ☐ SUBDIVISION CERTIFICATION
- ☐ OTHER _____ (SPECIFY)

PRE-DESIGN MEETING:

- ☐ YES
- ☐ NO
- ☐ COPY PROVIDED

JUN 22 1994

DATE SUBMITTED:

BY:

6/22/94

Andy Lee



City of Albuquerque

P.O. BOX 1293 ALBUQUERQUE, NEW MEXICO 87103

August 19, 1991

R.P. Bohannon
Easterling & Associates, Inc.
5643 Paradise Boulevard, NW
Albuquerque, New Mexico 87114

RE: ENGINEER'S CERTIFICATION FOR UPS GRADING, DRAINAGE &
PAVING IMPROVEMENTS DATED MARCH 26, 1991 (G-16/D20)


Dear Mr. Bohannon:

The as-built drainage plan received on March 27, 1991 is in accordance with our pre-design, hence, your submittal is approved.

The appropriate site drainage discharge points to the proposed SAD 216 drainage improvements will be determined during final design of SAD drainage improvements. The final approval of the connection to the SAD storm drain will be through the City Engineer's office (Hydrology Division) and through the SAD Engineer.

Should you have any questions, please call me at 768-2650.

Cordially,

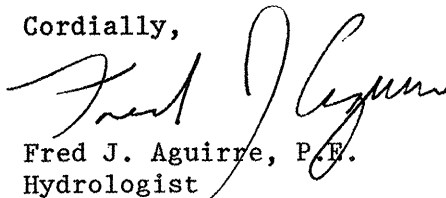

Fred J. Aguirre, P.E.
Hydrologist

FJA/bsj
(WP+2857)


PUBLIC WORKS DEPARTMENT

Walter H. Nickerson, Jr., P.E.
Assistant Director Public Works

ENGINEERING GROUP

Telephone (505) 768-2500

AN EQUAL OPPORTUNITY EMPLOYER

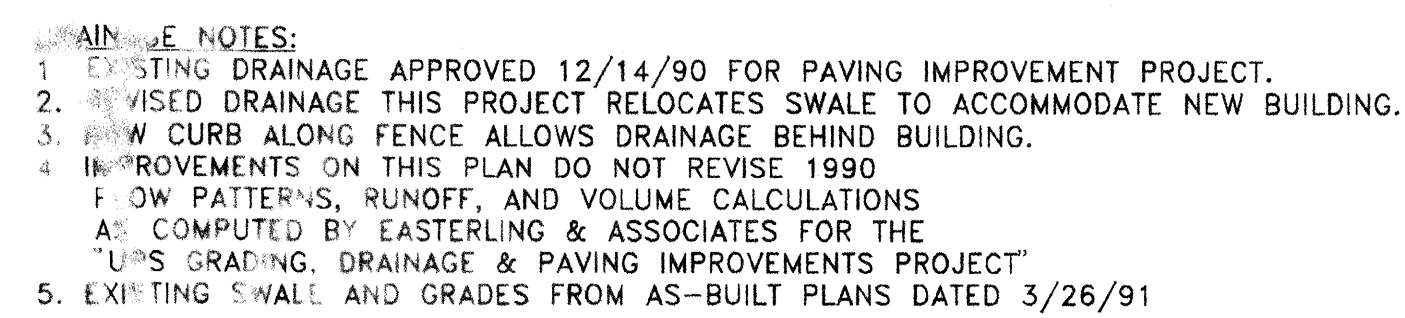

SCALE: 1"=50'-0"

A circular professional engineer seal for the State of New Mexico. The outer ring contains the text "REGISTERED PROFESSIONAL ENGINEER" at the top and "NEW MEXICO" at the bottom. The center of the seal features the text "STATE OF" at the top, "NO. 3677" in the middle, and "RICHARD G. VAUGHAN" at the bottom. There are handwritten initials "R" and "G" over the number "3677".



I HEREBY CERTIFY THAT I AM A REGISTERED PROFESSIONAL ENGINEER,
THAT I HAVE INSPECTED THE SITE, AND THAT THE IMPROVEMENTS HAVE
BEEN CONSTRUCTED IN ACCORDANCE WITH THE APPROVED PLANS WITH
MINOR REVISIONS AS NOTED ON THESE AS-CONSTRUCTED PLANS.

Ronald P. Bohannon
R.P. BOHANNAN, P.E.
N.M.P.E. NO. 9814

DATE: 3/26/91

Ronald P. Bohannon
3/26/91

40 20 0 40 80
Scale 1" = 40' Feet

CONSTRUCT BERM IMPROVEMENTS
SEE DETAIL ON SHEET 2 FOR
IMPROVEMENTS IN THIS AREA

EXISTING OUTLET STRUCTURES

I-25 EAST FRONTAGE ROAD

AREA 5
(EXISTING POND)

EXISTING RETENTION /
DETENTION POND

AREA 4
(EXISTING ASPHALT)

EXISTING

BUILDING

AREA 3

CONSTRUCT CONCRETE CURB
CONSTRUCT EXTRUDED
ASPHALT CURB

CONSTRUCT 3" GRAVEL SURFACE

LAYOUT AND STRIPE
TRUCK PARKING STALLS
PER UPS PLAN &
SPECIFICATIONS

CONSTRUCT 3" ASPHALT PAVING
WITHIN AREA 1 (ASPHALT)
APPROX. 7450 S.Y.

TBM
TOP OF GAS
ISLAND 5060.75

EXIST. EDGE
OF PVM T

SAWCUT HEADER CURB 4' WIDE
AND DOWN TO PROPOSED GRADE
PROPOSED INV. = 59.09

CONSTRUCT 6' WIDE
CONC. SWALE SEE
DETAIL THIS SHEET

REMOVE & DISPOSE OF
EXIST. FRENCH DRAIN
BACKFILL W/ CLEAN
FILL COMPACTED TO 95%
ASTM D-1557

ADDITIONAL
PAVING

GUARD STATION

CONSTRUCT 2" ASPHALT PAVING
WITHIN AREA 2 (ASPHALT)
APPROX. 2290 S.Y.

ADDITIONAL
PAVING

CONSTRUCT GRAVEL SURFACING
WITHIN AREA 3 (GRAVEL)
APPROX. 6640 S.Y.

AREA 3
(GRAVEL)

REMOVE EXIST. GUARD
POSTS & BACKFILL POST
HOLES (APPROX. 25 EA.)

EXISTING FENCE

COMMANCHE

BLVD.

SECTION A-A

6" SUBGRADE
95% COMPACTION
ASTM D-1557

#4 AT 24" OC =
WELDED WIRE MESH 6" X 6" X 6"
PER COA STD. DWG. 2420

VOLUME CALCULATIONS

Q100 (6HR) RUNOFF VOLUME EXISTING CONDITION = 73,503 CF
Q100 (6HR) RUNOFF VOLUME WITH PROPOSED
ADDITIONAL PAVING = 81,997 CF
EXISTING POND VOLUME
DETENTION (ABOVE OUTLET WEIR ELEV (5050.85) = 57,002 CF
RETENTION (BELOW OUTLET WEIR ELEV (5050.85) = 26,858 CF
TOTAL = 83,860 CF

PROJECT: UPS
JOB NO. 2852 BY DLS DATE 12-12-90 CHECKED BY RPB DATE 12-12-90

		SCALE		FACTOR	
ELEVATION	IN ²	FT ²	FT ³	INDIVIDUAL ACRE FEET	CUMULATIVE ACRE FEET
5048.65	0	0	0	0.022	0.022
5049.00	3.5	5,600	18,800	.230	.252
5050.0	9.0	14,400	18,680	.429	.681
5051.0	14.35	22,960	25,080	.576	1.257
5052.0	17.0	27,200	29,120	.669	1.926
5053.0	19.40	31,040			(3,897cf)

NOTES:

1. Refer to sheet 2 for pavement sections.
2. Trim (sawcut) and remove and dispose of approximately 1' of existing asphalt at all existing pavement edges abutting proposed paving. Tack edge for new paving connection.
3. This plan does not show all existing improvements and utilities. Contractor shall locate and prevent damage to existing improvements and utilities.
4. For compaction purposes, site soils are considered cohesive.
5. Refer to legend sheet 2 of 2.

Approval of this interim drainage plan is based on the understanding that ultimate drainage improvements will be designed and constructed with SAD 216. If the SAD does not occur prior to future expansion, additional drainage improvements may be required.

APPROVAL: PAVING PERMIT

Ronald P. Bohannon
Date 12/14/90

LEGAL DESCRIPTION: LANDS OF MEXALB CORPORATION (PLATS C19-171 & D7-22)

BENCHMARK INFORMATION: WEST FRONTAGE ROAD OF I-25 .5 MILES SOUTH OF MONTANO ROAD. NM SHC STA. I-25-20 ELEV= 5079.46

NO.	REVISIONS	BY	DATE
UPS GRADING, DRAINAGE & PAVING IMPROVEMENTS			
EASTERLING & ASSOCIATES, INC. CONSULTING ENGINEERS 5643 Paradise Blvd. N.W. Albuquerque, New Mexico 87114			
Designed DLS	Drawn MES	Checked RPB	Sheet 1
Job No. 2852	Date DEC., 1990	of 2	


LEGEND

DESCRIPTION	NEW	EXISTING
CONTOURS	5094	5094
SPOT ELEVATIONS	5088	5088
DRAINAGE AREA BOUNDARY		
DRAINAGE DIVIDE		
WATER BLOCK		
DIRECTION OF FLOW		
ASPHALT PAVING	ASPHALT	ASPHALT
LANDSCAPING	L.S.	L.S.
RETAINING WALL		
GARDEN WALL		
SWALE		
PROPERTY LINE		
FENCE		
CATCH BASIN		
STORM DRAIN M.H. & LINE	36" SD	36" SD
SANITARY SEWER M.H. & LINE	8" SAS	8" SAS
FIRE HYDRANT & WATER LINE	6" W	6" W
REDUCERS		
WATER VALVES		
WATER CONNECTIONS		
WATER JOINTS		
CONCRETE		
GAS LINE		
UNDERGROUND TELEPHONE	UT	UT
CABLE TELEVISION	CT	CT
POWER/TELEPHONE POLE	P.P.	P.P.
UNDERGROUND ELECTRICAL	UE	UE
CURB ELEVATION	TC 5088.28 FL 5087.78	TC 5088.28 FL 5087.78
HYDROLOGICAL ANALYSIS PT.		
DETAIL REFERENCE		
KEYED NOTES		
C.O.A. DETAIL REFERENCE		
CURVE OR COORDINATE REFERENCE INFO.		
PHASE BOUNDARY		


GENERAL NOTES FOR GRADING AND DRAINAGE

- AN EXCAVATION/CONSTRUCTION PERMIT MAY BE REQUIRED BEFORE BEGINNING ANY WORK WITHIN CITY RIGHT-OF-WAY. AN APPROVED COPY OF THESE PLANS MUST BE SUBMITTED AT THE TIME OF APPLICATION FOR THIS PERMIT.
- ALL WORK DETAILED ON THESE PLANS, EXCEPT AS OTHERWISE STATED OR PROVIDED HEREON, SHALL BE CONSTRUCTED IN ACCORDANCE WITH UPS PROJECT SPECIFICATIONS.
- TWO WORKING DAYS PRIOR TO ANY EXCAVATION, CONTRACTOR MUST CONTACT LINE LOCATING SERVICE, 260-1990, FOR LOCATION OF EXISTING UTILITIES.
- PRIOR TO CONSTRUCTION, THE CONTRACTOR SHALL EXCAVATE AND VERIFY THE HORIZONTAL AND VERTICAL LOCATIONS OF ALL OBSTRUCTIONS. SHOULD A CONFLICT EXIST, THE CONTRACTOR SHALL NOTIFY THE ENGINEER SO THE CONFLICT CAN BE RESOLVED WITH A MINIMUM AMOUNT OF DELAY.
- BACKFILL COMPACTION SHALL BE 95% ASTM 1557.
- ALL UTILITIES AND UTILITY SERVICE LINES SHALL BE INSTALLED PRIOR TO PAVING.
- DISPOSAL OF ALL WASTE MATERIAL SHALL BE THE RESPONSIBILITY OF THE CONTRACTOR.
- OWNERSHIP OF DOCUMENTS:** THIS DOCUMENT, AND THE IDEAS AND DESIGNS INCORPORATED HEREIN, AS AN INSTRUMENT OF PROFESSIONAL SERVICE, IS THE PROPERTY OF EASTERLING & ASSOCIATES, INC. AND IS NOT TO BE USED, IN WHOLE OR IN PART, FOR ANY OTHER PROJECT WITHOUT THE WRITTEN AUTHORIZATION OF EASTERLING & ASSOCIATES, INC.
- CONSTRUCTION SAFETY:** THESE DRAWINGS DO NOT INCLUDE NECESSARY COMPONENTS FOR CONSTRUCTION SAFETY WHICH SHALL REMAIN THE CONTRACTOR'S RESPONSIBILITY.
- EROSION CONTROL:** THE SITE WILL BE FULLY DEVELOPED IMMEDIATELY. EROSION PROBLEMS GENERATED BY PHASED DEVELOPMENT WILL NOT, THEREFORE, BE A PROBLEM.
- CONSTRUCTION PHASE:** THE CONTRACTOR SHALL EXERCISE REASONABLE CARE DURING CONSTRUCTION TO PREVENT THE MOVEMENT OF SEDIMENT FROM THE SITE INTO THE STREET. LOOSE SOIL STOCKPILES IN THE STREET DURING UTILITY CONNECTION ACTIVITIES SHALL BE PROTECTED FROM BEING CARRIED DOWNSTREAM BY FLOWING WATER IN THE STREET.


AREA 1

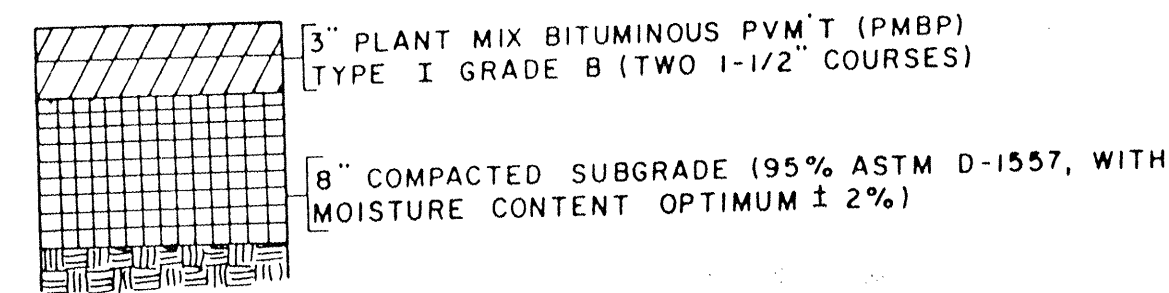

AREA 2

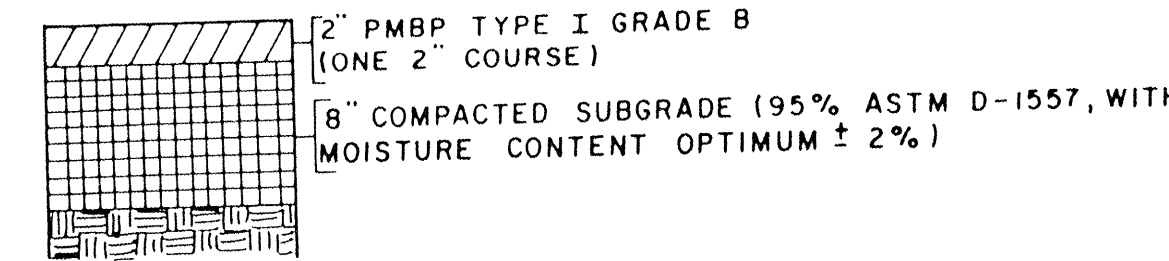


AREA 3

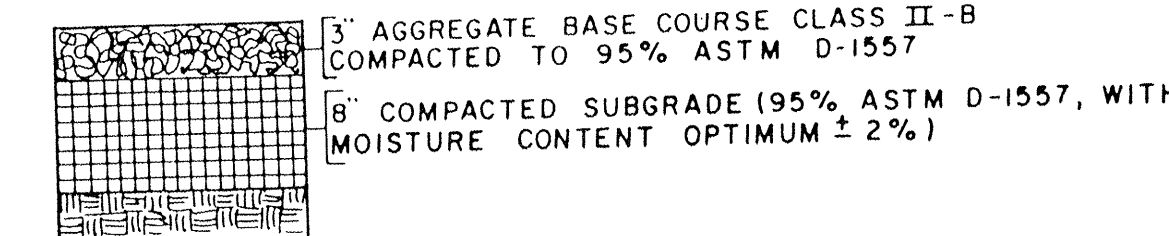

I HEREBY CERTIFY THAT I AM A REGISTERED PROFESSIONAL ENGINEER, THAT I HAVE INSPECTED THE SITE, AND THAT THE IMPROVEMENTS HAVE BEEN CONSTRUCTED IN ACCORDANCE WITH THE APPROVED PLANS WITH MINOR REVISIONS AS NOTED ON THESE AS-CONSTRUCTED PLANS.

R.P. BOHANNAN, P.E.
N.M.P.E. NO. 9814

DATE: 3/26/91

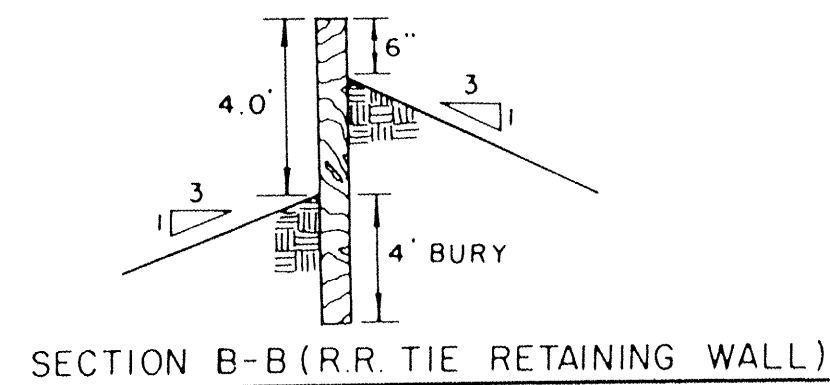

HYDROLOGY

TABLE 1 - RAINFALL DEPTHS (INCHES) FOR 100 YEAR RETURN PERIOD

DURATION	100 YEAR	50 YEAR	25 YEAR	10 YEAR	5 YEAR	2 YEAR
1 HOUR	2.91	1.81	1.61	1.34	1.14	0.87
6 HOUR	2.35	1.12	1.00	1.17	1.10	1.00
24 HOUR	2.75	2.40	2.20	1.83	1.56	1.19
4 DAY	3.30	2.97	2.64	2.28	1.87	1.43
10 DAY	3.95	3.56	3.16	2.63	2.24	1.71

TABLE 2 - BASIN LAND TREATMENT SUMMARY

BASIN	DESCRIPTION	AREA (ACRES)	LAND TREATMENT CLASSIFICATION (% OF TOTAL)
1.0	EXISTING	1.60	0.0% 0.0% 100.0% 0.0% 100.0%
2	EXISTING	0.40	0.0% 0.0% 100.0% 0.0% 100.0%
3	EXISTING	3.66	0.0% 0.0% 100.0% 0.0% 100.0%
4	EXISTING	6.94	0.0% 0.0% 100.0% 0.0% 100.0%
5	EXISTING	1.43	100.0% 0.0% 0.0% 0.0% 100.0%
1A	PROPOSED	1.60	0.0% 0.0% 100.0% 0.0% 100.0%
2A	PROPOSED	0.40	0.0% 0.0% 100.0% 0.0% 100.0%
3A	PROPOSED	3.66	0.0% 0.0% 100.0% 0.0% 100.0%
4A	PROPOSED	6.94	0.0% 0.0% 100.0% 0.0% 100.0%
5A	PROPOSED	1.43	100.0% 0.0% 0.0% 0.0% 100.0%

TABLE 3 - 2 YEAR EVENT SUPPLY FOR ALL BASINS

BASIN	DESCRIPTION	AREA (ACRES)	DISCHARGE VOLUME	PEAK	6 HOUR	24 HOUR	4 DAY	10 DAY
1.0	EXISTING	1.60	0.00	0.00	0.00	0.00	0.00	0.00
2	EXISTING	0.40	0.00	0.00	0.00	0.00	0.00	0.00
3	EXISTING	3.66	2.19	0.856	0.836	0.836	0.836	0.836
4	EXISTING	6.94	14.30	0.654	0.519	0.519	0.519	0.519
5	EXISTING	1.43	0.00	0.00	0.00	0.00	0.00	0.00
1A	PROPOSED	1.60	0.00	0.00	0.00	0.00	0.00	0.00
2A	PROPOSED	0.40	0.00	0.00	0.00	0.00	0.00	0.00
3A	PROPOSED	3.66	2.19	0.856	0.836	0.836	0.836	0.836
4A	PROPOSED	6.94	14.30	0.654	0.519	0.519	0.519	0.519
5A	PROPOSED	1.43	0.00	0.00	0.00	0.00	0.00	0.00

TABLE 4 - 10 YEAR EVENT SUPPLY FOR ALL BASINS

BASIN	DESCRIPTION	AREA (ACRES)	DISCHARGE VOLUME	PEAK	6 HOUR	24 HOUR	4 DAY	10 DAY
1.0	EXISTING	1.60	0.00	0.00	0.00	0.00	0.00	0.00
2	EXISTING	0.40	0.00	0.00	0.00	0.00	0.00	0.00
3	EXISTING	3.66	12.61	0.264	0.264	0.264	0.264	0.264
4	EXISTING	6.94	35.01	1.003	1.799	1.719	1.897	1.897
5	EXISTING	1.43	0.00	0.00	0.00	0.00	0.00	0.00
1A	PROPOSED	1.60	0.00	0.00	0.00	0.00	0.00	0.00
2A	PROPOSED	0.40	0.00	0.00	0.00	0.00	0.00	0.00
3A	PROPOSED	3.66	12.61	0.264	0.264	0.264	0.264	0.264
4A	PROPOSED	6.94	35.01	1.003	1.799	1.719	1.897	1.897
5A	PROPOSED	1.43	0.00	0.00	0.00	0.00	0.00	0.00

TABLE 5 - 100 YEAR EVENT SUPPLY FOR ALL BASINS


BASIN	DESCRIPTION	AREA (ACRES)	DISCHARGE VOLUME	PEAK	6 HOUR	24 HOUR	4 DAY	10 DAY
1.0	EXISTING	1.60	0.00	0.00	0.00	0.00	0.00	0.00
2	EXISTING	0.40	0.00	0.00	0.00	0.00	0.00	0.00
3	EXISTING	3.66	12.61	0.264	0.264	0.264	0.264	0.264
4	EXISTING	6.94	35.01	1.003	1.799	1.719	1.897	1.897
5	EXISTING	1.43	0.00	0.00	0.00	0.00	0.00	0.00
1A	PROPOSED	1.60	0.00	0.00	0.00	0.00	0.00	0.00
2A	PROPOSED	0.40	0.00	0.00	0.00	0.00	0.00	0.00
3A	PROPOSED	3.66	12.61	0.264	0.264	0.264	0.264	0.264
4A	PROPOSED	6.94	35.01	1.003	1.799	1.719	1.897	1.897
5A	PROPOSED	1.43	0.00	0.00	0.00	0.00	0.00	0.00

SOILS INFORMATION FROM SOIL SURVEY U.S.D.A., S.C.S.


SOIL SERIES AND MAP SYMBOLS	DEGREE AND KIND OF LIMITATIONS FOR						SUITABILITY AS SOURCE OF —				SOIL FEATURES AFFECTING —		HYDROLOGIC SOIL GROUP
	CEPTIC TANK ABSORPTION FIELDS	SEWAGE LAGOONS	SHALLOW EXCAVATIONS	DWELLINGS WITHOUT BASEMENTS	SANITARY LANDFILL (TRENCH TYPE)	LOCAL ROAD AND STREETS	ROAD FILL	SAND	GRAVEL	TOPSOIL	POND RESERVOIR AREAS	DIKES, LEVEES, AND OTHER EMBANKMENTS	
Embudo: EmB, Etc	Slight	Severe: seepage.	Moderate: small stones.	Slight	Severe: seepage.	Slight	Good	Poor: excess fine.	Poor: excess fine.	Poor: small stones.	Seepage	Piping; compressible	B
Wink: WaB, WeB, WM	Slight	Severe: seepage.	Slight	Slight	Severe: seepage.	Slight	Fair: low strength.	Unsuited	Unsuited	Good	Seepage	Piping; erodes easily.	B

BERM IMPROVEMENTS DETAIL


VICINITY MAP ZONE ATLAS MAP NO.

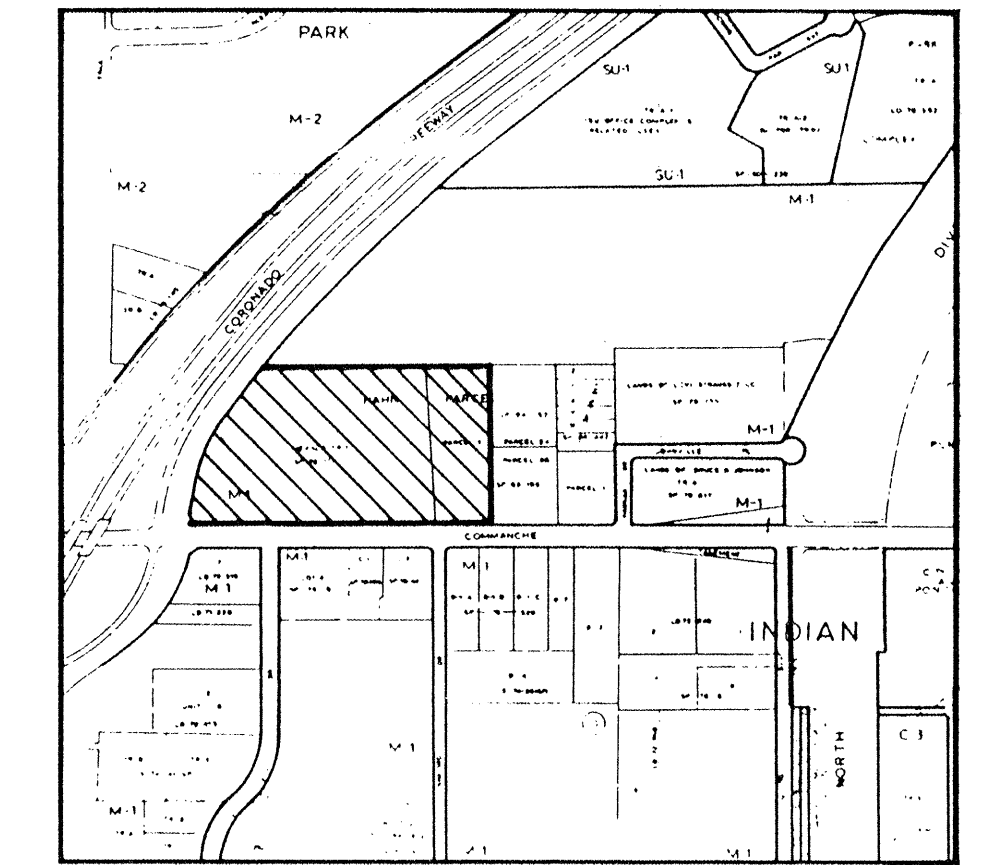

FLOOD HAZARD MAP & OFF-SITE FLOWS FROM F.E.M.A.

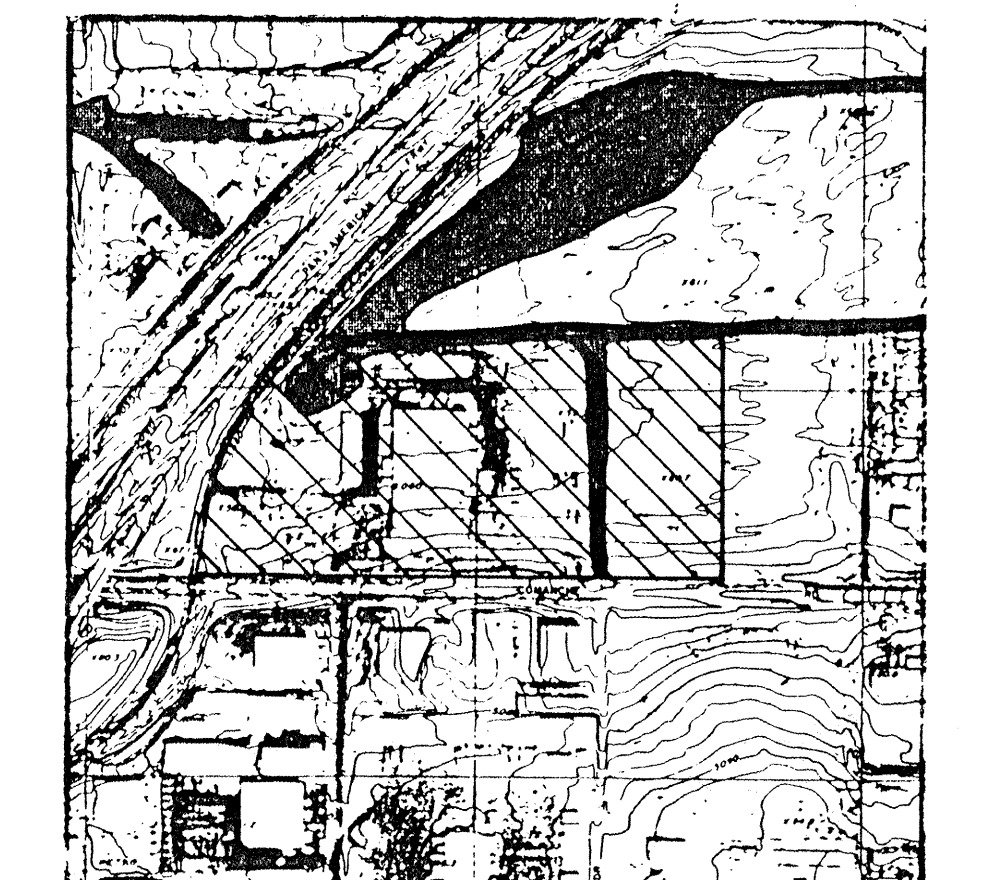

SOILS MAP SOIL SURVEY U.S.D.A., S.C.S.

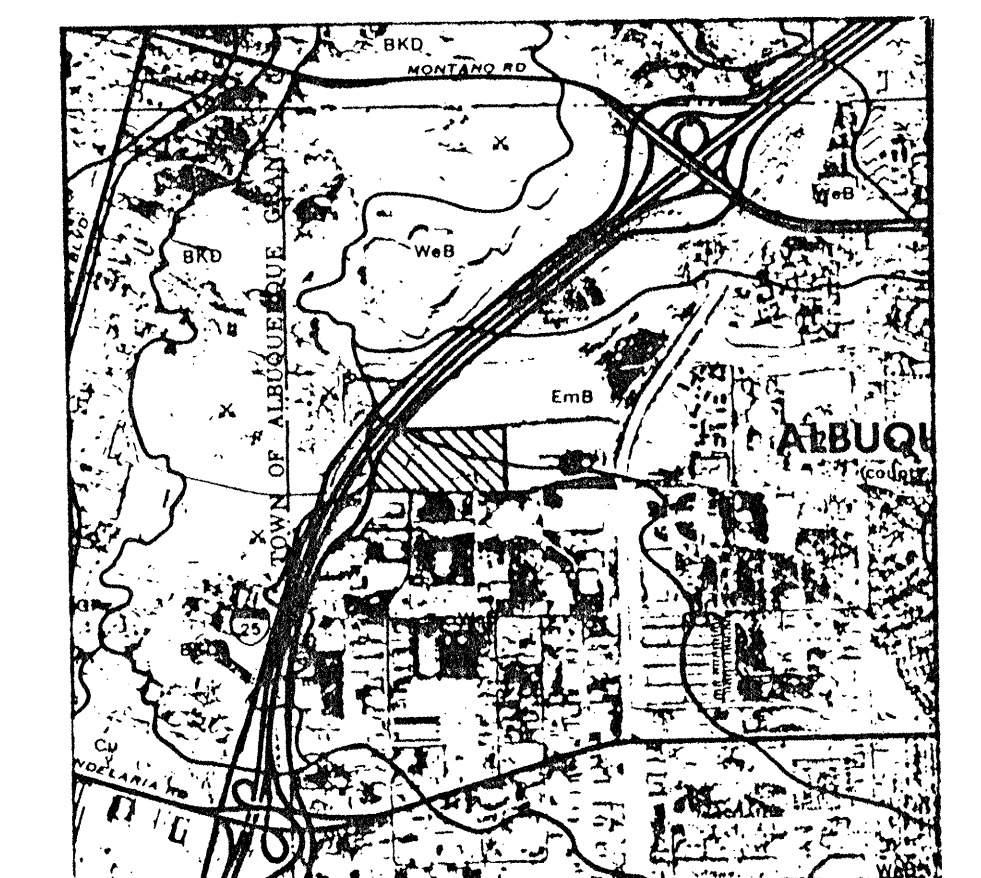

NO.	REVISIONS	BY	DATE
-----	-----------	----	------

UPS GRADING, DRAINAGE & PAVING IMPROVEMENTS

EASTERLING & ASSOCIATES, INC.
CONSULTING ENGINEERS

5643 Paradise Blvd. N.W.
Albuquerque, New Mexico 87114

Designed: DLS	Drawn: MES	Checked: RPB	Sheet: 2
Job No: 2852	Date: DEC., 1990	of: 2	

22 1994

I HEREBY CERTIFY THAT I AM A REGISTERED PROFESSIONAL ENGINEER, THAT I HAVE INSPECTED THE SITE, AND THAT THE IMPROVEMENTS HAVE BEEN CONSTRUCTED IN ACCORDANCE WITH THE APPROVED PLANS WITH MINOR REVISIONS AS NOTED ON THESE AS-CONSTRUCTED PLANS.

R.P. BOHANNAN, P.E.
N.M.P.E. NO. 9814

DATE: 3/26/91



Scale 1" = 40' Feet

CONSTRUCT BERM IMPROVEMENTS
SEE DETAIL ON SHEET 2 FOR
IMPROVEMENTS IN THIS AREA

EXISTING OUTLET STRUCTURES

I-25 EAST FRONTAGE ROAD

AREA 5
(EXISTING POND)

EXISTING RETENTION /
DETENTION POND

AREA 4
(EXISTING ASPHALT)

EXISTING

BUILDING

AREA 3

LAYOUT AND STRIPE
TRUCK PARKING STALLS
PER UPS PLAN 8
SPECIFICATIONS

CONSTRUCT 3" ASPHALT PAVING
WITHIN AREA 1 (ASPHALT)
APPROX. 7450 S.Y.

TBM
TOP OF GAS
ISLAND 5060.75

EXIST. EDGE
OF P.V.M.T.

SAWCUT HEADER CURB 4' WIDE
AND DOWN TO PROPOSED GRADE
PROPOSED INV. = 59.09

CONSTRUCT 6' WIDE
CONC. SWALE SEE
DETAIL THIS SHEET

REMOVE & DISPOSE OF
EXIST. FRENCH DRAIN
BACKFILL W/ CLEAN
FILL COMPACTED TO 95%
ASTM D-1557

ADDITIONAL
PAVING

GUARD STATION

CONSTRUCT 2" ASPHALT PAVING
WITHIN AREA 2 (ASPHALT)
APPROX. 2290 S.Y.

CONSTRUCTED CONCRETE CURB
CONSTRUCT EXTRUDED
ASPHALT CURB
CONSTRUCT 3" GRAVEL SURFACE

CONSTRUCTED CONCRETE CURB
CONSTRUCT EXTRUDED
ASPHALT CURB

CONSTRUCT GRAVEL SURFACING
WITHIN AREA 3 (GRAVEL)
APPROX. 4640 S.Y.

AREA 3
(GRAVEL)

REMOVE EXIST. GUARD
POSTS & BACKFILL POST
HOLES (APPROX. 25 EA.)

EXISTING FENCE

AREA 2
(ASPHALT)

ADDITIONAL
PAVING

COMMANCHE
BLVD.

APPROPRIATE SITE DRAINAGE DISCHARGE POINTS TO THE
PROPOSED SAD 216 DRAINAGE IMPROVEMENTS WILL
BE DETERMINED DURING FINAL DESIGN OF SAD
DRAINAGE IMPROVEMENTS. THE FINAL APPROVAL OF THE
CONSTRUCTION OF THE SAD STORM DRAIN WILL BE FROM
THE CITY ENGINEERING DEPT. (HYDROLOGY DIV.) AND FROM
THE T&E ENGINEER.

VOLUME CALCULATIONS

PROJECT UPS
JOB NO. 2852 BY DLS DATE 12-12-90 CHECKED BY EPB DATE 12-12-90

ELEVATION		IN ²		FT ²		FT ³		INDIVIDUAL ACRE FEET		CUMULATIVE ACRE FEET	
5048.65	Ø	Ø	Ø	Ø	Ø	Ø	Ø	Ø	Ø	Ø	Ø
5049.00	3.5	5,600	900	.022	.022						
5050.0	9.0	14,400	1,800	.230	.252						
5051.0	14.35	22,960	18,680	.429	.681						
5052.0	17.0	27,200	25,080	.576	1.257						
5053.0	19.40	31,040	29,120	.669	1.926						
										(3,897.6)	

NOTES:


1. Refer to sheet 2 for pavement sections.
2. Trim (sawcut) and remove and dispose of approximately 1' of existing asphalt at all existing pavement edges abutting proposed paving. Tack edge for new paving connection.
3. This plan does not show all existing improvements and utilities. Contractor shall locate and prevent damage to existing improvements and utilities.
4. For compaction purposes, site soils are considered cohesive.
5. Refer to legend sheet 2 of 2.

Include your
As-built plan
on your existing plan

Approval of this interim drainage plan is based
on the understanding that ultimate drainage
improvements will be designed and constructed
with SAD 216. If the SAD does not occur prior
to future expansion, additional drainage
improvements may be required.

APPROVAL: PRINCE PERMIT

And J. Leguina 12/14/90
Date

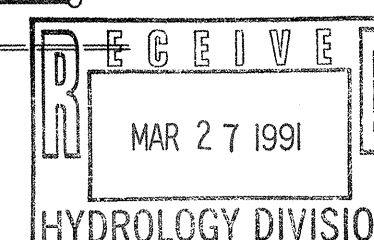

NO.	REVISIONS	BY	DATE
UPS GRADING, DRAINAGE & PAVING IMPROVEMENTS			
EASTERLING & ASSOCIATES, INC. CONSULTING ENGINEERS 5643 Paradise Blvd. N.W. Albuquerque, New Mexico 87114			
Designed: DLS	Drawn: MES	Checked: RPB	Sheet 1
Job No: 2852	Date: DEC., 1990	of 2	

LEGAL DESCRIPTION: LANDS OF MEXALB CORPORATION (PLATS C19-171 & D7-22)

BENCHMARK INFORMATION: WEST FRONTAGE ROAD OF I-25 .5 MILES SOUTH OF MONTANO ROAD. NM SHC STA. I-25-20 ELEV= 5079.46

LEGEND

DESCRIPTION	NEW	EXISTING
CONTOURS	5094	5094
SPOT ELEVATIONS	5088	5088
DRAINAGE AREA BOUNDARY		
DRAINAGE DIVIDE		
WATER BLOCK		
DIRECTION OF FLOW		
ASPHALT PAVING	ASPHALT	ASPHALT
LANDSCAPING	L.S.	L.S.
RETAINING WALL		
GARDEN WALL		
SWALE		
PROPERTY LINE		
FENCE		
CATCH BASIN		
STORM DRAIN M.H. & LINE	36" SD	36" SD
SANITARY SEWER M.H. & LINE	8" SAS	8" SAS
FIRE HYDRANT & WATER LINE	6" W	6" W
REDUCERS		
WATER VALVES	1/2" GATE BUTTERFLY	1/2" GATE BUTTERFLY
WATER CONNECTIONS		
WATER JOINTS		
CONCRETE		
GAS LINE		
UNDERGROUND TELEPHONE		
CABLE TELEVISION		
POWER/TELEPHONE POLE		
UNDERGROUND ELECTRICAL		
CURB ELEVATION	TC 5088.28 FL 5087.78	TC 5088.28 FL 5087.78
HYDROLOGICAL ANALYSIS PT.		
DETAIL REFERENCE		
KEYED NOTES		
C.O.A. DETAIL REFERENCE		
CURVE OR COORDINATE REFERENCE INFO.		
PHASE BOUNDARY		

GENERAL NOTES FOR GRADING AND DRAINAGE

- AN EXCAVATION/CONSTRUCTION PERMIT MAY BE REQUIRED BEFORE BEGINNING ANY WORK WITHIN CITY RIGHT-OF-WAY. AN APPROVED COPY OF THESE PLANS MUST BE SUBMITTED AT THE TIME OF APPLICATION FOR THIS PERMIT.
- ALL WORK DETAILED ON THESE PLANS, EXCEPT AS OTHERWISE STATED OR PROVIDED HEREON, SHALL BE CONSTRUCTED IN ACCORDANCE WITH UPS PROJECT SPECIFICATIONS.
- TWO WORKING DAYS PRIOR TO ANY EXCAVATION, CONTRACTOR MUST CONTACT LINE LOCATING SERVICE, 260-1990, FOR LOCATION OF EXISTING UTILITIES.
- PRIOR TO CONSTRUCTION, THE CONTRACTOR SHALL EXCAVATE AND VERIFY THE HORIZONTAL AND VERTICAL LOCATIONS OF ALL OBSTRUCTIONS. SHOULD A CONFLICT EXIST, THE CONTRACTOR SHALL NOTIFY THE ENGINEER SO THE CONFLICT CAN BE RESOLVED WITH A MINIMUM AMOUNT OF DELAY.
- BACKFILL COMPACTION SHALL BE 95% ASTM 1557.
- ALL UTILITIES AND UTILITY SERVICE LINES SHALL BE INSTALLED PRIOR TO PAVING.
- DISPOSAL OF ALL WASTE MATERIAL SHALL BE THE RESPONSIBILITY OF THE CONTRACTOR.
- OWNERSHIP OF DOCUMENTS:** THIS DOCUMENT, AND THE IDEAS AND DESIGNS INCORPORATED HEREIN, AS AN INSTRUMENT OF PROFESSIONAL SERVICE, IS THE PROPERTY OF EASTERLING & ASSOCIATES, INC., AND IS NOT TO BE USED, IN WHOLE OR IN PART, FOR ANY OTHER PROJECT WITHOUT THE WRITTEN AUTHORIZATION OF EASTERLING & ASSOCIATES, INC.
- CONSTRUCTION SAFETY:** THESE DRAWINGS DO NOT INCLUDE NECESSARY COMPONENTS FOR CONSTRUCTION SAFETY WHICH SHALL REMAIN THE CONTRACTOR'S RESPONSIBILITY.
- EROSION CONTROL:** THE SITE WILL BE FULLY DEVELOPED IMMEDIATELY. EROSION PROBLEMS GENERATED BY PHASED DEVELOPMENT WILL NOT, THEREFORE, BE A PROBLEM.
- CONSTRUCTION PHASE:** THE CONTRACTOR SHALL EXERCISE REASONABLE CARE DURING CONSTRUCTION TO PREVENT THE MOVEMENT OF SEDIMENT FROM THE SITE INTO THE STREET. LOOSE SOIL STOCKPILES IN THE STREET DURING UTILITY CONNECTION ACTIVITIES SHALL BE PROTECTED FROM BEING CARRIED DOWNSTREAM BY FLOWING WATER IN THE STREET.

AREA 1

- 3" PLANT MIX BITUMINOUS PVM'T (PMBP) TYPE I GRADE B (TWO 1-1/2" COURSES)
- 8" COMPACTED SUBGRADE (95% ASTM D-1557, WITH MOISTURE CONTENT OPTIMUM \pm 2%)


AREA 2

- 2" PMBP TYPE I GRADE B (ONE 2" COURSE)
- 8" COMPACTED SUBGRADE (95% ASTM D-1557, WITH MOISTURE CONTENT OPTIMUM \pm 2%)

AREA 3


- 1" AGGREGATE BASE COURSE CLASS II-B COMPACTED TO 95% ASTM D-1557
- 8" COMPACTED SUBGRADE (95% ASTM D-1557, WITH MOISTURE CONTENT OPTIMUM \pm 2%)

I HEREBY CERTIFY THAT I AM A REGISTERED PROFESSIONAL ENGINEER, THAT I HAVE INSPECTED THE SITE, AND THAT THE IMPROVEMENTS HAVE BEEN CONSTRUCTED IN ACCORDANCE WITH THE APPROVED PLANS WITH MINOR REVISIONS AS NOTED ON THESE AS-CONSTRUCTED PLANS.

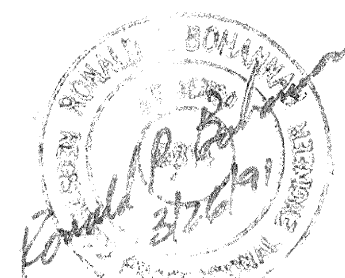

R.P. BOHANNAN, P.E.
N.M.P.E. NO. 9814

DATE: 3/26/91

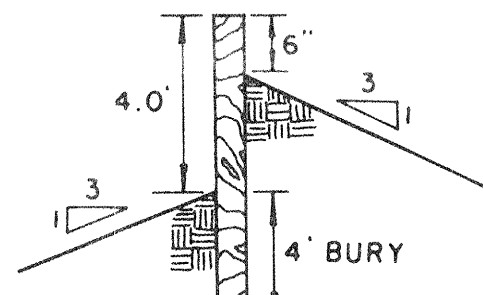

SECTION B-B (R.R. TIE RETAINING WALL)

HYDROLOGY

TABLE 1 - RAINFALL DEPTHS (INCHES) FOR ZONE 2

DURATION	100 YEAR	50 YEAR	25 YEAR	10 YEAR	5 YEAR	2 YEAR
1 HOUR	2.81	1.81	1.61	1.34	1.14	0.87
6 HOUR	2.35	1.32	1.08	1.17	1.33	1.42
24 HOUR	2.75	2.40	2.20	1.83	1.56	1.19
4 DAY	3.30	2.57	2.54	2.20	1.87	1.43
10 DAY	3.95	3.56	3.16	2.63	2.24	1.71

TABLE 2 - BASIN LAND TREATMENT SUPPLY

BASIN I.D.	DESCRIPTION	AREA (ACRES)	A	B	C	D	TOTAL
1	EXISTING	1.68	0.0%	0.0%	100.0%	0.0%	100.0%
2	EXISTING	0.88	0.0%	0.0%	100.0%	0.0%	100.0%
3	EXISTING	3.66	0.0%	0.0%	100.0%	0.0%	100.0%
4	EXISTING	6.94	0.0%	0.0%	0.0%	100.0%	100.0%
5	EXISTING	1.43	100.0%	0.0%	0.0%	0.0%	100.0%
1A	PROPOSED	1.08	0.0%	0.0%	0.0%	100.0%	100.0%
2A	PROPOSED	0.40	0.0%	0.0%	0.0%	100.0%	100.0%
3A	PROPOSED	3.66	0.0%	0.0%	0.0%	100.0%	100.0%
4A	PROPOSED	6.94	0.0%	0.0%	0.0%	100.0%	100.0%
5A	PROPOSED	1.43	100.0%	0.0%	0.0%	0.0%	100.0%

TABLE 3 - 2 YEAR EVENT SUPPLY FOR ALL BASINS

BASIN I.D.	DESCRIPTION	AREA (ACRES)	DISCHARGE VOLUME (CFS)	6 HOUR (AC-FT)	24 HOUR (AC-FT)	4 DAY (AC-FT)	10 DAY (AC-FT)
1	EXISTING	1.68	1.41	0.818	0.818	0.818	0.818
2	EXISTING	0.88	0.79	0.809	0.809	0.809	0.809
3	EXISTING	3.66	2.19	0.856	0.856	0.856	0.856
4	EXISTING	6.94	14.38	0.454	0.516	0.649	0.818
5	EXISTING	1.43	0.86	0.802	0.802	0.802	0.802
1A	PROPOSED	1.08	3.47	0.181	0.124	0.169	0.195
2A	PROPOSED	0.40	0.59	0.839	0.839	0.855	0.859
3A	PROPOSED	3.66	2.19	0.856	0.856	0.856	0.856
4A	PROPOSED	6.94	14.38	0.454	0.518	0.649	0.818
5A	PROPOSED	1.43	0.86	0.802	0.802	0.802	0.802

TABLE 4 - 10 YEAR EVENT SUPPLY FOR ALL BASINS

BASIN I.D.	DESCRIPTION	AREA (ACRES)	DISCHARGE VOLUME (CFS)	6 HOUR (AC-FT)	24 HOUR (AC-FT)	4 DAY (AC-FT)	10 DAY (AC-FT)
1	EXISTING	1.68	3.25	0.804	0.804	0.804	0.804
2	EXISTING	0.88	0.53	0.873	0.873	0.873	0.873
3	EXISTING	3.66	7.46	0.138	0.138	0.138	0.138
4	EXISTING	6.94	24.08	0.735	0.888	1.101	1.351
5	EXISTING	1.43	1.83	0.828	0.828	0.828	0.828
1A	PROPOSED	1.08	5.85	0.173	0.237	0.267	0.325
2A	PROPOSED	0.40	1.67	0.858	0.858	0.858	0.858
3A	PROPOSED	3.66	7.46	0.138	0.138	0.138	0.138
4A	PROPOSED	6.94	24.08	0.735	0.888	1.101	1.351
5A	PROPOSED	1.43	1.83	0.828	0.828	0.828	0.828


TABLE 5 - 100 YEAR EVENT SUPPLY FOR ALL BASINS

BASIN I.D.	DESCRIPTION	AREA (ACRES)	DISCHARGE VOLUME (CFS)	6 HOUR (AC-FT)	24 HOUR (AC-FT)	4 DAY (AC-FT)	10 DAY (AC-FT)
1	EXISTING	1.68	5.81	0.138	0.138	0.138	0.138
2	EXISTING	0.88	1.66	0.878	0.878	0.878	0.878
3	EXISTING	3.66	12.61	0.284	0.284	0.284	0.284
4	EXISTING	6.94	35.81	1.183	1.397	1.718	2.097
5	EXISTING	1.43	2.68	0.829	0.829	0.829	0.829
1A	PROPOSED	1.08	8.69	0.206	0.297	0.416	0.582
2A	PROPOSED	0.40	2.49	0.882	0.882	0.882	0.882
3A	PROPOSED	3.66	12.61	0.284	0.284	0.284	0.284
4A	PROPOSED	6.94	35.81	1.183	1.397	1.718	2.097
5A	PROPOSED	1.43	2.68	0.829	0.829	0.829	0.829


SOILS INFORMATION FROM SOIL SURVEY U.S.D.A., S.C.S.

SOIL SERIES AND MAP SYMBOLS	DEGREE AND KIND OF LIMITATIONS FOR						SUITABILITY AS SOURCE OF —				SOIL FEATURES AFFECTING—		HYDROLOGIC SOIL GROUP
	SEPTIC TANK ABSORPTION FIELDS	SEWAGE LAGOONS	SHALLOW EXCAVATIONS	DWELLINGS WITHOUT BASEMENTS	SANITARY LANDFILL (TRENCH TYPE)	LOCAL ROAD AND STREETS	ROAD FILL	SAND	GRAVEL	TOPSOIL	POND RESERVOIR AREAS	DIKES, LEVEES, AND OTHER EMBANKMENTS	
Embudo: EmB, Etc	Slight	Severe: seepage.	Moderate: small stones.	Slight	Severe: seepage.	Slight	Good	Poor: excess fines.	Poor: excess fines.	Poor: small stones.	Seepage	Piping; compressible	B
Wink: WaB, WeB, WM	Slight	Severe: seepage.	Slight	Slight	Severe: seepage.	Slight	Fair: low strength.	Unsuited	Unsuited	Good	Seepage	Piping; erodes easily.	B


VICINITY MAP ZONE ATLAS MAP NO.

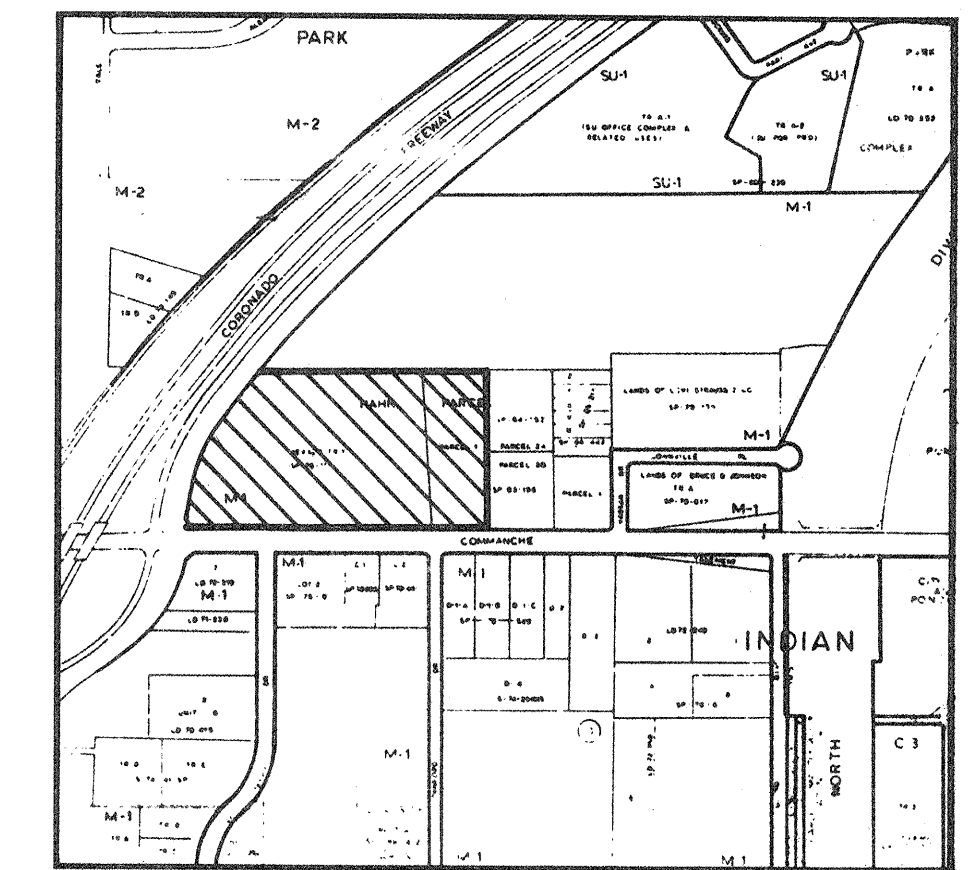

FLOOD HAZARD MAP & OFF-SITE FLOWS FROM F.E.M.A.

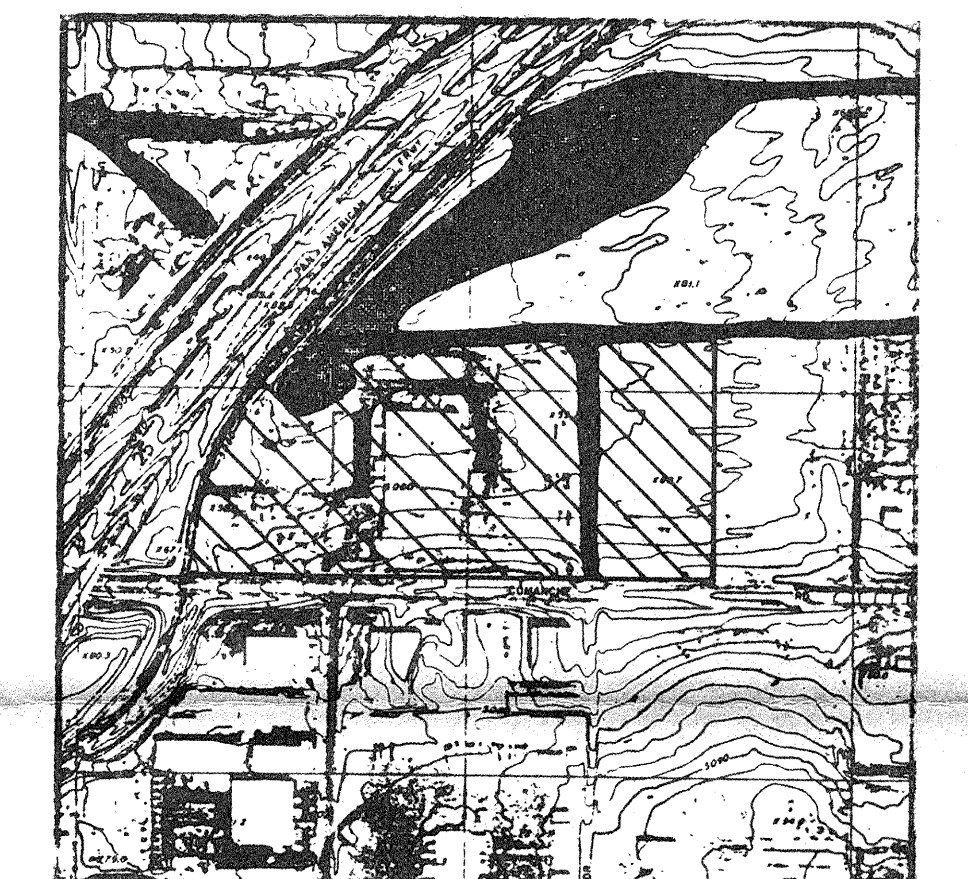


SOILS MAP SOIL SURVEY U.S.D.A., S.C.S.

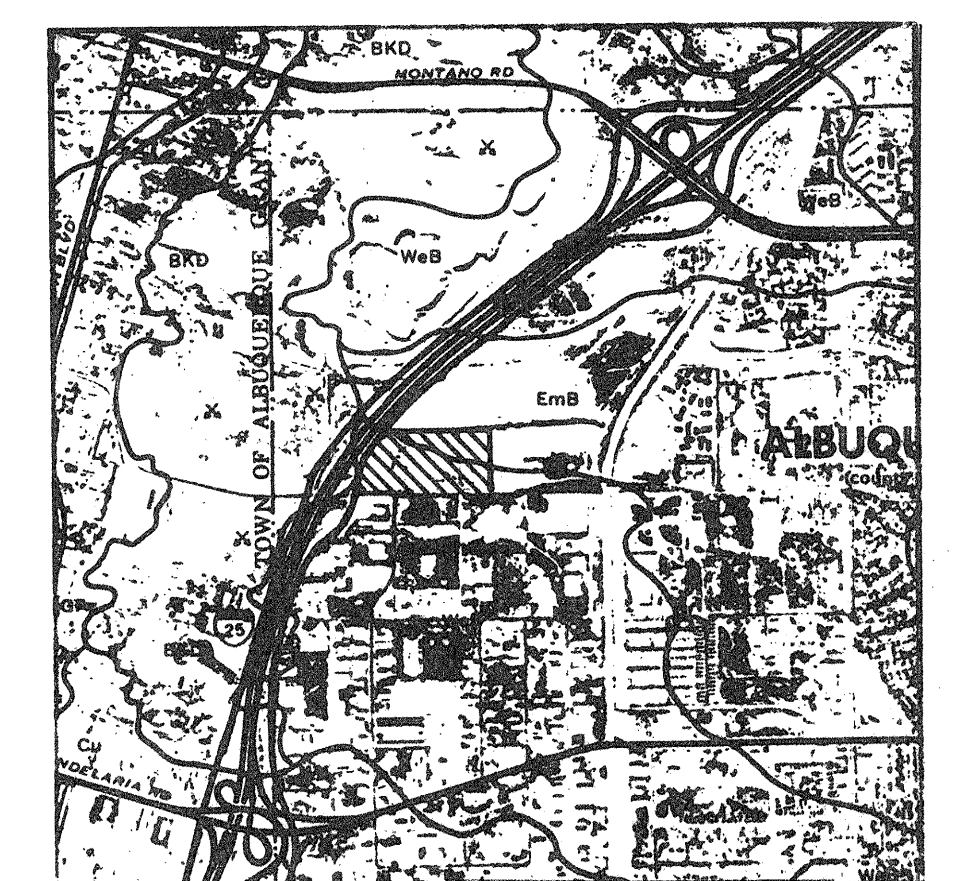

NO. _____ REVISIONS _____ DIVISION _____ BY _____ DATE _____

UPS GRADING, DRAINAGE & PAVING IMPROVEMENTS

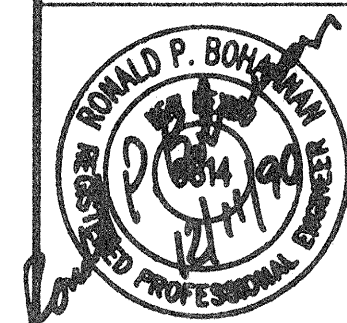

EASTERLING & ASSOCIATES, INC.
CONSULTING ENGINEERS


5643 Paradise Blvd. N.W.
Albuquerque, New Mexico 87114

Designed: DLS Drawn: MES Checked: RPB Sheet 2
Job No: 2852 Date: DEC. 1990 of 2

I HEREBY CERTIFY THAT I AM A REGISTERED PROFESSIONAL ENGINEER, THAT I HAVE INSPECTED THE SITE, AND THAT THE IMPROVEMENTS HAVE BEEN CONSTRUCTED IN ACCORDANCE WITH THE APPROVED PLANS WITH MINOR REVISIONS AS NOTED ON THESE AS-CONSTRUCTED PLANS.

Ronald P. Bohannon
R.P. BOHANNAN, P.E.
N.M.P.E. NO. 9814

DATE: 3/26/91

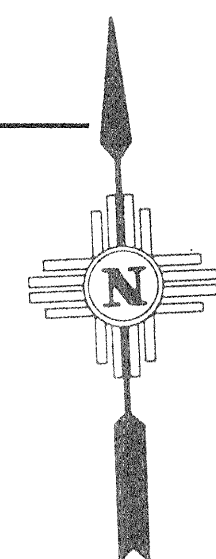

Scale 1" = 40' Feet

CONSTRUCT BERM IMPROVEMENTS
SEE DETAIL ON SHEET 2 FOR
IMPROVEMENTS IN THIS AREA

EXISTING OUTLET STRUCTURES

I-25 EAST FRONTAGE ROAD

AREA 5
(EXISTING POND)

EXISTING RETENTION /
DETENTION POND

AREA 4
(EXISTING ASPHALT)

EXISTING

BUILDING

AREA 3

CONSTRUCTED CONCRETE CURB
CONSTRUCT EXTRUDED
ASPHALT CURB

CONSTRUCT 3" GRAVEL SURFACE

LAYOUT AND STRIPE
TRUCK PARKING STALLS
PER UPS PLAN &
SPECIFICATIONS

CONSTRUCT 3" ASPHALT PAVING
WITHIN AREA 1 (ASPHALT)
APPROX. 7450 S.Y.

TBM
TOP OF GAS
ISLAND 5060.75

EXIST. EDGE
OF PVMT

SAWCUT HEADER CURB 4' WIDE
AND DOWN TO PROPOSED GRADE
PROPOSED INV. = 59.09

CONSTRUCT 6' WIDE
CONC. SWALE SEE
DETAIL THIS SHEET

REMOVE & DISPOSE OF
EXIST. FRENCH DRAIN.
BACKFILL W/ CLEAN
FILL COMPACTED TO 95%
ASTM D-1557

ADDITIONAL
PAVING

GUARD STATION

CONSTRUCT 2" ASPHALT PAVING
WITHIN AREA 2 (ASPHALT)
APPROX. 2290 S.Y.

ADDITIONAL
PAVING

COMMANCHE

BLVD.

APPROPRIATE SITE DRAINAGE DISCHARGE POINTS TO THE
PROPOSED SAD 216 DRAINAGE IMPROVEMENTS WILL
BE DETERMINED DURING FINAL DESIGN OF SAD
DRAINAGE IMPROVEMENTS. THE FINAL APPROVAL OF THE
CONNECTION TO THE SAD STORM DRAIN WILL BE FROM
THE CITY ENGINEER'S OFFICE (HYDROLOGY DIV) AND FROM
THE SAD ENGINEER.

VOLUME CALCULATIONS

Q100 (6HR) RUNOFF VOLUME EXISTING CONDITION = 73,503 CF
Q100 (6HR) RUNOFF VOLUME WITH PROPOSED
ADDITIONAL PAVING = 81,997 CF

EXISTING POND VOLUME
DETENTION (ABOVE OUTLET WEIR ELEV (5050.85) = 57,002 CF
RETENTION (BELOW OUTLET WEIR ELEV (5050.85) = 26,858 CF

TOTAL 83,860 CF

PROJECT: UPS
JOB NO. 2852 BY DLS DATE 12-12-90 CHECKED BY EPD DATE 12-12-90

		SCALE		FACTOR	
ELEVATION	IN ²	FT ²	FT ³	INDIVIDUAL ACRE FEET	CUMULATIVE ACRE FEET
5048.65	0	0	0	.022	.022
5049.00	3.5	5,600	18,000	.230	.252
5050.0	9.0	14,400	43,200	.429	.681
5051.0	14.35	22,960	68,880	.576	1.257
5052.0	17.0	27,200	81,600	.669	1.926
5053.0	19.40	31,040	93,120		(3,897cf)

NOTES:

1. Refer to sheet 2 for pavement sections.
2. Trim (sawcut) and remove and dispose of approximately 1' of existing asphalt at all existing pavement edges abutting proposed paving. Tack edge for new paving connection.
3. This plan does not show all existing improvements and utilities. Contractor shall locate and prevent damage to existing improvements and utilities.
4. For compaction purposes, site soils are considered cohesive.
5. Refer to legend sheet 2 of 2.

Approval of this interim drainage plan is based on the understanding that ultimate drainage improvements will be designed and constructed with SAD 216. If the SAD does not occur prior to future expansion, additional drainage improvements may be required.

APPROVAL: PAVING PERMIT

Frank J. Goyette 12/14/90
Date

LEGAL DESCRIPTION: LANDS OF MEXALB CORPORATION (PLATS C19-171 & D7-22)

BENCHMARK INFORMATION: WEST FRONTAGE ROAD OF I-25 .5 MILES SOUTH OF MONTANO ROAD. NM SHC STA. I-25-20 ELEV= 5079.46

RECEIVED		MAR 27 1991	
HYDROLOGY DIVISION			
NO.	REVISIONS	BY	DATE
UPS GRADING, DRAINAGE & PAVING IMPROVEMENTS			
EASTERLING & ASSOCIATES, INC. CONSULTING ENGINEERS 5643 Paradise Blvd. N.W. Albuquerque, New Mexico 87114			
Designed: DLS	Drawn: MES	Checked: RPB	Sheet 1
Job No: 2852	Date: DEC., 1990	of	2


LEGEND

DESCRIPTION	NEW	EXISTING
CONTOURS	5094	5094
SPOT ELEVATIONS	5088	5088
DRAINAGE AREA BOUNDARY		
DRAINAGE DIVIDE		
WATER BLOCK		
DIRECTION OF FLOW		
ASPHALT PAVING	ASPHALT	ASPHALT
LANDSCAPING	L.S.	L.S.
RETAINING WALL		
GARDEN WALL		
SWALE		
PROPERTY LINE		
FENCE		
CATCH BASIN		
STORM DRAIN M.H. & LINE	36" SD	36" SD
SANITARY SEWER M.H. & LINE	8" SAS	8" SAS
FIRE HYDRANT & WATER LINE	6" W	6" W
REDUCERS		
WATER VALVES	GATE BUTTERFLY	GATE BUTTERFLY
WATER CONNECTIONS		
WATER JOINTS		
CONCRETE		
GAS LINE		
UNDERGROUND TELEPHONE	UT	UT
CABLE TELEVISION	CT	CT
POWER/TELEPHONE POLE	O.P.P.	O.P.P.
UNDERGROUND ELECTRICAL	UE	UE
CURB ELEVATION	TC 5088.28 FL 5087.78	TC 5088.28 FL 5087.78
HYDROLOGICAL ANALYSIS PT.		
DETAIL REFERENCE		
KEYED NOTES		
C.O.A. DETAIL REFERENCE		
CURVE OR COORDINATE REFERENCE INFO.		
PHASE BOUNDARY		

GENERAL NOTES FOR GRADING AND DRAINAGE

- AN EXCAVATION/CONSTRUCTION PERMIT MAY BE REQUIRED BEFORE BEGINNING ANY WORK WITHIN CITY RIGHT-OF-WAY. AN APPROVED COPY OF THESE PLANS MUST BE SUBMITTED AT THE TIME OF APPLICATION FOR THIS PERMIT.
- ALL WORK DETAILED ON THESE PLANS, EXCEPT AS OTHERWISE STATED OR PROVIDED HEREON, SHALL BE CONSTRUCTED IN ACCORDANCE WITH UPS PROJECT SPECIFICATIONS.
- TWO WORKING DAYS PRIOR TO ANY EXCAVATION, CONTRACTOR MUST CONTACT LINE LOCATING SERVICE, 260-1990, FOR LOCATION OF EXISTING UTILITIES.
- PRIOR TO CONSTRUCTION, THE CONTRACTOR SHALL EXCAVATE AND VERIFY THE HORIZONTAL AND VERTICAL LOCATIONS OF ALL OBSTRUCTIONS. SHOULD A CONFLICT EXIST, THE CONTRACTOR SHALL NOTIFY THE ENGINEER SO THE CONFLICT CAN BE RESOLVED WITH A MINIMUM AMOUNT OF DELAY.
- BACKFILL COMPACTION SHALL BE 95% ASTM 1557.
- ALL UTILITIES AND UTILITY SERVICE LINES SHALL BE INSTALLED PRIOR TO PAVING.
- DISPOSAL OF ALL WASTE MATERIAL SHALL BE THE RESPONSIBILITY OF THE CONTRACTOR.
- OWNERSHIP OF DOCUMENTS:** THIS DOCUMENT, AND THE IDEAS AND DESIGNS INCORPORATED HEREIN, AS AN INSTRUMENT OF PROFESSIONAL SERVICE, IS THE PROPERTY OF EASTERLING & ASSOCIATES, INC. AND IS NOT TO BE USED, IN WHOLE OR IN PART, FOR ANY OTHER PROJECT WITHOUT THE WRITTEN AUTHORIZATION OF EASTERLING & ASSOCIATES, INC.
- CONSTRUCTION SAFETY:** THESE DRAWINGS DO NOT INCLUDE NECESSARY COMPONENTS FOR CONSTRUCTION SAFETY WHICH SHALL REMAIN THE CONTRACTOR'S RESPONSIBILITY.
- EROSION CONTROL:** THE SITE WILL BE FULLY DEVELOPED IMMEDIATELY. EROSION PROBLEMS GENERATED BY PHASED DEVELOPMENT WILL NOT, THEREFORE, BE A PROBLEM.
- CONSTRUCTION PHASE:** THE CONTRACTOR SHALL EXERCISE REASONABLE CARE DURING CONSTRUCTION TO PREVENT THE MOVEMENT OF SEDIMENT FROM THE SITE INTO THE STREET. LOOSE SOIL STOCKPILES IN THE STREET DURING UTILITY CONNECTION ACTIVITIES SHALL BE PROTECTED FROM BEING CARRIED DOWNSTREAM BY FLOWING WATER IN THE STREET.


AREA 1

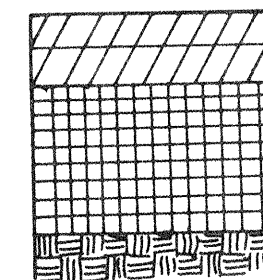

3" PLANT MIX BITUMINOUS PVM'T (PMBP)
TYPE I GRADE B (TWO 1-1/2" COURSES)

8" COMPACTED SUBGRADE (95% ASTM D-1557, WITH
MOISTURE CONTENT OPTIMUM \pm 2%)


AREA 2

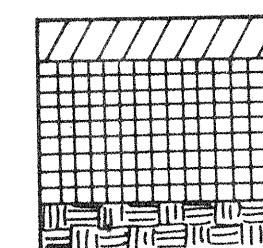

2" PMBP TYPE I GRADE B
(ONE 2" COURSE)

8" COMPACTED SUBGRADE (95% ASTM D-1557, WITH
MOISTURE CONTENT OPTIMUM \pm 2%)


AREA 3

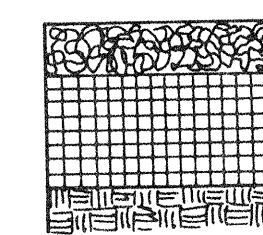


3" AGGREGATE BASE COURSE CLASS II-B
COMPACTED TO 95% ASTM D-1557

8" COMPACTED SUBGRADE (95% ASTM D-1557, WITH
MOISTURE CONTENT OPTIMUM \pm 2%)


VICINITY MAP ZONE ATLAS MAP NO.

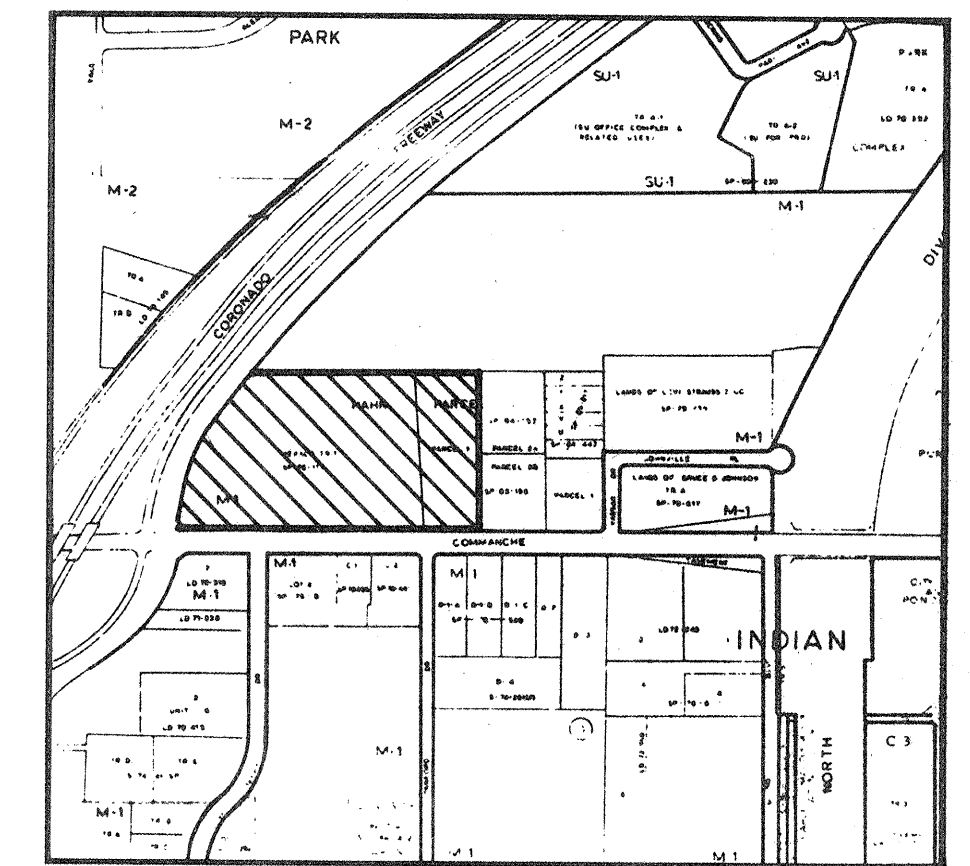

FLOOD HAZARD MAP & OFF-SITE FLOWS FROM F.E.M.A.

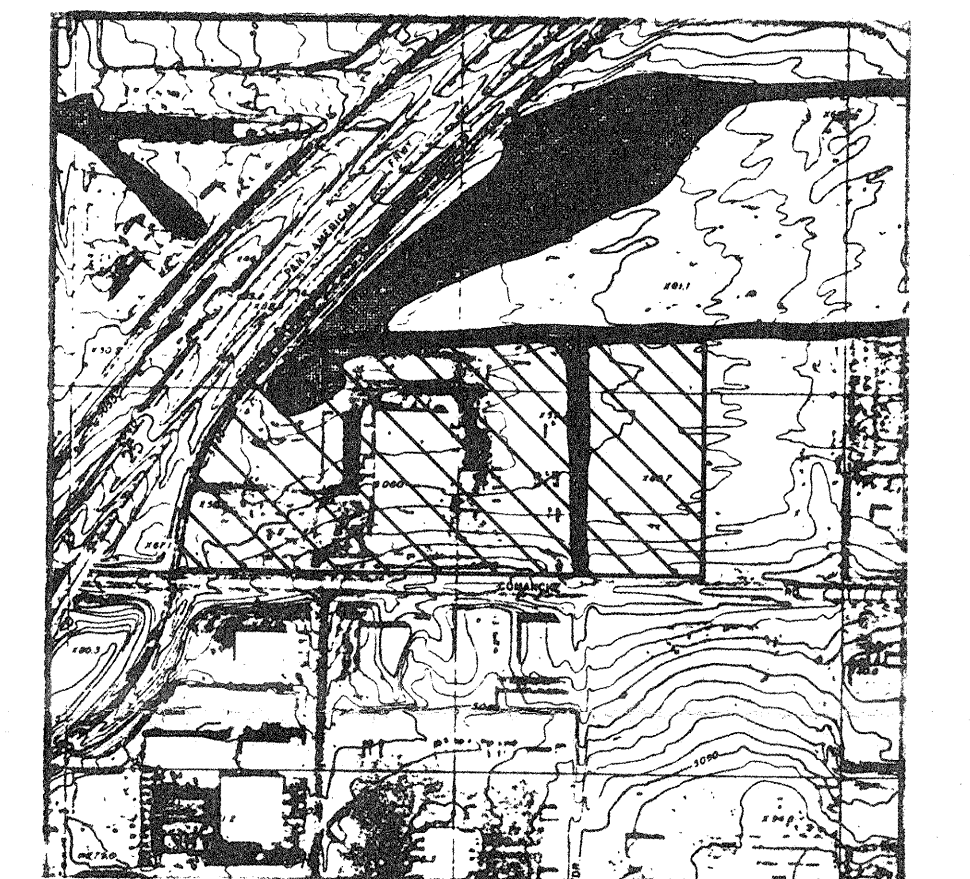

SOILS MAP SOIL SURVEY U.S.D.A., S.C.S.

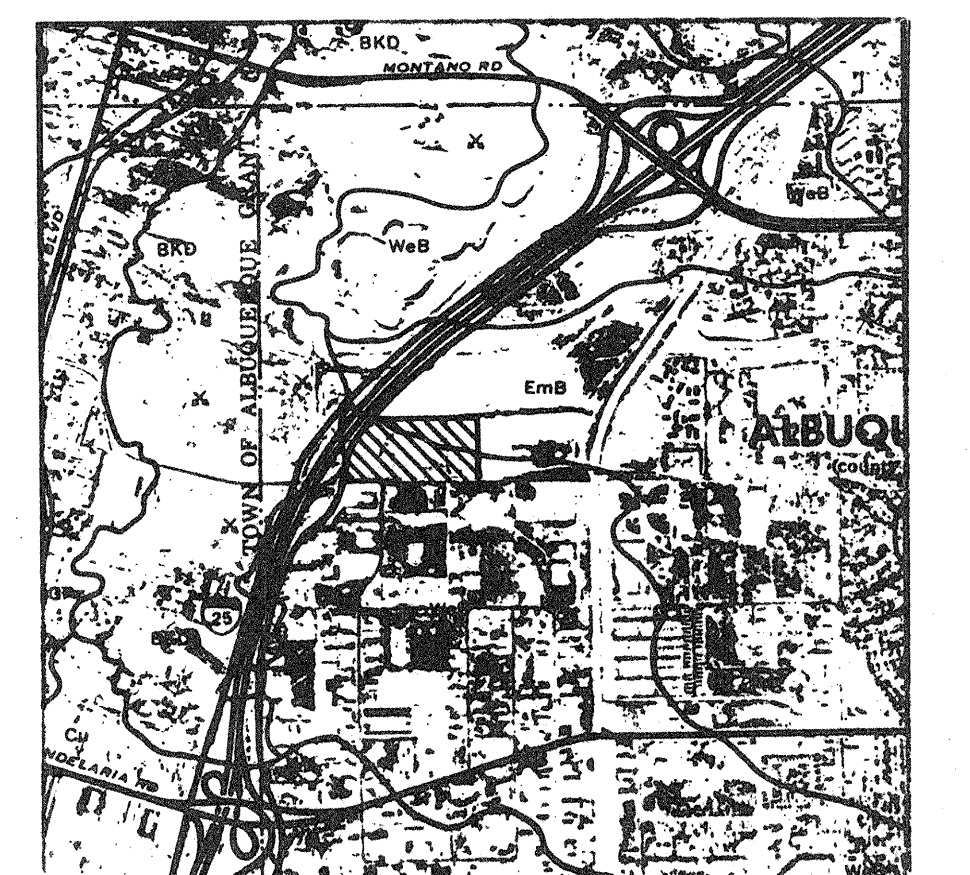


I HEREBY CERTIFY THAT I AM A REGISTERED PROFESSIONAL ENGINEER, THAT I HAVE INSPECTED THE SITE, AND THAT THE IMPROVEMENTS HAVE BEEN CONSTRUCTED IN ACCORDANCE WITH THE APPROVED PLANS WITH MINOR REVISIONS AS NOTED ON THESE AS-CONSTRUCTED PLANS.



R.P. BOHANNAN, P.E.
N.M.P.E. NO. 9814

DATE: 3/26/91

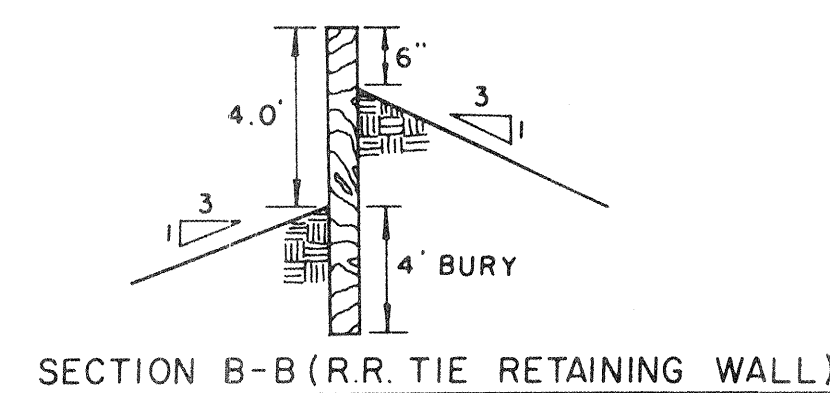

HYDROLOGY

TABLE 1 - RAINFALL DEPTHS (INCHES) FOR TIME

DURATION	100 YEAR	50 YEAR	25 YEAR	10 YEAR	5 YEAR	2 YEAR
1 HOUR	2.81	1.81	1.61	1.34	1.14	0.87
6 HOUR	2.35	1.12	1.08	1.15	1.35	1.87
24 HOUR	2.75	2.48	2.28	1.83	1.56	1.19
4 DAY	3.38	2.97	2.64	2.28	1.87	1.43
18 DAY	3.35	3.56	3.16	2.63	2.24	1.71

BASIN I.D.	DESCRIPTION	AREA (ACRES)	LAND TREATMENT CLASSIFICATION (% OF TOTAL)			
			A	B	C	D
1	EXISTING	1.68	0.0%	0.0%	100.0%	0.0%
2	EXISTING	0.40	0.0%	0.0%	100.0%	0.0%
3	EXISTING	3.66	0.0%	0.0%	100.0%	0.0%
4	EXISTING	6.54	0.0%	0.0%	100.0%	0.0%
5	EXISTING	1.43	100.0%	0.0%	0.0%	0.0%
1A	PROPOSED	1.68	0.0%	0.0%	100.0%	0.0%
2A	PROPOSED	0.40	0.0%	0.0%	100.0%	0.0%
3A	PROPOSED	3.66	0.0%	0.0%	100.0%	0.0%
4A	PROPOSED	6.54	0.0%	0.0%	100.0%	0.0%
5A	PROPOSED	1.43	100.0%	0.0%	0.0%	0.0%

TABLE 8 - 2 YEAR EVENT SUMMARY FOR ALL BASINS

BASIN	DESCRIPTION	AREA (ACRES)	PEAK DISCHARGE (CFS)	6 HOUR (AC-F1)	24 HOUR (AC-F1)	4 DAY (AC-F1)	18 DAY (AC-F1)
1	EXISTING	1.68	1.81	0.809	0.809	0.809	0.809
2	EXISTING	0.40	0.823	0.37	0.37	0.37	0.37
3	EXISTING	3.66	2.19	0.836	0.836	0.836	0.836
4	EXISTING	6.54	14.38	0.414	0.5168	0.5549	0.5161
5	EXISTING	1.43	0.86	0.802	0.802	0.802	0.802
1A	PROPOSED	1.68	3.47	0.181	0.1254	0.1589	0.1385
2A	PROPOSED	0.40	0.59	0.829	0.829	0.829	0.829
3A	PROPOSED	3.66	2.19	0.836	0.836	0.836	0.836
4A	PROPOSED	6.54	14.38	0.414	0.5168	0.5549	0.5161
5A	PROPOSED	1.43	0.86	0.802	0.802	0.802	0.802

TABLE 9 - 10 YEAR EVENT SUMMARY FOR ALL BASINS

BASIN	DESCRIPTION	AREA (ACRES)	PEAK DISCHARGE (CFS)	6 HOUR (AC-F1)	24 HOUR (AC-F1)	4 DAY (AC-F1)	18 DAY (AC-F1)
1	EXISTING	1.68	3.25	0.804	0.804	0.804	0.804
2	EXISTING	0.40	0.823	0.37	0.37	0.37	0.37
3	EXISTING	3.66	7.46	0.1318	0.1318	0.1318	0.1318
4	EXISTING	6.54	21.80	0.735	0.8880	1.1818	1.3518
5	EXISTING	1.43	1.43	0.828	0.828	0.828	0.828
1A	PROPOSED	1.68	5.85	0.1783	0.2157	0.2672	0.3281
2A	PROPOSED	0.40	1.67	0.818	0.818	0.818	0.818
3A	PROPOSED	3.66	7.46	0.1318	0.1318	0.1318	0.1318
4A	PROPOSED	6.54	21.80	0.735	0.8880	1.1818	1.3518
5A	PROPOSED	1.43	1.43	0.828	0.828	0.828	0.828

TABLE 10 - 100 YEAR EVENT SUMMARY FOR ALL BASINS

BASIN	DESCRIPTION	AREA (ACRES)	PEAK DISCHARGE (CFS)	6 HOUR (AC-F1)	24 HOUR (AC-F1)	4 DAY (AC-F1)	18 DAY (AC-F1)
1	EXISTING	1.68	5.85	0.1320	0.1320	0.1320	0.1320
2	EXISTING	0.40	1.66	0.828	0.828	0.828	0.828
3	EXISTING	3.66	12.61	0.284	0.284	0.284	0.284
4	EXISTING	6.54	35.81	1.1683	1.797	1.7178	2.8927
5	EXISTING	1.43	2.68	0.829	0.829	0.829	0.829
1A	PROPOSED	1.68	6.69	0.286	0.3297	0.4169	0.5482
2A	PROPOSED	0.40	2.40	0.802	0.802	0.802	0.802
3A	PROPOSED	3.66	12.61	0.284	0.284	0.284	0.284
4A	PROPOSED	6.54	35.81	1.1683	1.797	1.7178	2.8927
5A	PROPOSED	1.43	2.68	0.829	0.829	0.829	0.829

SOILS INFORMATION FROM SOIL SURVEY U.S.D.A., S.C.S.

SOIL SERIES AND MAP SYMBOLS	DEGREE AND KIND OF LIMITATIONS FOR						SUITABILITY AS SOURCE OF —				SOIL FEATURES AFFECTING—		HYDROLOGIC SOIL GROUP
	SEPTIC TANK ABSORPTION FIELDS	SEWAGE LAGOONS	SHALLOW EXCAVATIONS	DWELLINGS WITHOUT BASEMENTS	SANITARY LANDFILL (TRENCH TYPE)	LOCAL ROAD AND STREETS	ROAD FILL	SAND	GRAVEL	TOPSOIL	POND RESERVOIR AREAS	DIKES, LEVEES, AND OTHER EMBANKMENTS	
Embudo: Em B, EIC	Slight	Severe: seepage.	Moderate: small stones.	Slight	Severe: seepage.	Slight	Good	Poor: excess fines.	Poor: excess fines.	Poor: small stones.	Seepage	Piping; compressible	B
Wink: Wa B, We B, WM	Slight	Severe: seepage.	Slight	Slight	Severe: seepage.	Slight	Fair: low strength.	Unsuited	Unsuited	Good	Seepage	Piping; erodes easily.	B

UPS GRADING, DRAINAGE & PAVING IMPROVEMENTS

EASTERLING & ASSOCIATES, INC.
CONSULTING ENGINEERS

5643 Paradise Blvd. N.W.
Albuquerque, New Mexico 87114

Designed: DLS Drawn: MES Checked: RPB Sheet: 2
Job No: 2852 Date: DEC., 1990 of: 2