

CITY OF ALBUQUERQUE

DRAINAGE FACILITIES WITHIN CITY RIGHT-OF-WAY (S.O. 19)

NOTICE TO CONTRACTORS

1. AN EXCAVATION/CONSTRUCTION PERMIT WILL BE REQUIRED BEFORE BEGINNING ANY WORK WITHIN CITY RIGHT-OF-WAY. AN APPROVED COPY OF THESE PLANS MUST BE SUBMITTED AT THE TIME OF APPLICATION FOR THIS PERMIT.
2. ALL WORK DETAILED ON THIS PLAN TO BE PERFORMED UNDER CONTRACT, EXCEPT AS OTHERWISE STATED OR PROVIDED FOR HEREIN, SHALL BE CONSTRUCTED IN ACCORDANCE WITH STANDARD SPECIFICATIONS FOR PUBLIC WORKS CONSTRUCTION, 1986, AS UPDATED THROUGH REVISION NO. 6.
3. TWO (2) WORKING DAYS PRIOR TO ANY EXCAVATION, CONTRACTOR MUST CONTACT NEW MEXICO ONE CALL SYSTEM, INC., 260-1990, FOR LOCATION FOR EXISTING UTILITIES.
4. PRIOR TO CONSTRUCTION, THE CONTRACTOR SHALL EXCAVATE AND VERIFY THE HORIZONTAL AND VERTICAL LOCATIONS OF ALL OBSTRUCTIONS. SHOULD A CONFLICT EXIST, THE CONTRACTOR SHALL NOTIFY THE ENGINEER SO THAT THE CONFLICT CAN BE RESOLVED WITH A MINIMUM AMOUNT OF DELAY.
5. BACKFILL COMPACTION SHALL BE ACCORDING TO TRAFFIC/STREET USE.
6. MAINTENANCE OF THESE FACILITIES SHALL BE THE RESPONSIBILITY OF THE OWNER OF THE PROPERTY SERVED.
7. WORK ON ARTERIAL STREETS SHALL BE PERFORMED ON A 24-HOUR BASIS.

APPROVAL FOR SW CULVERTS	NAME	DATE
INSPECTOR:		

GRADING PLAN LEGEND:

EXISTING	NEW	DESCRIPTION
5284	84	CONTOUR
84.00	84.00	SPOT ELEVATION
		PROPERTY LINE
		SWALE
		SHEET FLOW
		ROOF FLOW
		DOWN SPOUT

TOPOG SURVEY LEGEND:

BOC = BACK OF CURB	ER = EDGE OF ROAD
CC = CURB CUT	FINFLR = FINISH FLOOR
DI = DRAINAGE INLET	FL = FLOW LINE
EA = EDGE OF ASPHALT	FND = FOUND
EC = EDGE OF CONCRETE	FP = FENCE POST
EL = ELEVATION	G = GROUND
EDW = EDGE OF WALL	INV = INVERT

TOPOGRAPHIC SURVEY GENERAL NOTES :

1. CONTOUR INTERVAL IS ONE (1) FOOT.
2. ELEVATIONS ARE BASED ON CITY OF ALBUQUERQUE STATION No. "11-H16", HAVING AN ELEVATION OF 5097.88
3. UTILITIES SHOWN HEREON ARE IN THEIR APPROXIMATE LOCATION BASED ONLY ON ABOVE GROUND EVIDENCE FOUND IN THE FIELD AND AS-BUILT INFORMATION PROVIDED BY THE CLIENT. UTILITIES SHOWN HEREON, WHETHER INDICATED AS ABANDONED OR NOT, SHALL BE VERIFIED BY OTHERS FOR EXACT LOCATION AND/OR DEPTH PRIOR TO EXCAVATION OR DESIGN CONSIDERATIONS.
5. THIS IS NOT A BOUNDARY SURVEY. BEARINGS AND DISTANCES SHOWN HEREON ARE FOR REFERENCE ONLY.



EROSION CONTROL NOTES:

THE CONTRACTOR SHALL BE RESPONSIBLE FOR COMPLIANCE WITH THE FOLLOWING:

1. NO SEDIMENT-BEARING WATER SHALL BE ALLOWED TO DISCHARGE FROM THE SITE DURING CONSTRUCTION.
2. DURING GRADING OPERATIONS AND UNTIL THE PROJECT HAS BEEN COMPLETED, ALL ADJACENT PROPERTY, RIGHTS-OF-WAY, AND EASEMENTS SHALL BE PROTECTED FROM FLOODING BY RUNOFF FROM THE SITE.
3. SHOULD THE CONTRACTOR FAIL TO PREVENT SEDIMENT-BEARING WATER FROM ENTERING PUBLIC RIGHT-OF-WAY, HE SHALL PROMPTLY REMOVE FROM THE PUBLIC RIGHT-OF-WAY ANY AND ALL SEDIMENT ORIGINATING FROM THE SITE.
4. CONTROL OF SEDIMENT-LADEN WATERS WILL BE ACCOMPLISHED BY USE OF A COMPACTED EARTH BERM OF ADEQUATE HEIGHT. THE BERM SHALL BE LOCATED ALONG THE DOWNSTREAM PERIMETER OF THE PROPERTY.

DRAINAGE CONSIDERATIONS:

EXISTING SITE CONDITIONS:

The site is located on the east side of Stanford Drive, NE, approximately half way between Candelaria Road and Aztec Drive. The site is developed as is the property to the north, east and south. There is one existing office/manufacturing building on the site as well as a small booth and existing asphalt pavement and concrete slabs. The original development had a hydrology submittal, G16-D34. These are on microfilm and are difficult to read. Copies have been ordered from Lason Inc. The project was constructed in the early 1980's. A detention pond was called for on the plans and is in place on the site. The pond outlet appears to be a 4" PVC pipe through the curb. Apparently, the pond detains water to a depth in excess of one foot. The limits of the pond encroach on the significant rain occurs.

EXISTING DRAINAGE BASIN CONDITIONS:

This light industrial area which lies between the North Diversion Channel and Interstate 25, and between Candelaria and Aztec, drains to Aztec and to Candelaria. The site is in the portion of the basin that drains to Aztec. The existence of detention ponding in the area was determined by a simple survey. This was accomplished by piecing together a composite of the on-line City of Albuquerque GIS 2004 aerial photo map of the area between Stanford and the North Diversion Channel and then driving Stanford, Vassar and Girard to locate any drainage pipes through curbs. Remarkably few were found. The above streets each have a high point that divides flow to Aztec or Candelaria. Only the area flowing to Aztec was considered. Only four pipes through curbs were found, including the property at 3312 Stanford NE. The composite map is submitted with this plan together with photos of the three detention areas besides this site. The photos show that, in those cases where detention was provided, only a token effort was made to reduce the peak discharge rate. The composite map shows the area to be fully developed, (i.e. no vacant lots) and the percentage of Treatment D is estimated to be near 90%.

PROPOSED SITE CONDITIONS:

It is proposed to construct an 80' x 53' metal building on the site as shown. The roof will be sloped to drain west into the parking lot. In view of the above analysis, it is proposed to discharge the site runoff directly into Stanford by means of a sidewalk culvert.

DRAINAGE CRITERIA:

The calculations shown on this plan were prepared in accordance with Section 22.2, Hydrology, of the Development Process Manual, Volume 2, Design Criteria, for the City of Albuquerque in cooperation with Bernalillo County, New Mexico and the Metropolitan Arroyo Flood Control Authority, January, 1993.

PRECIPITATION ZONE:

The site is between the Rio Grande River and San Mateo Boulevard. Therefore, it is within the limits of Precipitation Zone 2.

LAND TREATMENT AREAS, ETC.:

The peak discharge per acre and excess precipitation are shown for the four land treatments in Zone 2 in the table below, and the values shown are from the City of Albuquerque D.P.M. Also shown are the existing and proposed land treatment areas.

LAND TREAT.	q(cfs/oc)		E (in)		Existing Site Areas		Developed Site Areas	
	100-yr	10-yr	100-yr	10-yr	% Sq.Ft.	Acres	% Sq.Ft.	Acres
A	1.56	0.38	0.53	0.13	0	0.0000	0.0	0.0000
B	2.28	0.95	0.78	0.28	0	0.0000	9.7	1,953
C	3.14	1.71	1.13	0.52	43.6	8,710	0.2000	8.9
D	4.70	3.14	2.12	1.34	56.4	11,290	0.2591	81.4
Totals					100.0	20,000	0.4591	100.0

PEAK DISCHARGE:

EXISTING CONDITIONS:

$$Q_{100} = 0.2000 * 3.14 + 0.2591 * 4.70 = 1.85 \text{ cfs}$$

$$Q_{10} = 0.2000 * 1.71 + 0.2591 * 3.14 = 1.16 \text{ cfs}$$

DEVELOPED CONDITIONS:

$$Q_{100} = 0.0448 * 2.28 + 0.0407 * 3.14 + 0.3736 * 4.70 = 1.99 \text{ cfs}$$

$$Q_{10} = 0.0448 * 0.95 + 0.0407 * 1.71 + 0.3736 * 3.14 = 1.29 \text{ cfs}$$

VOLUME, 100-YEAR AND 10-YEAR, 6-HOUR:

EXISTING CONDITIONS:

$$V_{100} = (8,710 * 1.13 + 11,290 * 2.12) / 12 = 2,815 \text{ cf}$$

$$V_{10} = (8,710 * 0.52 + 11,290 * 1.34) / 12 = 1,638 \text{ cf}$$

DEVELOPED CONDITIONS:

$$V_{100} = (1,953 * 0.78 + 1,775 * 1.13 + 16,272 * 2.12) / 12 = 3,169 \text{ cf}$$

$$V_{10} = (1,953 * 0.28 + 1,775 * 0.52 + 16,272 * 1.34) / 12 = 1,939 \text{ cf}$$

SUMMARY OF ON-SITE VOLUMES AND DISCHARGE RATES:


	V100(CF)	V10(CF)	Q100(CFS)	Q10(CFS)
DEVELOPED	3,169	1,939	1.99	1.29
EXISTING	2,815	1,638	1.85	1.16
INCREASE	354	301	0.14	0.13

SIDEWALK CULVERT CAPACITY:

Use Weir Equation, $Q = CLH^{3/2}$ Design $Q = 1.99 \text{ cfs}$ $C = 2.65$ $L = 1.50$ $H = 0.67'$.
 $Q = 2.65 * 1.50 * 0.67^{3/2} = 2.18 \text{ cfs}$ $1.99 \text{ cfs} < 2.18 \text{ cfs}$ OK


DOWNSTREAM CAPACITY:

- The flow from this site enters Stanford Drive and flows north to Aztec Ave. It then flows west in Aztec Avenue to inlets at the intersection of the I-25 East Frontage Road. The portion of Aztec Ave. between Stanford and Princeton is very flat and therefore does not convey the volume of water that the section west of Princeton conveys. It is believed that allowing unrestricted discharge from this site will not cause increased depth in the critical section of Aztec Ave. for the following reasons:
1. The site is one of the smallest lots in the drainage basin.
 2. The site is relatively at the low end of the basin. Runoff from the site will be through the flat portion of Aztec Ave. before the peak flow occurs in that section.
 3. The site is an infill site. Future development will have to, in most cases, replace existing pavement or existing buildings.
 4. The peak discharge rate for this site very small in comparison with the entire portion of the basin draining to the flat portion of Aztec Ave.

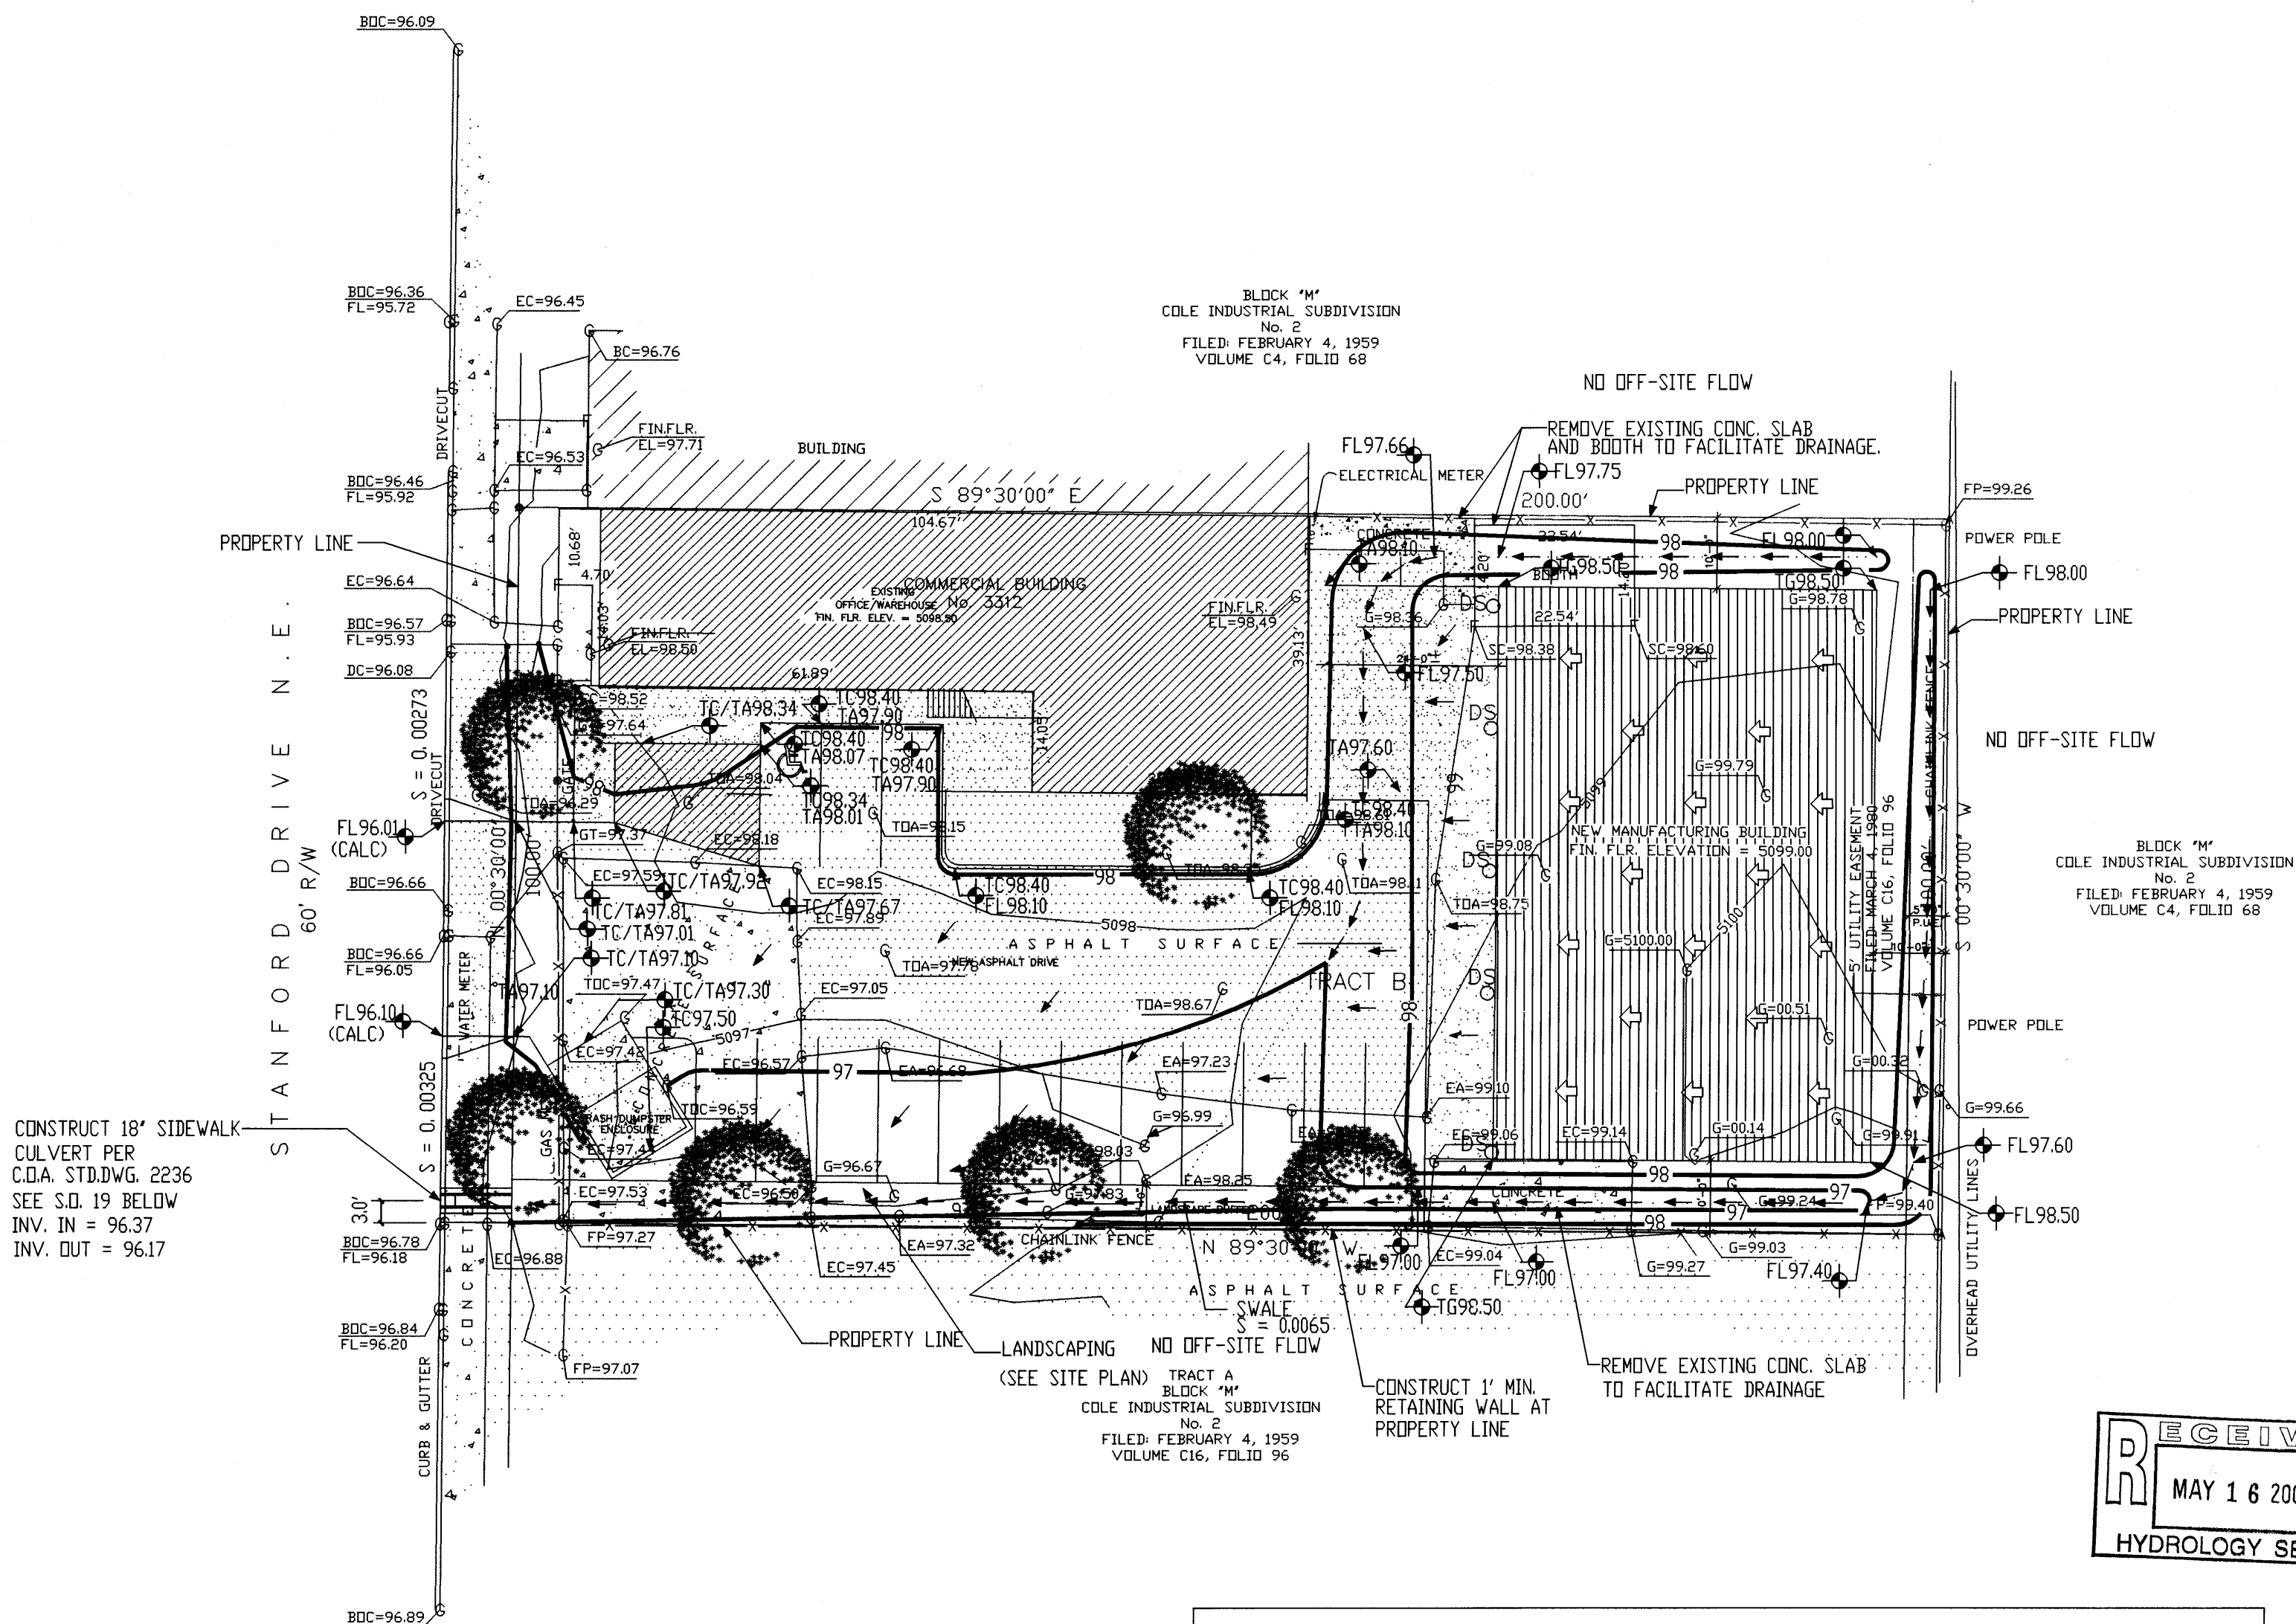

LEGAL DESCRIPTION

LOT 'B' OF THE NORTH 100 FEET OF THE WEST HALF OF BLOCK 'M' OF COLE'S INDUSTRIAL SUBDIVISION No. 2, IN THE CITY OF ALBUQUERQUE, N.M. AS SHOWN AND DESIGNATED ON THE AMENDED SUMMARY PLAT FILED IN THE OFFICE OF THE COUNTY CLERK OF BERNALILLO COUNTY, N.M. ON MARCH 4, 1980 IN PLAT BLOCK VOL. C16, FOLIO 96.

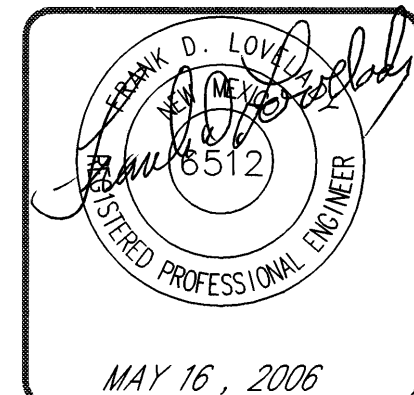


GRADING AND DRAINAGE PLAN

ARRAY TECHNOLOGIES INC.

3312 STANFORD DRIVE NE

ALBUQUERQUE, NEW MEXICO

FRANK D. LOVELADY, P.E.

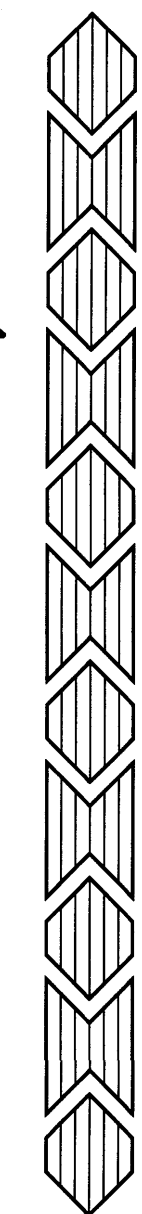

JOB NO: 699









DATE: May 16, 2006

REVISIONS

SHEET NO.

1 OF 1

HYDROLOGICAL SECTION
MAY 16 2006
D E G E I V E

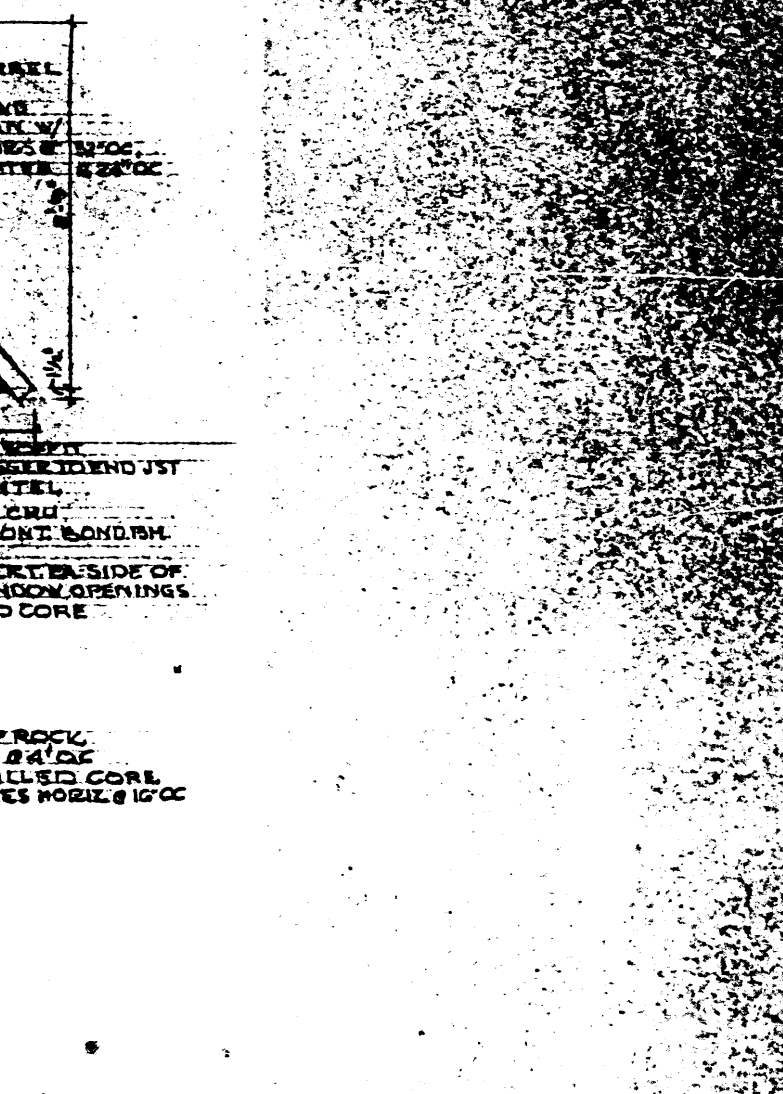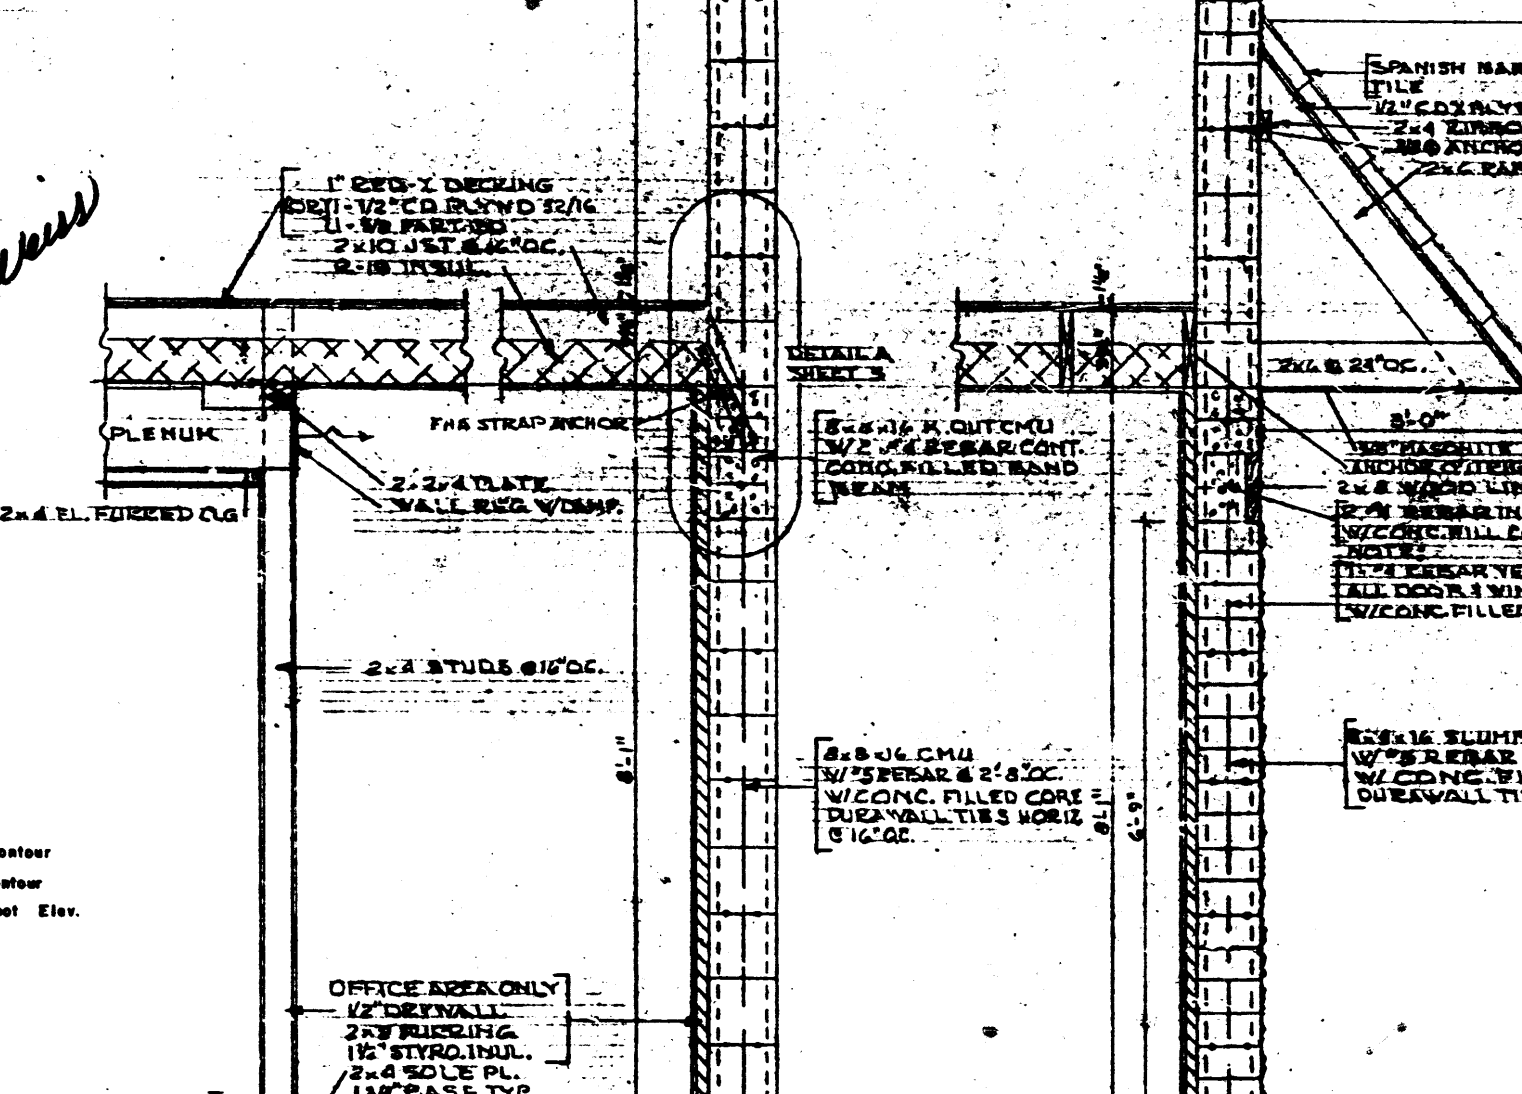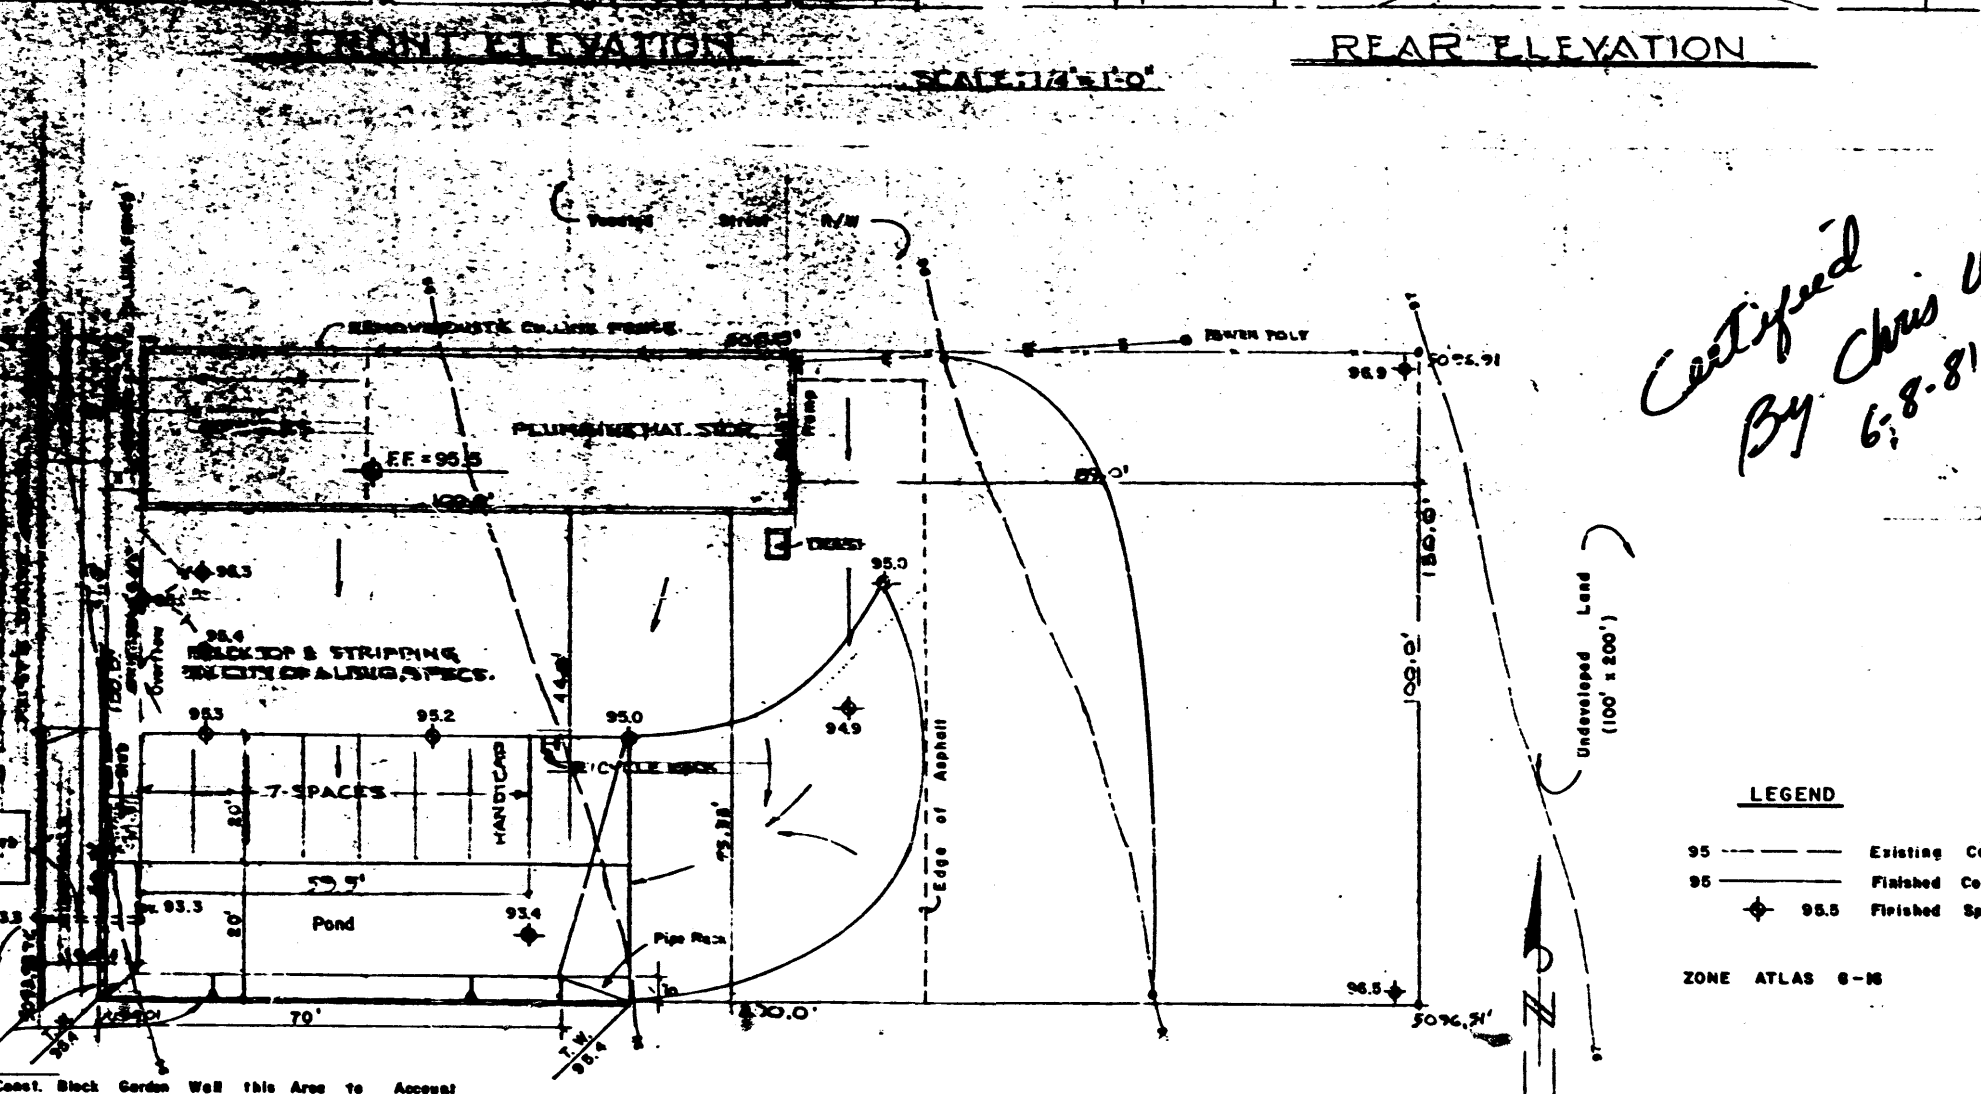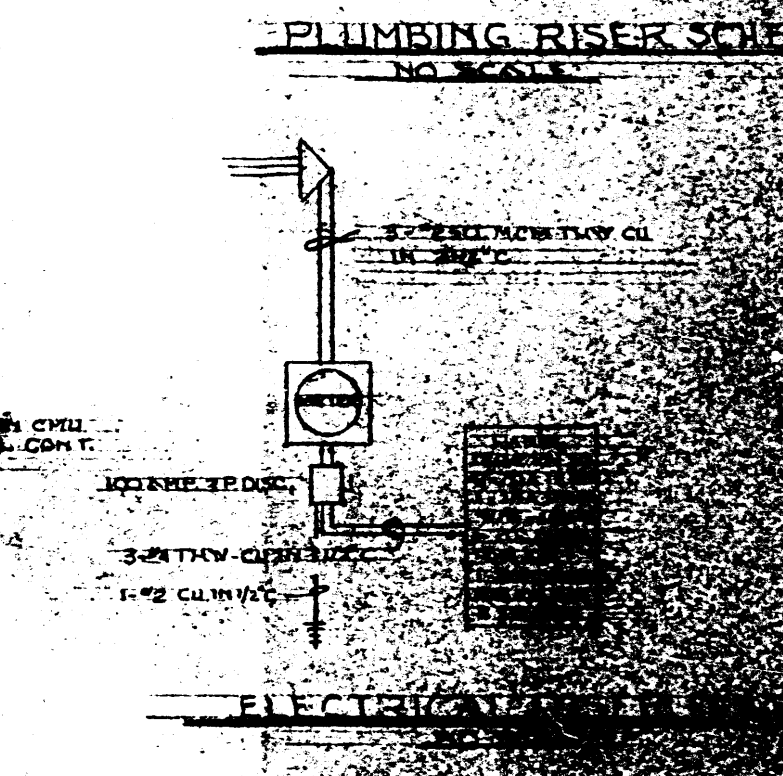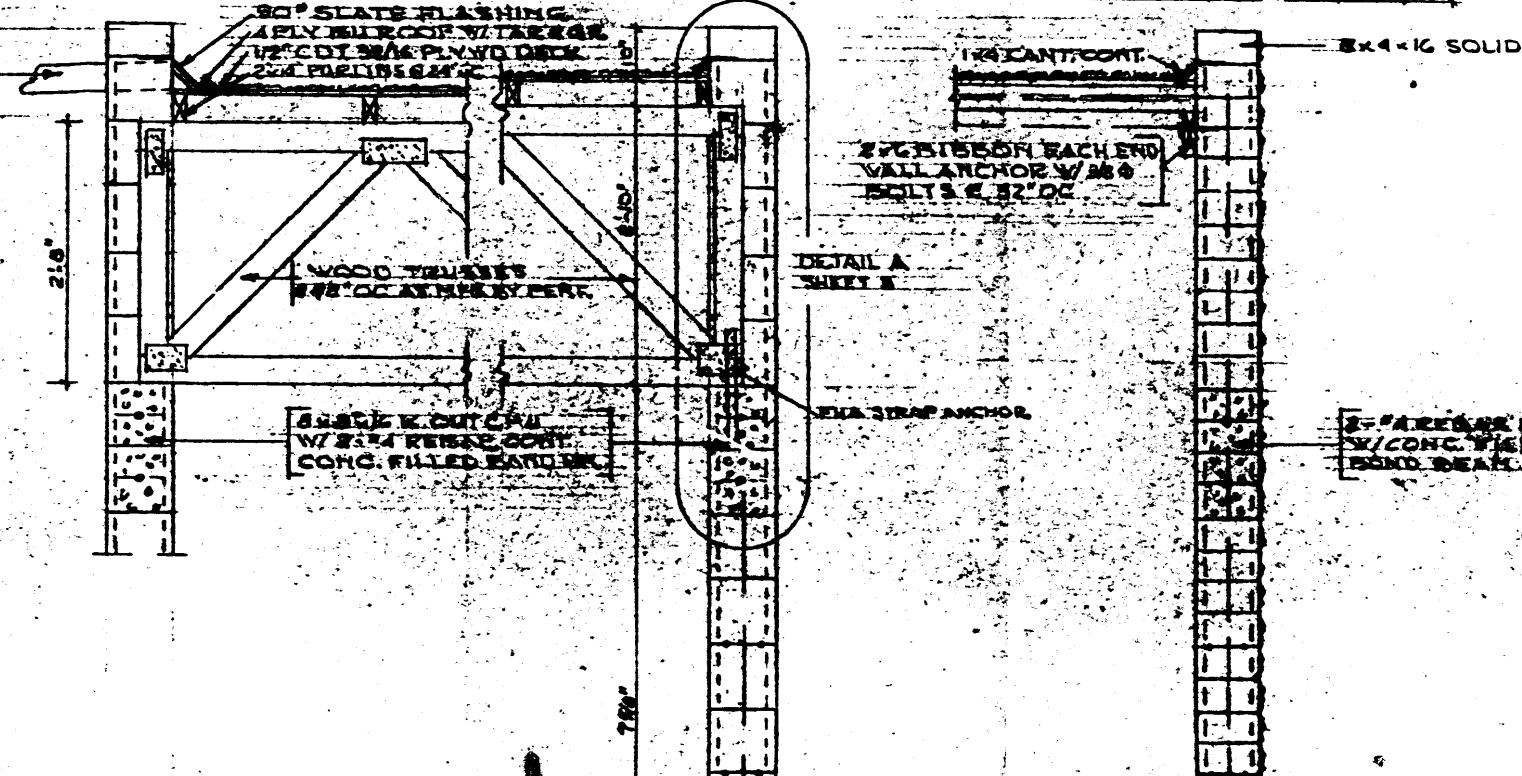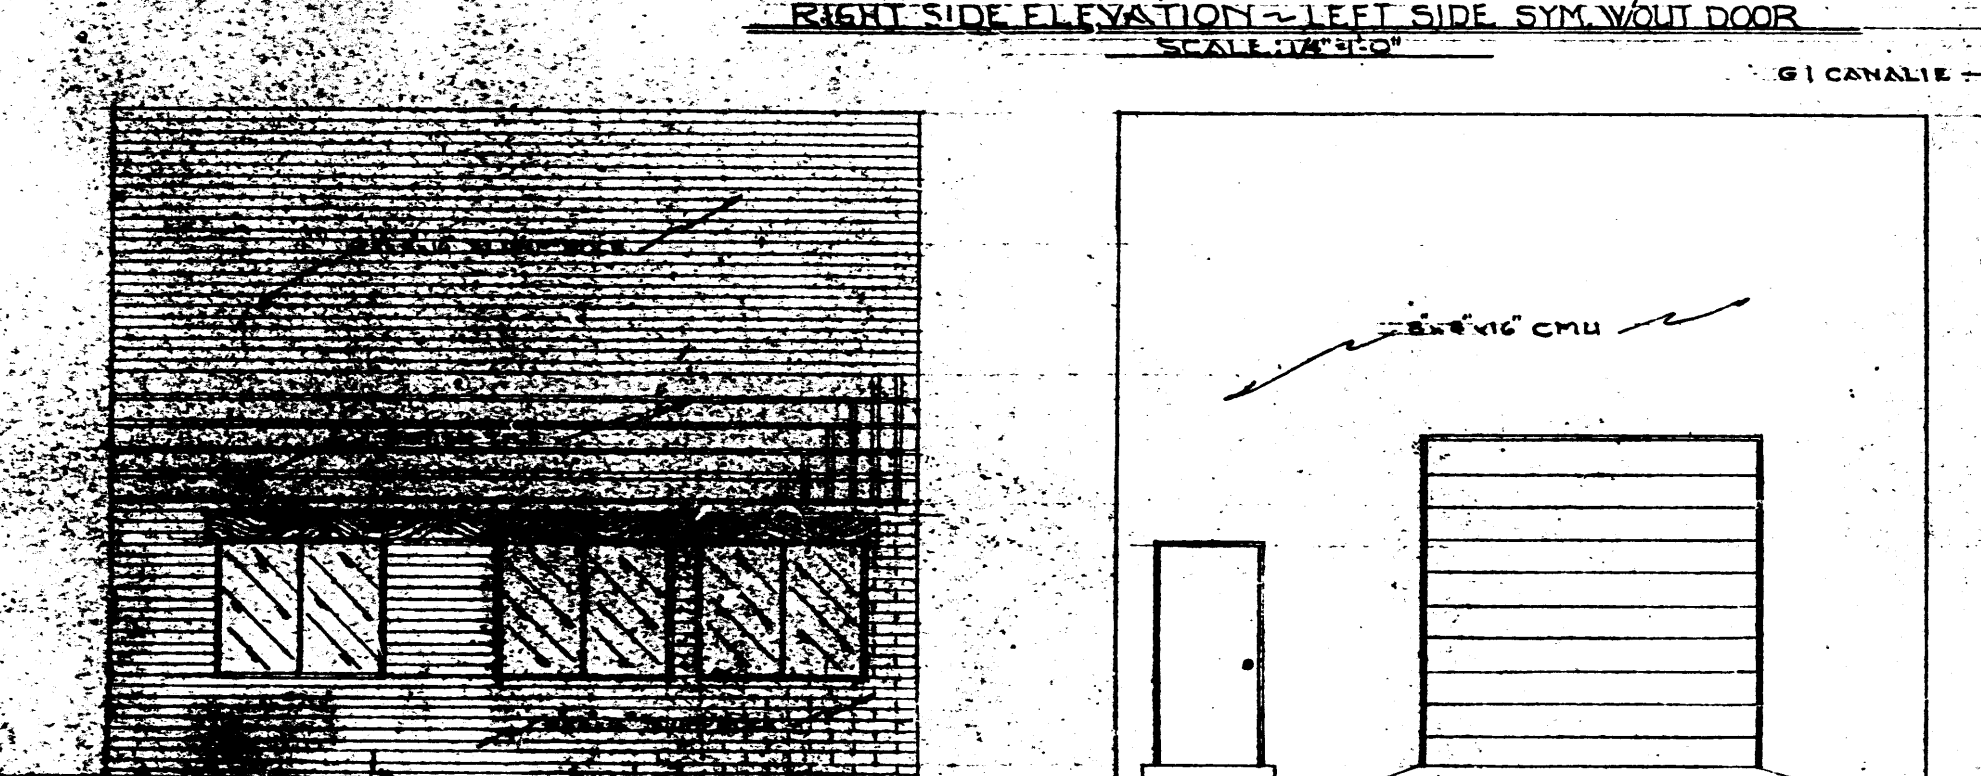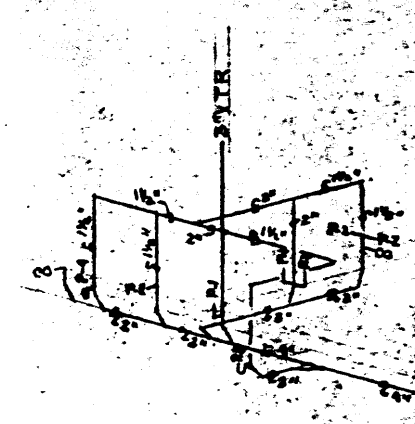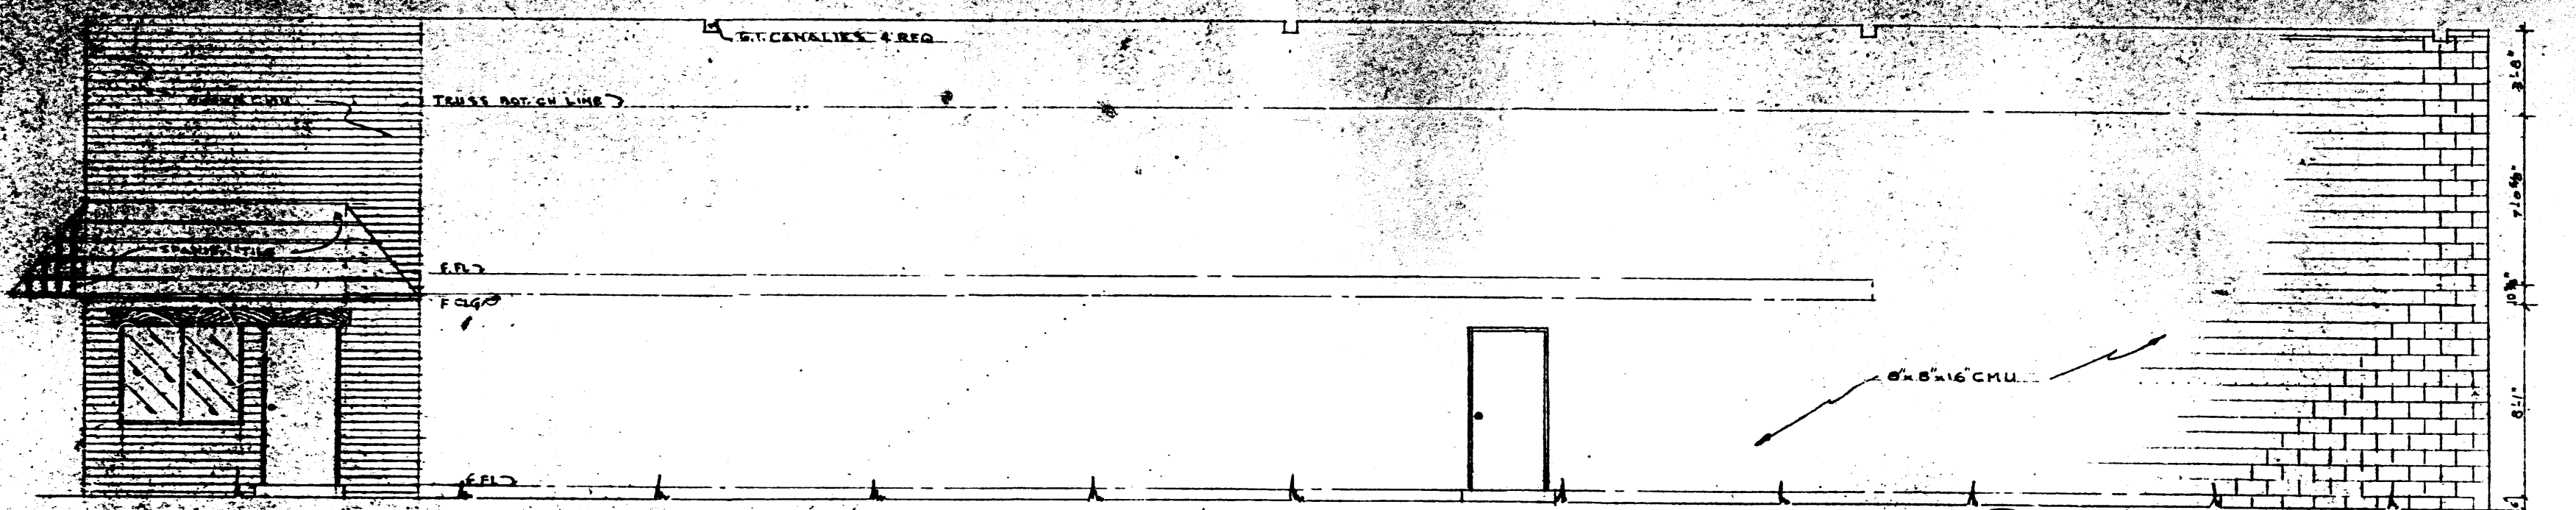


*Certified
By Chris Weiss
6.8.81*

LEGEND
95 --- Existing Contour
96 --- Finished Contour
95.5 --- Finished Spot Elev.
ZONE ATLAS 6-M

SITE PLAN
NORTH 100' OF THE WEST 1/2 OF BLOCK "M" OF COLES INDUSTRIAL SUBDIVISION NO. 2


NOTES:
1. The proposed building is to be located on the site shown on the site plan.
2. The proposed building is to be constructed of concrete block and steel framing.
3. The proposed building is to be constructed on a foundation of concrete piers.
4. The proposed building is to be constructed on a lot of 1.57 acres.
5. The proposed building is to be constructed on a lot of 1.57 acres.

NOTES:
1. The proposed building is to be located on the site shown on the site plan.
2. The proposed building is to be constructed of concrete block and steel framing.
3. The proposed building is to be constructed on a foundation of concrete piers.
4. The proposed building is to be constructed on a lot of 1.57 acres.
5. The proposed building is to be constructed on a lot of 1.57 acres.

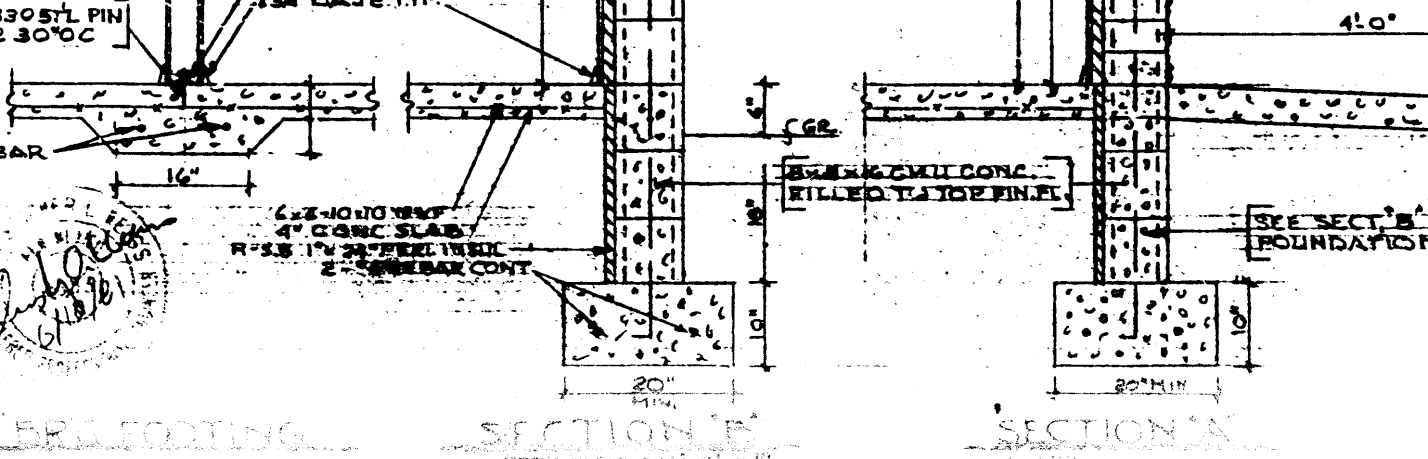


NOTES:
1. The proposed building is to be located on the site shown on the site plan.
2. The proposed building is to be constructed of concrete block and steel framing.
3. The proposed building is to be constructed on a foundation of concrete piers.
4. The proposed building is to be constructed on a lot of 1.57 acres.
5. The proposed building is to be constructed on a lot of 1.57 acres.



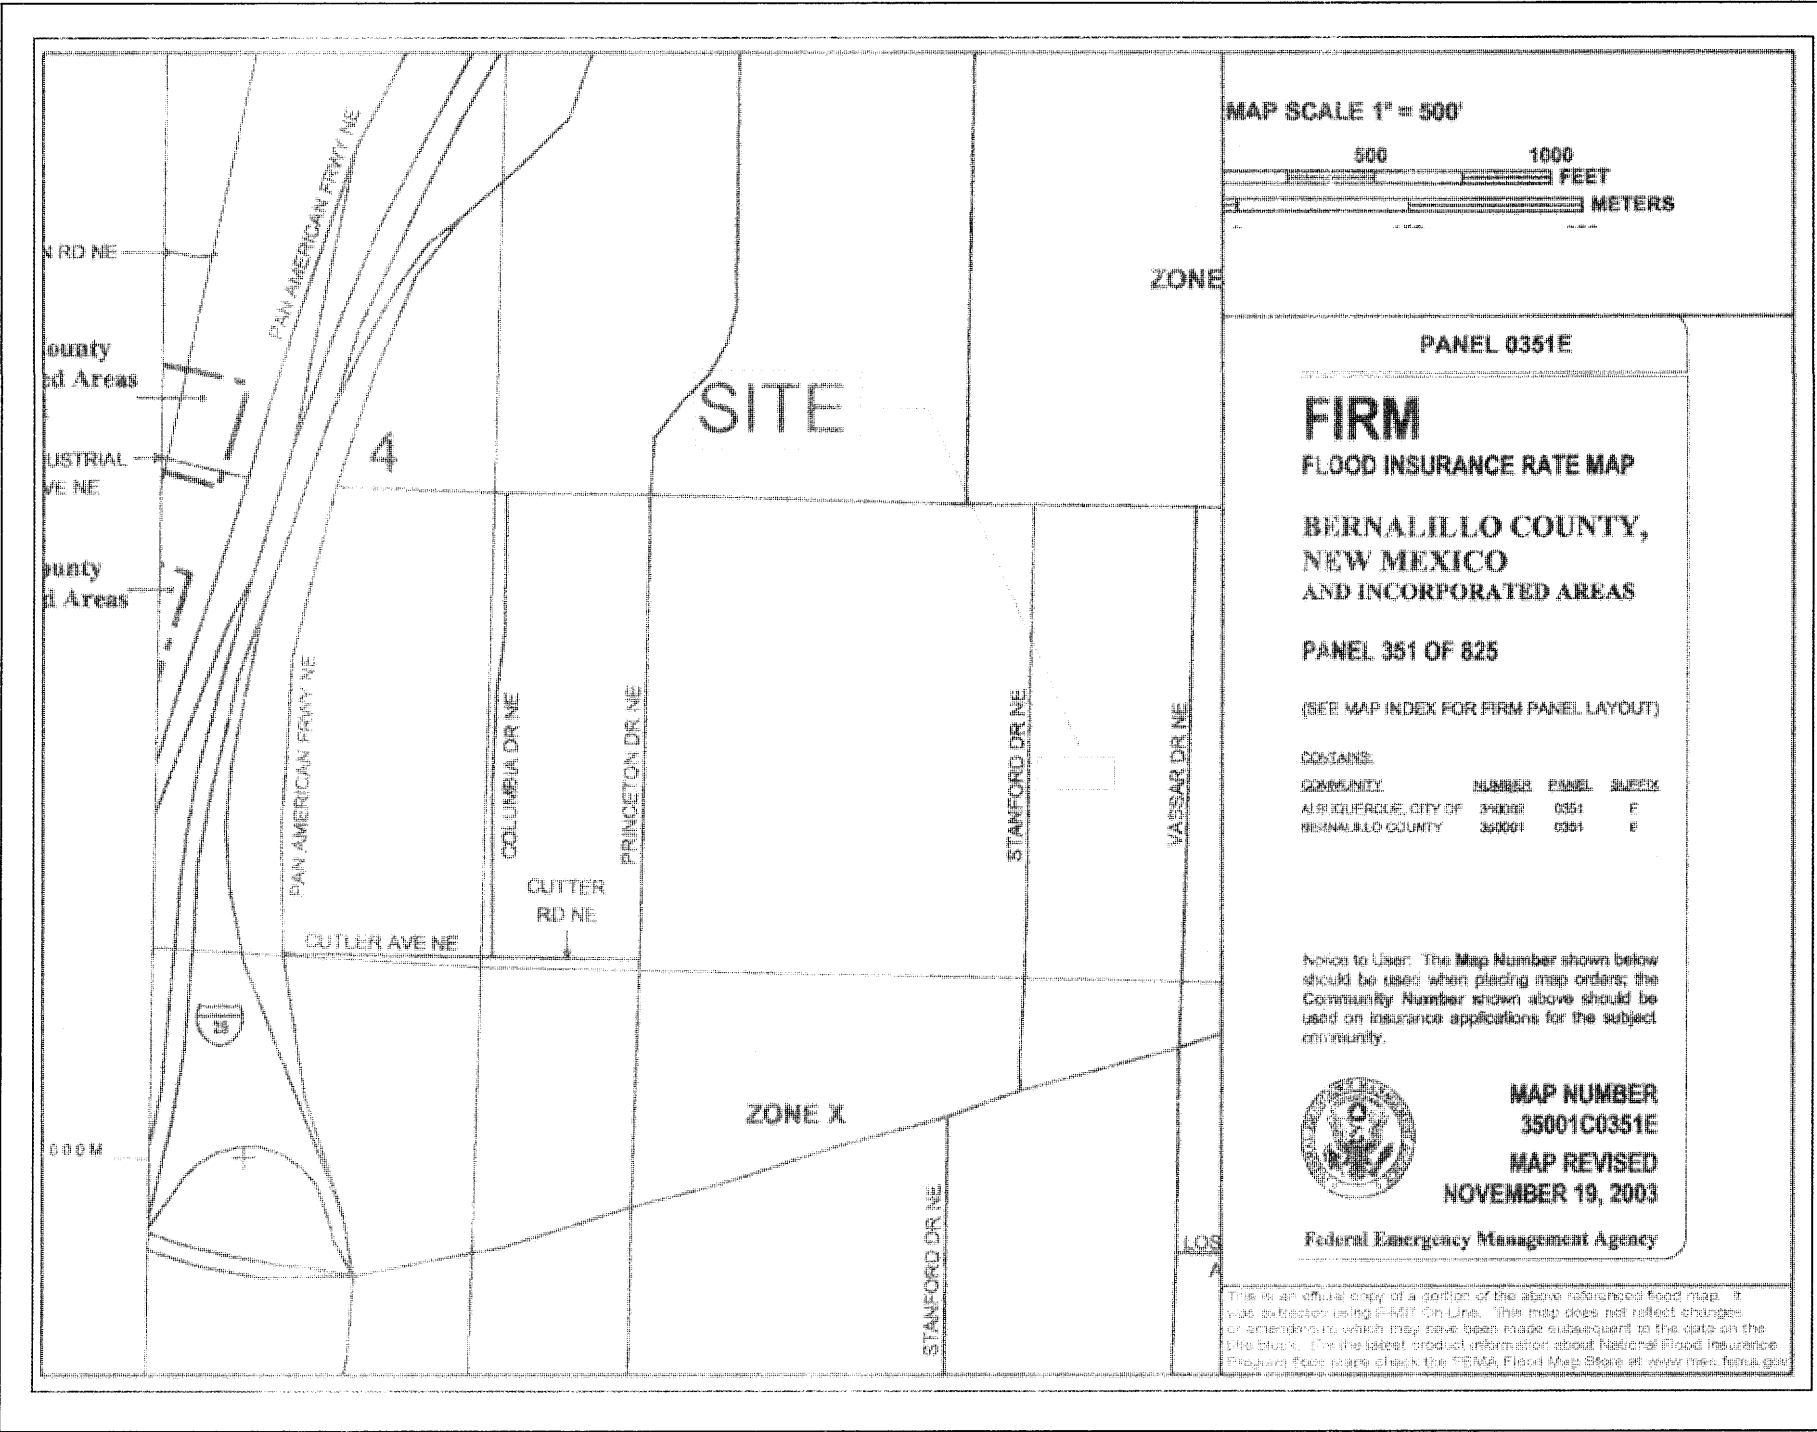

FLOOD INSURANCE RATE MAP (FIRMETTE)

MAP NO. 351

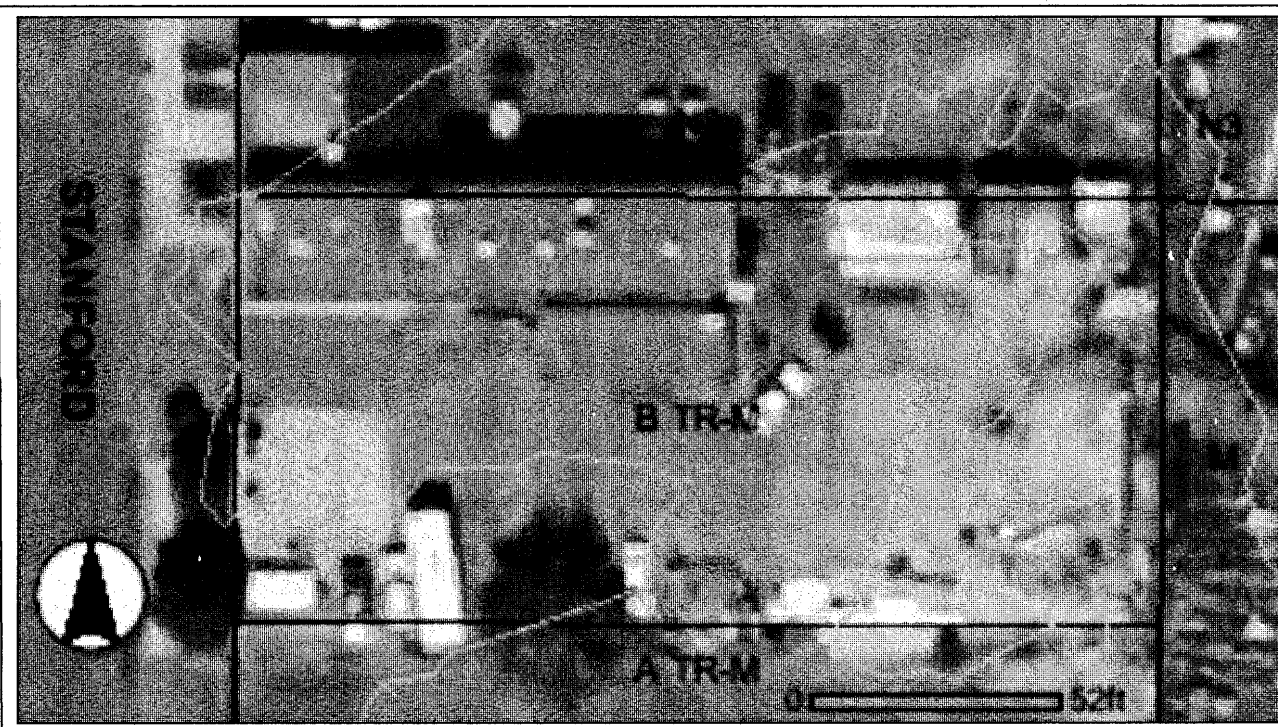

2004 AERIAL PHOTO

CITY OF ALBUQUERQUE DRAINAGE FACILITIES WITHIN CITY RIGHT-OF-WAY (S.O. 19) NOTICE TO CONTRACTORS

1. AN EXCAVATION/CONSTRUCTION PERMIT WILL BE REQUIRED BEFORE BEGINNING ANY WORK WITHIN CITY RIGHT-OF-WAY. AN APPROVED COPY OF THESE PLANS MUST BE SUBMITTED AT THE TIME OF APPLICATION FOR THIS PERMIT.
2. ALL WORK DETAILED ON THIS PLAN TO BE PERFORMED UNDER CONTRACT, EXCEPT AS OTHERWISE STATED OR PROVIDED FOR HEREIN, SHALL BE CONSTRUCTED IN ACCORDANCE WITH STANDARD SPECIFICATIONS FOR PUBLIC WORKS CONSTRUCTION, 1986, AS UPDATED THROUGH REVISION NO. 6.
3. TWO (2) WORKING DAYS PRIOR TO ANY EXCAVATION, CONTRACTOR MUST CONTACT NEW MEXICO ONE CALL SYSTEM, INC., 260-1990, FOR LOCATION FOR EXISTING UTILITIES.
4. PRIOR TO CONSTRUCTION, THE CONTRACTOR SHALL EXCAVATE AND VERIFY THE HORIZONTAL AND VERTICAL LOCATIONS OF ALL OBSTRUCTIONS. SHOULD A CONFLICT EXIST, THE CONTRACTOR SHALL NOTIFY THE ENGINEER SO THAT THE CONFLICT CAN BE RESOLVED WITH A MINIMUM AMOUNT OF DELAY.
5. BACKFILL COMPACTION SHALL BE ACCORDING TO TRAFFIC/STREET USE.
6. MAINTENANCE OF THESE FACILITIES SHALL BE THE RESPONSIBILITY OF THE OWNER OF THE PROPERTY SERVED.
7. WORK ON ARTERIAL STREETS SHALL BE PERFORMED ON A 24-HOUR BASIS.

APPROVAL FOR SW CULVERTS	NAME	DATE
INSPECTOR:		

GRADING PLAN LEGEND:


EXISTING	NEW	DESCRIPTION
5284	84	CONTOUR
84.00	84.00	SPOT ELEVATION
←	←	PROPERTY LINE
←	←	SWALE
←	←	SHEET FLOW
←	←	ROOF FLOW
←	←	DOWN SPOUT

TOPD SURVEY LEGEND:

BDC = BACK OF CURB	ER = EDGE OF ROAD
CC = CURB CUT	FINFLR = FINISH FLOOR
DI = DRAINAGE INLET	FL = FLOW LINE
EA = EDGE OF ASPHALT	FND = FOUND
EC = EDGE OF CONCRETE	FP = FENCE POST
EL = ELEVATION	G = GROUND
EDW = EDGE OF WALL	INV = INVERT

TOPOGRAPHIC SURVEY GENERAL NOTES :

1. CONTOUR INTERVAL IS ONE (1) FOOT.
2. ELEVATIONS ARE BASED ON CITY OF ALBUQUERQUE STATION No. "11-H16", HAVING AN ELEVATION OF 5097.88.
3. UTILITIES SHOWN HEREON ARE IN THEIR APPROXIMATE LOCATION BASED ONLY ON ABOVE GROUND EVIDENCE FOUND IN THE FIELD AND AS-BUILT INFORMATION PROVIDED BY THE CLIENT. UTILITIES SHOWN HEREON, WHETHER INDICATED AS ABANDONED OR NOT, SHALL BE VERIFIED BY OTHERS FOR EXACT LOCATION AND/OR DEPTH PRIOR TO EXCAVATION OR DESIGN CONSIDERATIONS.
5. THIS IS NOT A BOUNDARY SURVEY. BEARINGS AND DISTANCES SHOWN HEREON ARE FOR REFERENCE ONLY.

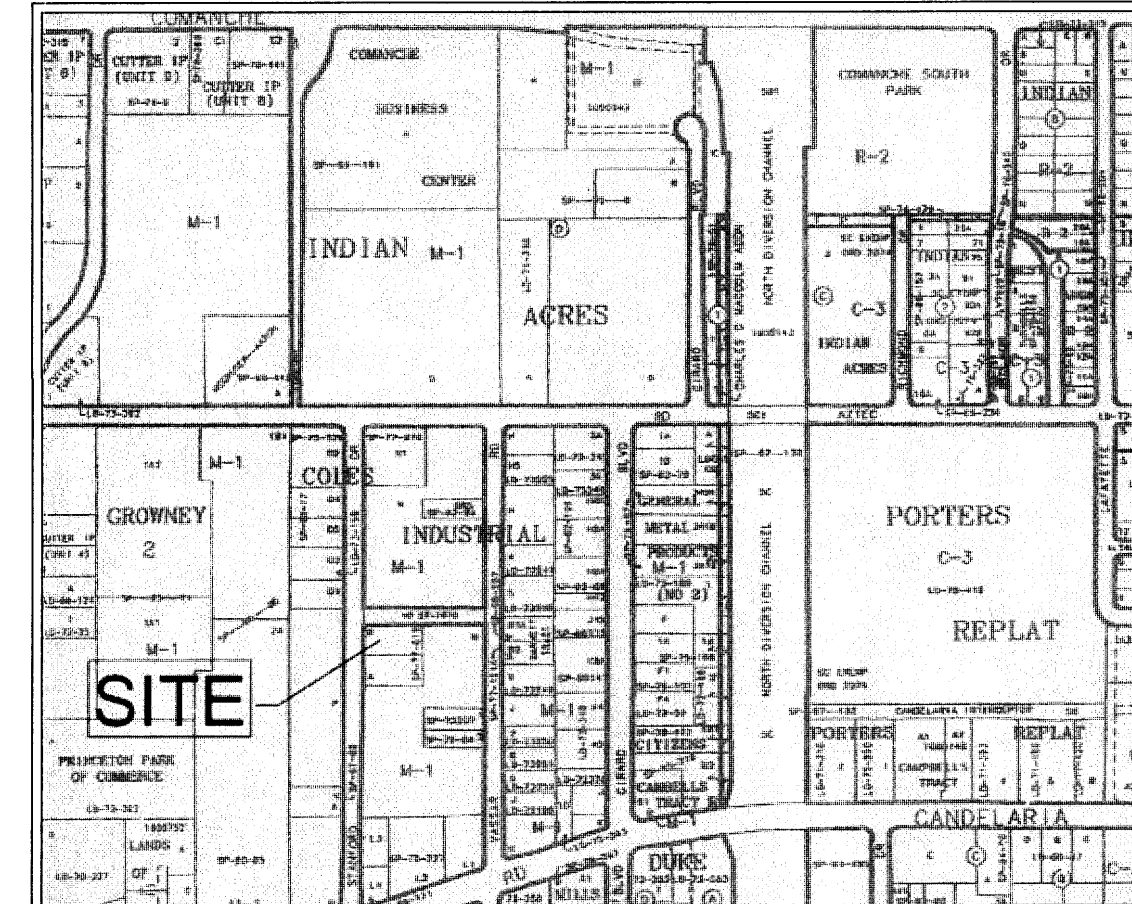

VICINITY MAP

ZONE ATLAS G-16-Z

EROSION CONTROL NOTES:

THE CONTRACTOR SHALL BE RESPONSIBLE FOR COMPLIANCE WITH THE FOLLOWING:

1. NO SEDIMENT-BEARING WATER SHALL BE ALLOWED TO DISCHARGE FROM THE SITE DURING CONSTRUCTION.
2. DURING GRADING OPERATIONS AND UNTIL THE PROJECT HAS BEEN COMPLETED, ALL ADJACENT PROPERTY, RIGHTS-OF-WAY, AND EASEMENTS SHALL BE PROTECTED FROM FLOODING BY RUNOFF FROM THE SITE.
3. SHOULD THE CONTRACTOR FAIL TO PREVENT SEDIMENT-BEARING WATER FROM ENTERING PUBLIC RIGHT-OF-WAY, HE SHALL PROMPTLY REMOVE FROM THE PUBLIC RIGHT-OF-WAY ANY AND ALL SEDIMENT ORIGINATING FROM THE SITE.
4. CONTROL OF SEDIMENT-LADEN WATERS WILL BE ACCOMPLISHED BY USE OF A COMPACTED EARTH BERM OF ADEQUATE HEIGHT. THE BERM SHALL BE LOCATED ALONG THE DOWNSTREAM PERIMETER OF THE PROPERTY.

DRAINAGE CONSIDERATIONS:

EXISTING SITE CONDITIONS:

The site is located on the east side of Stanford Drive, NE, approximately half way between Candelaria Road and Aztec Drive. The site is developed as is the property to the north, east and south. There is one existing office/manufacturing building on the site as well as a small booth and existing asphalt pavement and concrete slabs. The original development had a hydrology submittal, G16-D34. These are on microfilm and are difficult to read. Copies have been ordered from Lason Inc. The project was constructed in the early 1980's. A detention pond was called for on the plans and is in place on the site. The pond outlet appears to be a 4" PVC pipe through the curb. Apparently, the pond detains water to a depth in excess of one foot. The limits of the pond encroach on the parking area so that cars must be hurriedly moved every time a significant rain occurs.

EXISTING DRAINAGE BASIN CONDITIONS:

This light industrial area which lies between the North Diversion Channel and Interstate 25, and between Candelaria and Aztec, drains to Aztec and to Candelaria. The site is in the portion of the basin that drains to Aztec. The existence of detention ponding in the area was determined by a Simple survey. This was accomplished by piecing together a composite of the on-line City of Albuquerque GIS 2004 aerial photo map of the area between Stanford and the North Diversion Channel and then driving Stanford, Vassar and Girard to locate any drainage pipes through curbs. Remarkably few were found. The above streets each have a high point that divides flow to Aztec or Candelaria. Only the area flowing to Aztec was considered. Only four pipes through curbs were found, including the property at 3312 Stanford NE. The composite map is submitted with this plan together with photos of the three detention areas besides this site. The photos show that in those cases where detention was provided, only a token effort was made to reduce the peak discharge rate. The composite map shows the area to be fully developed, (i.e. no vacant lots) and the percentage of Treatment D is estimated to be near 90%.

PROPOSED SITE CONDITIONS:

It is proposed to construct an 80' x 53' metal building on the site as shown. The roof will be sloped to drain west into the parking lot. In view of the above analysis, it is proposed to discharge the site runoff directly into Stanford by means of a sidewalk culvert.

DRAINAGE CRITERIA:

The calculations shown on this plan were prepared in accordance with Section 22.2, Hydrology, of the Development Process Manual, Volume 2, Design Criteria, for the City of Albuquerque in cooperation with Bernalillo County, New Mexico and the Metropolitan Arroyo Flood Control Authority, January, 1993.

PRECIPITATION ZONE:

The site is between the Rio Grande River and San Mateo Boulevard. Therefore, it is within the limits of Precipitation Zone 2.

LAND TREATMENT AREAS, ETC.:

The peak discharge per acre and excess precipitation are shown for the four land treatments in Zone 2 in the table below, and the values shown are from the City of Albuquerque D.P.M. Also shown are the existing and proposed land treatment areas.

LAND TREAT.	q(cfs/acre)		E (in)		Existing Site Areas		Developed Site Areas	
	10-yr	100-yr	10-yr	100-yr	%	Sq.Ft.	%	Sq.Ft.
A	1.56	0.38	0.53	0.13	0.0	0.0000	0.0	0.0000
B	2.28	0.95	0.78	0.28	0.0	0.0000	9.7	1,953
C	3.14	1.71	1.13	0.52	43.6	8,710	8.9	1,775
D	4.70	3.14	2.12	1.34	56.4	11,290	81.4	16,272
Totals					100.0	20,000	0.4591	20,000

PEAK DISCHARGE:

EXISTING CONDITIONS:

$$Q_{100} = 0.2000 * 3.14 + 0.2591 * 4.70 = 1.85 \text{ cfs}$$

$$Q_{10} = 0.2000 * 1.71 + 0.2591 * 3.14 = 1.16 \text{ cfs}$$

DEVELOPED CONDITIONS:

$$Q_{100} = 0.0448 * 2.28 + 0.0407 * 3.14 + 0.3736 * 4.70 = 1.99 \text{ cfs}$$

$$Q_{10} = 0.0448 * 0.95 + 0.0407 * 1.71 + 0.3736 * 3.14 = 1.29 \text{ cfs}$$

VOLUME, 100-YEAR AND 10-YEAR, 6-HOUR:

EXISTING CONDITIONS:

$$V_{100} = (8.710 * 1.13 + 11,290 * 2.12) / 12 = 2,815 \text{ cf}$$

$$V_{10} = (8.710 * 0.52 + 11,290 * 1.34) / 12 = 1,638 \text{ cf}$$

DEVELOPED CONDITIONS:

$$V_{100} = (1,953 * 0.78 + 1,775 * 1.13 + 16,272 * 2.12) / 12 = 3,169 \text{ cf}$$

$$V_{10} = (1,953 * 0.28 + 1,775 * 0.52 + 16,272 * 1.34) / 12 = 1,939 \text{ cf}$$

SUMMARY OF ON-SITE VOLUMES AND DISCHARGE RATES:

	V100(CF)	V10(CF)	Q100(CFS)	Q10(CFS)
DEVELOPED	3,169	1,939	1.99	1.29
EXISTING	2,815	1,638	1.85	1.16
INCREASE	354	301	0.14	0.13

SIDEWALK CULVERT CAPACITY:

Use Weir Equation, $Q = CLH^{3/2}$ Design $Q = 1.99 \text{ cfs}$ $C = 2.65$ $L = 1.50$ $H = 0.67'$
 $Q = 2.65 * 1.50 * 0.67^{3/2} = 2.18 \text{ cfs}$ 1.99 cfs OK


DOWNSTREAM CAPACITY:

The flow from this site enters Stanford Drive and flows north to Aztec Ave. It then flows west in Aztec Avenue to inlets at the intersection of the I-25 East Frontage Road. The portion of Aztec Ave. between Stanford and Princeton is very flat and therefore does not convey the volume of water that the section west of Princeton conveys. It is believed that allowing unrestricted discharge from this site will not cause increased depth in the critical section of Aztec Ave. for the following reasons:



1. The site is one of the smallest lots in the drainage basin.
2. The site is relatively at the low end of the basin. Runoff from the site will be through the flat portion of Aztec Ave. before the peak flow occurs in that section.
3. The site is an infill site. Future development will have to, in most cases, replace existing pavement or existing buildings.
4. The peak discharge rate for this site very small in comparison with the entire portion of the basin draining to the flat portion of Aztec Ave.

CONSTRUCT 18" SIDEWALK CULVERT PER C.O.A. STD.DWG. 2236 SEE S.O. 19 BELOW INV. IN = 96.37 INV. OUT = 96.17

$$S = \frac{1.2}{96} = .01$$

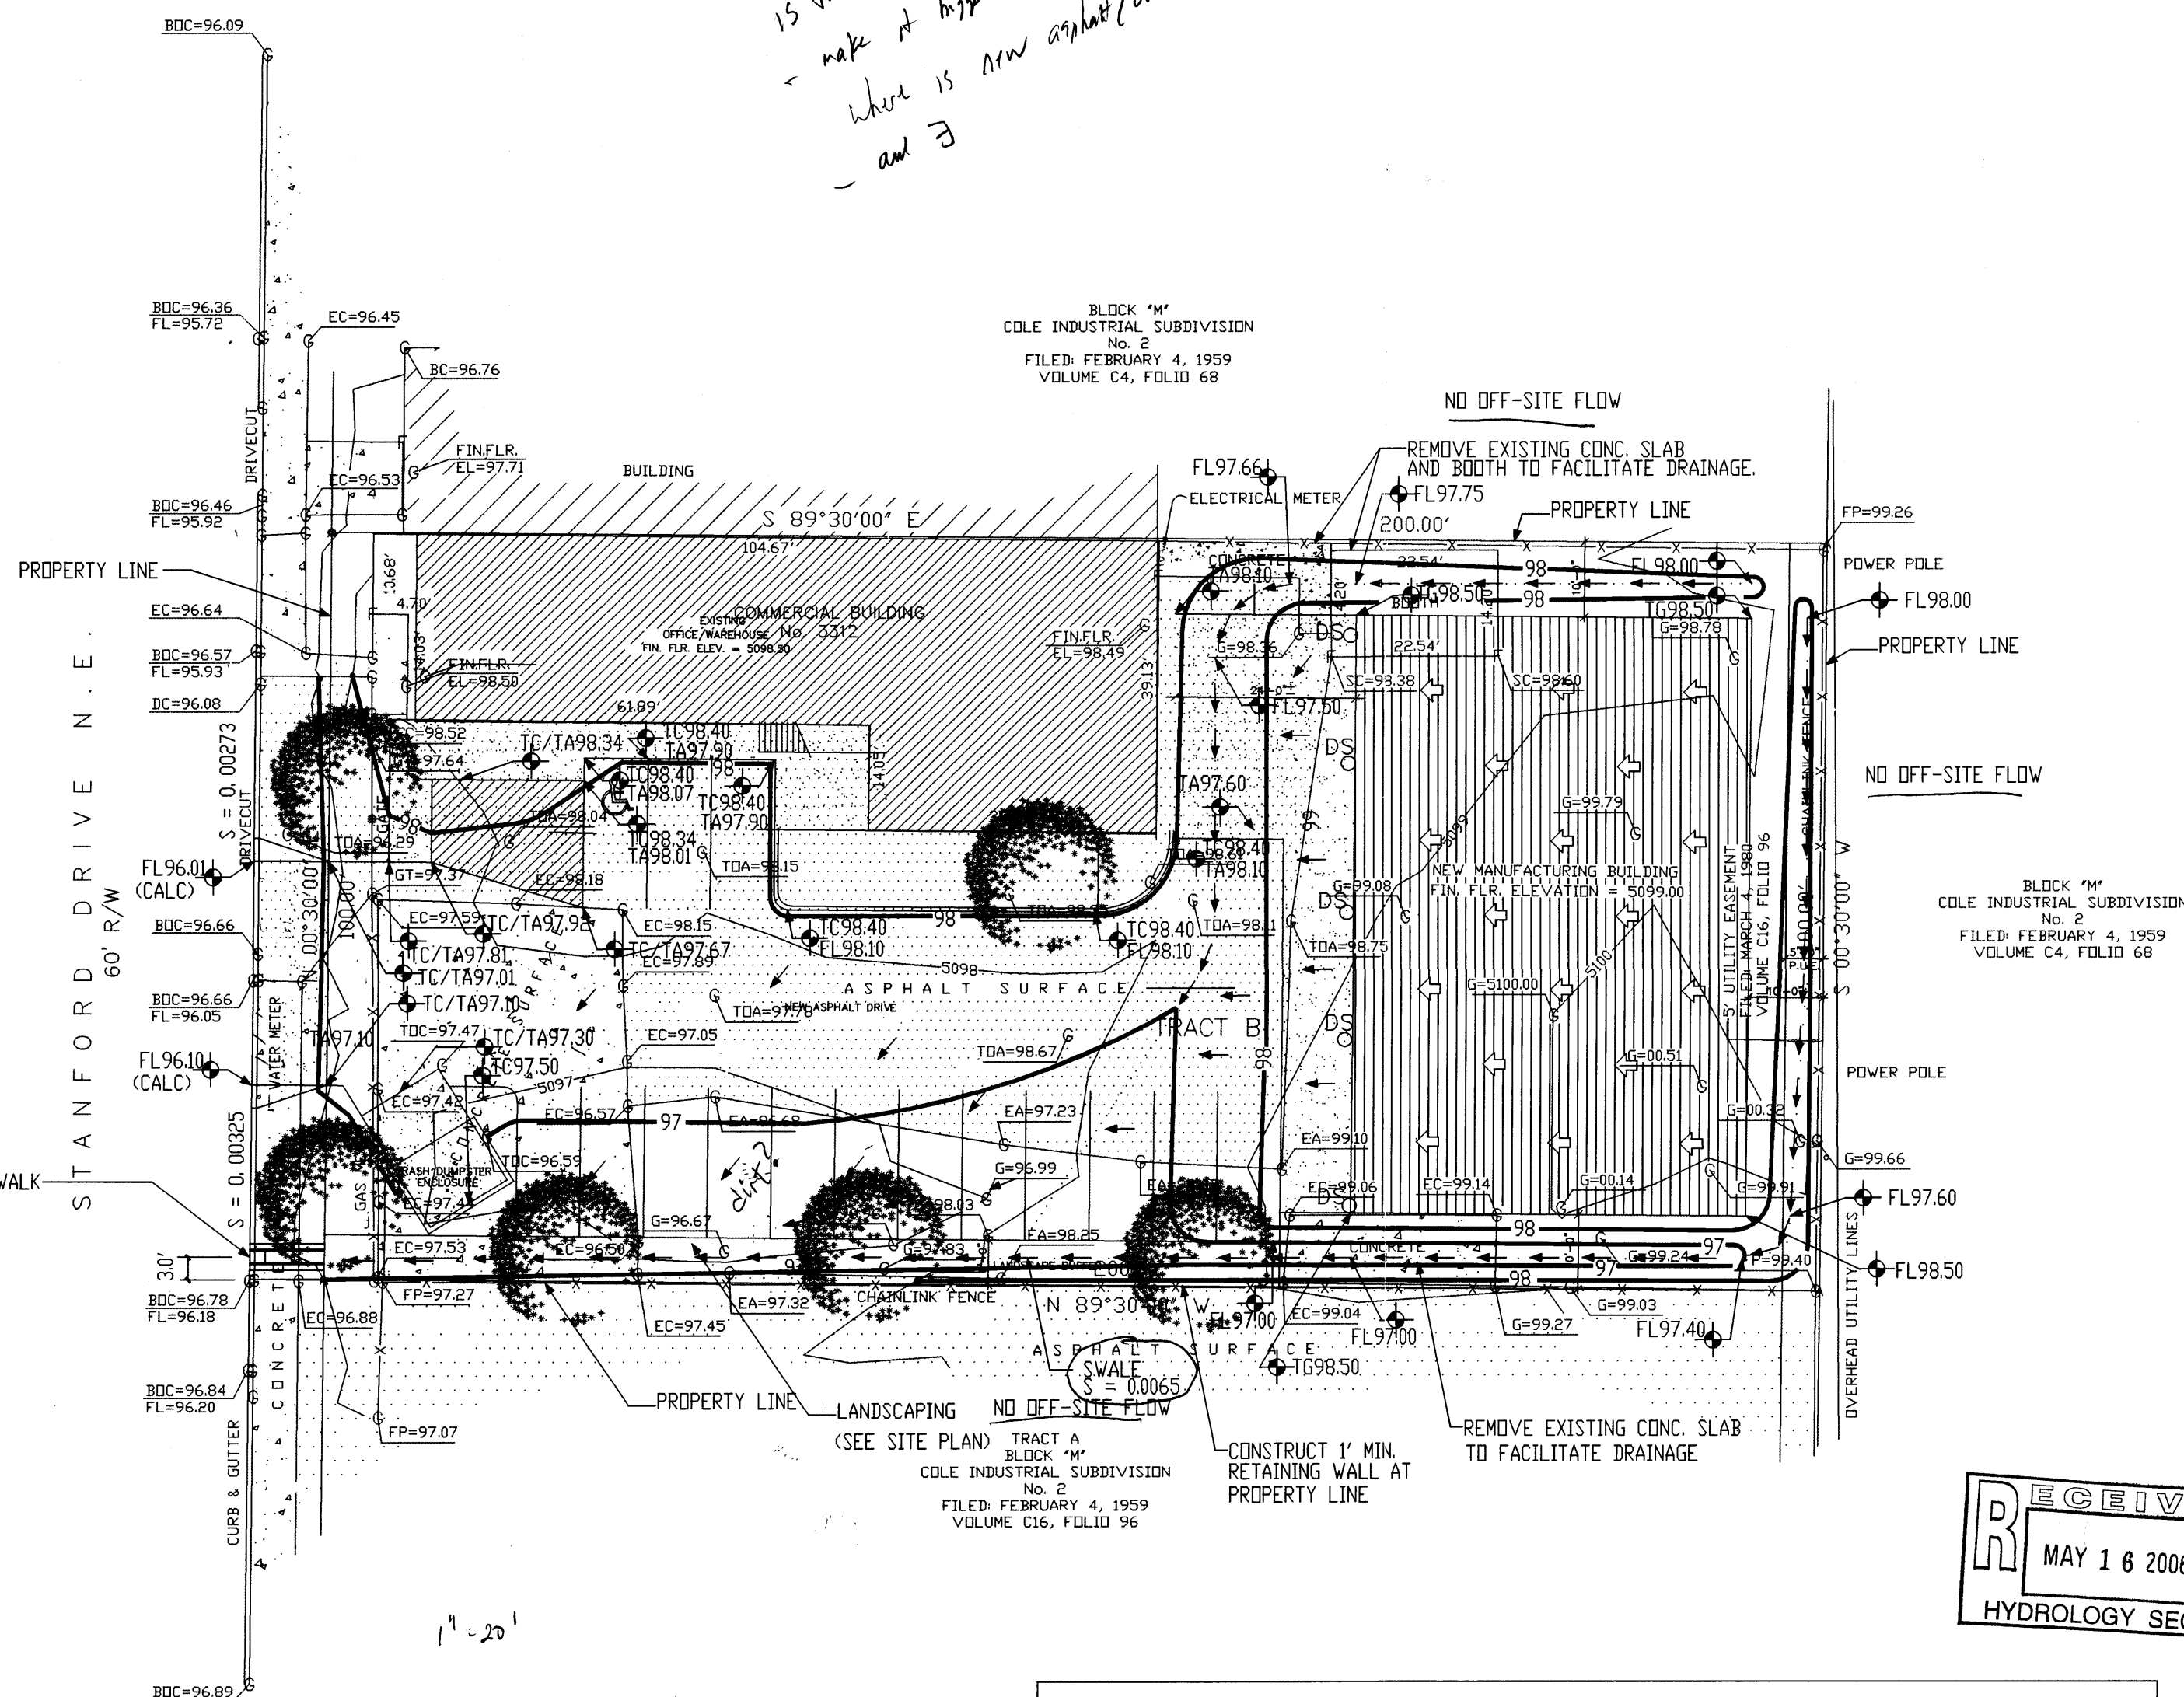

LEGAL DESCRIPTION
 LOT 'B' OF THE NORTH 100 FEET OF THE WEST HALF OF BLOCK 'M' OF COLE'S INDUSTRIAL SUBDIVISION NO. 2, IN THE CITY OF ALBUQUERQUE, N.M. AS SHOWN AND DESIGNATED ON THE AMENDED SUMMARY PLAT FILED IN THE OFFICE OF THE COUNTY CLERK OF BERNALILLO COUNTY, N.M. ON MARCH 4, 1980 IN PLAT BLOCK VOL. C16, FOLIO 96.

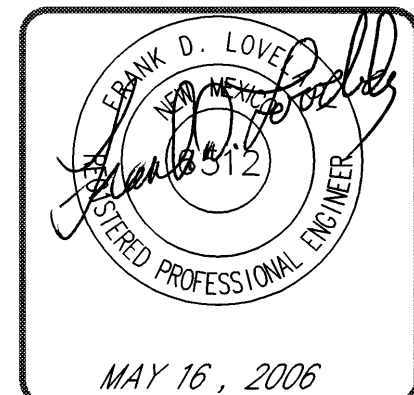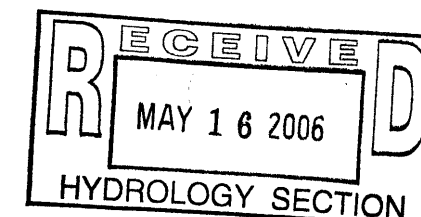

GRADING AND DRAINAGE PLAN
 ARRAY TECHNOLOGIES INC.
 3312 STANFORD DRIVE NE
 ALBUQUERQUE, NEW MEXICO

FRANK D. LOVELL, P.E.
 (505) 345-2267 * Fax (505) 345-2115 * 300 ALAMOSA RD. NW * Albuquerque, NM * 87107

JOB NO:	699
DATE:	May 16, 2006
REVISIONS	

SHEET NO.
 1 OF 1

GRADING PLAN LEGEND:

EXISTING	NEW	DESCRIPTION
5284	84	CONTOUR
84.00	84.00	SPOT ELEVATION
		PROPERTY LINE
		SWALE
		SHEET FLOW
		ROOF FLOW
		DOWN SPOUT


TOPO SURVEY LEGEND:

B/C = BACK OF CURB	ER = EDGE OF ROAD
CC = CURB CUT	FIN.FLR = FINISH FLOOR
DI = DRAINAGE INLET	FL = FLOW LINE
EA = EDGE OF ASPHALT	FND = FOUND
EC = EDGE OF CONCRETE	FP = FENCE POST
EL = ELEVATION	G = GROUND
EDW = EDGE OF WALL	INV = INVERT

HATCHING LEGEND:

[Hatched Box]	EXISTING ON-SITE BUILDING
[Hatched Box]	EXISTING OFF-SITE BUILDING
[Dotted Box]	EXISTING OFF-SITE ASPHALT
[Dashed Box]	EXISTING SIDEWALK ON STANFORD DR.
[Horizontal Lines]	NEW CONCRETE
[Vertical Lines]	NEW BUILDING
[Diagonal Lines]	PAVEMENT STRIPING


CONSTRUCT 18" SIDEWALK CULVERT PER C.D.A. STD.DWG. 2236 SEE S.D. 19 BELOW INV. IN = 96.37 INV. OUT = 96.17

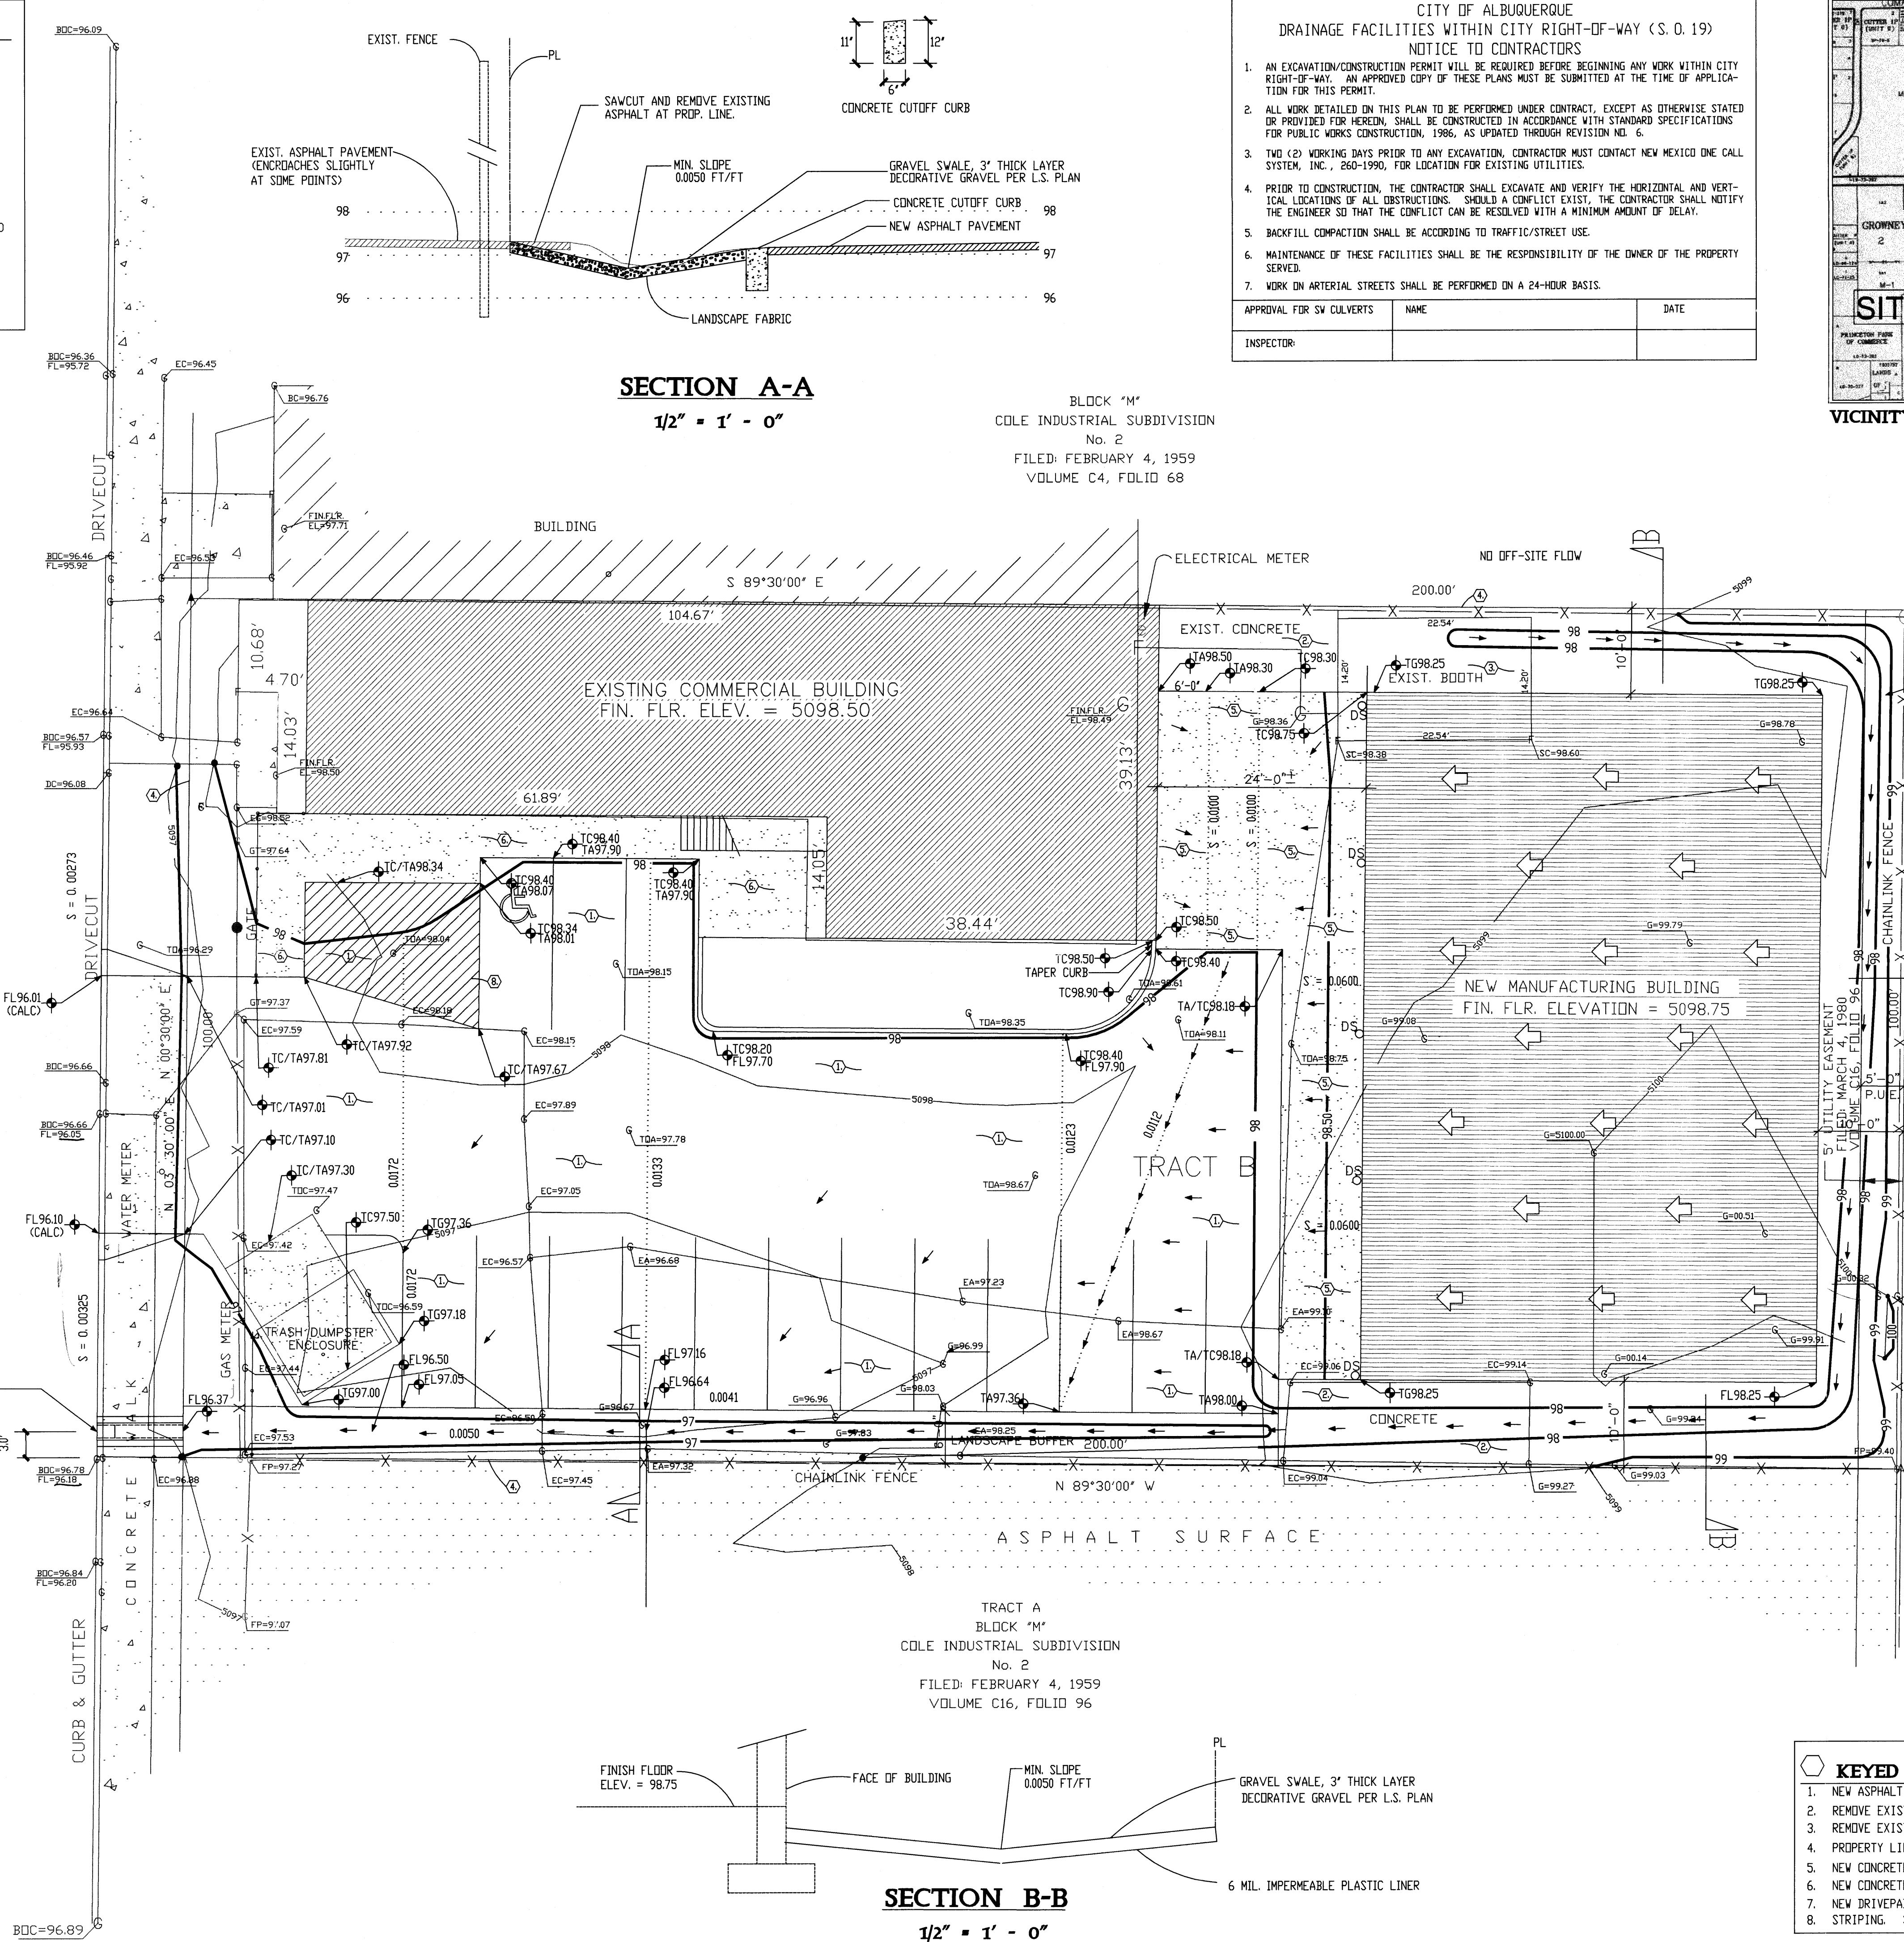

CITY OF ALBUQUERQUE
DRAINAGE FACILITIES WITHIN CITY RIGHT-OF-WAY (S.O. 19)
NOTICE TO CONTRACTORS

- AN EXCAVATION/CONSTRUCTION PERMIT WILL BE REQUIRED BEFORE BEGINNING ANY WORK WITHIN CITY RIGHT-OF-WAY. AN APPROVED COPY OF THESE PLANS MUST BE SUBMITTED AT THE TIME OF APPLICATION FOR THIS PERMIT.
- ALL WORK DETAILED IN THIS PLAN TO BE PERFORMED UNDER CONTRACT, EXCEPT AS OTHERWISE STATED OR PROVIDED FOR HEREIN. SHALL BE CONSTRUCTED IN ACCORDANCE WITH STANDARD SPECIFICATIONS FOR PUBLIC WORKS CONSTRUCTION, 1986, AS UPDATED THROUGH REVISION NO. 6.
- TWO (2) WORKING DAYS PRIOR TO ANY EXCAVATION, CONTRACTOR MUST CONTACT NEW MEXICO ONE CALL SYSTEM, INC., 260-1990, FOR LOCATION FOR EXISTING UTILITIES.
- PRIOR TO CONSTRUCTION, THE CONTRACTOR SHALL EXCAVATE AND VERIFY THE HORIZONTAL AND VERTICAL LOCATIONS OF ALL OBSTRUCTIONS. SHOULD A CONFLICT EXIST, THE CONTRACTOR SHALL NOTIFY THE ENGINEER SO THAT THE CONFLICT CAN BE RESOLVED WITH A MINIMUM AMOUNT OF DELAY.
- BACKFILL COMPACTION SHALL BE ACCORDING TO TRAFFIC/STREET USE.
- MAINTENANCE OF THESE FACILITIES SHALL BE THE RESPONSIBILITY OF THE OWNER OF THE PROPERTY SERVED.
- WORK ON ARTERIAL STREETS SHALL BE PERFORMED ON A 24-HOUR BASIS.

APPROVAL FOR SV CULVERTS	NAME	DATE
INSPECTOR:		

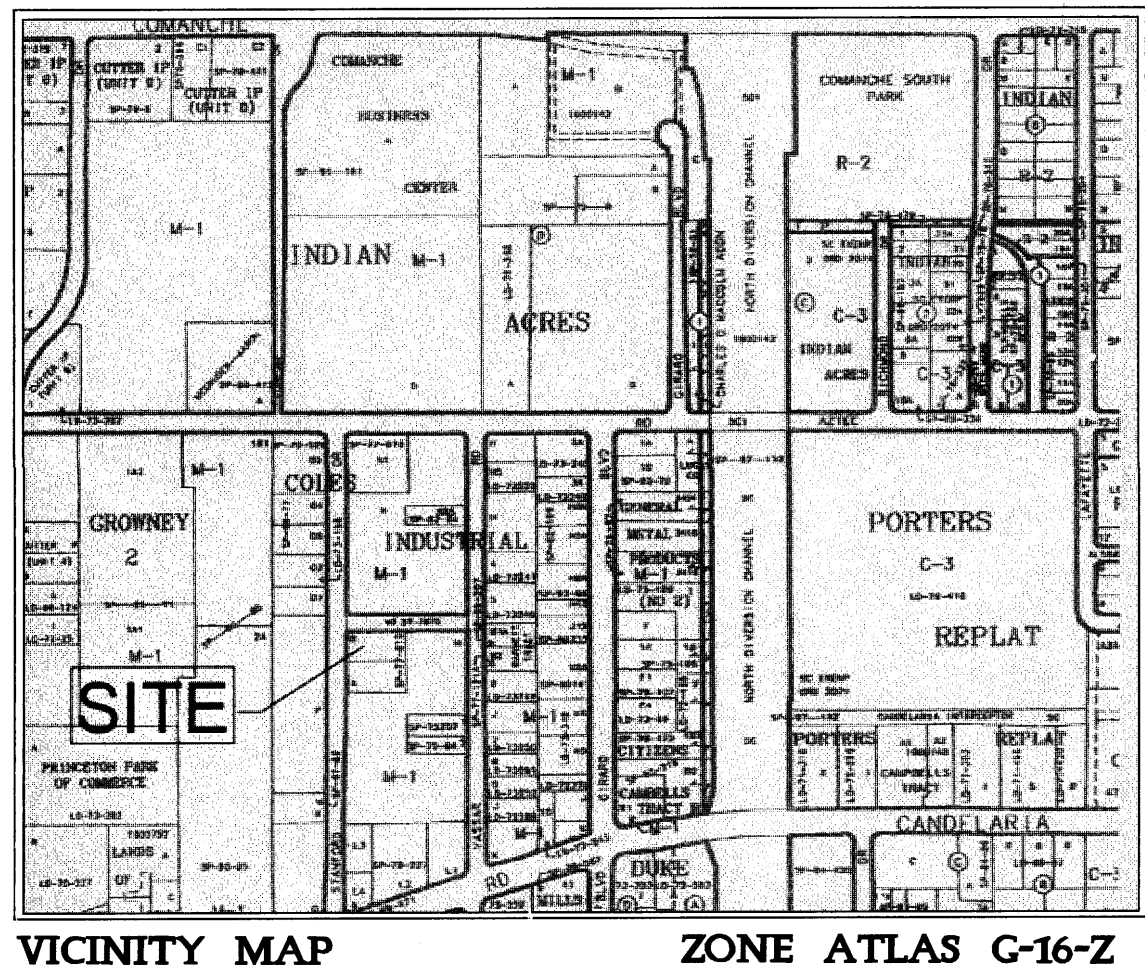

FRANK D. LOVELADY, P.E.
REGISTERED PROFESSIONAL ENGINEER
JUNE 9, 2006

GRADING AND DRAINAGE PLAN
ARRAY TECHNOLOGIES INC.
3312 STANFORD DRIVE NE
ALBUQUERQUE, NEW MEXICO


FRANK D. LOVELADY, P.E.
REGISTERED PROFESSIONAL ENGINEER
(505) 345-2287 • Fax (505) 345-2115 • 300 ALAMOS RD. NW • Albuquerque, NM • 87107

JOB NO:	699
DATE:	June 9, 2006
REVISIONS	

SHEET NO.
1 OF 2



FLOOD INSURANCE RATE MAP (FIRMETTE) MAP NO. 351

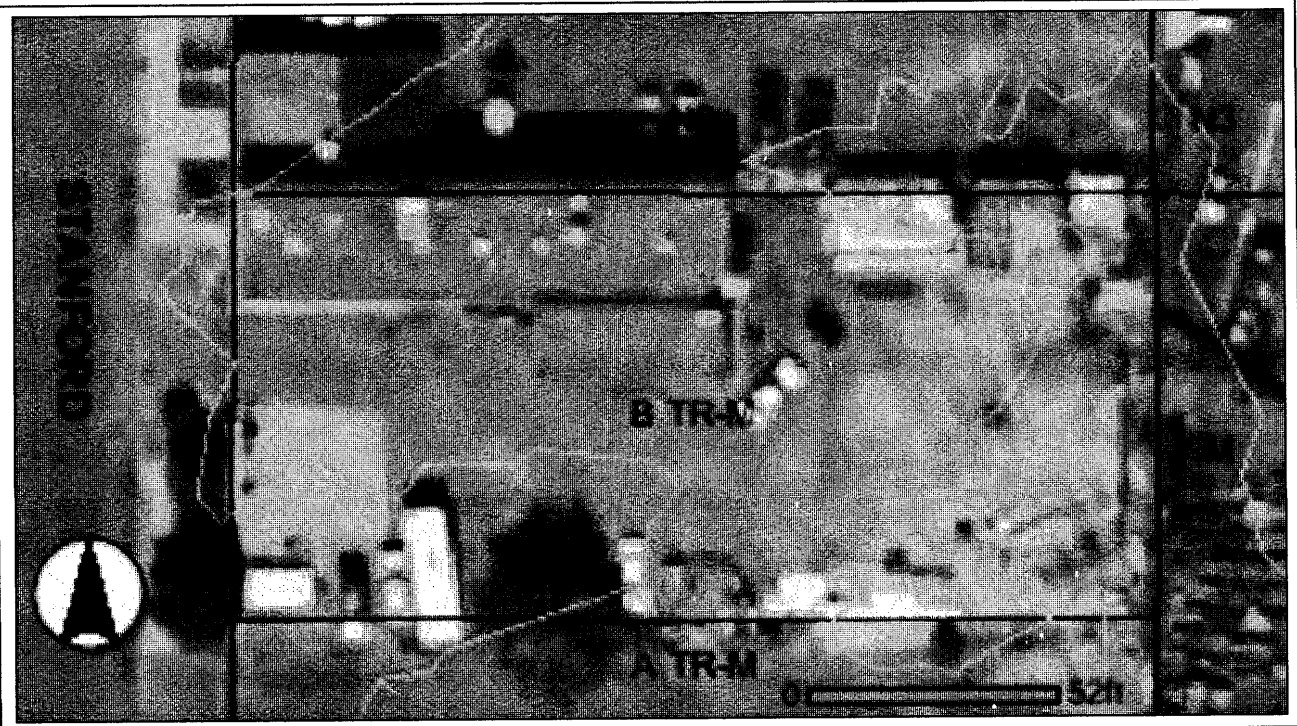

2004 AERIAL PHOTO

TOPOGRAPHIC SURVEY GENERAL NOTES :

- 1: CONTOUR INTERVAL IS ONE (1) FOOT.
- 2: ELEVATIONS ARE BASED ON CITY OF ALBUQUERQUE STATION No. "11-H16", HAVING AN ELEVATION OF 5097.88.
- 3: UTILITIES SHOWN HEREON ARE IN THEIR APPROXIMATE LOCATION BASED ONLY ON ABOVE GROUND EVIDENCE FOUND IN THE FIELD AND AS-BUILT INFORMATION PROVIDED BY THE CLIENT. UTILITIES SHOWN HEREON, WHETHER INDICATED AS ABANDONED OR NOT, SHALL BE VERIFIED BY OTHERS FOR EXACT LOCATION AND/ OR DEPTH PRIOR TO EXCAVATION OR DESIGN CONSIDERATIONS.
- 5: THIS IS NOT A BOUNDARY SURVEY. BEARINGS AND DISTANCES SHOWN HEREON ARE FOR REFERENCE ONLY.

EROSION CONTROL NOTES:

- THE CONTRACTOR SHALL BE RESPONSIBLE FOR COMPLIANCE WITH THE FOLLOWING:
1. NO SEDIMENT-BEARING WATER SHALL BE ALLOWED TO DISCHARGE FROM THE SITE DURING CONSTRUCTION.
 2. DURING GRADING OPERATIONS AND UNTIL THE PROJECT HAS BEEN COMPLETED, ALL ADJACENT PROPERTY, RIGHTS-OF-WAY, AND EASEMENTS SHALL BE PROTECTED FROM FLOODING BY RUNOFF FROM THE SITE.
 3. SHOULD THE CONTRACTOR FAIL TO PREVENT SEDIMENT-BEARING WATER FROM ENTERING PUBLIC RIGHT-OF-WAY, HE SHALL PROMPTLY REMOVE FROM THE PUBLIC RIGHT-OF-WAY ANY AND ALL SEDIMENT ORIGINATING FROM THE SITE.
 4. CONTROL OF SEDIMENT-LADEN WATERS WILL BE ACCOMPLISHED BY USE OF A COMPACTED EARTH BERM OF ADEQUATE HEIGHT. THE BERM SHALL BE LOCATED ALONG THE DOWNSTREAM PERIMETER OF THE PROPERTY.



CALCULATIONS AND MISCELLANEOUS
ARRAY TECHNOLOGIES INC.
3312 STANFORD DRIVE NE
ALBUQUERQUE, NEW MEXICO

DRAINAGE CONSIDERATIONS:

EXISTING SITE CONDITIONS:

The site is located on the east side of Stanford Drive, NE, approximately half way between Candelaria Road and Aztec Drive. The site is developed as is the property to the north, east and south. There is one existing office/manufacturing building on the site as well as a small booth and existing asphalt pavement and concrete slabs. The original development had a hydrology submittal, G16-D34. These are on microfilm and are difficult to read. Copies have been ordered from Lason Inc. The project was constructed in the early 1980's. A detention pond was called for on the plans and is in place on the site. The pond outlet appears to be a 4" PVC pipe through the curb. Apparently, the pond detains water to a depth in excess of one foot. The limits of the pond encroach on the parking area so that cars must be hurriedly moved every time a significant rain occurs.

EXISTING DRAINAGE BASIN CONDITIONS:

This light industrial area which lies between the North Diversion Channel and Interstate 25, and between Candelaria and Aztec, drains to Aztec and to Candelaria. The site is in the portion of the basin that drains to Aztec. The existence of detention ponding in the area was determined by a simple survey. This was accomplished by piecing together a composite of the on-line City of Albuquerque GIS 2004 aerial photo map of the area between Stanford and the North Diversion Channel and then driving Stanford, Vassar and Girard to locate any drainage pipes through curbs. Remarkably few were found. The above streets each have a high point that divides flow to Aztec or Candelaria. Only the area flowing to Aztec was considered. Only four pipes through curbs were found, including the property at 3312 Stanford NE. The composite map is submitted with this plan together with photos of the three detention areas besides this site. The photos show that in those cases where detention was provided, only a token effort was made to reduce the peak discharge rate. The composite map shows the area to be fully developed, (i.e. no vacant lots) and the percentage of Treatment D is estimated to be near 90%.

PROPOSED SITE CONDITIONS:

It is proposed to construct an 80' x 53' metal building on the site as shown. The roof will be sloped to drain west into the parking lot. In view of the above analysis, it is proposed to discharge the site runoff directly into Stanford by means of a sidewalk culvert.

DRAINAGE CRITERIA:

The calculations shown on this plan were prepared in accordance with Section 22.2, Hydrology, of the Development Process Manual, Volume 2, Design Criteria, for the City of Albuquerque in cooperation with Bernalillo County, New Mexico and the Metropolitan Arroyo Flood Control Authority, January, 1993.

PRECIPITATION ZONE:

The site is between the Rio Grande River and San Mateo Boulevard. Therefore, it is within the limits of Precipitation Zone 2.

LAND TREATMENT AREAS, ETC.:

The peak discharge per acre and excess precipitation are shown for the four land treatments in Zone 2 in the table below, and the values shown are from the City of Albuquerque D.P.M. Also shown are the existing and proposed land treatment areas.

LAND TREAT.	q(cfs/acre)		E (in)		Existing Site Areas		Developed Site Areas		
	100-yr.	10-yr.	100-yr.	10-yr.	%	Sq.Ft.	%	Sq.Ft.	
A	1.56	0.38	0.53	0.13	0.0	0	0.0000	0.0	0.0000
B	2.28	0.95	0.78	0.28	0.0	0	0.0000	9.7	1,953
C	3.14	1.71	1.13	0.52	43.6	8,710	0.2000	8.9	1,775
D	4.70	3.14	2.12	1.34	56.4	11,290	0.2591	81.4	16,272
Totals					100.0	20,000	0.4591	100.0	20,000

PEAK DISCHARGE:

EXISTING CONDITIONS:

$$Q100 = 0.2000 \times 3.14 + 0.2591 \times 4.70 = 1.85 \text{ cfs}$$
$$Q10 = 0.2000 \times 1.71 + 0.2591 \times 3.14 = 1.16 \text{ cfs}$$

DEVELOPED CONDITIONS:

$$Q100 = 0.0448 \times 2.28 + 0.0407 \times 3.14 + 0.3736 \times 4.70 = 1.99 \text{ cfs}$$
$$Q10 = 0.0448 \times 0.95 + 0.0407 \times 1.71 + 0.3736 \times 3.14 = 1.29 \text{ cfs}$$

VOLUME, 100-YEAR AND 10-YEAR, 6-HOUR:

EXISTING CONDITIONS:

$$V100 = (8,710 \times 1.13 + 11,290 \times 2.12) / 12 = 2,815 \text{ cf}$$
$$V10 = (8,710 \times 0.52 + 11,290 \times 1.34) / 12 = 1,638 \text{ cf}$$

DEVELOPED CONDITIONS:

$$V100 = (1,953 \times 0.78 + 1,775 \times 1.13 + 16,272 \times 2.12) / 12 = 3,169 \text{ cf}$$
$$V10 = (1,953 \times 0.28 + 1,775 \times 0.52 + 16,272 \times 1.34) / 12 = 1,939 \text{ cf}$$

SUMMARY OF ON-SITE VOLUMES AND DISCHARGE RATES:

	V100(CF)	V10(CF)	Q100(CFS)	Q10(CFS)
DEVELOPED	3,169	1,939	1.99	1.29
EXISTING	2,815	1,638	1.85	1.16
INCREASE	354	301	0.14	0.13

SIDEWALK CULVERT CAPACITY:

Use Weir Equation, $Q = CLH^{3/2}$ Design $Q = 1.99 \text{ cfs}$ $C = 2.65$ $L = 1.50$ $H = 0.67'$
 $Q = 2.65 \times 1.50 \times 0.67^{3/2} = 2.18 \text{ cfs}$ 1.99 cfs OK



DOWNSTREAM CAPACITY:

The flow from this site enters Stanford Drive and flows north to Aztec Ave. It then flows west in Aztec Avenue to inlets at the intersection of the I-25 East Frontage Road. The portion of Aztec Ave. between Stanford and Princeton is very flat and therefore does not convey the volume of water that the section west of Princeton conveys. It is believed that allowing unrestricted discharge from this site will not cause increased depth in the critical section of Aztec Ave. for the following reasons:


1. The site is one of the smallest lots in the drainage basin.
2. The site is relatively at the low end of the basin. Runoff from the site will be through the flat portion of Aztec Ave. before the peak flow occurs in that section.
3. The site is an infill site. Future development will have to, in most cases, replace existing pavement or existing buildings.
4. The peak discharge rate for this site very small in comparison with the entire portion of the basin draining to the flat portion of Aztec Ave.

OFF-SITE FLOW:

A portion of the parking lot of the adjacent lot on the south appears to drain across the south property line and into the swale. This off-site flow is accepted. The area is approximately 10' x 100' = 1000 sf = 0.0230 ac
 $Q = 0.0230 \times 4.70 = 0.11 \text{ cfs}$

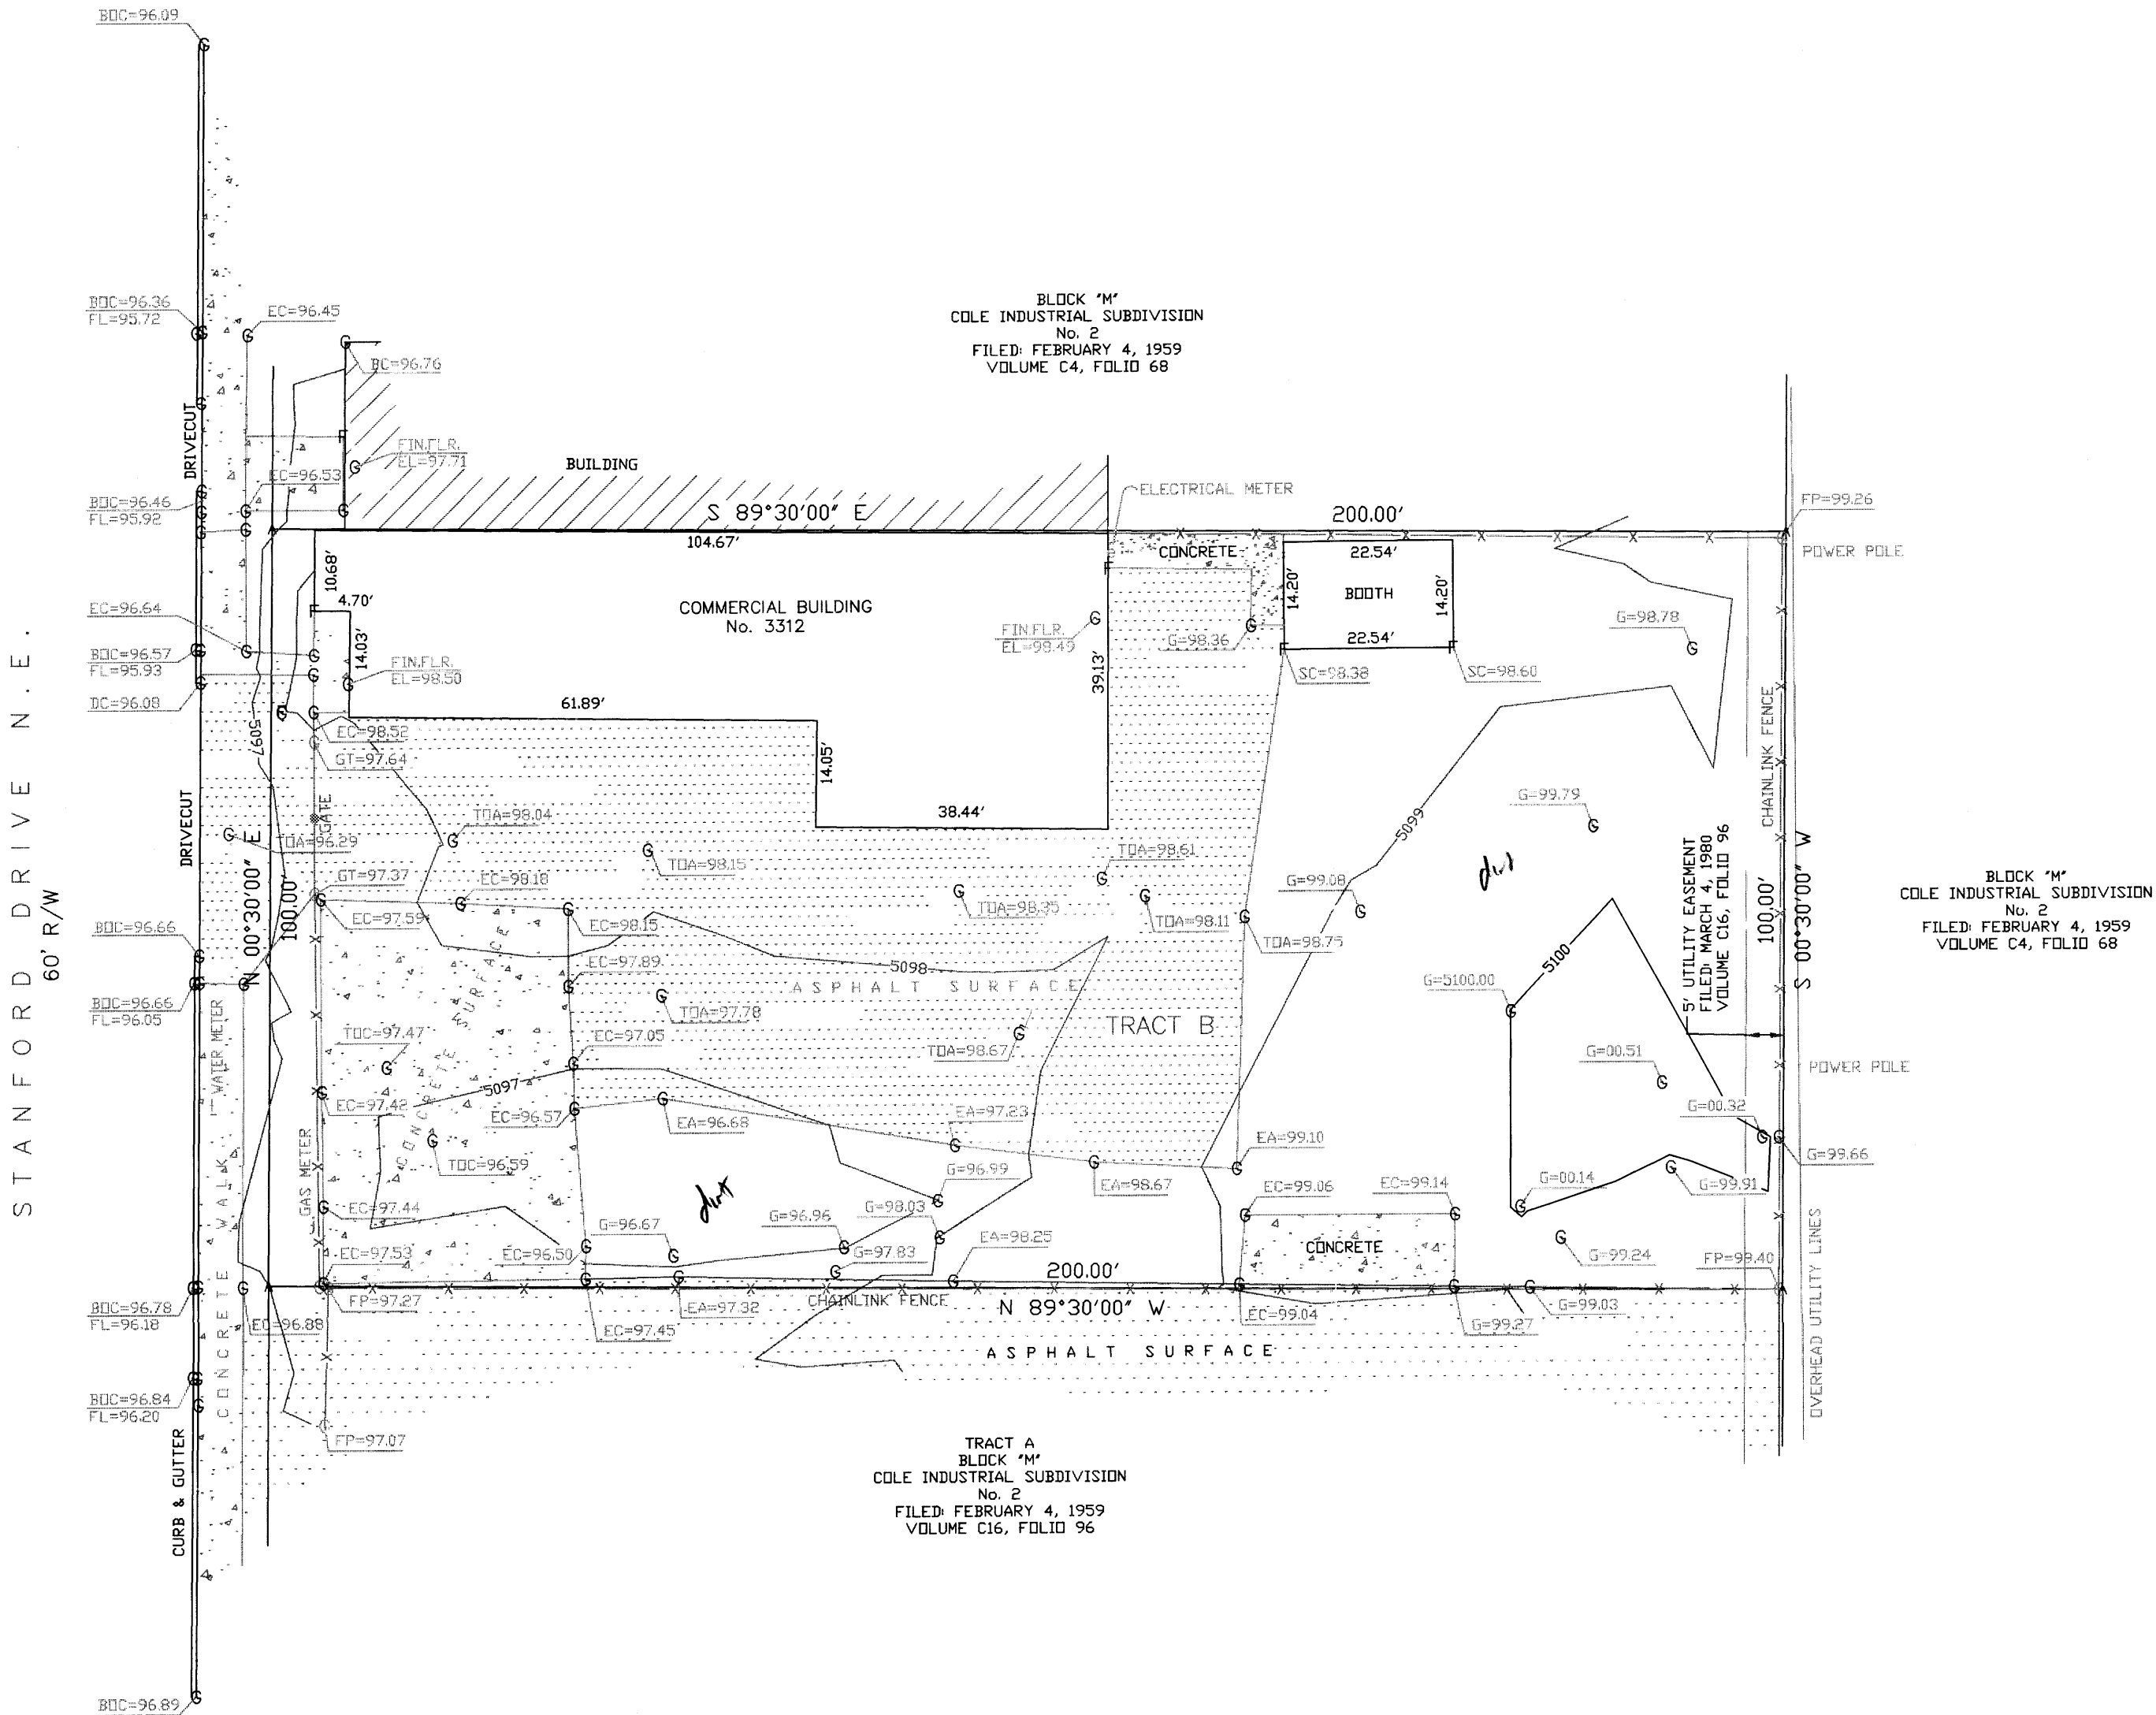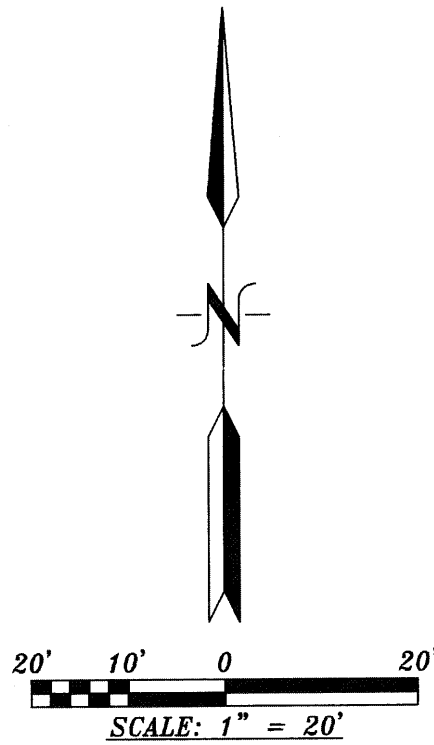

TOPOGRAPHIC SURVEY OF EXISTING SITE:

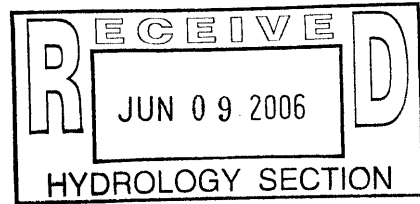

LEGAL DESCRIPTION
LOT 'B' OF THE NORTH 100 FEET OF THE WEST HALF OF BLOCK 'M' OF COLE'S INDUSTRIAL SUBDIVISION NO. 2, IN THE CITY OF ALBUQUERQUE, N.M. AS SHOWN AND DESIGNATED ON THE AMENDED SUMMARY PLAT FILED IN THE OFFICE OF THE COUNTY CLERK OF BERNALILLO COUNTY, N.M. ON MARCH 4, 1980 IN PLAT BLOCK VOL. C16, FOLIO 96.

FRANK D. LOVELADY, P.E.

JOB NO: 699

DATE: JUNE 9, 2006

REVISIONS

SHEET NO.

2 OF 2

1 OF 1

GRADING PLAN LEGEND:		
EXISTING	NEW	DESCRIPTION
5284	84	CONTOUR
84.00	84.00	SPOT ELEVATION
←	←	PROPERTY LINE
←	←	SWALE
←	←	SHEET FLOW
←	←	ROOF FLOW
←	←	DOWN SPOUT
TOPD SURVEY LEGEND:		
B/C = BACK OF CURB	ER =	EDGE OF ROAD
CC = CURB CUT	FL =	FINISH FLOOR
DI = DRAINAGE INLET	FL =	FINISH FLOOR
EA = EDGE OF ASPHALT	FND =	FOUND
EC = EDGE OF CONCRETE	FP =	FENCE POST
EL = ELEVATION	G =	GROUND
EDW = EDGE OF WALL	INV =	INVERT

LEGEND FOR CERT. SURVEY:	
✓	INDICATES SPOT ELEV. UNCHANGED
FL 77.99 / TA 47.91	INDICATES AS-CONSTRUCTED SPOT ELEV.

HATCHING LEGEND:	
	EXISTING ON-SITE BUILDING
	EXISTING OFF-SITE BUILDING
	EXISTING OFF-SITE ASPHALT
	EXISTING SIDEWALK ON STANFORD DR.
	NEW CONCRETE
	NEW BUILDING
	PAVEMENT STRIPING


CERTIFICATION WITH VERIFICATION BY ENGINEER OF RECORD

I, FRANK D. LOVELADY, NMPE 6512 OF THE FIRM FRANK D. LOVELADY P.E. HEREBY CERTIFY THAT THIS PROJECT HAS BEEN GRADED AND WILL DRAIN IN SUBSTANTIAL COMPLIANCE WITH AND IN ACCORDANCE WITH THE DESIGN INTENT OF THE APPROVED PLAN DATED 06-09-2006. THE RECORD INFORMATION EDITED ONTO THE ORIGINAL DESIGN DOCUMENT HAS BEEN OBTAINED BY WAYJOHN SURVEYING COMPANY.

I FURTHER CERTIFY THAT I HAVE PERSONALLY VISITED THE PROJECT SITE ON 11-30-07 AND HAVE DETERMINED BY VISUAL INSPECTION THAT THE SURVEY DATA PROVIDED IS REPRESENTATIVE OF ACTUAL SITE CONDITIONS AND IS TRUE AND CORRECT TO THE BEST OF MY KNOWLEDGE AND BELIEF. THIS CERTIFICATION IS SUBMITTED IN SUPPORT OF A REQUEST FOR PERMANENT CERTIFICATE OF OCCUPANCY.

THE RECORD INFORMATION PRESENTED HEREIN IS NOT NECESSARILY COMPLETE AND INTENDED ONLY TO VERIFY SUBSTANTIAL COMPLIANCE OF THE GRADING AND DRAINAGE ASPECTS OF THIS PROJECT. THOSE RELYING ON THIS RECORD DOCUMENT ARE ADVISED TO OBTAIN INDEPENDENT VERIFICATION OF ITS ACCURACY BEFORE USING IT FOR ANY OTHER PURPOSE.


FRANK D. LOVELADY
NMPE 6512
November 30, 2007
DATE

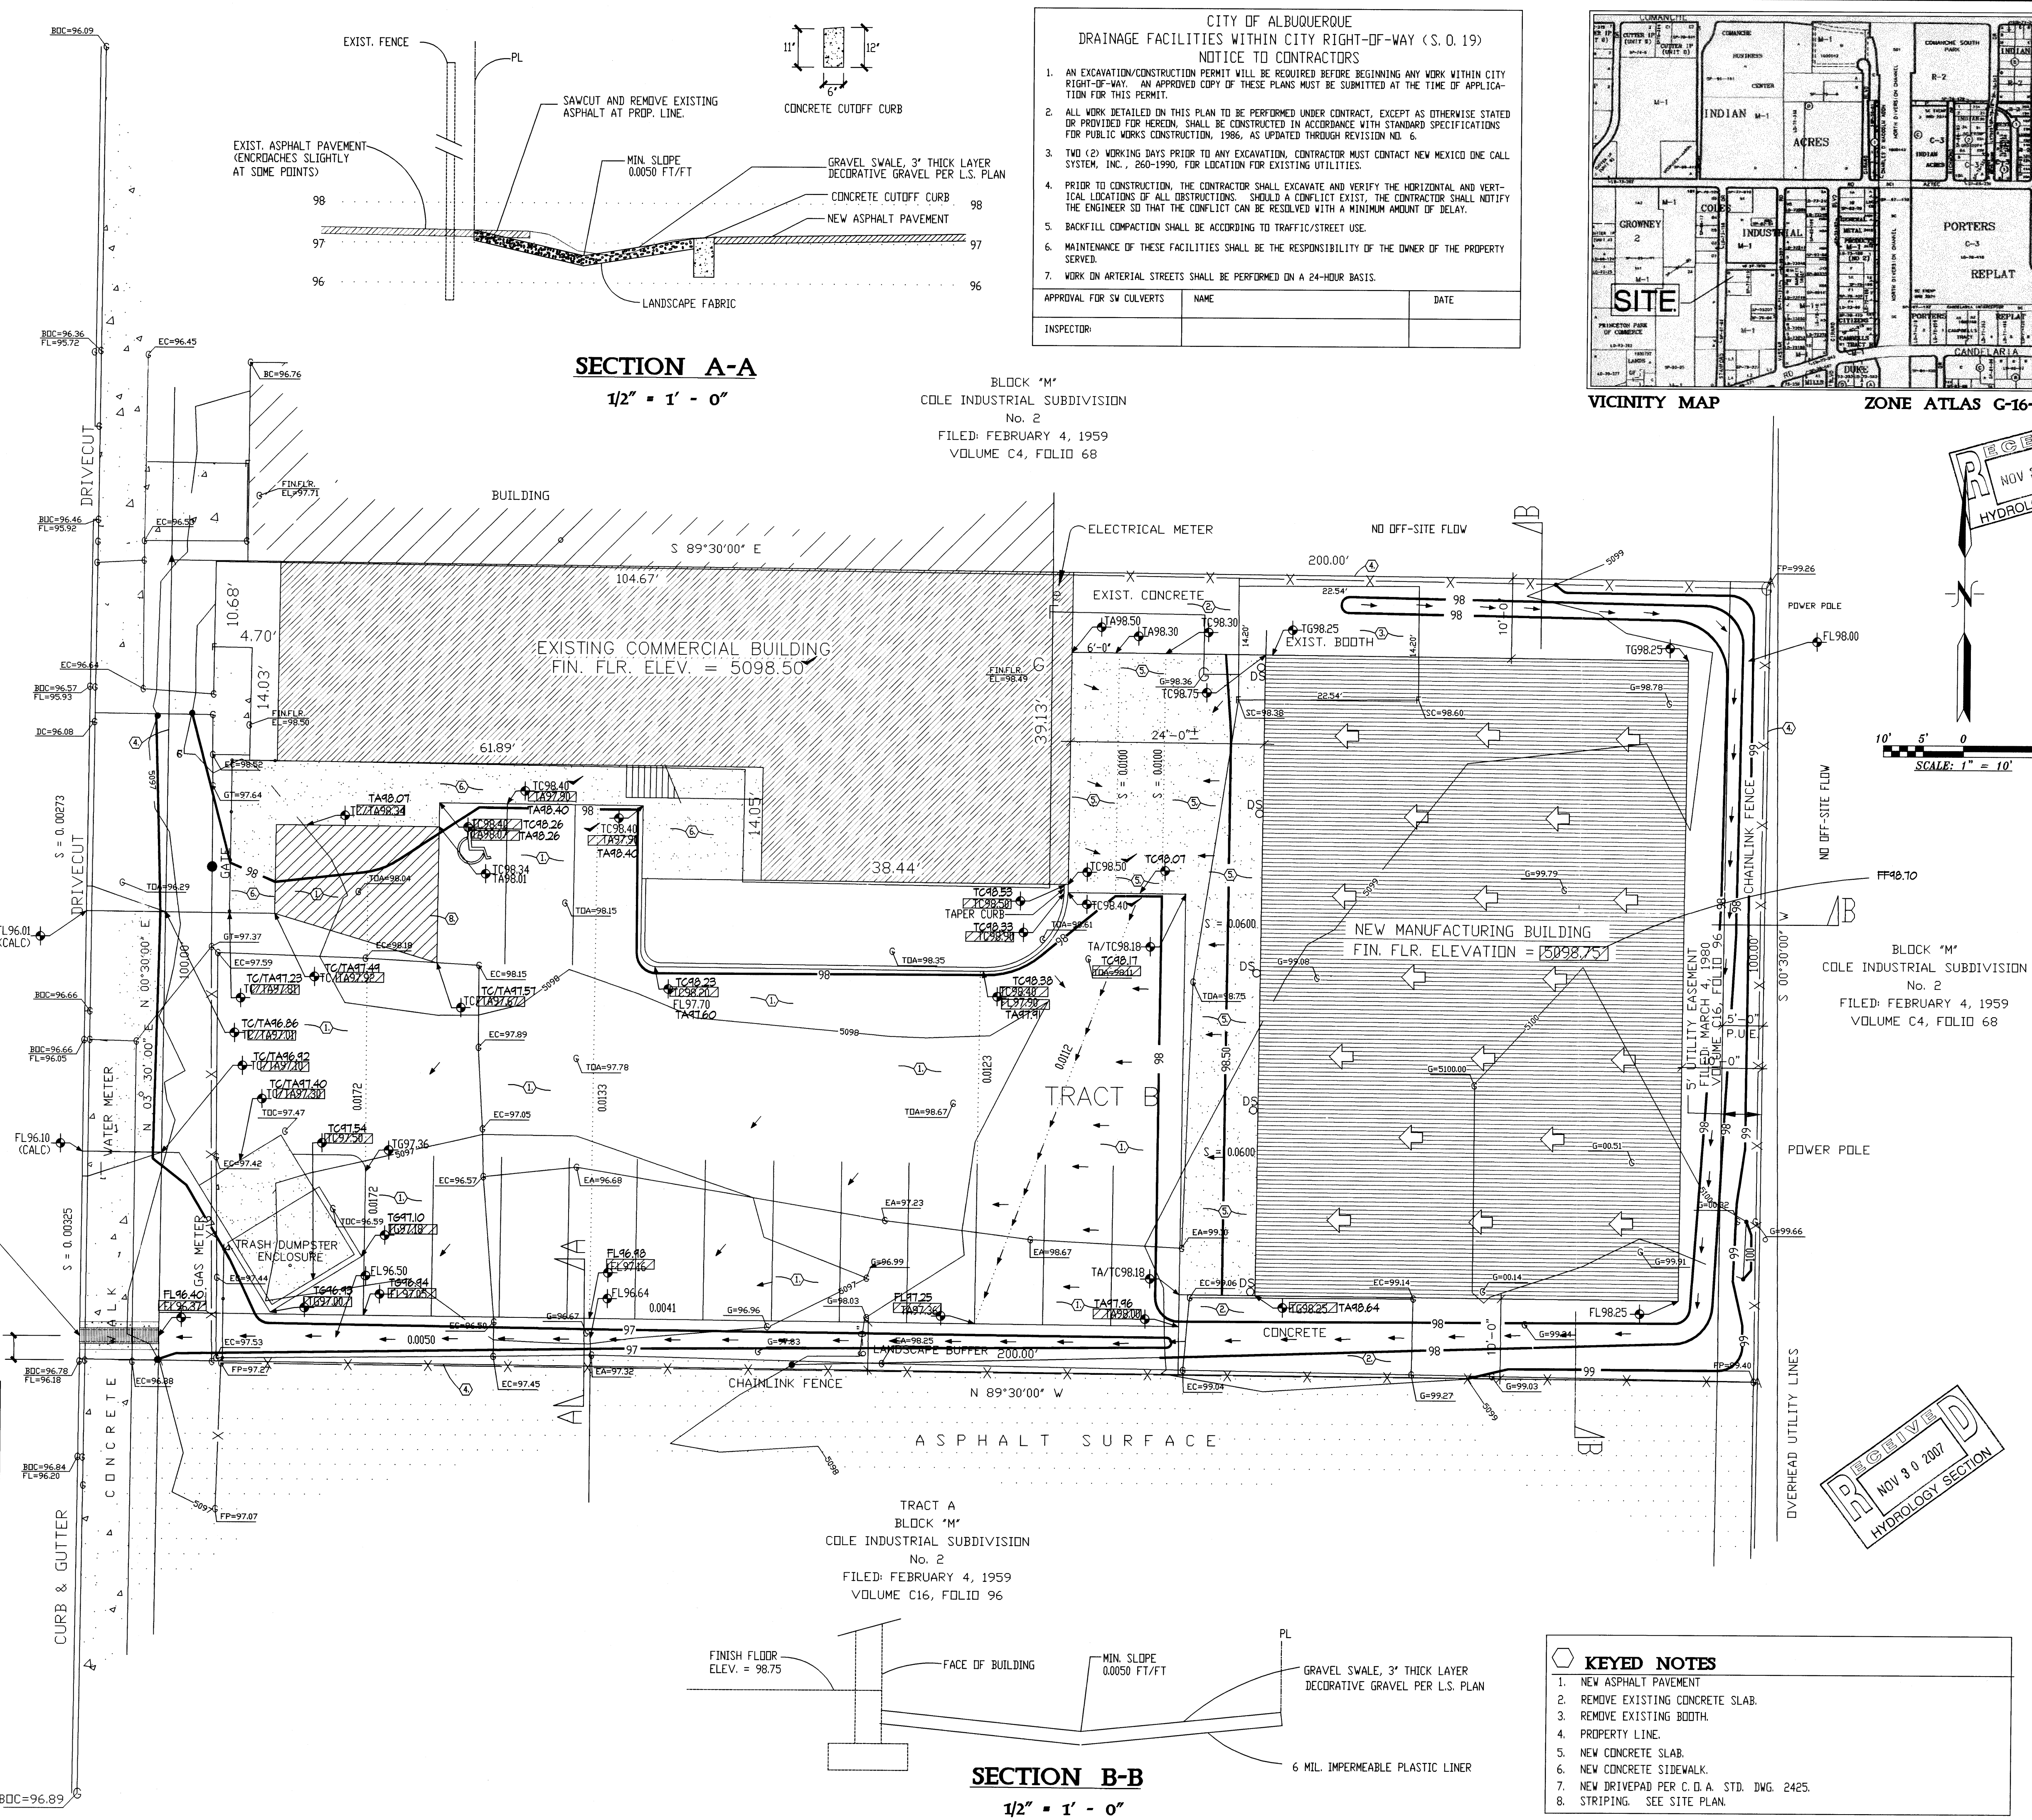

CITY OF ALBUQUERQUE
DRAINAGE FACILITIES WITHIN CITY RIGHT-OF-WAY (S.O. 19)
NOTICE TO CONTRACTORS

- AN EXCAVATION/CONSTRUCTION PERMIT WILL BE REQUIRED BEFORE BEGINNING ANY WORK WITHIN CITY RIGHT-OF-WAY. AN APPROVED COPY OF THESE PLANS MUST BE SUBMITTED AT THE TIME OF APPLICATION FOR THIS PERMIT.
- ALL WORK DETAILED IN THIS PLAN TO BE PERFORMED UNDER CONTRACT, EXCEPT AS OTHERWISE STATED OR PROVIDED FOR HEREIN, SHALL BE CONSTRUCTED IN ACCORDANCE WITH STANDARD SPECIFICATIONS FOR PUBLIC WORKS CONSTRUCTION, 1986, AS UPDATED THROUGH REVISION NO. 6.
- TWO (2) WORKING DAYS PRIOR TO ANY EXCAVATION, CONTRACTOR MUST CONTACT NEW MEXICO ONE CALL SYSTEM, INC., 860-1990, FOR LOCATION FOR EXISTING UTILITIES.
- PRIOR TO CONSTRUCTION, THE CONTRACTOR SHALL EXCAVATE AND VERIFY THE HORIZONTAL AND VERTICAL LOCATIONS OF ALL OBSTRUCTIONS. SHOULD A CONFLICT EXIST, THE CONTRACTOR SHALL NOTIFY THE ENGINEER SO THAT THE CONFLICT CAN BE RESOLVED WITH A MINIMUM AMOUNT OF DELAY.
- BACKFILL COMPACTION SHALL BE ACCORDING TO TRAFFIC/STREET USE.
- MAINTENANCE OF THESE FACILITIES SHALL BE THE RESPONSIBILITY OF THE OWNER OF THE PROPERTY SERVED.
- WORK ON ARTERIAL STREETS SHALL BE PERFORMED ON A 24-HOUR BASIS.

APPROVAL FOR SW CULVERTS	NAME	DATE
INSPECTOR		

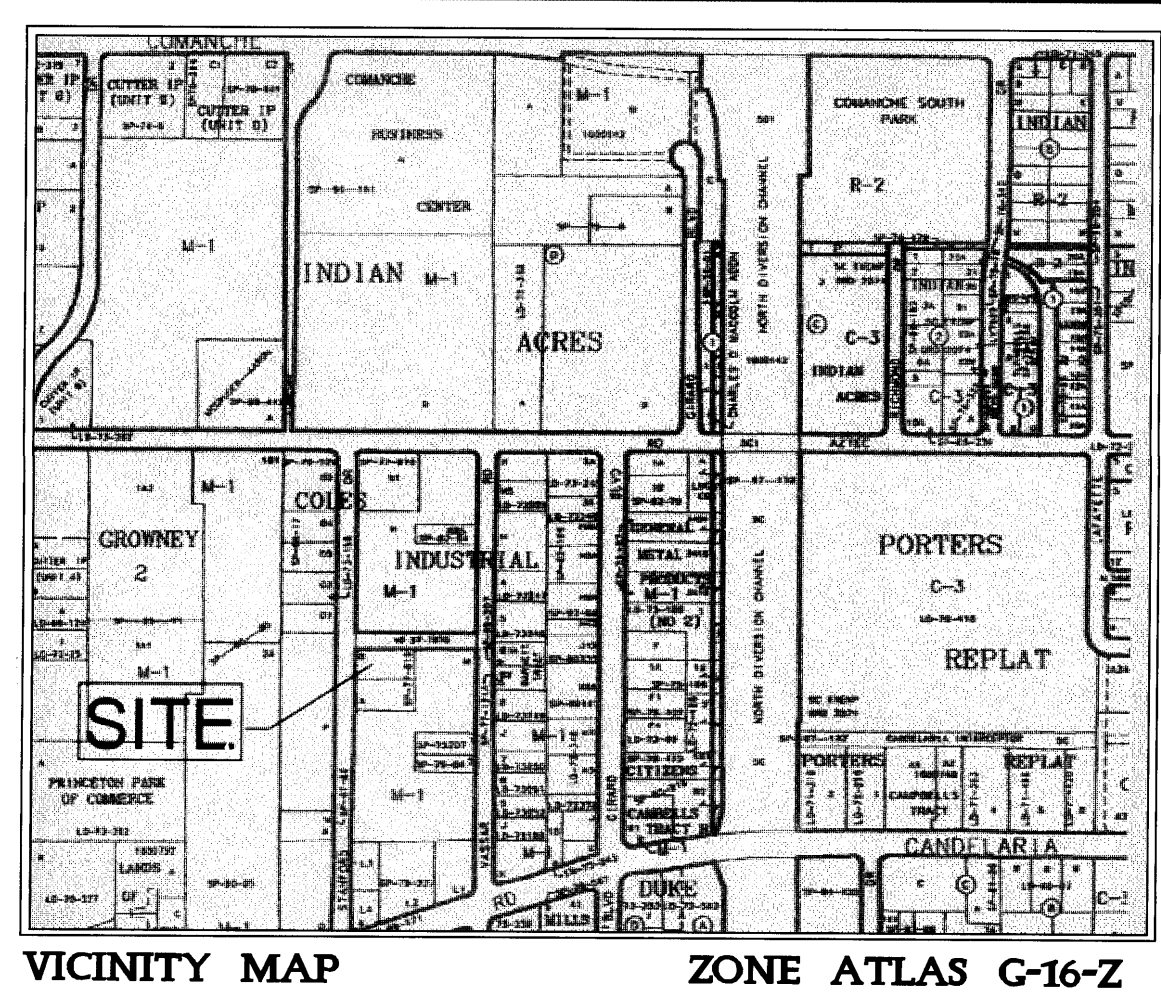

FRANK D. LOVELADY
NMPE 6512
JUNE 9, 2006
REVISED 11/30/2007

GRADING AND DRAINAGE PLAN
ARRAY TECHNOLOGIES INC.
3312 STANFORD DRIVE NE
ALBUQUERQUE, NEW MEXICO

FRANK D. LOVELADY, P.E.
(505) 345-2267 • Fax (505) 345-2015 • 300 ALAMOSA RD. NW • Albuquerque, NM • 87107

JOB NO:	699
DATE:	November 30, 2007
REVISIONS	

SHEET NO.
1 OF 1