

VICINITY MAP
NOT TO SCALE

A CHILD'S PLAYGROUND DRAINAGE & GRADING PLAN 3305 ALTAMONTE AVENUE NE ALBUQUERQUE, NEW MEXICO

DRAINAGE AND GRADING PLAN FOR A CHILD'S PLAYGROUND

LEGAL DESCRIPTION: LOT 8A AND 9A INDIAN ACRES SUBDIVISION
ADDRESS: NW corner, Tulane and Altamonte NE, (3305 Altamonte NE)
Zone Atlas G-16

FLOODPLAIN INFORMATION: The property is located in Zone X, areas outside the 500-year flood, according to the Floodway Boundary and Floodway Map of the City of Albuquerque, New Mexico, Community Panel 35001C0351 D, effective September 20, 1996.

EXISTING CONDITIONS: The subject property contains an area of approximately one acre. An existing building which is presently used as a day-care center, has asphalt-paved parking lot in front (south) and asphalt-paved drive areas on its north and east sides. About a third of the property is unpaved.

The property is bounded on the south by Alta Monte Ave. (paved, curb and gutter and sidewalk), on the west by existing apartments, on the north by existing residences, and on the east by Tulane Ave. (paved, curb and gutter, sidewalk).

OFFSITE RUN-OFF: The site receives no offsite flows.

PROPOSED IMPROVEMENTS: A building with a roof area of approximately 1,080 square feet will be built. The impervious area (1,080 SF of roof) that will be created by the proposed building addition will replace an equal amount of impervious area (1,080 SF of asphalt). An additional benefit of the proposed improvement is the creation of landscape strips which will decrease the site runoff rate and volume.

CALCULATIONS:

Existing Conditions:
Land Treatment A = 0
Land Treatment B = 0
Land Treatment C = 17,715 SF = 0.41 Ac.
Land Treatment D = 27,225 SF = 0.63 Ac.
TOTAL 1.04 Acres

Proposed Improvement:
Land Treatment A = 0
Land Treatment B = 4,000 SF = 0.10 Ac.
Land Treatment C = 17,715 SF = 0.41 Ac.
Land Treatment D = 23,225 SF = 0.53 Ac.

Zone 2 (From DPM 22.2, page A-1)

Existing Condition:
Peak Discharge, 100-year: C = 3.14, D = 4.70 (DPM 22.2, A-9)
 $Q_{100} = (0.41 \times 3.14) + (0.63 \times 4.70) = 4.24 \text{ cfs}$

Volume of Runoff, Excess Precipitation
100-year: C = 1.13, D = 2.12 (from DPM 22.2, A-7)
 $V_{100} = (0.41 \times 1.13 \times 43,560/12) + (0.63 \times 2.12 \times 43,560/12) = 6,529 \text{ cf}$

Proposed Improvement:
Peak Discharge, 100-year:
Land Treatment B, 100-year: 2.28 cfs
Land Treatment C, 100-year: 3.14 cfs
Land Treatment D, 100-year: 4.70 cfs

$Q_{100} = (0.10 \times 2.28) + (0.41 \times 3.14) + (0.53 \times 4.70) = 3.99 \text{ cfs}$
Volume of Runoff, 100-year:
Excess Precipitation, Land Treatment B = 0.78
Excess Precipitation, Land Treatment C = 1.13
Excess Precipitation, Land Treatment D = 2.12
 $V_{100} = (0.10 \times 0.78 \times 43,560/12) + (0.41 \times 1.13 \times 43,560/12) + (0.53 \times 2.12 \times 43,560/12) = 6,015 \text{ cf}$

Change:
Discharge, $Q_{100} = 4.24 - 3.99 = 0.25 \text{ cfs (decrease)}$
Volume, $V_{100} = 6,529 - 6,015 = 514 \text{ cf (decrease)}$


EROSION CONTROL: Water, if any, from activities during construction and/or from rain will be temporarily ponded on site to prevent the spread of silt.

CONCLUSION: The grading and drainage plan for the proposed construction on the subject property will not have any adverse impact on or will be adversely affected by the existing drainage from the surrounding areas.

###

LEGEND

- 21 — EXISTING CONTOUR LINE
- 21 — PROPOSED CONTOUR LINE
- EXISTING OVERHEAD LINE
- 1908' TA EXISTING TOP OF ASPHALT ELEVATION
- 1841' EXISTING SPOT ELEVATION
- 1908' TC EXISTING TOP OF CURB ELEVATION
- 1841' FL EXISTING FLOWLINE ELEVATION
- PROPOSED LANDSCAPE AREA
- TA 21.65 PROPOSED SPOT ELEVATION TOP OF ASPHALT
- TC 22.20 PROPOSED TOP OF CURB ELEVATION
- FL 21.70 PROPOSED FLOWLINE ELEVATION
- PROPOSED DIRECTION OF FLOW

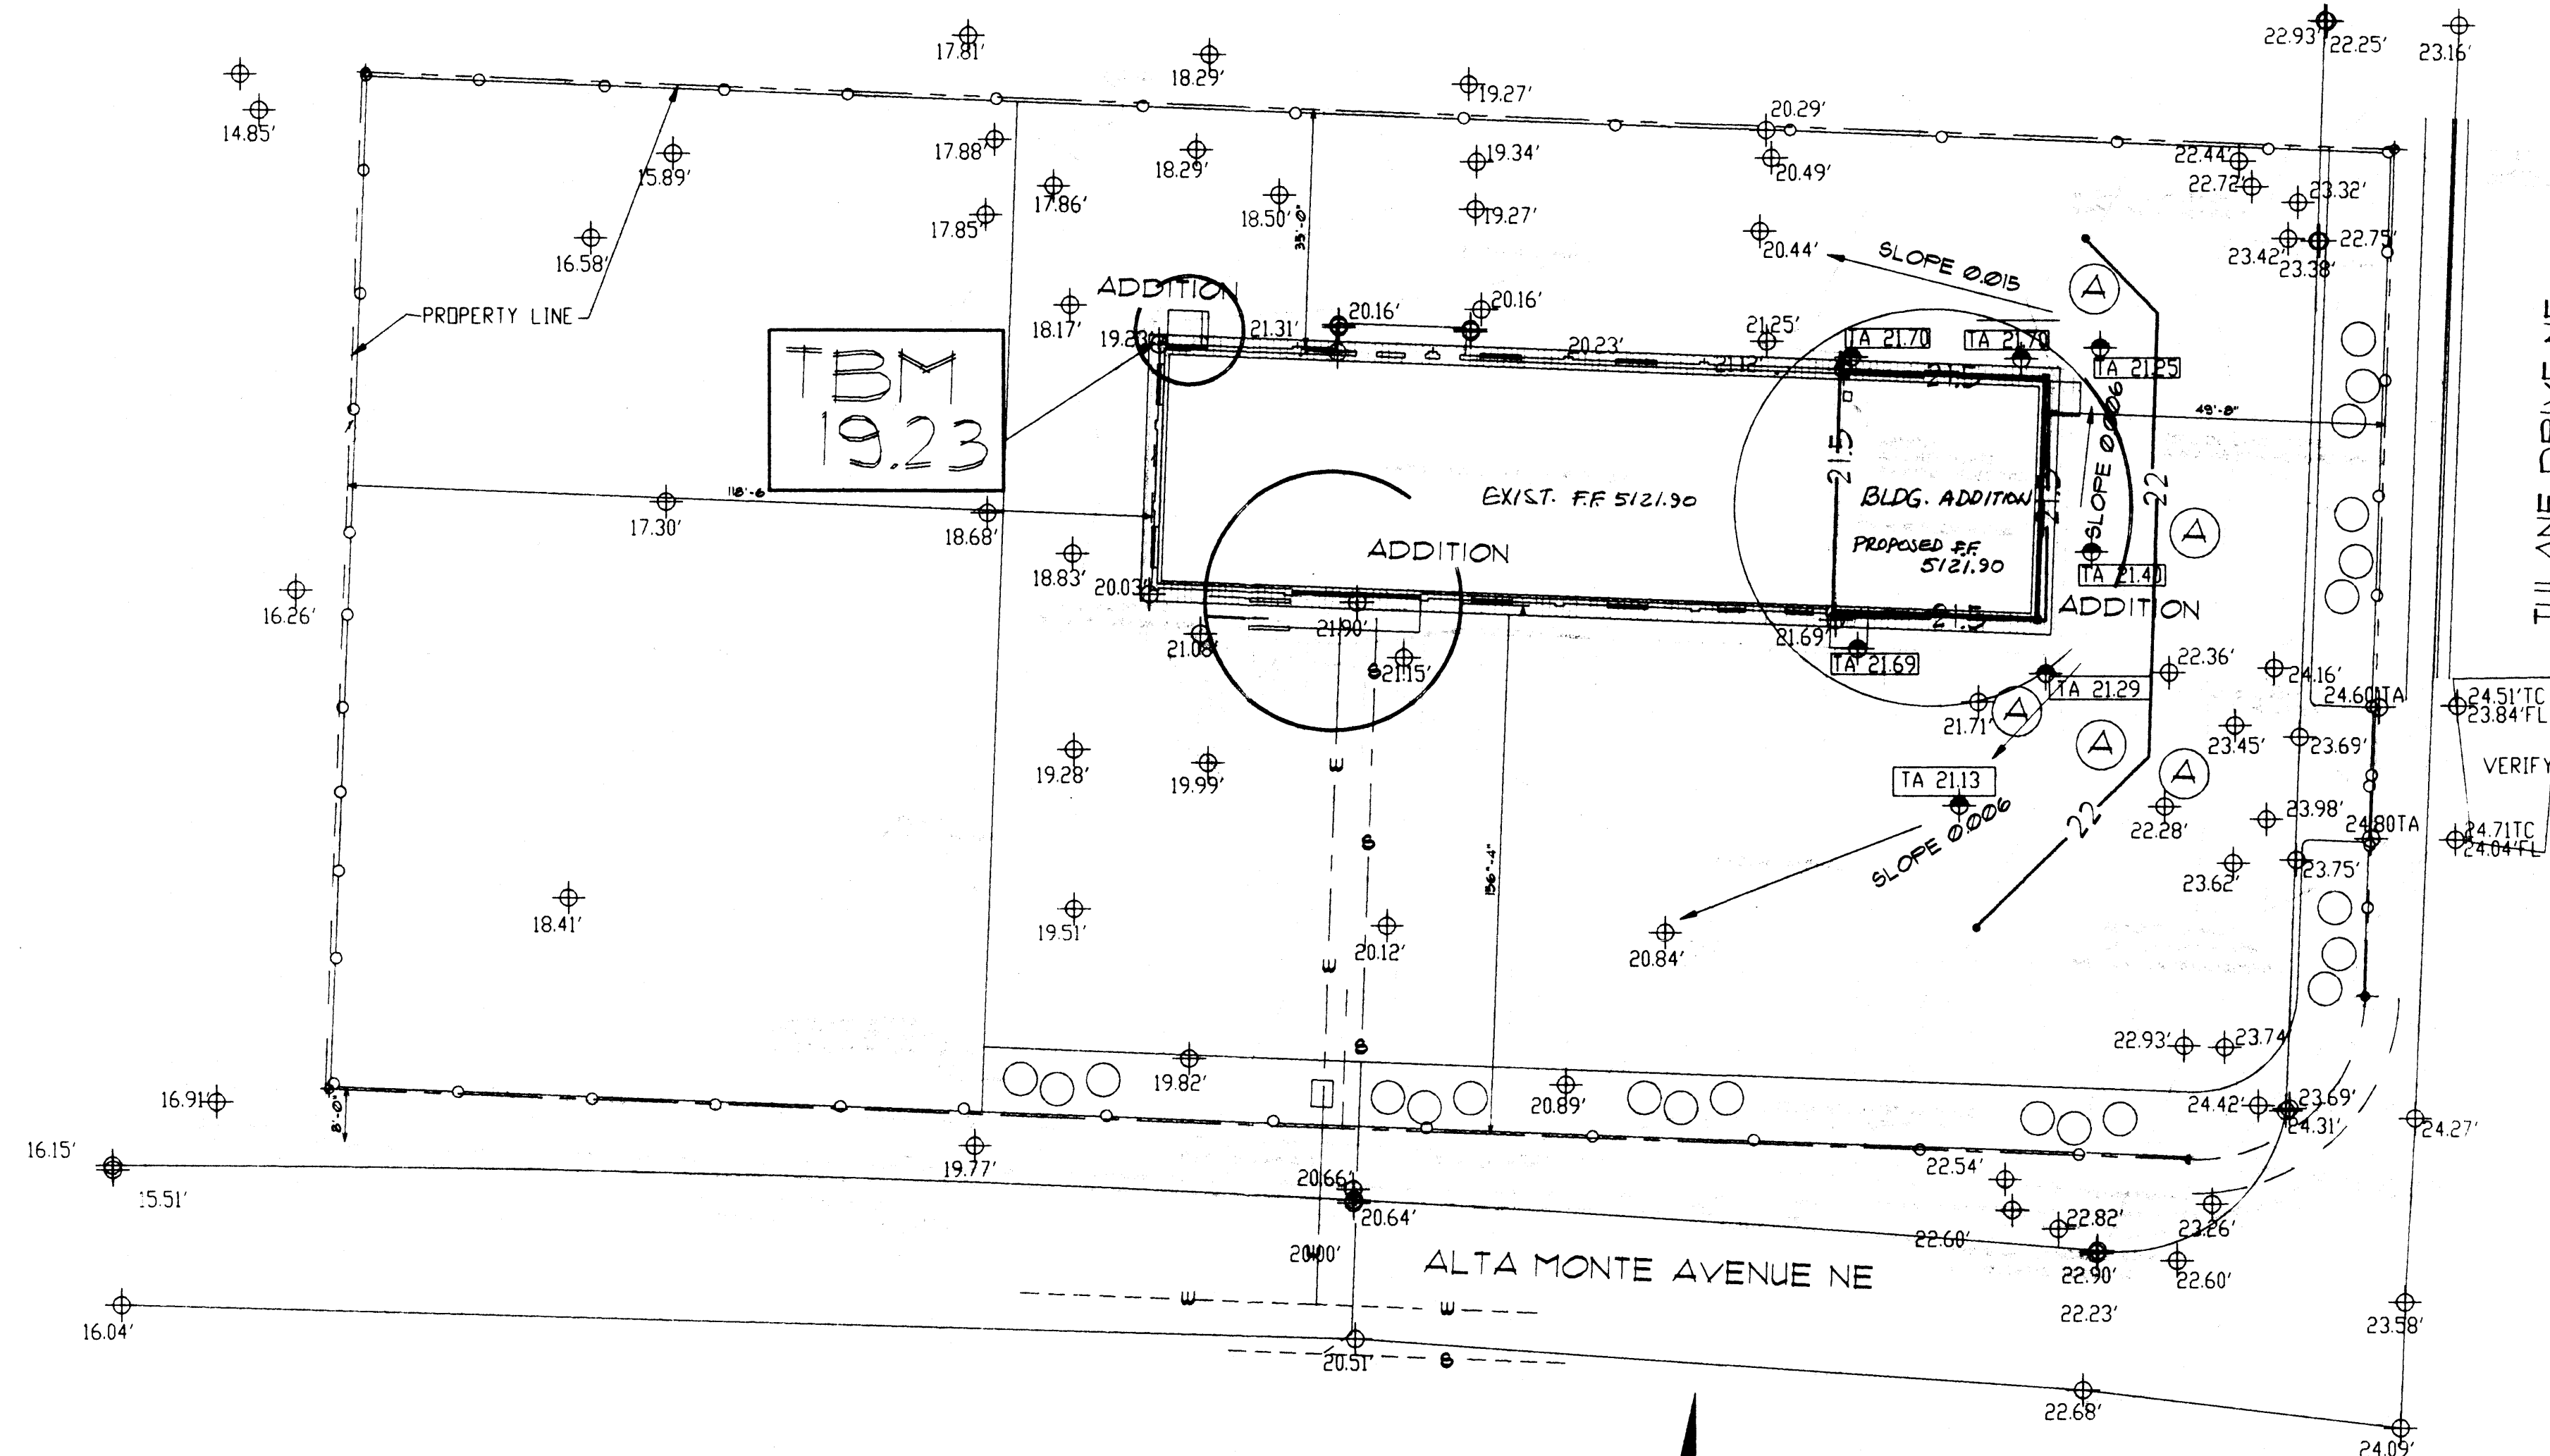

TBM: NW CORNER OF BUILDING ELEVATION 19.23

BENCHMARK: 1-G17 ELEVATION 5,130.10




NOTE:

1. THIS IS NOT A BOUNDARY SURVEY. APPARENT PROPERTY CORNERS ARE SHOWN FOR ORIENTATION ONLY.
2. UNDERGROUND UTILITIES SHOWN HEREON ARE BASED ON MAPS. THE CONTRACTOR SHALL BE RESPONSIBLE FOR VERIFYING LOCATIONS OF ALL UTILITIES, SHOWN OR NOT SHOWN ON THIS DRAWING, PRIOR TO ANY EXCAVATIONS.
3. CONTRACTOR IS RESPONSIBLE FOR OBTAINING A TOPSOIL DISTURBANCE PERMIT PRIOR TO BEGINNING WORK.
4. CONTRACTOR IS RESPONSIBLE FOR KEEPING RUN-OFF ON SITE DURING CONSTRUCTION AND CLEANING UP SEDIMENT THAT GETS INTO EXISTING RIGHT-OF-WAY AND ADJOINING PROPERTIES AFTER CONSTRUCTION.

KEYED NOTES:

- ④ REMOVE AND REPLACE ASPHALT PAVEMENT AS NECESSARY FOR SMOOTH RIDING TRANSITION.

A CHILD'S PLAYGROUND 3305 ALTAMONTE AVENUE NE DRAINAGE & GRADING PLAN

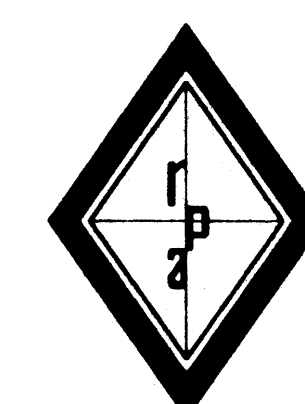

RHOMBUS P.A., INC.

FACILITIES ENGINEERS & ENVIRONMENTAL CONSULTANTS
2620 San Mateo NE SUITE B
Albuquerque, NM 87110

TEL. (505) 881-6690 FAX (505) 881-6896

Ante
4/13/98

A CHILD'S PLAYGROUND DRAINAGE & GRADING PLAN 3305 ALTAMONTE AVENUE NE ALBUQUERQUE, NEW MEXICO

DRAINAGE AND GRADING PLAN FOR A CHILD'S PLAYGROUND

LEGAL DESCRIPTION: LOT 8A AND 9A INDIAN ACRES SUBDIVISION

ADDRESS: NW corner, Tulane and Altamonte NE, (3305 Altamonte NE)

Zone Atlas G-16

FLOODPLAIN INFORMATION: The property is located in Zone X, areas outside the 500-year flood, according to the Floodway Boundary and Floodway Map of the City of Albuquerque, New Mexico, Community Panel 35001C0351 D, effective September 20, 1996.

EXISTING CONDITIONS: The subject property contains an area of approximately one acre. An existing building which is presently used as a day-care center, has asphalt-paved parking lot in front (south) and asphalt-paved drive areas on its north and east sides. About a third of the property is unpaved.

The property is bounded on the south by Alta Monte Ave. (paved, curb and gutter and sidewalk); on the west by existing apartments, on the north by existing residences, and on the east by Tulane Ave. (paved, curb and gutter, sidewalk).

OFFSITE RUN-OFF: The site receives no offsite flows.

PROPOSED IMPROVEMENTS: A building with a roof area of approximately 1,080 square feet will be built. The impervious area (1,080 SF of roof) that will be created by the proposed building addition will replace an equal amount of impervious area (1,080 SF of asphalt). An additional benefit of the proposed improvement is the creation of landscape strips which will decrease the site runoff rate and volume.

CALCULATIONS:

Existing Conditions:

Land Treatment A = 0
Land Treatment B = 0
Land Treatment C = 17,715 SF = 0.41 Ac.
Land Treatment D = 27,225 SF = 0.63 Ac.
TOTAL 1.04 Acres

Proposed Improvement:

Land Treatment A = 0
Land Treatment B = 4,000 SF = 0.10 Ac.
Land Treatment C = 17,715 SF = 0.41 Ac.
Land Treatment D = 23,225 SF = 0.53 Ac.

Zone 2 (From DPM 22.2, page A-1)

Existing Condition:

Peak Discharge, 100-year: C = 3.14, D = 4.70 (DPM 22.2, A-9)
 $Q_{100} = (0.41 \times 3.14) + (0.63 \times 4.70) = 4.24 \text{ cfs}$

Volume of Runoff,

Excess Precipitation
100-year: C = 1.13, D = 2.12 (from DPM 22.2, A-7)

$V_{100} = (0.41 \times 1.13 \times 43,560/12) + (0.63 \times 2.12 \times 43,560/12) = 6,529 \text{ cf}$

Proposed Improvement:

Peak Discharge, 100-year:
Land Treatment B, 100-year: 2.28 cfs
Land Treatment C, 100-year: 3.14 cfs
Land Treatment D, 100-year: 4.70 cfs

$Q_{100} = (0.10 \times 2.28) + (0.41 \times 3.14) + (0.53 \times 4.70) = 3.99 \text{ cfs}$

Volume of Runoff, 100-year:

Excess Precipitation, Land Treatment B = 0.78

Excess Precipitation, Land Treatment C = 1.13

Excess Precipitation, Land Treatment D = 2.12

$V_{100} = (0.10 \times 0.78 \times 43,560/12) + (0.41 \times 1.13 \times 43,560/12) + (0.53 \times 2.12 \times 43,560/12) = 6,015 \text{ cf}$

Change:


Discharge, $Q_{100} = 4.24 - 3.99 = 0.25 \text{ cfs (decrease)}$

Volume, $V_{100} = 6,529 - 6,015 = 514 \text{ cf (decrease)}$

EROSION CONTROL: Water, if any, from activities during construction and/or from rain will be temporarily ponded on site to prevent the spread of silt.

CONCLUSION: The grading and drainage plan for the proposed construction on the subject property will not have any adverse impact on or will be adversely affected by the existing drainage from the surrounding areas.


###

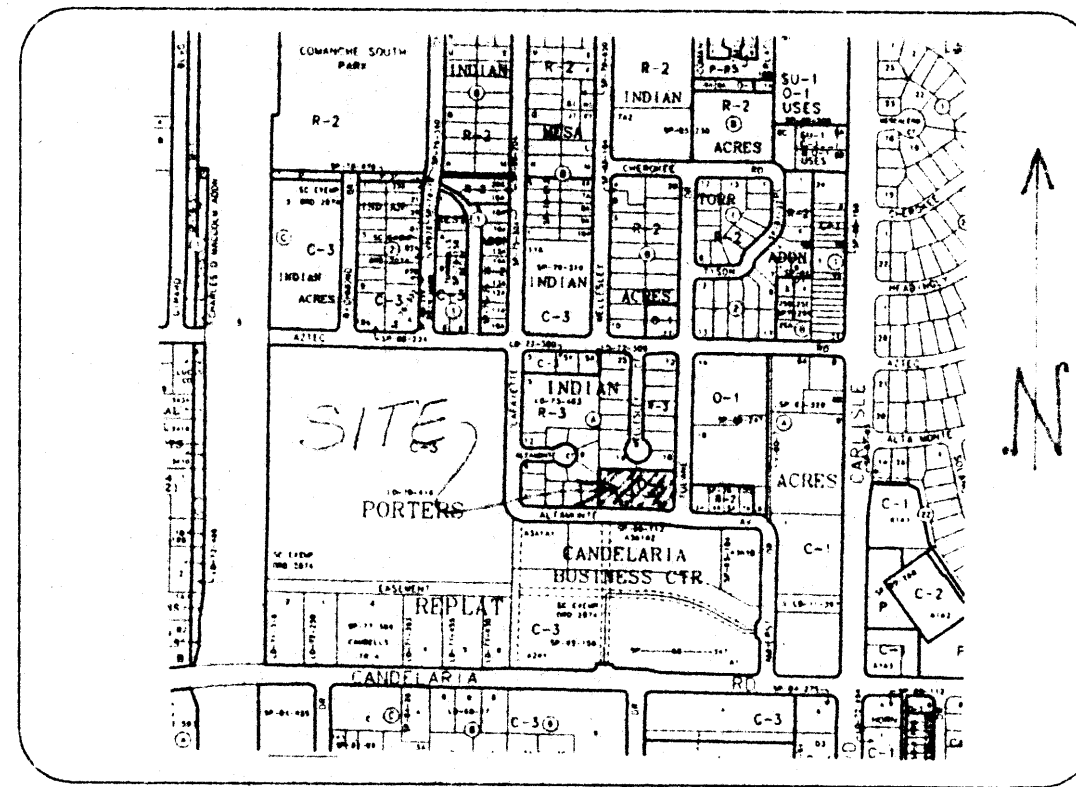

VICINITY MAP
NOT TO SCALE


LEGEND

- EXISTING CONTOUR LINE
- 21 PROPOSED CONTOUR LINE
- EXISTING OVERHEAD LINE
- 19.08' TA EXISTING TOP OF ASPHALT ELEVATION
- 18.41' EXISTING SPOT ELEVATION
- 19.08' TC EXISTING TOP OF CURB ELEVATION
- 18.41' FL EXISTING FLOWLINE ELEVATION
- PROPOSED LANDSCAPE AREA
- TA 21.65 PROPOSED SPOT ELEVATION TOP OF ASPHALT
- TC 22.20 PROPOSED TOP OF CURB ELEVATION
- FL 21.70 PROPOSED FLOWLINE ELEVATION
- PROPOSED DIRECTION OF FLOW
- AS BUILT SPOT ELEVATION

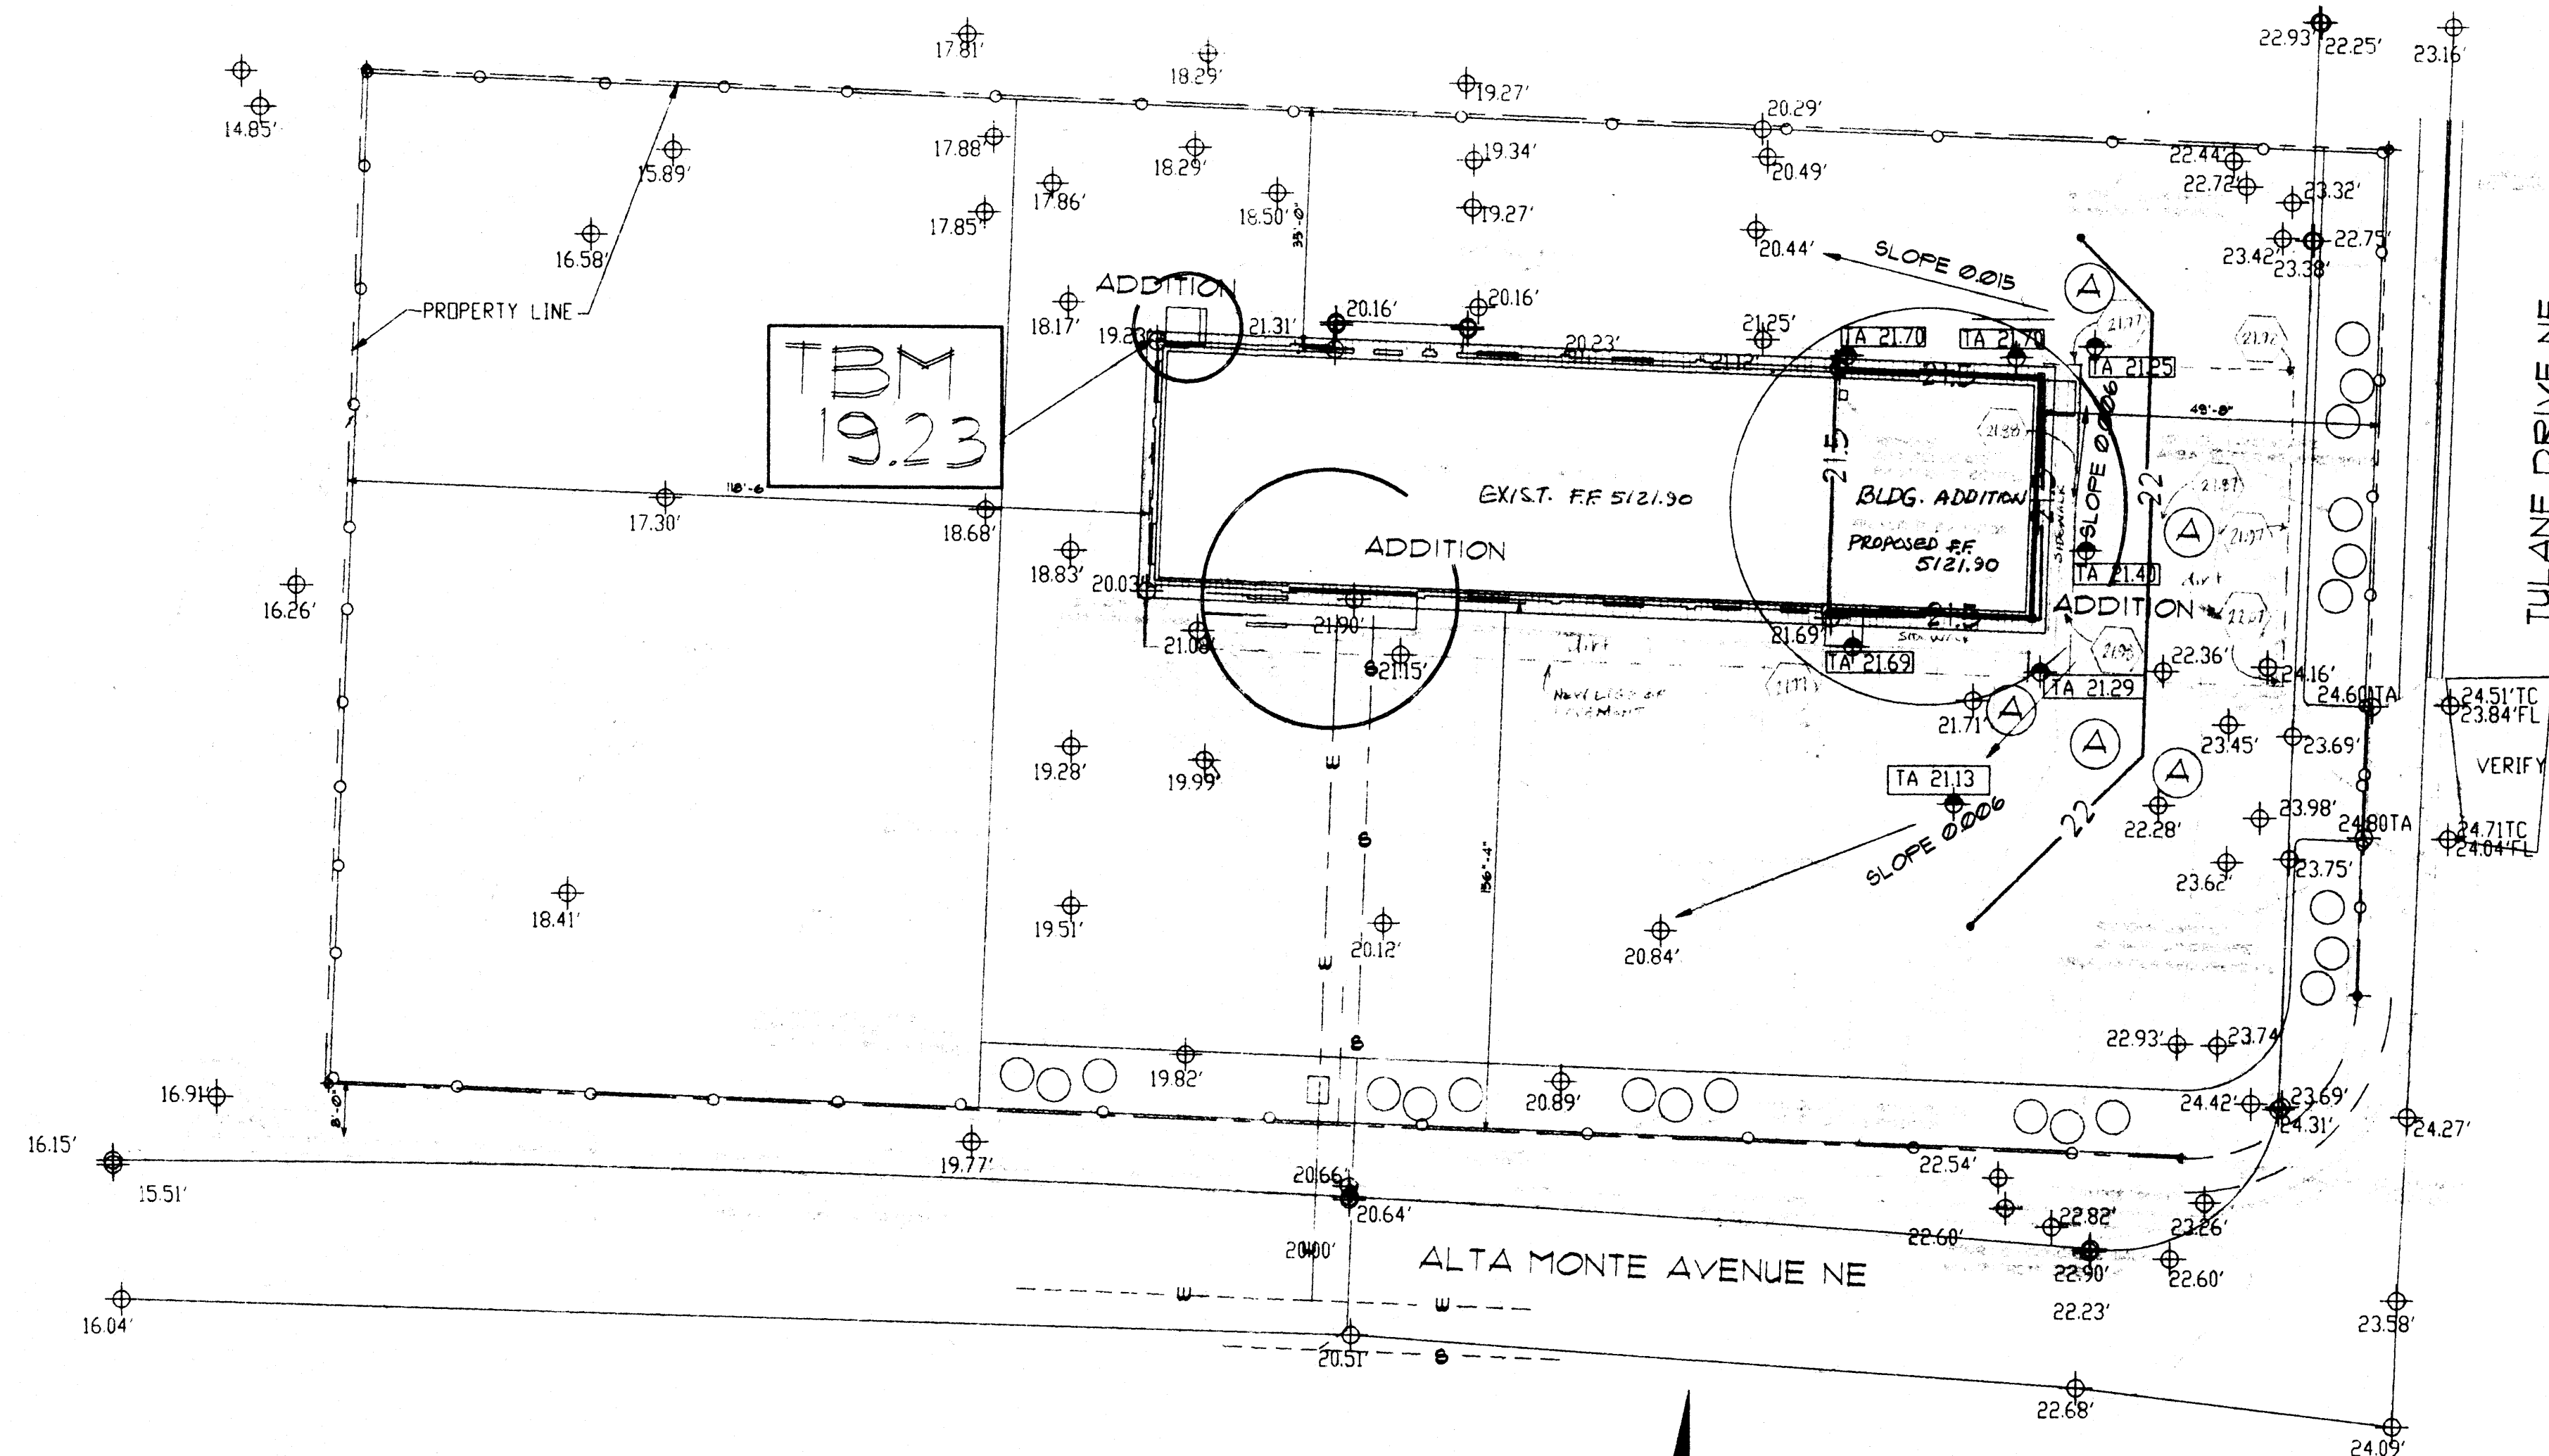

TBM: NW CORNER OF BUILDING ELEVATION 19.23

BENCHMARK: 1-G17 ELEVATION 5,130.10

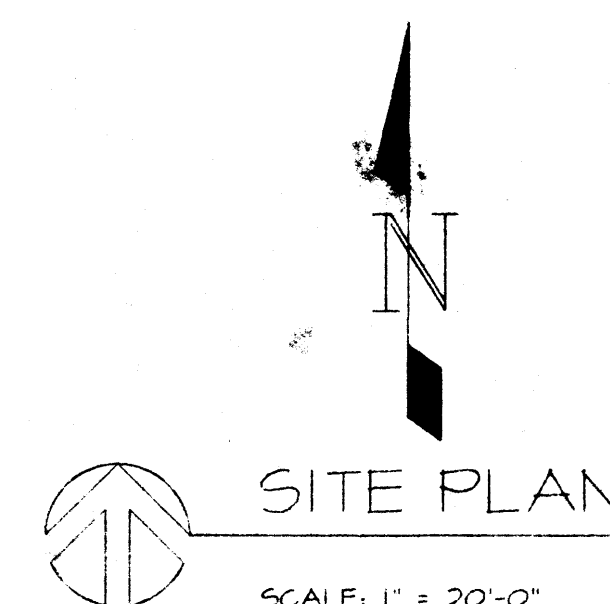

SITE PLAN

SCALE: 1" = 20'-0"

NOTE:

1. THIS IS NOT A BOUNDARY SURVEY. APPARENT PROPERTY CORNERS ARE SHOWN FOR ORIENTATION ONLY.
2. UNDERGROUND UTILITIES SHOWN HEREON ARE BASED ON MAPS. THE CONTRACTOR SHALL BE RESPONSIBLE FOR VERIFYING LOCATIONS OF ALL UTILITIES, SHOWN OR NOT SHOWN ON THIS DRAWING, PRIOR TO ANY EXCAVATIONS.
3. CONTRACTOR IS RESPONSIBLE FOR OBTAINING A TOPSOIL DISTURBANCE PERMIT PRIOR TO BEGINNING WORK.
4. CONTRACTOR IS RESPONSIBLE FOR KEEPING RUN-OFF ON SITE DURING CONSTRUCTION AND CLEANING UP SEDIMENT THAT GETS INTO EXISTING RIGHT-OF-WAY AND ADJOINING PROPERTIES AFTER CONSTRUCTION.


KEYED NOTES:

- (A) REMOVE AND REPLACE ASPHALT PAVEMENT AS NECESSARY FOR SMOOTH RIDING TRANSITION.

ENGINEER'S CERTIFICATION:

I HEREBY CERTIFY THAT THE SUBJECT FACILITY WAS CONSTRUCTED IN SUBSTANTIAL COMPLIANCE WITH THE APPROVED DRAINAGE AND GRADING PLAN.


James L. Hewitt, Jr. 02/17/99
JAMES L. HEWITT, JR., P.E. #6871 DATE

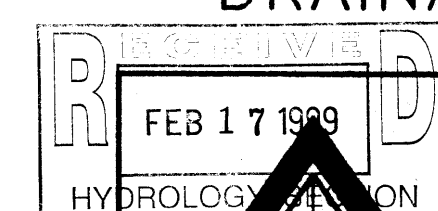

RHOMBUS P.A., INC.

FACILITIES ENGINEERS & ENVIRONMENTAL CONSULTANTS
2620 San Mateo NE SUITE B
Albuquerque, NM 87110

TEL. (505) 881-6690 FAX (505) 881-6896

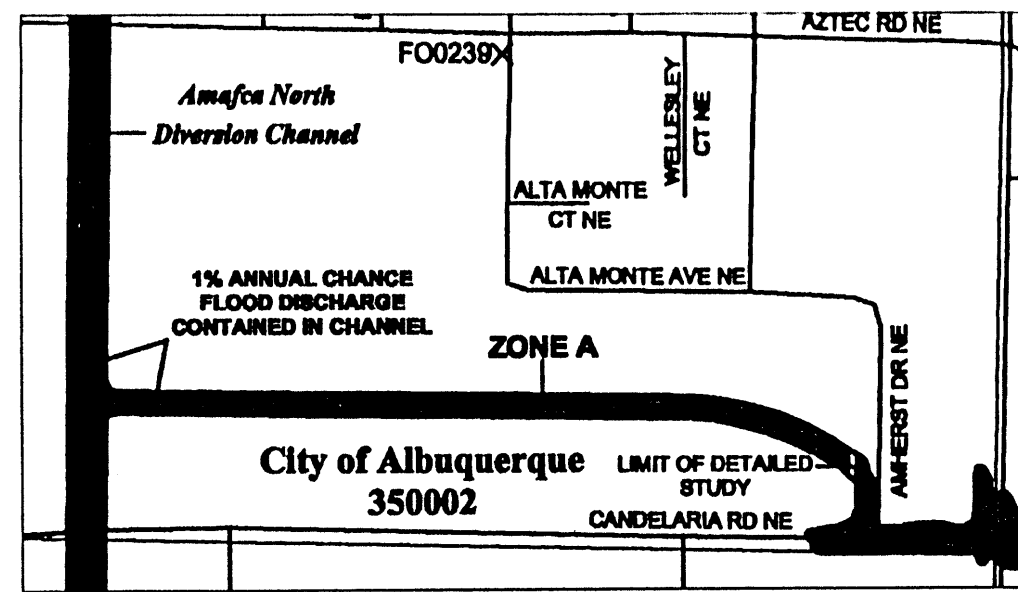

FIRM MAP PANEL # 351 F

GRADING & DRAINAGE PLAN


THE PROPOSED DAY-CARE EXPANSION PROJECT IS LOCATED IN THE CANDELARIA-125 COMMERCIAL AREA OF THE CITY OF ALBUQUERQUE. THE GRADING AND DRAINAGE SCHEME HEREON IS IN COMPLIANCE WITH THE BERNALILLO COUNTY FLOOD HAZARD ORDINANCE, NO.88-46, AND THE CITY STORM DRAINAGE ORDINANCE. THE PLAN IS REQUIRED IN ORDER TO FACILITATE THE OWNER'S REQUEST FOR BUILDING PERMIT. THE PLAN SHOWS:

1. EXISTING CONTOURS, AND SPOT ELEVATIONS AND EXISTING DRAINAGE PATTERNS AND IMPROVEMENTS, AND EXISTING STREET.
2. PROPOSED IMPROVEMENTS: A 4000 SF BUILDING, PRIVATE ASPHALT DRIVEWAY AND PARKING, NEW GRADE ELEVATIONS, DRAINAGE, AND LANDSCAPING COMPLIANCE IMPROVEMENTS/UPGRADING.
3. CONTINUITY BETWEEN EXISTING AND PROPOSED ELEVATIONS.
4. QUANTIFICATION OF DEVELOPED FLOWS GENERATED BY THE IMPROVEMENTS WHICH CONTRIBUTE TO THE EXISTING FLOWS.

PRESENTLY, THE SITE IS ESTABLISHED AND USED AS A DEVELOPED ANCIALLY PLAYGROUND AREA FOR THE EXISTING FACILITY TO THE EAST. THE PLAYGROUND CURRENTLY IS 2/3 GRAVEL SURFACING LOCATED IN THE SOUTHERN AREA. THE SITE IS BOUNDED BY DEVELOPED MULTI-FAMILY ON THE NORTH /COMMERCIAL PROPERTY TO THE WEST. ALTA MONTE AVE. ON THE SOUTH IS A 40 FEET WIDE PAVED CITY MAINTAINED LOCAL STREET WITH SIDEWALK. THE SITE TERRAIN SLOPES FROM EAST TO NORTHWEST AT 5%.

THE SITE IS NOT WITHIN OR ADJACENT TO A DESIGNATED FEMA FLOOD HAZARD ZONE. DEVELOPED LOT RUNOFF WILL BE PERMITTED TO DRAIN TO THE STREET. FREE DISCHARGE OF PROJECT RUNOFF IS ACCEPTABLE SINCE DOWNSTREAM DRAINAGE FACILITIES EXIST. A PORTION OF SITE RUNOFF IS ROUTED THROUGH PROPOSED LANDSCAPING AS POINT RAINFALL,SEE CALCULATIONS.

Scale: 1" = 10'

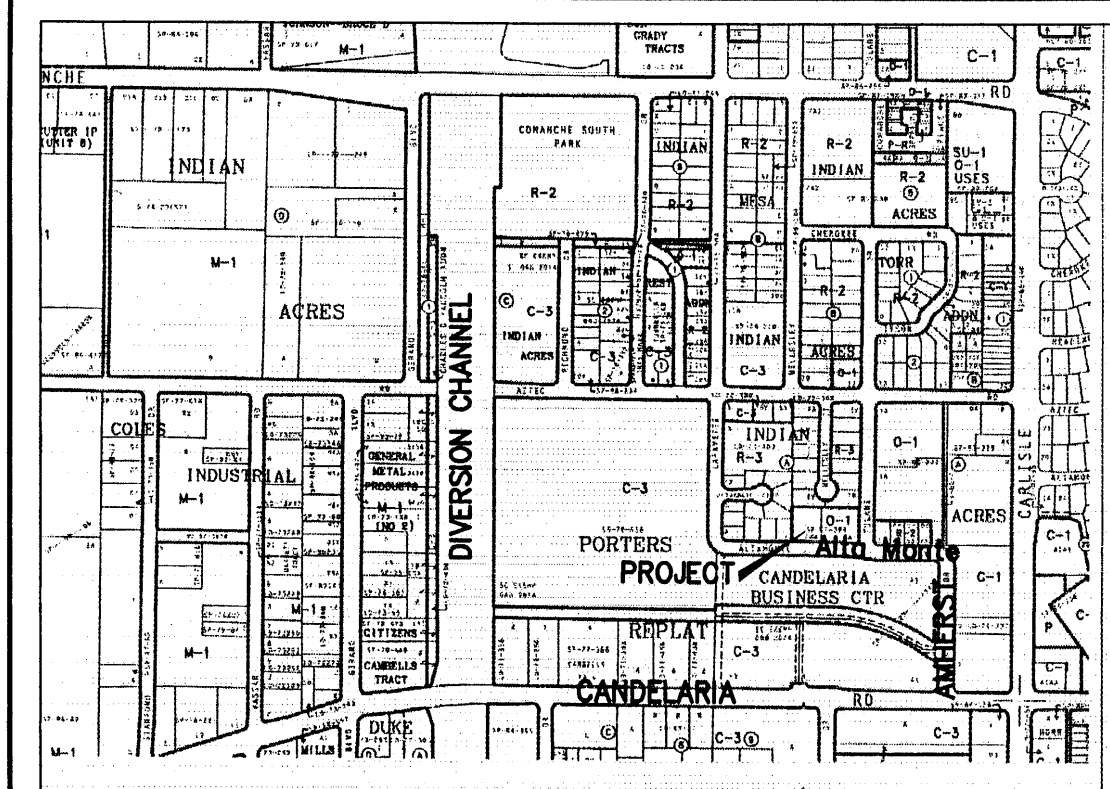

VICINITY MAP ZONE G-16

NOTES

1. ALL WORK WITHIN THE RIGHT-OF-WAY SHALL BE CONSTRUCTED IN ACCORDANCE WITH THE CITY OF ALBUQUERQUE STANDARD SPECS. FOR PUBLIC WORKS CONSTRUCTION, 7TH EDITION W/ UPDATES.
2. AN EXCAVATION/CONSTRUCTION PERMIT IS REQUIRED BEFORE BEGINNING ANY WORK WITHIN CITY R.O.W. AN APPROVED COPY OF THIS PLAN MUST BE SUBMITTED AT THE TIME OF APPLICATION.
3. ALL WORK ON THIS PROJECT SHALL BE PERFORMED IN ACCORDANCE WITH APPLICABLE FEDERAL, STATE AND LOCAL LAWS, RULES, AND REGULATIONS CONCERNING CONSTRUCTION SAFETY AND HEALTH.
4. ALL LANDSCAPING AREA SHALL BE SOFT-LINED WITH NATIVE VEGETATION AND/OR GRAVEL.
5. CONTRACTOR SHALL ENSURE THAT NO SITE SOILS/SEDIMENT OR SILT ENTER THE RIGHT-OF-WAYS DURING CONSTRUCTION.
6. REVEGETATE ALL AREAS DISTURBED DUE TO CONSTRUCTION PER CITY OF ALBUQ. SPEC. 1011, NATIVE SEED MIX.
7. MAXIMUM SITE GRADING WITHOUT EROSION PROTECTION: 3 HORIZONTAL TO 1 VERTICAL, 3:1.
8. NEW ASPHALT PAVEMENT SHALL CONSIST OF 3" ASPHALT CONCRETE OVER 6" AGGREGATE BASE COURSE ON 8" COMPACTED SUBGRADE, 95% PROCTOR, ASTM D-1557

LEGEND

- +24.0 EXIST. SPOT ELEVATION
- 10 EXIST. CONTOUR
- 24.0 NEW SPOT ELEVATION
- 54 NEW CONTOUR
- NEW SWALE
- DRAINAGE DIRECTION, EXISTING
- FL FLOWLINE
- PP EXISTING POWER POLE
- NG OR G NATURAL GROUND, EXISTING
- R/C REBAR AND CAP, EXISTING
- CLF CHAIN LINK FENCE, EXISTING
- NEW P.C.C., CONCRETE
- TG TOP OF GRATE (W/ ELEV.)

CALCULATIONS

DESIGN CRITERIA

HYDROLOGIC METHODS PER SECTION 22.2, HYDROLOGY OF THE DEVELOPMENT PROCESS MANUAL (DPM) REVISED JANUARY 1993 FOR CITY OF ALBUQUERQUE, ADOPTED BY THE COUNTY OF BERNALILLO DISCHARGE RATE: One-Peak x AREA, Peak Discharge Rates For Small Watersheds VOLUMETRIC DISCHARGE: VOLUME = E Weighted x AREA P100 = 2.35 inches, Zone 2 Time of Concentration, TC = 10 Minutes DESIGN STORM: 100-YEAR/6-HOUR, 10-YEAR/6-HOUR [] = 10 YEAR VALUES

EXISTING CONDITIONS

71% B (SAND), 29% HARDPAN 'C', LOT AREA = 0.43 ACRES, WHERE EXCESS PRECIP. 'W' = 0.88 in. [0.35] PEAK DISCHARGE, Q100 = 1.1 CFS [0.6] WHERE UNIT PEAK DISCHARGE = 2.5 CFS/AC. [1.3] THEREFORE: VOLUME 100 = 1374 CF [546]

DEVELOPED CONDITIONS (Includes Paved Parking)

DETERMINE LAND TREATMENTS, PEAK DISCHARGE AND VOLUMETRIC DISCHARGE FOR STUDY AREA

AREA	LAND TREATMENT	Q Peak	E
UNDEVELOPED	0.00 Ac.(0%)	A 1.56[0.38]	0.53[0.13]
LANDSCAPING/Depress	0.15 Ac.(35%)	B 2.28[0.95]	0.78[0.28]
GRAVEL & COMPACTED SOIL	0.05 Ac.(12%)	C 3.14[1.71]	1.13[0.52]
ROOF - PAVEMENT	0.23 Ac.(53%)	D 4.70[3.14]	2.12[1.34]


THEREFORE: E Weighted = 1.53 in.[0.87] & Q100 = 1.6 CFS VOLUME 100 = 2388 CF Q10 = 1.0 CFS VOLUME 10 = 1358 CF

DOWNSTREAM ANALYSIS

THE INCREASE OF RUNOFF RATE IS CONSIDERED MINIMAL FROM THE EXISTING CONDITIONS (0.5 CFS); THE DIFFERENCE WILL BE ROUTED INTO DEPRESSED LANDSCAPE AREA(S), THE REMAINING TWO-THIRDS OR 1 CFS WILL FREE-DISCHARGE TO THE STREET.

I, PHILIP W. CLARK, A PROFESSIONAL ENGINEER LICENSED IN ACCORDANCE WITH THE LAWS OF THE STATE OF NEW MEXICO, DO HEREBY CERTIFY THAT I HAVE VISITED THE SITE SHOWN HEREON, AND THAT THE CONTOURS SHOWN REPRESENT THE EXISTING GROUND CONDITIONS, AND DO FURTHER CERTIFY THAT NO EARTHWORK OF ANY KIND, NOR ANY DISTURBANCE OF THE EXISTING GROUND HAS OCCURRED ON THIS SITE SINCE THE CONTOURS WERE DETERMINED.

PHILIP W. CLARK NMPE #10265

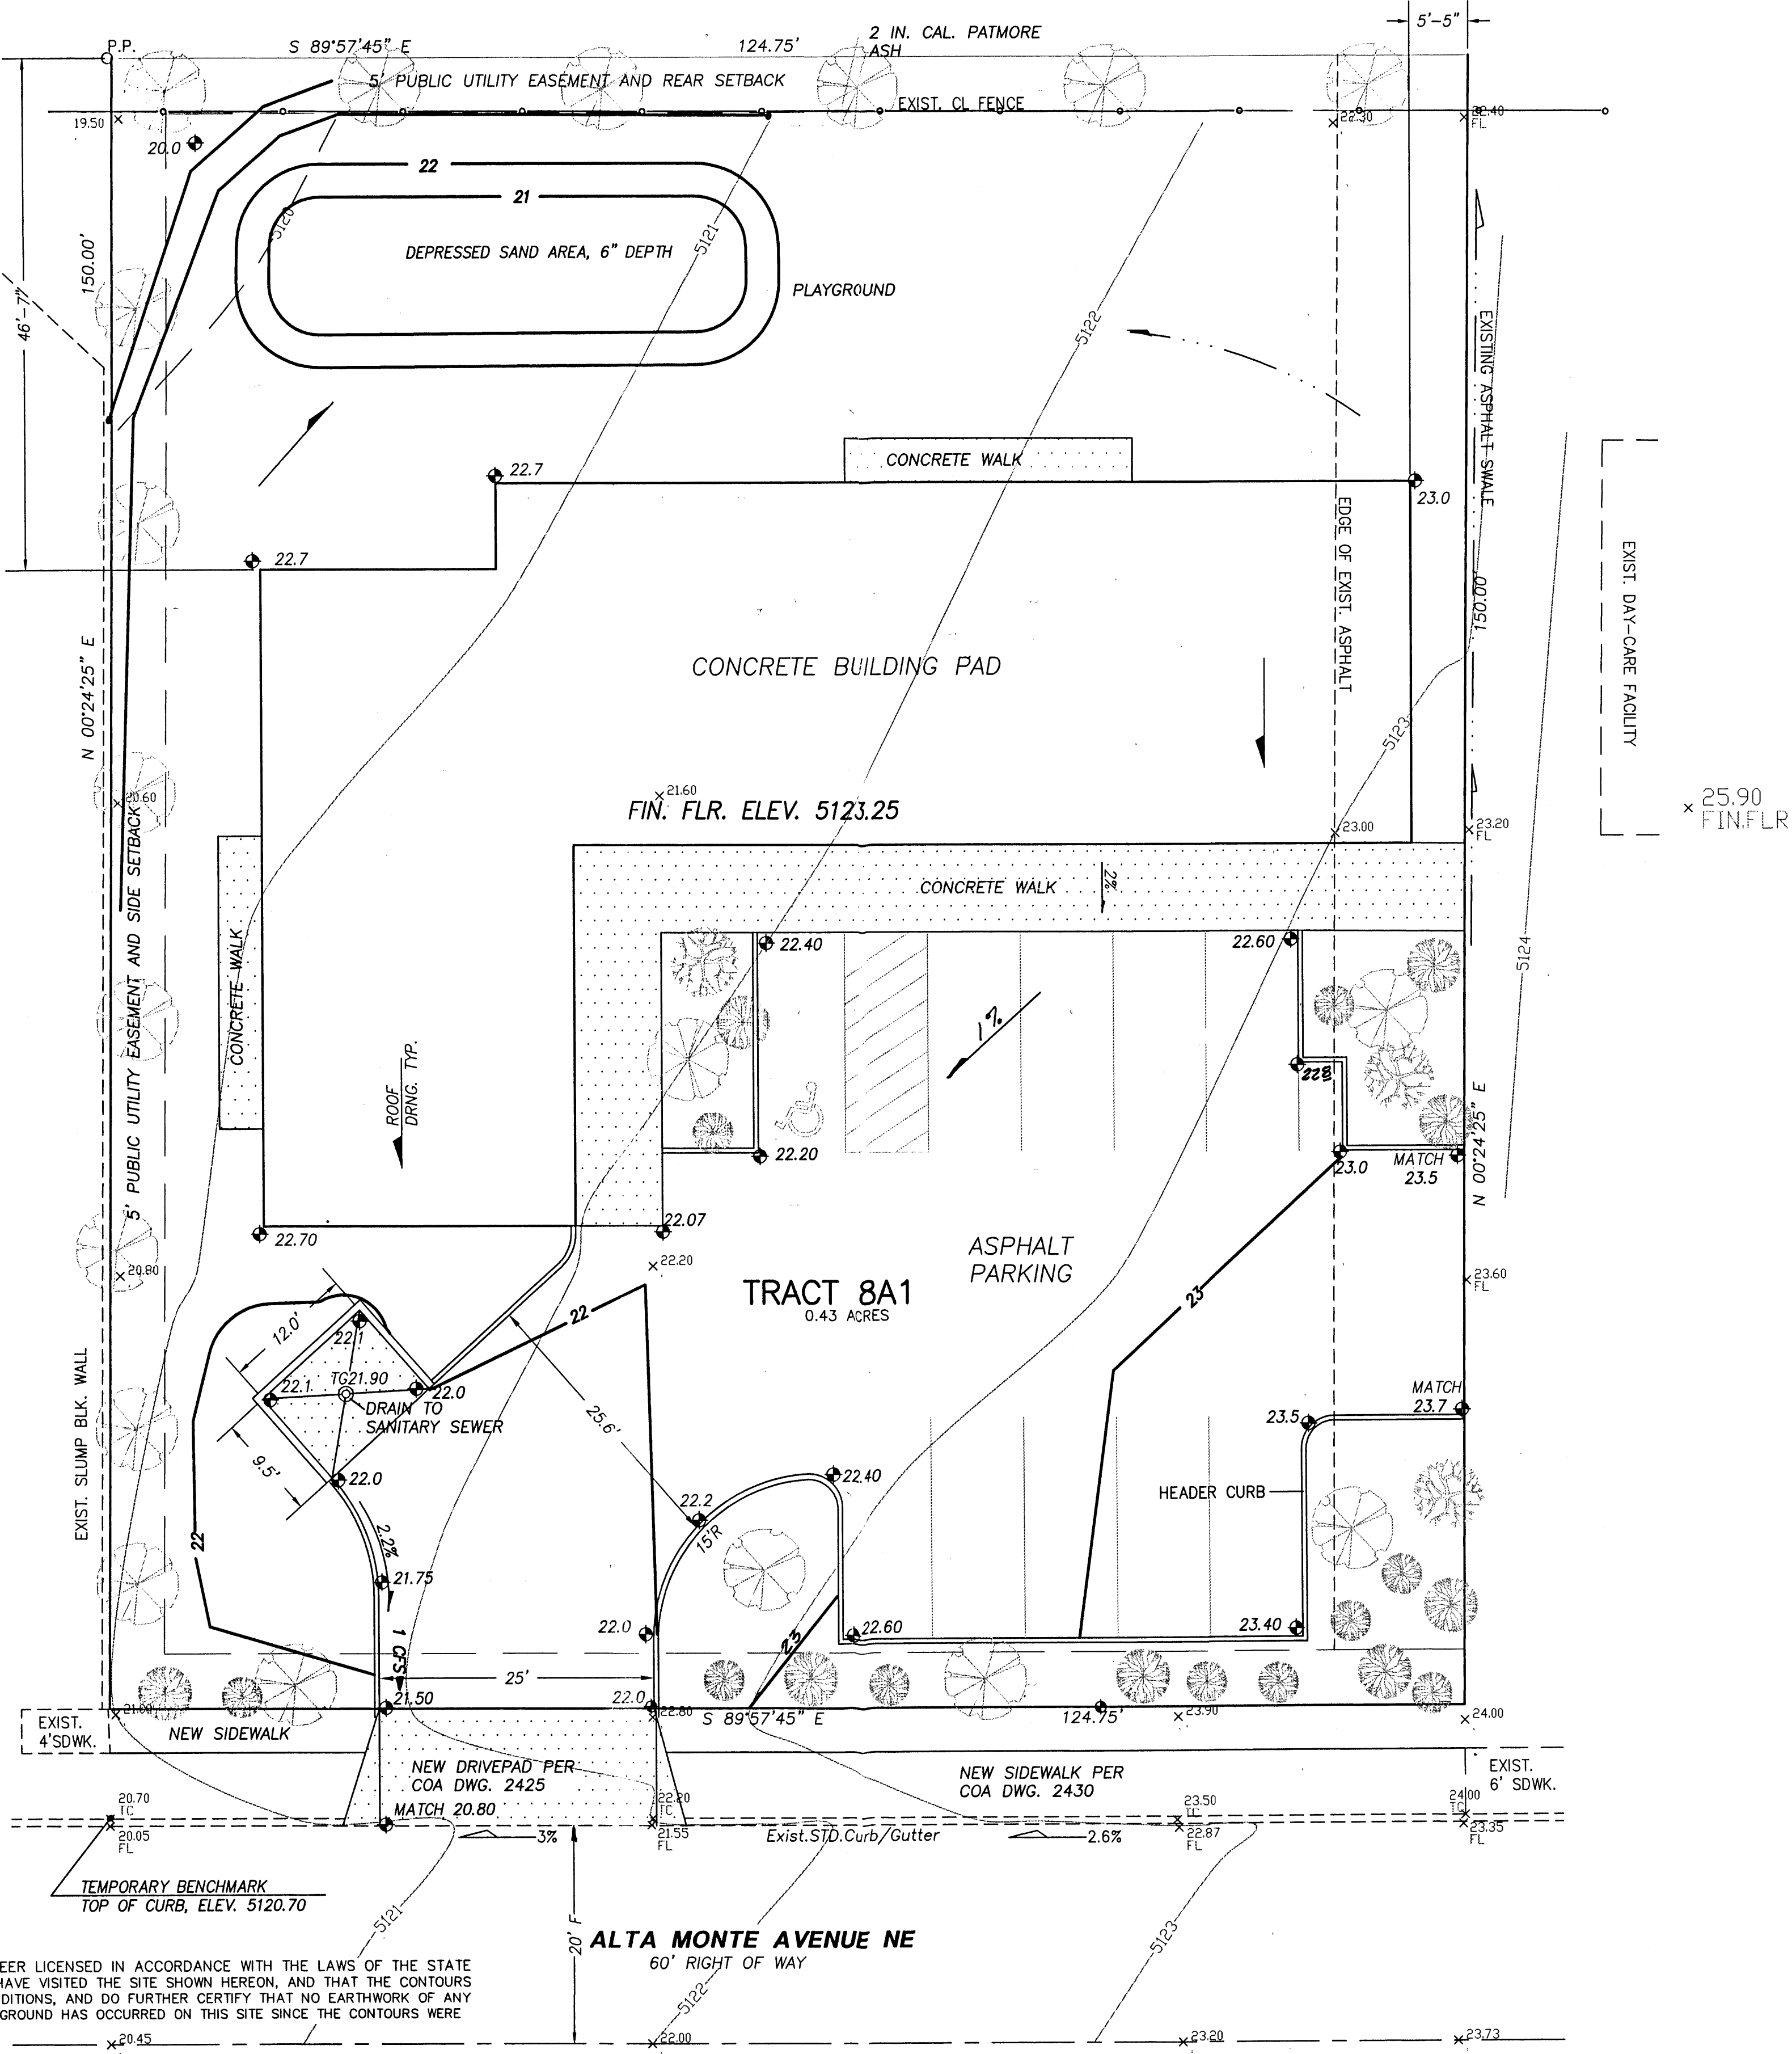

PROJECT DATA

LEGAL DESCRIPTION


TRACT 8A-1, BLOCK A, INDIAN ACRES SUBDIVISION ALBUQUERQUE, BERNALILLO COUNTY, NEW MEXICO

PROJECT BENCHMARK (NAVD88)

TOP OF CURB AT THE PROJECTION OF PROJECT SOUTHWEST CORNER SEE PLAN, ELEVATION = 5120.70, AS TIED FROM ACS CONTROL MONUMENT P-225 (ELEV. 5102.67) LOCATED @ THE SW QUADRANT OF LAFAYETTE/AZTEC

TOPOGRAPHIC DESIGN SURVEY DATA

COMPILED BY CLARK CONSULTING ENGINEERS, FEBRUARY 2007

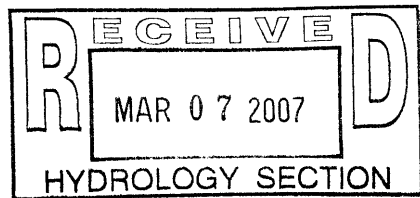

Clark Consulting Engineers

19 Ryan Road Edgewood, New Mexico 87015
Tele: (505) 281-2444 Fax: (505) 281-2444

DATE	REVISION

TR. 8A-1 OF BLOCK A, INDIAN ACRES ALBUQUERQUE, NEW MEXICO
3301 ALTA MONTE AVENUE, NE
Grading & Drainage Plan

DESIGNED BY: PWC	DRAWN BY: CCE	JOB #: WEAVER_VASS	1 OF 1
CHECKED BY: PWC	DATE: 1/12/07	FILE #: G/D	

GENERAL NOTES

DESIGN CRITERIA

- All work shall conform to the 2003 International Building Code.
Live loads:
Roof load 20 psf
Floor load 40 psf
Seismic zone 2b requirements
Wind loading 75 mph, exposure C
- Cast in place concrete:
a. Compressive strength of cast in place concrete 3000 psi at 28 days
b. Reinforcing steel shall be ASTM A-615 Grade 60 #5 and larger, Grade 40 #4 and smaller.
- Wood
a. Unless otherwise noted on drawings lumber shall be No. 2 Ponderosa Pine with allowable repetitive use fiber bending stress of 975 psi, single use fiber bending stress of 850 psi, and elastic modulus of 1500000 psi.
b. Where Hem-Fir is specified on plans it shall be No. 1 with allowable repetitive use fiber bending stress of 1200 psi, single use fiber bending stress of 1200 psi, and elastic modulus of 1500000 psi.
c. Micro-Lam lumber shall satisfy the following design values:
Bending (Fb) = 2600 psi
Horizontal shear (Fv) = 285 psi
Modulus of elasticity (E) = 1800000 psi
Compression perpendicular to grain = 650 psi
Compression parallel to grain (Fc) = 2460 psi
Drilling or notching of Micro-Lam lumber is not allowed.
- Design Soil bearing pressure 1500 psf with footings placed on natural ground and slab placed on engineered compacted fill.


CONSTRUCTION CRITERIA

- Lap reinforcing bars 32 diameters unless otherwise noted.
- Construction joints location and type shall have prior approval by Engineer.
- Fill material shall consist of soils that conform to the following characteristics:
Sieve Size Percent Passing
(Square openings) by weight
3 inch 100
No. 4 50-100
No. 200 10-40
The plasticity index of the material shall not exceed 10. Testing shall be in accordance with ASTM D 423 and 424 for P.I. and D-1557 for density.
- Where slabs are placed on fill the native soil shall be sacrificed to a minimum depth of 12 inches, watered as necessary to bring the moisture content as close as possible to optimum moisture content, and compacted to 95% of maximum density. Fill shall be spread in loose depth layers not exceeding 8 in. watered and compacted. Moisture content at the time of compaction shall be 2% below optimum moisture or higher. A minimum density of 95% of maximum density shall be obtained. Optimum moisture content and maximum density for each soil type shall be determined in accordance with ASTM D 1557.
- Contractor is responsible for any temporary bracing required to hold structural elements in place until work is complete.
- Contractor shall coordinate slab openings with Mechanical and Electrical drawings. (Mechanical and Electrical openings are not shown on Structural drawings.)
- All conditions shown on the plan shall be field verified by the contractor. If discrepancies exist they shall be brought to the attention of the Architect and Engineer before work proceeds.



LANDSCAPE NOTES

DESIGN CRITERIA

- Landscape and irrigation system maintenance shall be the responsibility of the owner.
- Landscape shall be watered by a complete underground irrigation drip system operated by automatic controller.
- Plantings shall achieve a minimum 75% live ground cover at maturity.

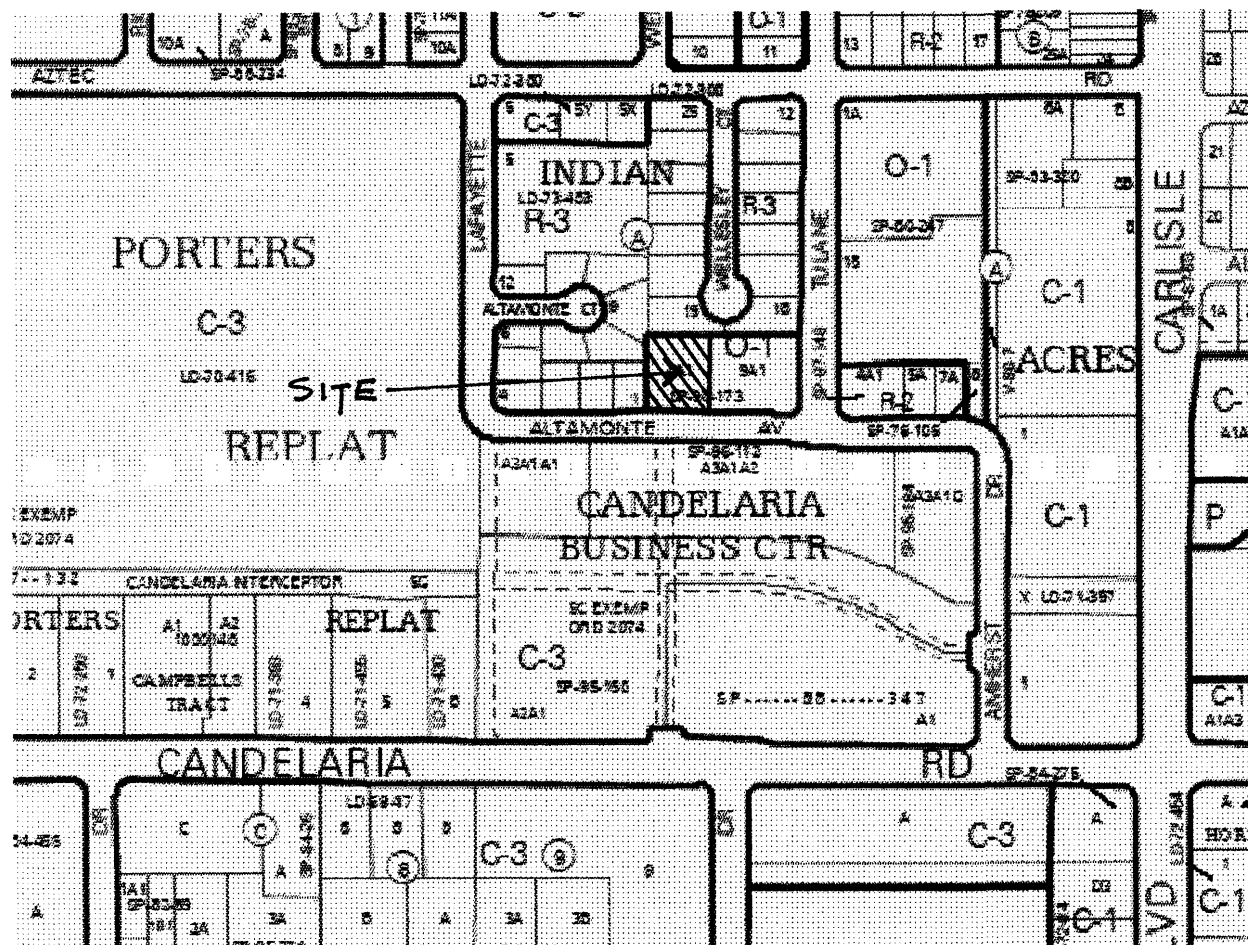

VICINITY MAP

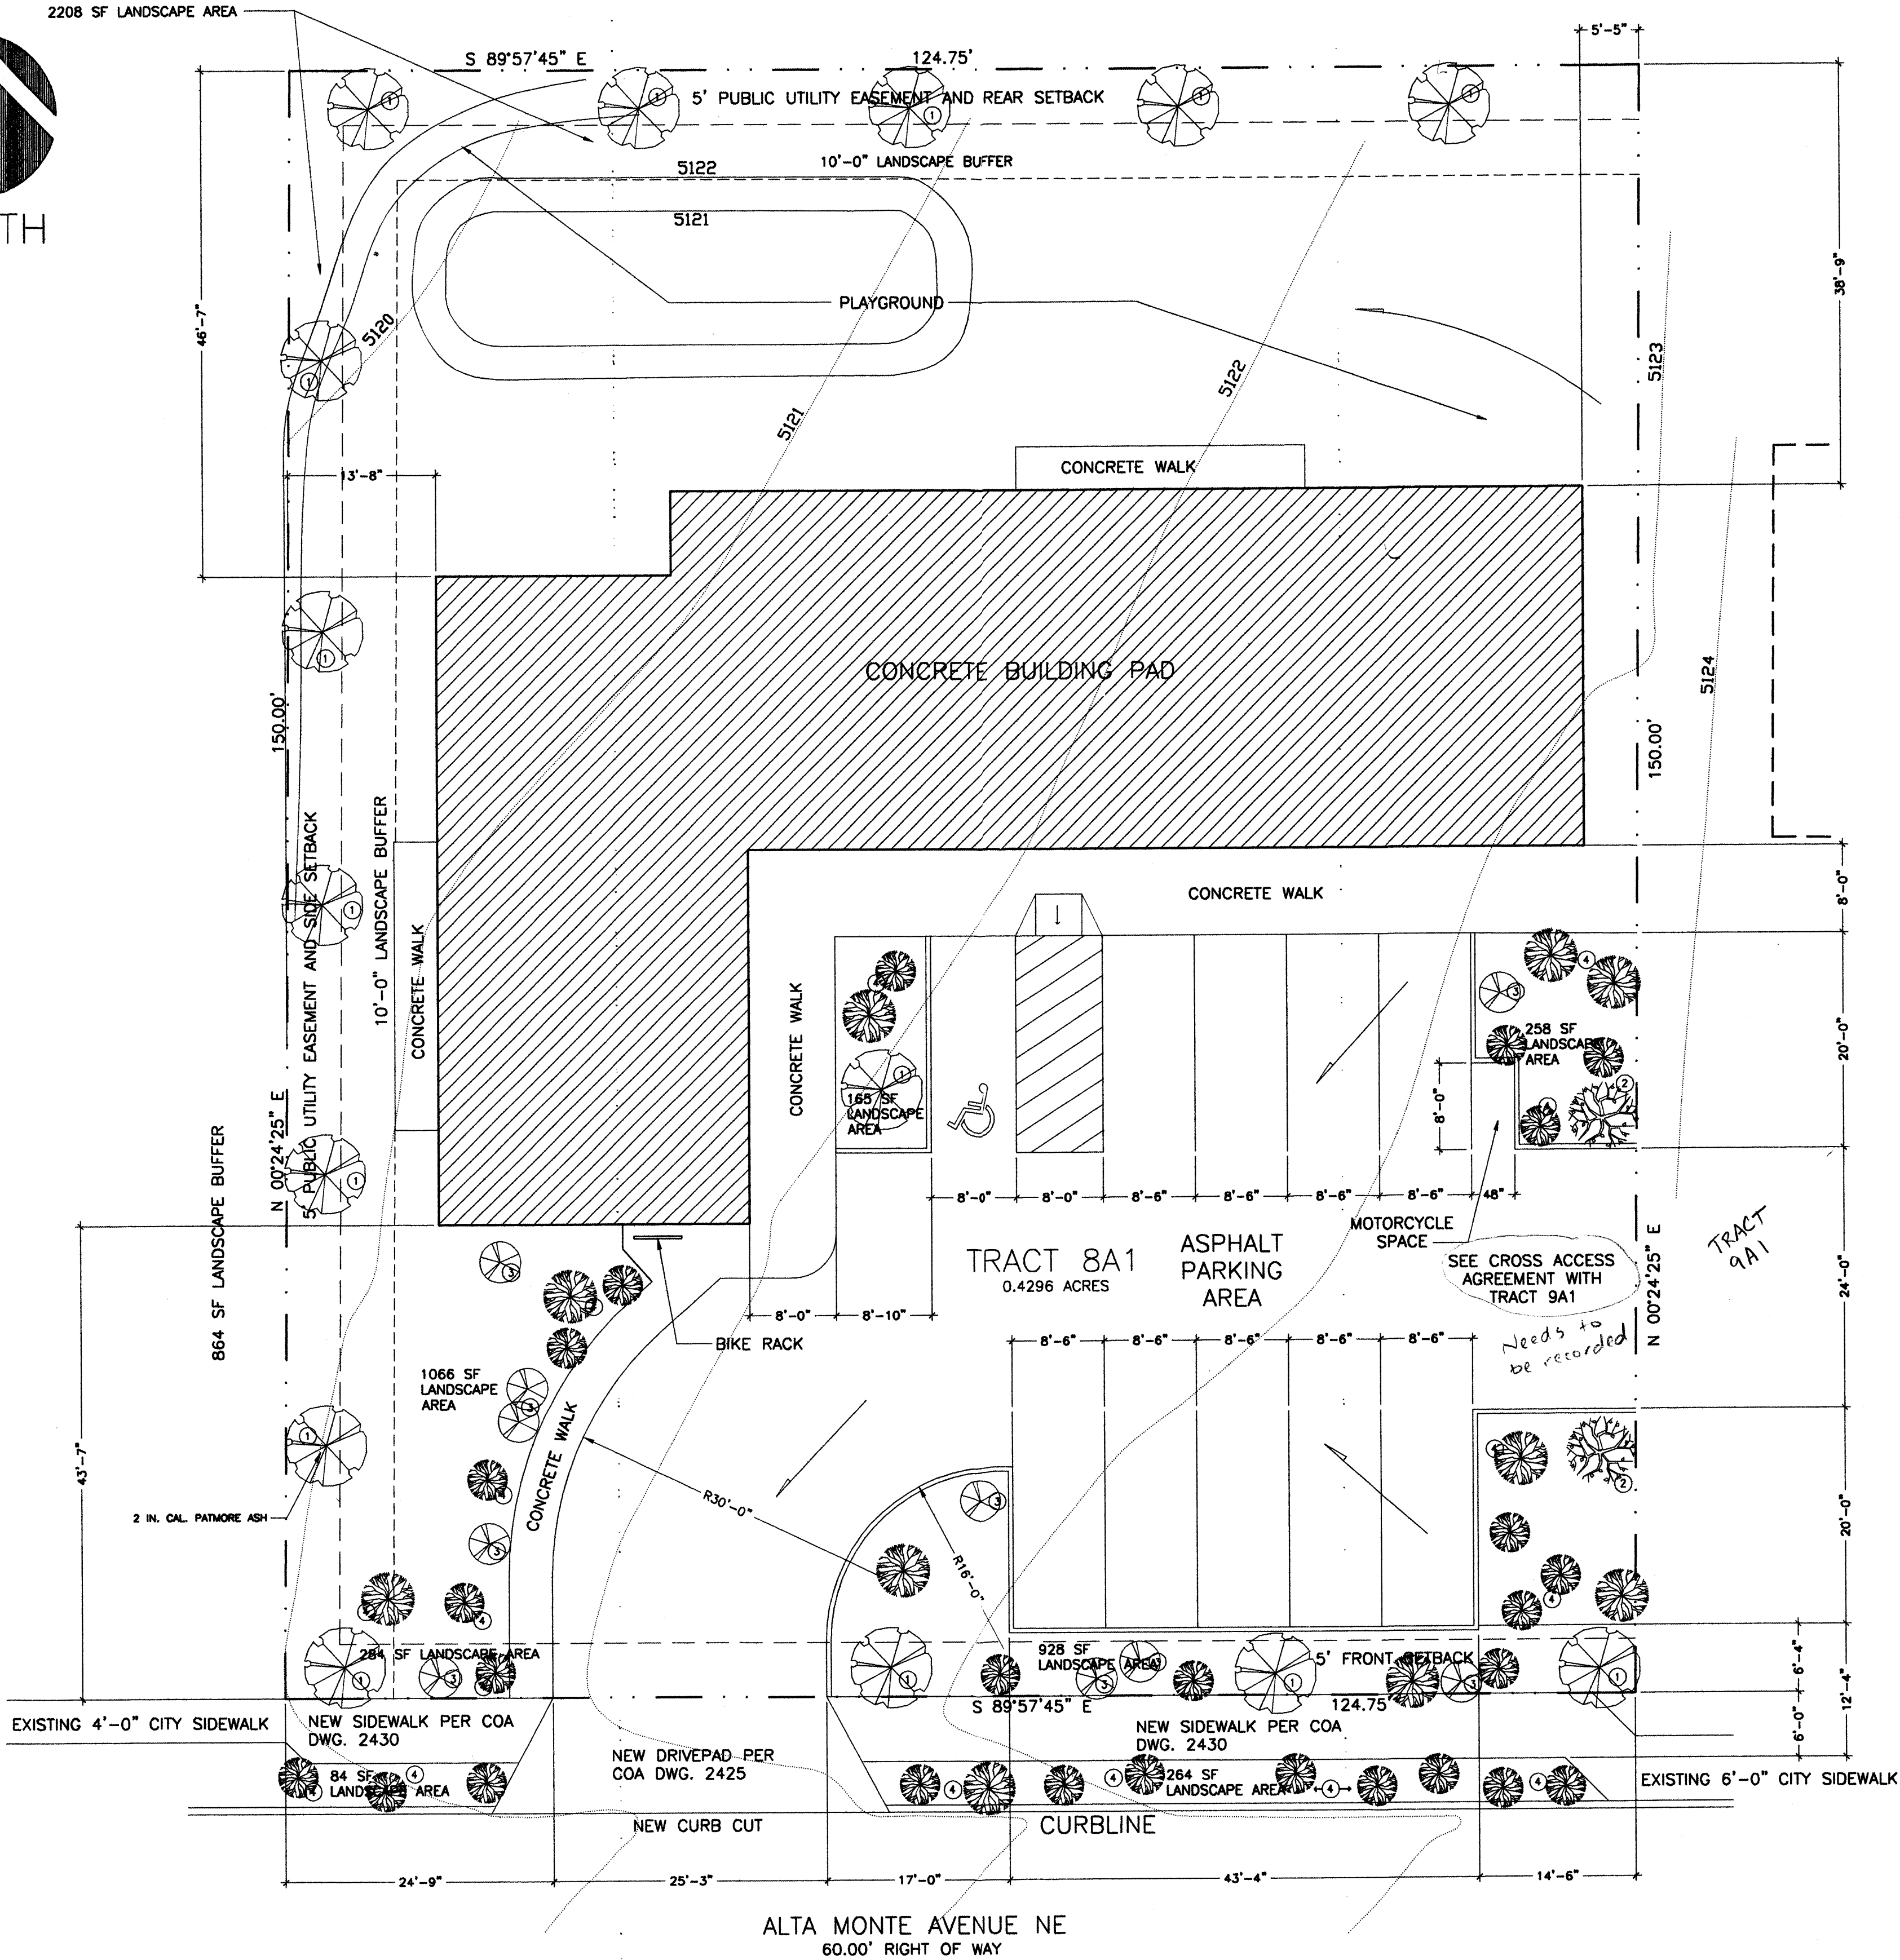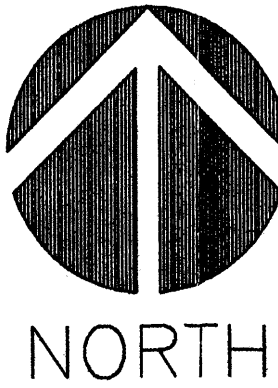

SITE PLAN

LANDSCAPE AREA REQUIRED:	
GROSS SITE AREA	= 18,713 SF
BUILDING AREA	= 4,322 SF
RIGHT-OF WAY	= 328 SF
NET SITE AREA	= 14,063 SF
15% OF NET AREA	= 2,109 SF REQUIRED
LANDSCAPE AREA PROVIDED: 4,973 SF	
VEGETATIVE GROUND COVER REQUIRED: 1,582 SF	

LANDSCAPE SCHEDULE		
MARK	DESCRIPTION	SIZE
①	PATMORE ASH	2" CALIPER
②	BRADFORD PEAR	15 GALLON
③	DESERT WILLOW	5 GALLON
④	BUFFALO JUNIPER	1 GALLON

1" = 0'-0"

TRAFFIC CIRCULATION LAYOUT APPROVED




Signed _____ Date 4/6/07

DRAWING INDEX	
A 1	SITE PLAN
A 1A	GRADING/DRAINAGE PLAN
A 2	FOUNDATION PLAN/DETAILS
A 3	FLOOR PLAN
A 4	FRAMING PLAN/SECTIONS/DETAILS
A 5	REFLECTED CEILING PLAN/ROOF PLAN
A 6	ELEVATIONS
P 1	PLUMBING PLAN
M 1	MECHANICAL PLAN
E 1	ELECTRICAL PLAN

BUILDING DATA	
PROJECT:	DAY CARE CENTER
	3301 ALTA MONTE AVENUE NE
	ALBUQUERQUE, NEW MEXICO 87107
OWNER:	GOZFAST LLC
	604 CEDAR HILL ROAD NE
	ALBUQUERQUE, NEW MEXICO 87122
ARCHITECT:	J. KORY BAKER ARCHITECT
	P.O. BOX 254
	ESTANCIA, NEW MEXICO 87016
ZONE ATLAS MAP:	G-16-Z
ZONING CLASSIFICATION:	O-1
BUILDING TYPE:	EDUCATIONAL -- DAY CARE
CONSTRUCTION TYPE:	VN
OCCUPANT LOAD:	
CLASSROOM #1	1120 SF/20 = 56
CLASSROOM #2	1120 SF/20 = 56
CLASSROOM #3	920 SF/20 = 46
CLASSROOM #4	492 SF/20 = 25
STORAGE/MECHANICAL	44 SF/300 = 1
TOTAL OCCUPANCY = 184	
OCCUPANCY GROUP:	GROUP E -- DAY CARE
NUMBER OF FLOORS:	1 FLOOR
GROSS SQUARE FOOTAGE:	4,322 SQ.FT.
ZONING ANALYSIS:	PARKING
PARKING REQUIRED:	
2 SPACES PLUS 1 SPACE	
PER 500 SF NET LEASABLE AREA	
NET LEASABLE AREA = 3655 SF	
3655/500 = 8 + 2 = 10	
REQUIRED PARKING = 10 SPACES	
PROVIDED PARKING = 10 SPACES	
REQUIRED HC PARKING = 1 SPACE	
PROVIDED HC PARKING = 1 SPACE	
VAN ACCESSIBLE	

CODES & RESTRICTIONS	
THE BUILDING SHALL BE CONSTRUCTED IN STRICT ACCORDANCE WITH THE FOLLOWING:	
• 2003 INTERNATIONAL BUILDING CODE	
• ALL APPLICABLE CODES AND REGULATIONS OF BERNALILLO COUNTY, AND THE STATE OF NEW MEXICO	

LEGAL DESCRIPTION	
TRACT 8A1, PLAT OF TRACTS 8A1 AND 9A1, TRACT 6, BLOCK A, INDIAN ACRES SUBDIVISION	

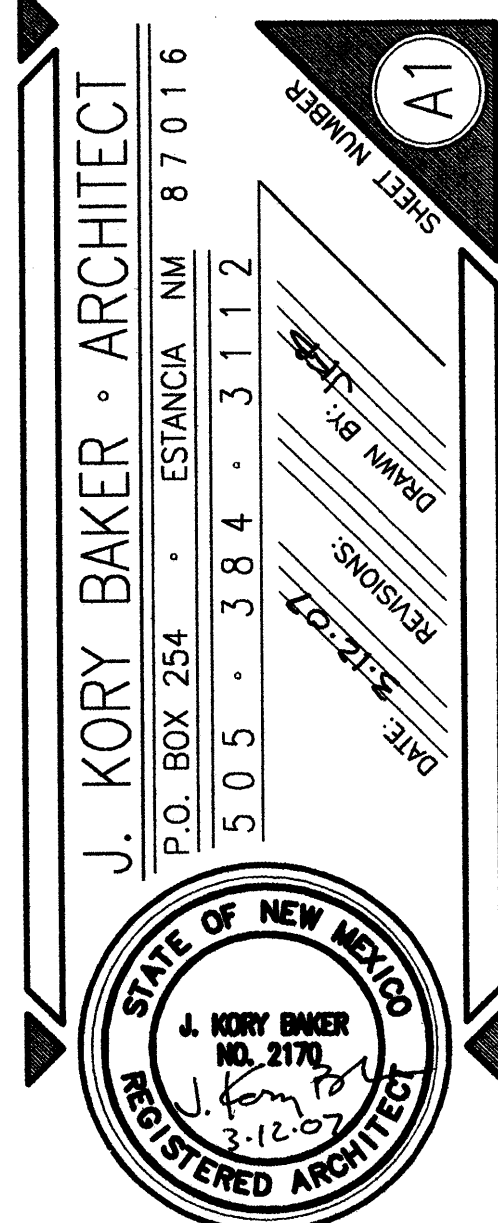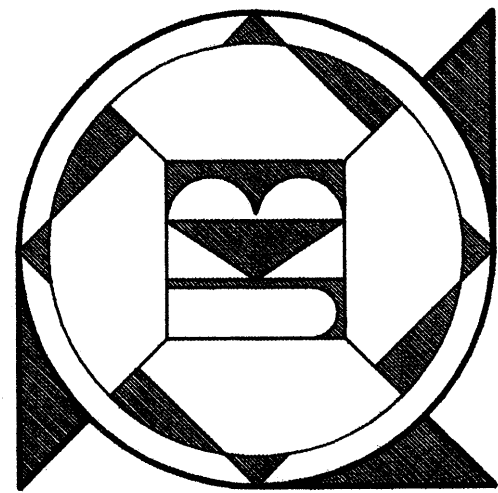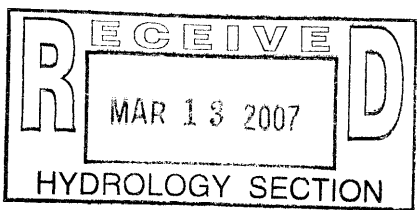

DAY CARE CENTER

ALBUQUERQUE • NEW MEXICO

GENERAL NOTES

DESIGN CRITERIA

- All work shall conform to the 2003 International Building Code.
Live loads:
Roof load 20 psf
Floor load 40 psf
Seismic zone 2b requirements
Wind loading 75 mph, exposure C
- Cast in place concrete:
a. Compressive strength of cast in place concrete 3000 psi at 28 days
b. Reinforcing steel shall be ASTM A-615 Grade 60 #5 and larger, Grade 40 #4 and smaller.
- Wood
a. Unless otherwise noted on drawings lumber shall be No. 2 Ponderosa Pine with allowable repetitive use fiber bending stress of 975 psi, single use fiber bending stress of 850 psi, and elastic modulus of 1500000 psi.
b. Where Hem-Fir is specified on plans it shall be No. 1 with allowable repetitive use fiber bending stress of 1200 psi, single use fiber bending stress of 1200 psi, and elastic modulus of 1500000 psi.
c. Micro-Lam lumber shall satisfy the following design values:
Bending (F_b) = 2600 psi
Horizontal shear (F_v) = 285 psi
Modulus of elasticity (E) = 1800000 psi
Compression perpendicular to grain = 650 psi
Compression parallel to grain (F_c) = 2460 psi
Drilling or notching of Micro-Lam lumber is not allowed.
- Design Soil bearing pressure 1500 psf with footings placed on natural ground and slab placed on engineered compacted fill.


CONSTRUCTION CRITERIA

- Lap reinforcing bars 32 diameters unless otherwise noted.
- Construction joints location and type shall have prior approval by Engineer.
- Fill material shall consist of soils that conform to the following characteristics:
Sieve Size Percent Passing
(Square openings) by weight
3 inch 100
No. 4 50-100
No. 200 10-40
The plasticity index of the material shall not exceed 10.
Testing shall be in conformance with ASTM D 423 and 424 for P.I. and D-1557 for density.
4. Where slabs are placed on fill the native soil shall be scarified to a minimum depth of 12 inches, watered as necessary to bring the moisture content as close as possible to optimum moisture content, and compacted to 95% of maximum density.
Fill shall be spread in loose depth layers not exceeding 8 in. watered and compacted. Moisture content at the time of compaction shall be 2% below optimum moisture or higher.
A minimum density of 95% of maximum density shall be obtained.
Optimum moisture content and maximum density for each soil type shall be determined in accordance with ASTM D 1557.
5. Contractor is responsible for any temporary bracing required to hold structural elements in place until work is complete.
6. Contractor shall coordinate slab openings with Mechanical and Electrical drawings. (Mechanical and Electrical openings are not shown on Structural drawings.)
7. All conditions shown on the plan shall be field verified by the contractor. If discrepancies exist they shall be brought to the attention of the Architect and Engineer before work proceeds.

LANDSCAPE NOTES


DESIGN CRITERIA

- Landscape and irrigation system maintenance shall be the responsibility of the owner.
- Landscape shall be watered by a complete underground irrigation drip system operated by automatic controller.
- Plantings shall achieve a minimum 75% live ground cover at maturity.

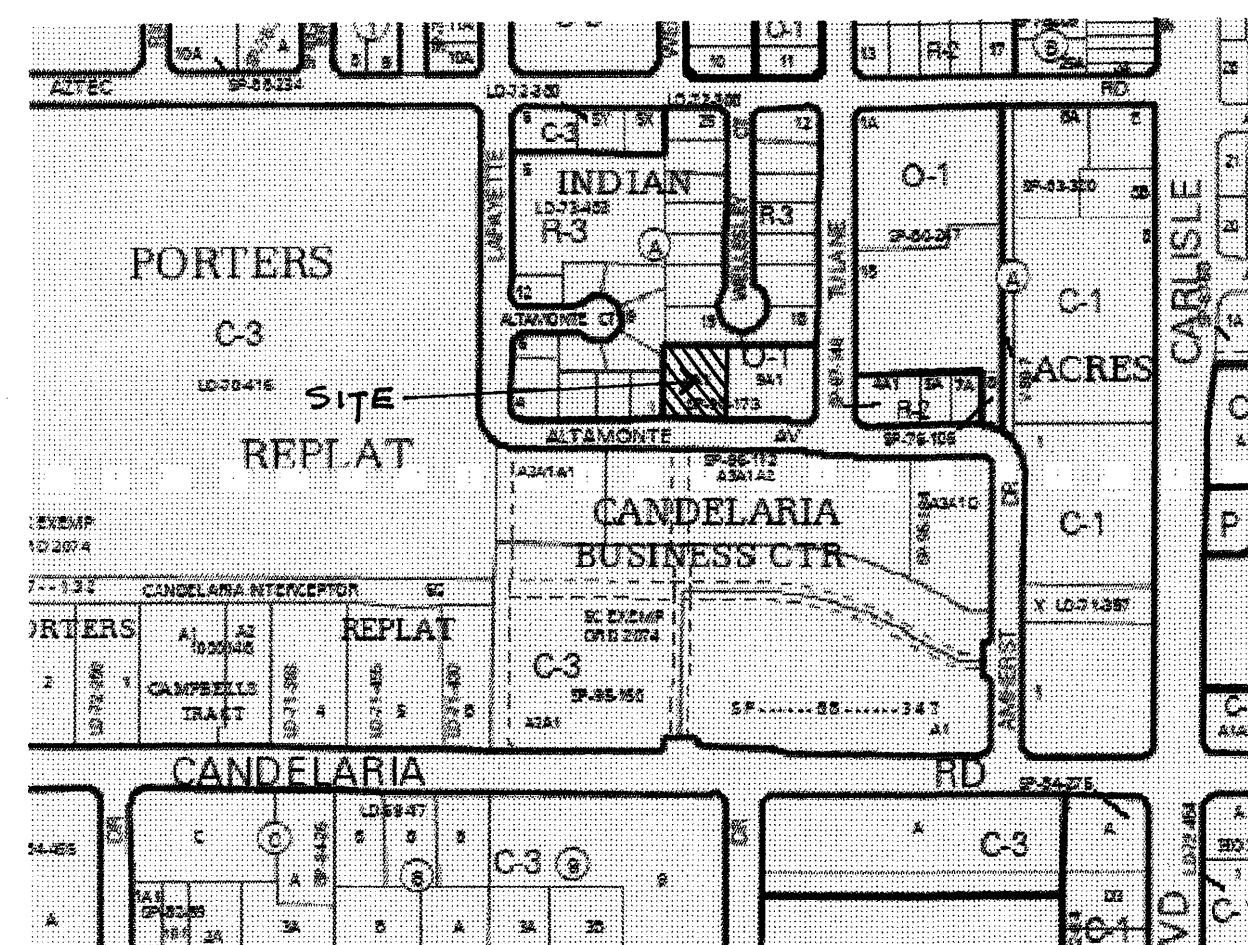

VICINITY MAP

NTS

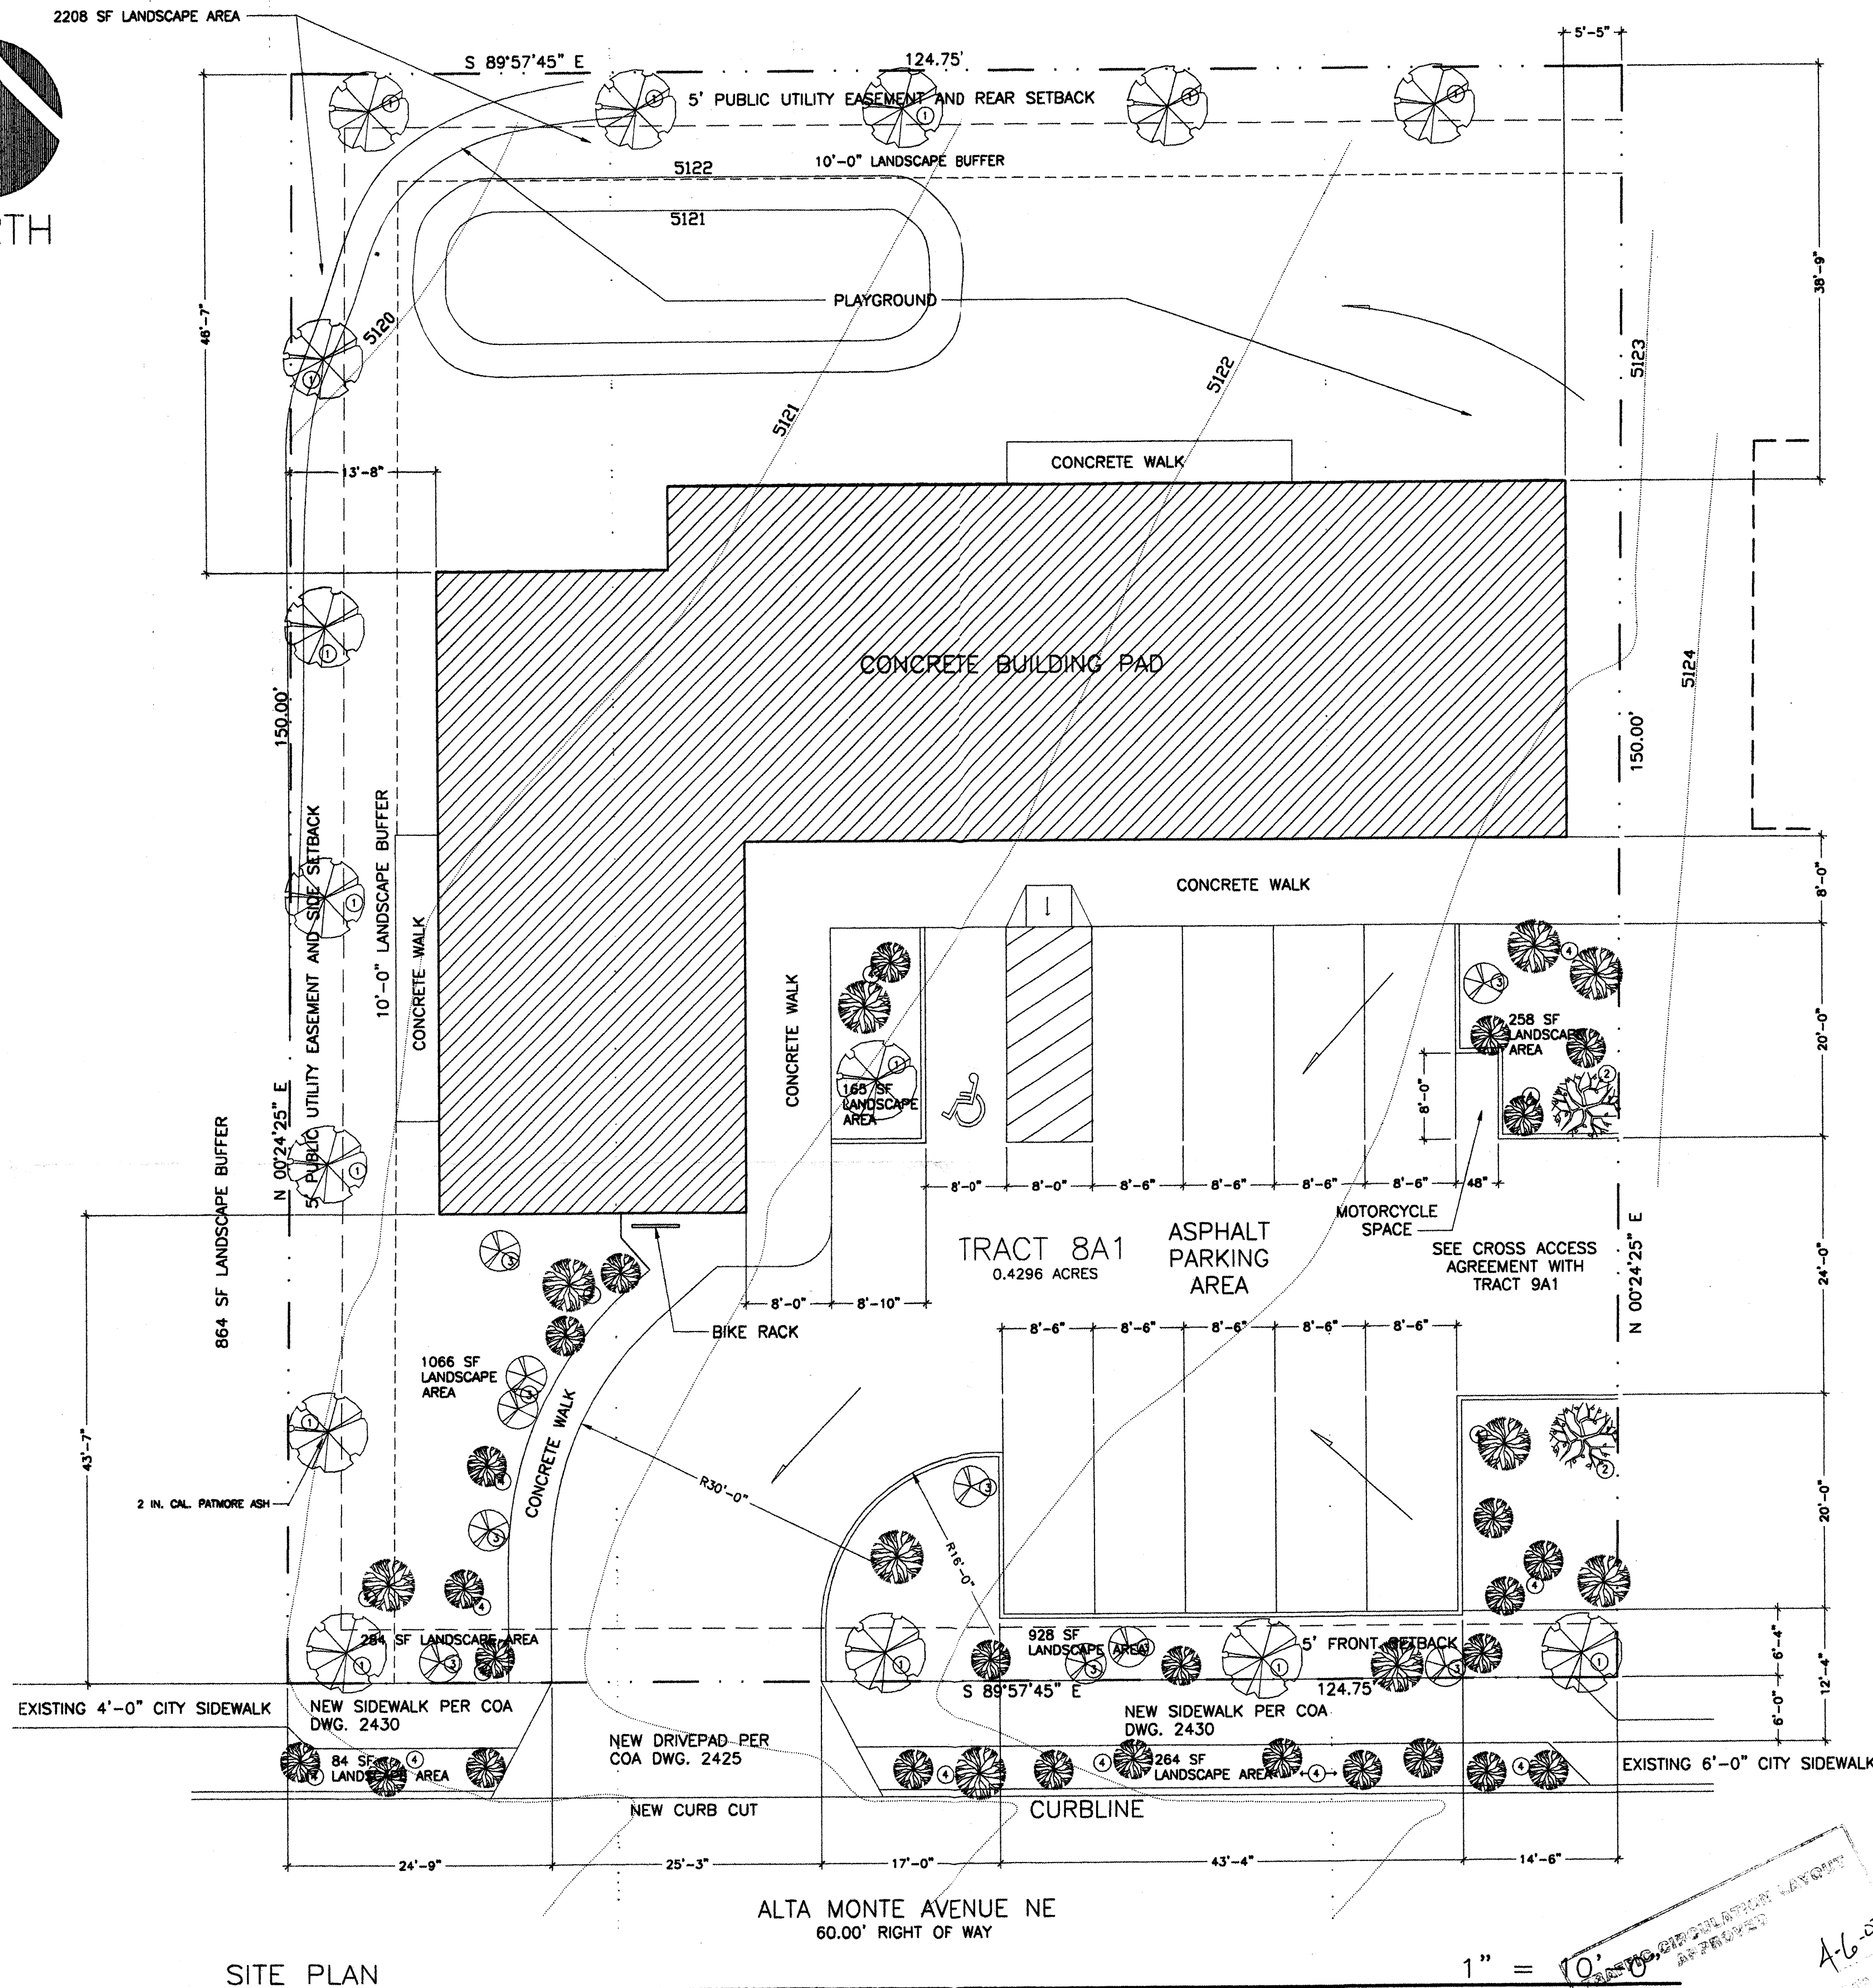

SITE PLAN

LANDSCAPE AREA REQUIRED:	
GROSS SITE AREA	= 18,713 SF
BUILDING AREA	= 4,322 SF
RIGHT-OF-WAY	= 328 SF
NET SITE AREA	= 14,063 SF
15% OF NET AREA	= 2,109 SF REQUIRED
LANDSCAPE AREA PROVIDED: 4,973 SF	
VEGETATIVE GROUND COVER REQUIRED: 1,582 SF	




LANDSCAPE SCHEDULE		
MARK	DESCRIPTION	SIZE
①	PATMORE ASH	2" CALIPER
②	BRADFORD PEAR	15 GALLON
③	DESERT WILLOW	5 GALLON
④	BUFFALO JUNIPER	1 GALLON

DRAWING INDEX	
A 1	SITE PLAN
A 1A	GRADING/DRAINAGE PLAN
A 2	FOUNDATION PLAN/DETAILS
A 3	FLOOR PLAN
A 4	FRAMING PLAN/SECTIONS/DETAILS
A 5	REFLECTED CEILING PLAN/ROOF PLAN
A 6	ELEVATIONS
P 1	PLUMBING PLAN
M 1	MECHANICAL PLAN
E 1	ELECTRICAL PLAN

BUILDING DATA	
PROJECT:	DAY CARE CENTER
	3301 ALTA MONTE AVENUE NE
	ALBUQUERQUE, NEW MEXICO 87107
OWNER:	GOZFAST LLC
	604 CEDAR HILL ROAD NE
	ALBUQUERQUE, NEW MEXICO 87122
ARCHITECT:	J. KORY BAKER ARCHITECT
	P.O. BOX 254
	ESTANCIA, NEW MEXICO 87016
ZONE ATLAS MAP:	G-16-Z
ZONING CLASSIFICATION:	O-1
BUILDING TYPE:	EDUCATIONAL - DAY CARE
CONSTRUCTION TYPE:	VN
OCCUPANT LOAD:	
CLASSROOM #1	1120 SF/20 = 56
CLASSROOM #2	1120 SF/20 = 56
CLASSROOM #3	920 SF/20 = 46
CLASSROOM #4	492 SF/20 = 25
STORAGE/MECHANICAL	44 SF/300 = 1
TOTAL OCCUPANCY	= 184
OCCUPANCY GROUP:	GROUP E - DAY CARE
NUMBER OF FLOORS:	1 FLOOR
GROSS SQUARE FOOTAGE:	4,322 SQ.FT.
ZONING ANALYSIS:	PARKING
PARKING REQUIRED:	
2 SPACES PLUS 1 SPACE	
PER 500 SF NET LEASABLE AREA	
NET LEASABLE AREA = 3655 SF	
3655/500 = 8 + 2 = 10	
REQUIRED PARKING = 10 SPACES	
PROVIDED PARKING = 10 SPACES	
REQUIRED HC PARKING = 1 SPACE	
PROVIDED HC PARKING = 1 SPACE	
VAN ACCESSIBLE	


CODES & RESTRICTIONS	
THE BUILDING SHALL BE CONSTRUCTED IN STRICT ACCORDANCE WITH THE FOLLOWING:	
• 2003 INTERNATIONAL BUILDING CODE	
• ALL APPLICABLE CODES AND REGULATIONS OF BERNALILLO COUNTY, AND THE STATE OF NEW MEXICO	

LEGAL DESCRIPTION	
TRACT 8A1, PLAT OF TRACTS 8A1 AND 9A1, TRACT 6, BLOCK A, INDIAN ACRES SUBDIVISION	

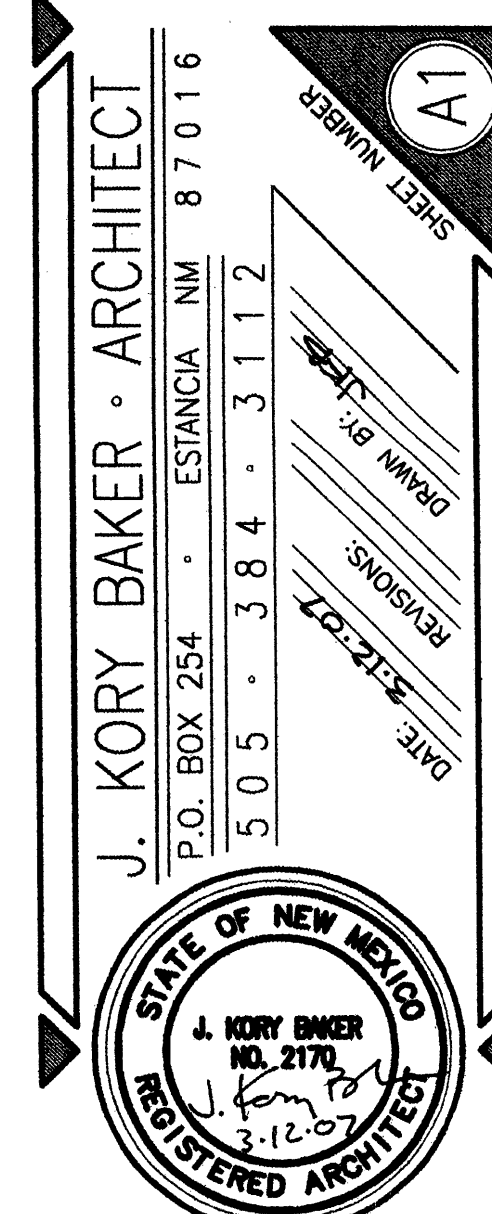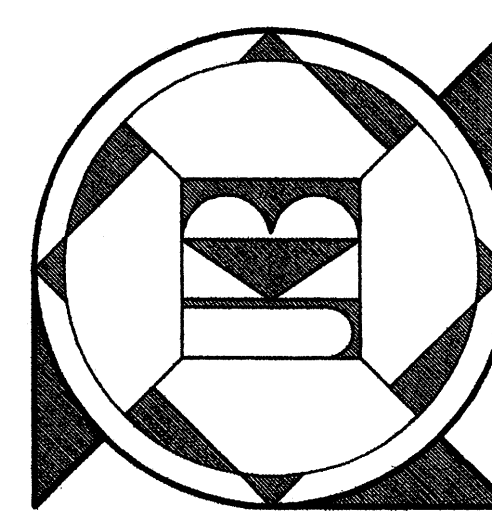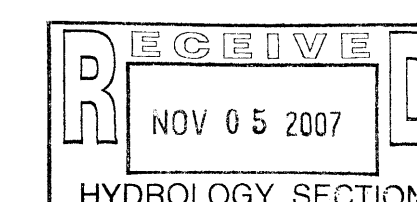

DAY CARE CENTER

ALBUQUERQUE • NEW MEXICO

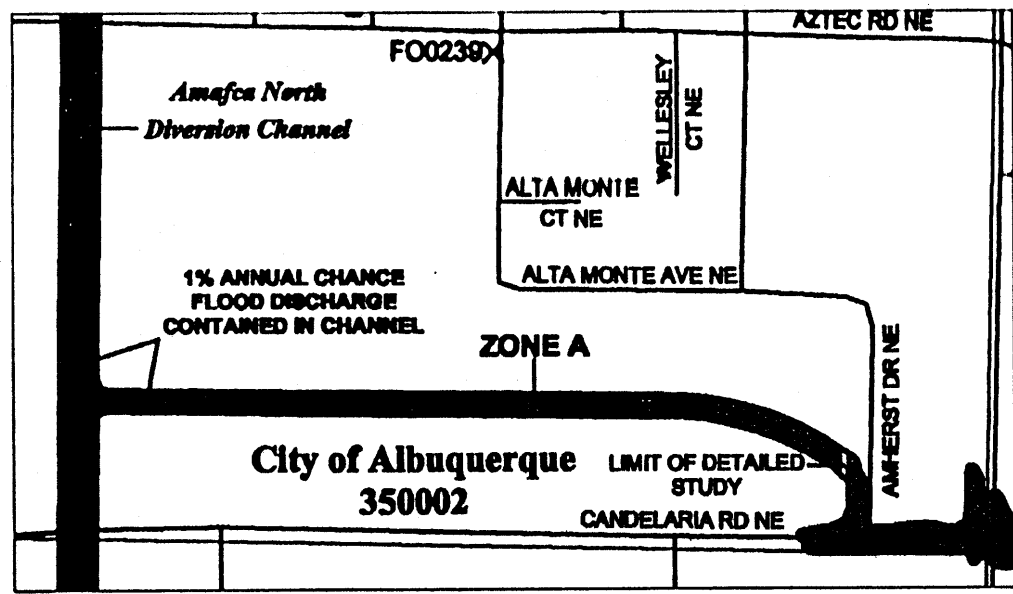

FIRM MAP PANEL # 351 F


GRADING & DRAINAGE PLAN

THE PROPOSED DAY-CARE EXPANSION PROJECT IS LOCATED IN THE CANELARIA-125 COMMERCIAL AREA OF THE CITY OF ALBUQUERQUE. THE GRADING AND DRAINAGE SCHEME HEREON IS IN COMPLIANCE WITH THE BERNALILLO COUNTY FLOOD HAZARD ORDINANCE, NO.88-46, AND THE CITY STORM DRAINAGE ORDINANCE. THE PLAN IS REQUIRED IN ORDER TO FACILITATE THE OWNER'S REQUEST FOR BUILDING PERMIT. THE PLAN SHOWS:

1. EXISTING CONTOURS, AND SPOT ELEVATIONS AND EXISTING DRAINAGE PATTERNS AND IMPROVEMENTS, AND EXISTING STREET.
2. PROPOSED IMPROVEMENTS: A 4000 SF BUILDING, PRIVATE ASPHALT DRIVEWAY AND PARKING, NEW GRADE ELEVATIONS, DRAINAGE, AND LANDSCAPING COMPLIANCE IMPROVEMENTS/UPGRADING.
3. CONTINUITY BETWEEN EXISTING AND PROPOSED ELEVATIONS.
4. QUANTIFICATION OF DEVELOPED FLOWS GENERATED BY THE IMPROVEMENTS WHICH CONTRIBUTE TO THE EXISTING FLOWS.

PRESENTLY, THE SITE IS ESTABLISHED AND USED AS A DEVELOPED ANCLARY PLAYGROUND AREA FOR THE EXISTING FACILITY TO THE EAST. THE PLAYGROUND CURRENTLY IS 2/3 GRAVEL SURFACING LOCATED IN THE SOUTHERN AREA. THE SITE IS BOUNDED BY DEVELOPED MULTI-FAMILY ON THE NORTH /COMMERCIAL PROPERTY TO THE WEST. ALTA MONTE AVE. ON THE SOUTH IS A 40 FEET WIDE PAVED CITY MAINTAINED LOCAL STREET WITH SIDEWALK. THE SITE TERRAIN SLOPES FROM EAST TO NORTHWEST AT 5%.

THE SITE IS NOT WITHIN OR ADJACENT TO A DESIGNATED FEMA FLOOD HAZARD ZONE. DEVELOPED LOT RUNOFF WILL BE PERMITTED TO DRAIN TO THE STREET. FREE DISCHARGE OF PROJECT RUNOFF IS ACCEPTABLE SINCE DOWNSTREAM DRAINAGE FACILITIES EXIST. A PORTION OF SITE RUNOFF IS ROUTED THROUGH PROPOSED LANDSCAPING AS POINT RAINFALL,SEE CALCULATIONS.

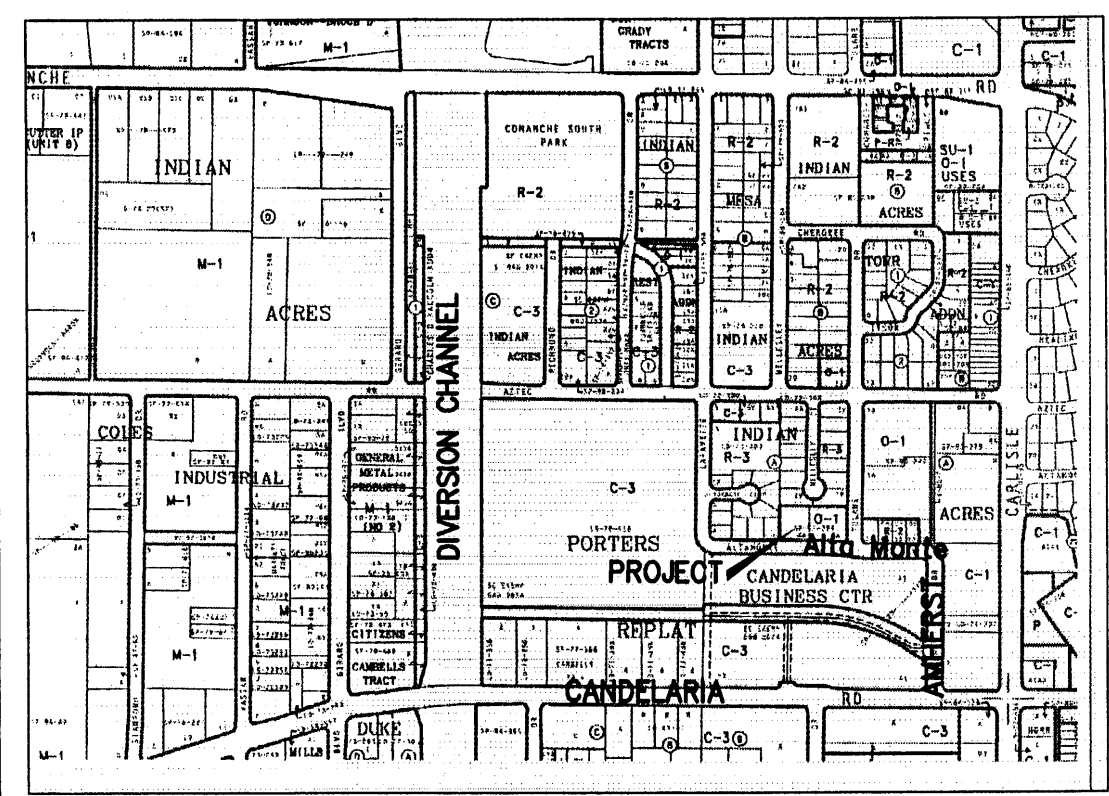

VICINITY MAP ZONE G-16

NOTES

1. ALL WORK WITHIN THE RIGHT-OF-WAY SHALL BE CONSTRUCTED IN ACCORDANCE WITH THE CITY OF ALBUQUERQUE STANDARD SPECS. FOR PUBLIC WORKS CONSTRUCTION, 7TH EDITION W/ UPDATES.
2. AN EXCAVATION/CONSTRUCTION PERMIT IS REQUIRED BEFORE BEGINNING ANY WORK WITHIN CITY R.O.W. AN APPROVED COPY OF THIS PLAN MUST BE SUBMITTED AT THE TIME OF APPLICATION.
3. ALL WORK ON THIS PROJECT SHALL BE PERFORMED IN ACCORDANCE WITH APPLICABLE FEDERAL, STATE AND LOCAL LAWS, RULES, AND REGULATIONS CONCERNING CONSTRUCTION SAFETY AND HEALTH.
4. ALL LANDSCAPING AREA SHALL BE SOFT-LINED WITH NATIVE VEGETATION AND/OR GRAVEL.
5. CONTRACTOR SHALL ENSURE THAT NO SITE SOILS/SEDIMENT OR SILT ENTER THE RIGHT-OF-WAYS DURING CONSTRUCTION.
6. REVEGETATE ALL AREAS DISTURBED DUE TO CONSTRUCTION PER CITY OF ALBUQ. SPEC. 1011, NATIVE SEED MIX.
7. MAXIMUM SITE GRADING WITHOUT EROSION PROTECTION: 3 HORIZONTAL TO 1 VERTICAL, 3:1.
8. NEW ASPHALT PAVEMENT SHALL CONSIST OF 3" ASPHALT CONCRETE OVER 6" AGGREGATE BASE COURSE ON 8" COMPACTED SUBGRADE, 95% PROCTOR, ASTM D-1557

LEGEND

DRAINAGE CERTIFICATION

I, Philip W. Clark, NMPE #10265 OF THE FIRM Clark Consulting Engineers, HEREBY CERTIFY THAT THIS PROJECT HAS BEEN GRADED AND WILL DRAIN IN SUBSTANTIAL COMPLIANCE WITH AND IN ACCORDANCE WITH THE DESIGN INTENT OF THE APPROVED PLAN DATED 11/10/07. THE RECORD INFORMATION EDITED ONTO THE ORIGINAL DESIGN DOCUMENT HAS BEEN OBTAINED BY ME OR UNDER MY DIRECT SUPERVISION. I AS SUPPLEMENTAL DATA TO THE ORIGINAL TOPOGRAPHIC SURVEY PREPARED BY Philip W. Turner, NMPS #024 OF THE FIRM TERRAMETRICS, (AND IS TRUE AND CORRECT TO THE BEST OF MY KNOWLEDGE AND BELIEF. THIS CERTIFICATION IS SUBMITTED IN SUPPORT OF A REQUEST FOR CERTIFICATE OF OCCUPANCY.

(DESCRIBE ANY EXCEPTIONS) **DELETED REFUSE**

(DESCRIBE ANY DEFICIENCIES)

THE RECORD INFORMATION PRESENTED HEREON IS NOT NECESSARILY COMPLETE AND INTENDED ONLY TO VERIFY SUBSTANTIAL COMPLIANCE OF THE GRADING AND DRAINAGE ASPECTS OF THIS PROJECT. THOSE RELYING ON THIS RECORD DOCUMENT ARE ADVISED TO OBTAIN INDEPENDENT VERIFICATION OF ITS ACCURACY BEFORE USING IT FOR ANY OTHER PURPOSE.

Philip W. Clark, NMPE 10265
DATE 11/10/07

LEGEND

- 15-Built 242 Elevation
- +24.0 EXIST. SPOT ELEVATION
- 10 EXIST. CONTOUR
- 24.0 NEW SPOT ELEVATION
- 54 NEW CONTOUR
- NEW SWALE
- DRAINAGE DIRECTION, EXISTING
- FL FLOWLINE
- o PP EXISTING POWER POLE
- NG OR G NATURAL GROUND, EXISTING
- R/C REBAR AND CAP, EXISTING
- o CLE CHAIN LINK FENCE, EXISTING
- NEW P.C.C., CONCRETE
- TG TOP OF GRATE (W/ ELEV.)

CALCULATIONS

DESIGN CRITERIA

HYDROLOGIC METHODS PER SECTION 22.2, HYDROLOGY OF THE DEVELOPMENT PROCESS MANUAL (DPM) REVISED JANUARY 1993 FOR CITY OF ALBUQUERQUE, ADOPTED BY THE COUNTY OF BERNALILLO

DISCHARGE RATE: $Q = CPEAK \times AREA$, Peak Discharge Rates For Small Watersheds

VOLUMETRIC DISCHARGE: $VOLUME = E \text{ Weighted} \times AREA$

P100 = 2.35 inches, Zone 2 Time of Concentration, TC = 10 Minutes

DESIGN STORM: 100-YEAR/6-HOUR, 10-YEAR/6-HOUR [] = 10 YEAR VALUES

EXISTING CONDITIONS

71% B (SAND), 29% HARDPAN 'C', LOT AREA = 0.43 ACRES, WHERE EXCESS PRECIP. 'W' = 0.88 in. [0.35]

PEAK DISCHARGE, Q100 = 1.1 CFS [0.6], WHERE UNIT PEAK DISCHARGE = 2.5 GFS/AC. [1.3]

THEREFORE: $VOLUME 100 = 1374 \text{ CF [546]}$

DEVELOPED CONDITIONS (Includes Paved Parking)

DETERMINE LAND TREATMENTS, PEAK DISCHARGE AND VOLUMETRIC DISCHARGE FOR STUDY AREA


AREA	LAND TREATMENT	Q Peak	E
UNDEVELOPED	0.00 Ac. (0%)	1.56 [0.38]	0.53 [0.13]
LANDSCAPING/Depress	0.15 Ac. (35%)	2.28 [0.95]	0.78 [0.28]
GRAVEL & COMPACTED SOIL	0.05 Ac. (12%)	3.14 [1.71]	1.13 [0.52]
ROOF - PAVEMENT	0.23 Ac. (53%)	4.70 [3.14]	2.12 [1.34]

THEREFORE: $E \text{ Weighted} = 1.53 \text{ in. [0.87]}$ & $VOLUME 100 = 2388 \text{ CF}$

Q100 = 1.6 CFS
Q10 = 1.0 CFS
VOLUME 10 = 1358 CF



DOWNSTREAM ANALYSIS

THE INCREASE OF RUNOFF RATE IS CONSIDERED MINIMAL FROM THE EXISTING CONDITIONS (0.5 CFS); THE DIFFERENCE WILL BE ROUTED INTO DEPRESSED LANDSCAPE AREA(S), THE REMAINING TWO-THIRDS OR 1 CFS WILL FREE-DISCHARGE TO THE STREET.

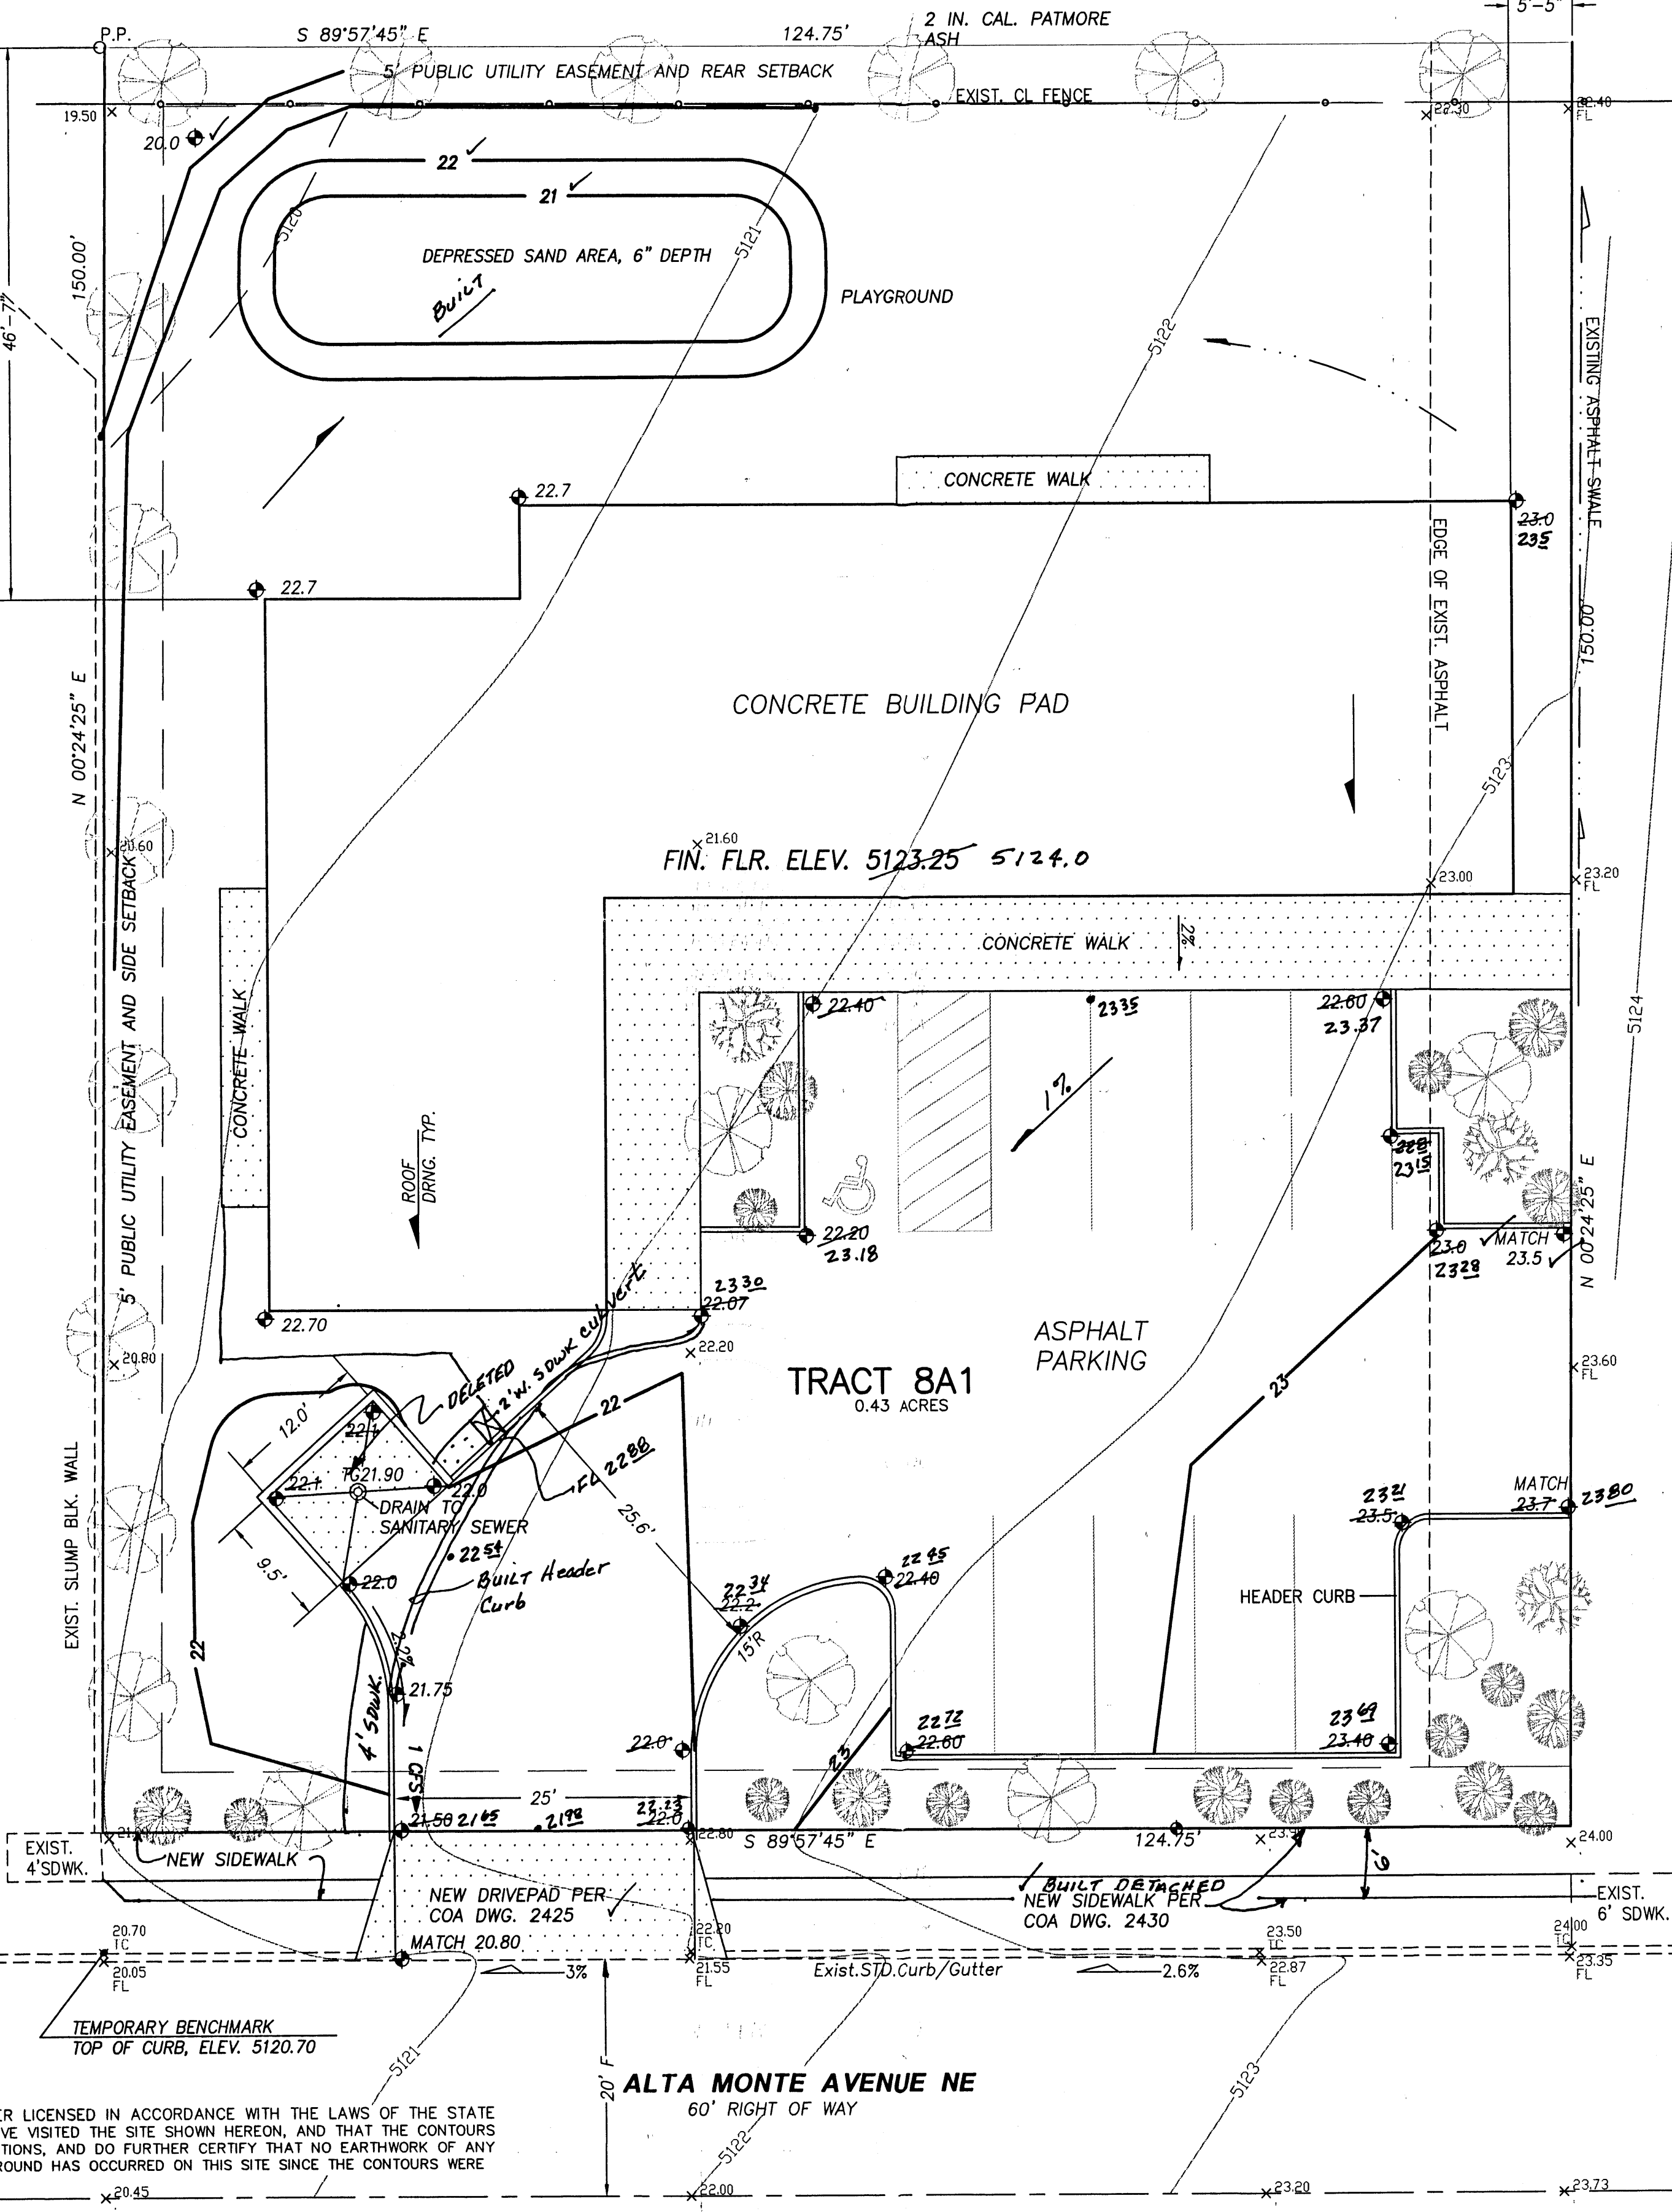

I, PHILIP W. CLARK, A PROFESSIONAL ENGINEER LICENSED IN ACCORDANCE WITH THE LAWS OF THE STATE OF NEW MEXICO, DO HEREBY CERTIFY THAT I HAVE VISITED THE SITE SHOWN HEREON, AND THAT THE CONTOURS SHOWN REPRESENT THE EXISTING GROUND CONDITIONS, AND DO FURTHER CERTIFY THAT NO EARTHWORK OF ANY KIND, NOR ANY DISTURBANCE OF THE EXISTING GROUND HAS OCCURRED ON THIS SITE SINCE THE CONTOURS WERE DETERMINED.

PHILIP W. CLARK NMPE #10265

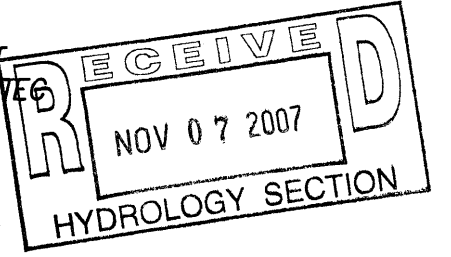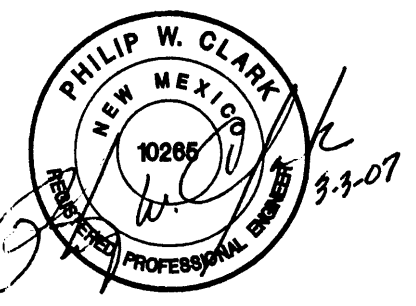

Clark Consulting Engineers	
19 Ryan Road Edgewood, New Mexico 87015 Tele: (505) 281-2444 Fax: (505) 281-2444	
DATE	REVISION
11-6-07	As. Carter
TR. 8A-1 OF BLOCK A, INDIAN ACRES ALBUQUERQUE, NEW MEXICO	
3301 ALTA MONTE AVENUE, NE	
Grading & Drainage Plan	
DESIGNED BY: PWC	DRAWN BY: CCE
CHECKED BY: PWC	DATE: 11/01/07
JOB #	FILE #
1 OF 1	