

TO ACCOMODATE THE ADJACENT FLOOD BOUNDARY, THE FINISHED FLOOR PROPOSED IS A MIN. OF 2 FEET ABOVE THE FLOWLINE ELEVATION OF TULANE DRIVE.

THE EXISTING SURVEY INFORMATION SHOWN HEREON WAS PREPARED FORM A FIELD SURVEY DONE BY WAYJOHN SURVEYING, INC., IN NOVEMBER OF 2003. A SUBSEQUENT FIELD REVIEW BY THIS OFFICE REVEALED THAT THE INFORMATION SHOWN IS CONSISTENT WITH THE ACTUAL CONDITIONS THAT EXIST IN THE FIELD.

RESULTS:

DEVELOPED VOLUMETRIC RUNOFF:

DEVELOPED PEAK DISCHARGE:

1648 - 1190 = 458 cf INCREASE IN RUNOFF VOLUME

1.07 - 0.91 = 0.16 cfs INCREASE IN PEAK DISCHARGE

office of the County Clerk of Bernalillo County, New Mexico, on June 5, 1952, in

FLOWLINE ELEVATION

ROOF DRAIN/DOWN SPOUT

RECORD DRAWING ELEV.

TOP OF ASPHALT

POWER POLE

FL

GENERAL NOTES

LOCATION MAP

- PRIOR TO ANY CONSTRUCTION, THE CONTRACTOR SHALL EXCAVATE AND VERIFY THE LOCATION OF ALL POTENTIAL OBSTRUCTIONS. SHOULD A CONFLICT EXIST, THE CONTRACTOR SHALL NOTIFY THE ENGINEER AS SOON AS POSSIBLE TO RESOLVE THE CONFLICT WITH A MINIMUM AMOUNT OF DELAY.
- ALL WORK ON THIS PLAN SHALL BE PERFORMED IN ACCORDANCE WITH APPLICABLE FEDERAL, STATE AND LOCAL LAWS, RULES AND REGULATIONS CONCERNING CONSTRUCTION SAFETY AND HEALTH.
- IF ANY UTILITY LINES, PIPELINES, OR UNDERGROUND UTILITY LINES ARE SHOWN ON THESE DRAWINGS, THEY ARE SHOWN IN AN APPROXIMATE LOCATION ONLY, AND LINES MAY EXIST WHERE NONE ARE SHOWN, THE LOCATION IS BASED UPON INFORMATION PROVIDED BY THE UTILITY OWNER OR FROM EXISTING PLANS, AND THIS INFORMATION MAY BE INCOMPLETE, OR OBSOLETE AT THE TIME OF CONSTRUCTION. THE ENGINEER HAS NOT UNDERTAKEN ANY FIELD VERIFICATION OF THESE LOCATIONS, LINE SIZES OR MATERIAL TYPE, MAKES NO REPRESENTATION THERETO, AND ASSUMES NO RESPONSIBILITY OR LIABILITY THEREFOR. THE CONTRACTOR SHALL INFORM ITSELF OF THE LOCATION OF ANY UTILITY LINE. PIPELINE OR UNDERGROUND INSTALLATION IN OR NEAR THE AREA IN ADVANCE OF AND DURING ANY EXCAVATION WORK. THE CONTRACTOR IS FULLY RESPONSIBLE FOR ANY AND ALL DAMAGES CAUSED BY ITS FAILURE TO LOCATE, IDENTIFY AND PRESERVE ANY AND ALL EXISTING UTILITIES. PIPELINES AND UNDERGROUND FACILITIES. IN PLANNING AND CONDUCTING EXCAVATIONS. THE CONTRACTOR SHALL COMPLY WITH ALL STATE STATUTES, MUNICIPAL AND LOCAL ORDINANCES, RULES AND REGULATIONS, IF ANY, PERTAINING TO THE LOCATION OF THESE LINES AND FACILITIES.
- THE CONTRACTOR SHALL INSURE THAT NO SOIL ERODES FROM THE SITE INTO PUBLIC RIGHTS-OF-WAY OR ONTO PRIVATE PROPERTY. THIS CAN BE ACHIEVED BY CONSTRUCTING TEMPORARY BERMS AND BY WETTING THE SOIL TO KEEP IT FROM BLOWING.
- THE CONTRACTOR SHALL OBTAIN ANY AND ALL PERMITS REQUIRED BY THE CITY OF ALB. FOR THE COMPLETION OF THE WORK PRIOR TO BEGINNING CONSTRUCTION.




EGEIVE MAR 3 0 2004 HYDROLOGY SECTION

ZONE MAP G-16

-3501 San Andres NE

File	* · · · · · · · · · · · · · · · · · · ·	Dat	e		······································	1		
Designed	Di	rawn	Ch	ecked	·····	Sheet	of	
	TCL	AND	GRA	/DIV	IG F	PLAN		
4-P	LEX	TULA	NE	&	SAN	1 AN	DR	ES

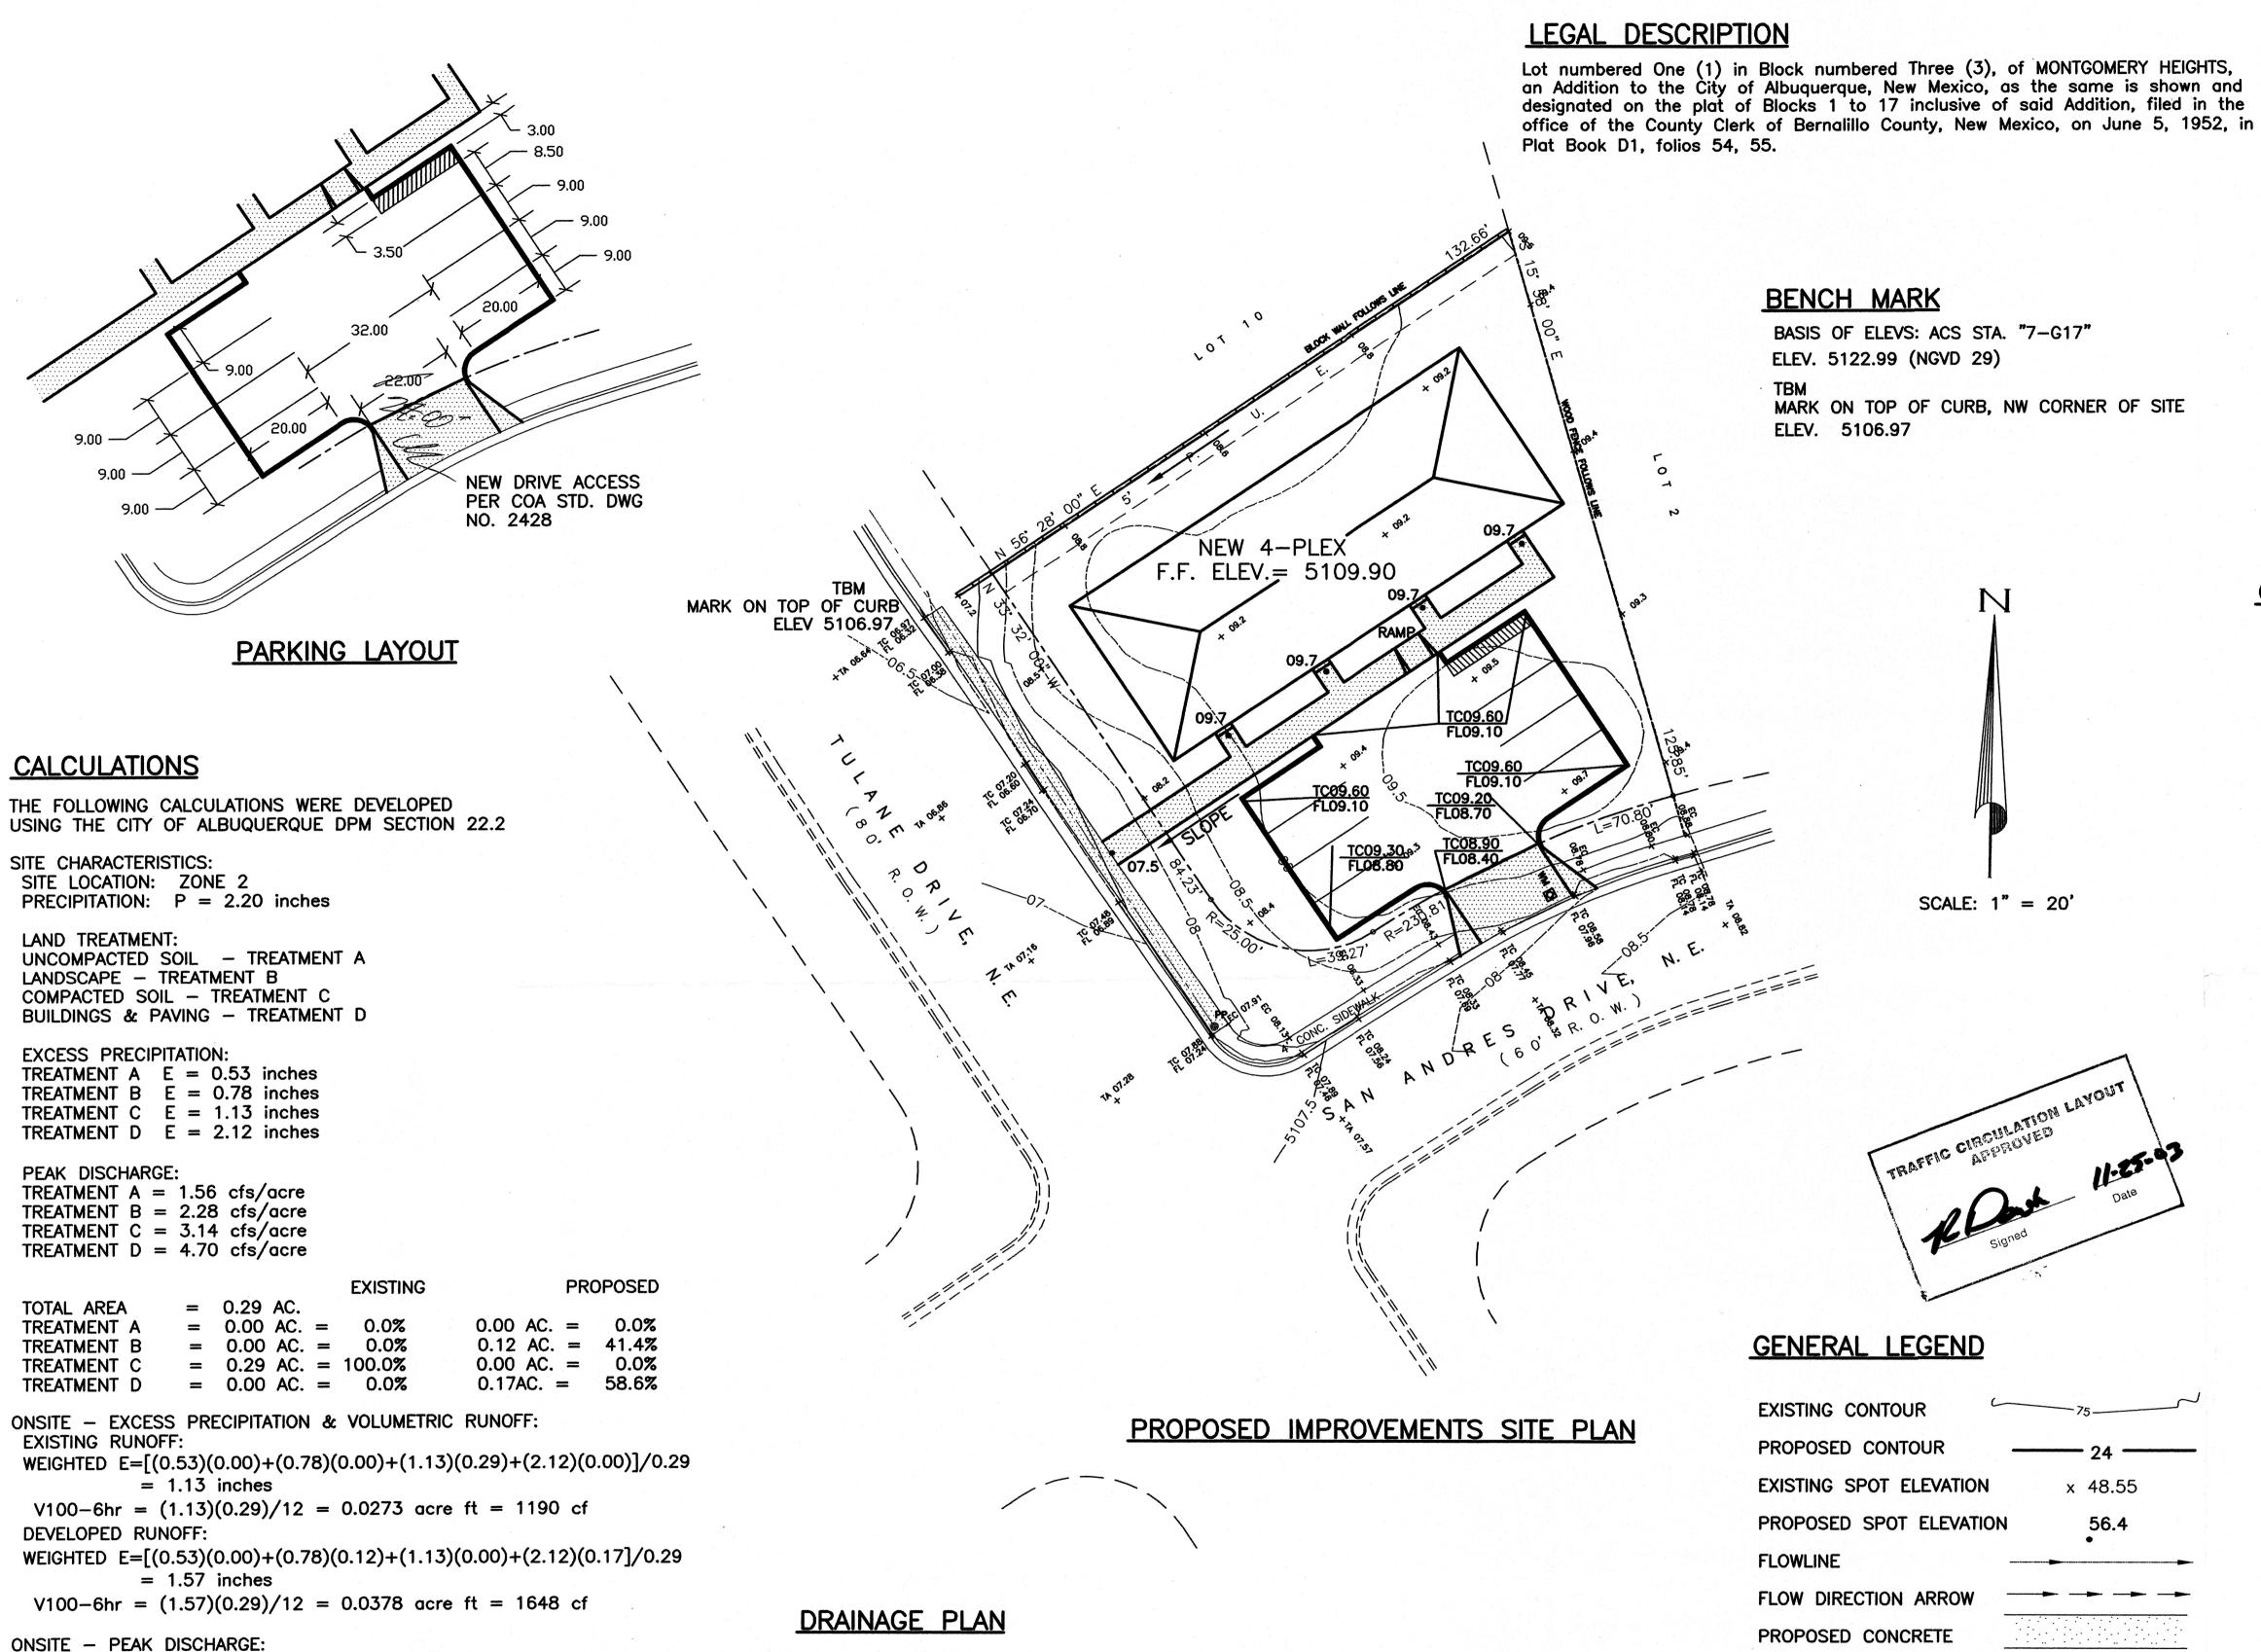

THIS SITE IS LOCATED ON THE NORTHEAST CORNER OF TULANE DRIVE SAN ANDRES DRIVE. THE SUBJECT PARCEL DOES NOT LIE WITHIN

DESIGNATED FLOOD HAZARD AREA. HOWEVER, THE ADJECENT TULANE ROAD IS WITHIN A FLOOD BOUNDARY ZONE AO DEPTH 1.

TO ACCOMODATE THE ADJACENT FLOOD BOUNDARY, THE FINISHED FLOOR PROPOSED A MIN. OF 2 FEET ABOVE THE FLOWLINE ELEVATION OF TULANE DRIVE.

EXISTING DISCHARGE:

RESULTS:

DEVELOPED DISCHARGE:

DEVELOPED VOLUMETRIC RUNOFF:

DEVELOPED PEAK DISCHARGE:

Q100 = (1.56)(0.00) + (2.28)(0.00) + (3.14)(0.29) + (4.70)(0.00) = 0.91 cfs


Q100 = (1.56)(0.00) + (2.28)(0.12) + (3.14)(0.00) + (4.70)(0.17) = 1.07 cfs

1648 - 1190 = 458 cf INCREASE IN RUNOFF VOLUME

1.07 - 0.91 = 0.16 cfs INCREASE IN PEAK DISCHARGE

THE EXISTING SURVEY INFORMATION SHOWN HEREON WAS PREPARED FORM A FIELD SURVEY DONE BY WAYJOHN SURVEYING, INC., IN NOVEMBER OF 2003. A SUBSEQUENT FIELD REVIEW BY THIS OFFICE REVEALED THAT THE INFORMATION SHOWN IS CONSISTENT WITH THE ACTUAL CONDITIONS THAT EXIST IN THE FIELD.

EXISTING CONTOUR	75
PROPOSED CONTOUR	24
EXISTING SPOT ELEVATION	x 48.55
PROPOSED SPOT ELEVATION	56.4
FLOWLINE	
FLOW DIRECTION ARROW	
PROPOSED CONCRETE	
TOP OF CURB ELEVATION	TC
TOP OF WALL ELEVATION	TW
FLOWLINE ELEVATION	FL
TOP OF ASPHALT	TA
POWER POLE	PP
ROOF DRAIN/DOWN SPOUT	D.S.

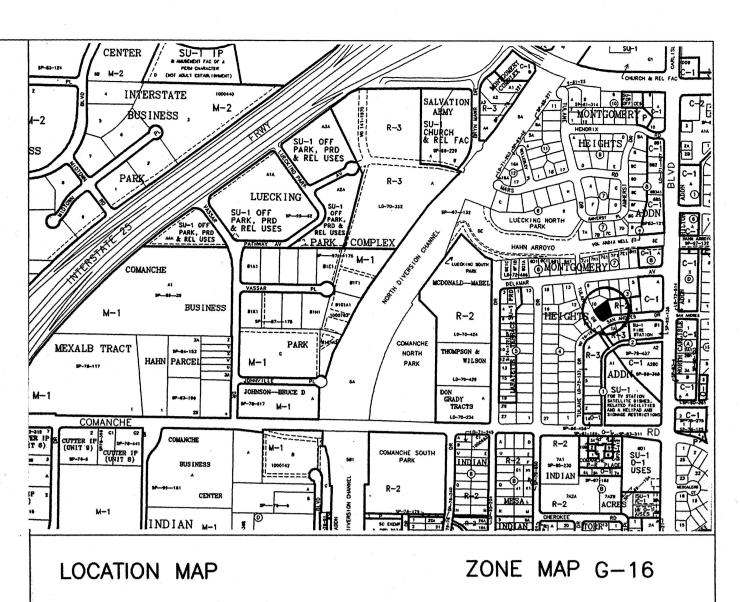


GENERAL NOTES

- PRIOR TO ANY CONSTRUCTION, THE CONTRACTOR SHALL EXCAVATE AND VERIFY THE LOCATION OF ALL POTENTIAL OBSTRUCTIONS. SHOULD A CONFLICT EXIST, THE CONTRACTOR SHALL NOTIFY THE ENGINEER AS SOON AS POSSIBLE TO RESOLVE THE CONFLICT WITH A MINIMUM AMOUNT OF DELAY.
- ALL WORK ON THIS PLAN SHALL BE PERFORMED IN ACCORDANCE WITH APPLICABLE FEDERAL, STATE AND LOCAL LAWS, RULES AND REGULATIONS CONCERNING CONSTRUCTION SAFETY AND HEALTH.
- IF ANY UTILITY LINES, PIPELINES, OR UNDERGROUND UTILITY LINES ARE SHOWN ON THESE DRAWINGS, THEY ARE SHOWN IN AN APPROXIMATE LOCATION ONLY, AND LINES MAY EXIST WHERE NONE ARE SHOWN, THE LOCATION IS BASED UPON INFORMATION PROVIDED BY THE UTILITY OWNER OR FROM EXISTING PLANS, AND THIS INFORMATION MAY BE INCOMPLETE OR OBSOLETE AT THE TIME OF CONSTRUCTION. THE ENGINEER HAS NOT UNDERTAKEN ANY FIELD VERIFICATION OF THESE LOCATIONS, LINE SIZES OR MATERIAL TYPE, MAKES NO REPRESENTATION THERETO, AND ASSUMES NO RESPONSIBILITY OR LIABILITY THEREFOR. THE CONTRACTOR SHALL INFORM ITSELF OF THE LOCATION OF ANY UTILITY LINE. PIPELINE OR UNDERGROUND INSTALLATION IN OR NEAR THE AREA IN ADVANCE OF AND DURING ANY EXCAVATION WORK. THE CONTRACTOR IS FULLY RESPONSIBLE FOR ANY AND ALL DAMAGES CAUSED BY ITS FAILURE TO LOCATE, IDENTIFY AND PRESERVE ANY AND ALL EXISTING UTILITIES, PIPELINES AND UNDERGROUND FACILITIES. IN PLANNING AND CONDUCTING EXCAVATIONS, THE CONTRACTOR SHALL COMPLY WITH ALL STATE STATUTES, MUNICIPAL AND LOCAL ORDINANCES, RULES AND REGULATIONS, IF ANY, PERTAINING TO THE LOCATION OF THESE LINES AND FACILITIES.
- THE CONTRACTOR SHALL INSURE THAT NO SOIL ERODES FROM THE SITE INTO PUBLIC RIGHTS-OF-WAY OR ONTO PRIVATE PROPERTY. THIS CAN BE ACHIEVED BY CONSTRUCTING TEMPORARY BERMS AND BY WETTING THE SOIL TO KEEP IT FROM BLOWING.
- THE CONTRACTOR SHALL OBTAIN ANY AND ALL PERMITS REQUIRED BY THE CITY OF ALB. FOR THE COMPLETION OF THE WORK PRIOR TO BEGINNING CONSTRUCTION.



11/26/03

4-PLEX TULANE & SAN ANDRES TCL AND GRADING PLAN Checked

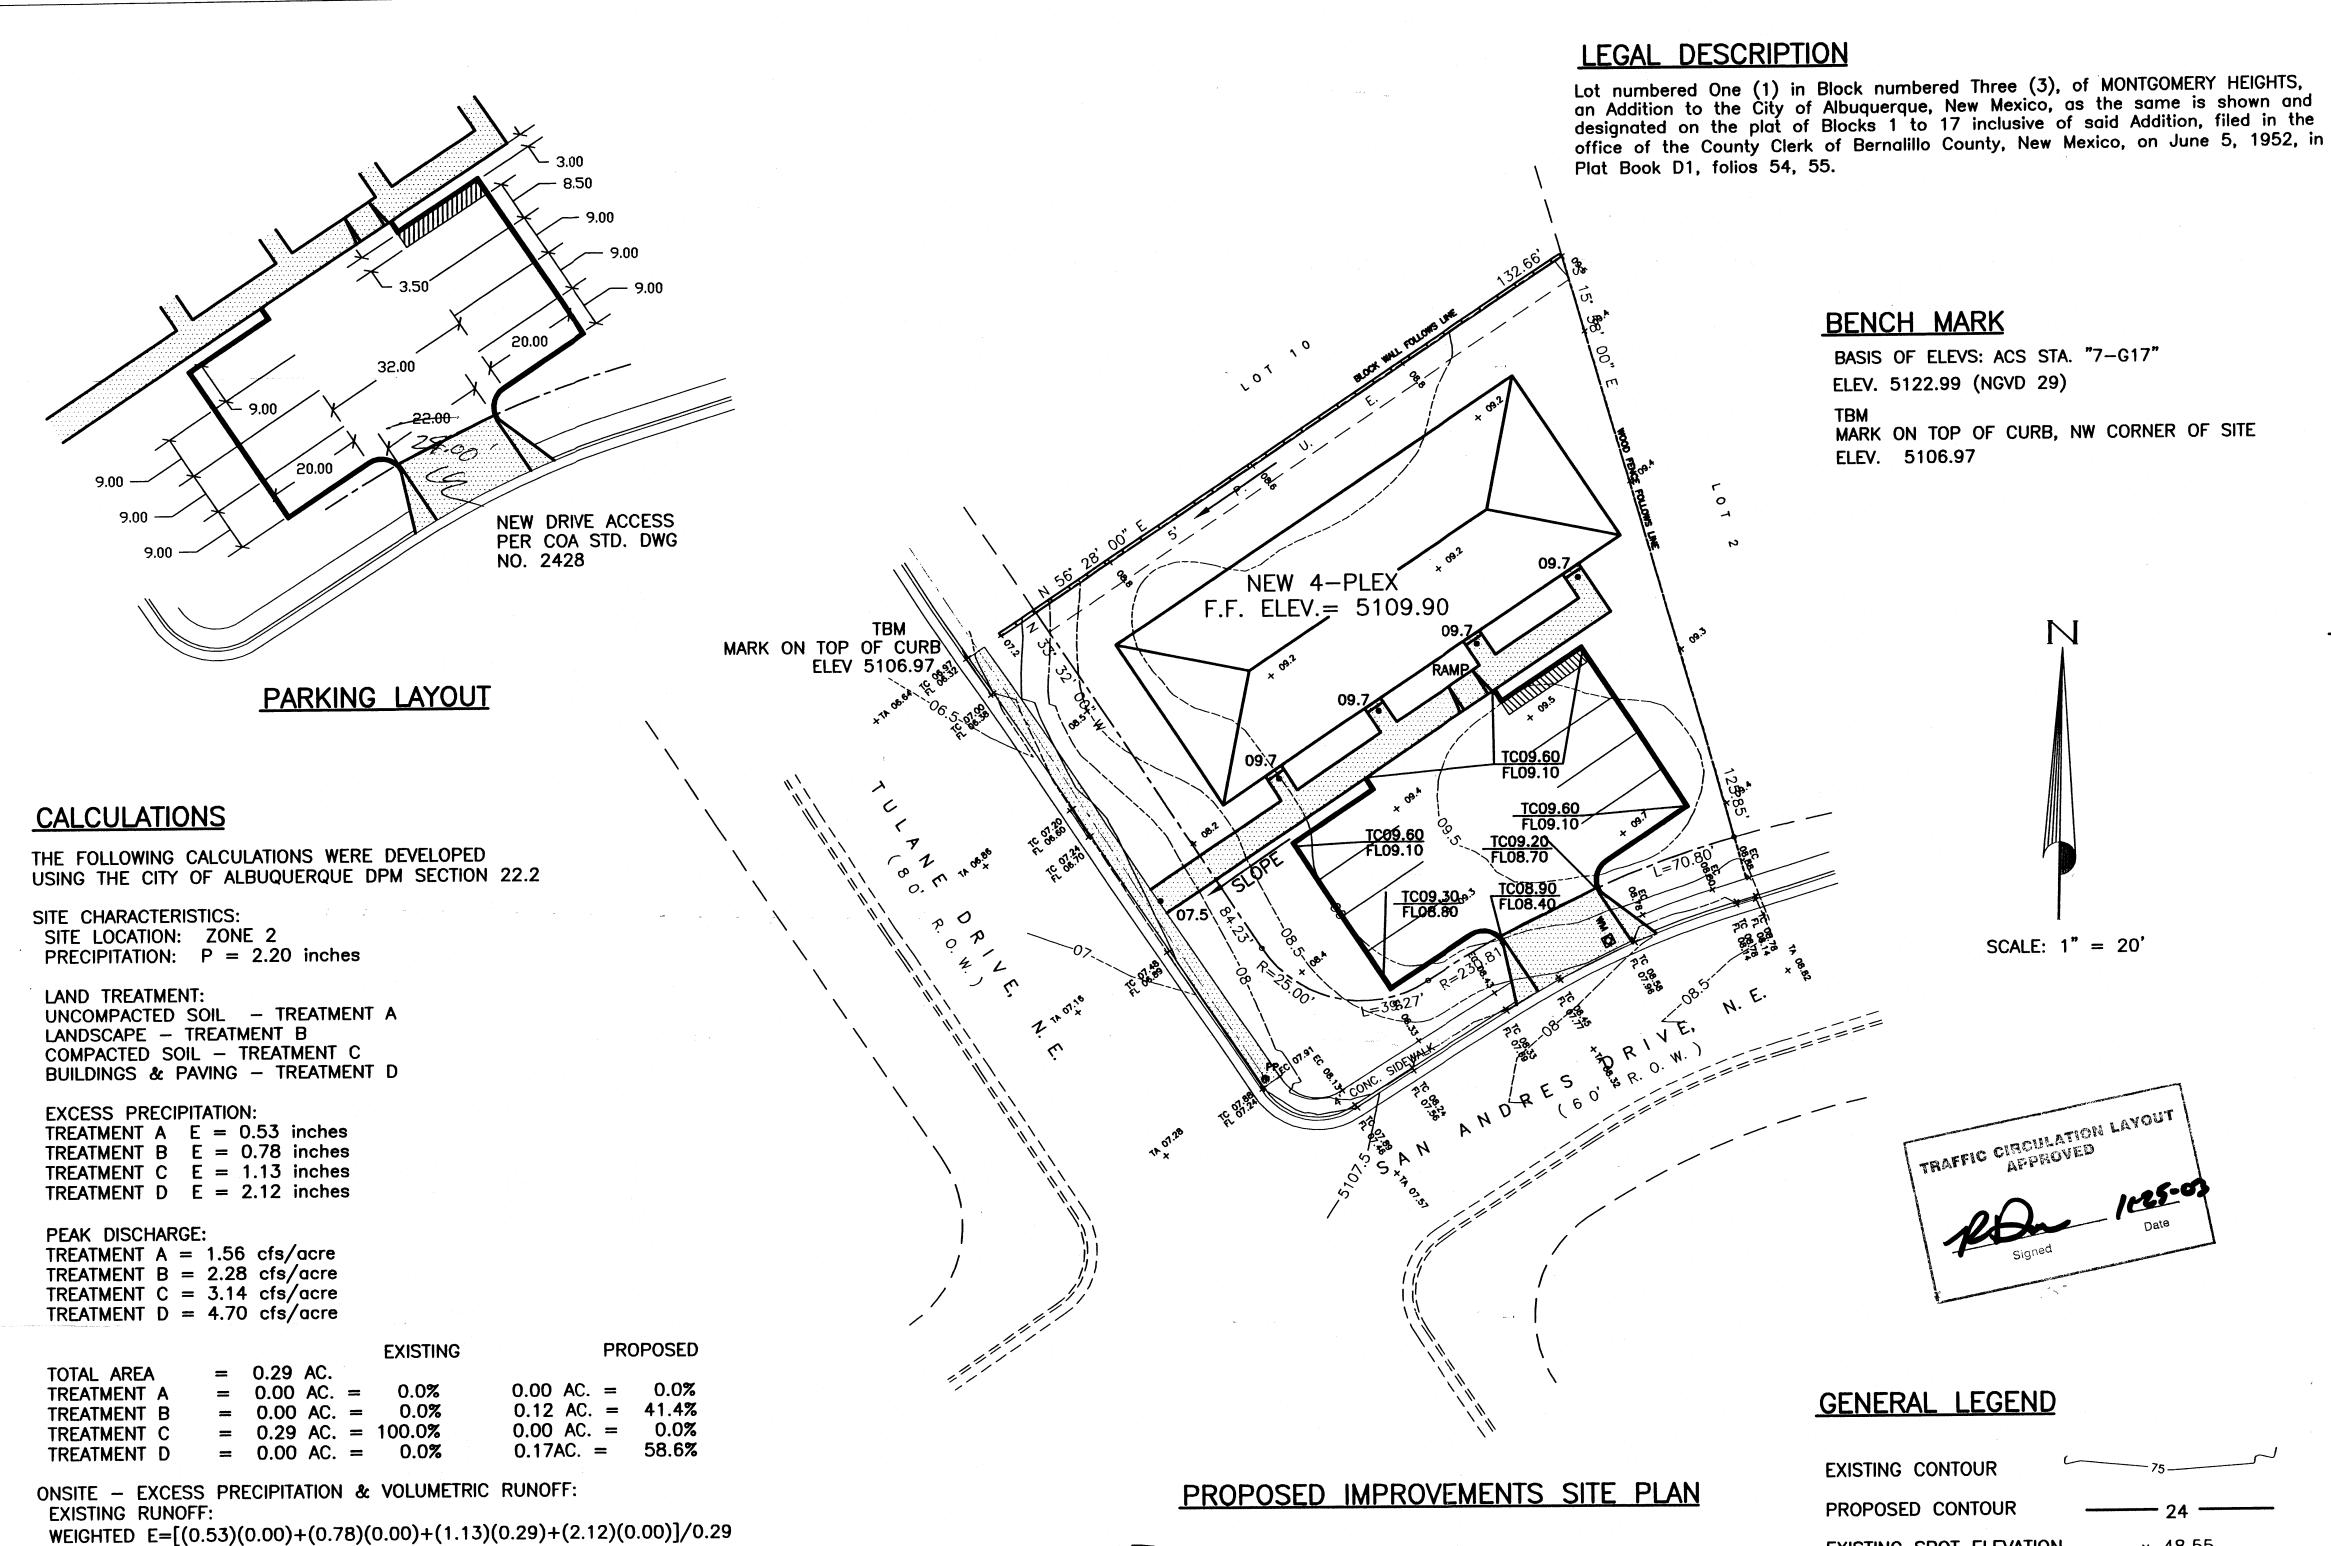

= 1.13 inches

= 1.57 inches

DEVELOPED RUNOFF:

ONSITE - PEAK DISCHARGE:

EXISTING DISCHARGE:

RESULTS:

DEVELOPED DISCHARGE:

DEVELOPED VOLUMETRIC RUNOFF:

DEVELOPED PEAK DISCHARGE:

V100-6hr = (1.13)(0.29)/12 = 0.0273 acre ft = 1190 cf

V100-6hr = (1.57)(0.29)/12 = 0.0378 acre ft = 1648 cf

WEIGHTED E=[(0.53)(0.00)+(0.78)(0.12)+(1.13)(0.00)+(2.12)(0.17]/0.29


Q100 = (1.56)(0.00) + (2.28)(0.00) + (3.14)(0.29) + (4.70)(0.00) = 0.91 cfs

Q100 = (1.56)(0.00) + (2.28)(0.12) + (3.14)(0.00) + (4.70)(0.17) = 1.07 cfs

1648 - 1190 = 458 cf INCREASE IN RUNOFF VOLUME

1.07 - 0.91 = 0.16 cfs INCREASE IN PEAK DISCHARGE

THE EXISTING SURVEY INFORMATION SHOWN HEREON WAS PREPARED FORM A FIELD SURVEY DONE BY WAYJOHN SURVEYING, INC., IN NOVEMBER OF 2003. SHOWN IS CONSISTENT WITH THE ACTUAL CONDITIONS THAT EXIST IN THE FIELD.

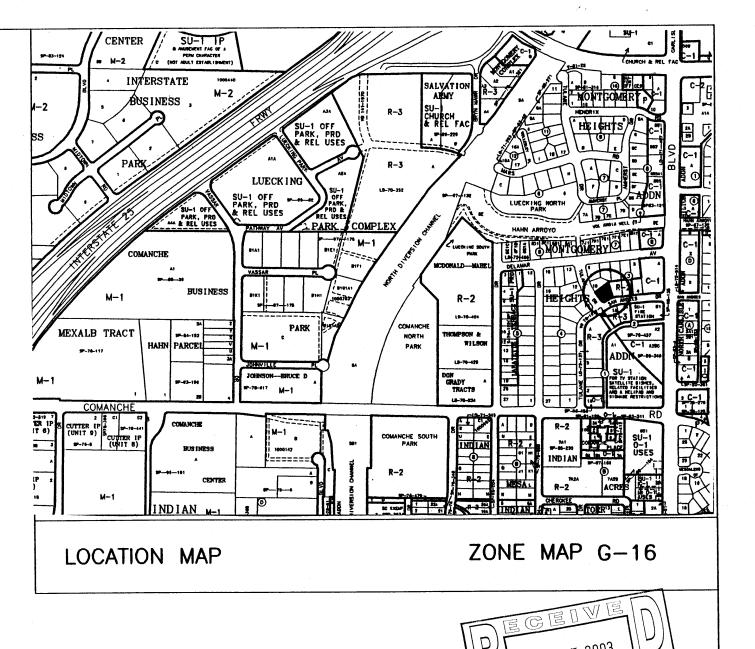

GENERAL NOTES

x 48.55

TW

TA

D.S.

56.4

EXISTING SPOT ELEVATION

FLOW DIRECTION ARROY

PROPOSED CONCRETE

TOP OF CURB ELEVATION

TOP OF WALL ELEVATION

ROOF DRAIN/DOWN SPOUT

FLOWLINE ELEVATION

TOP OF ASPHALT

POWER POLE

FLOWLINE

PROPOSED SPOT ELEVATION

- PRIOR TO ANY CONSTRUCTION, THE CONTRACTOR SHALL EXCAVATE AND VERIFY THE LOCATION OF ALL POTENTIAL OBSTRUCTIONS. SHOULD A CONFLICT EXIST, THE CONTRACTOR SHALL NOTIFY THE ENGINEER AS SOON AS POSSIBLE TO RESOLVE THE CONFLICT WITH A MINIMUM AMOUNT OF DELAY.
- ALL WORK ON THIS PLAN SHALL BE PERFORMED IN ACCORDANCE WITH APPLICABLE FEDERAL, STATE AND LOCAL LAWS, RULES AND REGULATIONS CONCERNING CONSTRUCTION SAFETY AND HEALTH.
- IF ANY UTILITY LINES, PIPELINES, OR UNDERGROUND UTILITY LINES ARE SHOWN ON THESE DRAWINGS, THEY ARE SHOWN IN AN APPROXIMATE LOCATION ONLY, AND LINES MAY EXIST WHERE NONE ARE SHOWN, THE LOCATION IS BASED UPON INFORMATION PROVIDED BY THE UTILITY OWNER OR FROM EXISTING PLANS, AND THIS INFORMATION MAY BE INCOMPLETE, OR OBSOLETE AT THE TIME OF CONSTRUCTION. THE ENGINEER HAS NOT UNDERTAKEN ANY FIELD VERIFICATION OF THESE LOCATIONS, LINE SIZES OR MATERIAL TYPE, MAKES NO REPRESENTATION THERETO, AND ASSUMES NO RESPONSIBILITY OR LIABILITY THEREFOR. THE CONTRACTOR SHALL INFORM ITSELF OF THE LOCATION OF ANY UTILITY LINE, PIPELINE OR UNDERGROUND INSTALLATION IN OR NEAR THE AREA IN ADVANCE OF AND DURING ANY EXCAVATION WORK. THE CONTRACTOR IS FULLY RESPONSIBLE FOR ANY AND ALL DAMAGES CAUSED BY ITS FAILURE TO LOCATE, IDENTIFY AND PRESERVE ANY AND ALL **EXISTING UTILITIES. PIPELINES AND UNDERGROUND FACILITIES.** IN PLANNING AND CONDUCTING EXCAVATIONS, THE CONTRACTOR SHALL COMPLY WITH ALL STATE STATUTES, MUNICIPAL AND LOCAL ORDINANCES, RULES AND REGULATIONS, IF ANY, PERTAINING TO THE LOCATION OF THESE LINES AND FACILITIES.
- THE CONTRACTOR SHALL INSURE THAT NO SOIL ERODES FROM THE SITE INTO PUBLIC RIGHTS-OF-WAY OR ONTO PRIVATE PROPERTY. THIS CAN BE ACHIEVED BY CONSTRUCTING TEMPORARY BERMS AND BY WETTING THE SOIL TO KEEP IT FROM BLOWING.
- THE CONTRACTOR SHALL OBTAIN ANY AND ALL PERMITS REQUIRED BY THE CITY OF ALB. FOR THE COMPLETION OF THE WORK PRIOR TO BEGINNING CONSTRUCTION.




Designed	C)rawn	Checked	Shee	t of
	TCL	AND	GRADIN	G PLA	N
4-P	LEX	TULA	NE &	SAN A	ANDRES

DRAINAGE PLAN

THIS SITE IS LOCATED ON THE NORTHEAST CORNER OF TULANE DRIVE SAN ANDRES DRIVE. THE SUBJECT PARCEL DOES NOT LIE WITHIN A DESIGNATED FLOOD HAZARD AREA. HOWEVER, THE ADJECENT TULANE ROAD IS WITHIN A FLOOD BOUNDARY ZONE AO DEPTH 1. TO ACCOMODATE THE ADJACENT FLOOD BOUNDARY, THE FINISHED FLOOR PROPOSED IS A MIN. OF 2 FEET ABOVE THE FLOWLINE ELEVATION OF TULANE DRIVE.

A SUBSEQUENT FIELD REVIEW BY THIS OFFICE REVEALED THAT THE INFORMATION

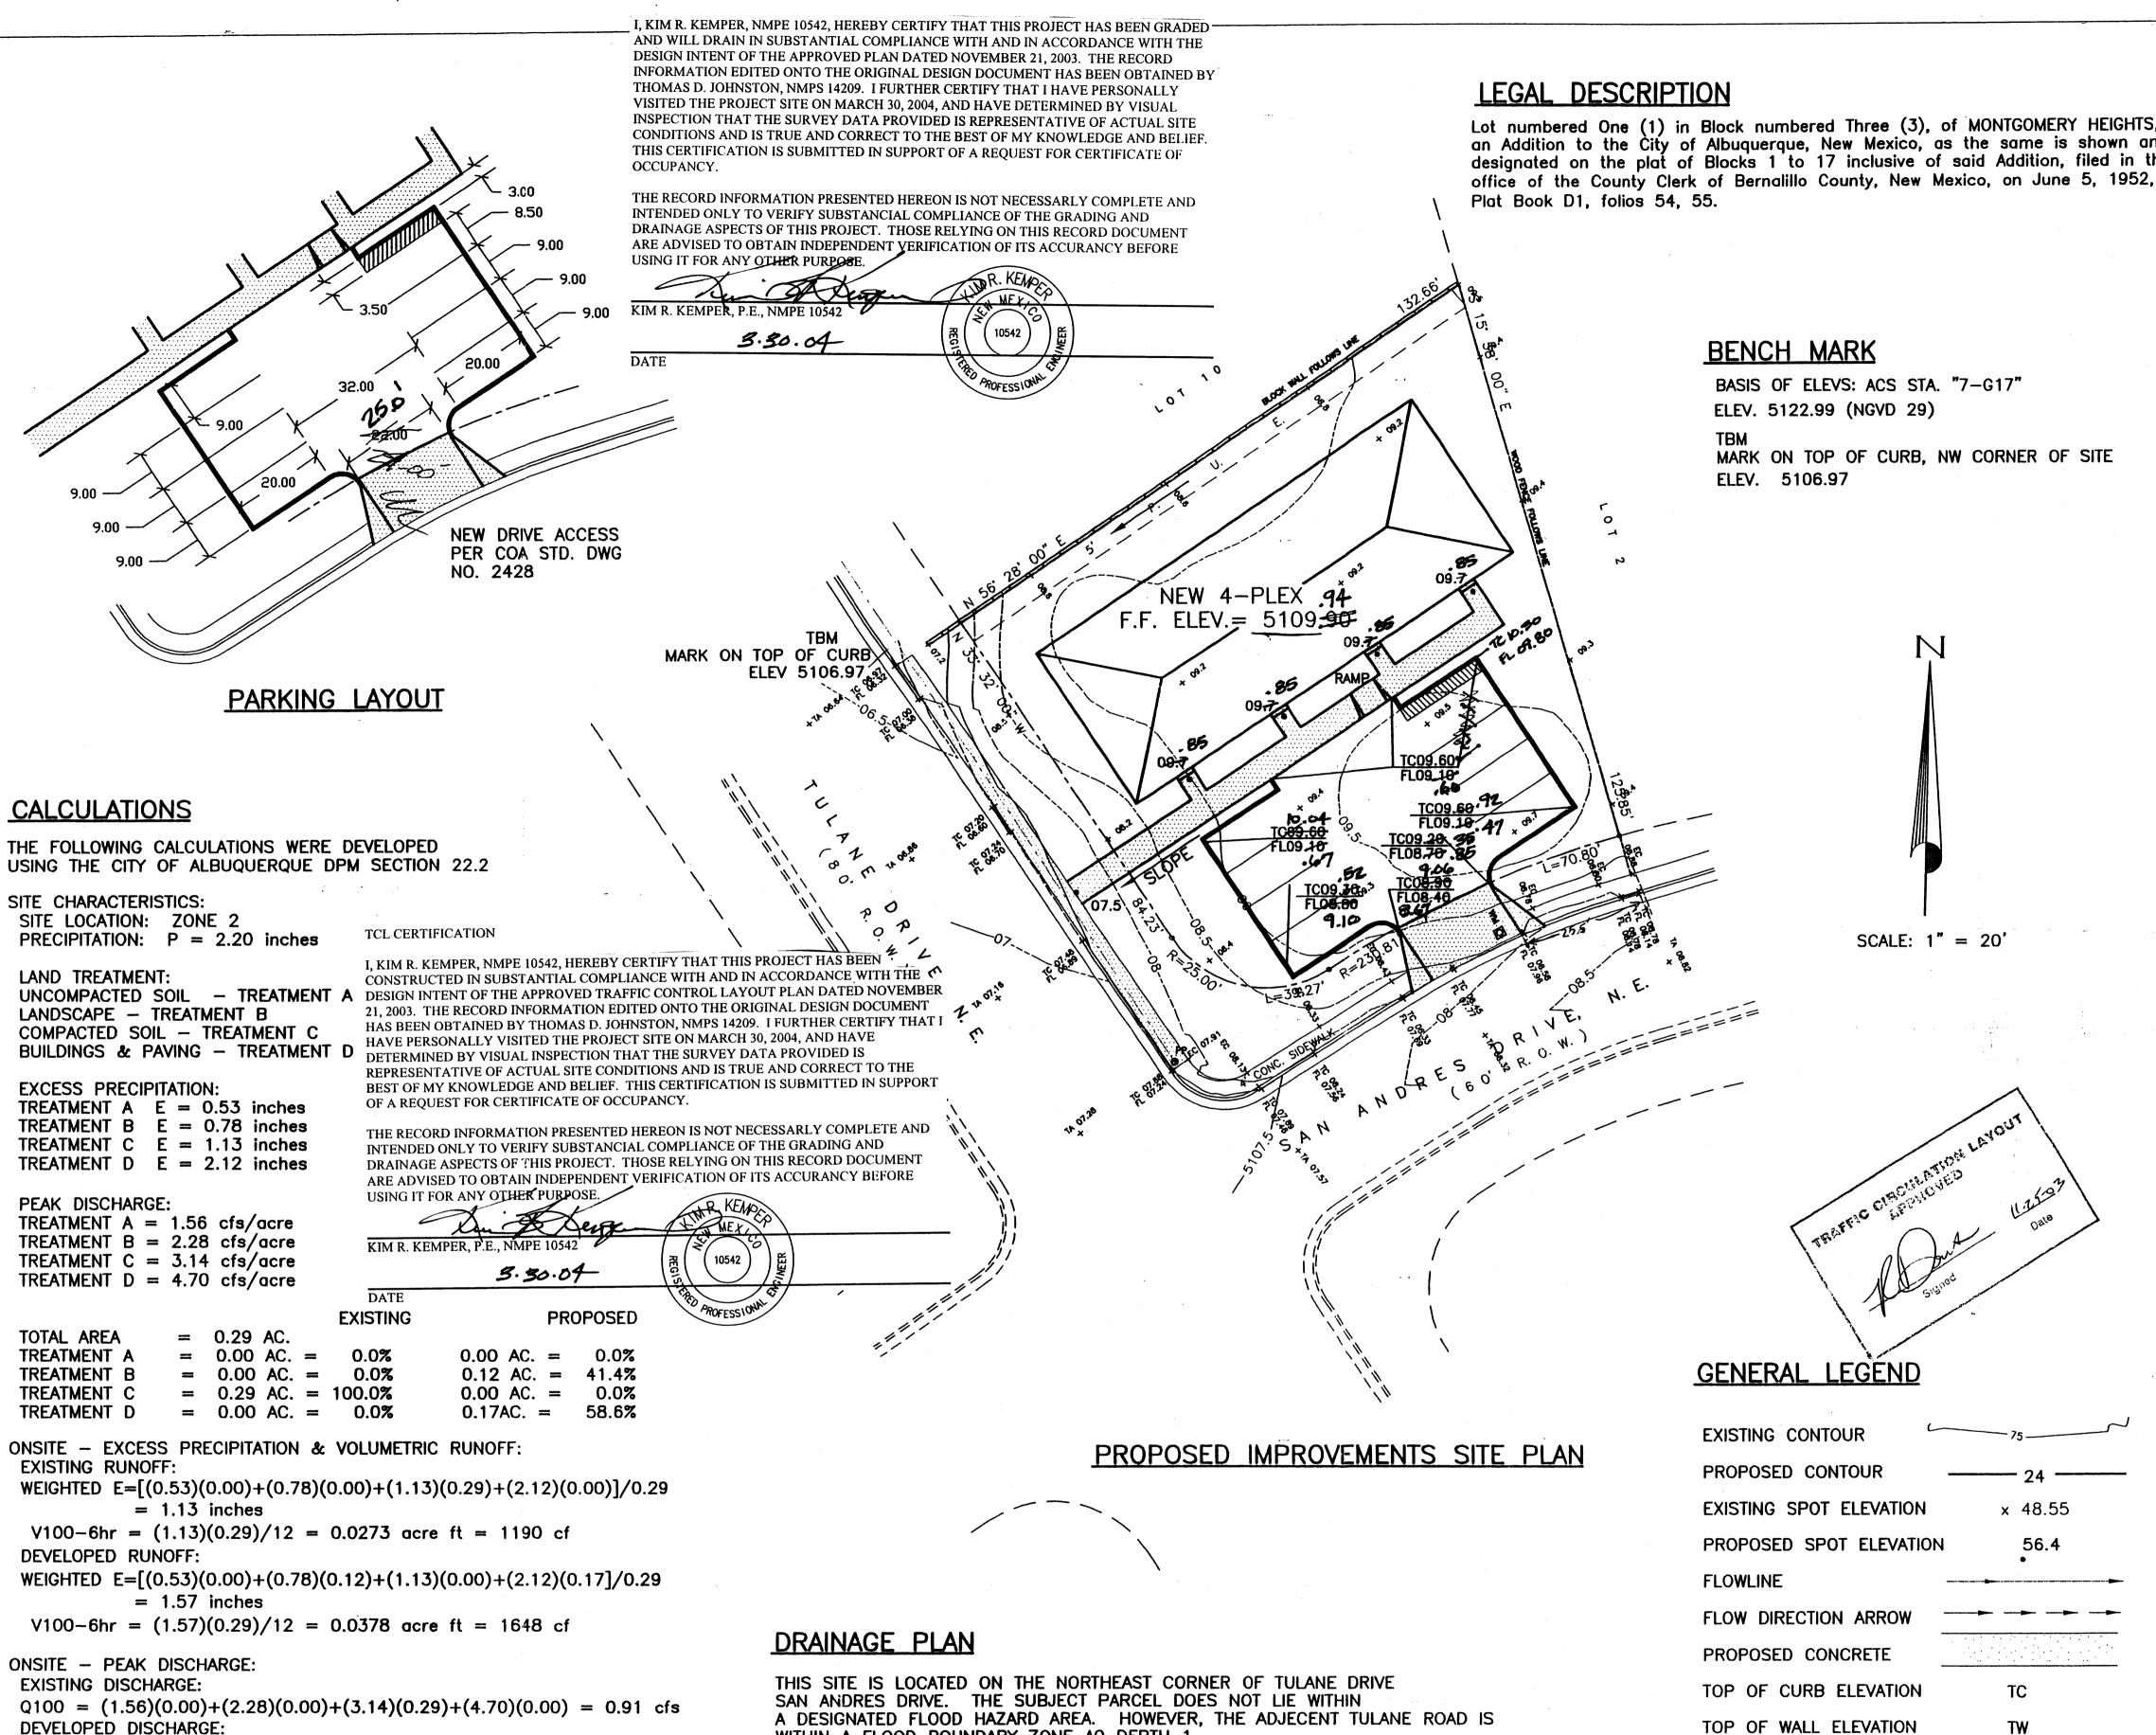

DRAINAGE CERTIFICATION

Q100 = (1.56)(0.00) + (2.28)(0.12) + (3.14)(0.00) + (4.70)(0.17) = 1.07 cfs

1648 - 1190 = 458 cf INCREASE IN RUNOFF VOLUME

1.07 - 0.91 = 0.16 cfs INCREASE IN PEAK DISCHARGE

RESULTS:

DEVELOPED VOLUMETRIC RUNOFF:

DEVELOPED PEAK DISCHARGE:

A DESIGNATED FLOOD HAZARD AREA. HOWEVER, THE ADJECENT TULANE ROAD IS WITHIN A FLOOD BOUNDARY ZONE AO DEPTH 1. TO ACCOMODATE THE ADJACENT FLOOD BOUNDARY. THE FINISHED FLOOR PROPOSED IS A MIN. OF 2 FEET ABOVE THE FLOWLINE ELEVATION OF TULANE DRIVE.

THE EXISTING SURVEY INFORMATION SHOWN HEREON WAS PREPARED FORM A FIELD SURVEY DONE BY WAYJOHN SURVEYING, INC., IN NOVEMBER OF 2003. A SUBSEQUENT FIELD REVIEW BY THIS OFFICE REVEALED THAT THE INFORMATION SHOWN IS CONSISTENT WITH THE ACTUAL CONDITIONS THAT EXIST IN THE FIELD.

Lot numbered One (1) in Block numbered Three (3), of MONTGOMERY HEIGHTS, an Addition to the City of Albuquerque, New Mexico, as the same is shown and designated on the plat of Blocks 1 to 17 inclusive of said Addition, filed in the office of the County Clerk of Bernalillo County, New Mexico, on June 5, 1952, in

FLOWLINE ELEVATION

ROOF DRAIN/DOWN SPOUT

RECORD DRAWING ELEV.

D.S.

09.60

TOP OF ASPHALT

POWER POLE


GENERAL NOTES

LOCATION MAP

PRIOR TO ANY CONSTRUCTION, THE CONTRACTOR SHALL EXCAVATE AND VERIFY THE LOCATION OF ALL POTENTIAL OBSTRUCTIONS. SHOULD A CONFLICT EXIST, THE CONTRACTOR SHALL NOTIFY THE ENGINEER AS SOON AS POSSIBLE TO RESOLVE THE CONFLICT WITH A MINIMUM AMOUNT OF DELAY.

ZONE MAP G-16

- ALL WORK ON THIS PLAN SHALL BE PERFORMED IN ACCORDANCE WITH APPLICABLE FEDERAL, STATE AND LOCAL LAWS, RULES AND REGULATIONS CONCERNING CONSTRUCTION SAFETY AND HEALTH.
- IF ANY UTILITY LINES, PIPELINES, OR UNDERGROUND UTILITY LINES ARE SHOWN ON THESE DRAWINGS, THEY ARE SHOWN IN AN APPROXIMATE LOCATION ONLY, AND LINES MAY EXIST WHERE NONE ARE SHOWN, THE LOCATION IS BASED UPON INFORMATION PROVIDED BY THE UTILITY OWNER OR FROM EXISTING PLANS, AND THIS INFORMATION MAY BE INCOMPLETE, OR OBSOLETE AT THE TIME OF CONSTRUCTION. THE ENGINEER HAS NOT UNDERTAKEN ANY FIELD VERIFICATION OF THESE LOCATIONS, LINE SIZES OR MATERIAL TYPE, MAKES NO REPRESENTATION THERETO, AND ASSUMES NO RESPONSIBILITY OR LIABILITY THEREFOR. THE CONTRACTOR SHALL INFORM ITSELF OF THE LOCATION OF ANY UTILITY LINE, PIPELINE OR UNDERGROUND INSTALLATION IN OR NEAR THE AREA IN ADVANCE OF AND DURING ANY EXCAVATION WORK. THE CONTRACTOR IS FULLY RESPONSIBLE FOR ANY AND ALL DAMAGES CAUSED BY ITS FAILURE TO LOCATE, IDENTIFY AND PRESERVE ANY AND ALL EXISTING UTILITIES, PIPELINES AND UNDERGROUND FACILITIES. IN PLANNING AND CONDUCTING EXCAVATIONS, THE CONTRACTOR SHALL COMPLY WITH ALL STATE STATUTES, MUNICIPAL AND LOCAL ORDINANCES, RULES AND REGULATIONS, IF ANY, PERTAINING TO THE LOCATION OF THESE LINES AND FACILITIES.
- THE CONTRACTOR SHALL INSURE THAT NO SOIL ERODES FROM THE SITE INTO PUBLIC RIGHTS-OF-WAY OR ONTO PRIVATE PROPERTY. THIS CAN BE ACHIEVED BY CONSTRUCTING TEMPORARY BERMS AND BY WETTING THE SOIL TO KEEP IT FROM BLOWING.
- THE CONTRACTOR SHALL OBTAIN ANY AND ALL PERMITS REQUIRED BY THE CITY OF ALB. FOR THE COMPLETION OF THE WORK PRIOR TO BEGINNING CONSTRUCTION.

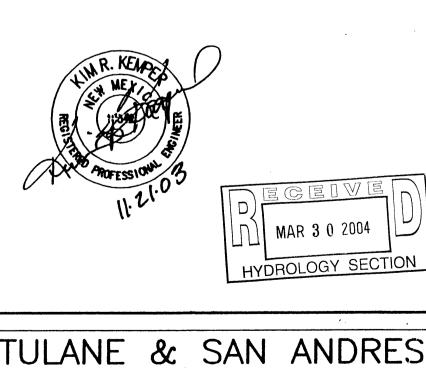

Checked	Sł	neet of	1
) GRADII	NG PL	.AN	
			\
			ANE & SAN ANDF GRADING PLAN