CITY OF ALBUQUERQUE



July 15, 2016

David Aube Design Group 120 Vassar SE, Suite 100 Albuquerque, NM

Re: APS Family School East Side
3303 Monroe NE
Traffic Circulation Layout
Engineer's/Architect's Stamp 6-10-16 (G17-D019A)

Dear Mr. Aube,

Based upon the information provided in your submittal received 7-12-16, the above referenced plan cannot be approved for Building Permit until the following comments are addressed:

- 1. List the number of parking spaces required by the zoning code as well as the proposed number of parking spaces.
- Please identify and detail all proposed buildings, doors, structures, sidewalks, curbs, drive pads, wall and anything that influences the parking and circulation on the site.
- Identify and dimension all existing access easements and rights of way width dimensions.
- 4. Identify the right of way width, medians, sidewalks, ADA ramps, curb cuts and street widths on Monroe St. and Bus drop-off driveway.
- 5. Please list the width and length for all existing and proposed parking spaces, including HC spaces and access isles.
- 6. Label the compact parking spaces by placing the words "COMPACT" on the pavement of each space.
- 7. The handicap accessible spaces must be a minimum of 8.5 ft. in width.
- 8. The handicap accessible spaces must include an 8 ft. wide van access aisle; all other aisles should be 5 ft. in width.
- The ADA accessible parking sign must have the required language per 66-7-352.4C NMSA 1978 "Violators Are Subject to a Fine and/or Towing." Please call out detail and location of HC signs.
- 10. The ADA access aisles shall have the words "NO PARKING" in capital letters, each of which shall be at least one foot high and at least two inches wide, placed at the rear of the parking space so as to be close to where an adjacent vehicle's rear tire would be placed. (66-1-4.1.B NMSA 1978)
- 11. Show all drive aisle widths and radii.

PO Box 1293

Albuquerque

New Mexico 87103

www.cabq.gov

CITY OF ALBUQUERQUE



- 12. Per DPM, a 6 ft. wide ADA accessible pedestrian pathway is required from the public sidewalk to the building entrances. Please clearly show this pathway and provide details.
- 13. Per DPM, a 6 ft. wide ADA accessible pedestrian pathway is required from the HC parking stall access aisles to the building entrances. Please clearly show this pathway and provide details.
- 14. Provide a min 6" or max 8" high concrete barrier curb or other acceptable barrier between landscaping and parking areas and/or drive aisles. Please call out detail and location of barrier curb.
- 15. One-way vehicular paths require pavement directional signage and a posted "Do Not Enter" sign at the point of egress. Please show detail and location of posted signs.
- 16. Please provide a sight distance exhibit (see the Development Process Manual, Chapter 23, Section 3, Part D.5). Please provide this detail for entrances/exits on Monroe St. and the north parking lot exit west of the proposed new Family School Phase 2 building.
- 17. Please add the following note to the clear sight triangle: "Landscaping and signage will not interfere with clear sight requirements. Therefore, signs, walls, trees, and shrubbery between 3 and 8 feet tall (as measured from the gutter pan) will not be acceptable in this area."
- 18. Please add a note on the plan stating "All improvements located in the Right of Way must be included on the work order."
- All broken or cracked sidewalk must be replaced with sidewalk and curb & gutter. A build note must be provided referring to the appropriate City Standard drawing.
- 20. Please include two copies of the traffic circulation layout at the next submittal.

Resubmit acceptable package along with fully completed Drainage Transportation Information Sheet to front counter personnel for log in and evaluation by Transportation. If you have any questions, please contact Gary Sandoval (505) 924-

3675 or me at 924-3991.

Sincerely.

New Mexico 87103

www.cabq.gov

PO Box 1293

Albuquerque

Racquel M. Michel, P.E.

Traffic Engineer, Planning Dept. Development Review Services

\gs via: email C: CO Clerk, File

DRAINAGE AND TRANSPORTATION INFORMATION SHEET

(REV. 1/28/2003rd)


PROJECT TITLE: APS Family School East Side DRB #: EPC#:	ZONE MAP/DRG. FILE #:G-17-DDC 19A) WORK ORDER#:
LEGAL DESCRIPTION: <u>Portions of Tracts D and E, Board</u> CITY ADDRESS: <u>3303 Monroe Street NE.</u>	of Education Addition.
ENGINEERING FIRM: Design Group ADDRESS: 120 Vassar SE, Suite 100 CITY, STATE: Albuquerque, NM	CONTACT: <u>David Aube</u> PHONE: <u>998-6430</u> ZIP CODE: <u>87106</u>
OWNER: APS Facilities ADDRESS: CITY, STATE: Albuquerque, NM	CONTACT: <u>Richard Miller</u> PHONE: <u>848-8835</u> ZIP CODE:
ARCHITECT: The Design Group ADDRESS: 120 Vassar SE, Suite 100 CITY, STATE: Albuquerque, NM	CONTACT: <u>Wendy Caruso</u> PHONE: 242-6880 ZIP CODE: <u>87106</u>
SURVEYOR: High Mesa Consulting ADDRESS: CITY, STATE: _	CONTACT: <u>Chuck Cala</u> PHONE: <u>345-4250</u> ZIP CODE:
CONTRACTOR: TBD ADDRESS: _ CITY, STATE:	CONTACT: PHONE: ZIP CODE: <u>871</u>
CHECK TYPE OF SUBMITTAL:	CHECK TYPE OF APPROVAL SOUGHT:
 □ DRAINAGE REPORT □ DRAINAGE PLAN 1st SUBMITTAL, REQUIRES TO DRAINAGE PLAN RESUBMITTAL □ CONCEPTUAL GRADING & DRAINAGE PLAN □ GRADING PLAN □ EROSION CONTROL PLAN □ ENGINEER'S CERTIFICATION (HYDROLOGY) □ CLOMR/LOMR □ TRAFFIC CIRCULATION LAYOUT (TCL) □ ENGINEERS CERTIFICATION (TCL) □ ENGINEERS CERTIFICATION (DRB APPR. SITE □ OTHER 	S. DEV. PLAN FOR SUB'D. APPROVAL S. DEV. PLAN FOR BLDG. PERMIT APPROVAL SECTOR PLAN APPROVAL FINAL PLAT APPROVAL FOUNDATION PERMIT APPROVAL BUILDING PERMIT APPROVAL CERTIFICATE OF OCCUPANCY (PERM.) CERTIFICATE OF OCCUPANCY (TEMP.) GRADING PERMIT APPROVAL PAVING PERMIT APPROVAL WORK ORDER APPROVAL
WAS A PRE-DESIGN CONFERENCE ATTENDED: YES NO COPY PROVIDED	OTHER (SPECIFY) JULY 1 2 2016 LAND DEVELOPMENT SECTION


DATE SUBMITTED:7-12-16

BY: David Aube P.E.

Requests for approvals of Site Development Plans and/or Subdivision Plats shall be accompanied by a drainage submittal. The particular nature, location and scope of the proposed development defines the degree of drainage detail. One or more of the following levels of submittal may be required based on the following:

- 1. **Conceptual Grading and Drainage Plan**: Required for approval of Site Development Plans greater than five (5) acres and Sector Plans.
- 2. **Drainage Plans**: Required for building permits, grading permits, paving permits and site plans less than five (5) acres.
- 3. **Drainage Report**: Required for subdivisions containing more than ten (10) lots or constituting five (5) acres or more.

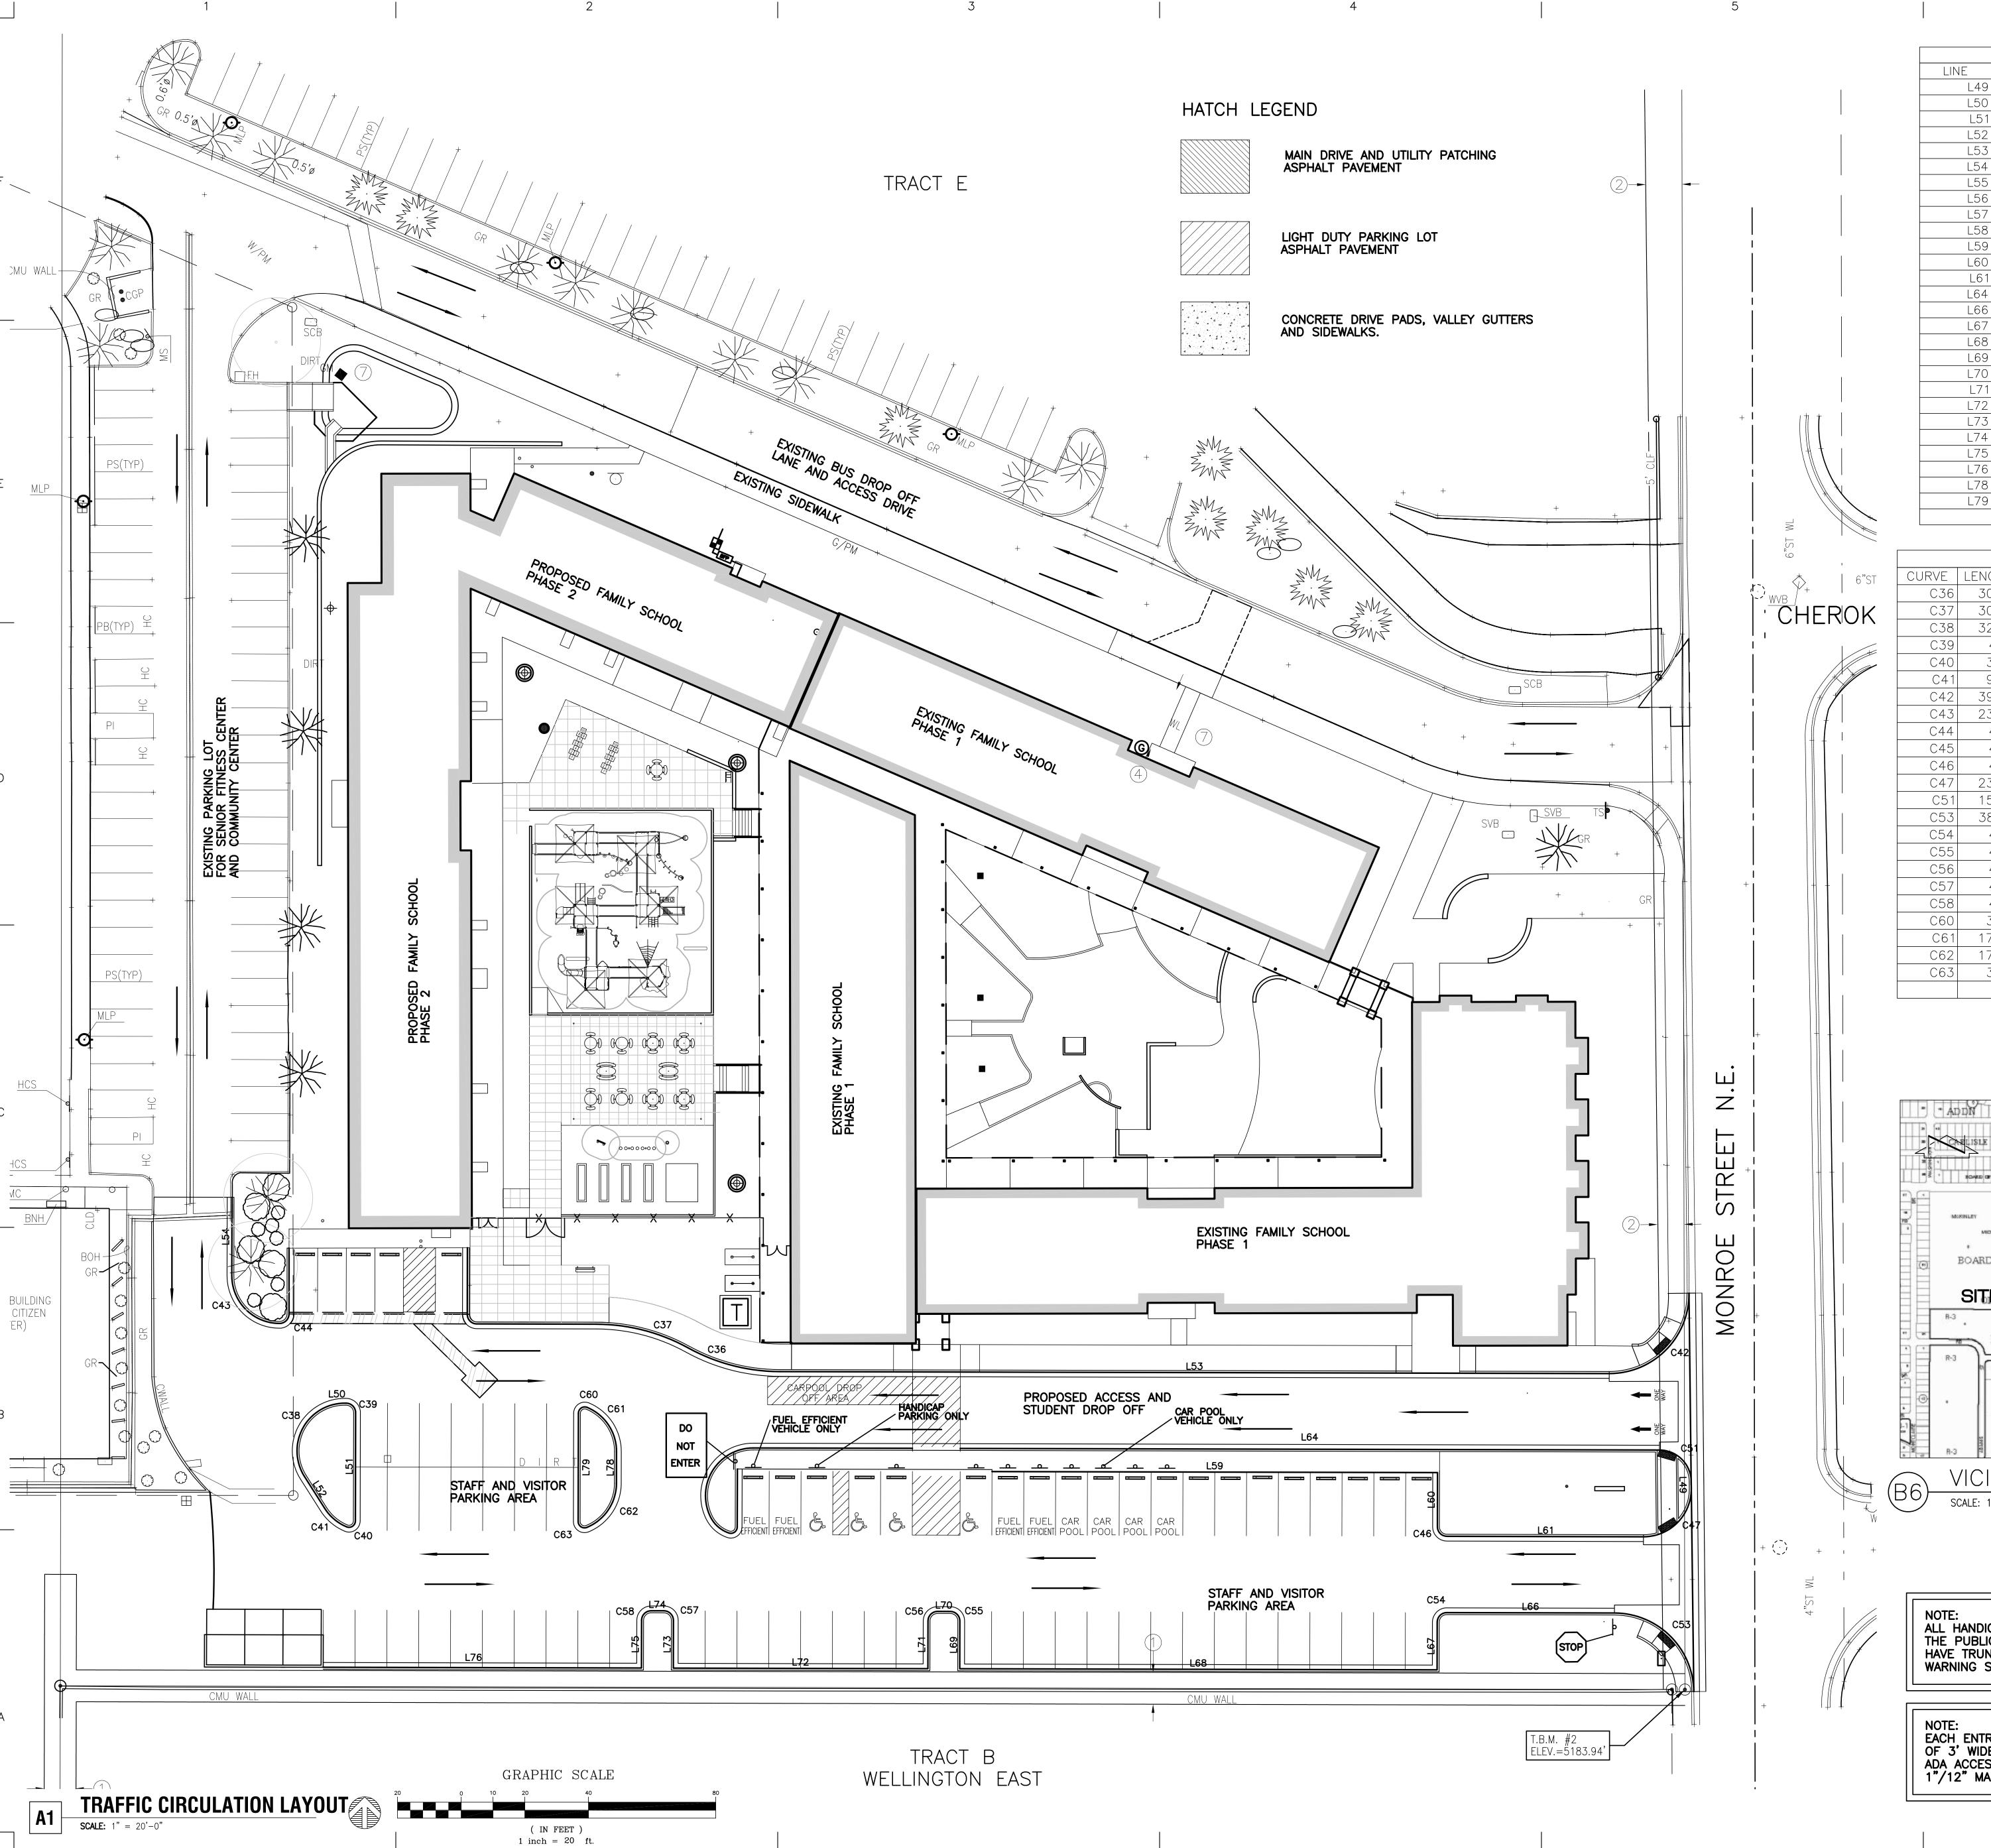

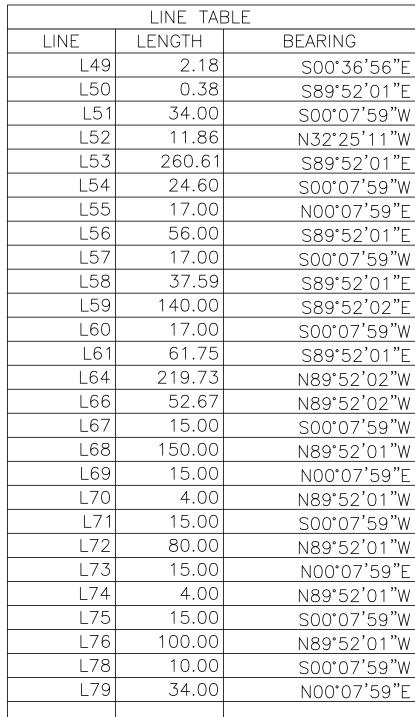

CURVE TABLE				
CURVE	LENGTH	RADIUS	TANGENT	DELTA
C36	30.08	60.00	15.36	28°43'26
C37	30.08	60.00	15.36	28°43'26
C38	32.08	15.00	27.37	122°33'10
C39	4.71	3.00	3.00	90°00'00
C40	3.93	2.00	3.00	112°37'12
C41	9.12	15.00	4.70	34°49'39
C42	39.57	25.00	25.30	90°41'16
C43	23.56	15.00	15.00	90°00'00
C44	4.71	3.00	3.00	90°00'00
C45	4.71	3.00	3.00	90°00'00
C46	4.71	3.00	3.00	90°00'00
C47	23.76	15.00	15.20	90°44'55
C51	15.58	10.00	9.87	89°15'05
C53	38.89	25.00	24.63	89°08'26
C54	4.71	3.00	3.00	90°00'00
C55	4.71	3.00	3.00	90°00'00
C56	4.71	3.00	3.00	90°00'00
C57	4.71	3.00	3.00	90°00'00
C58	4.71	3.00	3.00	90°00'00
C60	3.93	2.00	3.00	112°37'12
C61	17.64	15.00	10.00	67°22'48
C62	17.64	15.00	10.00	67°22'48
C63	3.93	2.00	3.00	112°37'12



NOTE: ALL HANDICAP ACCESS RAMPS WITHIN THE PUBLIC RIGHT OF WAY TO HAVE TRUNCATED CONES DETECTABLE WARNING SURFACE.	
--	--


NOTE:
EACH ENTRANCE SHLL HAVE A MINIMUM
OF 3' WIDE AT 2% CROSS SLOPE FOR
ADA ACCESS. ALL ACCESS RAMPS TO
1"/12" MAXIMUM SLOPE.

	de		
THE	HARTMAN	+ MAJEWSKI	
D^{I}	ESIGN	GROUP)
		S · INTERIOR DESIGN DESIGNERS · LEED®	ĺ

120 VASSAR DRIVE SE SUITE 100 ALBUQUERQUE, NEW MEXICO 87106 PHONE: 505.242.6880 FAX: 505.242.6881

CONSULTANT

STAMP

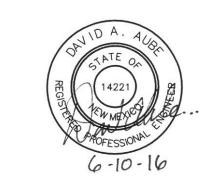

PROJECT NAME

PROJECT NAME

ILLOW FAMI L - PHASE II OM ADDITIO

CLASSROOM A
3303 MONROE STR

REV	ISIONS:	
No.	DATE	DESCRIPTION
	<u> </u>	
COPY	right - D	ESIGN GROUP
DEC	IGNER:	DAA
—DES	IGNEK:	DAA
CHE	CKED:	DAA

ESIGNER:	DAA	
HECKED:	DAA	
ATE:	03.03.2016	
CALE:	1" = 20'-0"	
OB NO.:	3043	
AD FILE:	3022MC_C101	

SHEET TITLE:
TRAFFIC
CIRCULATION
LAYOUT

SHEET NUMBER:

C-TCL