

ENGINEER'S CERTIFICATION

I, JEFFREY G. MORTENSEN, NMPE 8547, OF THE FIRM HIGH MESA CONSULTING GROUP, HEREBY CERTIFY THAT THIS PHASE II PROJECT HAS BEEN GRADED, DRAINED AND CONSTRUCTED IN SUBSTANTIAL COMPLIANCE WITH AND IN ACCORDANCE WITH THE DESIGN INTENT OF THE APPROVED PLAN DATED 09-02-2011. THE RECORD INFORMATION EDITED ONTO THE ORIGINAL DESIGN DOCUMENT HAS BEEN OBTAINED BY ME OR PERSONNEL UNDER MY DIRECT SUPERVISION AS SUPPLEMENTAL SITE DATA COMBINED WITH RECORD INFORMATION OBTAINED FROM THE AS-BUILT SURVEY DATED 12-19-2011 PERFORMED UNDER THE DIRECT SUPERVISION OF CHARLES G. CALA, JR., NMPS 11184, OF THE FIRM HIGH MESA CONSULTING GROUP AND IS TRUE AND CORRECT TO THE BEST OF MY KNOWLEDGE AND BELIEF. THIS CERTIFICATION IS SUBMITTED TO DOCUMENT COMPLETION OF THOSE IMPROVEMENTS IDENTIFIED ON THE APPROVED PLAN FOR THE OWNER AND CITY OF ALBUQUERQUE, TO SUPPORT A REQUEST FOR PERMANENT CERTIFICATE OF OCCUPANCY, AND TO SATISFY CONDITIONS OF GRADING AND DRAINAGE APPROVAL.

THE RECORD INFORMATION PRESENTED HEREON IS NOT NECESSARILY COMPLETE AND INTENDED ONLY TO VERIFY SUBSTANTIAL COMPLIANCE OF THE GRADING AND DRAINAGE AND SPECIFIC LIMITED ASPECTS OF THIS PROJECT. THIS CERTIFICATION DOES NOT ADDRESS ADA COMPLIANCE WHICH IS BEYOND THE SCOPE OF GRADING AND DRAINAGE. THOSE RELYING ON THIS RECORD DOCUMENT ARE ADVISED TO OBTAIN INDEPENDENT VERIFICATION OF ITS ACCURACY BEFORE USING IT FOR ANY OTHER PURPOSE.

JEFFREY G. MORTENSEN, NMPE 8547

DATE



INDEX OF DRAWINGS

SHEET

DESCRIPTION

- |          |  |
|----------|--|
| 1 OF 11  | COVER SHEET, VICINITY MAP, GENERAL NOTES, LEGEND AND INDEX OF DRAWINGS |
| 2 OF 11  | DEVELOPMENT PLAN (FOR ORIENTATION ONLY)                                |
| 3 OF 11  | PAVING AND LAYOUT PLAN   |
| 5 OF 11  | GRADING PLAN   |
| 6 OF 11  | DRAINAGE PLAN AND CALCULATIONS   |
| 10 OF 11 | APS PORTABLE CLASSROOM FOUNDATION PLAN                                 |

**HIGH MESA Consulting Group**

6010-B MIDWAY PARK BLVD. NE • ALBUQUERQUE, NEW MEXICO 87109  
PHONE: 505.345.4250 • FAX: 505.345.4254 • www.highmesacg.com

**DRAINAGE CERTIFICATION**  
**P.A.P.A. CHARTER SCHOOL AT BEL AIR**  
**ELEMENTARY SCHOOL - PHASE 2**

DESIGNED BY J.G.M.

DRAWN BY E.J.S.

APPROVED BY J.G.M.

NO.	DATE	BY

REVISIONS

JOB NO.

2011.180.2

DATE

03-2012

SHEET


1

1

VICINITY MAP

SCALE: 1" = 750' (APPROX.)

G-17

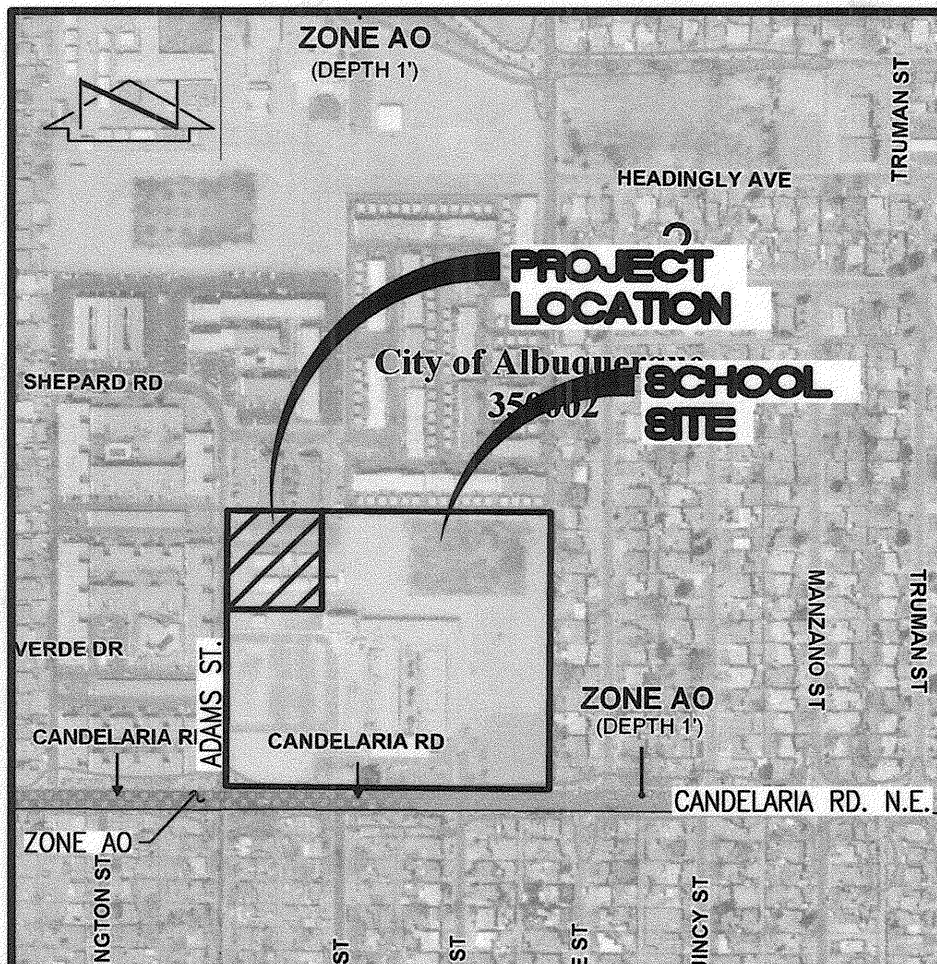

F.I.R.M.

SCALE: 1" = 500' (APPROX.)

PANEL 351 & 352 OF 825

DATED 09/26/2008

LEGAL DESCRIPTION

TRACTS H AND J, BEL AIR ELEMENTARY SCHOOL,  
ALBUQUERQUE, NEW MEXICO.

BENCHMARKS

PROJECT BENCHMARK

ACS BENCHMARK 9-G17, "□" CUT CHISELED ON TOP OF CONCRETE CURB AT THE WNW CURB RETURN LOCATED IN THE NORTHWEST QUADRANT OF THE INTERSECTION OF CANDELARIA ROAD N.E. AND SAN MATEO BOULEVARD N.E.  
ELEVATION = 5204.30 FEET (NGVD 29)

T.B.M. #1

A REBAR WITH CAP STAMPED "LS 7719" TAGGED WITH WASHER STAMPED "NMPS 11184", AT THE NORTHWEST CORNER OF THE PROPERTY, AS SHOWN ON SHEET 2.  
ELEVATION = 5171.37 FEET (NGVD 29)