




D1 TYPICAL WATER SERVICE CONNECTION
SCALE: 1" = 1'

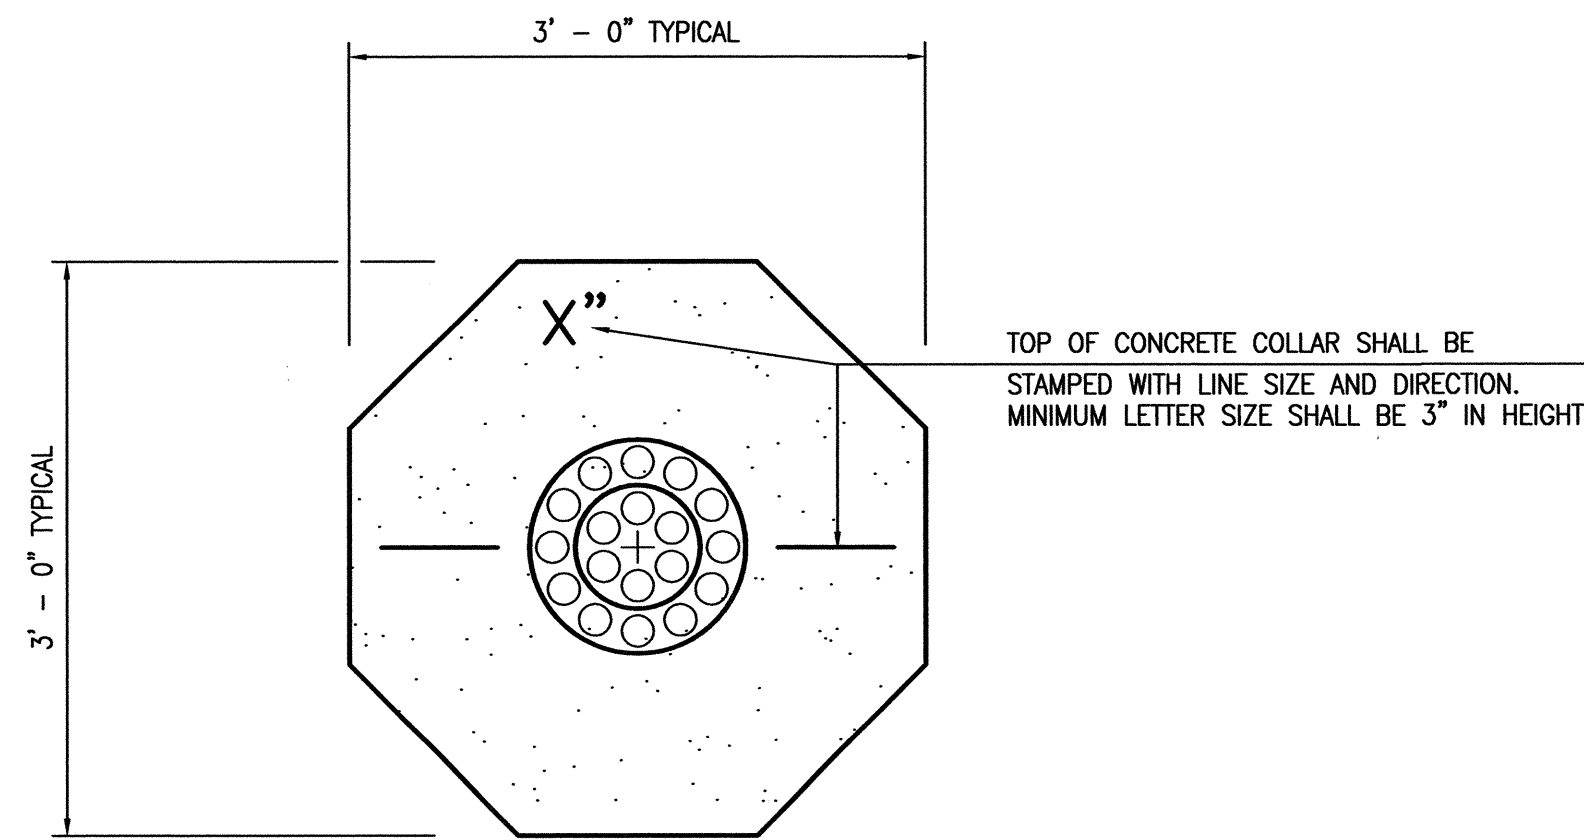


C1 TYPICAL WATER VALVE BOX COLLAR DETAIL
SCALE: 1" = 1'

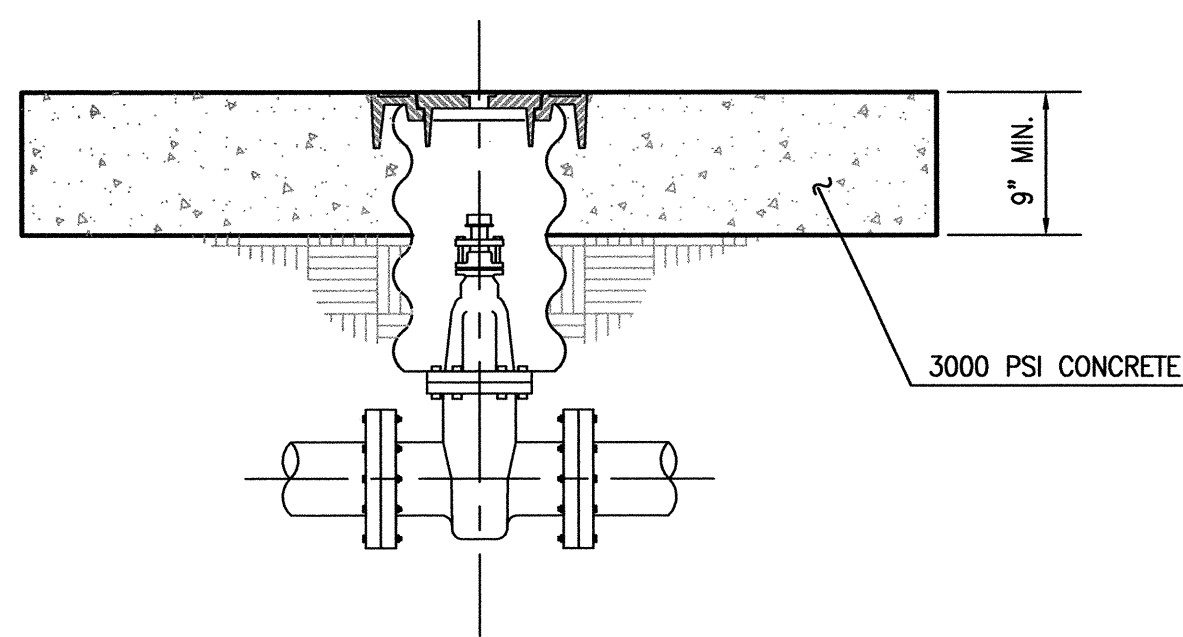


A1 TYPICAL WATER VALVE BOX SECTION
SCALE: 1" = 1'

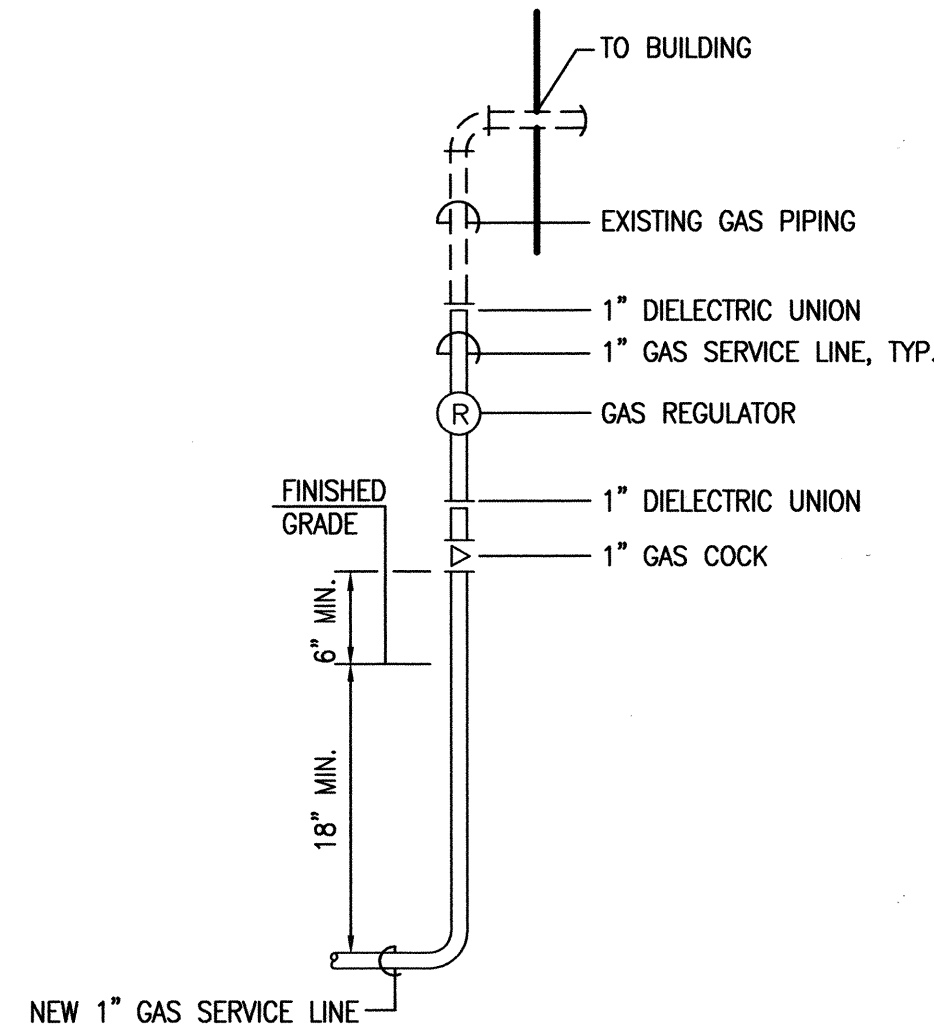


D3 TYPICAL GAS SERVICE CONNECTION
SCALE: 1" = 1'

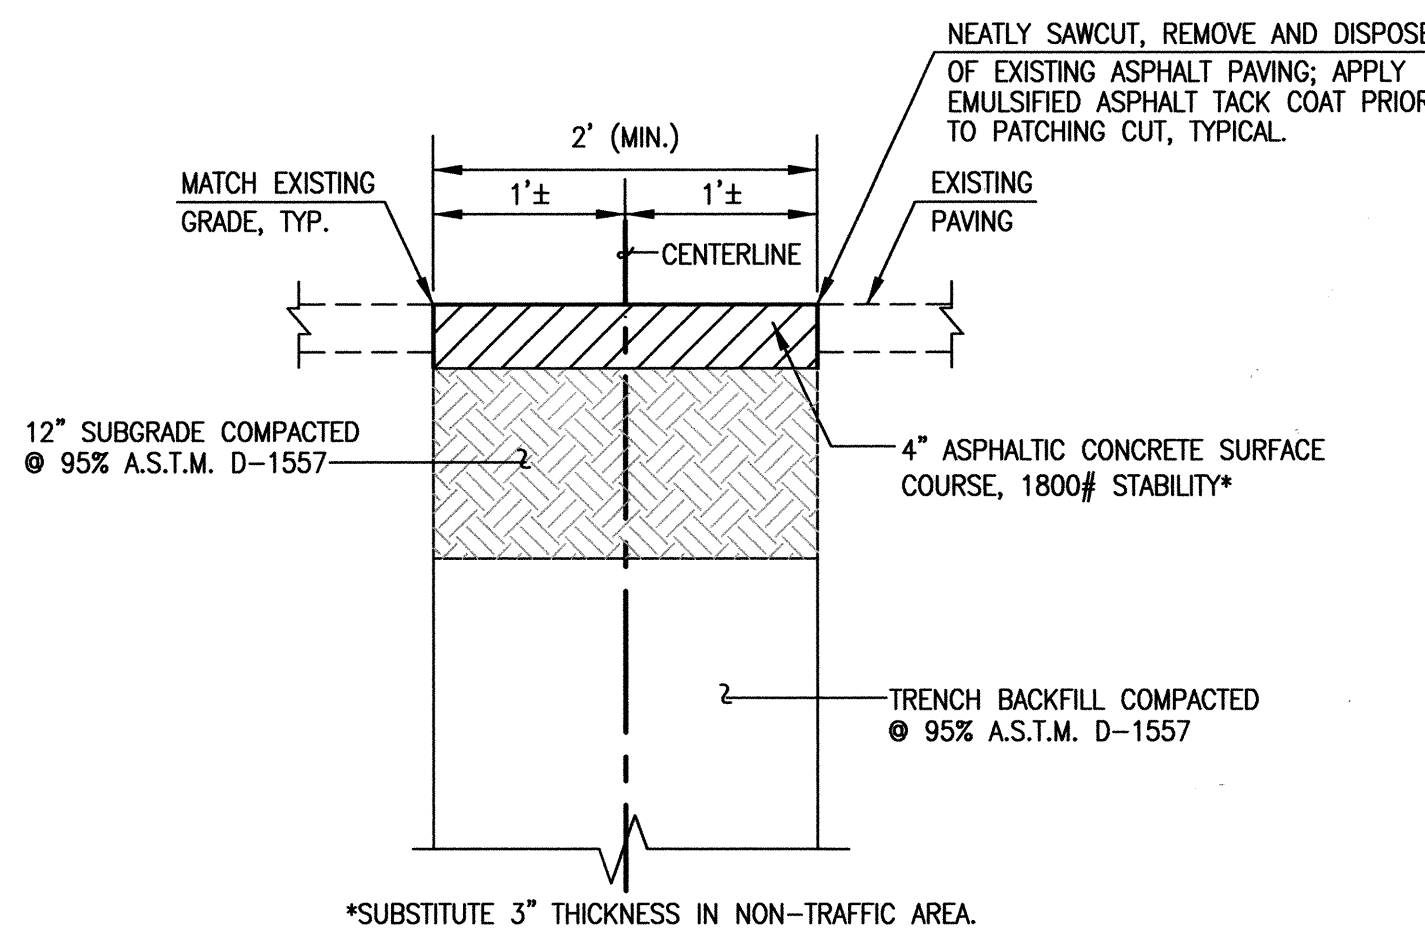


C3 TYPICAL PRIVATE PAVING UTILITY CUT AND PAVEMENT REPLACEMENT SECTION
SCALE: 1" = 1'

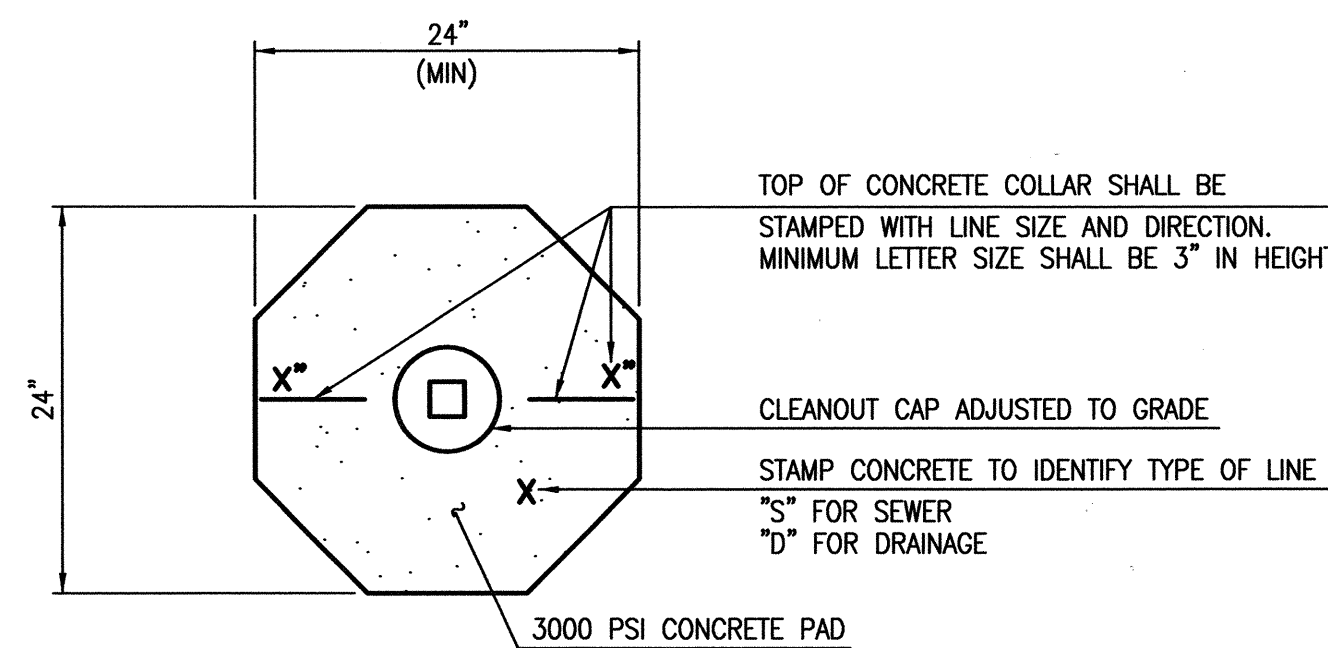


A3 TYPICAL CLEANOUT COLLAR DETAIL
SCALE: 1" = 1'

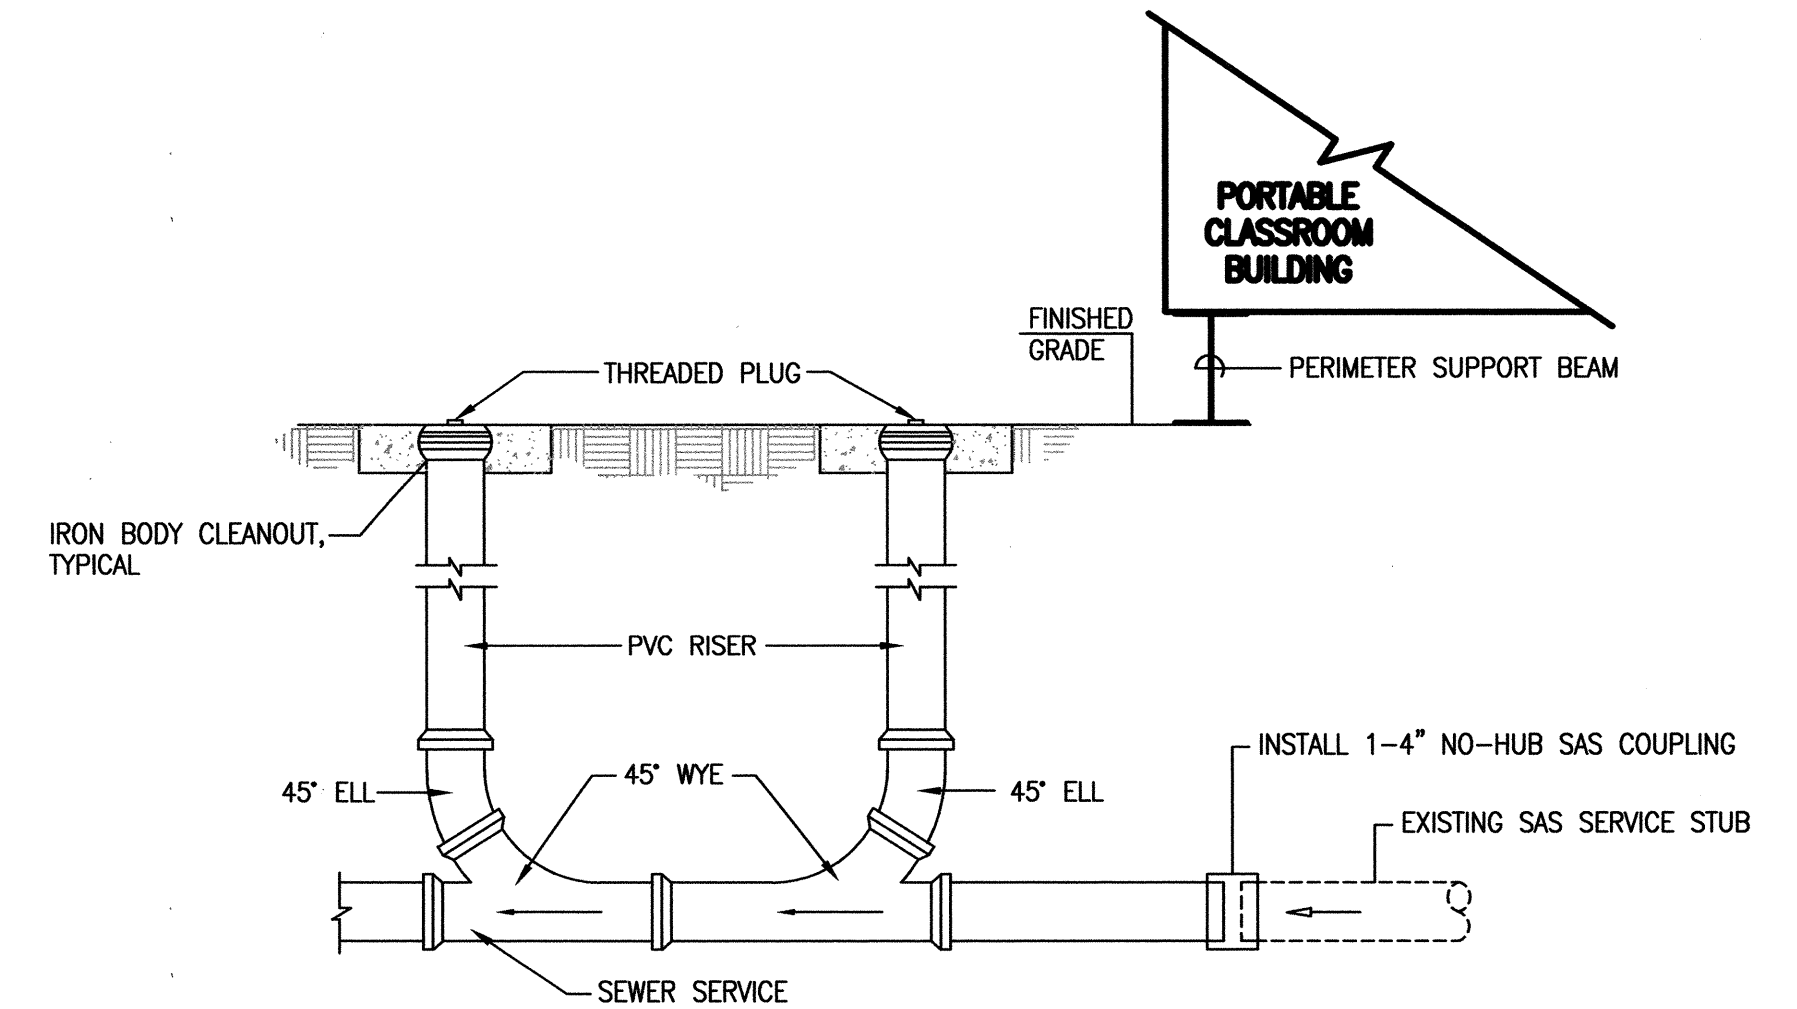

D5 TYPICAL DOUBLE CLEANOUT AND PORTABLE CONNECTION SECTION
NOT TO SCALE

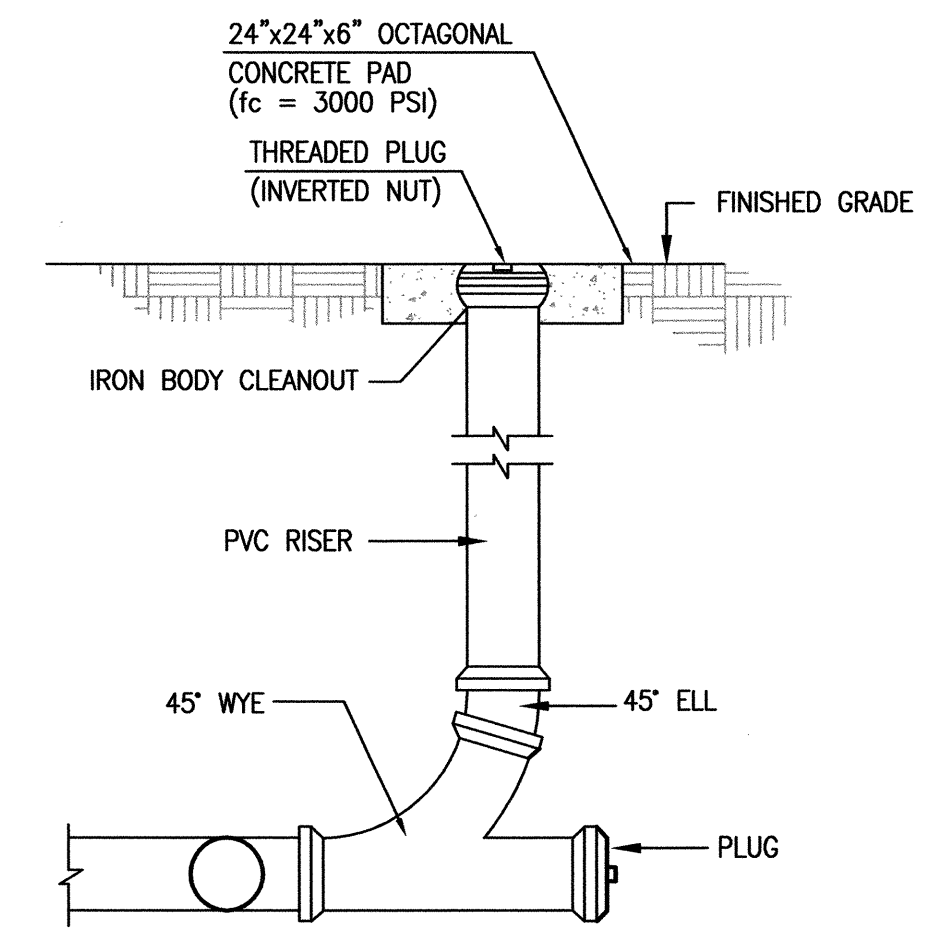

C5 TYPICAL SINGLE CLEANOUT SECTION
NOT TO SCALE

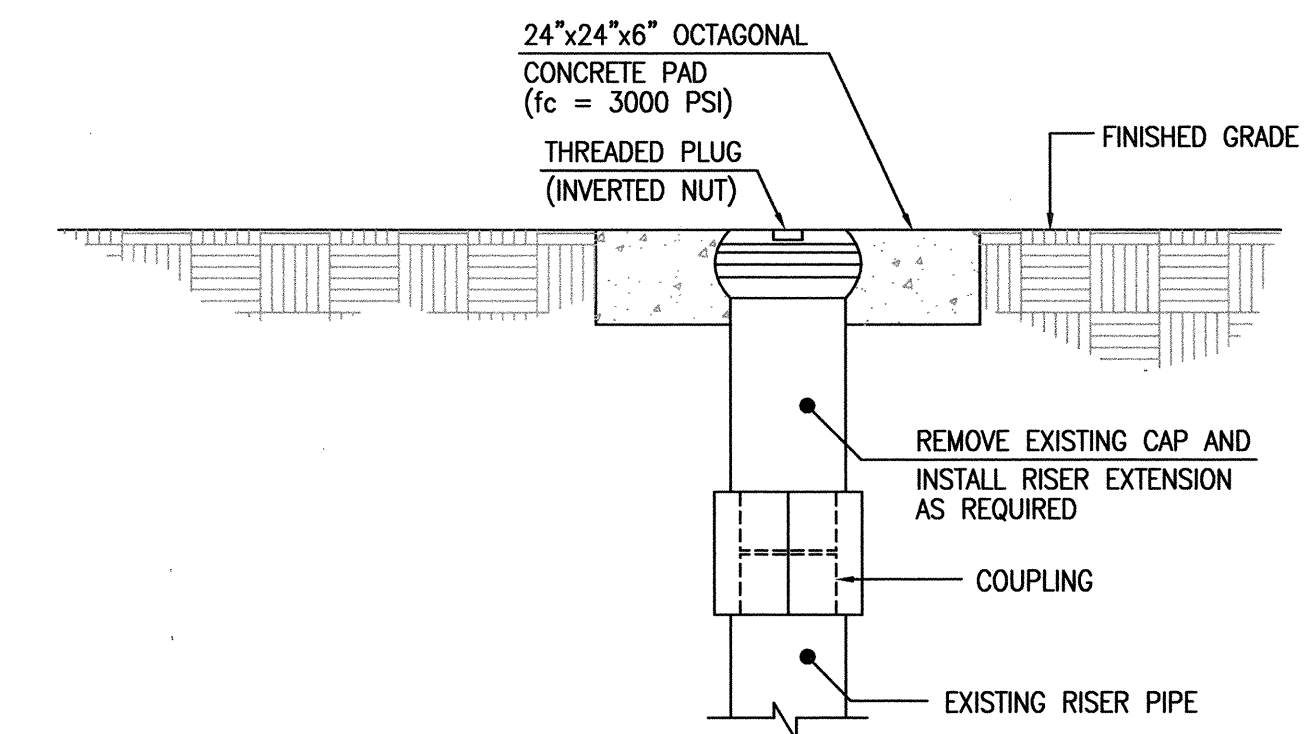

A5 TYPICAL SINGLE CLEANOUT ADJUSTMENT SECTION
NOT TO SCALE

RECORD DRAWING

09.02.2011
03.22.2012
JEFFREY G. MONTENSI
NEW MEXICO
8547
REGISTERED PROFESSIONAL ENGINEER

DESIGNED BY	J.G.M.	ND	DATE	BY	02/12 B.E.E.	RECORD DRAWING	JOB NO.	2011.180.2
DRAWN BY	J.Y.R./E.J.S.						DATE	09-2011
APPROVED BY	J.G.M.						SHEET	8 OF 11

HIGH MESA Consulting Group

6010-B MIDWAY PARK BLVD. NE • ALBUQUERQUE, NEW MEXICO 87109
PHONE: 505.345.4250 • FAX: 505.345.4254 • www.highmesacg.com

**PORTABLE CLASSROOM UTILITY CONNECTION DETAILS
P.A.P.A. CHARTER SCHOOL AT
BEL AIR ELEMENTARY SCHOOL
3000 ADAMS NE**

File Path: P:\DATA\2011\180.2\BEG\8547.DWG | Plot Date: 02-23-2012
File Name: 111802_SHAB.DWG | Plot Time: 13:05 pm