





DOUBLE PORTABLE CLASSROOM FOUNDATION PLAN

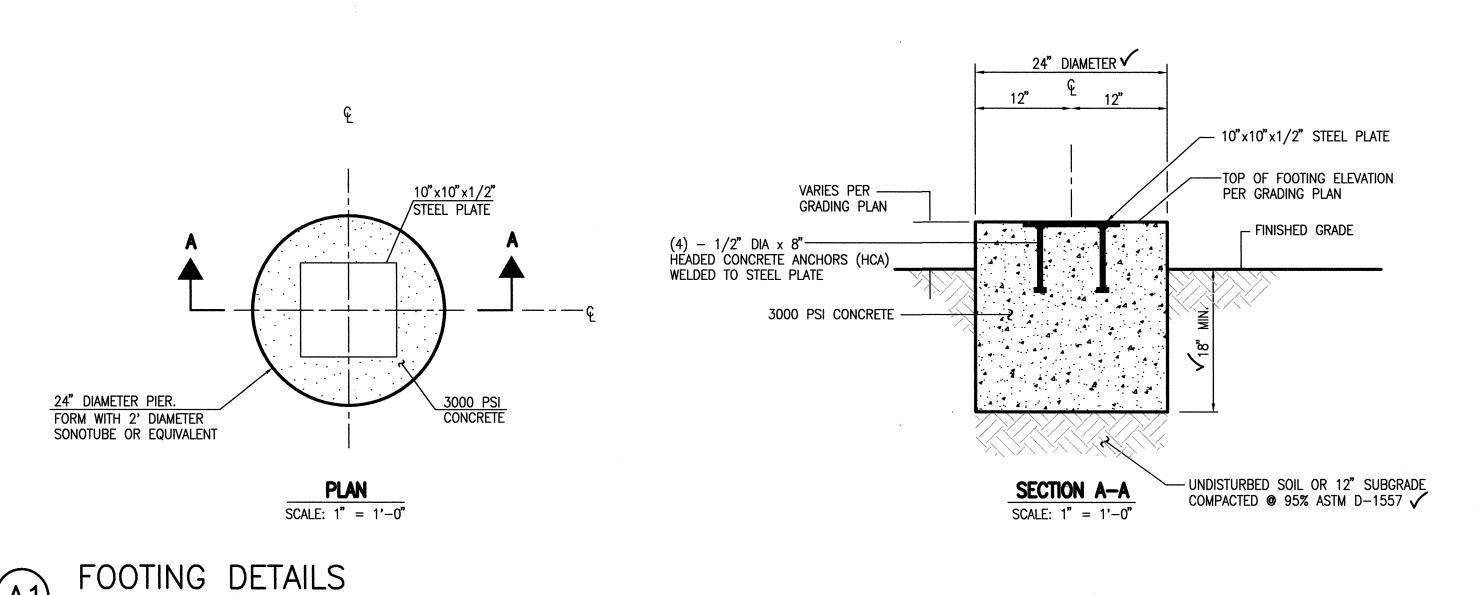

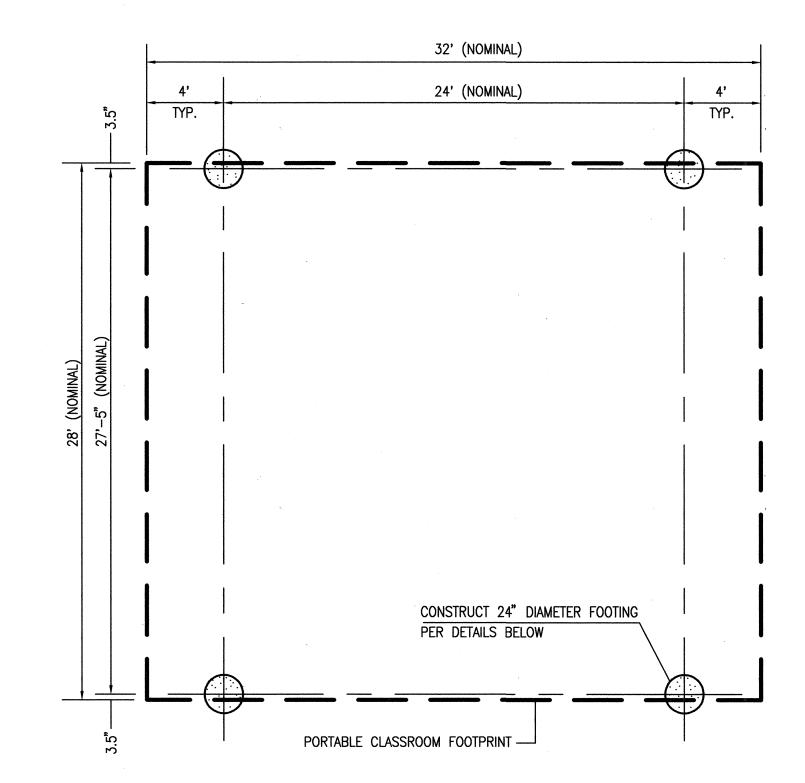

SINGLE PORTABLE CLASSROOM FOUNDATION PLAN

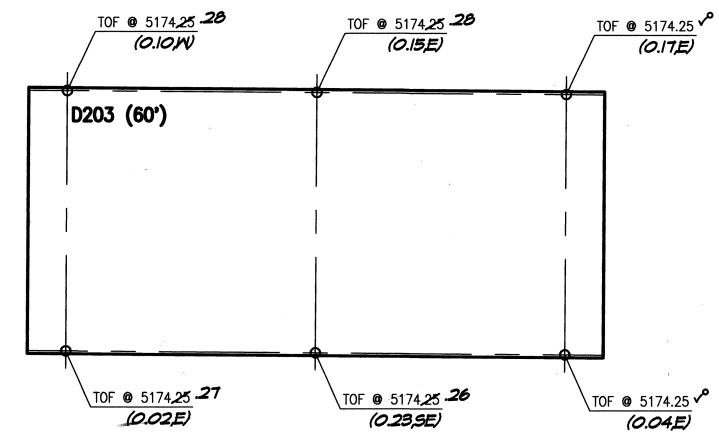

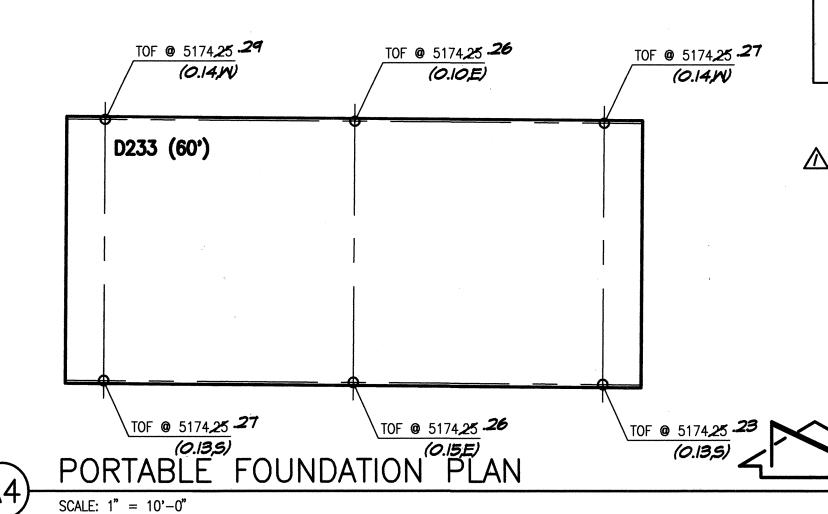

FOUNDATION AND PORTABLE INSTALLATION NOTES;

1. FOUNDATION LOCATIONS SHALL BE STAKED BY THE PROJECT SURVEYOR UNDER CONTRACT WITH THE OWNER.

2. THE CONTRACTOR SHALL NOTIFY THE ENGINEER WHEN FOUNDATIONS HAVE BEEN EXCAVATED AND ALL FORMS SET.

3. PRIOR TO POURING FOUNDATIONS, THE ENGINEER, OR HIS REPRESENTATIVE, SHALL OBSERVE AND APPROVE THE WORK FOR COMPLIANCE WITH THE PLANS AND SPECIFICATIONS.

4. THE ENGINEER, OR HIS REPRESENTATIVE, SHALL BE PRESENT TO OBSERVE THE POURING OF CONCRETE WITHIN THE FOUNDATION FORMS.

5. UPON COMPLETION OF CONSTRUCTION OF THE FOUNDATIONS, THE PROJECT SURVEYOR SHALL OBTAIN AS-BUILT MEASUREMENTS FOR THE HORIZONTAL AND VERTICAL LOCATIONS OF EACH FOUNDATION.

6. PRIOR TO INSTALLATION OF THE PORTABLE CLASSROOM BUILDINGS, THE ENGINEER SHALL REVIEW THE AS-BUILT SURVEY DATA AND PREPARE A FOUNDATION CERTIFICATION. PORTABLE BUILDINGS SHALL NOT BE INSTALLED WITHOUT THE CONSENT OF THE ENGINEER.

7. A PRE-INSTALLATION MEETING SHALL BE CONDUCTED PRIOR TO INSTALLATION OF THE PORTABLE CLASSROOM BUILDINGS TO DETERMINE THE CRITERIA FOR ALIGNING EACH BUILDING WITH RESPECT TO THE AS-CONSTRUCTED FOUNDATION LOCATIONS. ANY BUILDING INSTALLED IN ADVANCE OF A PRE-INSTALLATION MEETING SHALL BE ADJUSTED TO THE SATISFACTION OF THE OWNER AND THE ENGINEER AT NO ADDITIONAL COST TO THE OWNER.

RECORD INFORMATION LEGEND

RECORD INFORMATION (VERIFIED BY ENGINEER) AS-CONSTRUCTED = AS-DESIGNED (VERIFIED BY ENGINEER)

RECORD INFORMATION (VERIFIED BY ENGINEER) ● 31,25 .22 RECORD INFORMATION (VERIFIED BY ENGINEER)

AS-CONSTRUCTED = AS-DESIGNED (VERIFIED BY AS-BUILT SURVEY)

RECORD INFORMATION FROM AS-BUILT SURVEY RECORD INFORMATION FROM AS-BUILT SURVEY

● 31,25.22 RECORD INFORMATION FROM AS-BUILT SURVEY

CERTIFICATE OF SUBSTANTIAL COMPLIANCE


I, JEFFREY G. MORTENSEN, NMPE 8547, OF THE FIRM HIGH MESA CONSULTING GROUP. OBTAINED FROM AN AS-BUILT SURVEY DATED 11-07-2011 CONDUCTED BY HIGH MESA CONSULTING GROUP UNDER THE DIRECTION OF CHARLES G. CALA, JR., NMPS 11184, AND IS TRUE AND CORRECT TO THE BEST OF MY KNOWLEDGE AND BELIEF.

THIS RECORD INFORMATION IS NOT NECESSARILY COMPLETE AND INTENDED ONLY TO VERIFY SUBSTANTIAL COMPLIANCE OF THE DESIGN INTENT OF THE FOUNDATION PORTION OF THIS PROJECT. THOSE RELYING ON THIS DOCUMENT ARE ADVISED TO OBTAIN INDEPENDENT VERIFICATION OF ITS ACCURACY BEFORE USING IT FOR ANY OTHER PURPOSE THIS CERTIFICATION IS SUBMITTED TO DOCUMENT COMPLIANCE FOR THE OWNER.

MORTENSEN, NMPE 8547 11-08-2011



RECORD DRAWING FOR CERTIFICATION, SEE SHEET 1

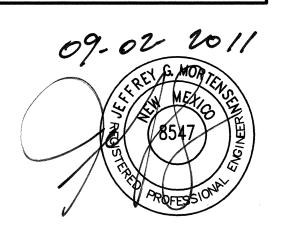

HIGH MESA Consulting Group 6010-B MIDWAY PARK BLVD. NE • ALBUQUERQUE, NEW MEXICO 87109 PHONE: 505.345.4250 • FAX: 505.345.4254 • www.highmesacg.com TYPICAL APS PORTABLE CLASSROOM FOUNDATION PLAN P.A.P.A. CHARTER SCHOOL AT BEL AIR ELEMENTARY SCHOOL 3000 ADAMS NE

2011.180.2 /\ II/II B.E.E. FOUNDATION CERTIFICATION DESIGNED BY J.G.M. 08-2011 DRAWN BY APPROVED BY J.G.M.

10 DF