



February 3, 1998

Tucker Green, P.E.
Per Se Engineering
9109 La Barranca NE
Albuquerque, NM 87111


**RE: PARSIFAL TOWN HOMES (G20-D39). ENGINEER'S CERTIFICATION FOR
SUBDIVISION CERTIFICATION AND RELEASE OF FINANCIAL GUARANTY.
ENGINEER'S CERTIFICATION DATED JANUARY 15, 1998.**

Dear Mr. Green:

Based on the information provided on your January 15, 1998 submittal, City Hydrology accepts the Engineer's Certification of grading and drainage. Contact Terri Martin to obtain the Financial Guaranty Release.

If I can be of further assistance, please feel free to contact me at 924-3984.

Sincerely,

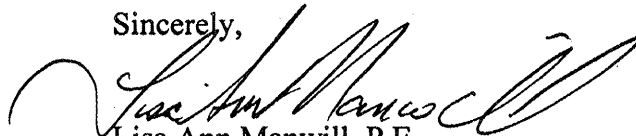
Lisa Ann Manwill, P.E.
Hydrology

c: Terri Martin
Andrew Garcia
File

Good for You, Albuquerque!



ON SITE HYDROLOGY
\$

STREET FLOW

(INCLUDING INLETS ON HILTON R
WEST OF SITE)

3-13-96

PARSIFAL TOWN HOMES

OLD DRAINAGE - AS WHEN HILTON R
STORM DRAINER WAS DESIGNED
ITPSD = HILTON PURGE STORM DRAIN

ITPSD - IF PROP NOT DEVELOPED, ANALYZED AS
IF BUILT OUT ACCORDING TO ITS ZONING

SITE - ZONE P FOR PARKING AT THAT TIME

METHODOLOGY IN ITPSD

RATIONAL METHOD $Q_p = CIA$ WITH INTENSITY I
INCREASING WITH LARGER UPSTREAM BASINS
IE, INCREASES IN DOWNSTREAM DIRECTION
& INCREASING TIME OF CONCENTRATION T_c

$$T_{min} = 10 \text{ MINUTES}$$

PARKING AREAS

ASSUME 85% PAVING 15% IRRIGATED LANDSCAPING
IF BUILT OUT AT TIME OF ITPSD DESIGN (1988-90)
(ALT ZONING CODE NOW)

AT MONTGOMERY & SUBANK, "OLD" GMR VOLUME 2.45"
PL 22.2 D-1

$$T_c = 10 \text{ MIN} = T_{min}$$

$$\begin{aligned} \text{PEAK INTENSITY } I &= (GMR \text{ RAIN}) (6.94) (T_c^{-0.51}) \quad \text{PL 22.2 D-2} \\ &= GMR \text{ RAIN} \times 2.11 \\ &= 5.17 \text{ IN HR} \end{aligned}$$

COMPOSITE C - FROM 1986 EMERGENCY RULE

STREETS DRIVES - IMPERV $C = 0.95$
LAWNS & LANDSCAPING $C = 0.25$

$$\text{COMPOSITE } (0.95)(.95) + (0.15)(.25) = 0.95$$

$$\begin{aligned} \text{PER ACRE, ZONED PARKING } Q_p &= (0.95)(5.17)(1) \\ &= 4.91 \text{ CFS/AC} \end{aligned}$$

$$\begin{aligned} (\text{FOR ALL PAVING } \& C = 0.95 \quad Q_p &= (0.95)(5.17)(1) \\ &= 4.91 \text{ CFS/AC} \end{aligned}$$

FILE=PARHYD1.WQ1

ALBUQUERQUE, NM (1/93 DPM CHAP 22.2) CRITERIA - SIMPLE PROCEDURE FOR <= 40 ACRES

PX100-6 = PRECIPITATION EXCESS FROM 100-YEAR 6-HOUR STORM

VOL10D = VOLUME OF RUNOFF FROM 100-YEAR 10-DAY STORM

TRTMT CLASS A=UNDISTURBED, B=LAWNS, C=UNPAVED ROADS, D=ROOFS,PAVEMENT: SEE DPM 22.2 P A-5

***** PROJECT INFO *****

PARSIFAL TOWNHOMES, LANDSCAPE AREA PER ACAD POLYLINES PA2DRN 7-21-96

ASSUME 30SF/LOT AS WALL NOT COUNTED W/ HOUSES: LS 31,203-720=30,483 ONSITE

SE CORNER AREA: 41974 SF TOT, 12061-(9*30)=11791 SF LANDSCAPE

RAIN ZONE 3 SEE DPM P 22.2-2

100-YEAR PRECIPITATION (P) DEPTHS, INCHES

1 HR	6 HR	24 HR	4 DAY	10 DAY
2.14	2.60	3.10	3.95	4.90

08/27/96 08:20 PM ENTIRE SITE, DEVELOPED CONDITIONS

AC TOT

TRTMT CLASS	AREA SQUARE FEET	AREA ACRES	PX100-6 IN/AC	QP100-6 CFS/AC	QP100-6 CFS	VOL6HR AC-FT	VOL1D AC-FT	VOL4D AC-FT	VOL10D AC-FT	TRTMT PERCENT
A	0.00	0.0000	0.66	1.87	0.000	0.000	0.000	0.000	0.000	0.00
B	30483.00	0.6998	0.92	2.60	1.819	0.054	0.054	0.054	0.054	28.21
C	0.00	0.0000	1.29	3.45	0.000	0.000	0.000	0.000	0.000	0.00
D	77575.00	1.7809	2.36	5.02	8.940	0.350	0.424	0.551	0.692	71.79

TOTAL 108058.00 2.4807 AVG Q/AC= 4.337 10.759 CFS 0.404 0.478 0.604 0.745 100.00
CU FT → 17593 20826 26321 32462

EX. COND $Q_p = 2.48 \times 0.66 = 1.64 \text{ CFS}$

10.756 ~ 10.76 ~ (0.8 CFS)

08/27/96 08:20 PM AS ABOVE, BUT MINUS NON-CONTRIB (BACKYARD, TYP) OF 11,965 SF

AC TOT

TRTMT CLASS	AREA SQUARE FEET	AREA ACRES	PX100-6 IN/AC	QP100-6 CFS/AC	QP100-6 CFS	VOL6HR AC-FT	VOL1D AC-FT	VOL4D AC-FT	VOL10D AC-FT	TRTMT PERCENT
A	0.00	0.0000	0.66	1.87	0.000	0.000	0.000	0.000	0.000	0.00
B	19238.00	0.4416	0.92	2.60	1.148	0.034	0.034	0.034	0.034	20.02
C	0.00	0.0000	1.29	3.45	0.000	0.000	0.000	0.000	0.000	0.00
D	76855.00	1.7643	2.36	5.02	8.857	0.347	0.421	0.545	0.685	79.98

TOTAL 96093.00 2.2060 AVG Q/AC= 4.536 10.005 0.381 0.454 0.579 0.719 100.00
CU FT → 16590 19792 25236 31320

$Q_p \text{ PER GROSS AREA}$

$= 10.005 / 2.48 = 4.03 \text{ CFS/AC}$


08/27/96 08:20 PM S.E. CORNER AREA: GET Qpeak FOR CRITICAL STREETFLOW

TOT %LS

TRTMT CLASS	AREA SQUARE FEET	AREA ACRES	PX100-6 IN/AC	QP100-6 CFS/AC	QP100-6 CFS	VOL6HR AC-FT	VOL1D AC-FT	VOL4D AC-FT	VOL10D AC-FT	TRTMT PERCENT
A	0.00	0.0000	0.66	1.87	0.000	0.000	0.000	0.000	0.000	0.00
B	11791.00	0.2707	0.92	2.60	0.704	0.021	0.021	0.021	0.021	28.11
C	0.00	0.0000	1.29	3.45	0.000	0.000	0.000	0.000	0.000	0.00
D	30156.00	0.6923	2.36	5.02	3.475	0.136	0.165	0.214	0.269	71.89

TOTAL 41947.00 0.9630 AVG Q/AC= 4.340 4.179 0.157 0.186 0.235 0.290 100.00
CU FT → 6835 8091 10227 12615

4.171 CFS ~ 4.18 ~ 4.2 CFS

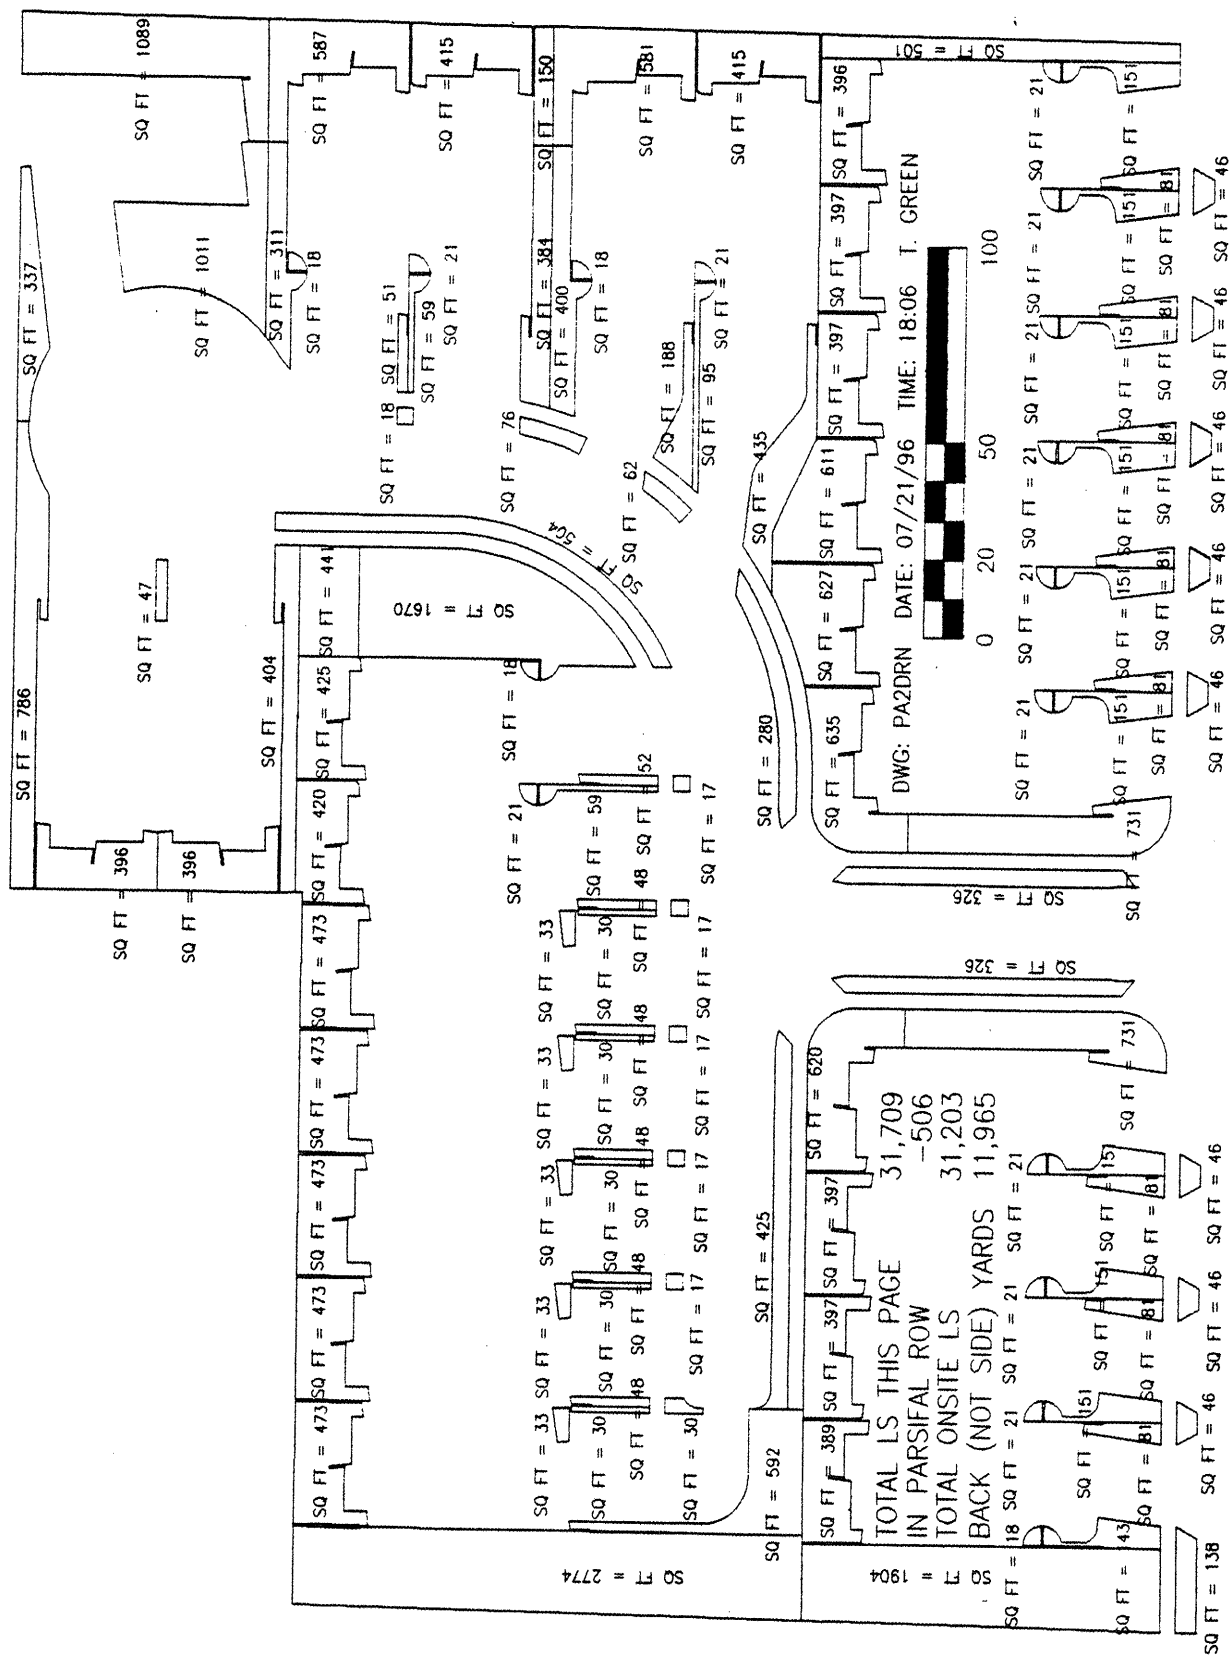

PARSIFAL

7-21-96

"SE CORNER" - AREA POSS CONTRIBUTING TO
STREET FLOW NE SW CORNER BAY & HILTON
LOTS 11-18 ESSENTIAL

WHOLE AREA, BY POLY LINE

41,974.13 SF
0.9636 ~ 0.964 AC

LANDSCAPE AREAS

504	337	76
1670	1089	384
441	1011	150
425	311	400
396	18	18
396	587	581
404	415	62
786	18	188
47	51	95
	59	21
	21	415
5069	3917	435
LOTS 16, 17, 18	14, 15, 16	250
		3075 ← LOTS 11, 12, 13

$\Sigma = 12,061$ SF LS

ASSUME ~ 30 SF/LOT WITH COUNTED AS LS
 $9 \times 30 = 270$; $12,061 - 270 = 11,791$

08-27-1996 14:45:19 Manning n = .017 STSEQ.BAS or STFLOWn.EXE output file PARBAY.STF

PARSIFAL TOWNHOMES, Qmax 4.2 cfs SW COR BAT CT & HILTO PL W/ 4" ROLL CURB

LONGIT SLOPE 3.14% ACTUAL ON CURVE (3.36% NOM PER CL).

MAX CROSS-SLOPE 4.8% AT HILTON PLACE AFTER TRANSITION. CHECK OTHER CROSS-SLOPES FOR COMPARISON ONLY

MAIN MENU

- (1) FOR ENTER Yn, S GET Q, V, T, Fr, Es, Ms
- (2) FOR ENTER Q, S GET Yn, V, T, Fr, Es, Ms
- (3) FOR ENTER Q, Yn GET S, etc
- (4) FOR PREV. Q, Ms GET Ysequent, etc
- (5) FOR ENTER Q, Fr GET S, Yn, etc
- (6) NEW CL OR GUTTER WIDTH
- (7) WRITE TO ASCII OUTPUT FILE
- (8) QUIT PROGRAM

{ SEE SPREADSHEET
PAR4402.WQ1 7/21/96 9:09 PM
FOR Q REQ'D = 4.20 CFS

Mnu #	Y #	S ft	WCL ft	Q cfs	V fps	Hv ft	Spread ft	Area sf	Pw ft	Fr #	Es ft	Ms cf	WPav ft	SxPav ft/ft	WGut ft	SxGut ft/ft
1	2	0.284	.03140	19.00	4.20	3.86	0.23	8.46	1.09	8.75	1.90	0.52	0.60	18.00	.03000	1.00 .06000
2	2	0.294	.03140	19.00	4.20	4.00	0.25	7.70	1.05	8.00	1.91	0.54	0.62	18.00	.03500	1.00 .06000
3	2	0.304	.03140	19.00	4.20	4.12	0.26	7.10	1.02	7.41	1.92	0.57	0.64	18.00	.04000	1.00 .06000
4	2	0.313	.03140	19.00	4.20	4.24	0.28	6.61	0.99	6.93	1.93	0.59	0.65	18.00	.04500	1.00 .06000
5	2	0.317	.03140	19.00	4.20	4.30	0.29	6.36	0.98	6.69	1.93	0.60	0.66	18.00	.04800	1.00 .06000
6	2	0.320	.03140	19.00	4.20	4.34	0.29	6.21	0.97	6.54	1.94	0.61	0.67	18.00	.05000	1.00 .06000

CRITERION IS FLOW DEPTH Y < HEIGHT AT R

$$\text{HEIGHT @ R} = 0.331(0.02)(9) = 0.51'$$

$\therefore Y$ MUST BE < 0.51'

ALL FLOWS HERE < 0.33' = TOP OF ROLL CURB OK

FOR NW CORNER RAY & HILTON, WEST SIDE

NOTE: LONGIT SLOPE GREATER
CONTRIBUTING AREA LESS

$\therefore$ BY COMPARISON TO SOUTHEAST CORNER
FLOW WILL BE BELOW TOP OF CURB OK

FLOW CAPACITY IN HILTON PL E. OF BAY CT: 4" ROLL CURB: DESIGN CROSS-SLOPE=0
 APPROX BY CROSS-SLOPE=0.001, SHOW .005 & .02 FOR COMPARISON. DESIGN LONGIT SLOPE
 4.8% NEAR BAY, 4.0% NEAR PARSIPAL. Q IS Q FOR HALF WIDTH: $Q_{total} = Q_{halfwidth} * 2$

MAIN MENU

- (1) FOR ENTER Yn, S GET Q, V, T, Fr, Es, Ms
- (2) FOR ENTER Q, S GET Yn, V, T, Fr, Es, Ms
- (3) FOR ENTER Q, Yn GET S, etc
- (4) FOR PREV. Q, Ms GET Ysequent, etc
- (5) FOR ENTER Q, Fr GET S, Yn, etc
- (6) NEW CL OR GUTTER WIDTH
- (7) WRITE TO ASCII OUTPUT FILE
- (8) QUIT PROGRAM

GET Q CAPACITY FOR
 DEPTH TO TOP OF 4" CURB

Q HALF WIDTH

Mnu	Y	S	WCL	Q	V	Hv	Spread	Area	Pw	Fr	Es	Ms	WPav	SxPav	WGut	SxGut
#	#	ft	ft/ft	ft	cfs	fps	ft	sf	ft	#	ft	cf	ft	ft/ft	ft	ft/ft
1	1	0.330	.04000	10.00	10.93	5.69	0.50	10.00	1.92	10.33	2.29	0.83	2.14	9.00	.02000	1.00 .06000
2	1	0.330	.04800	10.00	11.97	6.24	0.60	10.00	1.92	10.33	2.51	0.93	2.52	9.00	.02000	1.00 .06000
3	1	0.330	.04000	10.00	17.28	6.84	0.73	10.00	2.53	10.33	2.40	1.06	3.99	9.00	.00500	1.00 .06000
4	1	0.330	.04800	10.00	18.93	7.49	0.87	10.00	2.53	10.33	2.63	1.20	4.73	9.00	.00500	1.00 .06000
5	1	0.330	.04000	10.00	19.17	7.13	0.79	10.00	2.69	10.33	2.42	1.12	4.61	9.00	.00100	1.00 .06000
6	1	0.330	.04800	10.00	21.00	7.81	0.95	10.00	2.69	10.33	2.65	1.28	5.45	9.00	.00100	1.00 .06000

@ 4.8% LONGIT $Q_{cap} = 2 * 19.17 = 38.34$
 4.8% $2 * 21.00 = 42.00$

Q TOTAL ENTIRE SITE (INCLUDING 10/24 LOTS
 ALONG PARSIPAL NOT CONTRIBUTING TO THIS
 LOCATION) ≈ 10.8 CFS

Q TOTAL SITE $\ll$ Q CAPACITY HILTON R OK
 }

PARSIFAL TOWNHOMES - RAIN ZONE 3

INLET CAPACITY ON HILTON R WEST OF PARSIFAL
PAVEMENT WIDTH 32' FE, STD 8" C&C
SLOPE - ~4% G-20 PAVED TPO @ 1"=200'

(PER HILTON R STORM DRAIN PED (SHT 4006))
HGL ~5.5' BELOW PAVEMENT - PLENTY

$$Q_{TOTAL} = Q_{SITE} + Q_{ADJL}$$

$Q_{SITE} = 10.76 \text{ CFS}$ - SPREAD SHEET IN CALLS

Q_{ADJL} : AREA ~ $660 \times 100 = 66000 \text{ SF} \sim 1.515 \sim 1.52 \text{ AC}$
EST 75% IMPERVIOUS 5.02 CFS/AC
25% B LAWN/LANDSCAPE 2.60

$$1.52(1.25 \times 2.6 + 1.75 \times 5.02) = 6.71 \text{ CFS}$$

$$Q_{TOTAL} = 10.76 + 6.71 = 17.47 \sim 17.5 \text{ CFS}$$

$$Q_{PER INLET} = Q_{TOT}/2 = 8.75 \text{ CFS}$$

PER PROGRAM STFLOW3 OUTPUT

$y = 0.349 \sim 0.35'$ 16' 1/2 WIDTH, 4%, 8.75 CFS

$Q = 65.4 \text{ CFS}$ FOR $y = 0.66'$, ELSE SAME = ...

PER DPM PL 22.3 D6

GRATING CAPACITY FOR SINGLE A, C, D

$$\rightarrow \underline{Q_{INLET} = 5.5 \text{ CFS}} \quad y = 3.49 \sim 3.5 \text{ ft} \quad S = .04 \text{ ft}$$

NOTE: 1/2 PARSIFAL SITE $Q_P = 10.76/2 = 5.38$

5.38 PARSIFAL < 5.5 CAPACITY @ 8.75 CFS
OK

CAPACITY @ $y = 0.66' = 110 \text{ CFS} > 8.75 \text{ OK}$

08-25-1996 21:31:21 Manning n = .017 STSEQ.BAS or STFLOWn.EXE output file STF.OUT

HILTON PL WEST OF PARSIFAL, Qpeak EACH INLET=8.75 CFS, $8.75 \times 2 = 17.5$ CFS

Qpeak PARSIFAL TOWNHOMES=10.76 CFS, $10.76/2 = 5.38$ CFS EACH INLET

COMMENT:

MAIN MENU

- (1) FOR ENTER Yn, S GET Q, V, T, Fr, Es, Ms
- (2) FOR ENTER Q, S GET Yn, V, T, Fr, Es, Ms
- (3) FOR ENTER Q, Yn GET S, etc
- (4) FOR PREV. Q, Ms GET Ysequent, etc
- (5) FOR ENTER Q, Fr GET S, Yn, etc
- (6) NEW CL OR GUTTER WIDTH
- (7) WRITE TO ASCII OUTPUT FILE
- (8) QUIT PROGRAM

Mnu	Y	S	NCL	Q	V	Hv	Spread	Area	Pw	Fr	Es	Ms	WPav	SxPav	WGut	SxGut
#	#	ft	ft/ft	ft	cfs	fps	ft	ft	sf	ft	#	ft	cf	ft	ft/ft	ft/ft
1	2	0.349	.04000	16.00	8.75	4.64	0.33	13.44	1.89	13.79	2.18	0.68	1.45	14.00	.02000	2.00 .06000
2	1	0.660	.04000	16.00	65.40	9.62	1.44	16.00	6.80	16.67	2.60	2.10	21.06	14.00	.02000	2.00 .06000

SIERRA ULTA CHANNEL

PARSIAL DOWNHOMES OPPOSITE

S-1-96

PARCIVAL

SIERRA VISTA CHANNEL REANALYSIS

RAINFALL FOR HYMO - FROM DPM FG C-1 → C-3

1 HR RAIN ~ 2.15 INCH

6 HR ~ 2.59

24 HR ~ 3.11

PARSIFAL

SIERRA VISTA (SV) CHANNEL REANALYSIS

BASIN 1-C

245,300 SF $\approx$ 5.6313 $\approx$ 5.63 AC COMMERCIAL
 REST OF 9.7 AC (I & A SHT 6/32) ARTERIAL ST

$$9.7 - 5.63 = 4.07 \text{ AC ARTERIAL}$$

PER I & A SHTS 1-4

$$\text{ARTERIAL ST } 101/106 = 95.3\% \text{ IMPERVIOUS} = D \\ \Rightarrow 4.7\% \text{ LANDSCAPE} = B$$

$$\text{COMMERCIAL DEVELOPMENT } 93\% \text{ IMPERVIOUS} = \text{TREATMENT D} \\ 7\% \text{ LANDSCAPE} = \text{" B}$$

FOR 1-C IN SUM

$$\text{TREATMENT B} = (107)(5.63) + (.047)(4.07) \\ = 0.5840 \text{ AC}$$

$$\text{TREATMENT D} = \text{REST} = 9.7 - 0.584 \\ = 9.1160 \text{ AC} = \underline{\underline{93.98\%}}$$

I & A ANALYZED INLET BYPASS FLOW AT
 MONTGOMERY & EURANK & FOUND @ PEAK
 19 CFS BYPASS (SHT 27) OF 35 CFS (1-C) SHT 6
 $19/35 = 0.5429$ SAY 55% BYPASS

BY ANALOGY, FOR ANYING

ASSUME 55% BYPASSES INLETS WHICH
 SEND FLOW ALONG MONTGOMERY

55% OF 1-C FLOW TO SIERRA VISTA CHANNEL

NOTE I & A = ISAACSON & ARFMAN, HILTON PLACE
 STORM DRAIN DESIGN REPORT

PARSIFAZ

S-1-96

SIERRA VISTA CHAN - REANALYSIS

BASIN 1-C CONT

TIME OF CONCENTRATION ETC. $T_c \neq T_D$

$L \sim 2700'$ MOSTLY ALONG MONTGOMERY

$$\Delta \text{ELEV} \sim 5637 - 5572 = 65'$$

$$\text{SLOPE} = 65/2700 = 2.41\% \pm = 0.0241 \text{ ft/ft}$$

DPM 22.2 (JAN '93) §B.2

FOR $L < 4000' = 2700'$

$K > 3$ STREET FLOW & STORM SEWERS

$$V = 10.8 \sqrt{S}, S \text{ in ft/ft}$$

$$V = 10.8 \sqrt{0.0241} \sim 4.6573 \sim 4.66 \text{ ft/sec}$$

$$\begin{aligned} T_c &= \frac{L}{V} = \frac{2700}{35.0241} = 579.7 \sim 580 \text{ sec} \\ &= 9.66 \text{ min} \\ &= 0.161 \text{ hrs} \end{aligned}$$

IF CONSIDER 1-C FLOW PATH TO CATTLE GUARD IN LET
IN EMBANK (NO EXTRA AREA) THEN

$$L = 2700 + 550' = 3250'$$

$$\Delta \text{elev} = 5637 - 5559 \pm = 78'$$

$$S = 78/3250 = 2.0.240\%$$

$$V = 10.8 \sqrt{0.024} = 4.6476$$

$$\begin{aligned} T_c &= \frac{L}{V} = \frac{3250}{V} = 699.3 \text{ sec} \\ &= 11.65 \text{ min} \\ &= 0.1942 \text{ hr} \end{aligned}$$

USE $T_c = 12 \text{ minutes} - \text{min}$ } use $t_c = 12 \text{ min} = 12 \text{ min}$
 $t_p = T_c \times 2/3 = 8 \text{ minutes}$ } equal at 1-C
delay

4-30-96

PARTIAL

SIERRA VISTA CHANNEL REANALYSIS

I & A ~ ISAACSON & ARFMAN

HILTON PLACE STORM DRAIN DESIGN REPORT

BASIN 2-1 - EURANK & EAST

FROM I & A SHTS 1-5

16.7 AC TOTAL

~ 1,026,091 mi²

APT & SU 7.7 AC 25% B 75% D

COMMERCIAL 6.7 AC 7 93
1 AC

ARTERIAL STREET 2.3 AC 4.7% 95.3

B: $(.25)(7.7) + (.07)(6.7) + (.047)(2.3) \sim 15\%$

= 2,5021 ~ 2,502 AC

D = REST = 14,198 AC = .85018 ~ 85.0%

BASIN 2-2 - SIERRA VISTA TOWN HOMES & PART
OF SIERRA VISTA SHOPPING CENTER

TOTAL AREA = 10.4 AC + 17.152 AC D REASSIGNED

FROM 2-3 TO 2-2

= 10.7937 ~ 10.794 AC = 10,687 mi²

APT & SU 1.3 AC 25% B 75% D

RESIDENTIAL 2.4 48% B 52 D

COMMERCIAL 5.6 7 93

(URIG I & A) 0 100

REASSIGNED IMPERV 0.3937

B: $(.25)(1.3) + (.48)(2.4) + (.07)(5.6)$
= 1.869 AC

D = REST = 10.794 - 1.869 17.3%
= 8.925 AC 82.7%

4-30-96

PARSIFAL

SIERRA VISTA CHANNEL REANALYSIS

REFERENCE: ISMAISON & ARMAN HILTON PLACE
STORM DRAIN DESIGN REPORT

BASIN 2-3 - MUCH OF SIERRA VISTA SHOPPING CTR
FLOW ENTERS DOWN STREAM OF RAFFLE-
WEIR @ NEC OF TRACT C

TOTAL AREA = 11.5 AC - .3937 ~ .394 AC IMPERV
REASSIGNED TO 2-2
= 11.106 AC =

OFFICE	1.8 AC	22% B	78% D
COMMERCIAL (ORIG I & A)	9.7	7	93

$$D = (93)(9.7) - (1.00)(.394) = 9.021 - 0.394$$

$$= 8.627 AC \quad = 77.7\%$$

$$B = REST = 11.106 - 8.627$$

$$= 2.479 AC \quad 22.3\%$$

CHANNEL STORAGE VOLUMES REVISION

- ORIGINAL VOLUMES WERE BASED ON 19 FT WIDTH PER HILTON PLACE STORM DRAIN DESIGN REPORT
- SUBSEQUENT FIELD MEASUREMENT SHOWS THAT ACTUAL WIDTH IS $\pm 18.5'$ — 3 UPSTREAM WEIRS
- FIELD MEASUREMENT ALSO SHOWS THAT THE EXTRA WIDTH @ THE "L" IN THE NE CORNER IS 43" INSTEAD OF 48" (4') PREVIOUSLY ASSUMED. THIS AREA IS ~~A~~ SMALL COMPARED TO THE OVERALL AREA OF THIS RESERVOIR SECTION.

∴ REUSE AHYMO FILES FOR LESS
"RESERVOIR" STORAGE: FACTOR = $18.5/19$

AHYMO FILES ~~SUCX1, SUCXT1, SUCPR1~~

SUCX2, SUCXT2, & SUCPR2
REFLECT THESE CHANGES.

THE FOLLOWING CALCULATIONS HAVE
NOT BEEN REUSED UNLESS
SPECIFICALLY SO NOTED.


* ONLY THE 3 UPSTREAM WEIRS. LOWER WIDTH
CORRECT ALREADY

PARSIFAL

4-30-96

SICRRA USTA CHANNEL REANALYSIS
CHANNEL STORAGE

UPSTREAM - NEAR GUBANK

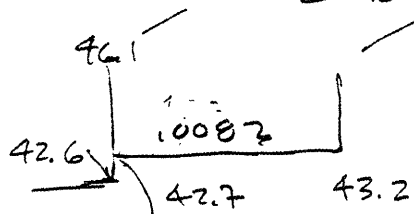FEA STA 10+92 TO 11+53 $\Delta = 61$ FT, @ 19' WIDE $\Rightarrow 1159$ SP@ $Q = 150$ CFS $W = 19'$, $C = 3$ $H = 1.91$ FT, $y_c = 1.27'$ $Q = 800$ $H = 3.02'$ $y_c = 2.02$

42.7 $U = 0$

43.2 $U = (43.2 - 42.7) \times 1159 \times \frac{1}{2} = 289.75 \sim 290$ CF

43.1 $U = (43.1 - 42.7) \times 1159 + U_{prev}$

$\approx 464 + 290$

~ 754 CF

46.1 $U = (46.1 - 43.1) \times 1159 + U_{prev}$

$= 3477 + 754$

~ 4231

48.1 $U = 2 \times 1159 + U_{prev} =$


6549

52.1 $U = 2 \times 1159 + U_{prev} =$

8867

46.5 $U = 4231 + (0.4)(1159) = 4695$

NEXT DOWNSTREAM - E OF INLET FROM TOWN HOMES

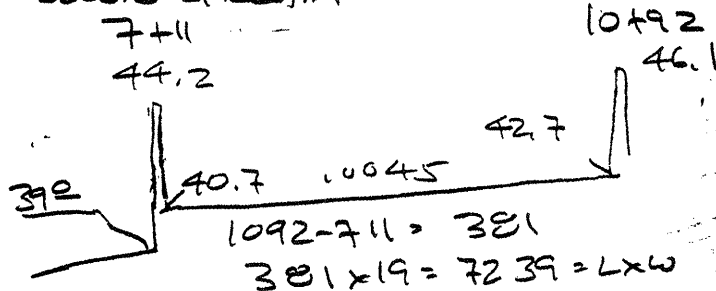

40.7 - $U = 0$

42.7 $U = (42.7 - 40.7)(7239)(\frac{1}{2}) = 7239$

43.2 $U = U_{prev} + (43.2 - 42.7) 7239 \approx 10859$

44.2 $U = U_{prev} + 7239$

18096

46.2 $U = U_{prev} + 2(7239)$

32,576

48.2 $U = U_{prev} + 2(7239)$

47,054

44.6 $U = 18096 + 0.4(7239) \approx 20,992$

PLAN & PROFILE

SIERRA VISTA CHANNEL

1" = 100' Horizontal
1" = 10' Vertical

Sierra Vista Shopping Center

12.5 F-F T&E

Existing 36" RCP

Sierra Vista Townhouses

Top of South or West Side Walls

36" RCP

.0005

.0082

.0017

.010

5+29

T. Step = 36.6
B. Step = 36.3

6+50

T. Step = 38.4
B. Step = 36.8

7+11

T. End Wall = 44.2
West Floor = 39.0
East Floor = 40.7

10+92

T. End Wall = 46.1
West Floor = 42.6
East Floor = 42.7

11+53

T. Head Wall = 46.6
West Floor = 43.2

PLAN & PROFILE

1" = 100' Horizontal

1" = 10' Vertical

Sierra Vista Shopping C

39.6 V ~~27~~ 340
40.6 36067
41.6 44794

- Sierra Vista Tower.

Below
Elev

AREA
SIR

35.3 $19 \times (275 + 4) + 4 \times 30 = 5269$

36.6 5269 512

36.8 $5269 + 121 \times 19 = 7568$

$$36.8 \quad 5269 + 12149 = \underline{7568}$$

38.4

$$39.0 \quad 7568 + 61 \times 19 = 2727$$
$$32.6 \text{ V} = 17216 + 0.2 \times 7568 + \left(\frac{6}{3}\right)\left(\frac{6}{3}\right)(12)(49) = 18768$$

Top of South or
West Side Walls

29.4


39°

5+29
T. 5HP
B. 5HP

6 + 50
T. Step = 38.4
B. Step = 36.8

7+11
T. End Wall = 44.2
West Floor = 39.0
East Floor = 40.7

36

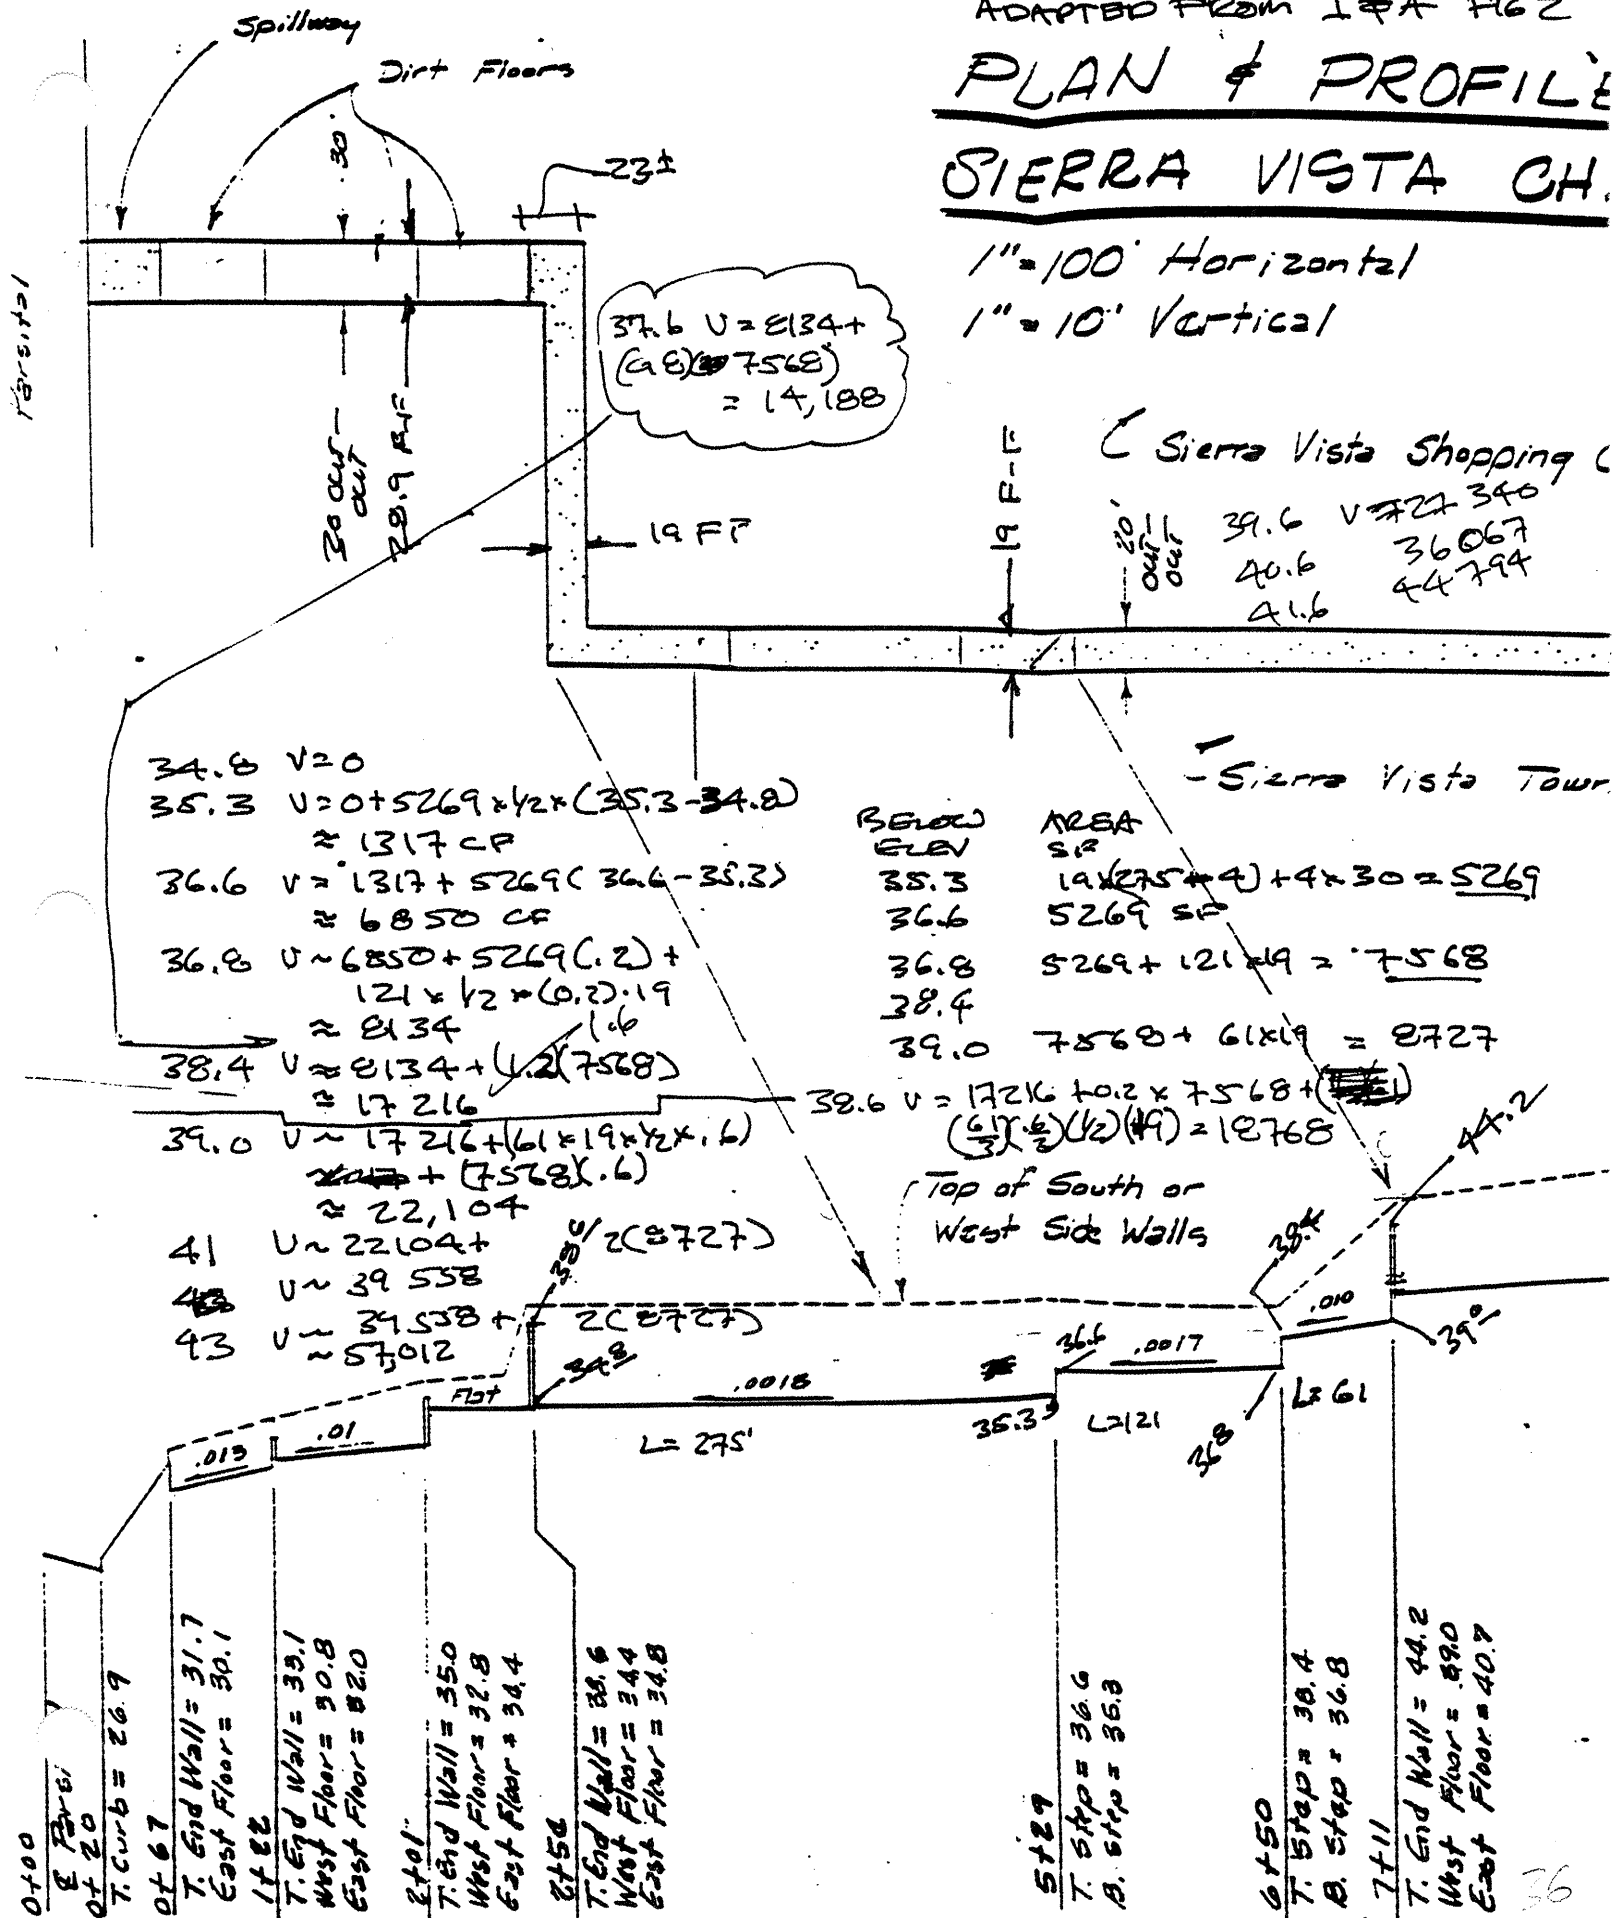

05/19/96

Revised 5-19-96 for width 18.5' instead of 19'

09:53 AM

Revised 5-19-96 to add weir flow for L=28.9 & weir elev=38.1, 37.1

ELEV FT	ORIG AREA	REV'D AREA	PYRAMID DVOL CONE	VOL FT^3	VOL AC-FT	AV END AREA DVOL AV AREA	VOL FT^3	VOL AC-FT
40.6	8723	8493	4247	38889	0.8928	4247	39324	0.9028
40.1	8723	8493	4247	34642	0.7953	4247	35077	0.8053
39.6	8723	8493	4247	30396	0.6978	4247	30831	0.7078
39.1	8723	8493	849	26149	0.6003	849	26584	0.6103
39	8723	8493	3246	25300	0.5808	3247	25735	0.5908
38.6	7950	7741	1510	22054	0.5063	1511	22488	0.5163
38.4	7564	7365	2209	20544	0.4716	2209	20978	0.4816
38.1	7564	7365	3682	18334	0.4209	3682	18768	0.4309
37.6	7564	7365	3682	14652	0.3364	3682	15086	0.3463
37.1	7564	7365	2209	10970	0.2518	2209	11404	0.2618
36.8	7564	7365	1242	8761	0.2011	1249	9194	0.2111
36.6	5265	5126	6664	7518	0.1726	6664	7945	0.1824
35.3	5265	5126	854	854	0.0196	1282	1282	0.0294
34.8	0	0	0	0	0.0000	0	0	0.0000

* C = 3.5	L=28.9	L=28.9	L=28.9	L=28.9	L=28.9	L=28.9	L=25.9	L=25.9
DEPTH	Q	DEPTH	Q	DEPTH	Q	DEPTH	Q	Q
40.6	2.00	286.1	3.50	662.3	4.00	809.2	3.50	593.6
40.1	1.50	185.8	3.00	525.6	3.50	662.3	3.00	471.0
39.6	1.00	101.2	2.50	399.8	3.00	525.6	2.50	358.3
39.1	0.50	35.8	2.00	286.1	2.50	399.8	2.00	256.4
39	0.40	25.6	1.90	264.9	2.40	376.1	1.90	237.4
38.6	0.00	0.0	1.50	185.8	2.00	286.1	1.50	166.5
38.4			1.30	149.9	1.80	244.3	1.30	134.4
38.1			1.00	101.2	1.50	185.8	1.00	90.7
37.6			0.50	35.8	1.00	101.2	0.50	32.0
37.1			0.00	0.0	0.50	35.8	0.00	0.0
36.8					0.20	9.0		
36.6					0.00	0.0		
35.3								
34.8								

USE
FOR
ATTIMO
SUCPRO2

$$Q = 0 @ 36.6$$

$$36.6 - 34.8 = 1.8$$

$$= \text{WEIR HT.}$$

USE IN ATTIMO SUCPRO2

NOTE: ELEV'S BASED ON HILTON PLUM
SPRM DRAIN REPORT, NOT ON FIELD
MEASUREMENTS FOR PARSIPAL TOWNHOMES
ELEV 34.8 HPSD CORRESPONDS TO 34.28
PARSIPAL FIELD MEASUREMENTS.

* C = 3.5 CF FIG 5.2 (BRATER &) KING 6MGD
CF ALSO HPSD REPORT - ALSO USED 3.5
HORIZONTAL SHARP-CRESTED WEIR

PARSIFAL


S-1-96

SIERRA VISTA CHAN REPRASE

STORAGE W. SIDE PARSIFAL DOWN HOUSE

- USE FIELD DATA BY TAG & AFM
- APPROXIMATE V SHAPE BY USING $\frac{1}{2}$ ELEV & AVERAGE OF ELEVS @ END
 - NEVER A BIG DIFFERENCE
 - TOTAL STORAGE IS VALUED VERY SMALL
- IGNORE ANY DIFF OF ELEV BASE *

EAST OF 2 LOW BAFFLES TO EAST HEADWALL
EAST HEADWALL I & A STA 2+54

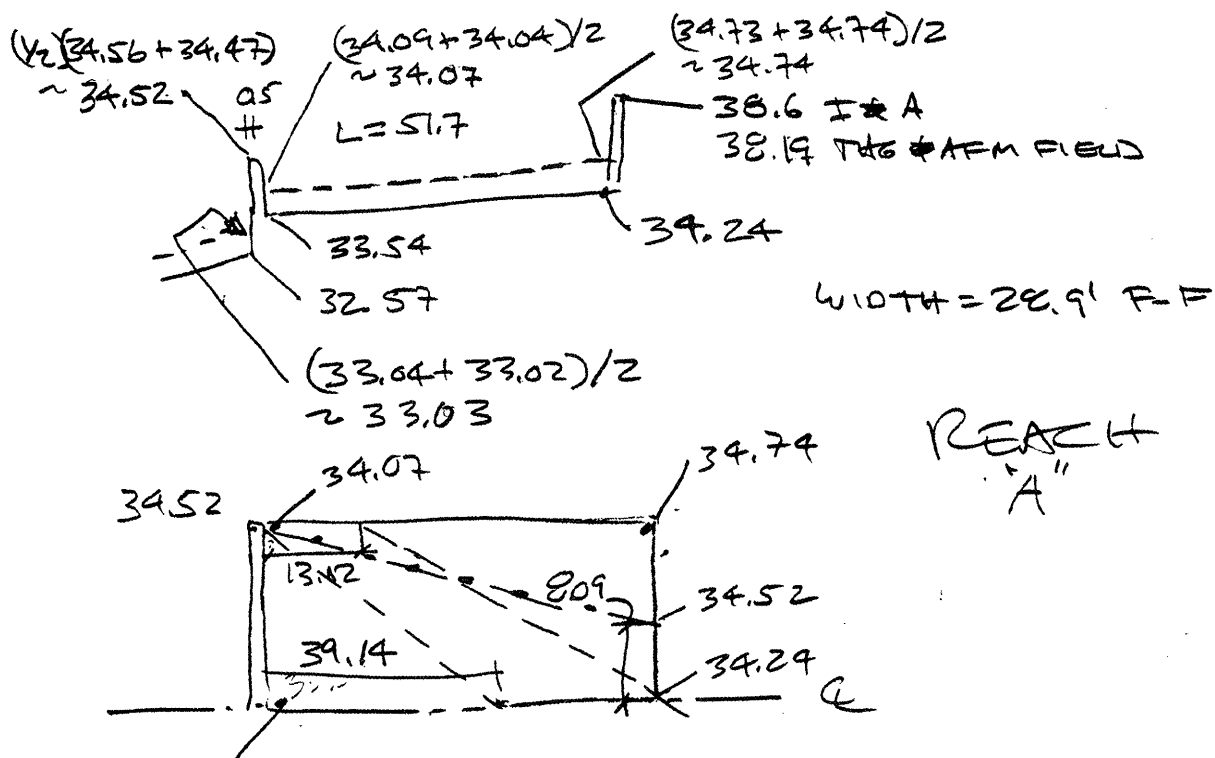

REACH
"A"

$$\begin{aligned} 33.54 & \quad \frac{34.07 - 33.54}{34.24 - 33.54} \times 51.7 = 39.14 \\ 34.24 - 34.07 & \quad \frac{34.24 - 34.07}{34.74 - 34.07} \times 51.7 = 13.12 \\ 34.52 - 34.24 & \quad \frac{34.52 - 34.24}{34.74 - 34.24} \times (28.9/2) = 8.09 \end{aligned}$$

$$\begin{aligned} @ 34.07 \quad A &= 2 \left(\frac{1}{2} \right) (28.9) (39.14) \left(\frac{1}{2} \right) = 565.6 \\ 34.24 \quad A &= 13.12 \times 28.9 + (51.7 - 13.12) (28.9) / 2 = 936.7 \\ 34.52 \quad A &= (51.7) \left(\frac{1}{2} \right) (28.9 + 2(8.09)) = 1165.3 \\ \rightarrow 34.74 \quad A &= (51.7) (28.9) = 1494.1 \end{aligned}$$

* EFFECT IS NIL BECAUSE OF "WATER FALL OVER 14' 6" WEIR @ I & A STA 2+54

SIERRA USTA CHANNEL REPRISE

REACH "A" STORAGE CONTINUED

ELEV V.C.F.
33.54 0

34.07: USE FRUSTUM OF PYRAMID FORMULA FOR THIS

$$V = \frac{h}{3} (A_{TOP} + A_{BOT} + \sqrt{A_{TOP} \cdot A_{BOT}})$$

$$\text{Here } A_{BOT} = 0 \Rightarrow V = \frac{h}{3} A_{TOP}$$

$$= \left(\frac{34.07 - 33.54}{3} \right) 565.6 = 99.92 \text{ CF} \approx \underline{100 \text{ CF}}$$

ABOVE BOTTOM USE AVG END AREAS FOR ΔV

$$\begin{aligned} \underline{34.24} \quad V &= 100 + (34.24 - 34.07) \left(\frac{1}{2} \right) (565.6 + 936.7) \\ &= 100 + 127.7 \\ &\approx \underline{228 \text{ CF}} \end{aligned}$$

$$\begin{aligned} 34.52 \quad V &= 228 + (34.52 - 34.24) \left(\frac{1}{2} \right) (936.7 + 1165.3) \\ &= 228 + 294.28 \\ &= \underline{522} \end{aligned}$$

$$\begin{aligned} 34.74 \quad V &= 522 + (34.74 - 34.52) \left(\frac{1}{2} \right) (1165.3 + 1494.1) \\ &= 522 + 292.53 \\ &\approx \underline{815 \text{ CF}} \end{aligned}$$

$$\begin{aligned} 35.74 \quad V &= 815 + 1494 \\ &= \underline{2309} \end{aligned}$$

$$\begin{aligned} 37.74 \quad V &= 2309 + 2(1494) \\ &= \underline{5297} \end{aligned}$$

$$34.92 \quad V = 815 + (.92 - .74) 1494 \approx 1084$$

$$35.52 \quad V = 815 + (.52 - .74) 1494 \approx 1900$$

$$36.52 \quad V = 1900 + 1494 = 3478$$

$$37.52 \quad V = 3478 + 1494 = 4968$$

PARSIFAL



5-1-96

SIERRA USTA CHAN REPRUSE

STORAGE N SIDE PARSIFAL TOWNHOUSE

REACH "B" - WEST/DOWNSTREAM SMALL RAPPLE

USE AVERAGE VALUES AS FOR REACH "A"

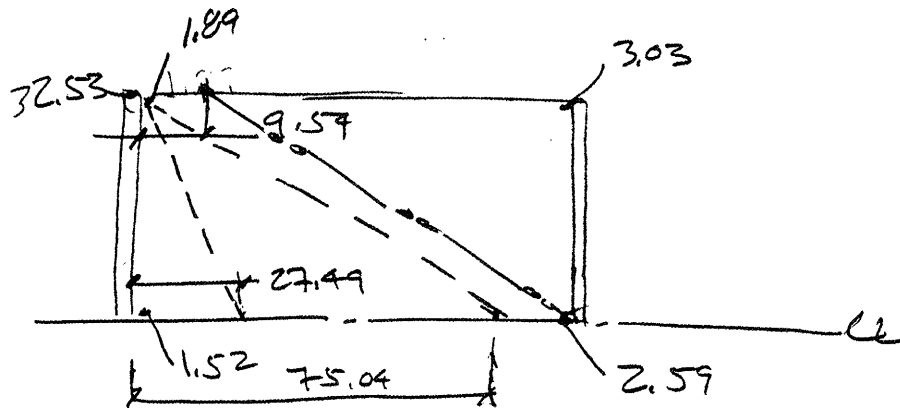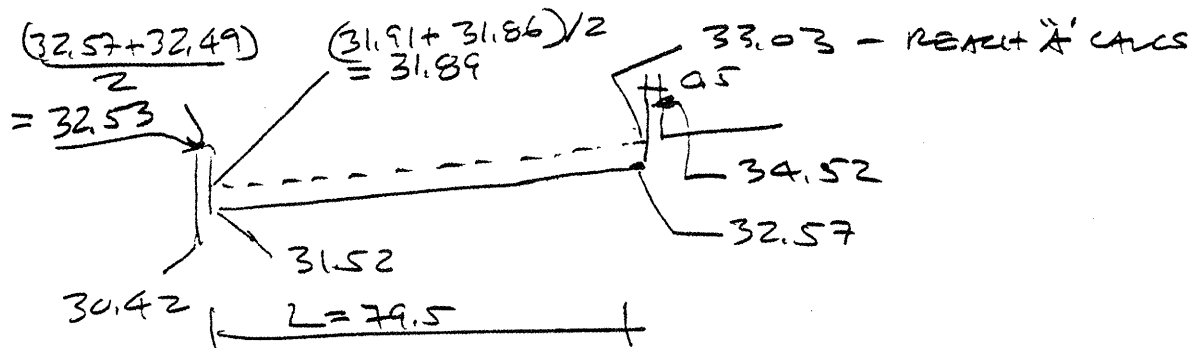

$$\left(\frac{2.53 - 1.52}{2.59 - 1.52} \right) \times 79.5 = 75.04$$

$$\left(\frac{1.89 - 1.52}{2.59 - 1.52} \right) (79.5) = 27.49$$

$$\left(\frac{2.59 - 2.53}{3.03 - 2.53} \right) (79.5) = 9.54$$

ELEV	AREA SF
1.89	$(28.9)(1/2)(27.49) = 397.23 \sim 397.2$
2.59	$(28.9)(9.54) + (79.5 - 9.54)(28.9)(1/2) = 1286.6$
2.53	$(28.9)(75.04)(1/2) = 1084.3$
3.03	$(28.9)(79.5) = 2297.6$

-SKIP

PARSIFAL

5-196

SIERRA USTA CHAN REPRUSE

REACH "B" STORAGE CONT

GEOMETRY SLIGHTLY DIFFER THAN IN REACH "A"

 $\Rightarrow$ USE FRUSTUM OF CONE UP TROUGH ELEV 33.03

ELEV U

(3) 1.52

0

$$1.89 \quad \left(\frac{1.89 - 1.52}{3} \right) (397.2) \sim 49.$$

$$2.53 \quad 49 + \left(\frac{2.53 - 1.89}{3} \right) (1084.3 + 397.2 + \sqrt{1084.3 \times 397.2})$$

$$= 49 + 456.06$$

$$2585$$

$$2.59 \quad 505 + \left(\frac{2.59 - 2.53}{3} \right) (1084.3 + 1286.6 + \sqrt{1084.3 \times 1286.6})$$

$$= 505 + 71.04$$

$$2576$$

$$3.03 \quad 576 + \left(\frac{3.03 - 2.59}{3} \right) (2297.6 + 1286.6 + \sqrt{2297.6 \times 1286.6})$$

$$= 576 + 777.95$$

$$= 1354.$$


$$3.53 = \text{avg} (3.03, 4.03) \\ = 2503$$

$$4.03 \quad 1354 + 2298 \\ = \underline{3652}$$

$$4.53 = \frac{3.53 + 2298}{2} = 4801$$

$$6.03 \quad 3652 + 2(2298) \\ = \underline{8248}$$

$$5.53 = 7099$$

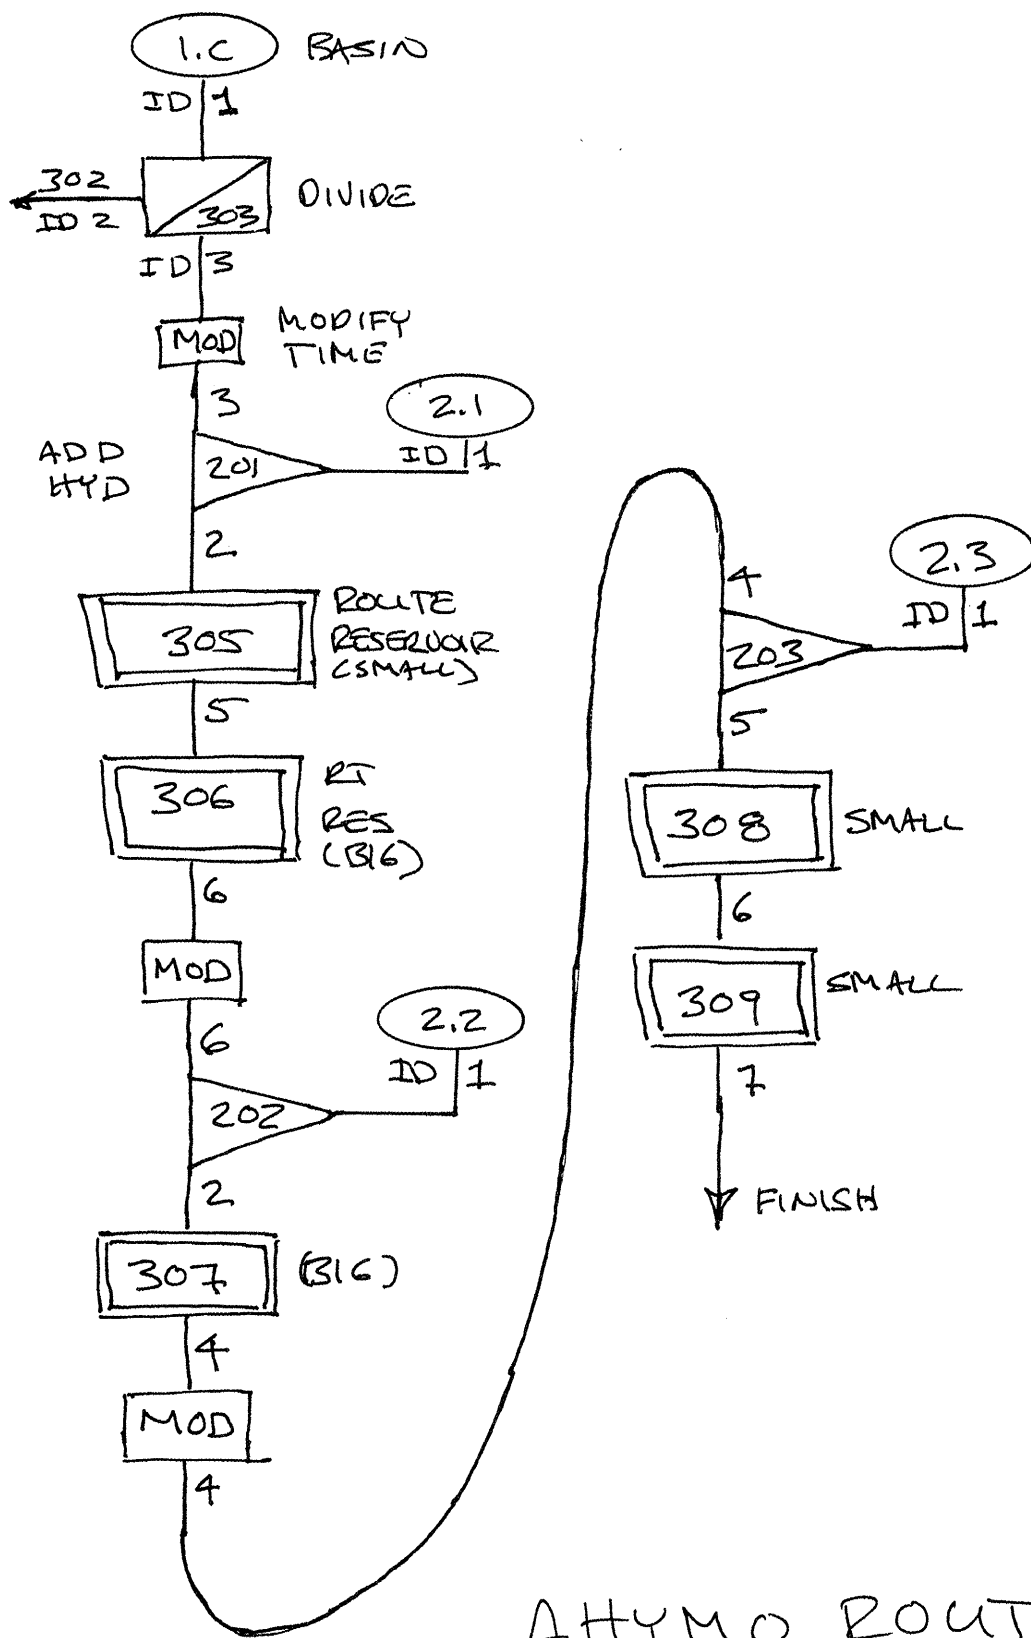

ATHMO ROUTING

ALHYMO

SUC X Z

SIERRA VISTA CHANNEL

EXISTING CHANNEL CONDITIONS

VERSION 2 (18.5' WIDE @UPSTREAM)

FULLY DEVELOPED CONDITIONS

Q100

AHYMO SUMMARY TABLE (AHYMO194) - AMAFCA Hydrologic Model - January, 1994
 INPUT FILE = SVCX2

RUN DATE (MON/DAY/YR) = 05/19/1996
 USER NO. = PERSEENG.194

COMMAND	HYDROGRAPH IDENTIFICATION	FROM ID NO.	TO ID NO.	AREA (SQ MI)	PEAK DISCHARGE (CFS)	RUNOFF VOLUME (AC-FT)	RUNOFF (INCHES)	TIME TO PEAK (HOURS)	CFS PER ACRE	PAGE = 1	NOTATION
START											
*S Sierra Vista Channel, future development, eXisting channel conditions, v2											
*S Original file created 5-6-96 by Tucker Green PE											
*S Revised 5-19-96: adjust routing volumes by 18.5/19: actual width = 18.5 ft											
*S											
*S 2 MAIN CHANNEL RESERVOIRS LAGGED BY (PEAK VOL) / (PEAK CFS)											
*S UPPER (ABOVE BASIN 2-2) LAGGED 0.074 HR											
*S LOWER (ABOVE 2-3) 0.066 HR											
*S											
RAINFALL TYPE= 1											
*S BASIN 1-C											
COMPUTE NM HYD	1.C	-	1	.01516	47.49	1.829	2.26177	1.500	4.894	PER IMP= 94.00	
*S NEXT SPLIT 1-C SO 55% BYPASSES INLETS TO MONTGOMERY SD & ENTERS SVC @ ID=3											
DIVIDE HYD	302.00	1	2	.00682	21.37	.823	2.26176	1.500	4.894		
	303.00	AND	3	.00834	26.12	1.006	2.26176	1.500	4.894		
*S NEXT DELAY HYD TO SIMULATE ROUTING IN STREET											
MODIFY TIME	303.00	3	3	.00834	26.12	1.006	2.26175	1.533	4.894		
*S BASIN 2-1											
COMPUTE NM HYD	2.10	-	1	.02609	78.04	2.969	2.13351	1.500	4.674	PER IMP= 85.00	
*S NEXT = COMBINED INFLOW TO SVC AT UPPER END											
ADD HYD	201.00	1& 3	2	.03443	102.00	3.974	2.16456	1.500	4.629		
*S RES ROUTE SHORT (42.7') UPPER SVC											
ROUTE RESERVOIR	305.00	2	5	.03443	101.31	3.974	2.16456	1.533	4.598	AC-FT= .131	
*S RES ROUTE LONG (381') UPPER SVC											
ROUTE RESERVOIR	306.00	5	6	.03443	101.27	3.974	2.16455	1.533	4.596	AC-FT= .616	
*S NEXT DELAY HYD TO SIMULATE ROUTING IN CHANNEL											
*S TIME LAG SHOULD BE APX = VOLpeak/Qpeak											
MODIFY TIME	306.00	6	6	.03443	101.27	3.974	2.16455	1.600	4.596		
*S BASIN 2-2											
COMPUTE NM HYD	2.20	-	1	.01687	49.86	1.890	2.10073	1.500	4.618	PER IMP= 82.70	
*S NEXT = COMBINED INFLOW TO SVC ABOVE NEC TR-C W/O ROUTING											
ADD HYD	202.00	1& 6	2	.05130	137.18	5.865	2.14356	1.567	4.178		
*S RES ROUTE LONG (+/- 457') LOWER SVC: WEIR @ NEC PARSIFAL TH (TR-C)											
ROUTE RESERVOIR	307.00	2	4	.05130	136.85	5.865	2.14356	1.600	4.168	AC-FT= .749	
*S NEXT DELAY HYD TO SIMULATE ROUTING IN CHANNEL											
*S TIME LAG SHOULD BE APX = VOLpeak/Qpeak											
MODIFY TIME	307.00	4	4	.05130	136.85	5.865	2.14356	1.667	4.168		
*S BASIN 2-3											
COMPUTE NM HYD	2.30	-	1	.01735	49.92	1.878	2.02947	1.500	4.496	PER IMP= 77.70	
*S COMBINED FLOW IN SVC JUST DOWN FROM WEIR IN NEC PARSIFAL TH (TR-C)											
ADD HYD	203.00	1& 4	5	.06865	162.95	7.742	2.11472	1.633	3.709		
*S RES ROUTE 1ST LOW WEIR W OF NEC PARSIFAL TownHomes (TR-C)											
ROUTE RESERVOIR	308.00	5	6	.06865	163.01	7.742	2.11472	1.667	3.710	AC-FT= .057	
*S RES ROUTE 2nd (ALSO=LAST) LOW WEIR W OF NEC PARSIFAL TownHomes (TR-C)											
ROUTE RESERVOIR	309.00	6	7	.06865	163.10	7.742	2.11472	1.667	3.712	AC-FT= .075	
FINISH											

SVC X2

START 0.0 PUNCH CODE=0 PRINT LINES=58
 CONTROL CODES AT START = 027 038 107 050 083
 0 0 0 0 0 0 0 0 0 0 0 0 0 0 0
 CONTROL CODES AT END = 0 0 0 0 0
 0 0 0 0 0 0 0 0 0 0 0 0 0 0 0

* CONTROL CODES ABOVE FOR HP DESKJET 540 INKJET PRINTER

*
*C PRINT CODES: 0=ALL; 1-TOTALS ONLY; 2=EVERY 2ND + TOTALS; 3,5,10,20 SIMILAR
*C RATING CURVE ID NEGATIVE => COMPUTE BUT NOT PRINT RATING CURVE
*C RATING CURVE n NEGATIVE => FLOODPLAIN SLOPE, n POSITIVE => CHANNEL SLOPE

SVC X2

*S Sierra Vista Channel, future development, existing channel conditions, v2
*S Original file created 5-6-96 by Tucker Green PE
*S Revised 5-19-96: adjust routing volumes by 18.5/19: actual width = 18.5 ft

*S
*S 2 MAIN CHANNEL RESERVOIRS LAGGED BY (PEAK VOL) / (PEAK CFS)

*S UPPER (ABOVE BASIN 2-2) LAGGED 0.074 HR

*S LOWER (ABOVE 2-3) 0.066 HR

*S

*C The major features of SVC (Sierra Vista Channel) are vertical concrete
*C walls, several raised concrete weirs 6" thick, and several vertical
*C drops without raised weirs. Raised weir sections ARE routed as reservoirs
*C with C=3.5 for sharp crested weirs (Brater & King, 6th ed, fig 5-2). Small
*C outlet pipes at base of weirs would probably be plugged with trash and
*C are neglected.

*C

*C Per Discussion with the City of Albuquerque, this "New Hydrology Reprise"
*C of the Sierra Vista Channel along the back side of the Sierra Vista
*C Shopping Center (SEC Montgomery & Eubank NE) is based on drainage area and
*C future development identified in the "Hilton Place Storm Drain Design
*C Report", by Isaacson & Arfman for City of Albuquerque NM, April 1990

*C

*C Actual drainage area may extend farther upstream along Montgomery Blvd,
*C especially if the existing storm drain inlets at Morris do not "dry up"
*C the intersection and direct flow south along Morris. However, runoff
*C rates from some areas may be *less* than assumed in the I & A report
*C because of controls (ponds) installed with development. This is most likely
*C for development on the NORTH side of Montgomery not directly included
*C in this AHYMO study.

*C

*C The DIVIDE HYD command here apportions flow from Basin 1-C, 45% into the
*C Montgomery storm drain and out of this study, the rest to the SVC.

*C The MODIFY TIME command here *simulates* routing delays: from 1-C to SVC,
*C and in the 2 large "linear pond" reaches of channel with raised vertical
*C weirs.

*C

*C The upper end of the SVC system - cattle guard inlet & 36" pipe - is *NOT*
*C modeled, because travel time in the pipe would be very short at peak flow.

*C

*C FLOW IS **NOT** BULKED FOR SEDIMENT IN THIS URBAN AREA

* RAINFALLS PER ALBUQUERQUE NM DPM - COMMENT OUT THOSE THAT DON'T APPLY

* TYPE 1 IS 6-HR STORM PER NOAA ATLAS 2 W PEAK INTENSITY @ 1.4 HRS (EQ C1-C5)

* FOR 6-HR USE DT = 0.033333 HR = 2 MINUTES

* TYPE 2 IS 24-HR STORM PER NOAA ATLAS 2 W PEAK INTENSITY @ 1.4 HRS (EQ C1-C6)

* FOR 24-HR USE DT = 0.0500 HR = 5 MINUTES

* RAIN QUARTER = 0.0 EXCEPT FOR TYPE 3 (6-HR PMP: SEE AHYMO MANUAL)

*

* RAINFALL AMOUNTS, INCHES



```

* RAINFALL          TWO YR  TYPE= 1  RAIN QUARTER= 0    RAIN ONE= 0.xx
*                   RAIN SIX= 1.xx  RAIN DAY= 1.xx    DT= .033333 HR
* RAINFALL          TEN YR  TYPE= 1  RAIN QUARTER= 0.0  RAIN ONE= 1.xx
*                   RAIN SIX= 1.xx  RAIN DAY= 2.xx    DT= .033333 HR
RAINFALL            HUNDRED TYPE= 1  RAIN QUARTER= 0.0  RAIN ONE= 2.15
                   RAIN SIX= 2.59  RAIN DAY= 3.11    DT= .033333 HR
*
*****
*S BASIN 1-C
COMPUTE NM HYD      ID= 1    HYD NO= 1.C    DA=0.01516 SQ MI
                   PER A= 0.00  B= 6      C= 0      D= 94
                   TP= -0.13333 HRS  RAIN= -1
PRINT HYD           ID= 1    CODE= 1
* PLOT HYD          ID= 1
*
*S NEXT SPLIT 1-C SO 55% BYPASSES INLETS TO MONTGOMERY SD & ENTERS SVC @ ID=3
DIVIDE HYD          ID_IN= 1  PER= -45  ID_OUT_A= 2  HYD_OUT_A= 302
                   ID_OUT_B= 3  HYD_OUT_B= 303
*
*S NEXT DELAY HYD TO SIMULATE ROUTING IN STREET
MODIFY TIME         ID= 3    TIME= 0.033333 HR  CODE= -1
*
*****
*S BASIN 2-1
COMPUTE NM HYD      ID= 1    HYD NO= 2.1    DA= 0.02609 SQ MI
                   PER A= 0.00  B= 15     C= 0      D= 85
                   TP= -0.13333 HRS  RAIN= -1
PRINT HYD           ID= 1    CODE= 1
* PLOT HYD          ID= 1
*
S NEXT = COMBINED INFLOW TO SVC AT UPPER END
ADD HYD             ID_OUT= 2  HYD_OUT= 201  ID_IN_I= 1  ID_IN_II= 3
PRINT HYD           ID= 2    CODE= 1
* PLOT HYD          ID= 2
*
*****
*S RES ROUTE SHORT (42.7') UPPER SVC
ROUTE RESERVOIR     ID= 5  HYD= 305  INFLOW ID= 2    CODE= 5.
                   OUTFLOW CFS  STORAGE AC-FT  ELEVATION FT
                   0.00000      0.0945      46.1
                   16.38       0.1051      46.5
                   64.75       0.1240      47.1
                   183.14      0.1463      48.1
                   336.45      0.1723      49.1
*S RES ROUTE LONG (381') UPPER SVC
ROUTE RESERVOIR     ID= 6  HYD= 306  INFLOW ID= 5    CODE= 5.
                   OUTFLOW CFS  STORAGE AC-FT  ELEVATION FT
                   0.00000      0.4053      44.2
                   16.38       0.4692      44.6
                   64.75       0.5663      45.2
                   183.14      0.7281      46.2
                   336.45      0.8899      47.2
*
*S NEXT DELAY HYD TO SIMULATE ROUTING IN CHANNEL
*S TIME LAG SHOULD BE APX = VOLpeak/Qpeak
MODIFY TIME         ID= 6    TIME= 0.HR  CODE= -1
MODIFY TIME         ID= 6    TIME= 0.074 HR  CODE= -1
*
*****
*S BASIN 2-2

```

```

COMPUTE NM HYD      ID= 1   HYD NO= 2.2   DA= 0.01687 SQ MI
                    PER A= 0.00   B= 17.3   C= 0       D= 82.7
                    TP= -0.13333 HRS   RAIN= -1
PRINT HYD           ID= 1   CODE= 1
* PLOT HYD          ID= 1
*
*S NEXT = COMBINED INFLOW TO SVC ABOVE NEC TR-C W/O ROUTING
ADD HYD             ID_OUT= 2   HYD_OUT= 202   ID_IN_I= 1   ID_IN_II= 6
PRINT HYD           ID= 2   CODE= 1
* PLOT HYD          ID= 2
*
*****
*S RES ROUTE LONG (+/- 457') LOWER SVC: WEIR @ NEC PARSIFAL TH (TR-C)
ROUTE RESERVOIR     ID= 4   HYD= 307   INFLOW ID= 2   CODE= 5.
                    OUTFLOW CFS   STORAGE AC-FT   ELEVATION FT
                    0.00000       0.5163         38.6
                    25.6         0.5908         39.0
                    35.8         0.6103         39.1
                    101.2        0.7078         39.6
                    185.8        0.8053         40.1
                    286.1        0.9028         40.6
*
*S NEXT DELAY HYD TO SIMULATE ROUTING IN CHANNEL
*S TIME LAG SHOULD BE APX = VOLpeak/Qpeak
* MODIFY TIME       ID= 4   TIME= 0.HR   CODE= -1
MODIFY TIME         ID= 4   TIME= 0.066 HR   CODE= -1
*****
*S BASIN 2-3
COMPUTE NM HYD      ID= 1   HYD NO= 2.3   DA= 0.01735 SQ MI
                    PER A= 0.00   B= 22.3   C= 0       D= 77.7
                    TP= -0.13333 HRS   RAIN= -1
PRINT HYD           ID= 1   CODE= 1
* PLOT HYD          ID= 1
*
*S COMBINED FLOW IN SVC JUST DOWN FROM WEIR IN NEC PARSIFAL TH (TR-C)
ADD HYD             ID_OUT= 5   HYD_OUT= 203   ID_IN_I= 1   ID_IN_II= 4
PRINT HYD           ID= 5   CODE= 1
* PLOT HYD          ID= 5
*
*****
*S RES ROUTE 1ST LOW WEIR W OF NEC PARSIFAL TownHomes (TR-C)
ROUTE RESERVOIR     ID= 6   HYD= 308   INFLOW ID= 5   CODE= 5.
                    OUTFLOW CFS   STORAGE AC-FT   ELEVATION FT
                    0.00000       0.0120         34.52
                    10.44        0.0187         34.74
                    25.59        0.0249         34.92
                    101.15       0.0455         35.52
                    286.10       0.0798         36.52
                    525.29       0.1140         37.52
*
*S RES ROUTE 2nd (ALSO=LAST) LOW WEIR W OF NEC PARSIFAL TownHomes (TR-C)
ROUTE RESERVOIR     ID= 7   HYD= 309   INFLOW ID= 6   CODE= 5.
                    OUTFLOW CFS   STORAGE AC-FT   ELEVATION FT
                    0.00000       0.0116         32.53
                    35.76        0.0311         33.03
                    101.15       0.0575         33.53
                    286.10       0.1102         34.53
                    525.29       0.1630         35.53
*

```

FINISH

AHYMO PROGRAM (AHYMO194) - AMAFCA Hydrologic Model - January, 1994
RUN DATE (MON/DAY/YR) = 05/19/1996
START TIME (HR:MIN:SEC) = 13:04:17 USER NO.= PERSEENG.194
INPUT FILE = SVCX2

START 0.0 PUNCH CODE=0 PRINT LINES=58
CONTROL CODES AT START = 027 038 107 050 083
0 0 0 0 0 0 0 0 0 0 0 0 0 0
CONTROL CODES AT END = 0 0 0 0 0
0 0 0 0 0 0 0 0 0 0 0 0 0 0
* CONTROL CODES ABOVE FOR HP DESKJET 540 INKJET PRINTER
*
*C PRINT CODES: 0=ALL; 1-TOTALS ONLY; 2=EVERY 2ND + TOTALS; 3,5,10,20 SIMILAR
*C RATING CURVE ID NEGATIVE => COMPUTE BUT NOT PRINT RATING CURVE
*C RATING CURVE n NEGATIVE => FLOODPLAIN SLOPE, n POSITIVE => CHANNEL SLOPE
*
*S Sierra Vista Channel, future development, existing channel conditions, v2
*S Original file created 5-6-96 by Tucker Green PE
*S Revised 5-19-96: adjust routing volumes by 18.5/19: actual width = 18.5 ft
*S
*S 2 MAIN CHANNEL RESERVOIRS LAGGED BY (PEAK VOL) / (PEAK CFS)
*S UPPER (ABOVE BASIN 2-2) LAGGED 0.074 HR
*S LOWER (ABOVE 2-3) 0.066 HR
*S
*C The major features of SVC (Sierra Vista Channel) are vertical concrete
*C walls, several raised concrete weirs 6" thick, and several vertical
*C drops without raised weirs. Raised weir sections ARE routed as reservoirs
*C with C=3.5 for sharp crested weirs (Brater & King, 6th ed, fig 5-2). Small
*C outlet pipes at base of weirs would probably be plugged with trash and
*C are neglected.
*C
*C Per Discussion with the City of Albuquerque, this "New Hydrology Reprise"
*C of the Sierra Vista Channel along the back side of the Sierra Vista
*C Shopping Center (SEC Montgomery & Eubank NE) is based on drainage area and
*C future development identified in the "Hilton Place Storm Drain Design
*C Report", by Isaacson & Arfman for City of Albuquerque NM, April 1990
*C
*C Actual drainage area may extend farther upstream along Montgomery Blvd,
*C especially if the existing storm drain inlets at Morris do not "dry up"
*C the intersection and direct flow south along Morris. However, runoff
*C rates from some areas may be *less* than assumed in the I & A report
*C because of controls (ponds) installed with development. This is most likely
*C for development on the NORTH side of Montgomery not directly included
*C in this AHYMO study.
*C
*C The DIVIDE HYD command here apportions flow from Basin 1-C, 45% into the
*C Montgomery storm drain and out of this study, the rest to the SVC.
*C The MODIFY TIME command here *simulates* routing delays: from 1-C to SVC,
*C and in the 2 large "linear pond" reaches of channel with raised vertical
*C weirs.
*C
*C The upper end of the SVC system - cattle guard inlet & 36" pipe - is *NOT*
*C modeled, because travel time in the pipe would be very short at peak flow.
*C
*C FLOW IS **NOT** BULKED FOR SEDIMENT IN THIS URBAN AREA

* RAINFALLS PER ALBUQUERQUE NM DPM - COMMENT OUT THOSE THAT DON'T APPLY
* TYPE 1 IS 6-HR STORM PER NOAA ATLAS 2 W PEAK INTENSITY @ 1.4 HRS (EQ C1-C5)

SVC XZ

* FOR 6-HR USE DT = 0.033333 HR = 2 MINUTES
 * TYPE 2 IS 24-HR STORM PER NOAA ATLAS 2 W PEAK INTENSITY @ 1.4 HRS (BQ C1-C6)
 * FOR 24-HR USE DT = 0.0500 HR = 5 MINUTES
 * RAIN QUARTER = 0.0 EXCEPT FOR TYPE 3 (6-HR PMP: SEE AHYMO MANUAL)
 *

* RAINFALL AMOUNTS, INCHES

* RAINFALL TWO YR TYPE= 1 RAIN QUARTER= 0 RAIN ONE= 0.xx
 * RAIN SIX= 1.xx RAIN DAY= 1.xx DT= .033333 HR
 * RAINFALL TEN YR TYPE= 1 RAIN QUARTER= 0.0 RAIN ONE= 1.xx
 * RAIN SIX= 1.xx RAIN DAY= 2.xx DT= .033333 HR
 RAINFALL HUNDRED TYPE= 1 RAIN QUARTER= 0.0 RAIN ONE= 2.15
 RAIN SIX= 2.59 RAIN DAY= 3.11 DT= .033333 HR

COMPUTED 6-HOUR RAINFALL DISTRIBUTION BASED ON NOAA ATLAS 2 - PEAK AT 1.40 HR.

DT = .033333 HOURS		END TIME = 5.999940 HOURS	
.0000	.0025	.0050	.0077
.0187	.0216	.0246	.0276
.0407	.0442	.0478	.0515
.0677	.0722	.0768	.0816
.1031	.1091	.1156	.1215
.1819	.2322	.3044	.4029
1.1540	1.3860	1.4831	1.5651
1.8222	1.8752	1.9249	1.9717
2.1343	2.1697	2.2033	2.2352
2.2866	2.2929	2.2990	2.3049
2.3263	2.3312	2.3359	2.3406
2.3580	2.3620	2.3660	2.3699
2.3848	2.3883	2.3917	2.3951
2.4082	2.4113	2.4144	2.4174
2.4291	2.4319	2.4347	2.4374
2.4481	2.4506	2.4532	2.4557
2.4655	2.4679	2.4702	2.4726
2.4817	2.4839	2.4861	2.4883
2.4968	2.4989	2.5009	2.5030
2.5110	2.5129	2.5149	2.5168
2.5244	2.5263	2.5281	2.5299
2.5371	2.5389	2.5407	2.5424
2.5493	2.5510	2.5526	2.5543
2.5609	2.5625	2.5641	2.5657
2.5720	2.5735	2.5750	2.5766
2.5826	2.5841	2.5856	2.5871
			2.5885
			2.5900

*

*S BASIN 1-C

COMPUTE NM HYD ID= 1 HYD NO= 1.C DA=0.01516 SQ MI
 PER A= 0.00 B= 6 C= 0 D= 94
 TP= -0.13333 HRS RAIN= -1

K = .072665HR TP = .133330HR K/TP RATIO = .545000 SHAPE CONSTANT, N = 7.106420
 UNIT PEAK = 56.249 CFS UNIT VOLUME = .9992 B = 526.28 P60 = 2.1500
 AREA = .014250 SQ MI IA = .10000 INCHES INF = .04000 INCHES PER HOUR
 RUNOFF COMPUTED BY INITIAL ABSTRACTION/INFILTRATION NUMBER METHOD - DT = .033333

K = .133807HR TP = .133330HR K/TP RATIO = 1.003575 SHAPE CONSTANT, N = 3.517606
 UNIT PEAK = 2.1941 CFS UNIT VOLUME = .9942 B = 321.61 P60 = 2.1500
 AREA = .000910 SQ MI IA = .50000 INCHES INF = 1.25000 INCHES PER HOUR
 RUNOFF COMPUTED BY INITIAL ABSTRACTION/INFILTRATION NUMBER METHOD - DT = .033333

PRINT HYD

ID= 1 CODE= 1

HYDROGRAPH FROM AREA 1.C

RUNOFF VOLUME = 2.26177 INCHES = 1.8287 ACRE-FEET
PEAK DISCHARGE RATE = 47.49 CFS AT 1.500 HOURS BASIN AREA = .0152 SQ. MI.

* PLOT HYD

ID= 1

*

*S NEXT SPLIT 1-C SO 55% BYPASSES INLETS TO MONTGOMERY SD & ENTERS SVC @ ID=3

DIVIDE HYD ID_IN= 1 PER= -45 ID_OUT_A= 2 HYD_OUT_A= 302

ID_OUT_B= 3 HYD_OUT_B= 303

*

*S NEXT DELAY HYD TO SIMULATE ROUTING IN STREET

MODIFY TIME ID= 3 TIME= 0.033333 HR CODE= -1

*

*S BASIN 2-1

COMPUTE NM HYD ID= 1 HYD NO= 2.1 DA= 0.02609 SQ MI

PER A= 0.00 B= 15 C= 0 D= 85

TP= -0.13333 HRS RAIN= -1

K = .072665HR TP = .133330HR K/TP RATIO = .545000 SHAPE CONSTANT, N = 7.106420

UNIT PEAK = 87.534 CFS UNIT VOLUME = .9992 B = 526.28 P60 = 2.1500

AREA = .022177 SQ MI IA = .10000 INCHES INF = .04000 INCHES PER HOUR

RUNOFF COMPUTED BY INITIAL ABSTRACTION/INFILTRATION NUMBER METHOD - DT = .033333

K = .133807HR TP = .133330HR K/TP RATIO = 1.003575 SHAPE CONSTANT, N = 3.517606

UNIT PEAK = 9.4399 CFS UNIT VOLUME = .9988 B = 321.61 P60 = 2.1500

AREA = .003914 SQ MI IA = .50000 INCHES INF = 1.25000 INCHES PER HOUR

RUNOFF COMPUTED BY INITIAL ABSTRACTION/INFILTRATION NUMBER METHOD - DT = .033333

PRINT HYD

ID= 1 CODE= 1

OUTFLOW HYDROGRAPH REACH 2.10

RUNOFF VOLUME = 2.13351 INCHES = 2.9687 ACRE-FEET

PEAK DISCHARGE RATE = 78.04 CFS AT 1.500 HOURS BASIN AREA = .0261 SQ. MI.

* PLOT HYD

ID= 1

*

*S NEXT = COMBINED INFLOW TO SVC AT UPPER END

ADD HYD ID_OUT= 2 HYD_OUT= 201 ID_IN_I= 1 ID_IN_II= 3

PRINT HYD ID= 2 CODE= 1

PARTIAL HYDROGRAPH 201.00

RUNOFF VOLUME = 2.16456 INCHES = 3.9744 ACRE-FEET

PEAK DISCHARGE RATE = 102.00 CFS AT 1.500 HOURS BASIN AREA = .0344 SQ. MI.

50

* PLOT HYD ID= 2

*

*S RES ROUTE SHORT (42.7') UPPER SVC

ROUTE RESERVOIR ID= 5 HYD= 305 INFLOW ID= 2 CODE= 5.
 OUTFLOW CFS STORAGE AC-FT ELEVATION FT
 0.00000 0.0945 46.1
 16.38 0.1051 46.5
 64.75 0.1240 47.1
 183.14 0.1463 48.1
 336.45 0.1723 49.1

* * * * *

TIME (HRS)	INFLOW (CFS)	ELEV (FEET)	VOLUME (AC-FT)	OUTFLOW (CFS)
.00	.00	46.10	.095	.00
.17	.00	46.10	.095	.00
.33	.00	46.10	.095	.00
.50	.00	46.10	.095	.00
.67	.00	46.10	.095	.00
.83	.00	46.10	.095	.00
1.00	.33	46.11	.095	.25
1.17	2.59	46.16	.096	2.46
1.33	28.44	46.64	.109	27.29
1.50	102.00	47.41	.131	101.20
1.67	55.11	47.00	.121	56.71
1.83	34.86	46.73	.112	35.19
2.00	25.27	46.61	.109	25.49
2.17	12.32	46.42	.103	13.12
2.33	5.78	46.24	.098	5.92
2.50	3.70	46.19	.097	3.78
2.67	2.57	46.16	.096	2.61
2.83	1.92	46.15	.096	1.95
3.00	1.50	46.14	.095	1.52
3.17	1.24	46.13	.095	1.25
3.33	1.07	46.13	.095	1.08
3.50	.97	46.12	.095	.97
3.67	.90	46.12	.095	.90
3.83	.84	46.12	.095	.84
4.00	.80	46.12	.095	.81
4.17	.78	46.12	.095	.78
4.33	.76	46.12	.095	.76
4.50	.75	46.12	.095	.75
4.67	.74	46.12	.095	.74
4.83	.75	46.12	.095	.75
5.00	.75	46.12	.095	.75
5.17	.76	46.12	.095	.76
5.33	.76	46.12	.095	.76
5.50	.78	46.12	.095	.78
5.67	.79	46.12	.095	.79
5.83	.81	46.12	.095	.81
6.00	.83	46.12	.095	.83
6.17	.37	46.11	.095	.40
6.33	.10	46.10	.095	.10
6.50	.04	46.10	.095	.05
6.67	.02	46.10	.095	.02
6.83	.01	46.10	.095	.01

7.00 .00 46.10 .095 .00
 PEAK DISCHARGE = 101.310 CFS - PEAK OCCURS AT HOUR 1.53
 MAXIMUM WATER SURFACE ELEVATION = 47.409
 MAXIMUM STORAGE = .1309 AC-FT INCREMENTAL TIME= .033333HRS

*S RES ROUTE LONG (381') UPPER SVC

ROUTE RESERVOIR ID= 6 HYD= 306 INFLOW ID= 5 CODE= 5.
 OUTFLOW CFS STORAGE AC-FT ELEVATION FT
 0.00000 0.4053 44.2
 16.38 0.4692 44.6
 64.75 0.5663 45.2
 183.14 0.7281 46.2
 336.45 0.8899 47.2

* * * * *

TIME (HRS)	INFLOW (CFS)	ELEV (FEET)	VOLUME (AC-FT)	OUTFLOW (CFS)
.00	.00	44.20	.405	.00
.17	.00	44.20	.405	.00
.33	.00	44.20	.405	.00
.50	.00	44.20	.405	.00
.67	.00	44.20	.405	.00
.83	.00	44.20	.405	.00
1.00	.25	44.20	.406	.09
1.17	2.46	44.25	.413	1.87
1.33	27.29	44.60	.470	16.60
1.50	101.20	45.46	.609	95.87
1.67	56.71	45.16	.560	61.36
1.83	35.19	44.86	.511	37.23
2.00	25.49	44.73	.490	26.68
2.17	13.12	44.58	.466	15.67
2.33	5.92	44.38	.434	7.24
2.50	3.78	44.31	.422	4.32
2.67	2.61	44.27	.417	2.91
2.83	1.95	44.25	.414	2.11
3.00	1.52	44.24	.412	1.63
3.17	1.25	44.23	.410	1.32
3.33	1.08	44.23	.410	1.12
3.50	.97	44.22	.409	1.00
3.67	.90	44.22	.409	.92
3.83	.84	44.22	.409	.86
4.00	.81	44.22	.408	.82
4.17	.78	44.22	.408	.79
4.33	.76	44.22	.408	.77
4.50	.75	44.22	.408	.75
4.67	.74	44.22	.408	.75
4.83	.75	44.22	.408	.75
5.00	.75	44.22	.408	.75
5.17	.76	44.22	.408	.75
5.33	.76	44.22	.408	.76
5.50	.78	44.22	.408	.78
5.67	.79	44.22	.408	.79
5.83	.81	44.22	.408	.80
6.00	.83	44.22	.409	.82
6.17	.40	44.21	.408	.59
6.33	.10	44.20	.406	.15
6.50	.05	44.20	.406	.06
6.67	.02	44.20	.405	.03

6.83	.01	44.20	.405	.01
7.00	.00	44.20	.405	.01
7.17	.00	44.20	.405	.00

PEAK DISCHARGE = 101.275 CFS - PEAK OCCURS AT HOUR 1.53
 MAXIMUM WATER SURFACE ELEVATION = 45.509
 MAXIMUM STORAGE = .6162 AC-FT INCREMENTAL TIME= .033333HRS

*
 *S NEXT DELAY HYD TO SIMULATE ROUTING IN CHANNEL
 *S TIME LAG SHOULD BE APX = VOL_{peak}/Q_{peak}
 * MODIFY TIME ID= 6 TIME= 0.HR CODE= -1
 MODIFY TIME ID= 6 TIME= 0.074 HR CODE= -1

*S BASIN 2-2
 COMPUTE NM HYD ID= 1 HYD NO= 2.2 DA= 0.01687 SQ MI
 PER A= 0.00 B= 17.3 C= 0 D= 82.7
 TP= -0.13333 HRS RAIN= -1

K = .072665HR TP = .133330HR K/TP RATIO = .545000 SHAPE CONSTANT, N = 7.106420
 UNIT PEAK = 55.069 CFS UNIT VOLUME = .9992 B = 526.28 P60 = 2.1500
 AREA = .013951 SQ MI IA = .10000 INCHES INF = .04000 INCHES PER HOUR
 RUNOFF COMPUTED BY INITIAL ABSTRACTION/INFILTRATION NUMBER METHOD - DT = .033333

K = .133807HR TP = .133330HR K/TP RATIO = 1.003575 SHAPE CONSTANT, N = 3.517606
 UNIT PEAK = 7.0399 CFS UNIT VOLUME = .9984 B = 321.61 P60 = 2.1500
 AREA = .002919 SQ MI IA = .50000 INCHES INF = 1.25000 INCHES PER HOUR
 RUNOFF COMPUTED BY INITIAL ABSTRACTION/INFILTRATION NUMBER METHOD - DT = .033333

PRINT HYD ID= 1 CODE= 1

OUTFLOW HYDROGRAPH REACH 2.20

RUNOFF VOLUME = 2.10073 INCHES = 1.8901 ACRE-FEET
 PEAK DISCHARGE RATE = 49.86 CFS AT 1.500 HOURS BASIN AREA = .0169 SQ. MI.

* PLOT HYD ID= 1

*S NEXT = COMBINED INFLOW TO SVC ABOVE NEC TR-C W/O ROUTING
 ADD HYD ID_OUT= 2 HYD_OUT= 202 ID_IN_I= 1 ID_IN_II= 6
 PRINT HYD ID= 2 CODE= 1

PARTIAL HYDROGRAPH 202.00

RUNOFF VOLUME = 2.14356 INCHES = 5.8645 ACRE-FEET
 PEAK DISCHARGE RATE = 137.18 CFS AT 1.567 HOURS BASIN AREA = .0513 SQ. MI.

* PLOT HYD ID= 2

*S RES ROUTE LONG (+/- 457') LOWER SVC: WEIR @ NEC PARSIFAL TH (TR-C)
 ROUTE RESERVOIR ID= 4 HYD= 307 INFLOW ID= 2 CODE= 5.
 OUTFLOW CFS STORAGE AC-FT ELEVATION FT

53

0.00000	0.5163	38.6
25.6	0.5908	39.0
35.8	0.6103	39.1
101.2	0.7078	39.6
185.8	0.8053	40.1
286.1	0.9028	40.6

* * * * *

TIME (HRS)	INFLOW (CFS)	ELEV (FEET)	VOLUME (AC-FT)	OUTFLOW (CFS)
---------------	-----------------	----------------	-------------------	------------------

.00	.00	38.60	.516	.00
.17	.00	38.60	.516	.00
.33	.00	38.60	.516	.00
.50	.00	38.60	.516	.00
.67	.00	38.60	.516	.00
.83	.00	38.60	.516	.00
1.00	.19	38.60	.517	.08
1.17	2.32	38.63	.521	1.69
1.33	20.61	38.82	.558	14.24
1.50	108.66	39.57	.703	97.80
1.67	108.91	39.69	.725	115.87
1.83	60.04	39.31	.651	63.22
2.00	41.97	39.16	.622	43.50
2.17	26.73	39.03	.598	29.16
2.33	12.42	38.83	.559	14.79
2.50	6.92	38.72	.539	7.76
2.67	4.57	38.68	.531	4.98
2.83	3.28	38.65	.527	3.51
3.00	2.50	38.64	.524	2.64
3.17	2.00	38.63	.522	2.10
3.33	1.69	38.63	.521	1.75
3.50	1.49	38.62	.521	1.53
3.67	1.36	38.62	.520	1.39
3.83	1.27	38.62	.520	1.29
4.00	1.20	38.62	.520	1.21
4.17	1.16	38.62	.520	1.17
4.33	1.13	38.62	.520	1.13
4.50	1.11	38.62	.520	1.11
4.67	1.09	38.62	.519	1.10
4.83	1.09	38.62	.519	1.09
5.00	1.10	38.62	.519	1.10
5.17	1.10	38.62	.520	1.10
5.33	1.11	38.62	.520	1.11
5.50	1.13	38.62	.520	1.13
5.67	1.15	38.62	.520	1.15
5.83	1.17	38.62	.520	1.17
6.00	1.20	38.62	.520	1.19
6.17	.94	38.62	.519	1.03
6.33	.30	38.61	.518	.41
6.50	.10	38.60	.517	.13
6.67	.05	38.60	.516	.06
6.83	.02	38.60	.516	.03
7.00	.01	38.60	.516	.01
7.17	.00	38.60	.516	.00

PEAK DISCHARGE = 136.852 CFS - PEAK OCCURS AT HOUR 1.60
 MAXIMUM WATER SURFACE ELEVATION = 39.811
 MAXIMUM STORAGE = .7489 AC-FT INCREMENTAL TIME= .033333HRS

39.81 - 38.6 = 1.21
 1.2 → AVAL OVER
 WEIR → NO GOOD

54

*

*S NEXT DELAY HYD TO SIMULATE ROUTING IN CHANNEL

*S TIME LAG SHOULD BE $APX = VOL_{peak}/Q_{peak}$

* MODIFY TIME ID= 4 TIME= 0.HR CODE= -1

MODIFY TIME ID= 4 TIME= 0.066 HR CODE= -1

*S BASIN 2-3

COMPUTE NM HYD ID= 1 HYD NO= 2.3 DA= 0.01735 SQ MI
PER A= 0.00 B= 22.3 C= 0 D= 77.7
TP= -0.13333 HRS RAIN= -1

K = .072665HR TP = .133330HR K/TP RATIO = .545000 SHAPE CONSTANT, N = 7.106420
UNIT PEAK = 53.212 CFS UNIT VOLUME = .9992 B = 526.28 P60 = 2.1500
AREA = .013481 SQ MI IA = .10000 INCHES INF = .04000 INCHES PER HOUR
RUNOFF COMPUTED BY INITIAL ABSTRACTION/INFILTRATION NUMBER METHOD - DT = .033333

K = .133807HR TP = .133330HR K/TP RATIO = 1.003575 SHAPE CONSTANT, N = 3.517606
UNIT PEAK = 9.3327 CFS UNIT VOLUME = .9988 B = 321.61 P60 = 2.1500
AREA = .003869 SQ MI IA = .50000 INCHES INF = 1.25000 INCHES PER HOUR
RUNOFF COMPUTED BY INITIAL ABSTRACTION/INFILTRATION NUMBER METHOD - DT = .033333

PRINT HYD ID= 1 CODE= 1

OUTFLOW HYDROGRAPH REACH 2.30

RUNOFF VOLUME = 2.02947 INCHES = 1.8779 ACRE-FEET
PEAK DISCHARGE RATE = 49.92 CFS AT 1.500 HOURS BASIN AREA = .0174 SQ. MI.

* PLOT HYD ID= 1

*

*S COMBINED FLOW IN SVC JUST DOWN FROM WEIR IN NEC PARSIFAL TH (TR-C)

ADD HYD ID_OUT= 5 HYD_OUT= 203 ID_IN_I= 1 ID_IN_II= 4

PRINT HYD ID= 5 CODE= 1

PARTIAL HYDROGRAPH 203.00

RUNOFF VOLUME = 2.11472 INCHES = 7.7424 ACRE-FEET
PEAK DISCHARGE RATE = 162.95 CFS AT 1.633 HOURS BASIN AREA = .0686 SQ. MI.

* PLOT HYD ID= 5

*

*S RES ROUTE 1ST LOW WEIR W OF NEC PARSIFAL TownHomes (TR-C)

ROUTE RESERVOIR ID= 6 HYD= 308 INFLOW ID= 5 CODE= 5.

OUTFLOW CFS	STORAGE AC-FT	ELEVATION FT
0.00000	0.0120	34.52
10.44	0.0187	34.74
25.59	0.0249	34.92
101.15	0.0455	35.52
286.10	0.0798	36.52
525.29	0.1140	37.52

* * * * *

SS

TIME (HRS)	INFLOW (CFS)	ELEV (FEET)	VOLUME (AC-FT)	OUTFLOW (CFS)
---------------	-----------------	----------------	-------------------	------------------

.00	.00	34.52	.012	.00
.17	.00	34.52	.012	.00
.33	.00	34.52	.012	.00
.50	.00	34.52	.012	.00
.67	.00	34.52	.012	.00
.83	.00	34.52	.012	.00
1.00	.18	34.52	.012	.14
1.17	2.01	34.56	.013	1.87
1.33	20.00	34.84	.022	18.98
1.50	104.71	35.53	.046	102.08
1.67	162.54	35.85	.057	163.01
1.83	94.18	35.47	.044	95.27
2.00	61.30	35.21	.035	61.70
2.17	40.73	35.04	.029	41.14
2.33	22.48	34.89	.024	23.04
2.50	11.42	34.75	.019	11.62
2.67	7.06	34.67	.017	7.20
2.83	4.89	34.62	.015	4.97
3.00	3.63	34.60	.014	3.68
3.17	2.85	34.58	.014	2.88
3.33	2.36	34.57	.014	2.38
3.50	2.04	34.56	.013	2.06
3.67	1.84	34.56	.013	1.85
3.83	1.70	34.56	.013	1.71
4.00	1.60	34.55	.013	1.60
4.17	1.53	34.55	.013	1.54
4.33	1.49	34.55	.013	1.49
4.50	1.46	34.55	.013	1.46
4.67	1.43	34.55	.013	1.43
4.83	1.43	34.55	.013	1.43
5.00	1.43	34.55	.013	1.43
5.17	1.44	34.55	.013	1.44
5.33	1.45	34.55	.013	1.45
5.50	1.47	34.55	.013	1.47
5.67	1.50	34.55	.013	1.49
5.83	1.52	34.55	.013	1.52
6.00	1.55	34.55	.013	1.55
6.17	1.32	34.55	.013	1.34
6.33	.71	34.54	.012	.75
6.50	.21	34.52	.012	.22
6.67	.09	34.52	.012	.09
6.83	.04	34.52	.012	.04
7.00	.02	34.52	.012	.02
7.17	.01	34.52	.012	.01
7.33	.00	34.52	.012	.00

PEAK DISCHARGE = 163.012 CFS - PEAK OCCURS AT HOUR 1.67
 MAXIMUM WATER SURFACE ELEVATION = 35.854
 MAXIMUM STORAGE = .0570 AC-FT INCREMENTAL TIME= .033333HRS

*

*S RES ROUTE 2nd (ALSO=LAST) LOW WEIR W OF NEC PARSIPAL TownHomes (TR-C)
 ROUTE RESERVOIR ID= 7 HYD= 309 INFLOW ID= 6 CODE= 5.
 OUTFLOW CFS STORAGE AC-FT ELEVATION FT
 0.00000 0.0116 32.53
 35.76 0.0311 33.03
 101.15 0.0575 33.53

56

286.10	0.1102	34.53
525.29	0.1630	35.53

* * * * *

TIME (HRS)	INFLOW (CFS)	ELEV (FEET)	VOLUME (AC-FT)	OUTFLOW (CFS)
---------------	-----------------	----------------	-------------------	------------------

.00	.00	32.53	.012	.00
.17	.00	32.53	.012	.00
.33	.00	32.53	.012	.00
.50	.00	32.53	.012	.00
.67	.00	32.53	.012	.00
.83	.00	32.53	.012	.00
1.00	.14	32.53	.012	.12
1.17	1.87	32.55	.013	1.76
1.33	18.98	32.77	.021	17.50
1.50	102.08	33.51	.056	98.46
1.67	163.01	33.86	.075	163.10
1.83	95.27	33.50	.056	96.76
2.00	61.70	33.23	.042	62.36
2.17	41.14	33.08	.034	41.74
2.33	23.04	32.86	.024	23.61
2.50	11.62	32.70	.018	11.92
2.67	7.20	32.63	.016	7.33
2.83	4.97	32.60	.014	5.03
3.00	3.68	32.58	.014	3.72
3.17	2.88	32.57	.013	2.90
3.33	2.38	32.56	.013	2.39
3.50	2.06	32.56	.013	2.07
3.67	1.85	32.56	.013	1.86
3.83	1.71	32.55	.013	1.71
4.00	1.60	32.55	.012	1.61
4.17	1.54	32.55	.012	1.54
4.33	1.49	32.55	.012	1.49
4.50	1.46	32.55	.012	1.46
4.67	1.43	32.55	.012	1.44
4.83	1.43	32.55	.012	1.43
5.00	1.43	32.55	.012	1.43
5.17	1.44	32.55	.012	1.44
5.33	1.45	32.55	.012	1.45
5.50	1.47	32.55	.012	1.47
5.67	1.49	32.55	.012	1.49
5.83	1.52	32.55	.012	1.52
6.00	1.55	32.55	.012	1.55
6.17	1.34	32.55	.012	1.36
6.33	.75	32.54	.012	.78
6.50	.22	32.53	.012	.24
6.67	.09	32.53	.012	.09
6.83	.04	32.53	.012	.04
7.00	.02	32.53	.012	.02
7.17	.01	32.53	.012	.01
7.33	.00	32.53	.012	.00

PEAK DISCHARGE = 163.103 CFS - PEAK OCCURS AT HOUR 1.67
 MAXIMUM WATER SURFACE ELEVATION = 33.865
 MAXIMUM STORAGE = .0752 AC-FT INCREMENTAL TIME= .033333HRS

*
FINISH

57

SIERRA ULTA CHANNEL HYDROLOGY

INDIVIDUAL BASINS - FROM SVCXZ HYMO

BASIN

1-C CONTRIBUTING

2.1

Q_P

26.12

79.04

 $\Sigma = 104.16$

1-C CONTRIB, LAGGED

ADDED TO 2.1

2.2

2.3

102.00

49.86

49.92

201.78 ~ 202 CFS

$$\Sigma - \text{ROUTED OUT} = 201.78 - 163.10 = 38.68 = \Delta$$

$$\frac{38.68}{201.78} = 0.192 \sim 19\% \quad \frac{38.68}{163.10} = .237 \sim 24\%$$

SIERRA ULSTA
CHANNEL

HYDRAULICS

PARSIFAL

8-26-96

SIERRA VISTA CHANNEL

HYDRAULICS UPSTREAM OF 4'($\pm$) WEIR NE CORNER

FROM ATMMO SVCX2.OUT

$$Q_{peak} = 137.18 \sim 137 \text{ CFS}$$

FROM WEIR EQN $C = 3.5$ $L = 28.9$

$$Q = C L y^{3/2}$$

$$y = \left(\frac{Q}{C L} \right)^{2/3} = \left(\frac{137.2}{(3.5)(28.9)} \right)^{2/3} = 1.225 \sim 1.23'$$

FROM ATMMO SVCX2.OUT

$$\text{MAX STORAGE} = .7489 \text{ AC FT}$$

$$= 32,622 \text{ CF}$$

$$\text{AREA AVG} = A_{\text{AVG}} = \text{VOL} / \text{LENGTH}$$

$$L = (6+50) - (2+54) = 396'$$

$$A_{\text{AVG}} = 32622 / 396 = 82.38 \text{ SF}$$

$$y_{\text{avg}} = A_{\text{avg}} / W = 82.38 / 18.5 = 4.453 \sim 4.45'$$

$$P_{\text{avg}} = 2 y_{\text{avg}} + W = 8.9 + 18.5 = 27.4$$

$$R = A / P = 82.38 / 27.4 = 3.006 \sim 3.01$$

$$V_{\text{avg}} = Q / A_{\text{avg}} = 132.2 / 82.38 = 1.6047 \sim 1.60 \text{ FPS}$$

$$V_{\text{obs}} = \frac{1.49}{n} (R^{2/3}) \sqrt{S_f} \quad \begin{array}{l} S_f = \text{friction (water surface) slope} \\ n = \text{friction factor} = 0.013 \end{array}$$

$$S_f = \left[\frac{n \cdot V}{1.49 R^{2/3}} \right]^2 = \left[\frac{(0.013)(1.60)}{(1.49)(3.01)^{2/3}} \right]^2 = 0.0000448$$

$$\approx .0045\%$$

$$L \cdot S_f \text{ to SE corner} \approx 0.000045 \times 198.75 = 0.0089 \sim 0.01\%$$

$$\text{to E R} \approx " \times 263.16 = 0.0119 \sim 0.01'$$

$$H_v = V^2 / 2g = (1.6)^2 / (2 \cdot 32.2) = 0.040$$

Super elev - subcrit, rectangular channel

assume $b/r = 1$ at corner DPM 22.3 p 58

$$S = \frac{V^2}{2g} \cdot \frac{b}{r} = 0.04'$$

$$L \times S_f + \text{Super} = .01 + .04 = .05'$$

PARSIFAL

8/26/96

TOP OF NEW WALL JUST WEST OF SIERRA
USTA CHANNEL

THICK + DEPTH + L + Sf + Super + Freeboard

$$38.19 + 1.23 + .01 + .04 + 2 = 41.47$$

WEIRS IN SUC ALONG N R

$Q_p = 163$ CFS SUC X 2, AFTER ADD'L
IN FLOW FROM SIERRA USTA
STOPPING CENTER

$$L = 28.9 \text{ FT} \quad C = 3.5$$

$$Q = C L H^{3/2} \quad \text{or} \quad H = \left(\frac{Q}{C L} \right)^{2/3}$$

$$H = \left[\frac{163}{(3.5)(28.9)} \right]^{2/3} = 1.374 \sim 1.37 \sim 1.4 \text{ FT}$$

PARSIFAL - SIERRA USTA CHAN RESULTS 5/20/96
OUT FLOW VIA PIPE & WEIR @ TRASH RACK *
 $Q_p = 169 \text{ CFS}$

$$30.96 - 24.79 = 6.17 - \text{WEIR ELEV}$$

$$31.52 - 24.79 = 6.73 - \text{T WALL SOUTH SIDE}$$

$$\text{ASSUME WEIR} = 28.9 - 6/2 = 25.9' \text{ WIDE}$$

$$\text{WEIR COEFF} \approx 2.86, \text{ KING, 6TH, TABLE 5-6 } \frac{Q}{L H^{3/2}}$$

OUTLET PIPE 53" x 34" , SQUARED EDGE ENT
HEC 10 CHART 15 - EXTEND

$$@ y = 6.73' \quad Q \approx 110 \text{ CFS}$$

$$Q_{\text{WEIR}} = 169 - 110 = 59 \text{ CFS}$$

$$Q = CL H^{3/2} = 2.86 \times 25.9 H^{3/2} = 74.074 H^{3/2}$$

$$H = (Q / 74.074)^{2/3}$$

$$= (59 / 74.074)^{2/3}$$

$$= 0.86 > 6.73 - 6.17 = 0.56$$

$$\text{TRY } y = 7.0 \Rightarrow h = .56 + 27 = .83$$

$$Q_{\text{PIPE}} \approx 112$$

$$169 - 112 = 57$$

$$H \approx (57 / 74.074)^{2/3} = 0.84 \approx .83$$

$$\Rightarrow y \approx 7.01 \text{ above invert} = 24.79 + \underline{\underline{7.01}} = \underline{\underline{31.80}}$$

$$Q_{\text{PIPE}} \approx 112$$

$$Q_{\text{WEIR}} \approx 57$$

$$169$$

* ASSUMES ENOUGH DROP IN PIPE, & LOW ENOUGH
WGL IN MANHOLE - SO THAT GET INLET CONTROL,
BACK WATER IN MANHOLE WOULD REDUCE
Q PIPE & INCREASE Q WEIR

NOTE: CALCS THIS PAGE BASED
ON $Q = 169 \text{ CFS}$ FROM AHHMO RUN
SUC PROZ. SUC PROZ NOT USED IN
AUG 96 SUBMITAL. ACTUAL Q IS
 163 CFS FROM SUCXZ, RESULTS
WOULD BE SIMILAR.



Capacity Charts for the Hydraulic Design of Highway Culverts

Hydraulic Engineering Circular No. 10

March 1978*

Prepared by the Hydraulics Branch, Bridge Division, Office of Engineering,
Federal Highway Administration, Washington, D.C. 20590

CONTENTS

Section	Page
I Introduction	10-1
II Description of Capacity Charts	
A. Scope of Charts	10-2
B. Composition of Charts	10-2
C. Reading of Charts	10-3
	10-4
III Requirements and Limitations for Use of Charts	10-7
IV Special Uses of Capacity Charts	10-9
V Design Considerations	10-14
A. Magnitude and Frequency of Floods	10-15
B. Design Floods	10-15
C. Allowable Headwater	10-16
D. Other Factors	10-17
VI Design Data	10-18
A. Hydrologic Data	10-18
B. Topographic and Other Site Data	10-18
C. Stream Channel Calculations	10-19
D. Design Data Tabulation	10-20
E. Multiple Barrel Culverts	10-21
VII Culvert Capacity Charts	10-22
VIII Appendix	
A. Hydraulic Principles and Compilation of Charts	10-75
B. Accuracy of Chart Solutions	10-82
C. Chart Listing	10-90



*Reprint of March 1965 publication

U. S. DEPARTMENT OF TRANSPORTATION
FEDERAL HIGHWAY ADMINISTRATION

CHART 15

#8 @ 95 CFS @ HW = 5.4' ←
~105 @ 6.15'

7.0
6.5

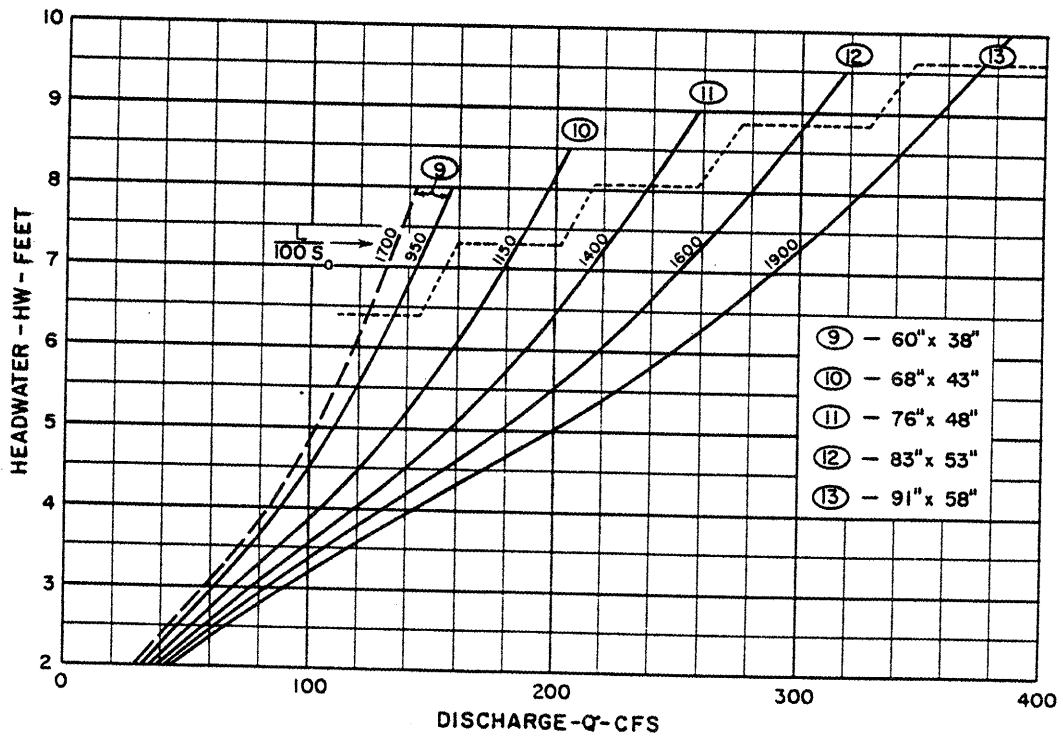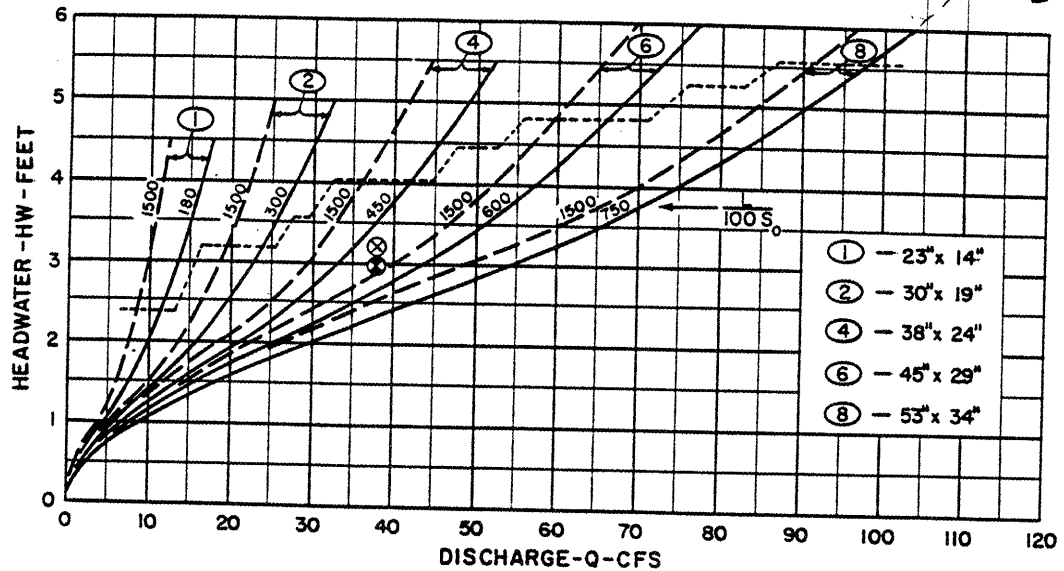

EXAMPLE

- ⊗ GIVEN:
38 CFS; AHW = 3.2 FT.
L = 66 FT.; $S_0 = 0.0015$
- ⊗ SELECT NO. 5, 42" x 27"
HW = 3.0 FT.

CULVERT CAPACITY OVAL CONCRETE PIPE - HORIZONTAL SQUARE-EDGED ENTRANCE 23" X 14" TO 91" X 58" ○

BUREAU OF PUBLIC ROADS JAN. 1963

HEC #10
FHWA 1978

10-43

60

SVC SPILLWAY TO PARSIFAL ST:57 CFS @ BS
Worksheet for Irregular Channel

Project Description	
Project File	c:\haestad\fmw\par1.fm2
Worksheet	warped spillway, svc to parsifal st.
Flow Element	Irregular Channel
Method	Manning's Formula
Solve For	Water Elevation

Input Data		MAX SLOPE THIS PROGRAM = 0.1 FT/FT		
Channel Slope	0.100000 ft/ft	— ACTUAL SLOPE ~ 0.123 FT/FT		
Elevation range: 26.43 ft to 28.39 ft.				
Station (ft)	Elevation (ft)	Start Station	End Station	Roughness
0.00	28.00	0.00	28.90	0.025
0.01	26.43			↑ BRICK PATTERN "ROMANITE" CONCRETE
18.90	26.72			
28.90	28.39			
Discharge	57.00	cfs		

Results		
Wtd. Mannings Coefficient	0.025	
Water Surface Elevation	26.91	ft
Flow Area	6.52	ft ²
Wetted Perimeter	20.56	ft
Top Width	20.06	ft
Height	0.48	ft
Critical Depth	27.22	ft
Critical Slope	0.011383	ft/ft
Velocity	8.74	ft/s
Velocity Head	1.19	ft
Specific Energy	28.10	ft
Froude Number	2.70	
Flow is supercritical.		


65




SVC SPILLWAY TO PARSIFAL ST: 57 CFS @ B.S.W.
Cross Section for Irregular Channel

Project Description	
Project File	c:\haestad\fmw\par1.fm2
Worksheet	warped spillway, svc to parsifal st.
Flow Element	Irregular Channel
Method	Manning's Formula
Solve For	Water Elevation

Section Data	
Wtd. Mannings Coefficient	0.025
Channel Slope	0.100000 ft/ft
Water Surface Elevation	26.91 ft
Discharge	57.00 cfs

ROMANISE BRICK PATTERNED CONCRETE
ACTUAL SLOPE ~ 0.123: THIS PROGRAM WON'T TAKE STEEPER THAN 0.10 FT/FT

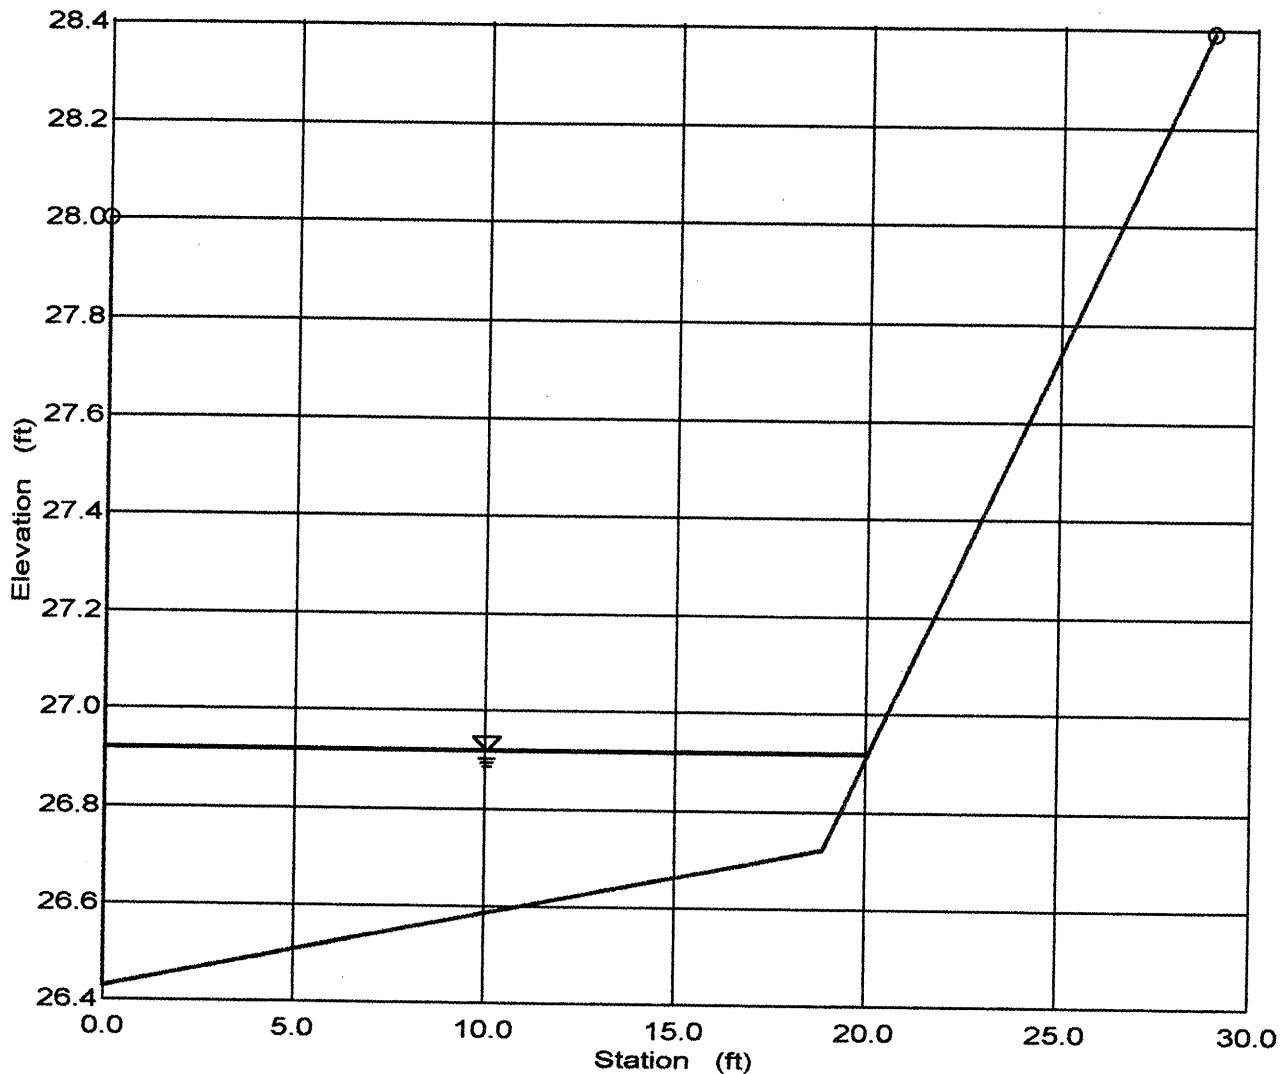

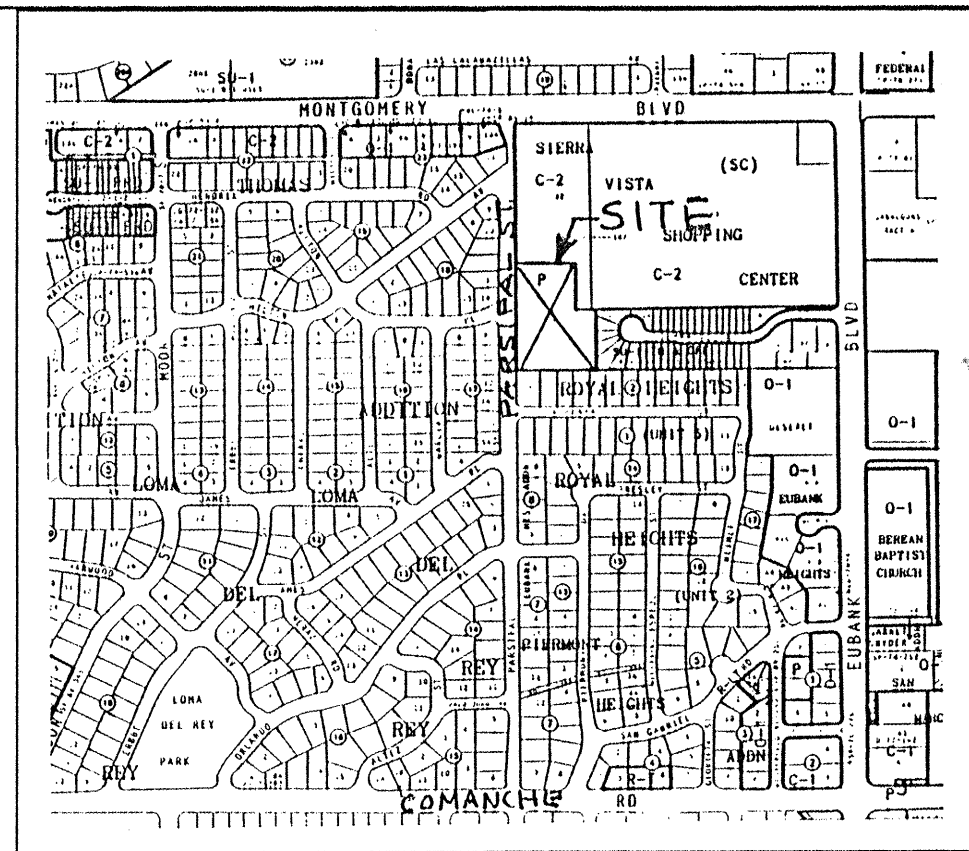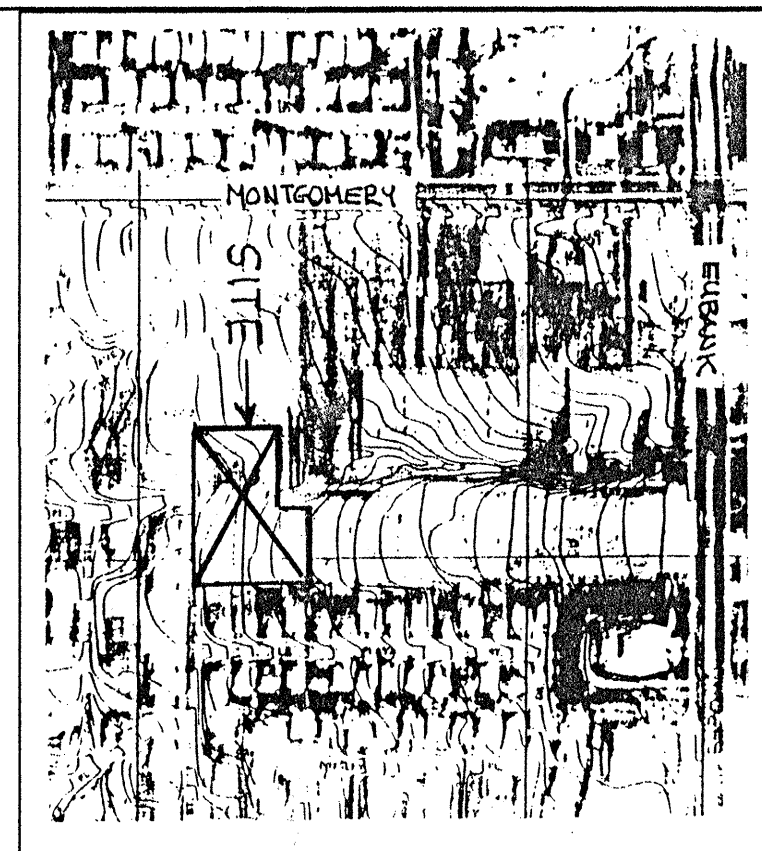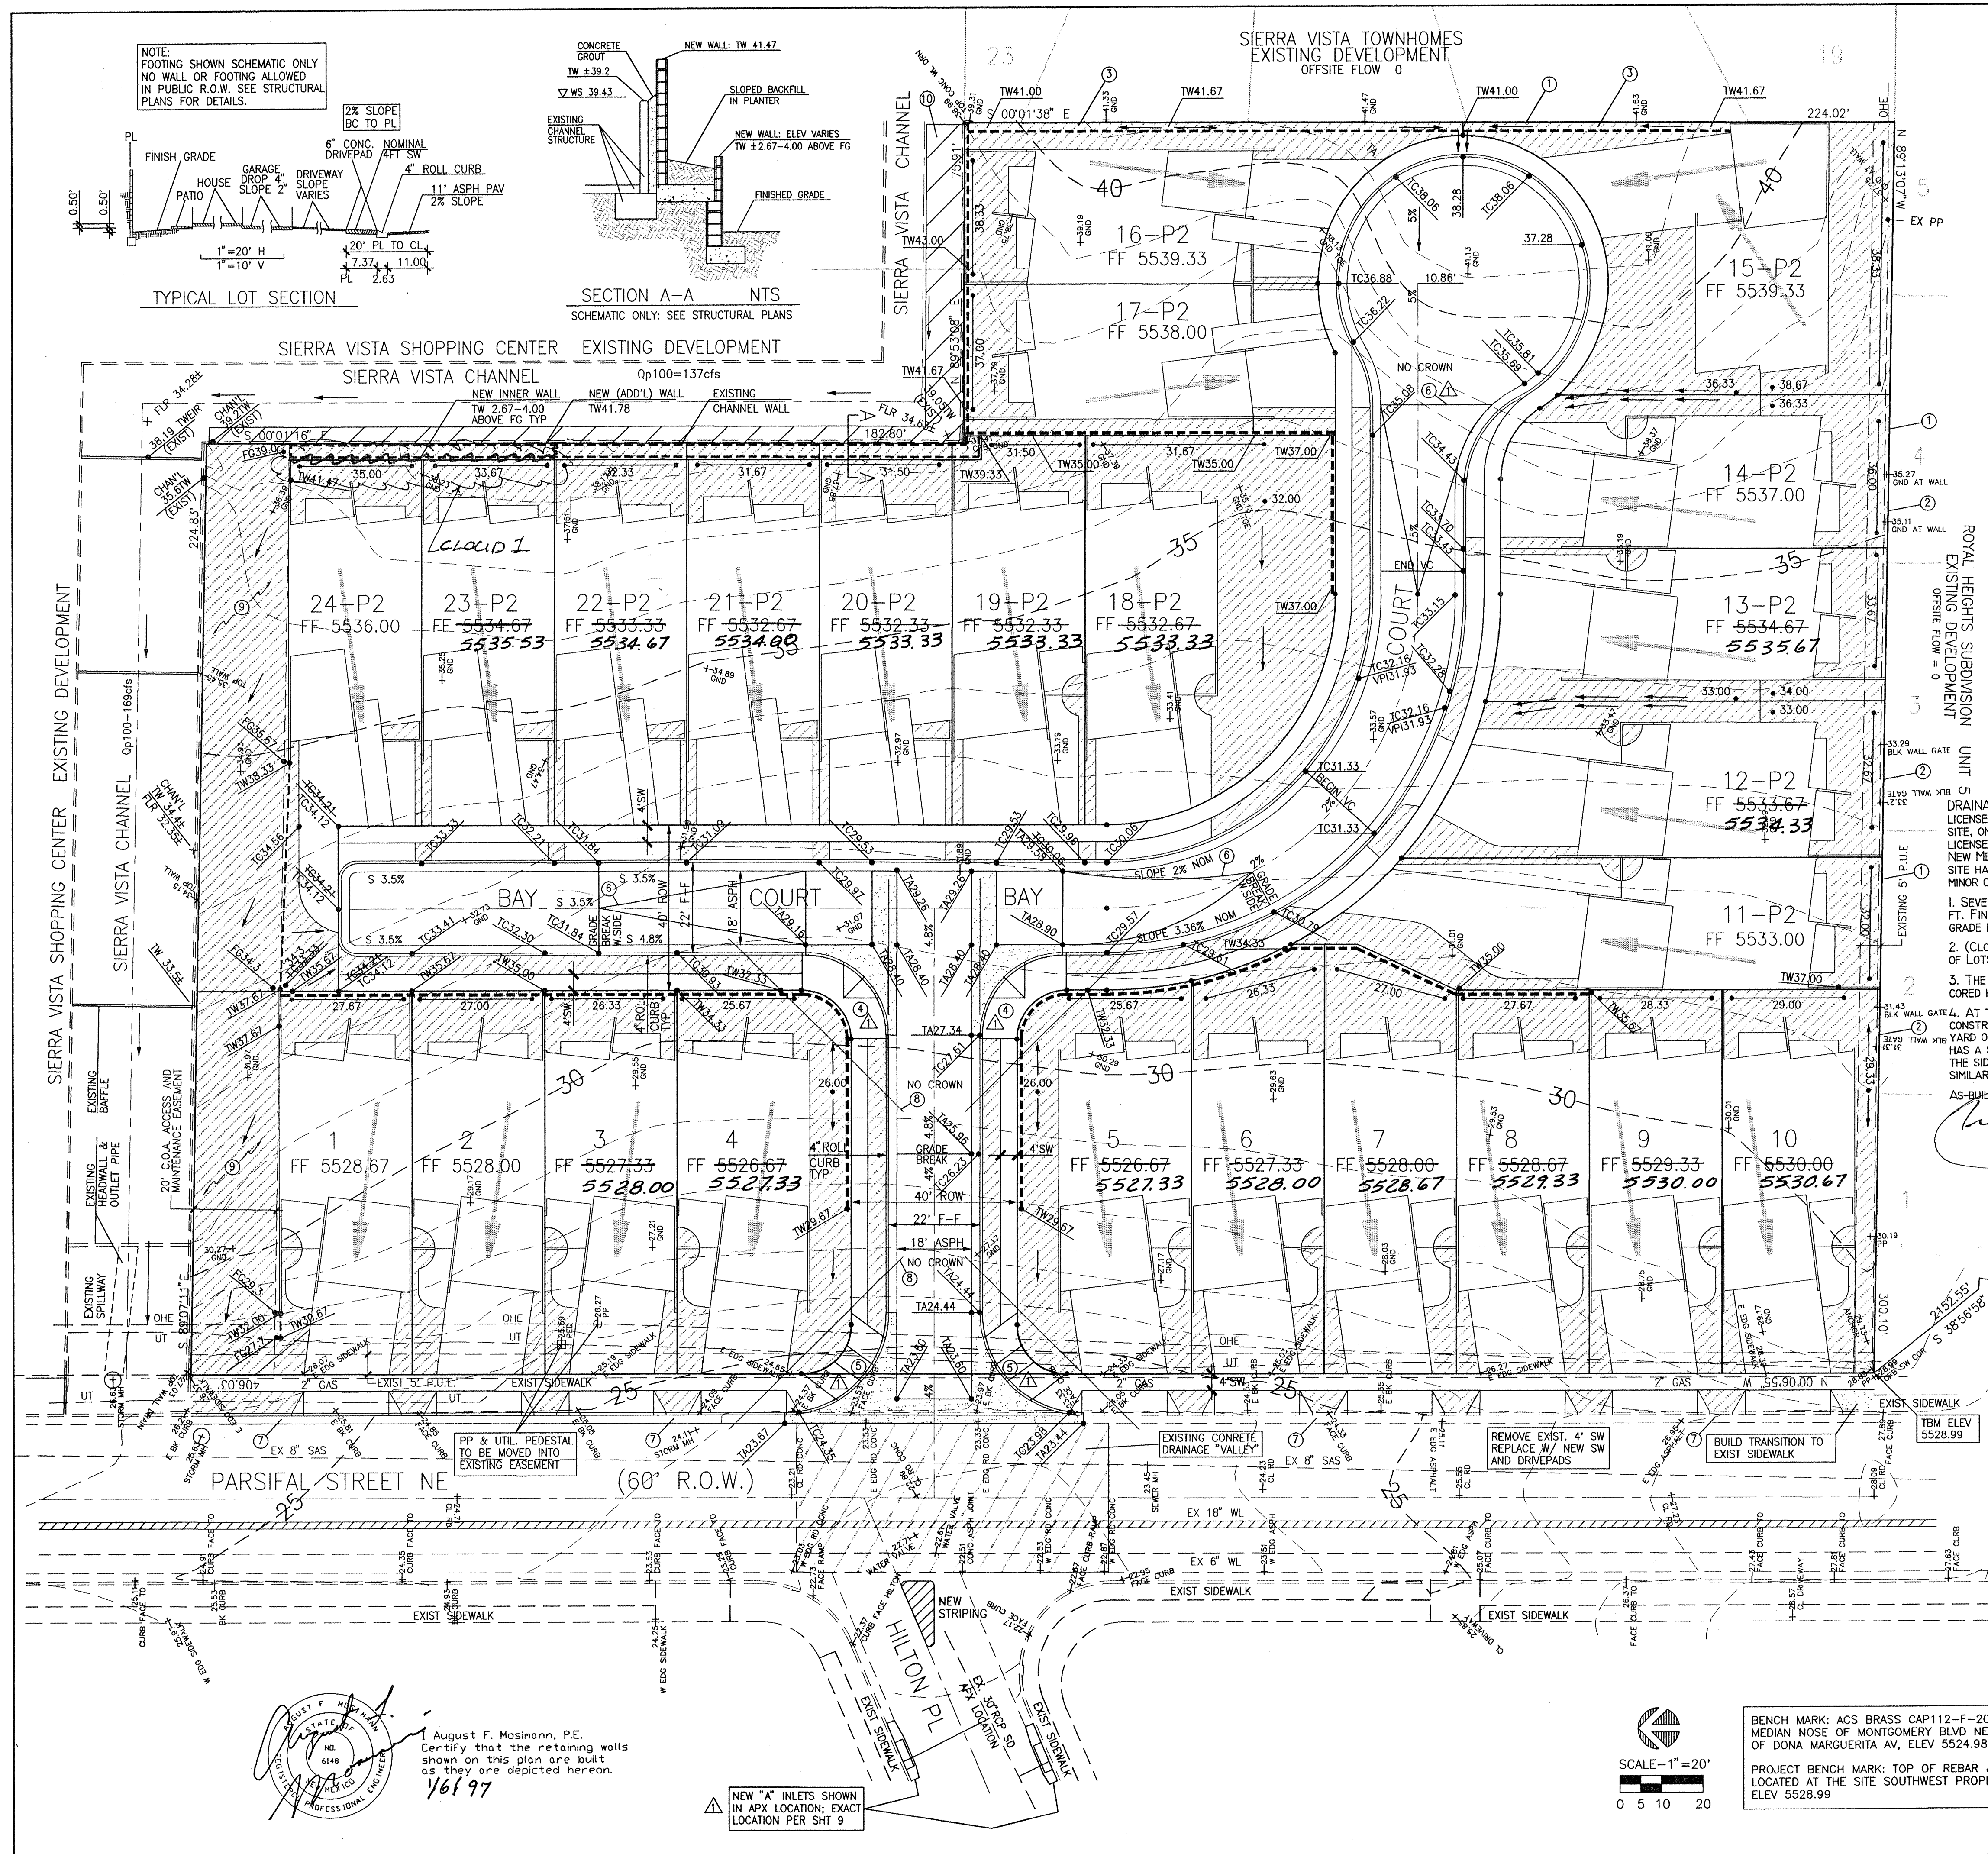

- KEYED NOTES**
- EXISTING CMU AND CONCRETE WALLS ALONG EAST & SOUTH PROPERTY LINES. OBTAIN PERMISSION TO CLOSE OPENINGS (SOUTH WALL ONLY) AND REFACE WALLS, OR CONSTRUCT NEW WALLS ENTIRELY ON SITE.
 - ENSURE NO DRAINAGE FROM PROJECT TO ADJACENT PROPERTY
 - FG BEHIND NEW WALL 3" MINIMUM BELOW TOP OF WALL. SLOPE FG BEHIND WALL TO DRAIN AS SHOWN.
 - EXPERIMENTAL COA HC ACCESS PER DTL SHT 6
 - HC ACCESS RAMP PER DWG 2440 WITH TRANSITION TO 8" STD C&G IN HC ACCESS PER DWG 2418
 - TRANSITION CROWN TO NO CROWN
 - STD 8" CURB & GUTTER. REMOVE & REPLACE AS NEEDED.
 - CLEAR SIGHT TRIANGLE
 - NO TREES, SHRUBS, OR OTHER OBSTRUCTIONS THAT WOULD INTERFERE WITH DESIGNATED USE TO BE PLANTED OR INSTALLED IN EASEMENT.
 - SEE PLAT FOR REFERENCE TO CITY-OWNED "EXCEPTION".

- GENERAL NOTES**
- An excavation/construction permit will be required before beginning any work within City of Albuquerque right-of-way. An approved copy of these plans must be submitted at the time of application for this permit.
 - The Contractor shall obtain a Topsoil Disturbance Permit prior to beginning construction.
 - All work detailed on these plans to be performed, except as otherwise stated or provided herein, shall be constructed in accordance with the City of Albuquerque Standard Specifications for Public Works Construction, 1986 edition, through Update 6.
 - All construction within City Right-of-Way or Easements must be done from approved Work Order documents from the City.
 - Two working days prior to any excavation, contractor must contact Line Locating Service (260-1990) for location of existing utilities.
 - Prior to construction, the Contractor shall become familiar with the plans, shall excavate and verify the horizontal and vertical locations of all obstructions, and shall verify all slopes and flowline elevations. In the case of a conflict or apparent omission or oddity the Contractor shall consult with the Engineer immediately, before final layout or construction.
 - Backfill compaction in the City right of way shall be according to the appropriate class of street or road. Backfill in parking lots and driveways shall be as for residential streets unless noted otherwise.
 - The Contractor shall be responsible for determining, prior to construction, whether overhead or underground utilities (and/or their structures) are obstructions to construction activities or would be harmed by such activities. If any problem is evident, the Contractor shall be responsible for coordinating with the utilities to have the utility supported, protected, or removed. The Contractor shall be responsible for any cost involved. Underground utility cables (such as for telephone, television, or power) shall be supported at intervals not to exceed 15'.
 - For work involving City Right-of-Way the Contractor shall submit a detailed schedule to the City Coordination Division three (3) working days prior to beginning construction, and shall obtain a Barring Permit two (2) working days prior to construction. The Contractor shall notify the Barricade Engineer (768-2551) prior to occupying an intersection. See Section 19 of the City Specifications.
 - If any utility lines, pipelines, or underground utility lines are shown on these drawings, they are shown in an approximate manner only, and such lines may exist even if they are not shown. The Engineer has undertaken no field verification of such utility lines etc. and the information on which the locations shown are based may be inaccurate, incomplete, or obsolete by the time construction occurs. The Contractor shall inform himself of the locations of such utilities etc. in or near the work before and during excavation and construction. The Contractor shall be fully responsible for any and all damage caused by his failure to locate, identify, and preserve such utilities.
 - In planning and conducting excavation and all other construction, the Contractor shall comply with all appropriate laws, rules, and regulations relating to these activities, particularly as regards to all utilities and to safety.
 - PROVIDE POSITIVE DRAINAGE AHEAD FROM ALL BUILDINGS
 - SEE ARCHITECTURAL OR STRUCTURAL PLANS FOR WALL DETAILS
 - SEE SEPARATE REPORT FOR DISCUSSION & CALCULATIONS

DRAINAGE CERTIFICATION: I, TUCKER H. GREEN, A PROFESSIONAL ENGINEER DULY LICENSED IN THE STATE OF NEW MEXICO - BASED ON MY OWN OBSERVATION OF THE SITE, ON AS-BUILT ELEVATIONS PROVIDED BY ROBERT MARTINEZ, A NEW MEXICO LICENSED SURVEYOR, AND ON WALL INSPECTION PROVIDED BY AUGUST F. MOSIMANN, A NEW MEXICO LICENSED PROFESSIONAL ENGINEER - CERTIFY THAT DRAINAGE FOR THIS SITE HAS BEEN COMPLETED IN SUBSTANTIAL COMPLIANCE WITH THE APPROVED DESIGN. MINOR CHANGES FROM THE APPROVED DESIGN ARE NOTED BELOW:

1. SEVERAL PAD ELEVATIONS HAVE BEEN CHANGED, BUT IN NO CASE BY MORE THAN 1.5 FT. FINISHED FLOOR ELEVATIONS SHOWN INCLUDE A 4-INCH ALLOWANCE ABOVE PAD GRADE FOR FLOOR SLAB THICKNESS.

2. (CLOUD 1) THE LOW, SECONDARY RETAINING WALL WAS NOT NEEDED AT THE REAR OF LOTS 23 & 24 AND WAS NOT BUILT. ELSEWHERE THIS WALL WAS BUILT PER PLAN.

3. THE "NOTCH" IN THE WALL AT THE END OF THE CUL DE SAC WILL BE REPLACED BY CORED HOLE. THE LOCATION HAS BEEN MARKED ON THE WALL.

AT THE TIME OF THIS CERTIFICATION THE FIRST 2 TOWNHOMES ARE UNDER CONSTRUCTION ON LOTS 9 & 10. THE UNDERSLAB SYSTEM FOR DRAINING THE REAR YARD OF LOT 9 HAS BEEN CONSTRUCTED ESSENTIALLY ACCORDING TO DESIGN. LOT 10 HAS A SMALL SIDE YARD; REAR YARD DRAINAGE WILL BE ROUTED TO THE STREET VIA THE SIDE YARD. ON THE REST OF THE SITE SIMILARLY SITUATED LOTS ARE TO BE SIMILARLY TREATED.


AS-BUILT GRADES FOR DRAINAGE ARE SHOWN ON THIS SHEET AND ON SHEET 5.

T.H. Green N.M.P.E. 10,731 1-16-98

A.C.S. BRASS CAP 9-G-24
STATE PLANE COORDS. (NAD 27)
N = 1,500,259.11
E = 415,515.66
DELTA ALPHA = - 00-09'45"
GRID FACTOR = 0.9996434

LEGEND	
TA TOP OF ASPHALT	LOW RETAINING WALL
TP TOP OF PAVEMENT	GARDEN WALL
FL FLOW LINE	GARDEN WALL OR RETAINING WALL
TC TOP OF CURB / CONCRETE	NEW CONTOURS
TO TOP OF SIDEWALK	EXISTING CONTOURS
FF FINISHED FLOOR	FLOW DIRECTION
FG FINISHED GRADE	NEW CURB AND GUTTER
EG EXISTING GRADE	EXISTING CURB AND GUTTER
WV WATER VALVE	NEW SPOT ELEVATIONS
WM WATER METER	EXISTING SPOT ELEVATIONS
FH FIRE HYDRANT	REVISED NEW SPOT ELEVATIONS
LANDSCAPING	

11-18-96: MINOR REVISIONS TO ACCOMMODATE DRC REQUIREMENTS

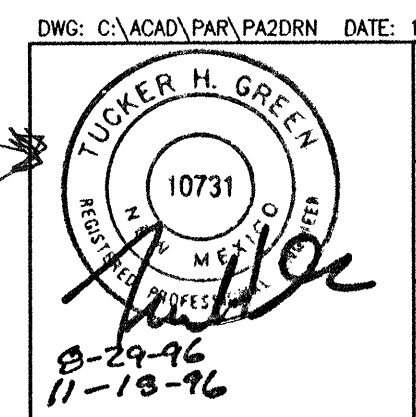

PARSIFAL TOWNHOMES
ALBUQUERQUE, NEW MEXICO


GRADING & DRAINAGE

PER SE ENGINEERING
Drainage, Utilities, and Site Design
3041 Blake Rd SW Albuquerque, NM 87105
(505) 877-6163 239-7855 mobile

SHEET NO.
C1 OF



BENCH MARK: ACS BRASS CAP 112-F-20-A, LOCATED ON MEDIAN NOSE OF MONTGOMERY BLVD NE, APX 39 FT WEST OF DONA MARGUERITA AV, ELEV 5524.98

PROJECT BENCH MARK: TOP OF REBAR & CAP (NMP# #9777) LOCATED AT THE SITE SOUTHWEST PROPERTY CORNER, ELEV 5528.99

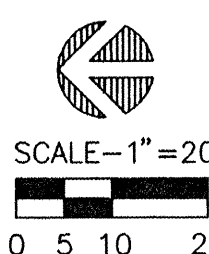

August F. Mosimann, P.E.
Certify that the retaining walls shown on this plan are built as they are depicted herein.

1/6/97

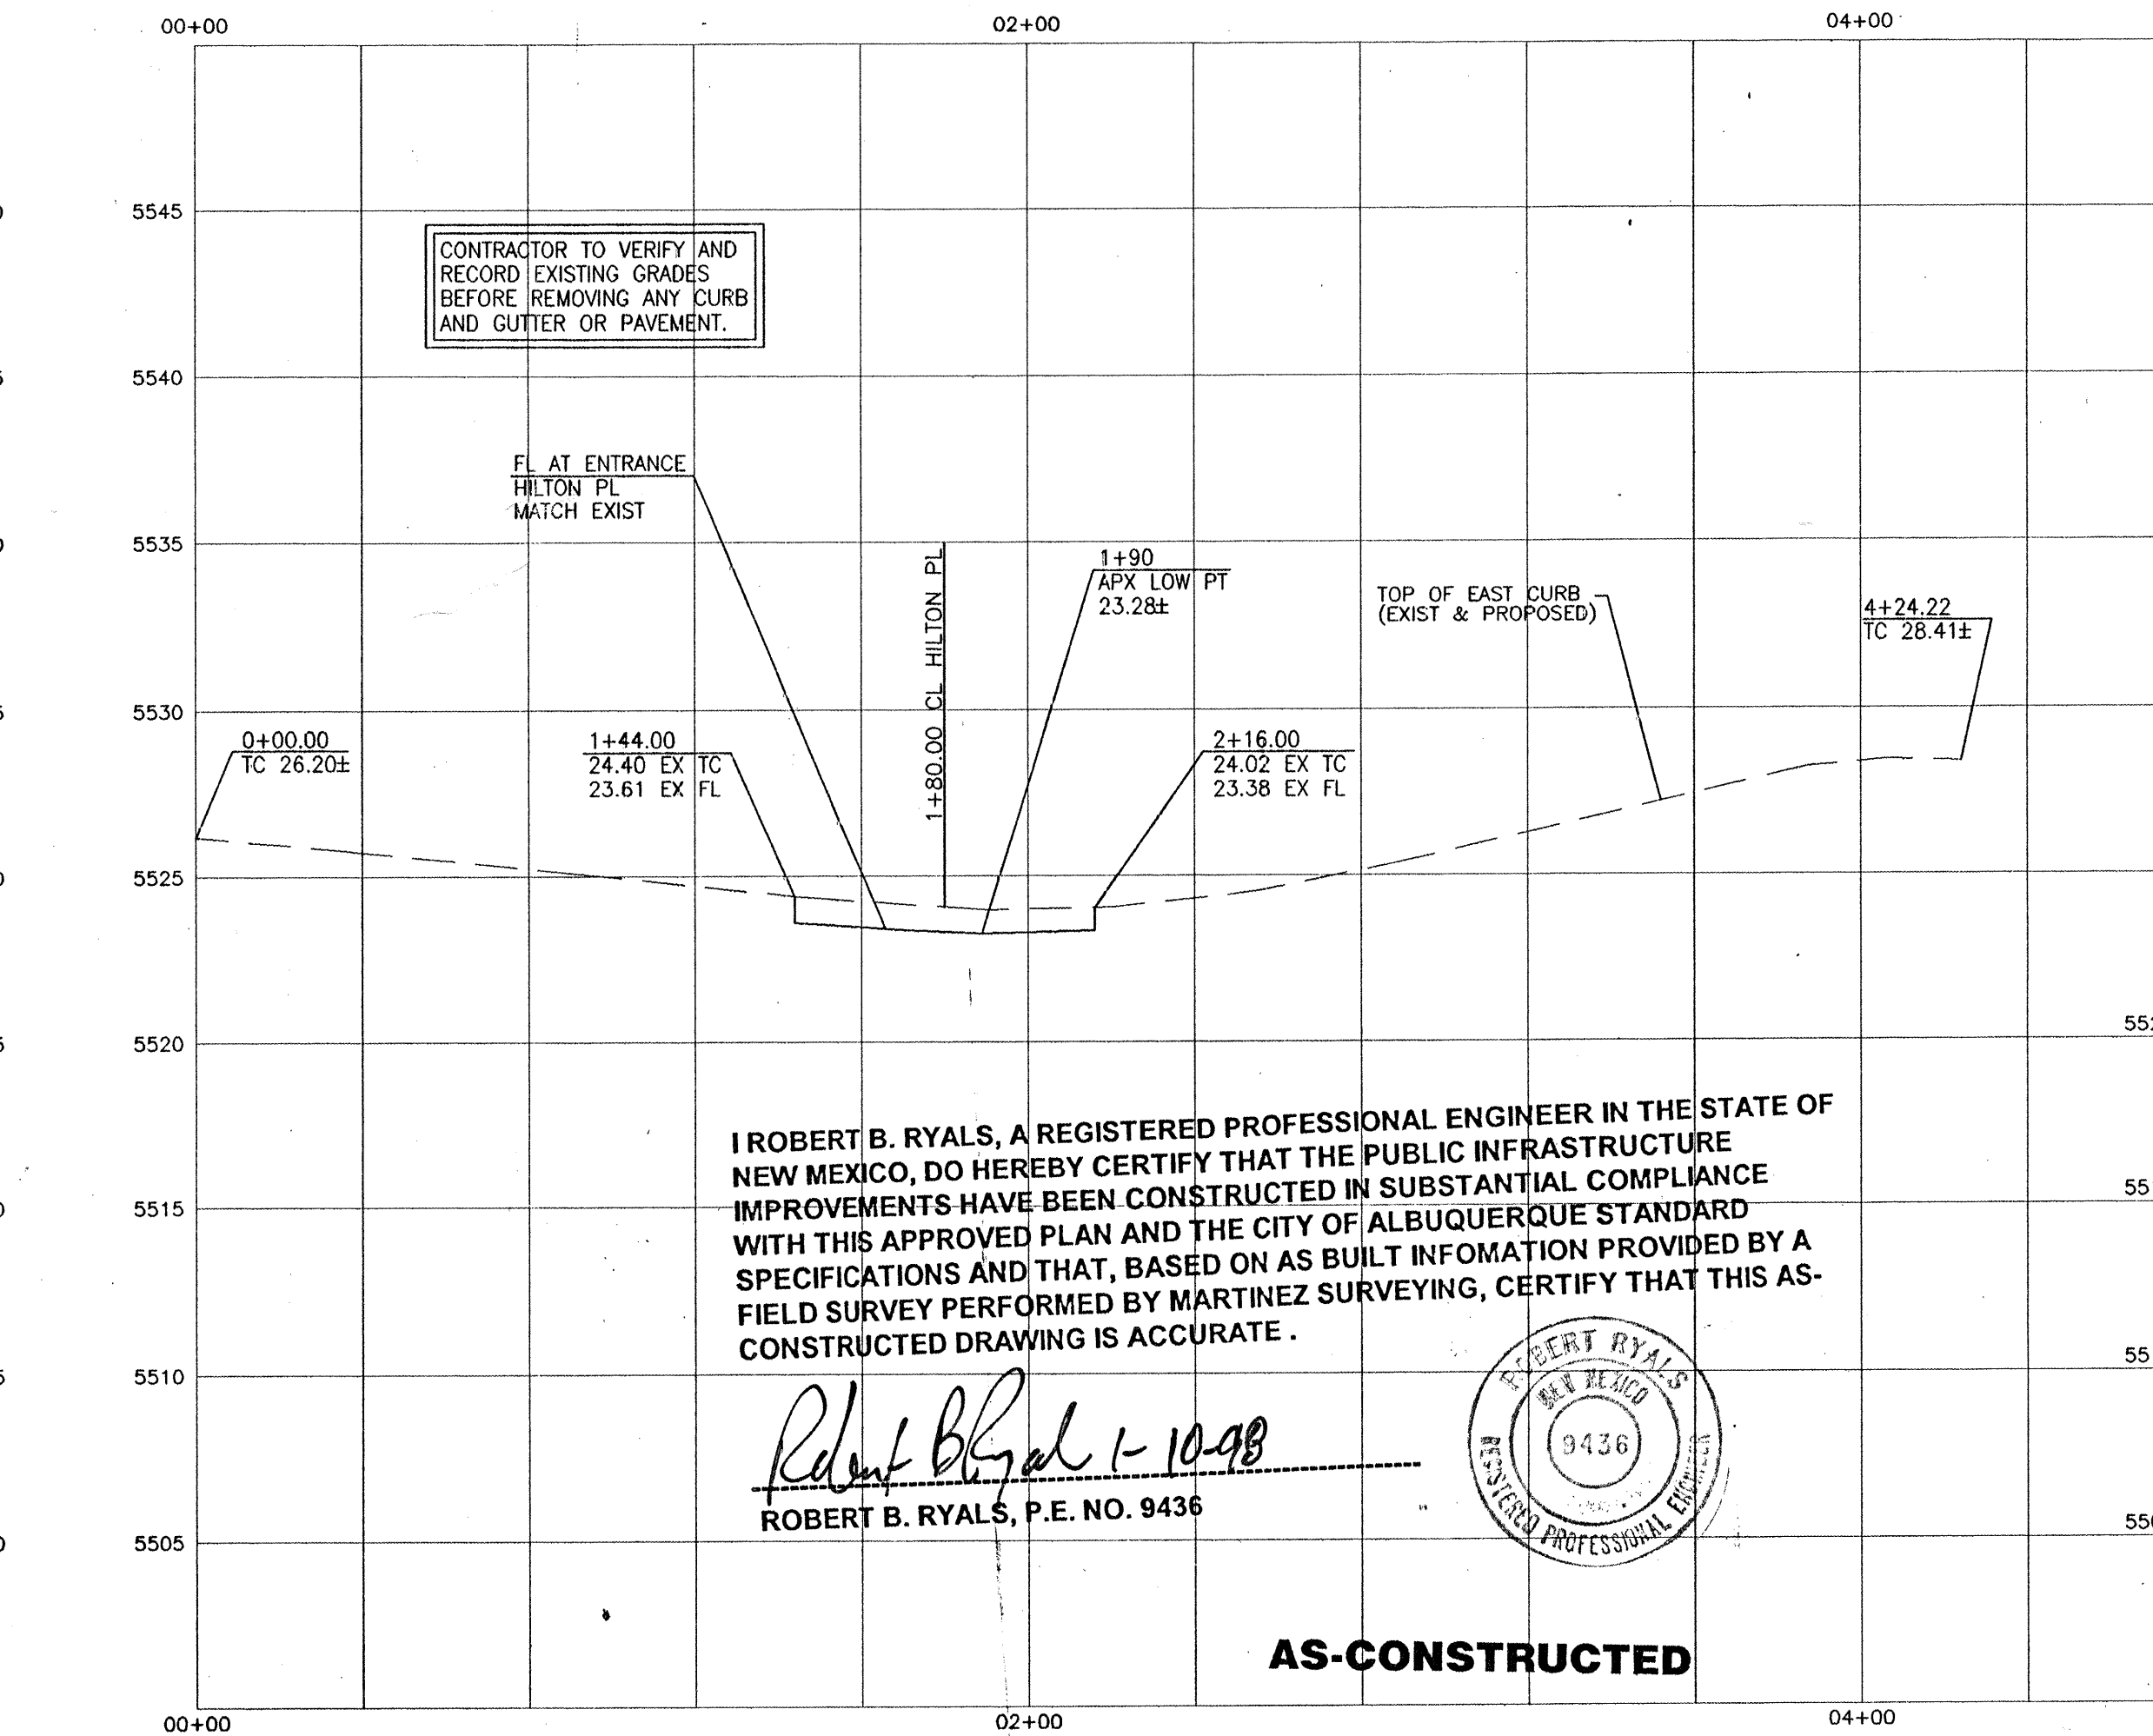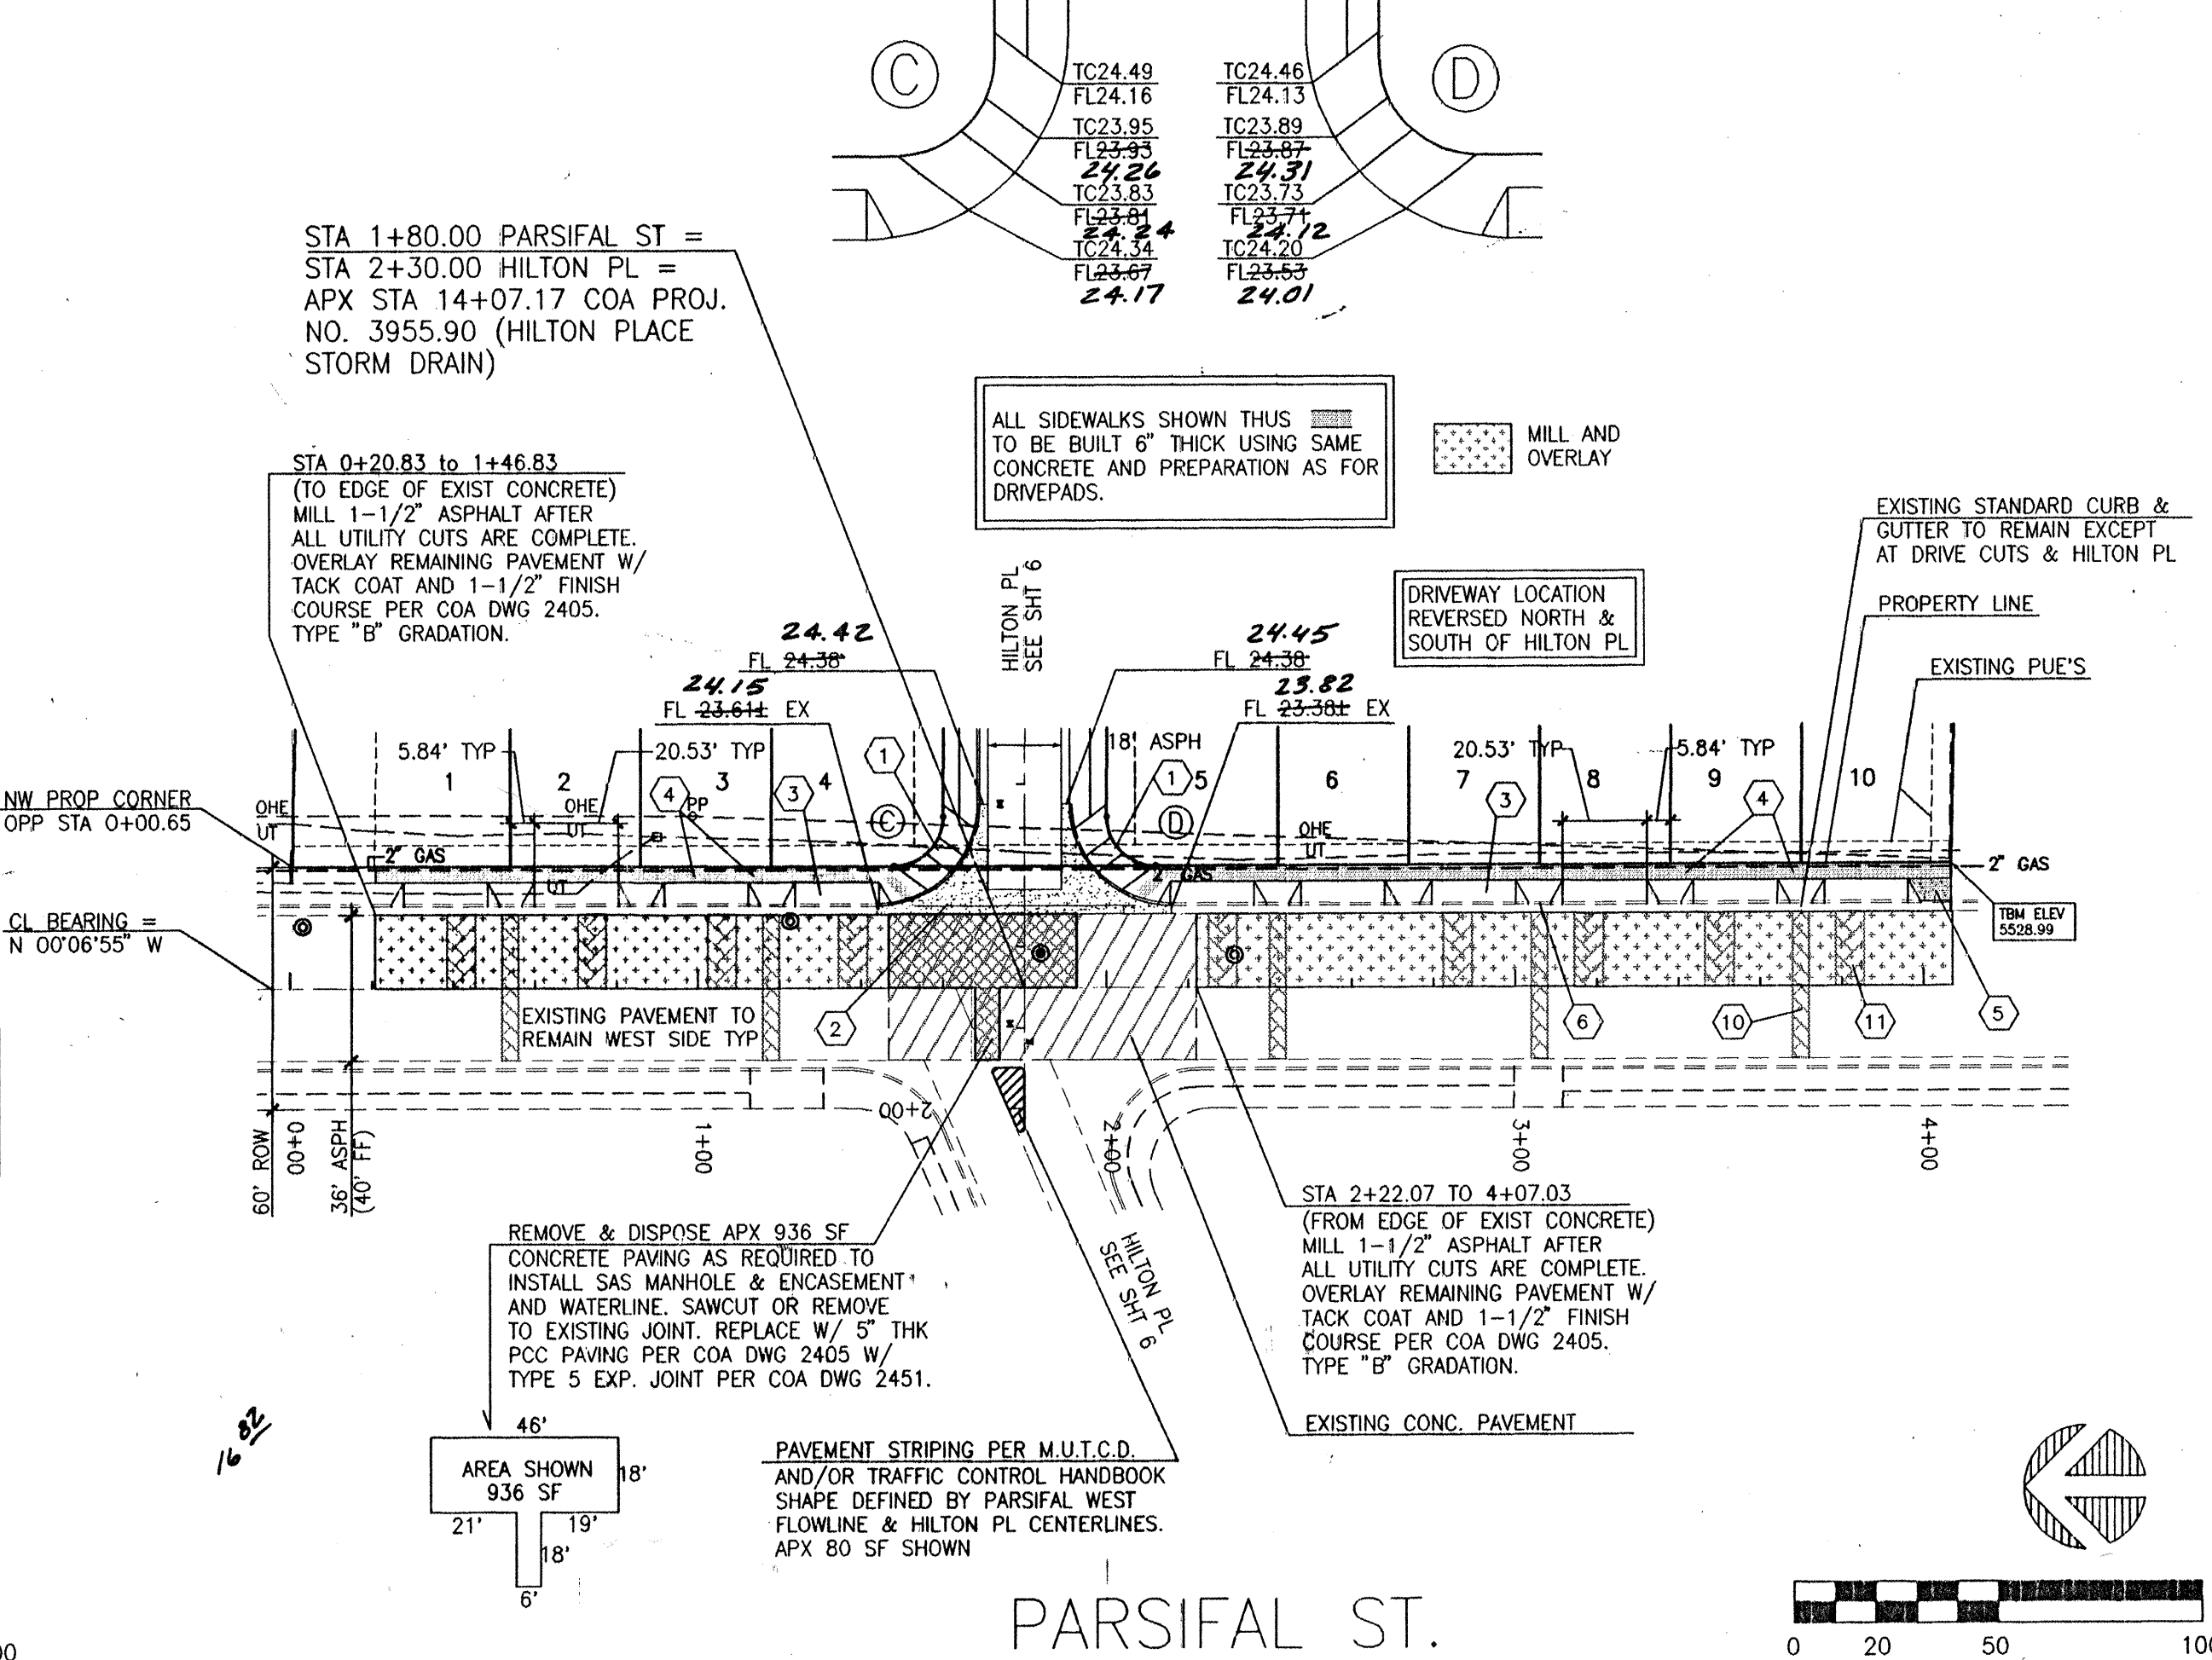

Robert B. Ryals 1-10-98

ROBERT B. RYALS, P.E. NO. 9436

AS-CONSTRUCTED

- ## CONSTRUCTION NOTES:
- 1 HC RAMP PER DWG 2441: CASE II, R=25.00 AT
NOM FACE OF CURB; R=12.00 AT PL TRANSITION
TO STD 8" CURB AT PARALLEL PER COA 2418.
 - 2 BUILD MODIFIED VALLEY GUTTER PER COA DWG 2420.
* PROVIDE STRAIGHT CROSS-SLOPE TO MATCH
* EXISTING PAVEMENT AT PARALLEL ST.
* DO NOT BUILD 1-1/2" FLOWLINE DEPRESSION
 - 3 DRIVEPAD PER COA DWG 2425
MAINTAIN 2% CROSS-SLOPE FULL SIDEWALK
WIDTH (4').
SAW CUT DRIVEPAD OPENINGS INTO EXISTING CURB.
SLOPE SAWCUTS TOWARD STREET PER COA 2415
 - 4 REMOVE EXISTING CONC SIDEWALK. BUILD
NEW 4 FT SIDEWALK TO DRIVEPAD STRENGTH
AND THICKNESS
 - 5 BUILD APX 48% EXTRA CONC SIDEWALK NEXT
TO CURB TO SOUTH PROPERTY LINE TO MATCH
WITH ADJACENT SIDEWALK.
 - 6 EXISTING 8" STD CURB & GUTTER TO REMAIN
ALONG PARALLEL, TYPICAL BETWEEN DRIVE CUTS
 - 7 EXPERIMENTAL COA HC RAMP PER DETAIL SHG 6.
R=20.00 AT NOM FACE CURB; R=12.00 AT PL.
 - 8 BUILD VALLEY GUTTER PER COA DWG 2420
 - 9 STA +171.00 TO +189.00 (BTW VALLEY GUTTERS)
BUILD "DEPRESSED" GUTTER - PROVIDE SMOOTH ROLL
FWD TOP OF CURB TO ASPHALT. ELEV AT 1 FT FROM
EDGE OF ASPHALT 0.06' ABOVE TOP OF ASPHALT
 - 10 PAVEMENT CUT FOR WATER SERVICE: ±4"x36"
 - 11 PAVEMENT CUT FOR SEWER SERVICE: ±7"x18"
 - 12 4' 4" THICK SIDEWALK PER
COA STD DWG

LEGEND		
DESCRIPTION	PROPOSED	EXISTING
WATER VALVE		
FIRE HYDRANT		
STREET LIGHT		
STORM DRAIN MANHOLE		
SAS MANHOLE		
CURB & GUTTER		
WATER LINE		
SEWER LINE		
STORM DRAIN		
SEWER SERVICE		
CATCH BASIN		
SINGLE WATER SERVICE		
DOUBLE WATER SERVICE		
CENTERLINE MONUMENT		
PROJECT BOUNDARY		
ADJACENT PROP. LINE		
UTILITY CORNER		
UTILITY POLE		
HYDRAULIC GRADE LINE		

DWG: C:\ACAD\PAR\PA2D2 DATE: 11/18/96 TIME: 17:00 T. GREEN

PER SE ENGINEERING
Drainage, Utilities, and Site Design
3041 Blake Rd SW Albuquerque NM 87105
(505) 877-6163 239-7855 mobile

CITY OF ALBUQUERQUE
PUBLIC WORKS DEPARTMENT
ENGINEERING GROUP

TITLE: PARSIFAL TOWNHOMES
PAVING PLAN & PROFILE: PARSIFAL ST & BAY CT


Design Review

APPROVED
MAR 27 1967
DESIGN
REVISIONS

REVIEW COMMITTEE	
PROJECT NO.	5571.81

MAP NO.	G-20
---------	------

SHEET 5 OF 9

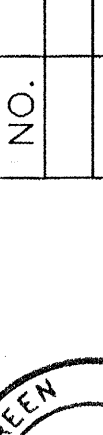ES ST & BAY CT		SHEET 5 OF 9	
DATE: 11/96 DRAWN BY: THG CHECKED BY: THG		DATE: 11/96 DATE: 11/96 DATE: 11/96	
REMARKS REVISIONS DESIGN		NO. DATE BY	
ENGINEER'S SEAL 		SURVEY INFORMATION FIELD NOTES NO. BY DATE	
BENCH MARKS: CITY OF ALBUQUERQUE SURVEY MONUMENT BENCH MARK: ACS BRASS CAP 12-F-20-A, LOCATED ON THE MEDIAN NOSE OF MONTGOMERY BLVD NE, APX 39 FT WEST OF DONA MARGUERITA AV NE, ELEVATION 5524.98		AS BUILT INFORMATION CONTRACTOR: Stan Dave WORKED BY: Mayhew DATE: 8/9/97 ACCEPTED BY: Davis DATE: 7/9/97 VERIFICATION BY: Davis DATE: 7/9/97 DRAWINGS CONTROLLED BY: Davis DATE: 7/9/97 MICRO-FILM INFORMATION RECORDED BY: [Signature] NO. []	