
# CITY OF ALBUQUERQUE

Planning Department Brennon Williams, Director

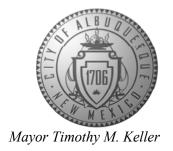

April 6, 2021

David Soule, P.E. Rio Grande Engineering P.O. Box 93924 Albuquerque, NM 87199

RE: 13606 Sunset Canyon Dr. NE

**Grading and Drainage Plan** 

Engineer's Stamp Date: 03/08/21

Engineer's Certification Date: 04/05/21

**Hydrology File: G23D016** 

Dear Mr. Soule:

Based upon the information provided in your submittal received 04/06/2021 and site photos sent PO Box 1293

on 04/06/21, the Grading and Drainage Plan is approved for Building Permit and Building Pad Certification for 13606 Sunset Canyon Dr. NE. Please attach a copy of this approved plan in the

construction sets for Building Permit processing along with a copy of this letter.

Albuquerque

Prior to approval in support of Permanent Release of Occupancy by Hydrology, Engineer

Certification per the DPM checklist will be required.

NM 87103

If you have any questions, please contact me at 924-3995 or <u>rbrissette@cabq.gov</u>.

www.cabq.gov

Sincerely,

Renée C. Brissette, P.E. CFM Senior Engineer, Hydrology

Renée C. Brissette

Planning Department



# City of Albuquerque

### Planning Department

### Development & Building Services Division

## DRAINAGE AND TRANSPORTATION INFORMATION SHEET (REV 6/2018)

Project Title: 13606 SUNSET CANY	ON Building Permit #:	Hydrology File #:
DRB#:		
Local Description, LOT 59 BLOCK	15 CLENWOOD HILLS INTT	. 3
City Address: 13606 SUNSET CAN	YON NE	
		<del></del>
Applicant: LAS VENTANAS HOME		
Address:		
Phone#:	Fax#:	E-mail:
Other Contact: RIO GRANDE ENGI	NEERING	Contact:DAVID_SOULE
Address: PO BOX 93924 ALB N	М 87199	<del></del>
Phone#: 505.321.9099	Fax#: 505.872.0999	E-mail: david@riograndeengineering.com
TYPE OF DEVELOPMENT: PLA	T X RESIDENCE D	DRB SITE ADMIN SITE
Check all that Apply:		
DEPARTMENT:  X HYDROLOGY/ DRAINAGE TRAFFIC/ TRANSPORTATION	<u>×</u> BUILDING	OVAL/ACCEPTANCE SOUGHT: PERMIT APPROVAL TE OF OCCUPANCY
TYPE OF SUBMITTAL:		
ENGINEER/ARCHITECT CERTIFICATI	<del></del>	ARY PLAT APPROVAL
X PAD CERTIFICATION		FOR SUB'D APPROVAL
CONCEPTUAL G & D PLAN		FOR BLDG. PERMIT APPROVAL
GRADING PLAN	FINAL PLA	AT APPROVAL
DRAINAGE REPORT	CIA/DELE	AGE OF EDIANGLAY OLLAD ANTENE
DRAINAGE MASTER PLAN		ASE OF FINANCIAL GUARANTEE
FLOODPLAIN DEVELOPMENT PERMI		ON PERMIT APPROVAL
ELEVATION CERTIFICATE		PERMIT APPROVAL
CLOMR/LOMR	SO-19 APPI	ERMIT APPROVAL
TRAFFIC CIRCULATION LAYOUT (TO TRAFFIC IMPACT STUDY (TIS)	<del></del>	PAD CERTIFICATION
STREET LIGHT LAYOUT		ER APPROVAL
OTHER (SPECIFY)	<del></del>	
PRE-DESIGN MEETING?	<del></del>	IN DEVELOPMENT PERMIT
IS THIS A RESUBMITTAL?: X Yes	OTHER (SE	PECIFY)
DATE SUBMITTED:	By:	
COA STAFF:	ELECTRONIC SUBMITTAL RECEIVED:	

FEE PAID:\_\_\_\_

### Weighted E Method

PROPOSED

**EXISTING** 

Weighted E = Ea\*Aa + Eb\*Ab + Ec\*Ac + Ed\*Ad / (Total Area)


Volume = Weighted D \* Total Area

Flow = Qa \* Aa + Qb \* Ab + Qc \* Ac + Qd \* Ad

Where for 100-year, 6-hour storm (zone 4)

Qb= 2.92 Ec= 1.46 Qc= 3.73 Ed= 2.64 Qd= 5.25

THIS SITE IS A LOT WITHIN A FULLY DEVELOPED RESIDENTIAL SUBDIVISION. THE SITE IS ADJACENT TO FULLY DEVELOPED ROADWAYS. THE SITE HAS A SMALL UPLAND UNDEVELOPED WATER SHED THAT ENTERS AS SHEET FLWO. THE DENSITY OF THIS DEVELOPMENT IS SIMILAR TO THE SURROUNDING FULLY DEVELOPED CONDITIONS. THE SITE WILL FREE DISCHARGE. THIS SITE IS NOT REQUIRED TO RETAIN THE FIRST FLUSH, YET A SMALL DESILATION POND HAS BEEN ADDED ADJACENT TO THE ROAL

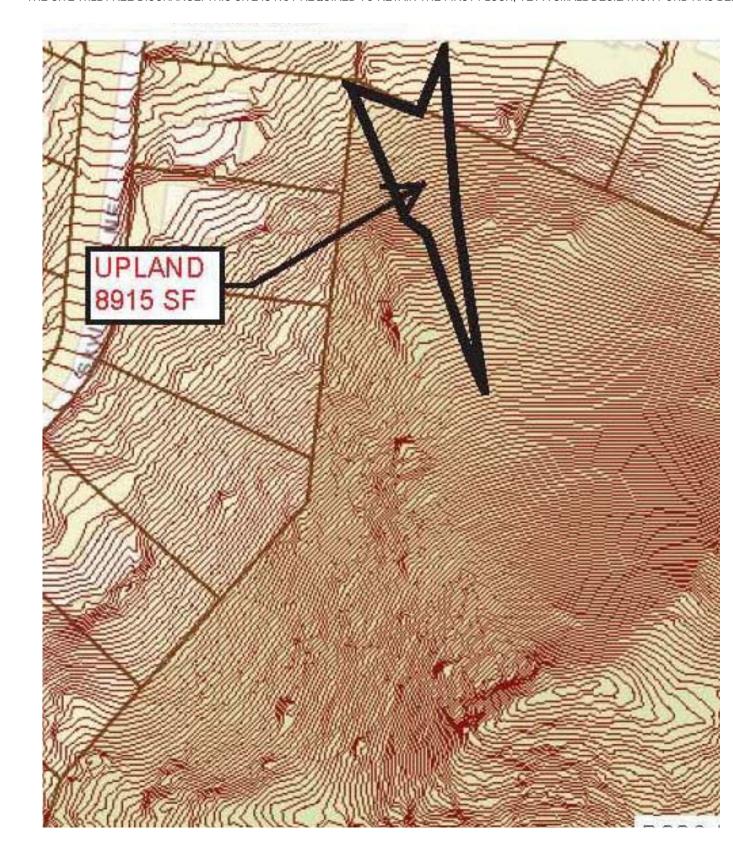

I, DAVID SOULE HAVE PERSONALLY INPECTED THE SITE. I HEREBY CERTIFY THE PAD HAS BEEN CONSTRUCTED SUCH THAT IT IS IN SUBSTANTIAL CONFORMANCE TO THE APPROVED GRADING PLAN DATED 3/8/21

WATER QUALITY POND

EARTHEN SWALE

FF = 6259.00 FP = 6258.50

**RETAINING WALL** 

TOP = 6259.00

INTEGRAL WITH HOUSE

TOP = 6255.25

VOLUME = 20 CF

EARTHEN SWALE-

BOTTOM = 6254.75



WATER QUALITY POND

BOTTOM = 6256.00 VOLUME =201 CF

TOP = 6257.50

TW = 61.00BW = 59.00

BW = 63.00

TW = 65.67

BW = 65.00

TW = 72.33BW = 70.33

END 2ND RETAINING WALL

BW = 72.33

END 1ST RETAINING WALL

EARTHEN SWALE

## **EROSION CONTROL NOTES:**


City of Albuquerque Planning Department Development Review Services

**HYDROLOGY SECTION** 


**APPROVED** 

G23D016

- 1. CONTRACTOR IS RESPONSIBLE FOR OBTAINING A TOPSOIL DISTURBANCE PERMIT PRIOR TO BEGINNING WORK.
- 2. CONTRACTOR IS RESPONSIBLE FOR MAINTAINING RUN-OFF ON SITE DURING CONSTRUCTION.
- 3. CONTRACTOR IS RESPONSIBLE FOR CLEANING ALL SEDIMENT THAT GETS INTO EXISTING RIGHT-OF-WAY.
- 4. REPAIR OF DAMAGED FACILITIES AND CLEANUP OF SEDIMENT ACCUMULATIONS ON ADJACENT PROPERTIES AND IN PUBLIC FACILITIES IS THE RESPONSIBILITY OF THE CONTRACTOR.
- 5. ALL EXPOSED EARTH SURFACES MUST BE PROTECTED FROM WIND AND WATER EROSION PRIOR TO FINAL ACCEPTANCE OF ANY PROJECT.

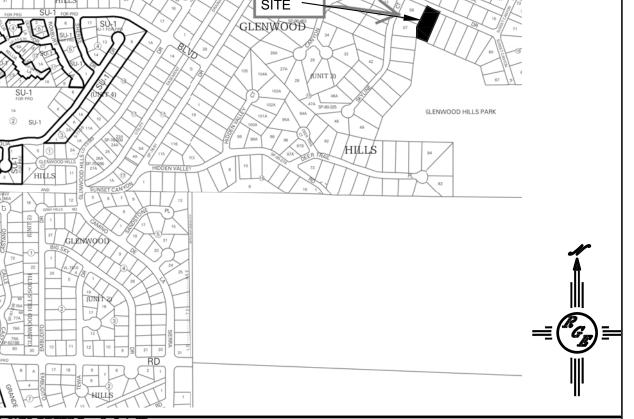

## **VICINITY MAP:**

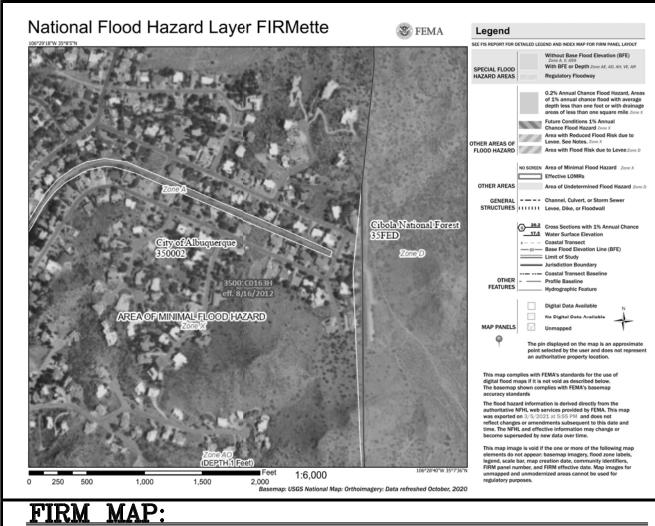


**LEGAL DESCRIPTION:** LOT 59, BLOCK 15, GLENWOOD HILLS, UNIT 3

CITY OF ALBUQUERQUE, BERNALILLO COUNTY, NEW MEXICO

## NOTES:


- 1. ALL SPOT ELEVATIONS REPRESENT FLOWLINE ELEVATION UNLESS OTHERWISE NOTED.
- 2. ALL SLOPES SHALL BE 3:1 MAX. AND GRAVEL OR NATIVE SEEDING PRIOR TO CO.
- 3. ANY PERIMETER WALLS MUST BE PERMITED SEPARATELY ALL RETAINING WALL DESIGN SHALL BE BY OTHERS.
- 4. SURVEY INFORMATION PROVIDED BY COMMUNITY SCIENCES CORPORATION USING NAVD
- 5. A PAD ELEVATION CERTIFICATION SHALL BE REQUIRED PRIOR TO RELEASE OF BUILDING

# **LEGEND**

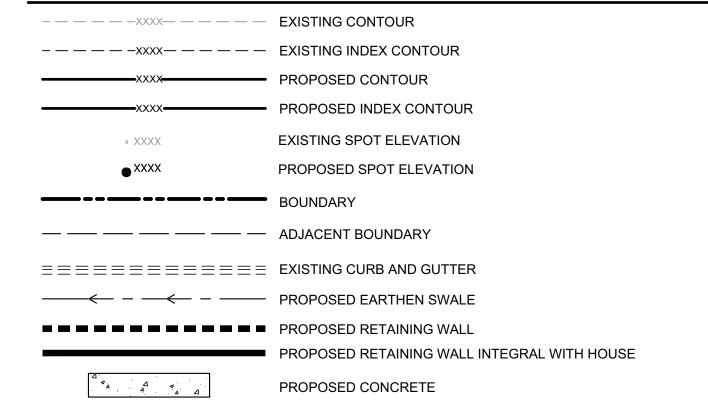

# **CAUTION:**

EXISTING UTILITIES ARE NOT SHOWN. IT SHALL BE THE SOLE RESPONSIBILITY OF THE CONTRACTOR TO CONDUCT ALL **NECESSARY FIELD INVESTIGATIONS PRIOR** TO ANY EXCAVATION TO DETERMINE THE ACTUAL LOCATION OF UTILITIES & OTHER IMPROVEMENTS.

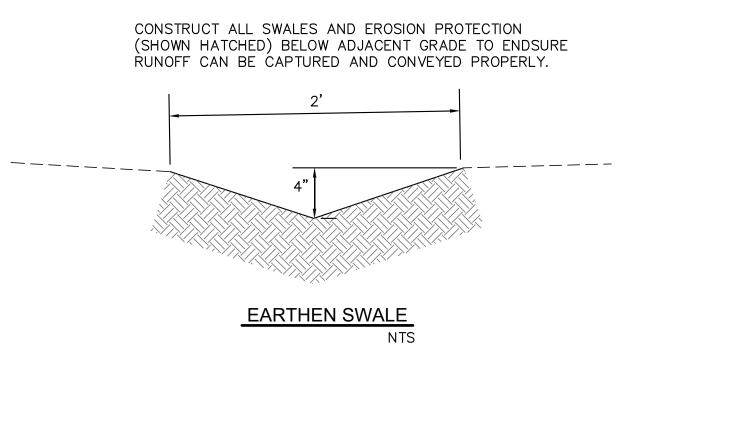

TEMPORARY BENCHMARK FIRE HYDRANT FLANGE


ELEV. = 6262.24

BEĞIN 2ND RETAINING WALL


BEGIN 1ST RETAINING WALL

BW = 62.33

BW = 60.00

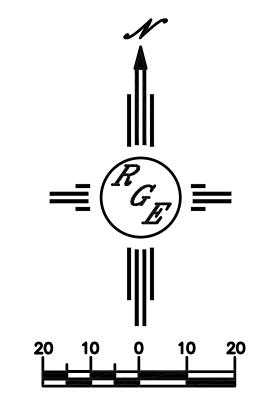

SCALE: 1"=20'

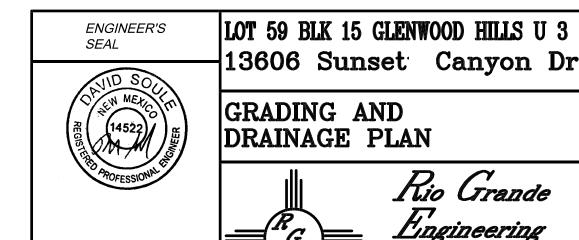

13606 Sunset Canyon Dr GRADING AND DRAINAGE PLAN

Rio Grande Lingineering PO BOX 93924

 $^{BY}$  DEM

DATE 3-6-21

13606 Sunsett Canyon Dr.DWG

SHEET#

JOB#

C1

3/8/21 DAVID SOULE P.E. #14522

ALBUQUERQUE, NM 87199 (505) 321-9099