



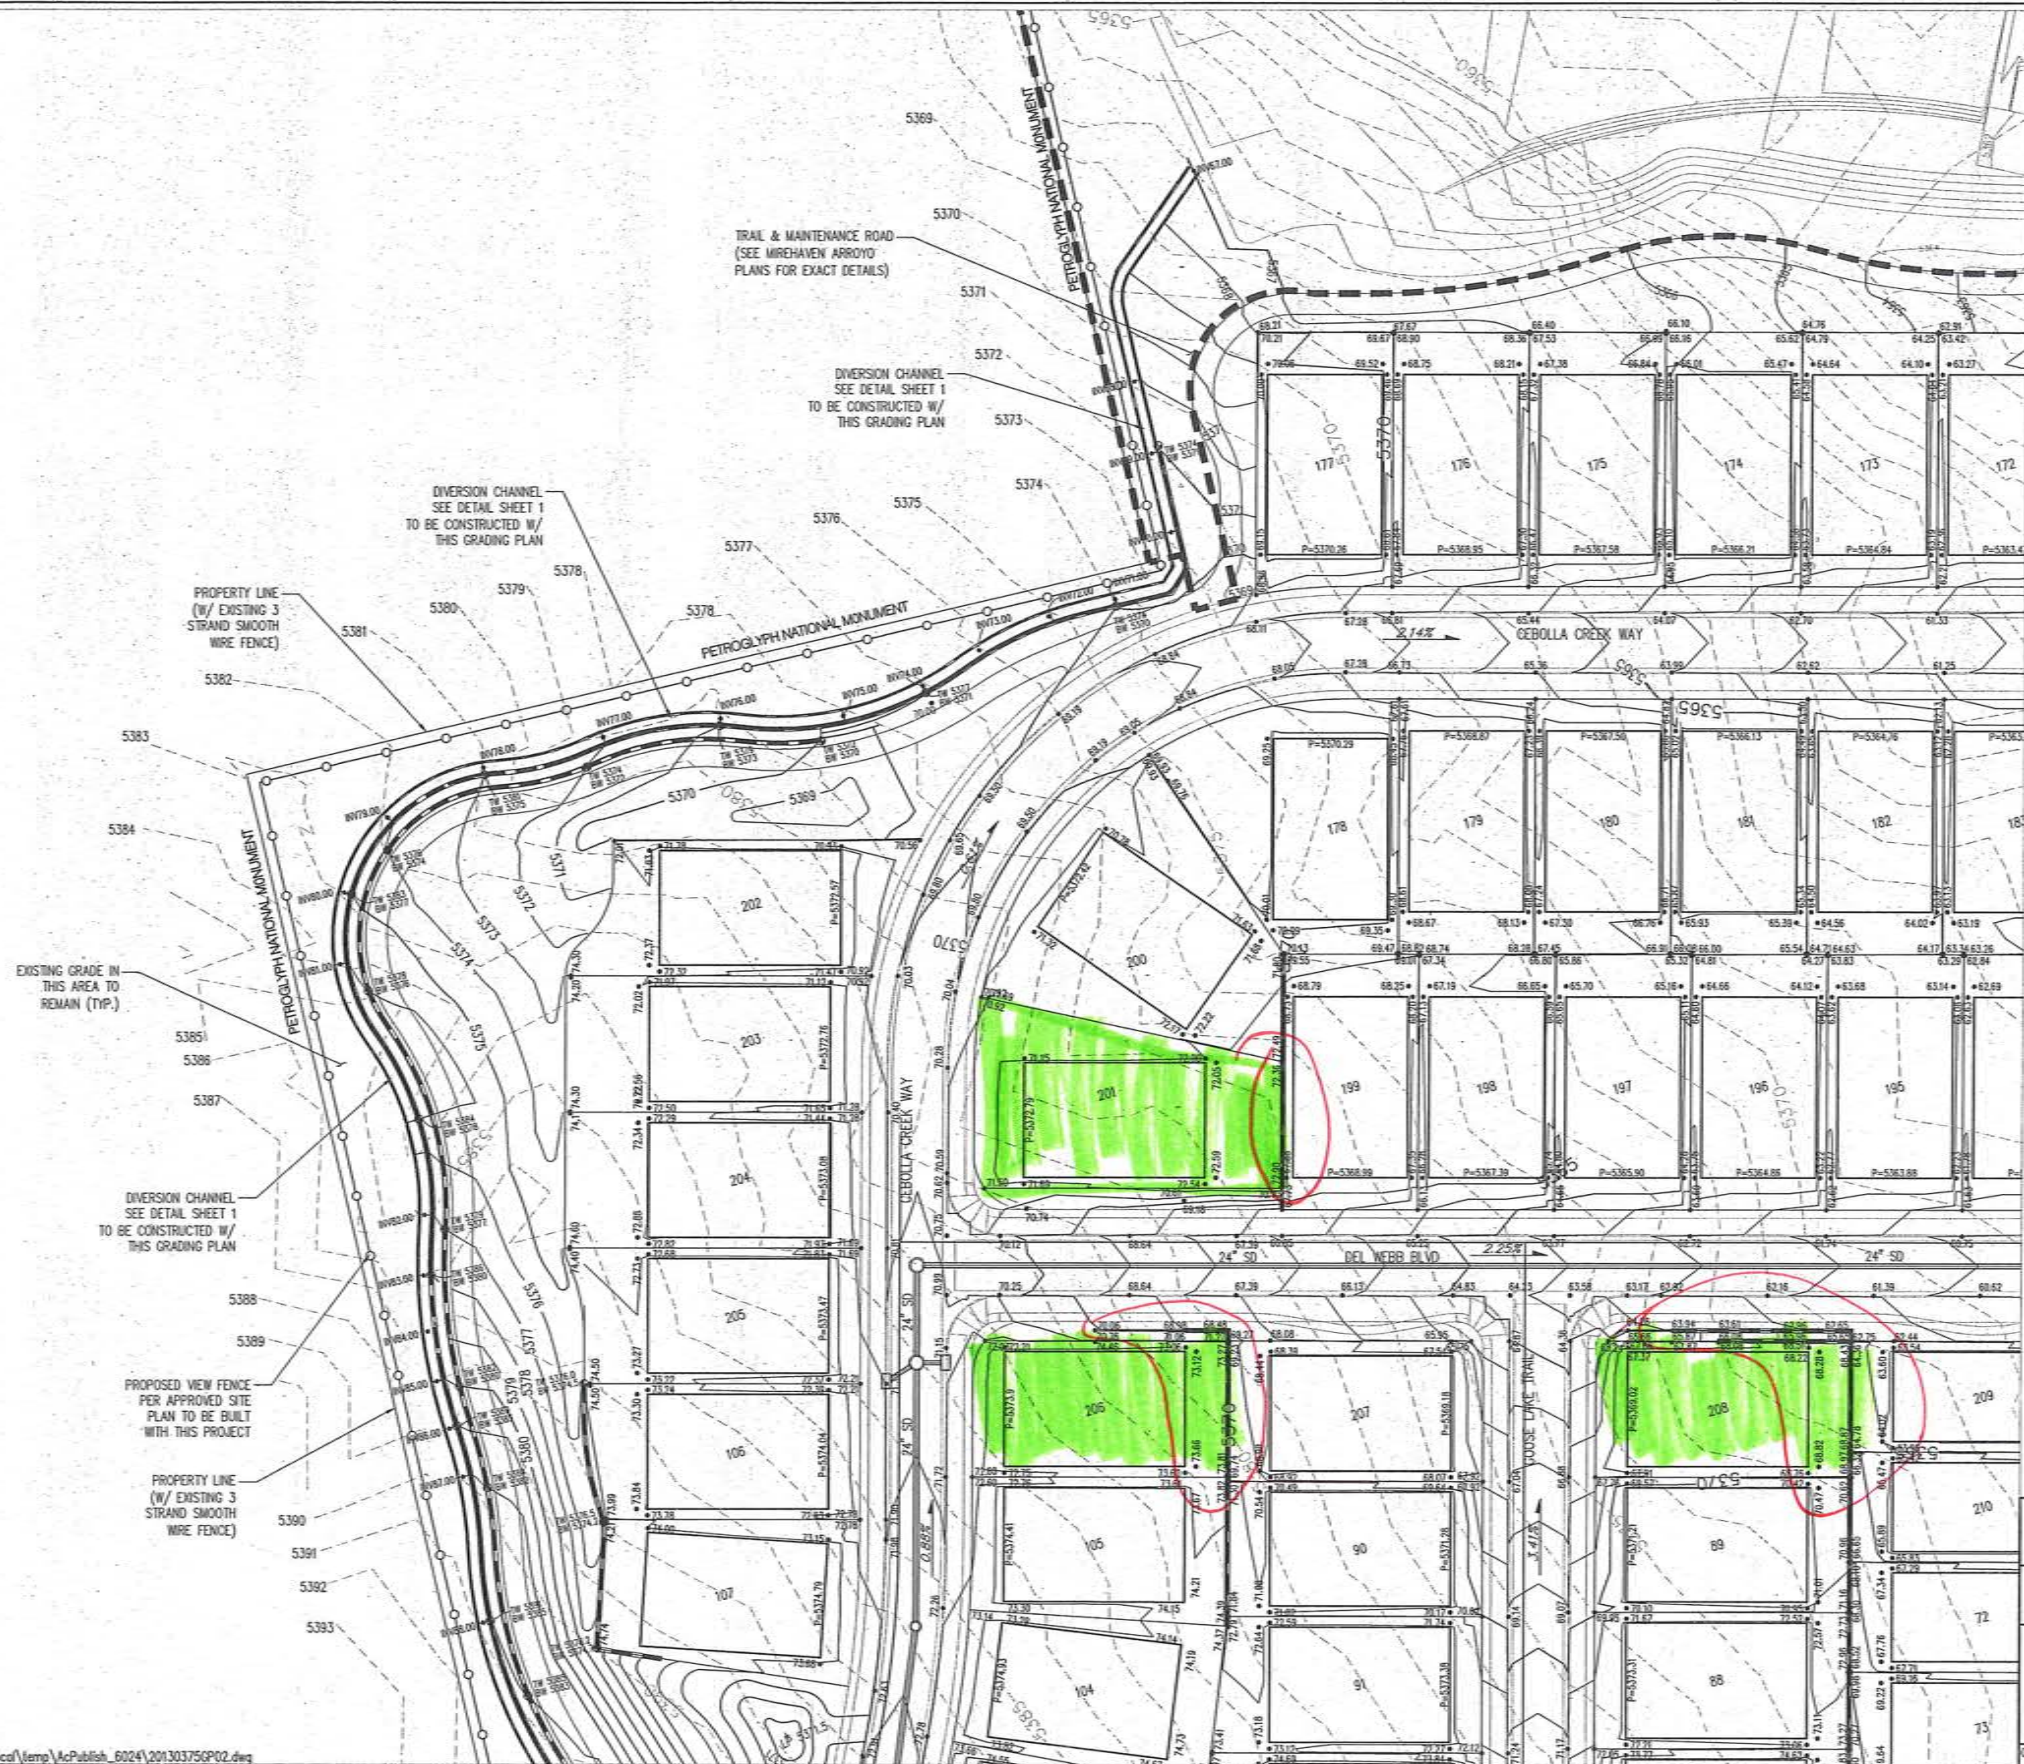

LEGEND

- PROPOSED SPOT ELEVATION
- EXISTING SPOT ELEVATION
- PROPOSED CONTOUR
- EXISTING STORM DRAIN LINE
- PROPOSED STORM DRAIN INLET
- PROPOSED STORM DRAIN LINE
- PROPOSED STORM DRAIN MANHOLE
- PROPOSED WATER BLOCK
- RETAINING WALL
- PAD
- TB
- STREET SLOPE
- CHECK DAM (SEE SHEET 8 FOR DETAIL)
- MIREHAVEN ARROYO EASEMENT BOUNDARY

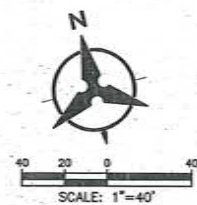

Bohannon & Huston
www.bhinc.com 800.877.5332


CITY OF ALBUQUERQUE
DEPARTMENT OF
MUNICIPAL DEVELOPMENT
DEL WEBB @ MIREHAVEN PHASE 1
GRADING PLAN

DESIGN REVIEW COMMITTEE	CITY ENGINEER APPROVAL	MO./DAY/YR.	MO./DAY/YR.

CITY PROJECT NO. ZONE MAP NO. SHEET 2 OF 8


SURVEY INFORMATION		BENCH MARKS		AS-BUILT INFORMATION	
NO.	DATE	US&GS BRASS DISC STAMPED	REWARD 1967	CONTRACTOR	DATE
		GEOGRAPHIC POSITION (NAD 83)		BY	DATE
		N.M. STATE PLANE COORDINATES		INSPECTOR'S	DATE
		(CENTRAL ZONE)		FIELD PLACE BY	DATE
		N=1497364.063 E=1491190.819		VERIFICATION BY	DATE
		GROUND TO GRID = 0.999675005		CORRECTION BY	DATE
		DELTA ALPHA = -0.0171226"		MICRO-FILM INFORMATION	
		NAVD 1988 ELEVATION = 5319.688		RECORDED BY	DATE
				NO.	DATE



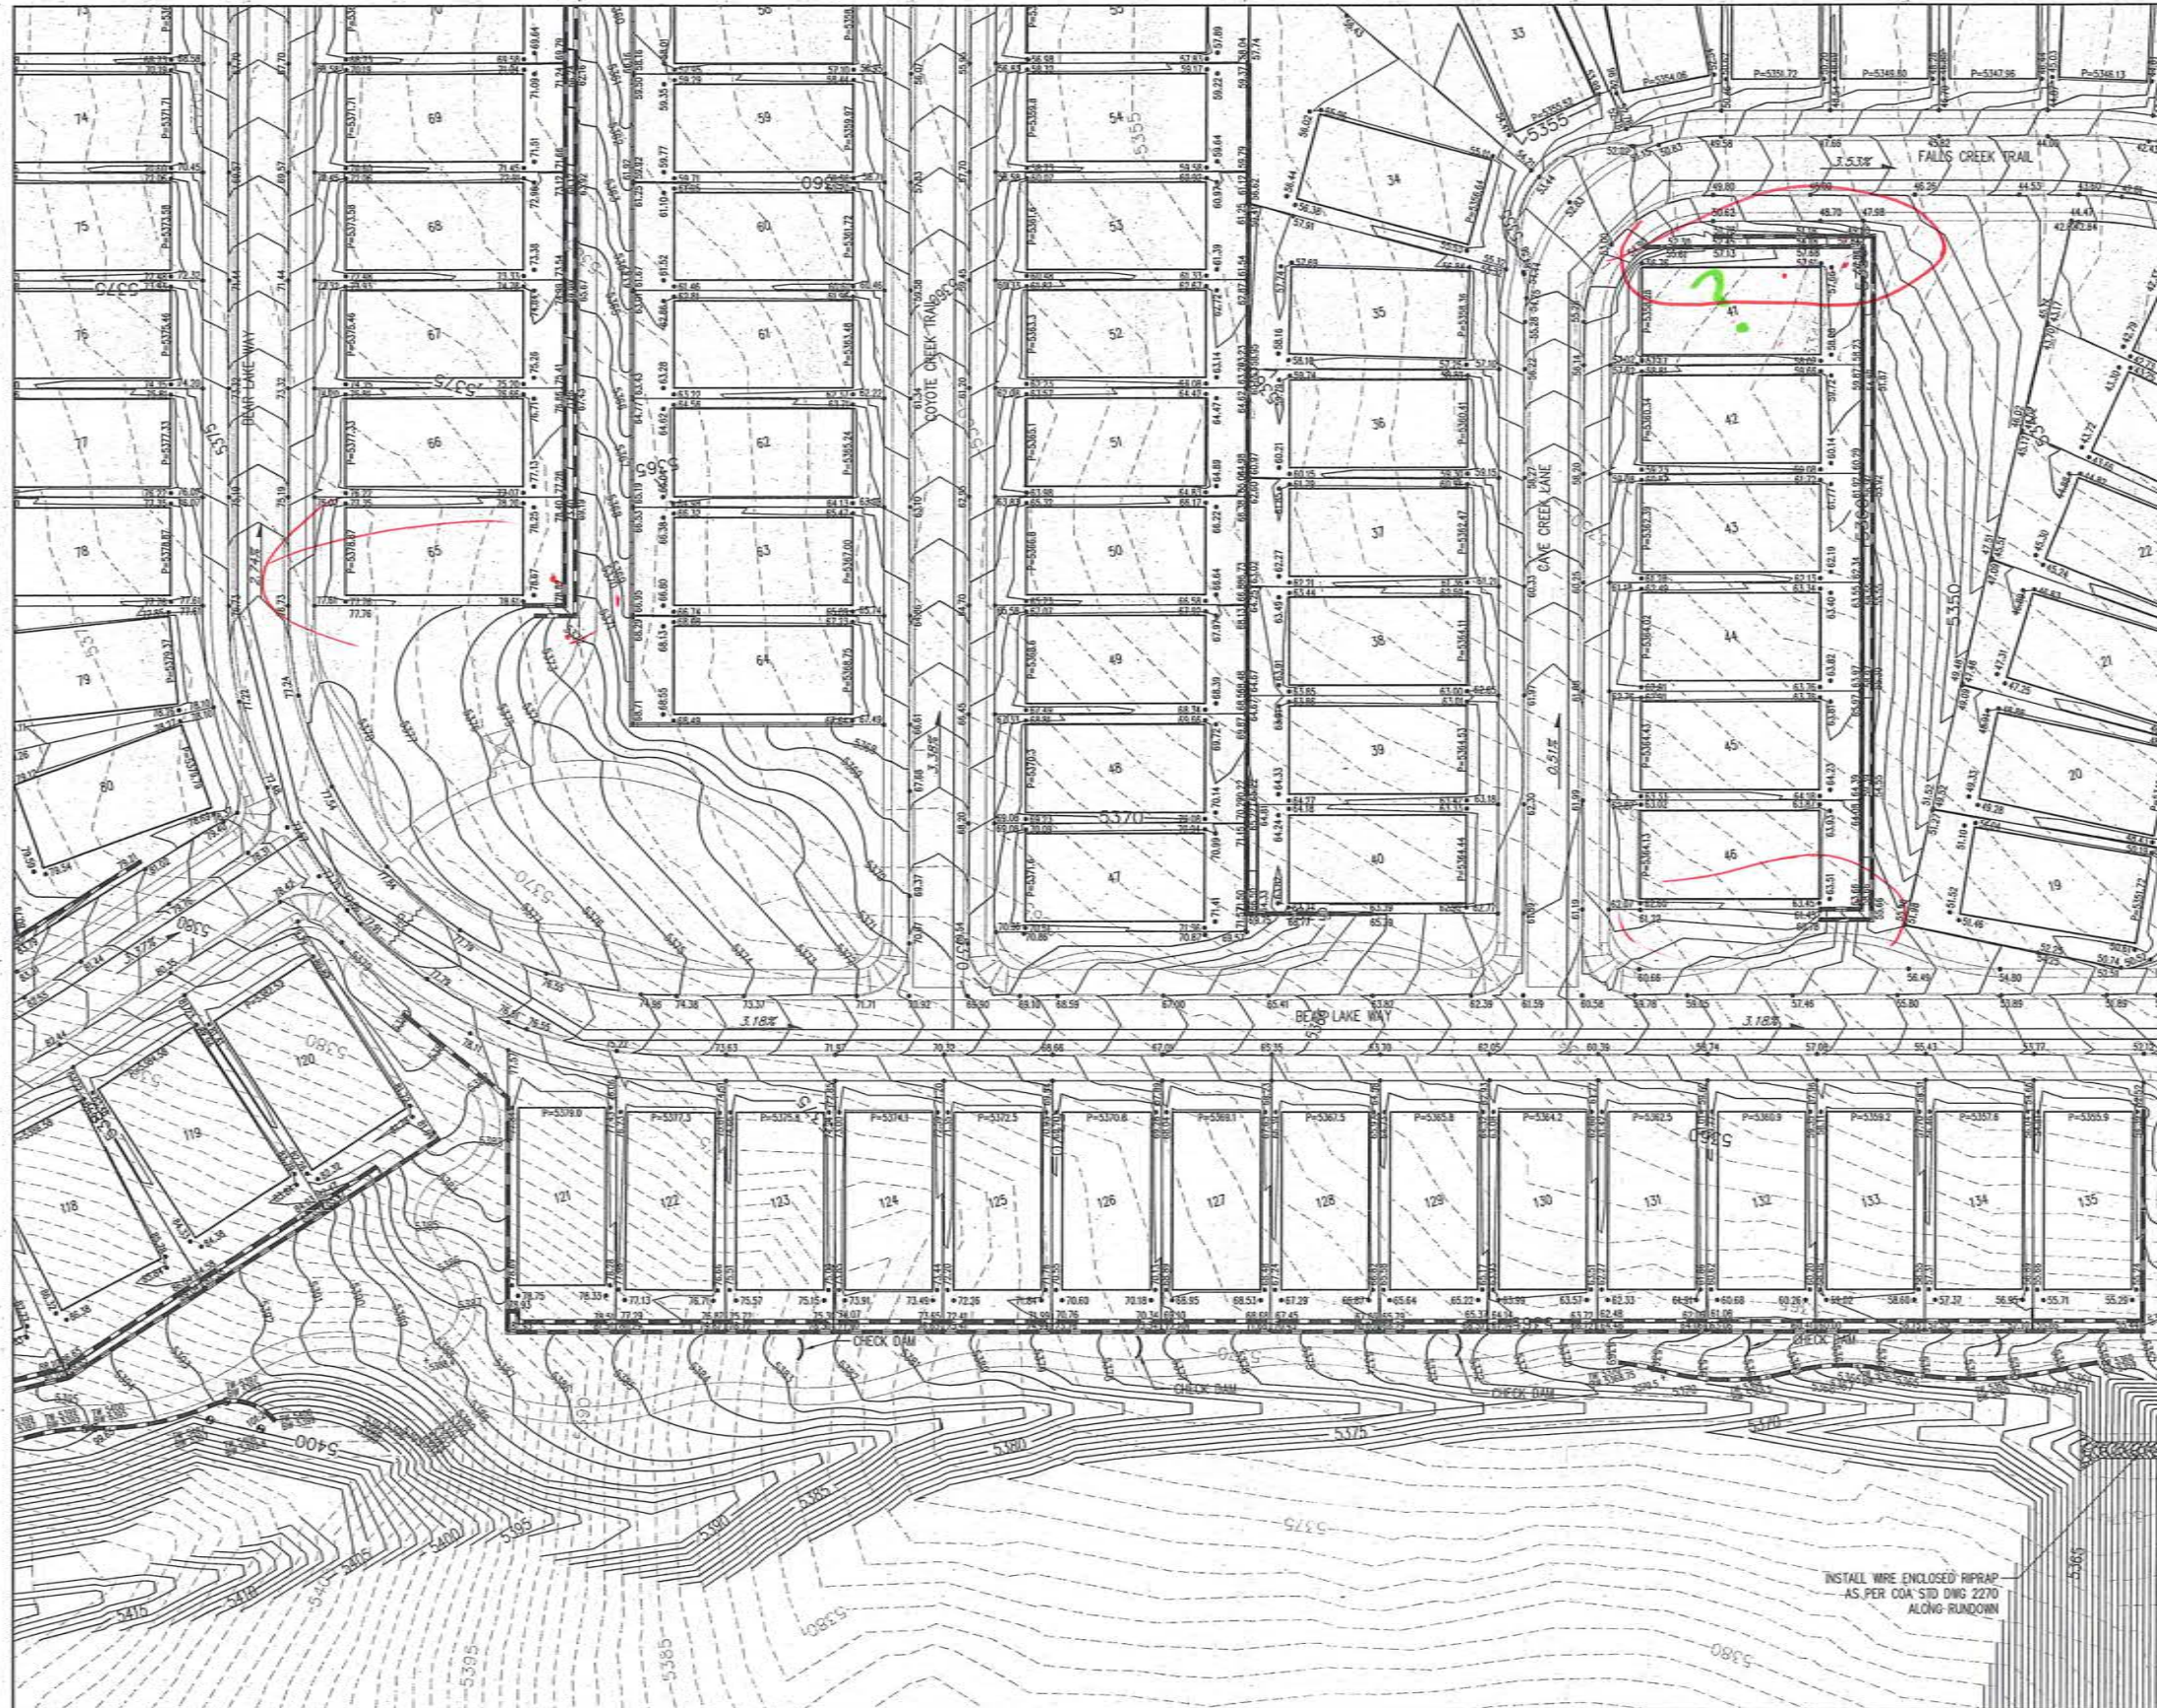




- LEGEND**
- PROPOSED SPOT ELEVATION • 5235.25
 - EXISTING SPOT ELEVATION • EX 5235.25
 - PROPOSED CONTOUR --- 5025 ---
 - EXISTING STORM DRAIN LINE ---
 - PROPOSED STORM DRAIN INLET □
 - PROPOSED STORM DRAIN LINE ---
 - PROPOSED STORM DRAIN MANHOLE ○
 - PROPOSED WATER BLOCK ---
 - RETAINING WALL ---
 - PAD 10 P-5000-00
 - TB
 - STREET SLOPE XX
 - CHECK DAM (SEE SHEET 8 FOR DETAIL)
 - MIREHAVEN ARROYO EASEMENT BOUNDARY ---

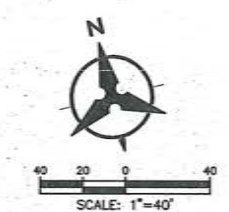

Bohannon & Huston www.bhinc.com 800.877.5332	
CITY OF ALBUQUERQUE DEPARTMENT OF MUNICIPAL DEVELOPMENT DEL WEBB @ MIREHAVEN PHASE 1 GRADING PLAN	
DESIGN REVIEW COMMITTEE	CITY ENGINEER APPROVAL
NO. / DATE	NO. / DATE
REVISIONS	REVISIONS
DESIGN	DESIGN
DESIGNED BY YPM	DATE 03/20/14
DRAWN BY ARR	DATE 03/20/14
CHECKED BY YPM & KOP	DATE 03/20/14
CITY PROJECT NO. ZONE MAP NO. SHEET 7 OF 8	

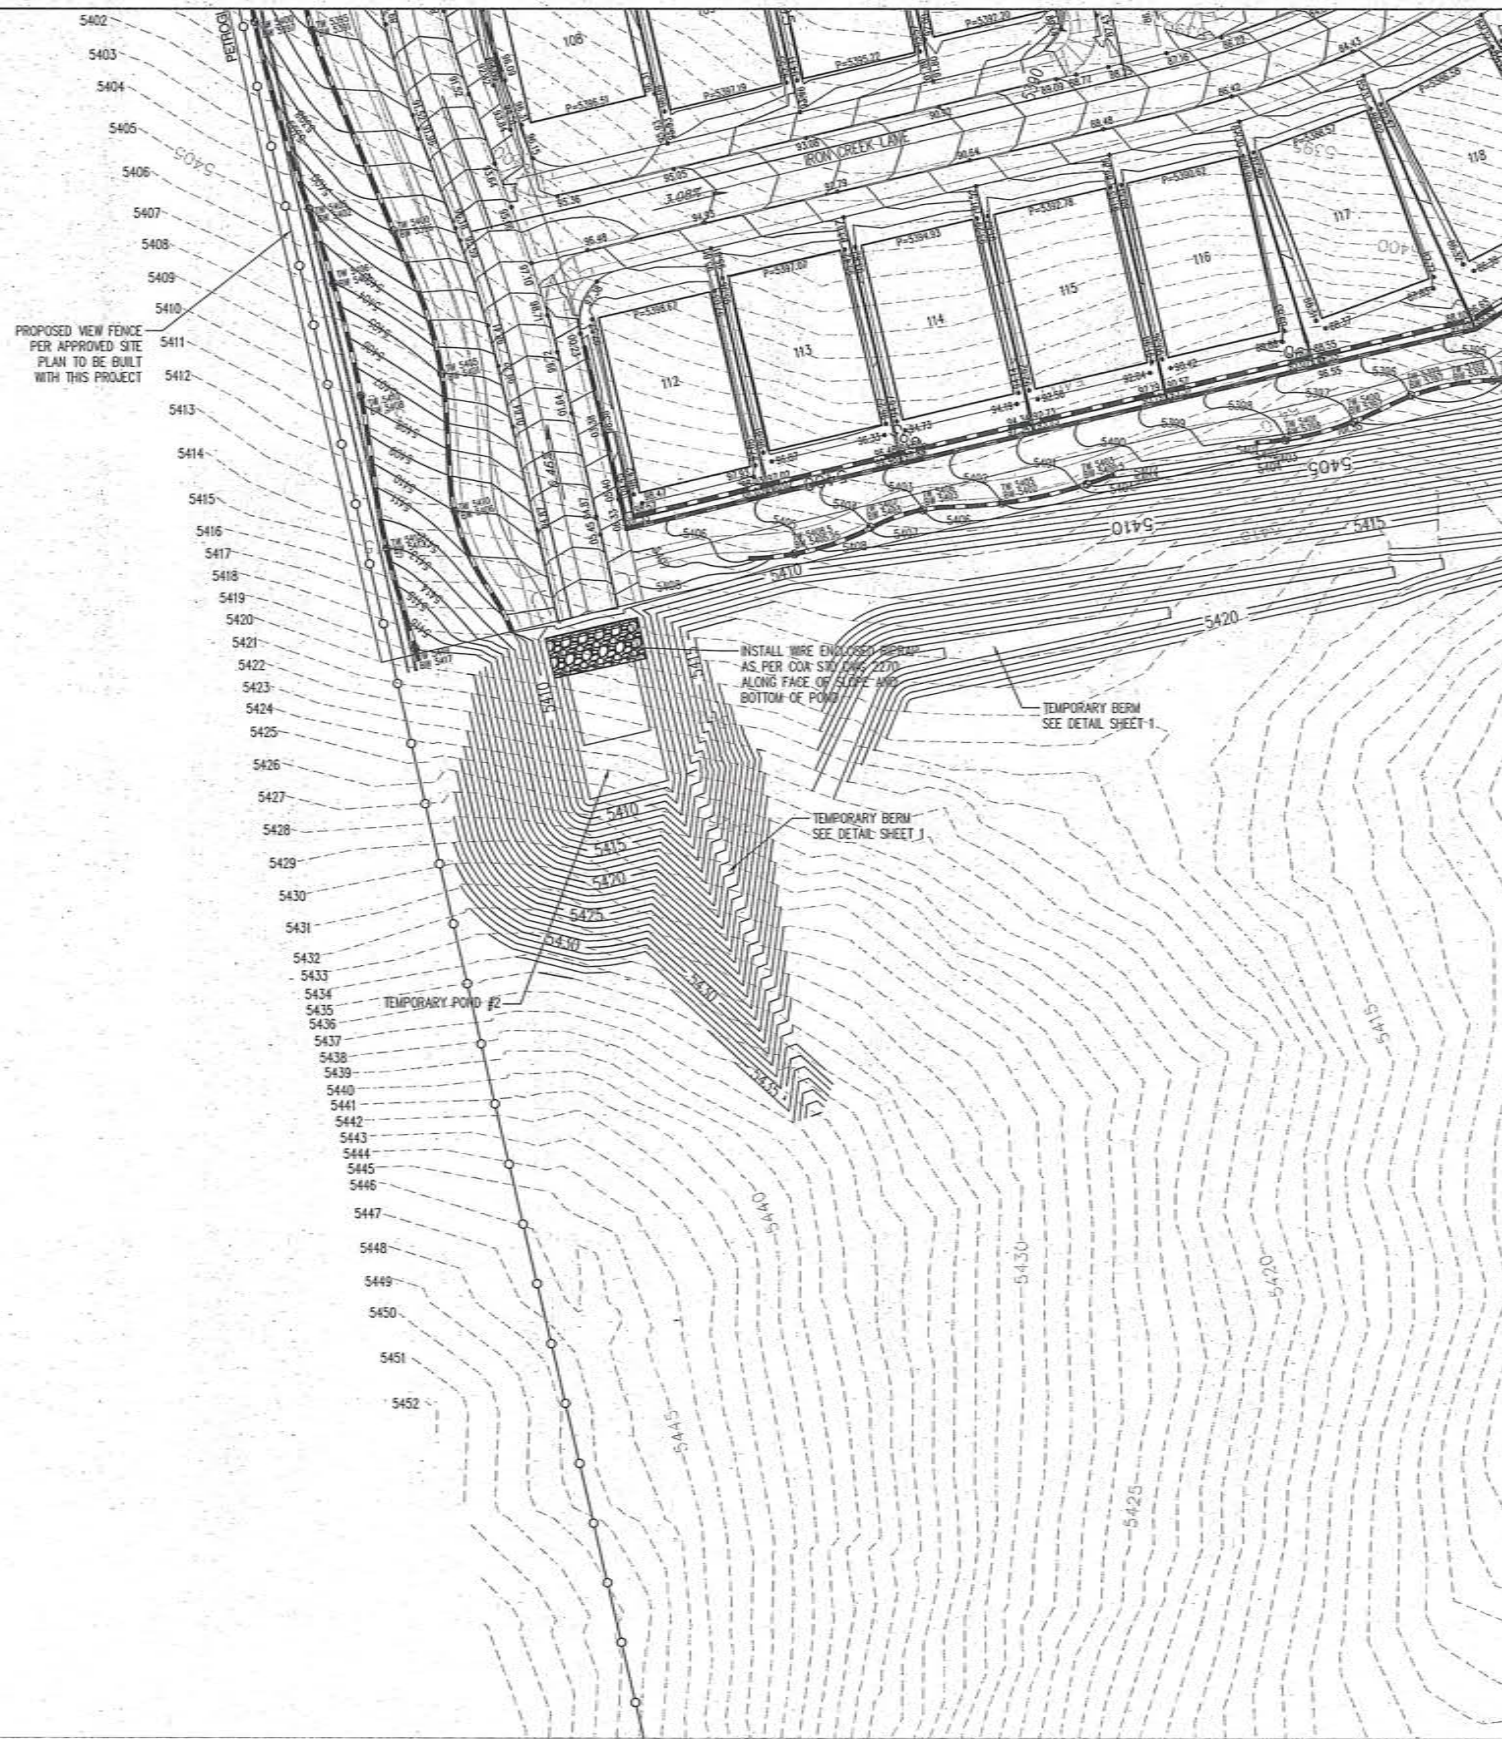

PROPOSED SPOT ELEVATION • 5235.25
EXISTING SPOT ELEVATION — EX 5235.25
PROPOSED CONTOUR — 5025
EXISTING STORM DRAIN LINE == == == ==
PROPOSED STORM DRAIN INLET □
PROPOSED STORM DRAIN LINE == == == ==
PROPOSED STORM DRAIN MANHOLE ○
PROPOSED WATER BLOCK ~~~~~
RETAINING WALL ———
PAID 10
TB P-5200.00
STREET SLOPE TURNED BLOCK
CHECK DAM (SEE SHEET 8 FOR
DETAIL) XX
WIREHAEN ARROYO EASEMENT
BOUNDARY ———



Bohannon  **Huston**
www.bhinc.com 800.877.5332



CITY OF ALBUQUERQUE
DEPARTMENT OF
MUNICIPAL DEVELOPMENT

DEL WEBB @ MIREHAVEN PHASE 1
GRADING PLAN

DESIGN REVIEW COMMITTEE	CITY ENGINEER APPROVAL	LAST DESIGN UPDATE	MO./DAY/YR.	MO./DAY/YR.	
CITY PROJECT NO.	ZONE MAP NO.	SHEET	8	OF	8

P:\20130375\CDP\Plans\General\DWI_1A\20130375GP02.dwg
Thu, 20-Mar-2014 - 8:03:am, Plotted by: AROMERO

BHI JOB NO. 20130375

