CITY OF ALBUQUERQUE



February 18, 2015

Yolanda Padilla Moyer, P.E. **Bohannan Huston Inc.** 7500 Jefferson St NE, Ctyd 1 Albuquerque, NM 87109

Re: Del Webb @ Mirehaven Phase 1a,

Pad Certification - Lots 77-80 and 118-123

Engineer's Stamp dated: 3-20-14, (H09D017C)

Certification dated: 2-6-15

Dear Ms. Padilla Moyer,

Based upon the information provided in the Certification received 2-6-15, the above referenced Certification is acceptable for Building Permit on the lots referenced above.

As previously discussed with Pulte Homes, Hydrology wishes to see continuous progress on the Mirehaven Arroyo and the shotcrete diversion channel along the western edge of the subdivision.

PO Box 1293

'If you have any questions, you can contact me at 924-3986.

Albuquerque

New Mexico 87103

www.cabq.gov

Sincerely,

Curtis A. Cherne, P.E.

Principal Engineer, Hydrology

Planning Dept.

File

C:



February 6, 2015

Courtyard I 7500 Jefferson St. NE Albuquerque, NM 87109-4335

www.bhinc.com

voice: 505.823.1000 facsimile: 505.798.7988 toll free: 800.877.5332

Mr. Curtis Cherne Hydrology Section City of Albuquerque 600 2nd Street NW Albuquerque, NM 87102

Re: Partial Grading and Drainage Certification, Del Webb @ Mirehaven Phase 1

DRB Case No. 1006864

Dear Curtis:

We are submitting a partial grading and drainage certification for Del Webb @ Mirehaven Phase 1. The partial certification includes lots 77 – 80 and 154 - 158. Enclosed for your review is the approved grading and drainage plan dated 3/11/14 and 3/20/14. These lots have been graded; retaining walls, curb and gutter, pavement and downstream infrastructure have been constructed. The remaining lots have been graded, but the retaining walls have not been completed. The remaining lots will be certified once construction of all improvements has been completed

After reviewing these as-built elevations and visiting the site on 2/5/15 and 2/6/15 it is my belief that the above lots have been graded in substantial compliance with the approved grading and drainage plan and that the interim drainage improvements allow runoff to be managed in the interim condition.

Your review and approval is requested for Building Permit Approval for the above listed buildings. I appreciate your time and consideration. If you have questions or require additional information, please contact me at 823-1000.

Sincerely,

Yolanda Padilla Moyer, P.E. Senior Project Manager

Community Development & Planning

Enclosure


cc: Peter Steen, Pulte Homes


Kevin Patton, Pulte Homes


Engineering A

Spatial Data

Advanced Technologies

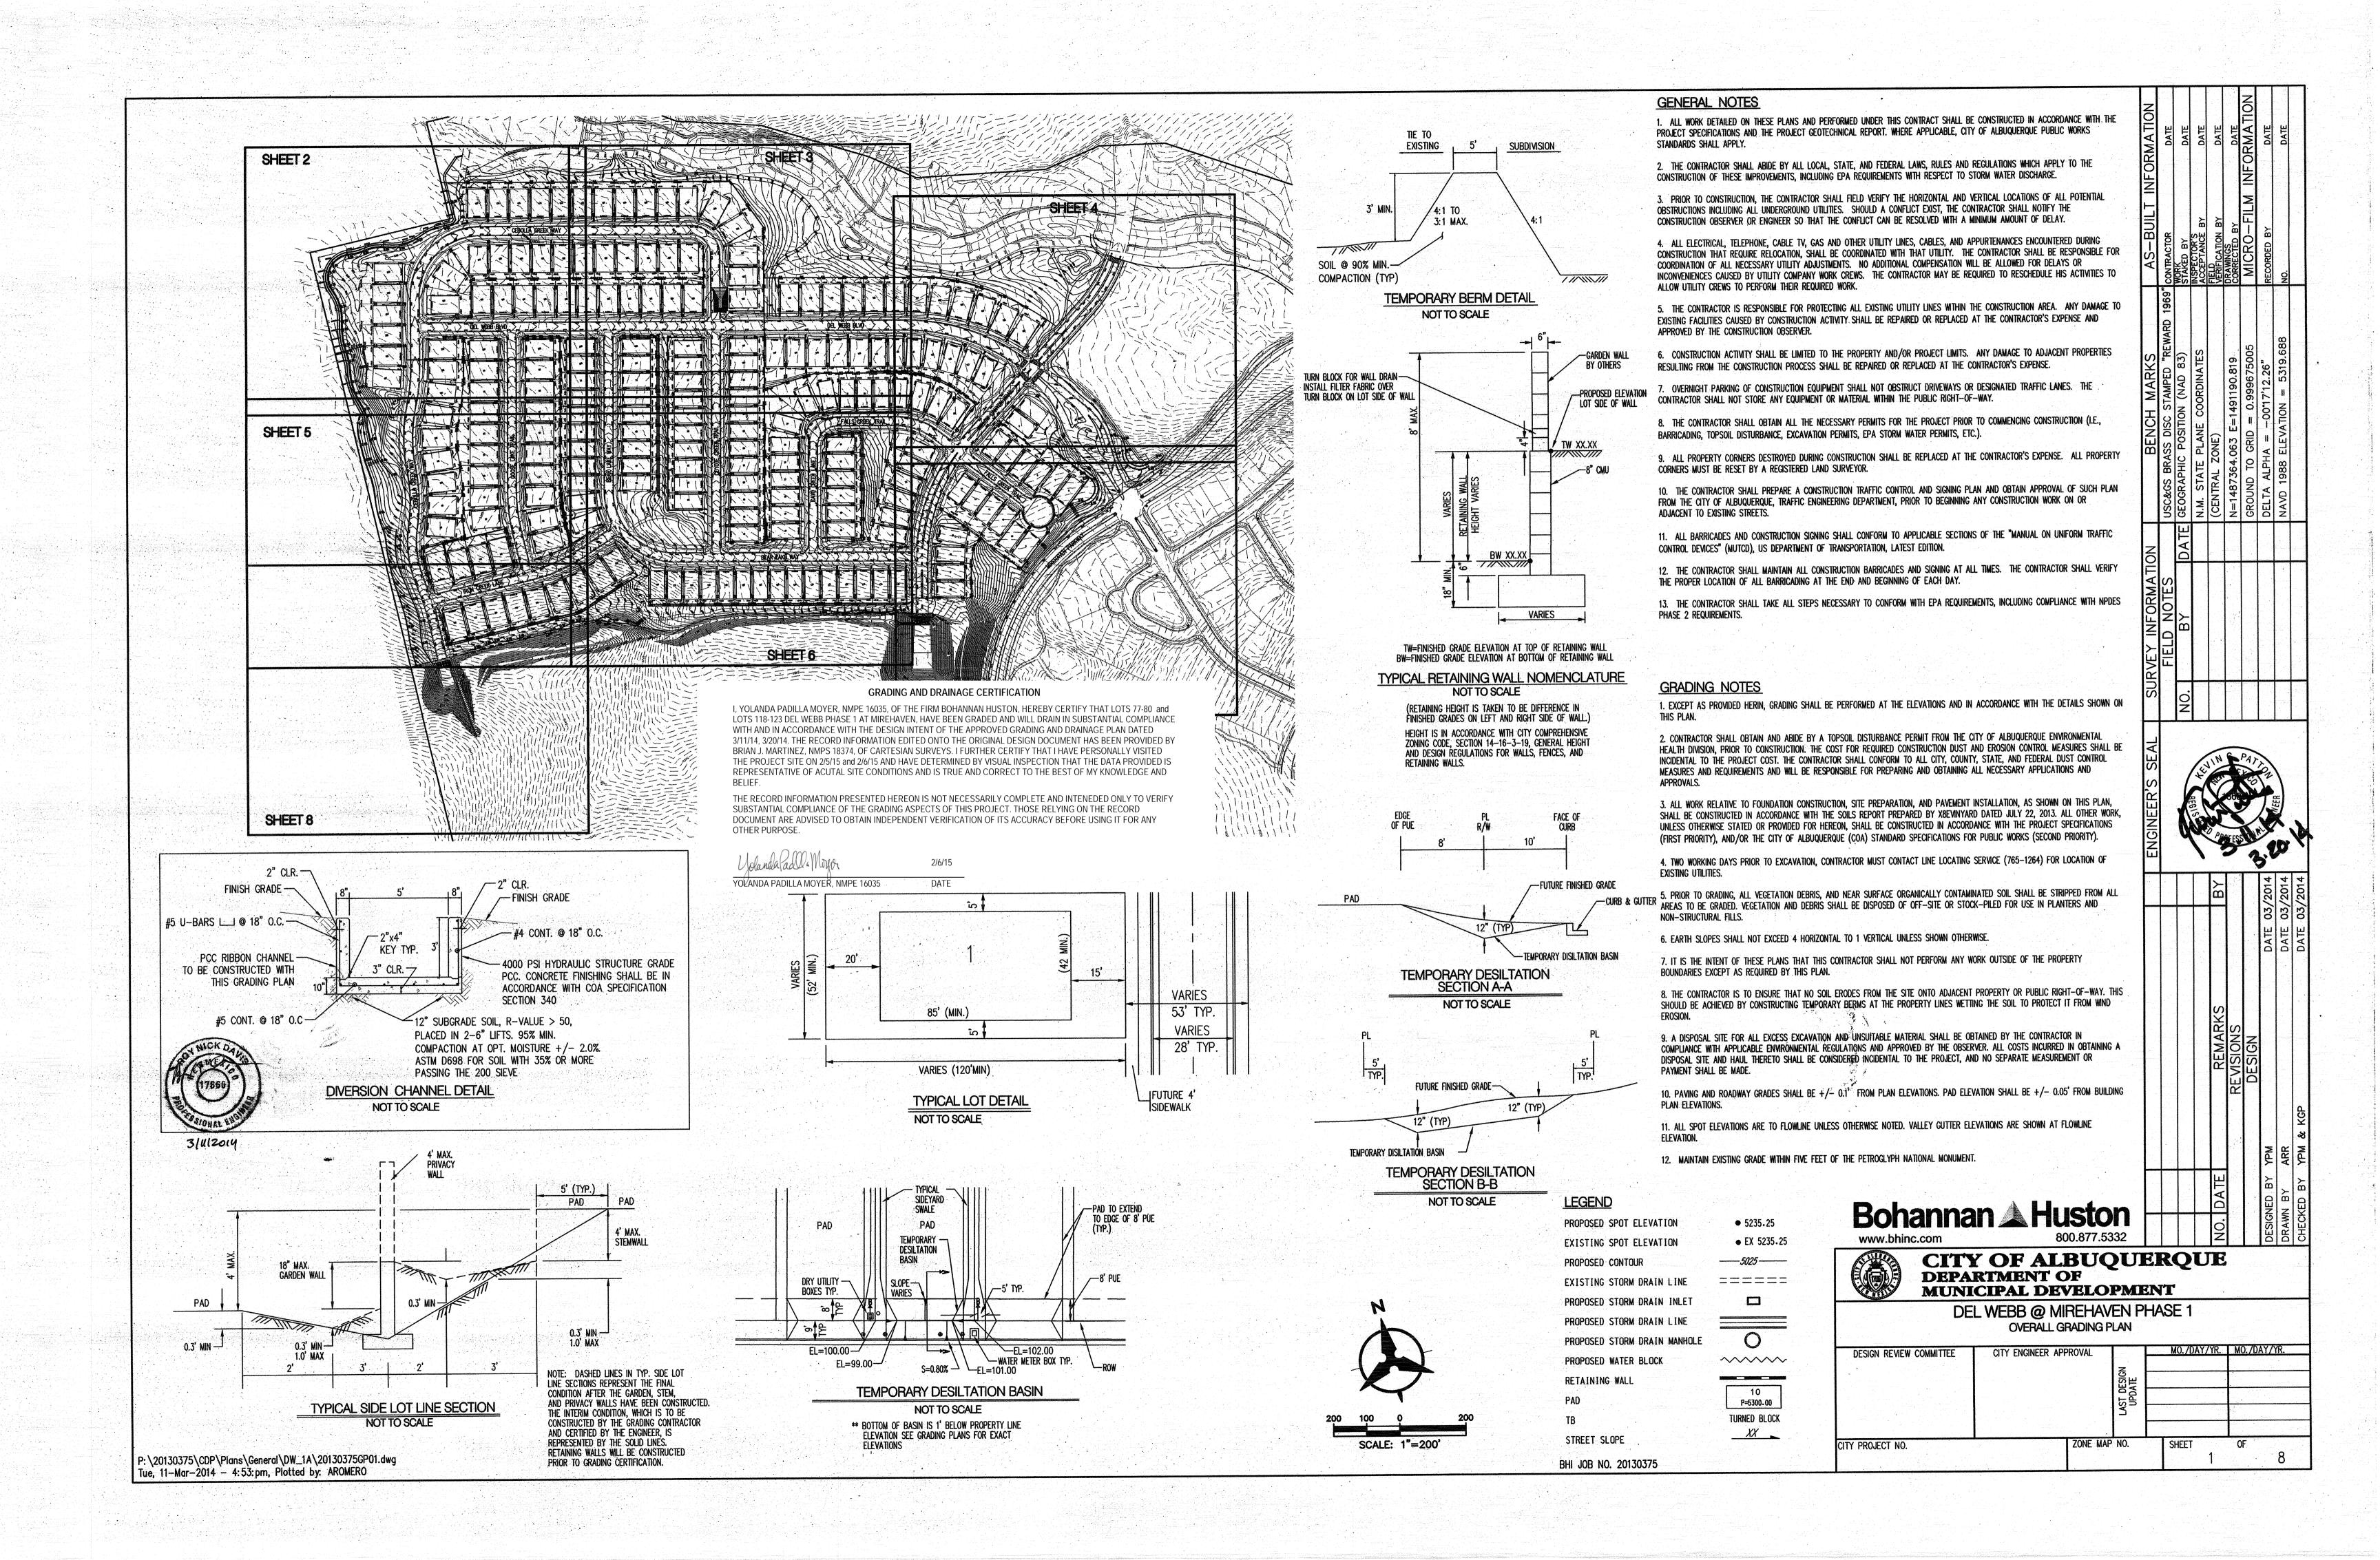

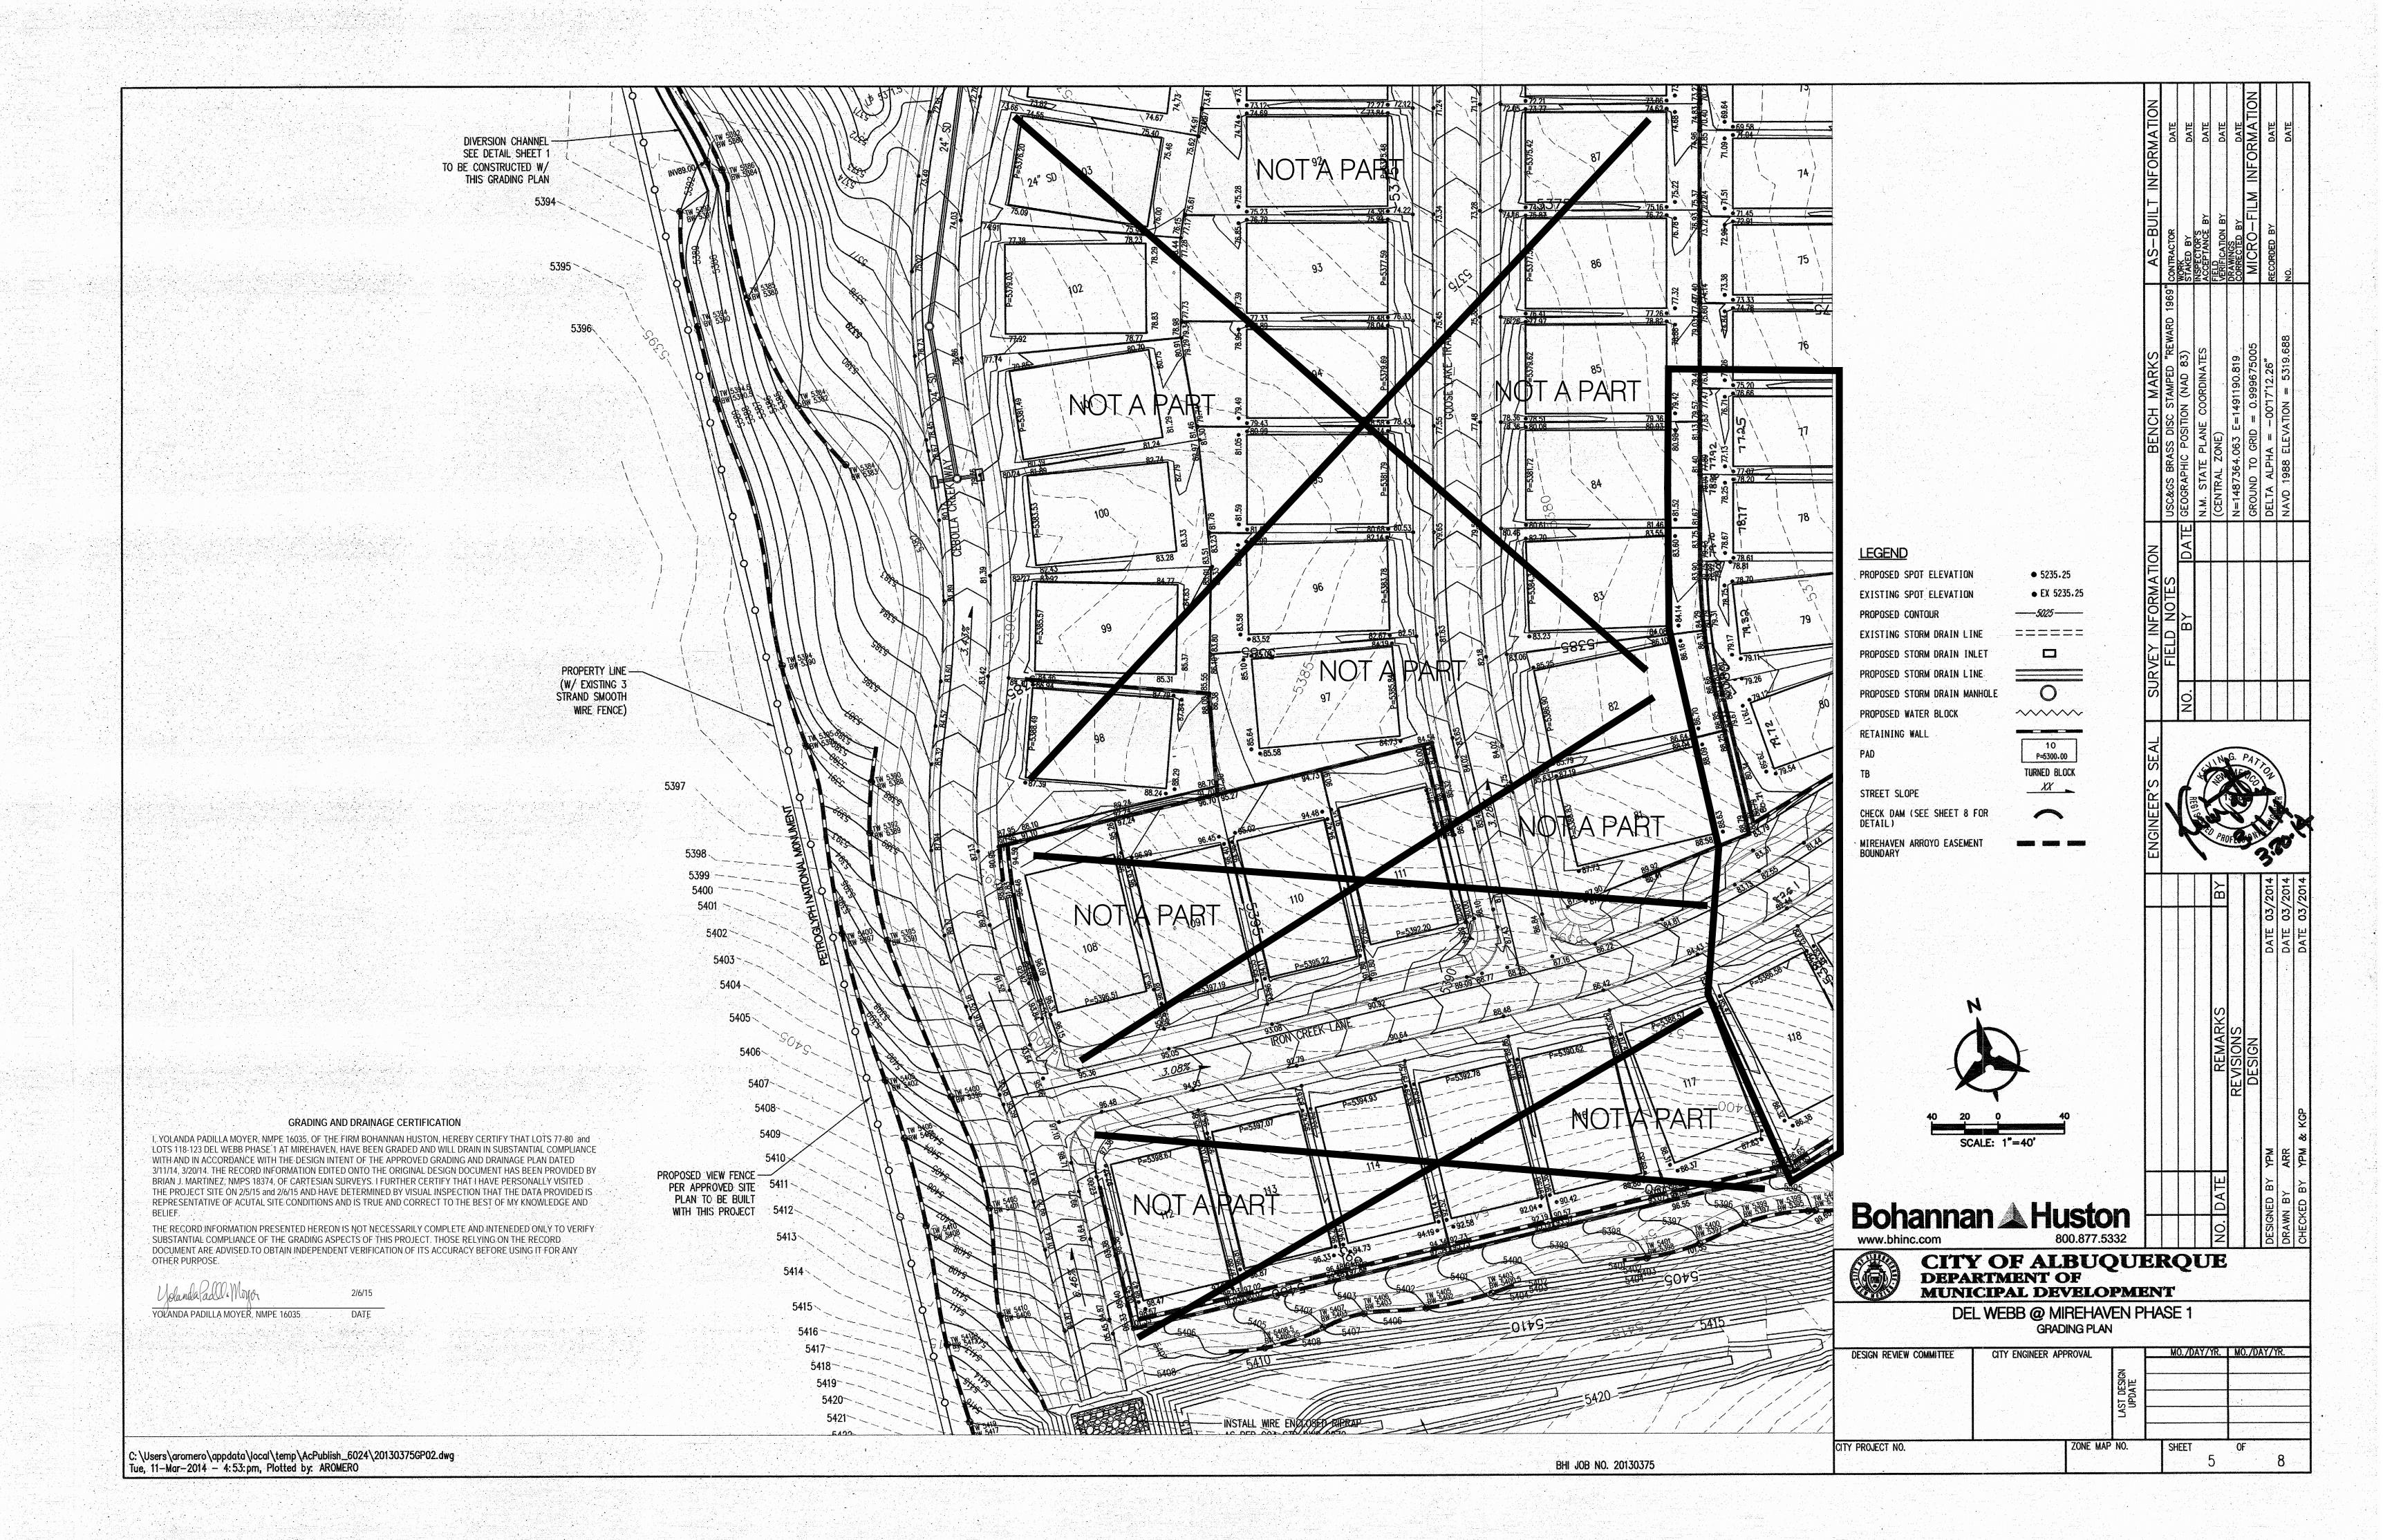

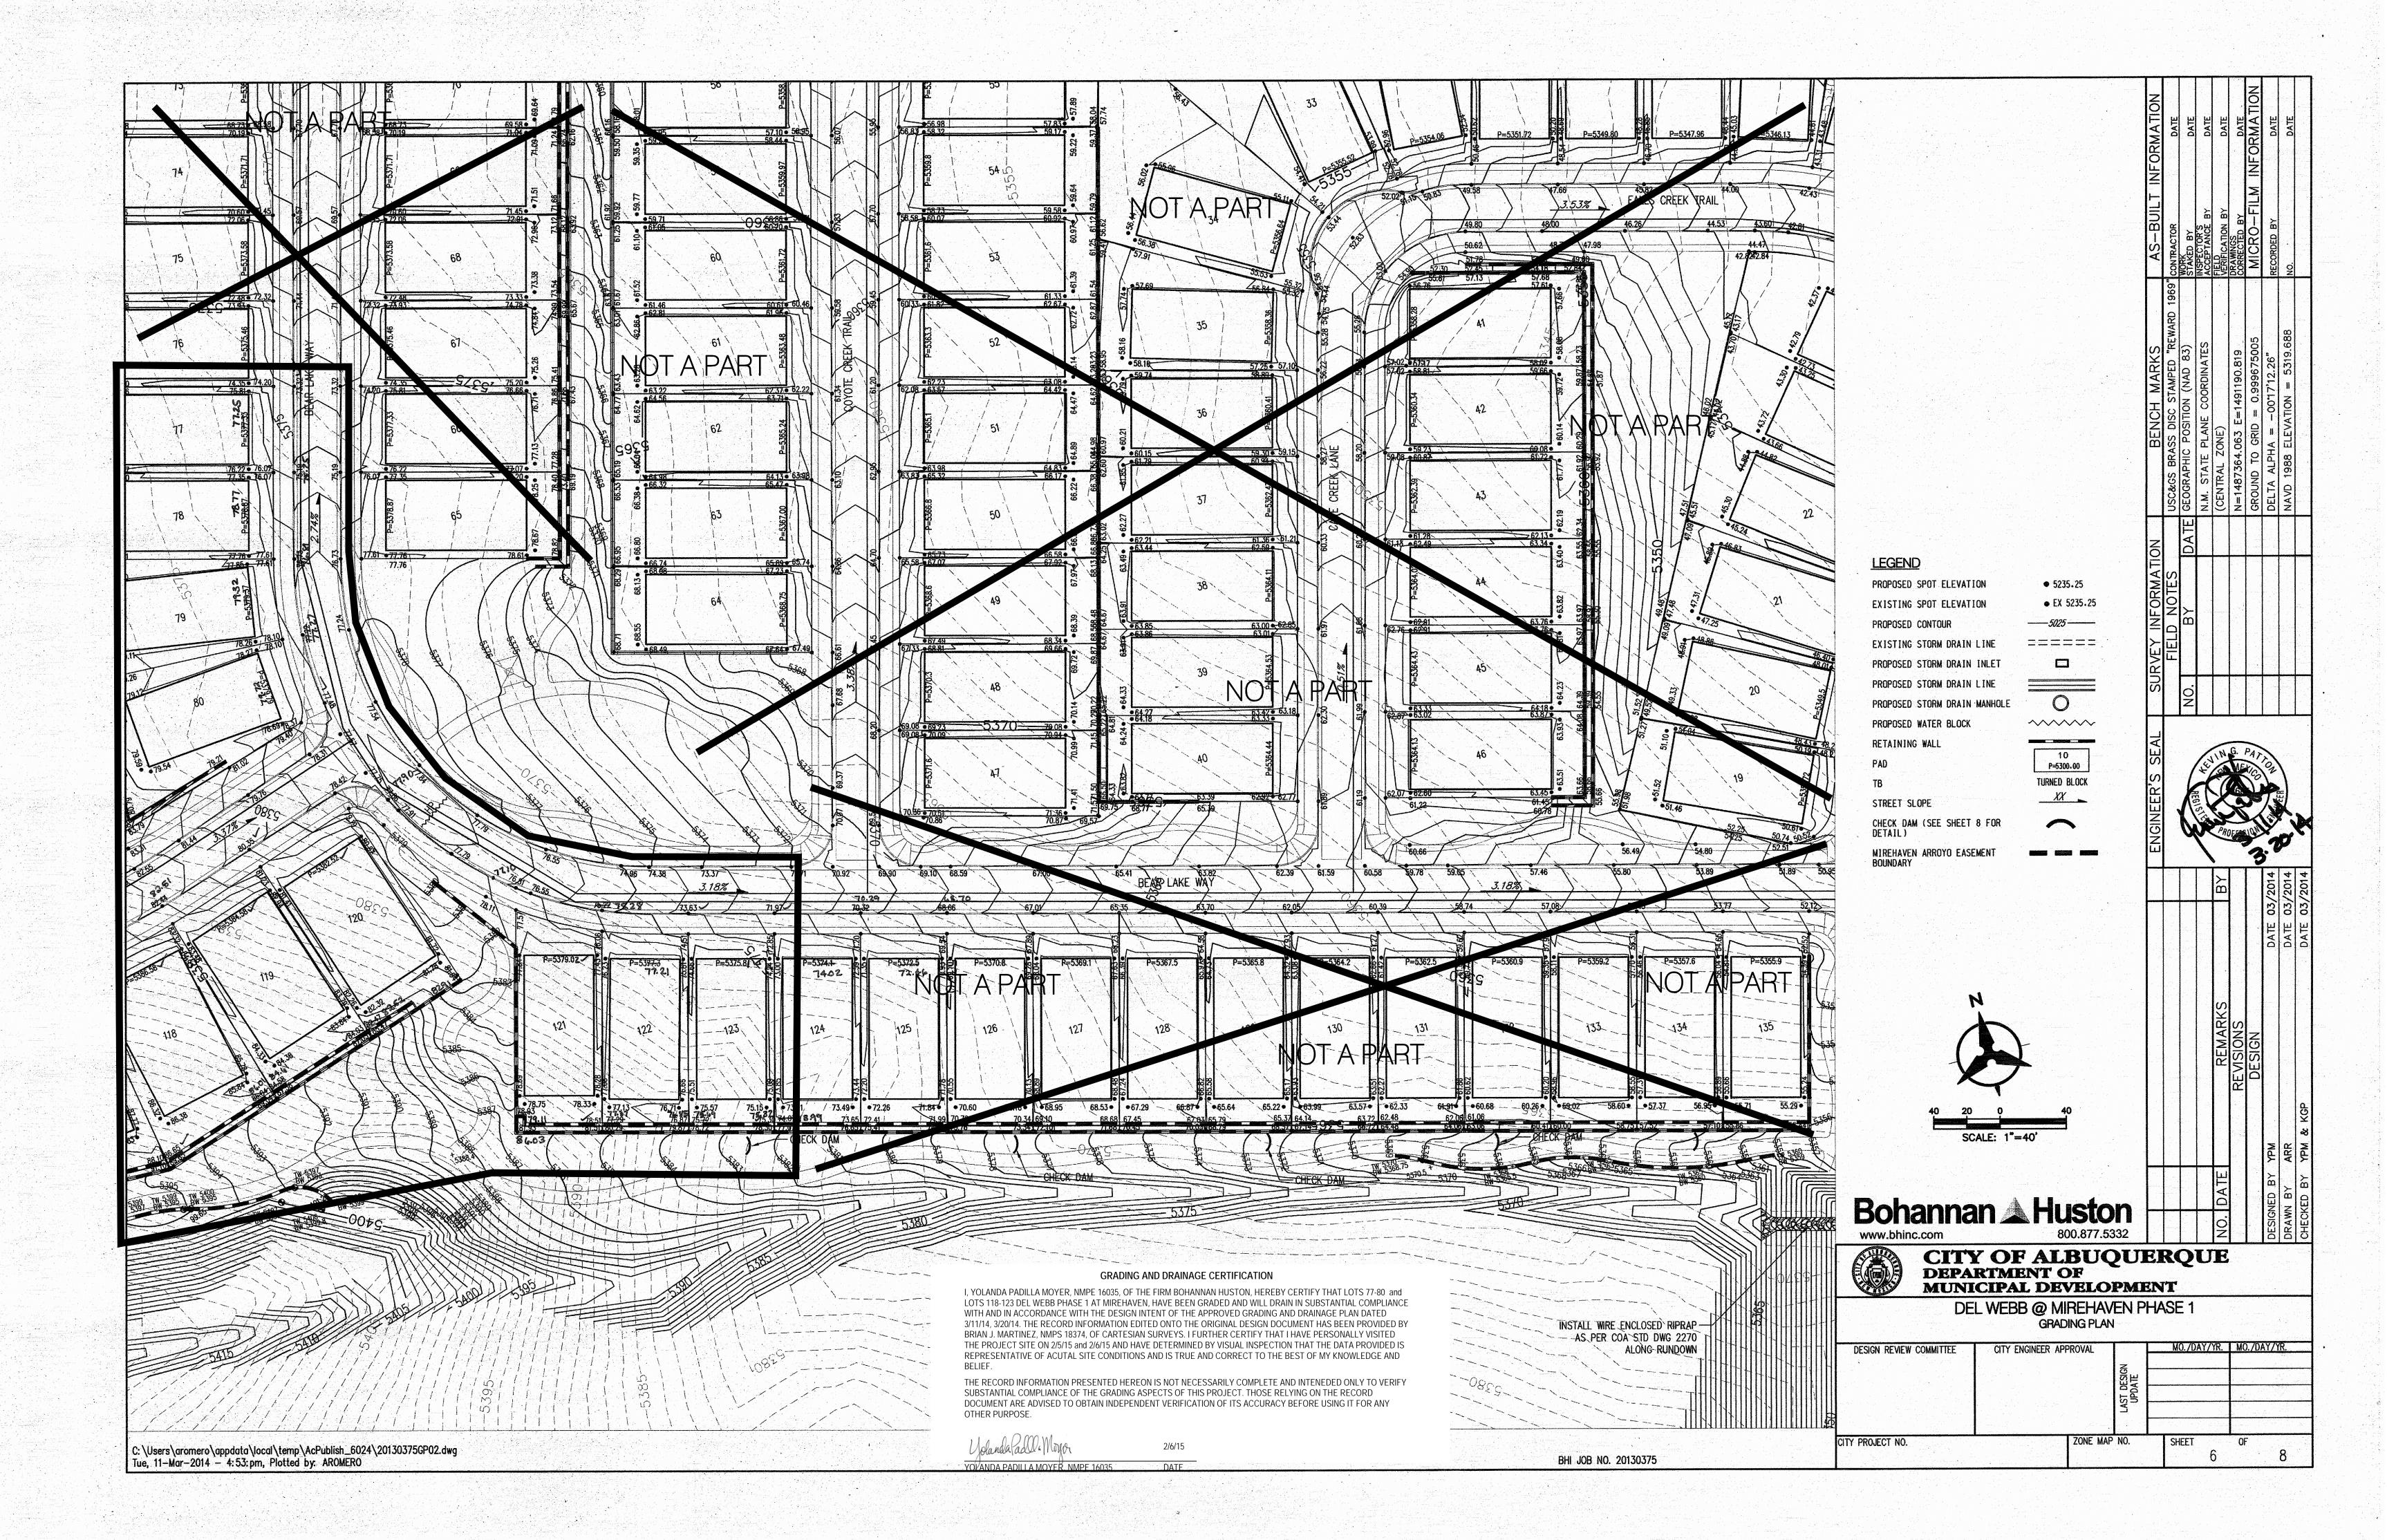



Project Title:

City of Albuquerque

Planning Department

Development & Building Services Division

DRAINAGE AND TRANSPORTATION INFORMATION SHEET

(REV 02/2013)

Building Permit #: ____ City Drainage #: _

DRB#: EPC#:	Work Order#:
Legal Description:	
City Address:	
Engineering Firm:	Contact:
Address:	
	E-mail:
Owner:	Contact:
Address:	
Phone#: Fax#:	E-mail:
Architect:	Contact:
Address:	
Phone#: Fax#:	E-mail:
Surveyor:	Contact:
Address:	
Phone#: Fax#:	E-mail:
Contractor:	Contact:
Address:	
Phone#: Fax#:	E-mail:
TYPE OF SUBMITTAL:	CHECK TYPE OF APPROVAL/ACCEPTANCE SOUGHT:
DRAINAGE REPORT	SIA/FINANCIAL GUARANTEE RELEASE
DRAINAGE PLAN 1st SUBMITTAL	PRELIMINARY PLAT APPROVAL
DRAINAGE PLAN RESUBMITTAL	S. DEV. PLAN FOR SUB'D APPROVAL
CONCEPTUAL G & D PLAN	S. DEV. FOR BLDG. PERMIT APPROVAL
GRADING PLAN	SECTOR PLAN APPROVAL
EROSION & SEDIMENT CONTROL PLAN (ESC)	FINAL PLAT APPROVAL
ENGINEER'S CERT (HYDROLOGY)	CERTIFICATE OF OCCUPANCY (PERM)
CLOMR/LOMR	CERTIFICATE OF OCCUPANCY (TCL TEMP)
TRAFFIC CIRCULATION LAYOUT (TCL)	FOUNDATION PERMIT APPROVAL
ENGINEER'S CERT (TCL)	BUILDING PERMIT APPROVAL
ENGINEER'S CERT (DRB SITE PLAN)	GRADING PERMIT APPROVAL SO-19 APPROVAL
ENGINEER'S CERT (ESC)	PAVING PERMIT APPROVAL ESC PERMIT APPROVAL
SO-19	WORK ORDER APPROVAL ESC CERT. ACCEPTANCE
OTHER (SPECIFY)	GRADING CERTIFICATION OTHER (SPECIFY)
ROUGH GRADING	
WAS A PRE-DESIGN CONFERENCE ATTENDED:	Yes Copy Provided
DATE SUBMITTED:	By:

Requests for approvals of Site Development Plans and/or Subdivision Plats shall be accompanied by a drainage submittal. The particular nature, location, and scope to the proposed development defines the degree of drainage detail. One or more of the following levels of submittal may be required based on the followin

- 1. Conceptual Grading and Drainage Plan: Required for approval of Site Development Plans greater than five (5) acres and Sector Plans
- Drainage Plans: Required for building permits, grading permits, paving permits and site plans less than five (5) acres
- Drainage Report: Required for subdivision containing more than ten (10) lots or constituting five (5) acres or more
- Erosion and Sediment Control Plan: Required for any new development and redevelopment site with 1-acre or more of land disturbing area, including project less than 1-acre than are part of a larger common plan of development