CITY OF ALBUQUERQUE

July 10, 2018



Yolanda Padilla-Moyer, PE Bohannan-Huston 7500 Jefferson St NE Courtyard I Albuquerque, NM 87109

Re:

Del Webb @ Mirehaven 2B

Pad Certification for lots 122-124, 139-141, 143-144, 151-152

Engineer's Stamp dated: 3-11-16 (H09D017F)

Certification dated: 6-27-18

Dear Ms. Padilla-Moyer,

Based on the Certifications received 7/9/18, the above referenced Certification for the above mentioned is acceptable for building permit by Hydrology.

If you have any questions, you can contact me at 924-3986 or Totten Elliott at 924-3982.

PO Box 1293

Sincerely,

Albuquerque

James D. Hughes, P.E.


Principal Engineer, Planning Dept. Development and Review Services


NM 87103


TE/JH

www.cabq.gov

C: email

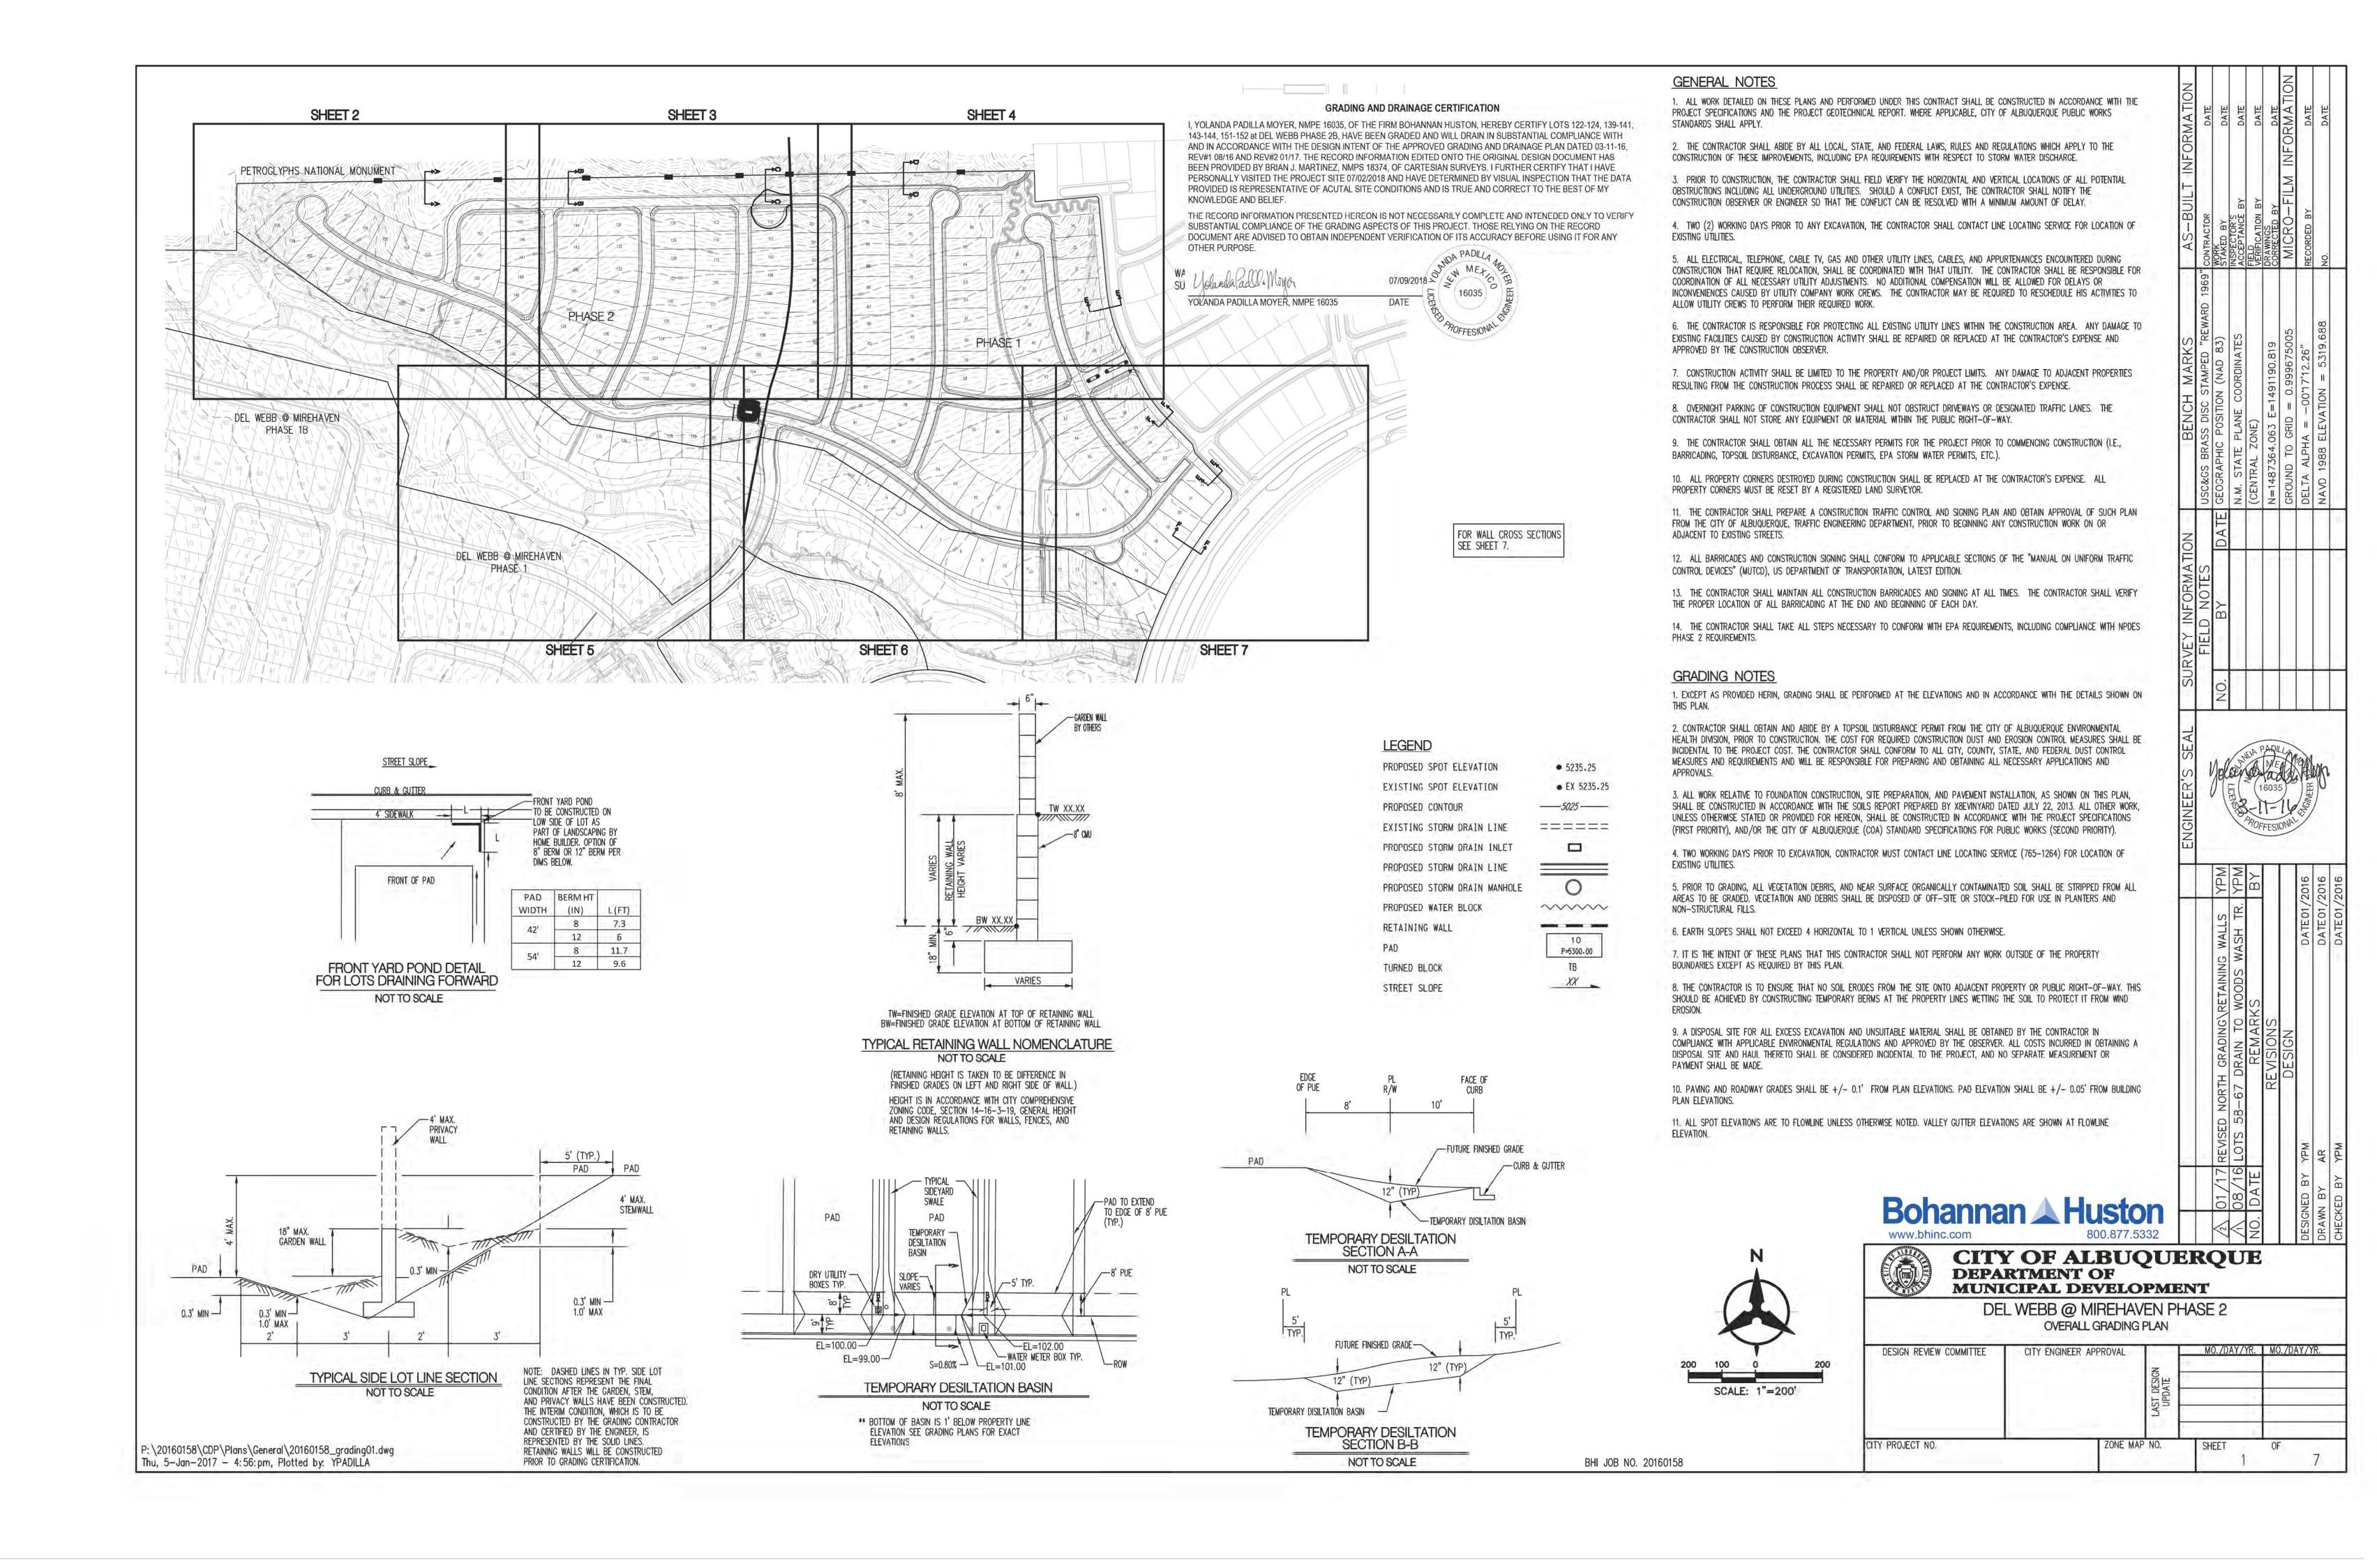

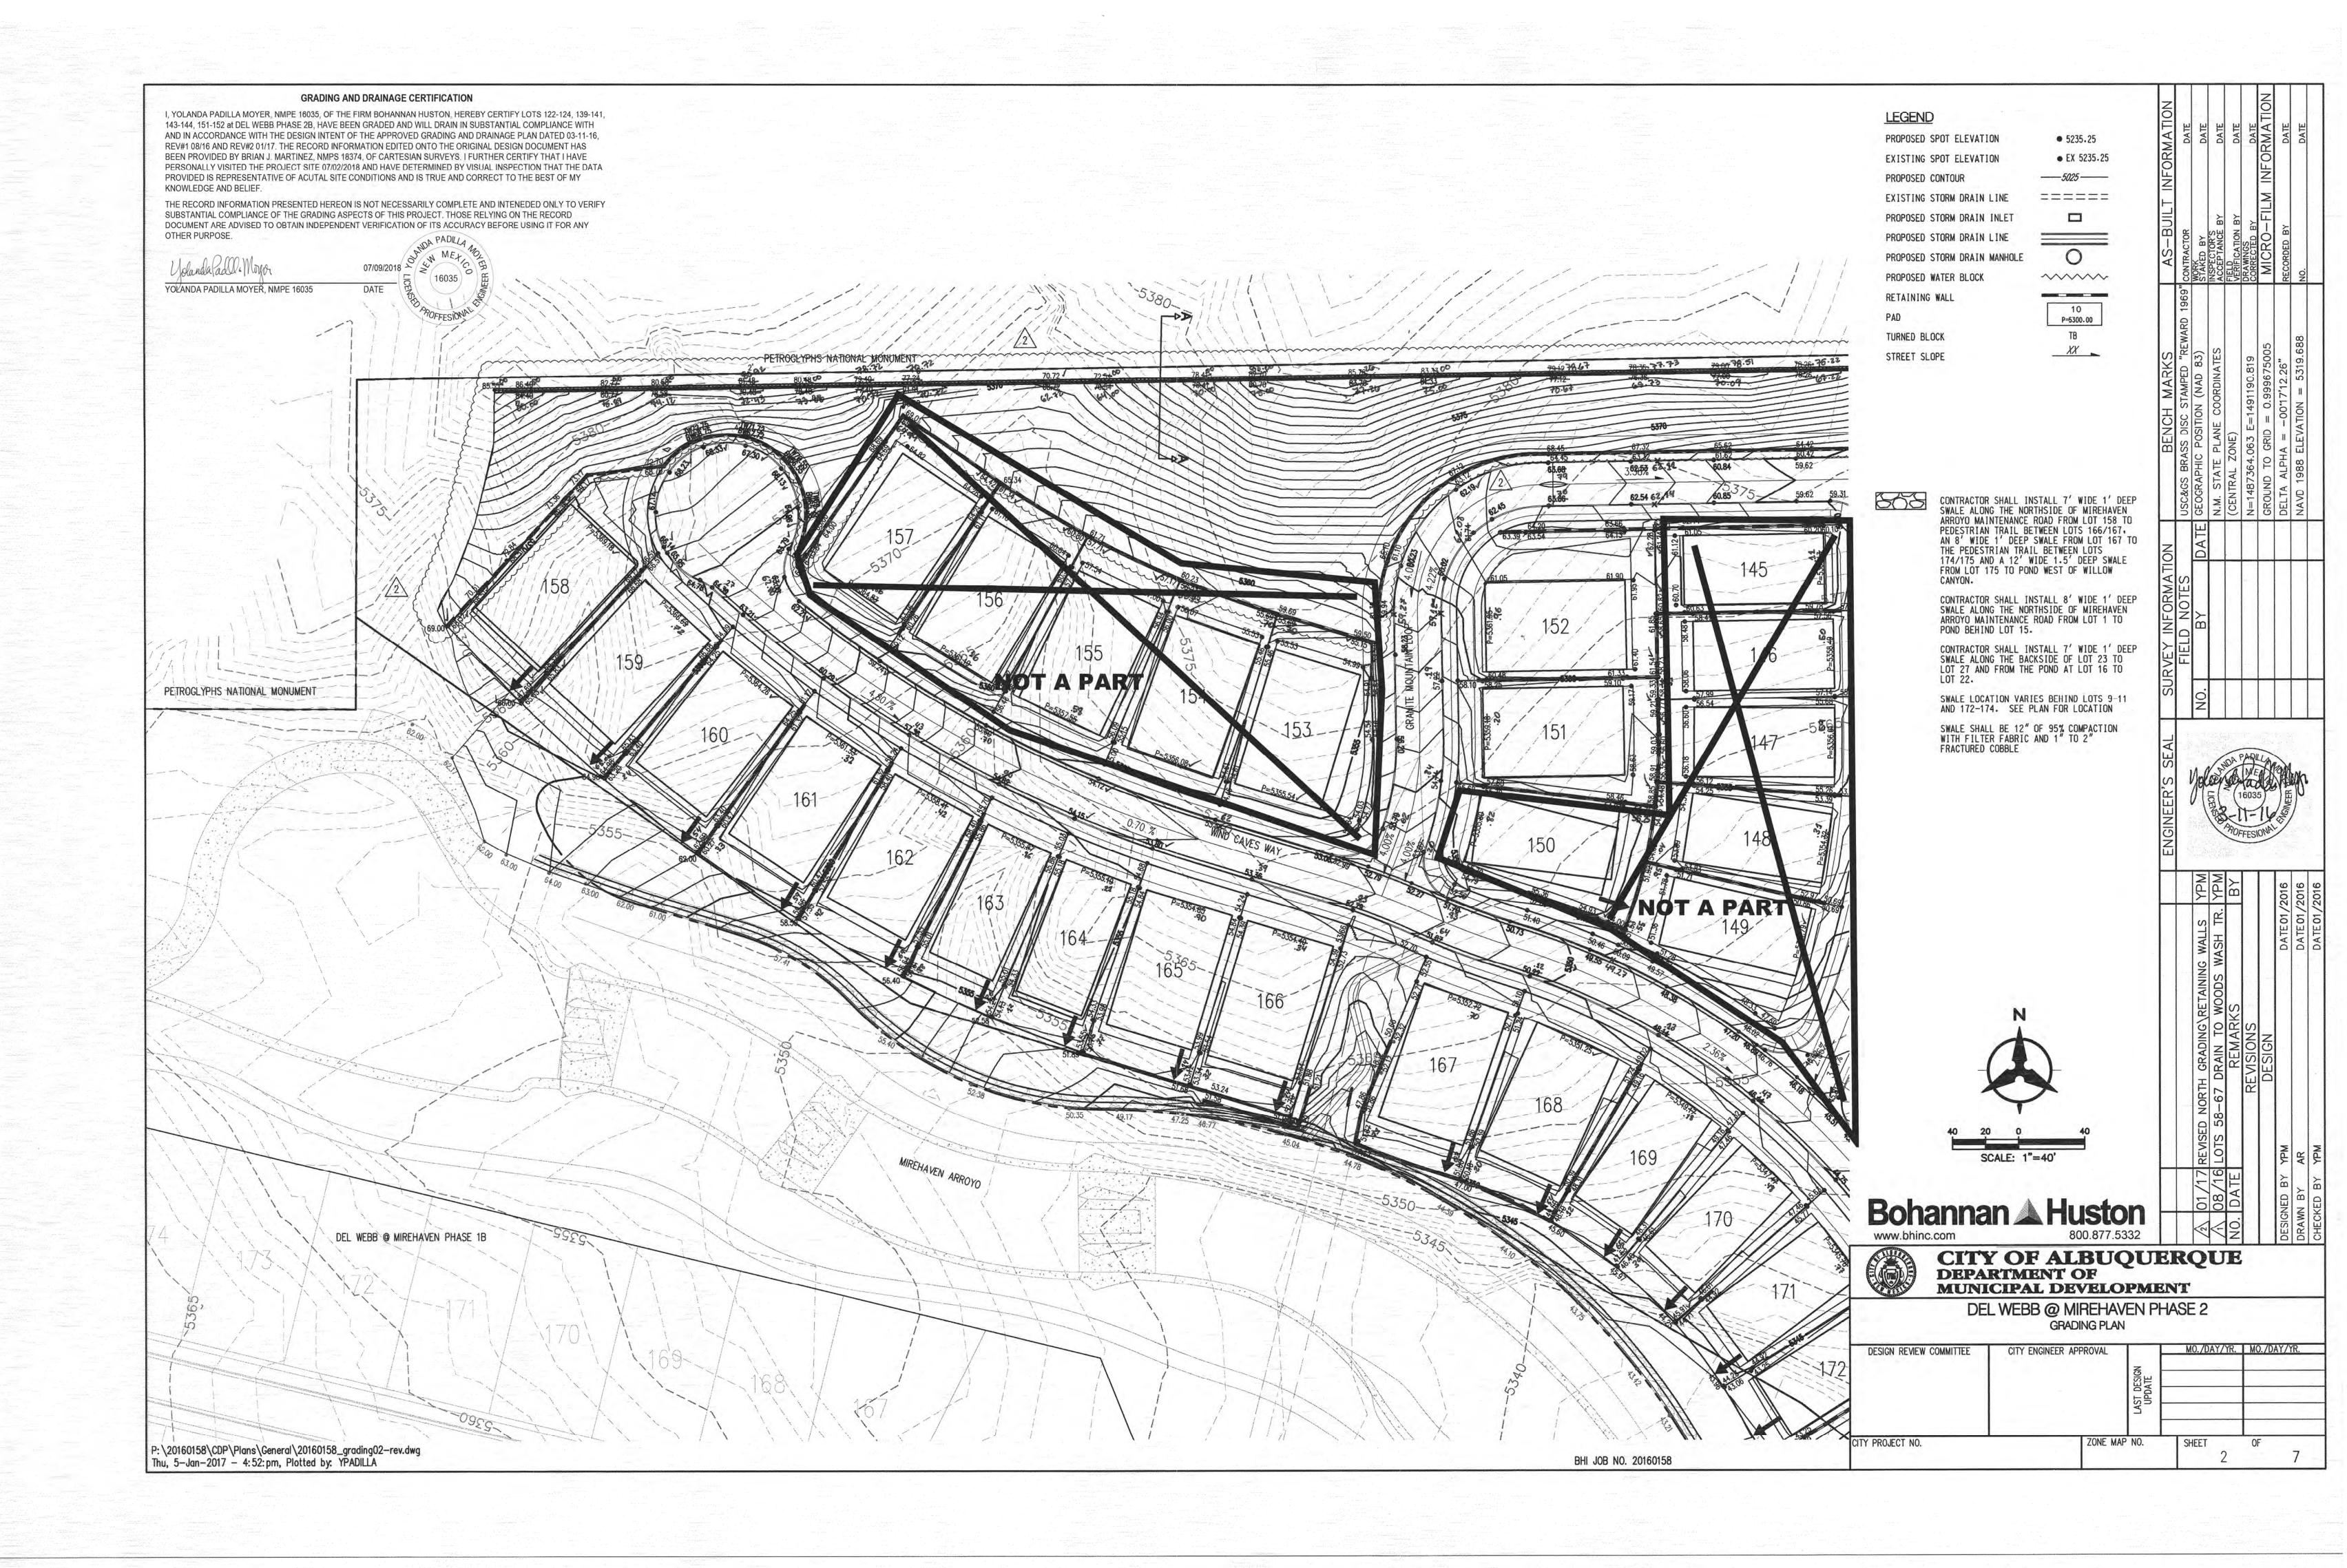

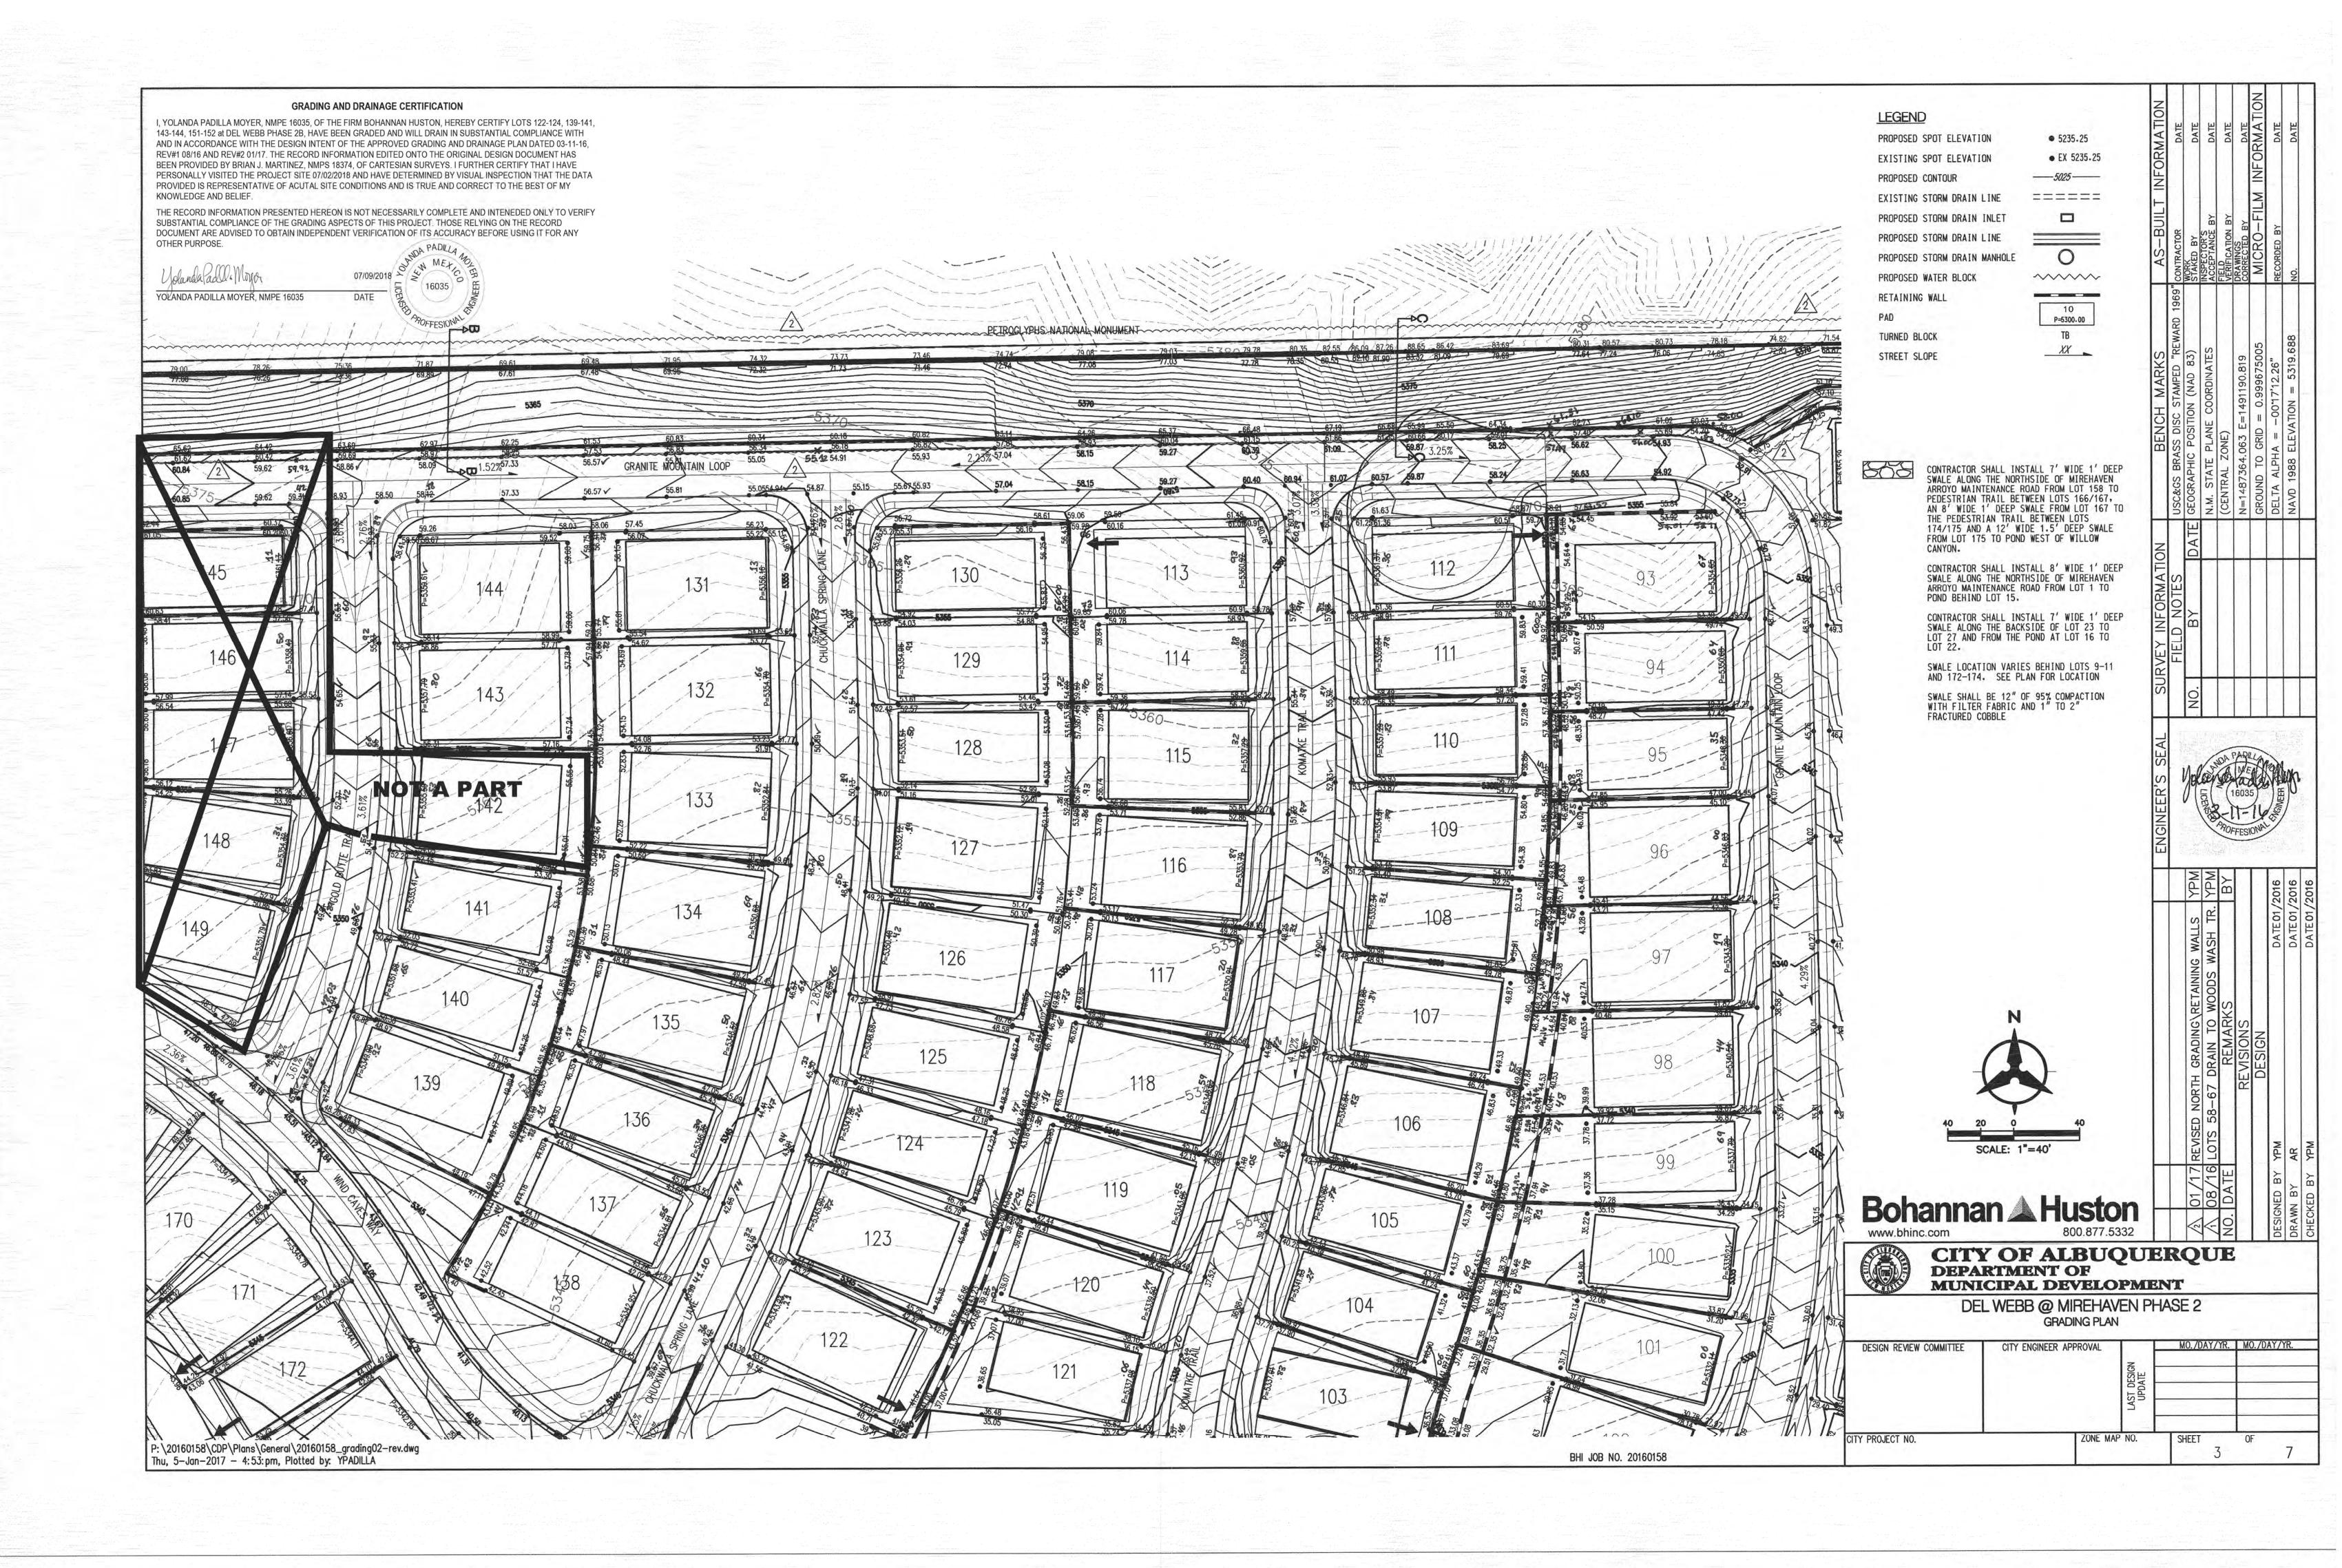



July 9, 2018

Courtyard I 7500 Jefferson St. NE Albuquerque, NM 87109-4335

www.bhinc.com

voice: 505.823.1000 facsimile: 505.798.7988 toll free: 800.877.5332

Mr. Dana Peterson Hydrology Section City of Albuquerque 600 2nd Street NW Albuquerque, NM 87102

Re: Partial Grading and Drainage Certification (Lots 122-124, 139-141, 143-144, 151-152) Del

Webb @ Mirehaven Phase 2B - DRB Case No. 1006864

Dear Dana:

We are submitting a partial grading and drainage certification for Del Webb @ Mirehaven Phase 2B. The partial certification includes Lots 122-124, 139-141, 143-144, 151-152. Enclosed for your review is the approved grading and drainage plan dated 03/11/16, rev #1 08/16, rev#2 01/17. These lots have been graded; retaining walls, curb and gutter, pavement and downstream infrastructure have been constructed. The remaining lots have been graded, but the retaining walls have not been completed. The remaining lots will be certified once construction of all improvements has been completed.

After reviewing these as-built elevations and visiting the site on 07-02-18. It is my belief that the above lots have been graded in substantial compliance with the approved grading and drainage plan and that the interim drainage improvements allow runoff to be managed in the interim condition.

Your review and approval is requested for Building Permit Approval for the above listed buildings. I appreciate your time and consideration. If you have questions or require additional information, please contact me at 823-1000.

Sincerely,

Yŏlanda Padilla Moyer, P.E. Senior Proiect Manager

Community Development & Planning

Enclosure

cc: Kevin Patton, Pulte Homes

Engineering A

Spatial Data

Advanced Technologies A



City of Albuquerque

Planning Department

Development & Building Services Division

DRAINAGE AND TRANSPORTATION INFORMATION SHEET (REV 3/2018)

		t #: Hydrology File #: H-9
		Work Order#: 650480
Legal Description: Del Webb Phase 2B	at Mirehaven	
City Address:	The state of the s	
		Contact: Yolanda Moyer
Address: 7500 JEFFERSON ST NE COUR	TYARD 1 ALBUQUERQUE	NM 87109
Phone#: 798-7945	Fax#: 798-7988	E-mail: ypadilla@bhinc.com
Other Contact:		Contact:
Address:		
		E-mail:
Check all that Apply: DEPARTMENT:	1.150	IS THIS A RESUBMITTAL?: Yes No
* HYDROLOGY/ DRAINAGE TRAFFIC/ TRANSPORTATION TYPE OF SUBMITTAL: * ENGINEER/ARCHITECT CERTIFICATION CONCEPTUAL G & D PLAN GRADING PLAN		TYPE OF APPROVAL/ACCEPTANCE SOUGHT: BUILDING PERMIT APPROVAL CERTIFICATE OF OCCUPANCY PRELIMINARY PLAT APPROVAL SITE PLAN FOR SUB'D APPROVAL SITE PLAN FOR BLDG. PERMIT APPROVAL FINAL PLAT APPROVAL SIA/ RELEASE OF FINANCIAL GUARANTEE FOUNDATION PERMIT APPROVAL GRADING PERMIT APPROVAL SO-19 APPROVAL PAVING PERMIT APPROVAL * GRADING/ PAD CERTIFICATION (10 Lots) WORK ORDER APPROVAL CLOMR/LOMR FLOODPLAIN DEVELOPMENT PERMIT OTHER (SPECIFY)
DATE SUBMITTED: 07-09-2018	By: YOLANDA	A PADILLA MOYER, P.E.

FEE PAID:____