## CITY OF ALBUQUERQUE



August 13, 2019

Yolanda Padilla-Moyer, PE Bohannan-Huston 7500 Jefferson St NE Courtyard I Albuquerque, NM 87109

## Re: Del Webb @ Mirehaven 3A Pad Certification for lots 1-3, 7-9, 65-72 Engineer's Stamp dated: 7-9-18 (H09D017G) Certification dated: 8-12-19

Dear Ms. Padilla-Moyer,

Based on the Certifications received 8/12/19, the above referenced Certification for the above mentioned is acceptable for building permit by Hydrology. The Certificate of Occupancy will be issued only upon completion of the infrastructure.

If you have any questions, you can contact me at 924-3999 or Totten Elliott at 924-3982.

PO Box 1293

Albuquerque

NM 87103


Shahab Biazar, P.E.
City Engineer, Planning Dept.
Development and Review Services

www.cabq.gov

TE/SB C: email

Sincerely,

Albuquerque - Making History 1706-2006

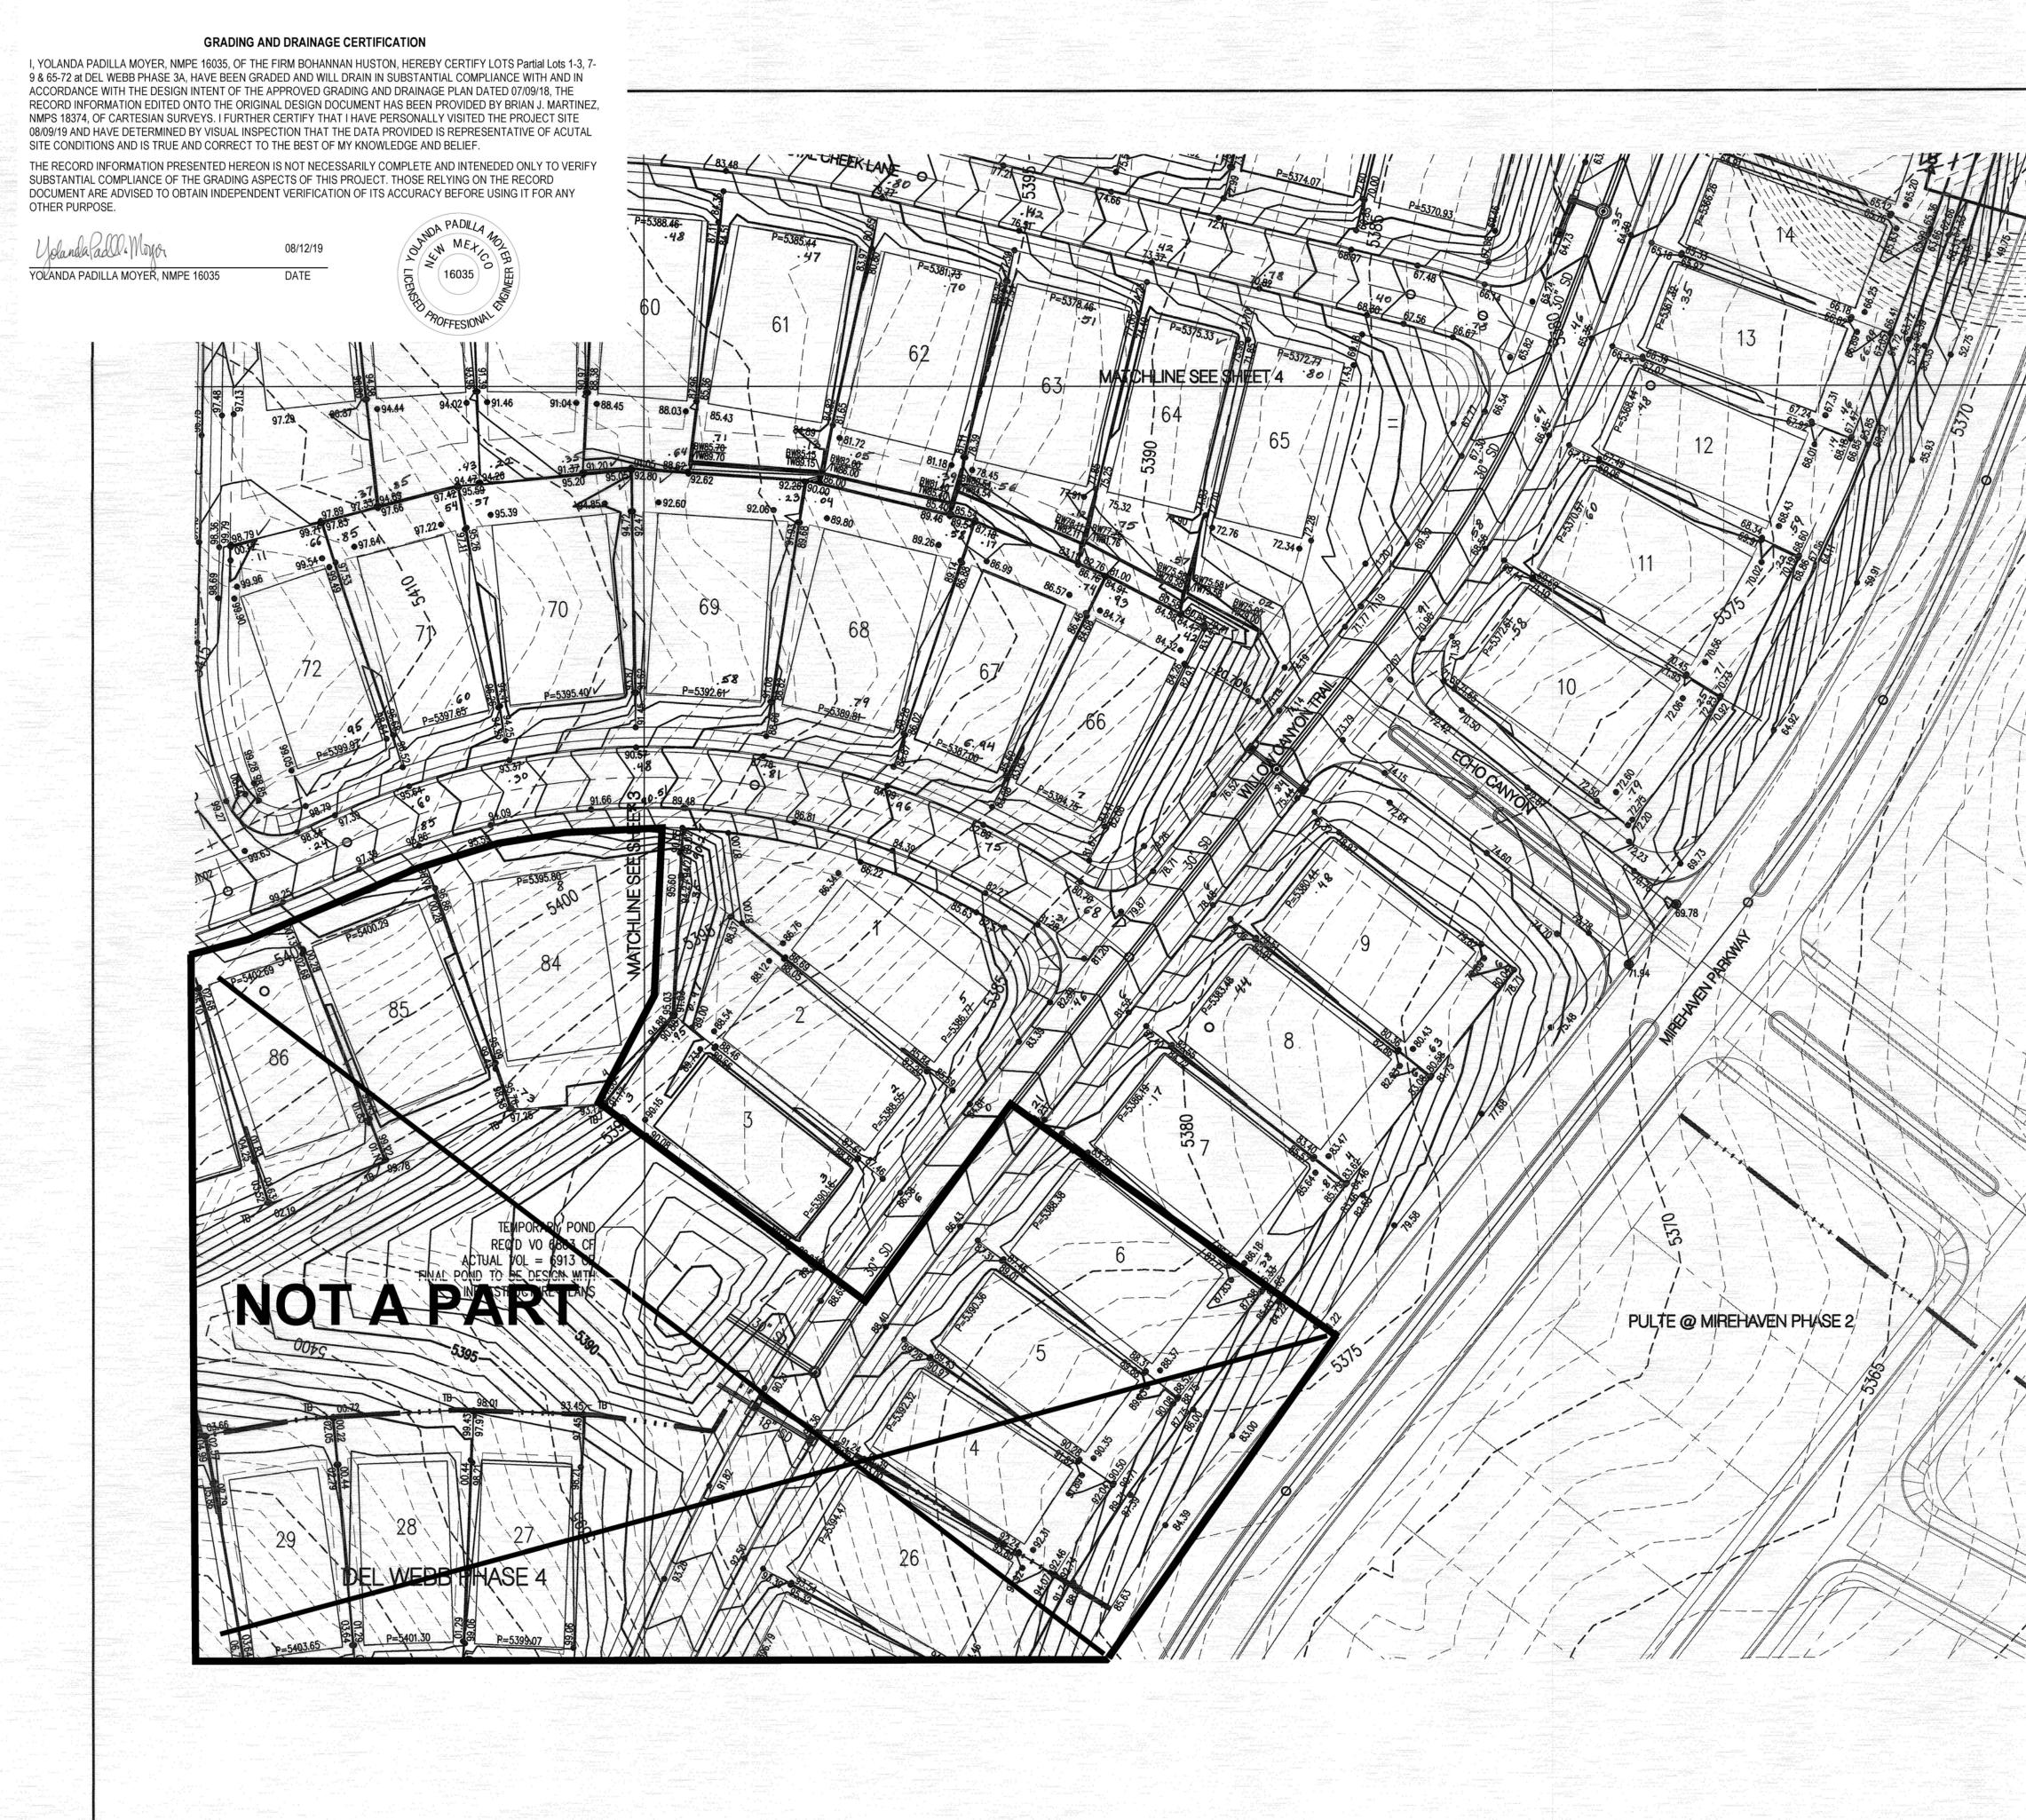

			TION T	<u></u> Ш Ш		DATE DATE DATE	
	LEGEND PROPOSED SPOT ELEVATION EXISTING SPOT ELEVATION PROPOSED CONTOUR EXISTING STORM DRAIN LINE	• 5235.25 • EX 5235.25 	AS-BUILT INFORMATI CONTRACTOR DATE	BY OR'S ANCE BY	CATION BY NGS CTED BY COTED BY	DED BY	
	PROPOSED STORM DRAIN INLET PROPOSED STORM DRAIN LINE PROPOSED STORM DRAIN MANHOLE PROPOSED WATER BLOCK RETAINING WALL PAD TURNED BLOCK STREET SLOPE		BENCH MARKS S BRASS DISC STAMPED "REWARD 1969"	GEOGRAPHIC POSITION (NAU 83) BTAKED N.M. STATE PLANE COORDINATES ACCEPTI ACCEPTI	AL 2011 7364.063 E=1491190.819 00	GROUND TO GRID = 0.9996/5005 MIL DELTA ALPHA = -00°17'12.26" RECOR NAVD 1988 ELEVATION = 5319.688 NO.	
			SURVEY INFORMATION FIELD NOTES	NO.			
			ENGINEER'S SEAL	UCENSED O	16035 07FE	NALL NO.	8
						DATE04/18 DATE04/18	DATE04/18
					Y Y S	DESIGN	
	1*=40' Bohannan	800.877.5332				DESIGNED BY YPM DRAWN BY AR	CHECKED BY YPM
	MUNICIPA	F ALBUQU ENT OF L DEVELOPMI B @ MIREHAVEN P GRADING PLAN	ENT				
	DESIGN REVIEW COMMITTEE CITY EI	NGINEER APPROVAL NGINEER APPROVAL IPDATE IPDATE	<u>MO.</u>	/DAY/YR	. <u>MO.</u> /	<u>/DAY/YR.</u>	
180338	CITY PROJECT NO. 650482 FOR INFORMATIC	ZONE MAP NO. H-8/9	SHE	5	OF	6 ET 4	

## Bohannan 🛦 Huston

August 12, 2019

Courtyard I 7500 Jefferson St. NE Albuquerque, NM 87109-4335

www.bhinc.com

voice: 505.823.1000 facsimile: 505.798.7988 toll free: 800.877.5332

Mr. Shahab Biazar, P.E. Hydrology Section City of Albuquerque 600 2<sup>nd</sup> Street NW Albuquerque, NM 87102

Re: Partial Grading and Drainage Certification (Lots 1-3, 7-9 & 65-72) Del Webb Phase 3A
 @ Mirehaven
 Phase 3A - DRB Case No. 1006864

Dear Shahab,

We are submitting a partial grading and drainage certification for Del Webb @ Mirehaven Phase 3A. The partial certification includes Lots 1-3, 7-9 & 65-72. Enclosed for your review is the approved grading and drainage plan dated 07/09/18. These lots have been graded; retaining walls, curb and gutter, and downstream infrastructure have been constructed.

After reviewing these as-built elevations and visiting the site on 08/09/19, it is my belief that the above lots have been graded in substantial compliance with the approved grading and drainage plan and that the interim drainage improvements allow runoff to be managed in the interim condition.

Your review and approval is requested for Building Permit Approval for the above listed buildings. I appreciate your time and consideration. If you have questions or require additional information, please contact me at 823-1000.

Sincerely,

Yolanda Padilla Moyer, P.E. Senior Project Manager Community Development & Planning

Enclosure

cc: Kevin Patton, Pulte Homes Brian Anderson, Pulte Homes



- Spatial Data 🔺
- Advanced Technologies A



## City of Albuquerque

Planning Department Development & Building Services Division DRAINAGE AND TRANSPORTATION INFORMATION SHEET (REV 11/2018)

Project Title:	Building	Permit #: Hydrology File #:				
		Work Order#:				
Legal Description:						
City Address:						
Applicant:		Contact:				
Address:						
		E-mail:				
Owner:		Contact:				
Address:						
		E-mail:				
TYPE OF SUBMITTAL: PLAT (14	4_# OF LOTS)	RESIDENCE DRB SITE ADMIN SITE				
IS THIS A RESUBMITTAL?:	Yes	No				
DEPARTMENT: TRAFFIC/ TRAM	SPORTATION	HYDROLOGY/ DRAINAGE				
Check all that Apply:						
TYPE OF SUBMITTAL:		TYPE OF APPROVAL/ACCEPTANCE SOUGHT:				
ENGINEER/ARCHITECT CERTIFIC	ATION	BUILDING PERMIT APPROVAL				
PAD CERTIFICATION		CERTIFICATE OF OCCUPANCY				
CONCEPTUAL G & D PLAN		PRELIMINARY PLAT APPROVAL				
CONCEPTUAL G & D PLAN GRADING PLAN		SITE PLAN FOR SUB'D APPROVAL				
ORADING PLAN DRAINAGE MASTER PLAN		SITE PLAN FOR BLDG. PERMIT APPROVAL				
DRAINAGE MASTER TEAN DRAINAGE REPORT		FINAL PLAT APPROVAL SIA/ RELEASE OF FINANCIAL GUARANTEE				
FLOODPLAIN DEVELOPMENT PERMIT APPLIC		FOUNDATION PERMIT APPROVAL				
ELEVATION CERTIFICATE		GRADING PERMIT APPROVAL				
CLOMR/LOMR		SO-19 APPROVAL				
TRAFFIC CIRCULATION LAYOUT (TCL)		PAVING PERMIT APPROVAL				
TRAFFIC IMPACT STUDY (TIS)		GRADING/ PAD CERTIFICATION				
OTHER (SPECIFY)		WORK ORDER APPROVAL				
PRE-DESIGN MEETING?		CLOMR/LOMR				
		FLOODPLAIN DEVELOPMENT PERMIT				
		OTHER (SPECIFY)				
DATE SUBMITTED:	Bv:					

COA STAFF:

ELECTRONIC SUBMITTAL RECEIVED:

FEE PAID: