



**Planning Department
Transportation Development Services**

January 7, 2016

Ron Bohannon
Tierra West, LLC
5571 Midway Park PL NE
Albuquerque, NM 87109

**Re: Heritage Market Place
1820 Unser Blvd., NW
Request for Temporary Certificate of Occupancy- Transportation
Development
Engineer's/Architect's Stamp dated 4-9-15 (H09-D024)
Certification dated 1-04-15/6**

Dear Mr. Bohannon,

PO Box 1293

Based upon the information provided in your submittal received 1-05 -15,
Transportation Development cannot issue Certificate of Occupancy for the above
referenced project.

Albuquerque

Prior to the issuance of a Certificate of Occupancy, the following items must be
addressed:

New Mexico 87103

1. Add Stop signs at interior 4-Way intersection south west of the building.
2. Truncated domes along all public Right of Ways need to be installed.
3. ADA parking spaces do not meet number of required spaces. ADA pavement between ADA parking spaces needs to be marked with cross hatching.
4. Motorcycle parking is missing and required.
5. Additional signage and striping is required to prevent left hand turns at the shopping center exit located approximately 500 ft. south of Ladera Blvd. on Market Street.
6. "No Trucks" sign Key Note "K" needs to be installed at the eastern entrance.
7. Painted "Yield" on pavement on the north side of store needs to be repainted, due to discoloration.
8. Work Order must be complete and accepted prior to final C.O.

www.cabq.gov

Please note that Certification of Site Plan for Building Permit needs to reflect date drawing was signed by D.R.B Chairperson, which was 4-9-15 for this project.

CITY OF ALBUQUERQUE



Once corrections are complete resubmit acceptable package along with a completed Drainage Transportation Information Sheet to front counter personnel for log in and evaluation by Transportation. For digital submittal please submit to PLNDRS@cabq.gov. If you have any questions, please contact me at (505) 924-3991.

Sincerely,

A handwritten signature in red ink, appearing to read 'R Michel', is written over the typed name.

Racquel M. Michel, P.E.
Traffic Engineer, Planning Dept.
Development Review Services

\gs via: email
C: CO Clerk, File

PO Box 1293

Albuquerque

New Mexico 87103

www.cabq.gov



City of Albuquerque

Planning Department

Development & Building Services Division

DRAINAGE AND TRANSPORTATION INFORMATION SHEET (REV 09/2015)

Project Title: Heritage Market Place Building Permit #: _____ City Drainage #: H09D024
 DRB#: 1003275 EPC#: _____ Work Order#: 529882
 Legal Description: Bulk Land Plat of Tracts A, B, and C Heritage Market Place(Replat of Tract 1-A-1, El Rancho Atrisco PH III)
 City Address: _____

Engineering Firm: Tierra West, LLC Contact: Ron Bohannon

Address: 5571 Midway Park Place NE Albuquerque, NM 87109

Phone#: 505 858-3100 Fax#: _____ E-mail: rrb@tierrawestllc.com

Owner: _____ Contact: _____

Address: _____

Phone#: _____ Fax#: _____ E-mail: _____

Architect: _____ Contact: _____

Address: _____

Phone#: _____ Fax#: _____ E-mail: _____

Other Contact: _____ Contact: _____

Address: _____

Phone#: _____ Fax#: _____ E-mail: _____

Check all that Apply:

DEPARTMENT:


- HYDROLOGY/ DRAINAGE
- TRAFFIC/ TRANSPORTATION
- MS4/ EROSION & SEDIMENT CONTROL

CHECK TYPE OF APPROVAL/ACCEPTANCE SOUGHT:

- BUILDING PERMIT APPROVAL
- CERTIFICATE OF OCCUPANCY

TYPE OF SUBMITTAL:

- ENGINEER/ ARCHITECT CERTIFICATION
- CONCEPTUAL G & D PLAN
- GRADING PLAN
- DRAINAGE MASTER PLAN
- DRAINAGE REPORT
- CLOMR/LOMR
- TRAFFIC CIRCULATION LAYOUT (TCL)
- TRAFFIC IMPACT STUDY (TIS)
- EROSION & SEDIMENT CONTROL PLAN (ESC)
- OTHER (SPECIFY) _____

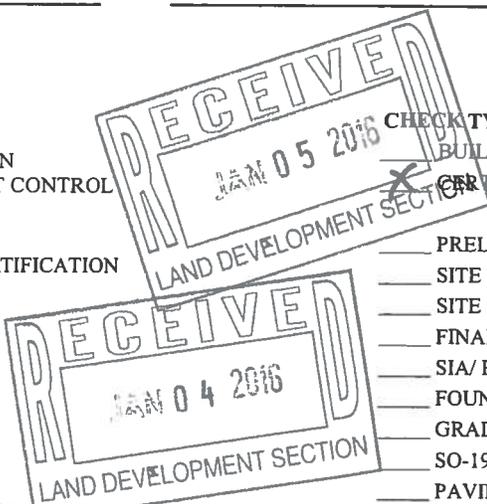

- PRELIMINARY PLAT APPROVAL
- SITE PLAN FOR SUB'D APPROVAL
- SITE PLAN FOR BLDG. PERMIT APPROVAL
- FINAL PLAT APPROVAL
- SIA/ RELEASE OF FINANCIAL GUARANTEE
- FOUNDATION PERMIT APPROVAL
- GRADING PERMIT APPROVAL
- SO-19 APPROVAL
- PAVING PERMIT APPROVAL
- GRADING/ PAD CERTIFICATION
- WORK ORDER APPROVAL
- CLOMR/LOMR
- PRE-DESIGN MEETING
- OTHER (SPECIFY) _____

IS THIS A RESUBMITTAL?: Yes No

DATE SUBMITTED: 1/4/16 By: BRAD FROSCH FOR RRB

COA STAFF: _____ ELECTRONIC SUBMITTAL RECEIVED: _____

gaw

TIERRA WEST, LLC

January 5, 2016

Ms. Racquel Michel, P.E.
Development and Building Services
City of Albuquerque
P.O. Box 1293
Albuquerque, NM 87103

**RE: SITE PLAN FOR BUILDING PERMIT CERTIFICATION
CERTIFICATION FOR TEMPORARY CERTIFICATE OF OCCUPANCY
HERITAGE MARKET WALMART, 1820 UNSER BLVD NW**

Dear Ms. Michel:

I, Ronald R. Bohannon, NMPE #7868, of the firm Tierra West LLC, hereby request approval of the Approved Site Plan for Building Permit for issuance of the Temporary Certificate of Occupancy for the project referenced above. This project is in substantial compliance as inspected on January 4, 2016 and is in accordance with the design intent of the Approved Pad D Site Plan for Building Permit dated 2/17/15. This certification is submitted in support of the request for issuance of a Temporary Certificate of Occupancy to allow the contractor to add an additional ADA parking space, provide the required motorcycle parking and complete minor signage and striping per the sitework punchlist to meet the site parking requirements.


The record information presented hereon is not necessarily complete and intended only to verify substantial compliance of the traffic aspects of this project. Those relying on the record document are advised to obtain independent verification of its accuracy before using it for any other purpose.

Enclosed, please find the information sheet and the as-built Pad D Site Plan for Building Permit. Therefore, we request approval of the as-built Pad D Site Plan for Building Permit for a Temporary Certificate of Occupancy for the as referenced buildings.

If you have any questions or need additional information regarding this matter, please do not hesitate to contact me.

Sincerely,

Ronald R. Bohannon, P.E.

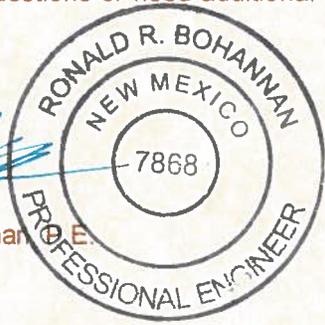


Enclosure/s



JN: 2014038
RRB/JH/bf

5571 Midway Park Place NE Albuquerque, NM 87109
(505) 858-3100 Fax (505) 858-1118 1-800-245-3102
tierrawestllc.com

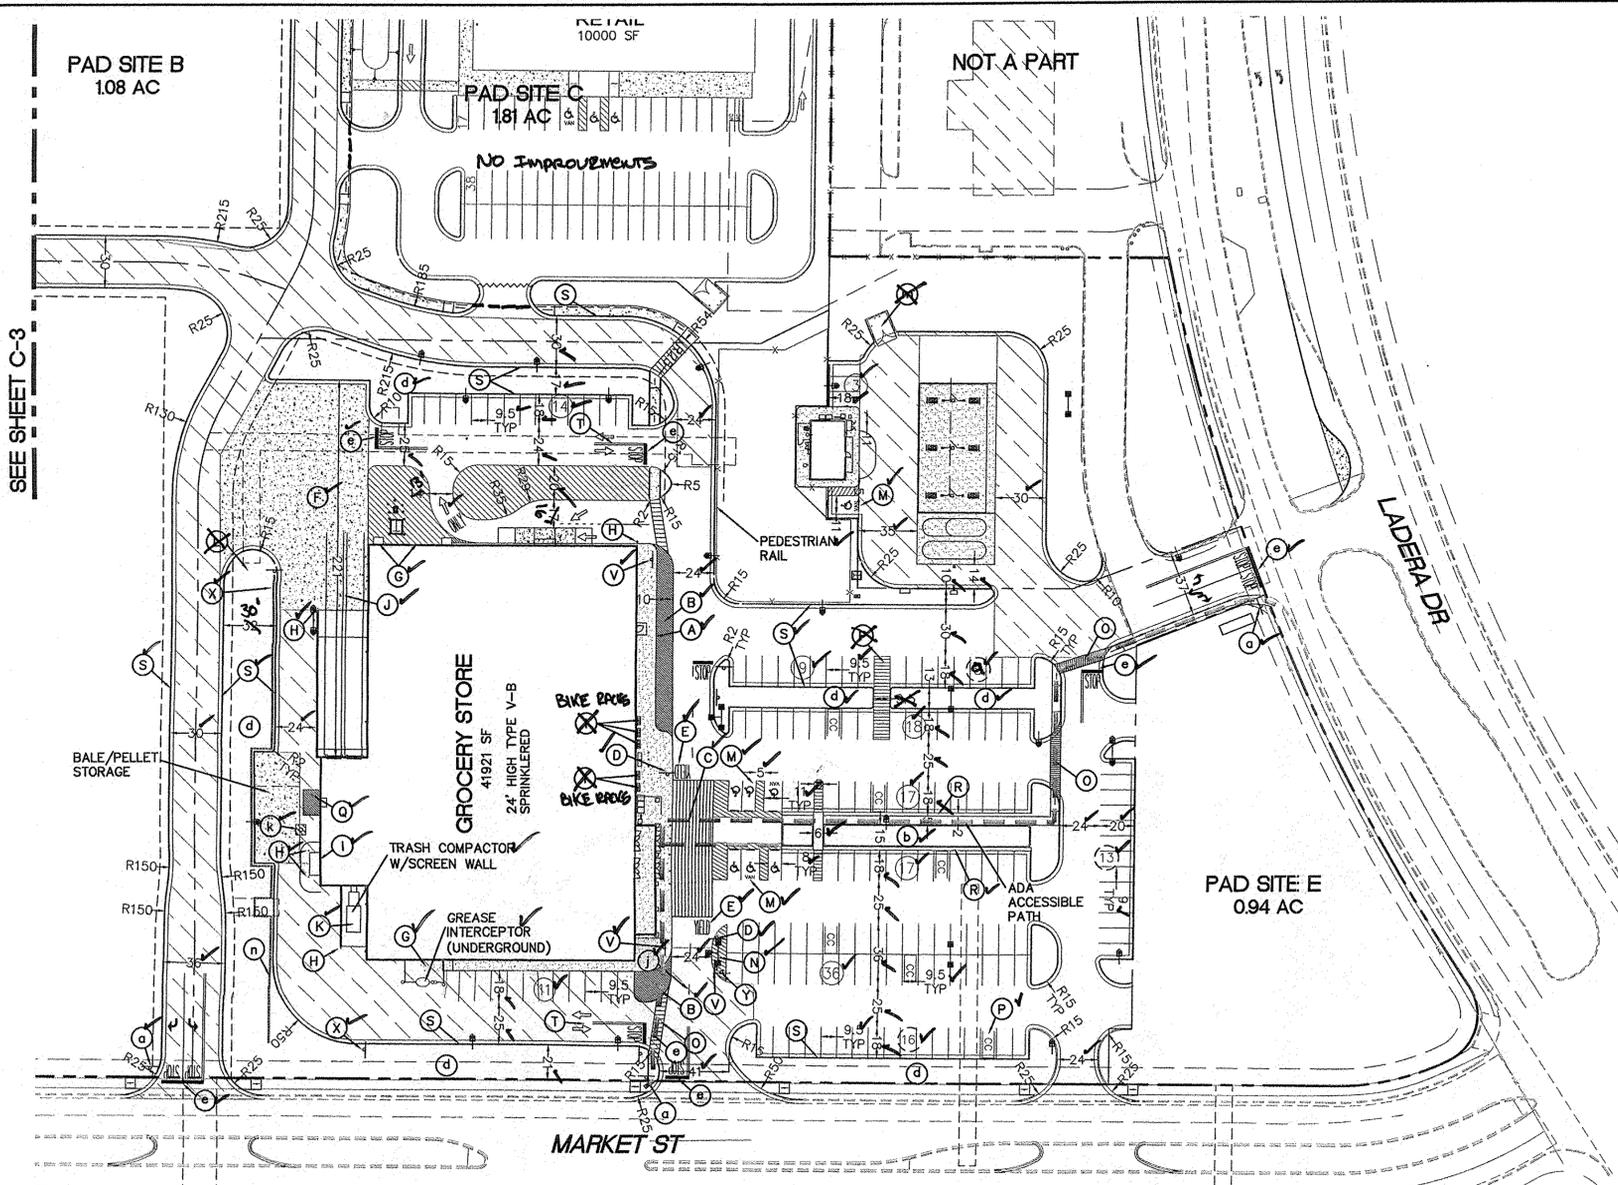

SEE SHEET SP-2 FOR KEYED NOTES

- SITE NOTES**
1. ALL WORK AND MATERIALS SHALL COMPLY WITH ALL CITY/COUNTY REGULATIONS AND CODES AND O.S.H.A. STANDARDS.
 2. CONTRACTOR SHALL REFER TO THE ARCHITECTURAL PLANS FOR EXACT LOCATIONS AND DIMENSIONS OF VESTIBULES, SLOPE PAVING, SIDEWALKS, EXIT PORCHES, TRUCK DOCKS, PRECISE BUILDING DIMENSIONS AND EXACT BUILDING UTILITY ENTRANCE LOCATIONS.
 3. ALL DISTURBED AREAS ARE TO RECEIVE FOUR INCHES OF TOPSOIL, SEED, MULCH AND WATER UNTIL A HEALTHY STAND OF GRASS IS ESTABLISHED.
 4. ALL CURBED RADII ARE TO BE 10' UNLESS OTHERWISE NOTED. STRIPED RADII ARE TO BE 5'.
 5. ALL DIMENSIONS AND RADII ARE TO THE FACE OF CURB UNLESS OTHERWISE NOTED.
 6. EXISTING STRUCTURES WITHIN CONSTRUCTION LIMITS ARE TO BE ABANDONED, REMOVED OR RELOCATED AS NECESSARY. ALL COST SHALL BE INCLUDED IN BASE BID.
 7. CONTRACTOR SHALL BE RESPONSIBLE FOR ALL RELOCATIONS, (UNLESS OTHERWISE NOTED ON PLANS) INCLUDING BUT NOT LIMITED TO, ALL UTILITIES, STORM DRAINAGE, SIGNS, TRAFFIC SIGNALS & POLES, ETC. AS REQUIRED. ALL WORK SHALL BE IN ACCORDANCE WITH GOVERNING AUTHORITIES REQUIREMENTS AND PROJECT SITE WORK SPECIFICATIONS AND SHALL BE APPROVED BY SUCH. ALL COST SHALL BE INCLUDED IN BASE BID.
 8. SITE BOUNDARY, TOPOGRAPHY, UTILITY AND ROAD INFORMATION TAKEN FROM A SURVEY BY A LAND SURVEYOR.
 9. TOTAL LAND AREA IS XX.XX± ACRES.
 10. NO WETLANDS WERE PRESENT ON THIS SITE AS INDICATED BY THE LETTER FROM THE U.S. ARMY CORP OF ENGINEERS LETTER DATE XX-XX-XX. (REFERENCE)
 11. THE SITE WORK FOR THIS PROJECT SHALL MEET OR EXCEED "THE SITE SPECIFIC SPECIFICATIONS".
 12. PYLON SIGNS SHALL BE CONSTRUCTED BY OTHERS.
 13. REFER TO ARCH. PLANS FOR SITE LIGHTING ELECTRICAL PLAN.
 14. ALL WM GENERAL CONTRACTOR WORK TO BE COMPLETED (EARTHWORK, FINAL UTILITIES, AND FINAL GRADING) BY THE MILESTONE DATE IN PROJECT DOCUMENTS. OUTLOT AREA TO BE KEPT FREE OF JOB TRAILERS AND STORAGE AFTER THE CONTRACT MILESTONE DATE FOR THE OUTLOT. WM GENERAL CONTRACTOR TO PROVIDE CLEAR ACCESS FOR OUTLOT CONTRACTOR TO THE SPECIFIC PARCEL AT ALL TIMES AFTER MILESTONE DATE. PURCHASER OF OUTLOT TO PROVIDE PERMIT DOCUMENTS AND SWPPP REQUIRED BY STATE/LOCAL REQUIREMENTS FOR SPECIFIC OUTLOT.

PROJECT NUMBER: 1003275
APPLICATION NUMBER: 14EPC-40079, 15DRB-70051

This plan is consistent with the specific Site Development Plan approved by the Environmental Planning Commission (EPC), dated _____ and the Findings and Conditions in the Official Notification of Decision are satisfied.

Is an Infrastructure List required? () Yes () No If Yes, then a set of approved DRB plans with a work order is required for any construction within Public Right-of-Way or for construction of public improvements.

DRB SITE DEVELOPMENT PLAN SIGNOFF APPROVAL:

<i>[Signature]</i> Traffic Engineer, Transportation Division	02-25-15 Date
<i>[Signature]</i> Water Utility Development	02-25-15 Date
<i>[Signature]</i> Parks & Recreation Department	02-25-15 Date
<i>[Signature]</i> City Engineer	4-8-15 Date
* Environmental Health Department (conditional)	_____ Date
<i>[Signature]</i> Solid Waste Management	2-3-15 Date
<i>[Signature]</i> DRB Chairperson, Planning Department	4-9-15 Date

*Environmental Health, if necessary

SITE DATA

LEGAL DESCRIPTION: PORTION OF TRACT 1-A-1, PLAT OF TRACTS 1-A-1 & 1-B-1 EL RANCHO ATRISCO PHASE 3

ZONING:

PAD SITES A, B, C, E
 SU-1/SU-2 PLANNED OFFICE PARK & COMMERCIAL DEVELOPMENT WITH SALES FOR FULL SERVICE ALCOHOL SALES FOR SIT DOWN RESTAURANT.

PAD SITE D
 SU1-SU2 FOR PLANNED OFFICE PARK AND COMMERCIAL DEVELOPMENT TO INCLUDE SALES OF PACKAGE LIQUOR IN ASSOCIATION WITH A GROCERY STORE. PERMITTEE SHALL NOT SELL DISTILLED SPIRITS IN ANY PACKAGE THAT CONTAINS LESS THAN 750 MILLILITERS (MINIBOTTLES) AND BEER IN ANY SINGLE CONTAINER CONTAINING 16 OR FEWER OUNCES (SINGLES)

SITE AREA: PAD D (GROCERY STORE): 4.99 ACRES
 PAD F (GAS PAD): 0.9751 ACRES

SITE DATA (CONTINUED)

INTERNAL CIRCULATION REQUIREMENTS:
 INTERNAL ROADWAY AND SIDEWALK NETWORK TO INTERCONNECT USES WITHIN CENTER WITH PUBLIC RIGHT OF WAY.

MAXIMUM BUILDING HEIGHT ALLOWED (ALL LOTS):
 MAXIMUM BUILDING HEIGHTS FOR ALL BUILDING SHALL BE PER THE SU-1 ZONE.

MINIMUM BUILDING SETBACK:
 N/A

MAXIMUM TOTAL DWELLING UNITS (ALL LOTS):
 NO RESIDENTIAL PROPOSED

NON RESIDENTIAL USES' MAXIMUM FLOOR AREA RATIO (ALL LOTS):
 MAXIMUM F.A.R IS 0.30

PHASING:
 ACCESS ON PUBLIC RIGHT OF WAY AND INTERNAL ROADWAY NETWORK WITH PUBLIC UTILITIES TO BE CONSTRUCTED WITH FIRST DEVELOPMENT.

PARKING DATA (GROCERY STORE AND GAS LOT)

PARKING REQUIRED	210 SPACES (1 SPACE PER 200 SF) GROCERY
PARKING REQUIRED	4 SPACES (1 SPACE PER 200 SF) GAS LOT
TOTAL PARKING REQUIRED	214 SPACES
PARKING PROVIDED	160 SPACES (GROCERY) + 4 (GAS LOT)
HC PARKING REQUIRED	8 SPACES
HC PARKING PROVIDED	7 8 SPACES (GROCERY) + 1 (GAS LOT) (ADD 1000 SPACE)
TOTAL PARKING PROVIDED	164 SPACES
MC PARKING REQUIRED	5 SPACES
MC PARKING PROVIDED	5 SPACES (ADD 1000 PARKING)
BICYCLE PARKING PROVIDED	25 SPACES (5 RACKS)


**SEE SHEET SP-2 FOR PAD C PARKING DATA

PROPOSED USE:
 GROCERY STORE (41,921 SF) WITH A PHARMACY DRIVE-UP SERVICE WINDOW, RETAIL SALES OF GASOLINE WITH 6-TWO SIDED FUELING DISPENSER UNITS, AND CONVENIENCE STORE (740 SF); RETAIL BUILDING (10,000 SF) WITH DRIVE-UP WINDOW.


PEDESTRIAN AND VEHICULAR INGRESS AND EGRESS:
 VEHICULAR ACCESS AND CIRCULATION— THE PROPOSED DEVELOPMENT HAS ACCESS TO ADJACENT STREETS ON ALL FOUR SIDES OF THE PROPERTY. LIMITED ACCESS TO UNSER BOULEVARD (A LIMITED ACCESS PRINCIPAL ARTERIAL) HAS BEEN APPROVED BY THE TRANSPORTATION COORDINATING COMMITTEE OF THE METROPOLITAN TRANSPORTATION BOARD OF THE MID-REGION COUNCIL OF GOVERNMENTS (R-14-01 TCC). ACCESS INCLUDES A RIGHT-IN, RIGHT OUT, AND LEFT-IN ACCESS (APPROXIMATELY 1,040 FEET SOUTH OF LADERA) AND AN ADDITIONAL RIGHT-IN ACCESS (APPROXIMATELY 529 FEET SOUTH OF LADERA) TO SERVE THE PROPOSED DEVELOPMENT. THERE ARE EXISTING ACCESS POINTS ON THE NORTH SIDE OF THE PROPERTY TO LADERA DRIVE THAT REMAIN. ADDITIONAL ACCESS IS SHOWN ON LADERA DRIVE, MARKET STREET, AND HANOVER ROAD.

NOTE:
 SITE LIGHTING SHALL COMPLY WITH THE LIGHTING REGULATIONS OF THE ZONING CODE, 14-16-3-9, AREA LIGHTING REGULATIONS. LIGHT FIXTURES WITHIN 100 FEET OF A RESIDENTIAL AREA SHALL NOT EXCEED 16 FEET. THE MAXIMUM HEIGHT FOR PARKING LOT LIGHTS SHALL BE A MAXIMUM OF 28 FEET.

- INDEX TO DRAWINGS**
- SP-1 SITE PLAN FOR BUILDING PERMIT
 - SP-2 SITE PLAN FOR BUILDING PERMIT
 - R-1 OVERALL SITE PLAN (FOR REFERENCE)
 - L-1 LANDSCAPING PLAN
 - GR-1 GRADING PLAN
 - GR-2 GRADING PLAN
 - GR-3 GRADING PLAN-FUEL AREA
 - MU-1 MASTER UTILITY PLAN
 - MU-2 MASTER UTILITY PLAN
 - A2 ARCHITECTURAL ELEVATIONS
 - DET 1-2 DETAILS

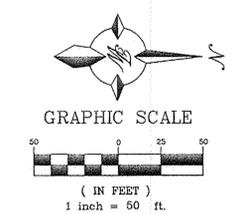


ENGINEER'S SEAL	HERITAGE MARKET PLACE ALBUQUERQUE, NM	DRAWN BY pm
	PAD D SITE PLAN FOR BUILDING PERMIT	DATE 2-17-15
RONALD R. BOHANNAN P.E. #7868	TERRA WEST, LLC 5571 MIDWAY PARK PL NE ALBUQUERQUE, NEW MEXICO 87109 (505) 858-3100 www.tierrawestllc.com	DRAWING 2014038-SPC
		SHEET NO SP-1
		JOB # 2014038

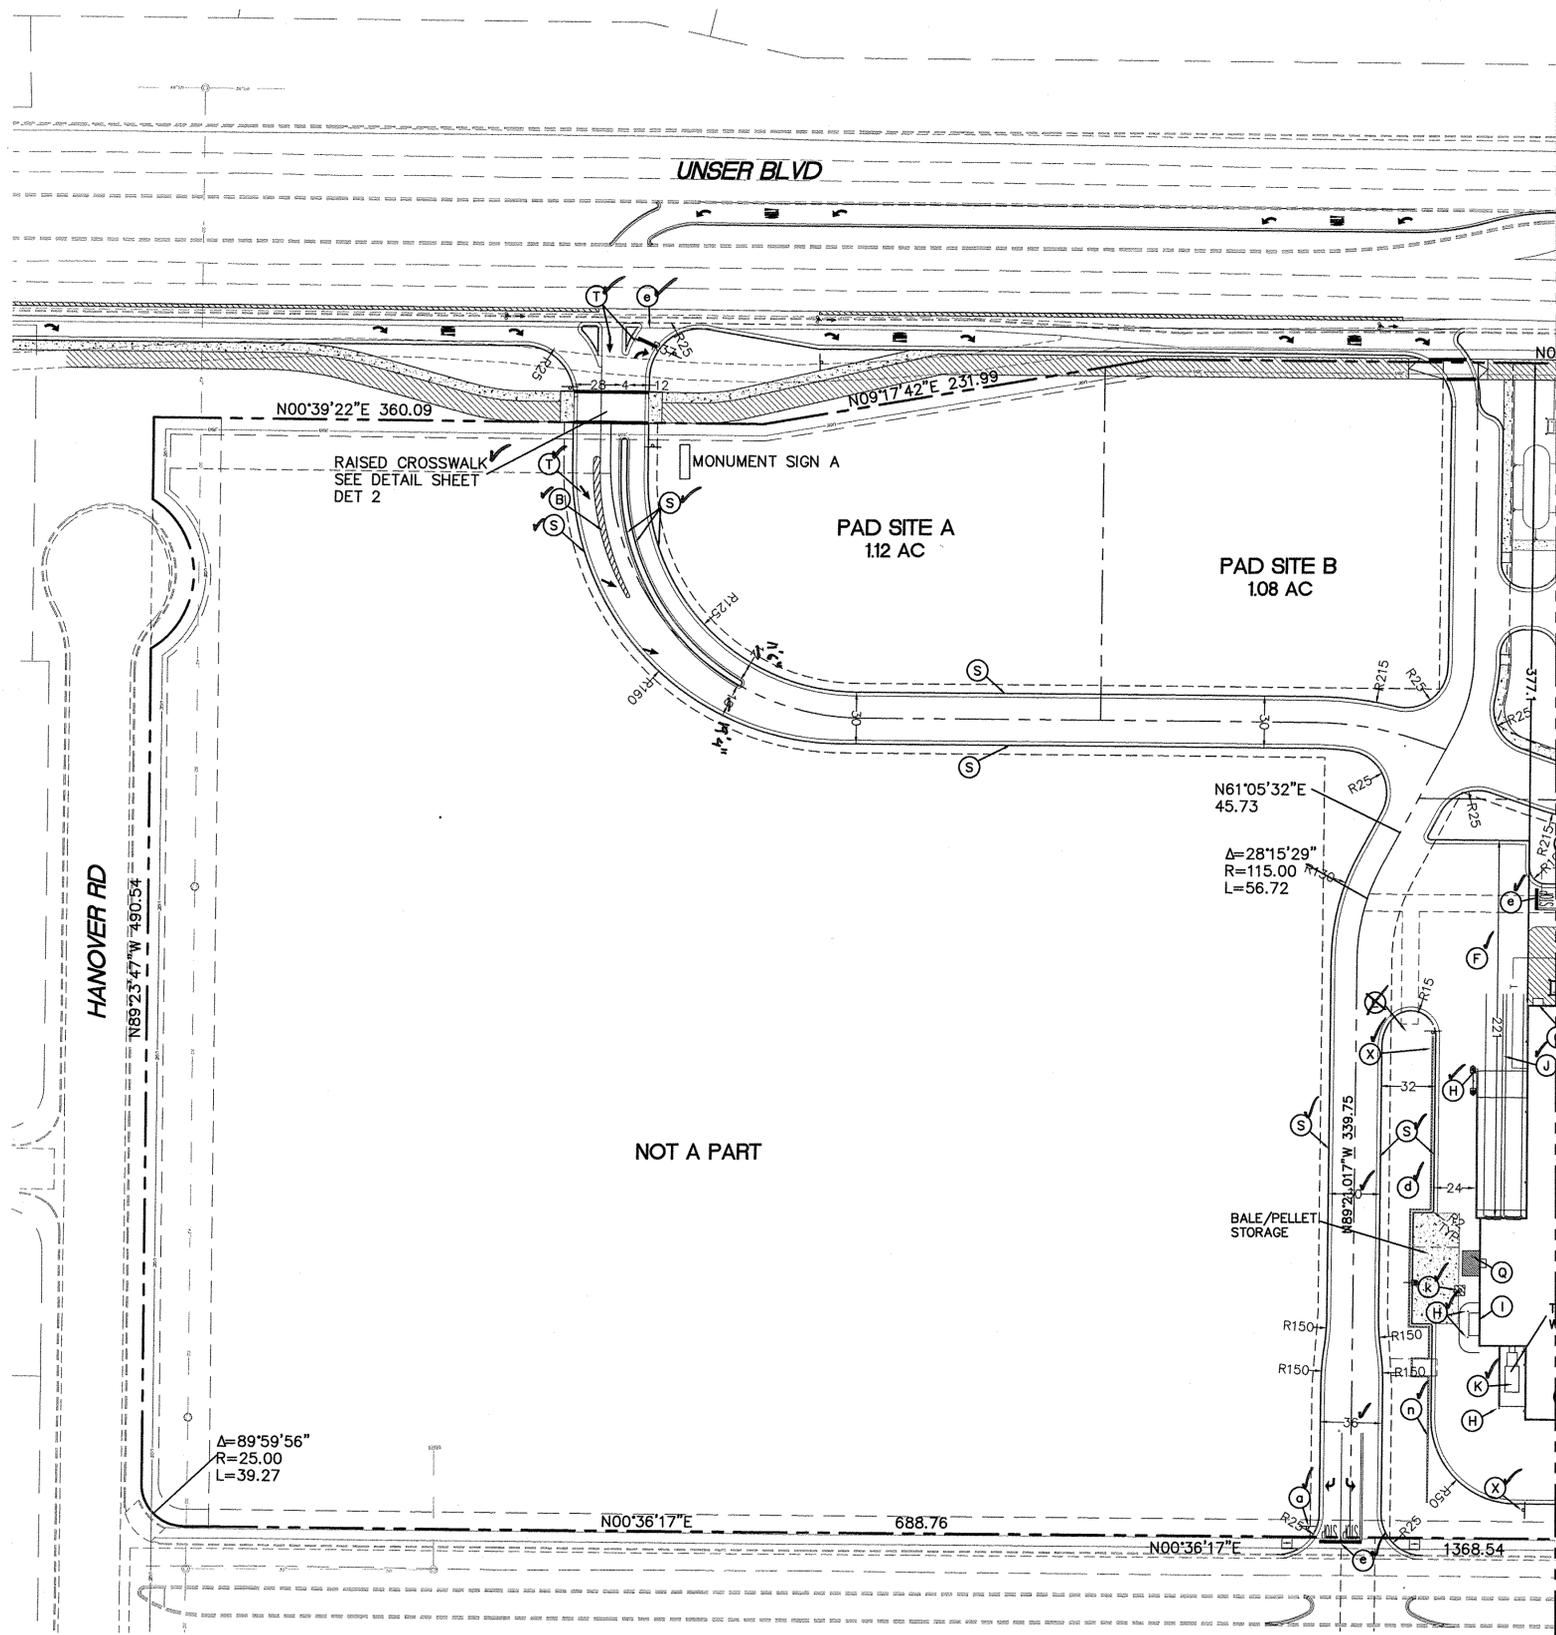

KEYED NOTES

- ✓ (A) 6" WIDE FIRE LANE STRIPING PAINTED TRAFFIC RED W/ "NO PARKING FIRE LANE" PAINTED WITH 4" HIGH WHITE LETTERING AT 25' O.C. SEE DETAIL SHEET C-8 - *PER FIRE DEPARTMENT DIRECTIONS*
- ✓ (B) AREA STRIPED AT SYSL/4" AT 45' @ 2'-0" O.C.
- ✓ (C) PROVIDE 80' MINIMUM WIDTH CROSSWALK MARKINGS AT ALL GROCERY AND GM VESTIBULE ENTRIES. 6" WIDE PAINTED WHITE STRIPING PARALLEL TO DIRECTION OF TRAFFIC AT 2'-0" O.C. AND (1)-8" WHITE STRIPE PERPENDICULAR ON BOTH ENDS UNLESS NOTED OTHERWISE. SEE SITE PLAN FOR DIMENSIONS.
- ✓ (D) PEDESTRIAN CROSSING SIGN TYPICAL AT PEDESTRIAN CROSSWALKS AS NOTED ON PLANS.
- ✓ (E) "YIELD" PAINTED WHITE ON PAVEMENT TYPICAL. SEE DETAIL SHEET C-8
- ✓ (F) CONCRETE JOINTING AND FILLERS TO BE COMPLETED PER DETAIL (TYPICAL OF ALL EXTERIOR CONCRETE EXCLUSIVE OF ARCHITECTURAL CONCRETE).
- ✓ (G) EXIT PORCH. SEE ARCHITECTURAL PLANS FOR EXACT SIZE, LOCATION FOR STOOPS, STAIRS AND/OR RAMPS THAT MAY BE REQUIRED. RAMP PAVEMENT FLUSH WITH THE TOP OF STOOP.
- ✓ (H) 6" DIA PIPE BOLLARD TYPICAL UNLESS NOTED OTHERWISE. SEE DETAIL SHEET C-8 *MISSING AT COMPACTOR R, NW BOLDING CORNER*
- ✓ (I) AT GRADE OVERHEAD DOOR LOCATION. SEE ARCHITECTURAL PLANS FOR EXACT SIZE AND LOCATION FOR COORDINATION WITH CIVIL PLANS.
- ✓ (J) 4" WIDE x 130' LONG YELLOW PAINTED TRUCK ALIGNMENT STRIPES TYPICAL.
- ✓ (K) 16' X 42' CONCRETE COMPACTOR PAD AND 16' X 35' HEAVY DUTY PAD (ORIENT FOR TRUCK LOADING). REFER TO ARCHITECTURAL PLAN FOR EXACT LOCATION AND SLOPE.
- ✗ (X) CONCRETE TRANSFORMER PAD. CONTRACTOR TO COORDINATE WITH LOCAL POWER COMPANY FOR DETAILS. *MOVED TO SW CORNER OF BUILDING*
- ✓ (M) ACCESSIBLE PARKING SPACE TYPICAL. SEE DETAIL SHEET FOR ACCESSIBLE PARKING SPACE SIZE, SIGN AND SYMBOL ("VAN"-INDICATES VAN ACCESSIBLE SPACE). *LACKING ONE SPACE TO BE ADDED*
- ✓ (N) PAINTED ISLAND TYPICAL UNLESS NOTED OTHERWISE. STRIPES SHALL BE PAINTED SYSL/4" AT 2'-0" O.C. PERPENDICULAR TO THE PARKING SPACE. SEE DETAIL SHEET C-8
- ✓ (O) 8'-0" WIDE PEDESTRIAN CROSSWALK. SEE DETAIL SHEET C-8
- ✓ (P) CART CORRAL TYPICAL. SEE DETAIL SHEET C-9 - *Temp locations*
- ✓ (Q) 10' X 15' STRIPED AREA PAINTED SYSL/4" AT 45' @ 2'-0" O.C. AT JIB CRANE LOCATION. SEE ARCH. PLANS.
- ✓ (R) 2' BUFFER FOR CAR OVERHANG - REFERENCE LANDSCAPE BUFFER DETAIL. SEE DETAIL SHEET C-8
- ✓ (S) 18" CONCRETE CURB AND GUTTER TYPICAL. SEE "BASE BID - ASPHALT PLAN" AND/OR "ALTERNATE A - CONCRETE PLAN" FOR CURB TYPE. SEE DETAIL SHEET C-8
- ✓ (T) ARROW PAVEMENT MARKINGS TYPICAL. SEE DETAIL SHEET C-8
- ✓ (U) BUILDING SETBACK LINE PER ZONING ORDINANCE.
- ✓ (V) "NO PARKING FIRE LANE" SIGN. SEE PLAN FOR LOCATION. *MISSING SIGN AT ENTRANCE AT MARKET ST.*
- ✗ (3) 3' HD CONCRETE BUFFER FOR LANDSCAPE PROTECTION. SEE DETAIL SHEET C-8 *NOT USED*
- ✗ (D) "DELIVERY TRAFFIC ONLY" SIGN. SEE DETAIL SHEET C-10 *NOT USED*
- ✓ (Y) "NO TRUCKS" SIGN. SEE DETAIL SHEET C-10 *MISSING SIGN AT ENTRANCE AT MARKET ST.*
- ✓ (Z) "TRUCK ROUTE" SIGN. SEE PLAN FOR LOCATION.
- ✓ (a) "STOP" SIGN. SEE DETAIL SHEET C-9
- ✓ (b) ADA STALL, LANDSCAPE ISLAND WALKWAY, & CART CROSSOVER. SEE DETAIL SHEET C-8
- ✗ (c) HIGH TRAFFIC AREA END CAP ISLAND. SEE DETAIL SHEET.
- ✓ (d) INTERIOR LANDSCAPE ISLAND. SEE DETAIL SHEET.
- ✓ (e) 2' STOP BAR
- ✗ (f) OPTIONAL MOVEMENT LANE CONTROL SIGN. SEE DIRECTION INDICATED AT SYMBOL. SEE DETAIL SHEET C-8
- ✓ (g) ISOLATION JOINT TYPICAL AT FIXED STRUCTURES (BUILDINGS, RETAINING WALLS/DOCK WALLS, DROP INLETS, MANHOLES, LIGHT POLE BASES AND BOLLARDS). SEE DETAIL SHEET C-9
- ✗ (h) ADVANCED INTERSECTION LANE CONTROL SIGN. SEE DIRECTION INDICATED AT SYMBOL. SEE DETAIL SHEET.
- ✓ (i) ACCESSIBLE "SITE ARRIVAL POINT". SEE PLAN FOR LOCATION AND LIMITS. *- ROUTE TO BE CERTIFIED*
- ✓ (j) 6' LONG STRIPE WITH 18' GAPS - TYPICAL.
- ✓ (k) 6'x6' PAINTED STRIPED AREA CENTERED ON SIPHONIC BREAK STORM MANHOLE. 4" PAINTED SOLID TRAFFIC YELLOW STRIPES 18" O.C. @ 45'. SEE DETAIL SHEET C-9
- ✓ (M) SCREEN WALL (CMU)

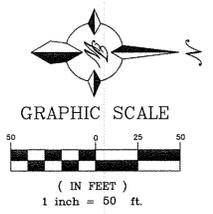

ENGINEER'S SEAL	HERITAGE MARKET PLACE ALBUQUERQUE, NM	DRAWN BY pm
	PAD D SITE PLAN FOR BUILDING PERMIT	DATE 2-17-15
RONALD R. BOHANNAN P.E. #7868	TIERRA WEST, LLC 5571 MIDWAY PARK PL NE ALBUQUERQUE, NEW MEXICO 87109 (505) 858-3100 www.tierrawestllc.com	DRAWING 2014038-SPC
		SHEET NO SP-2
		JOB # 2014038