


ENGINEER'S CERTIFICATION
I, SCOTT M. MCGEE, LICENSED UNDER THE LAWS OF THE STATE OF NEW MEXICO, DO HEREBY CERTIFY THAT THIS PROJECT WAS CONSTRUCTED IN SUBSTANTIAL COMPLIANCE WITH THE APPROVED PLAN DATED 01/29/99 (CITY APPROVAL LETTER DATED 03/19/99) AS FIELD VERIFIED BY ALDRICH LAND SURVEYING, NMLS NO 7719 ON 09/20/99 AND 10/20/99 IN ACCORDANCE WITH THE "NEW MEXICO ENGINEERING AND SURVEYING ACT" SECTION 61-23-1 THROUGH 61-23-32 NMSD (1978).

Scott M. McGee
SCOTT M. MCGEE, NMPE NO. 10519




KENSINGTON SUBDIVISION
PHASE TWO
ALBUQUERQUE, NEW MEXICO
JANUARY 1999

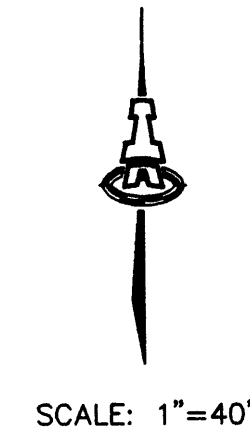

LEGEND

- (C) BLOCK No.
- PHASE LINE
- - - 5110 - - - EXISTING INDEX CONTOUR
- PG=5111.7 PAD GRADE ELEVATION
- +2.2 PROPOSED SPOT ELEVATION
- TC 2.02 TOP OF CURB
- TW 3.0 BW 1.0 TOP OF WALL
BOTTOM OF WALL
- PROPOSED FLOW ARROW
- PROPOSED RETAINING WALL
- ===== EXISTING CURB & GUTTER
- ===== PROPOSED CURB & GUTTER
- ===== PROPOSED VALLEY GUTTER
- FEMA FLOODPLAIN BOUNDARY

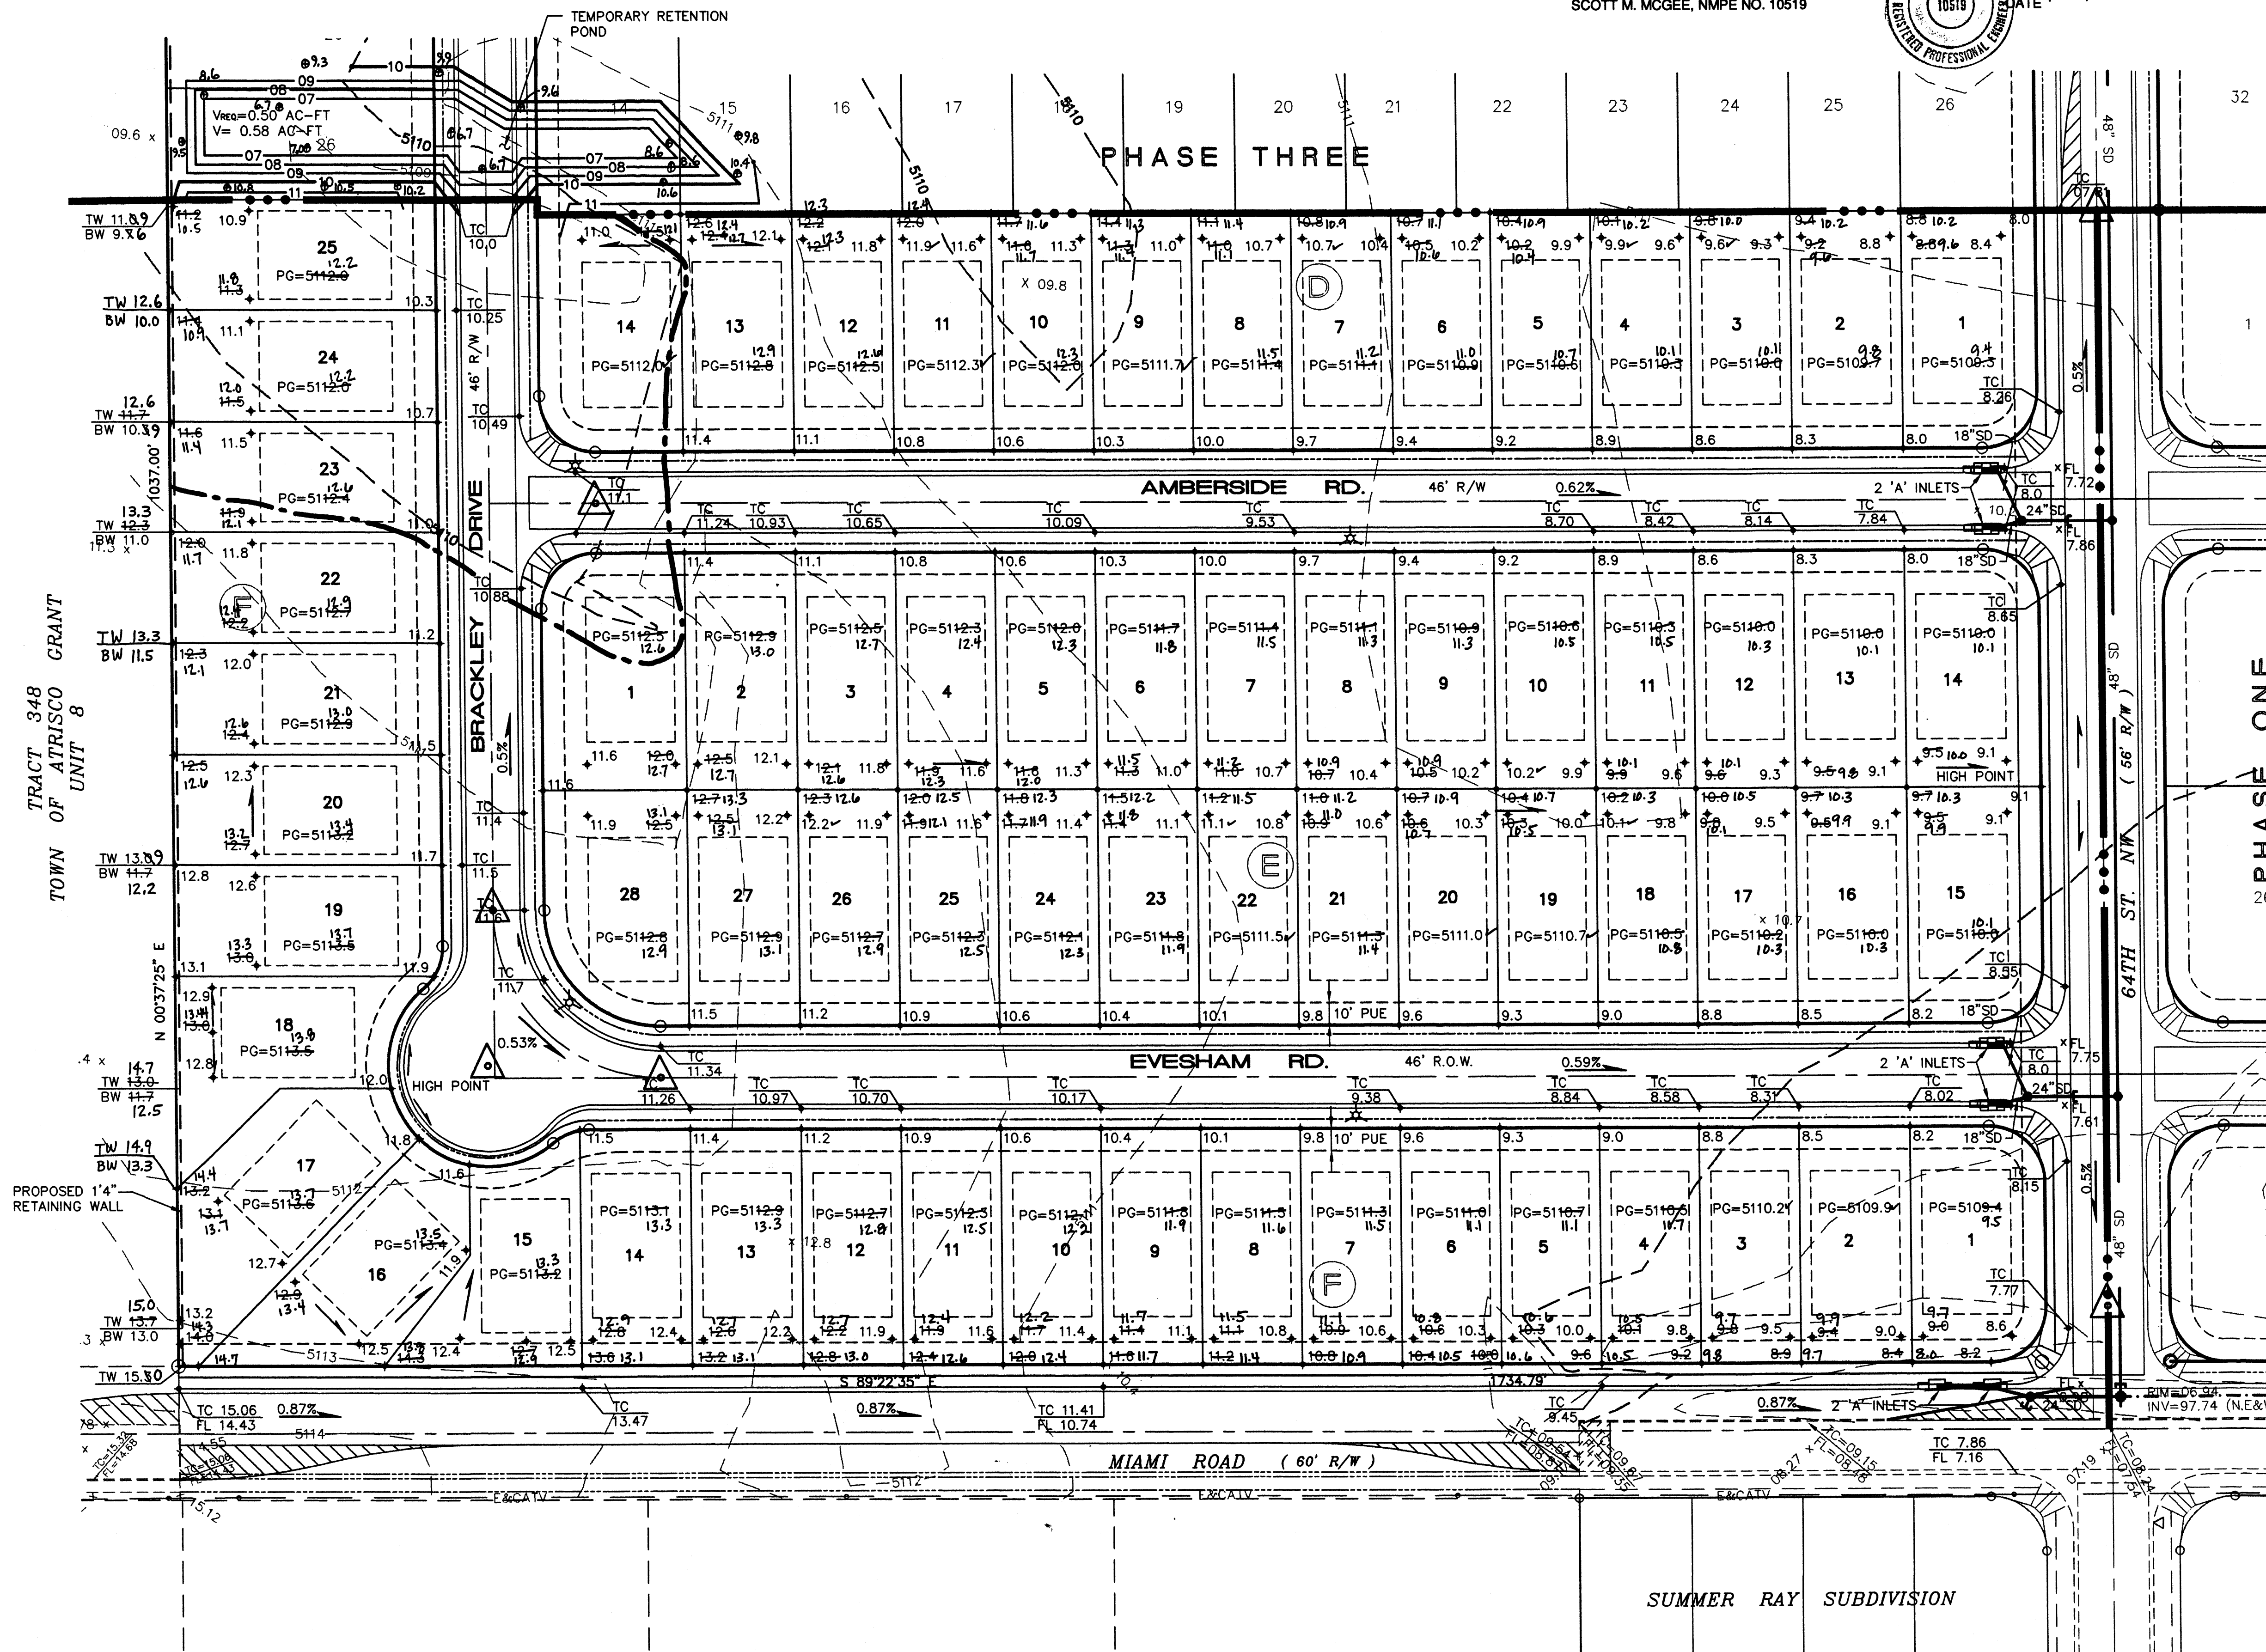

SUMMER RAY SUBDIVISION

DRB GRADING PLAN

ISAACSON & ARFMAN, P.A.
Consulting Engineering Associates
128 Monroe Street N.E.
Albuquerque, New Mexico

977GRD3.DWGaw 1/26/99

SHEET 1