



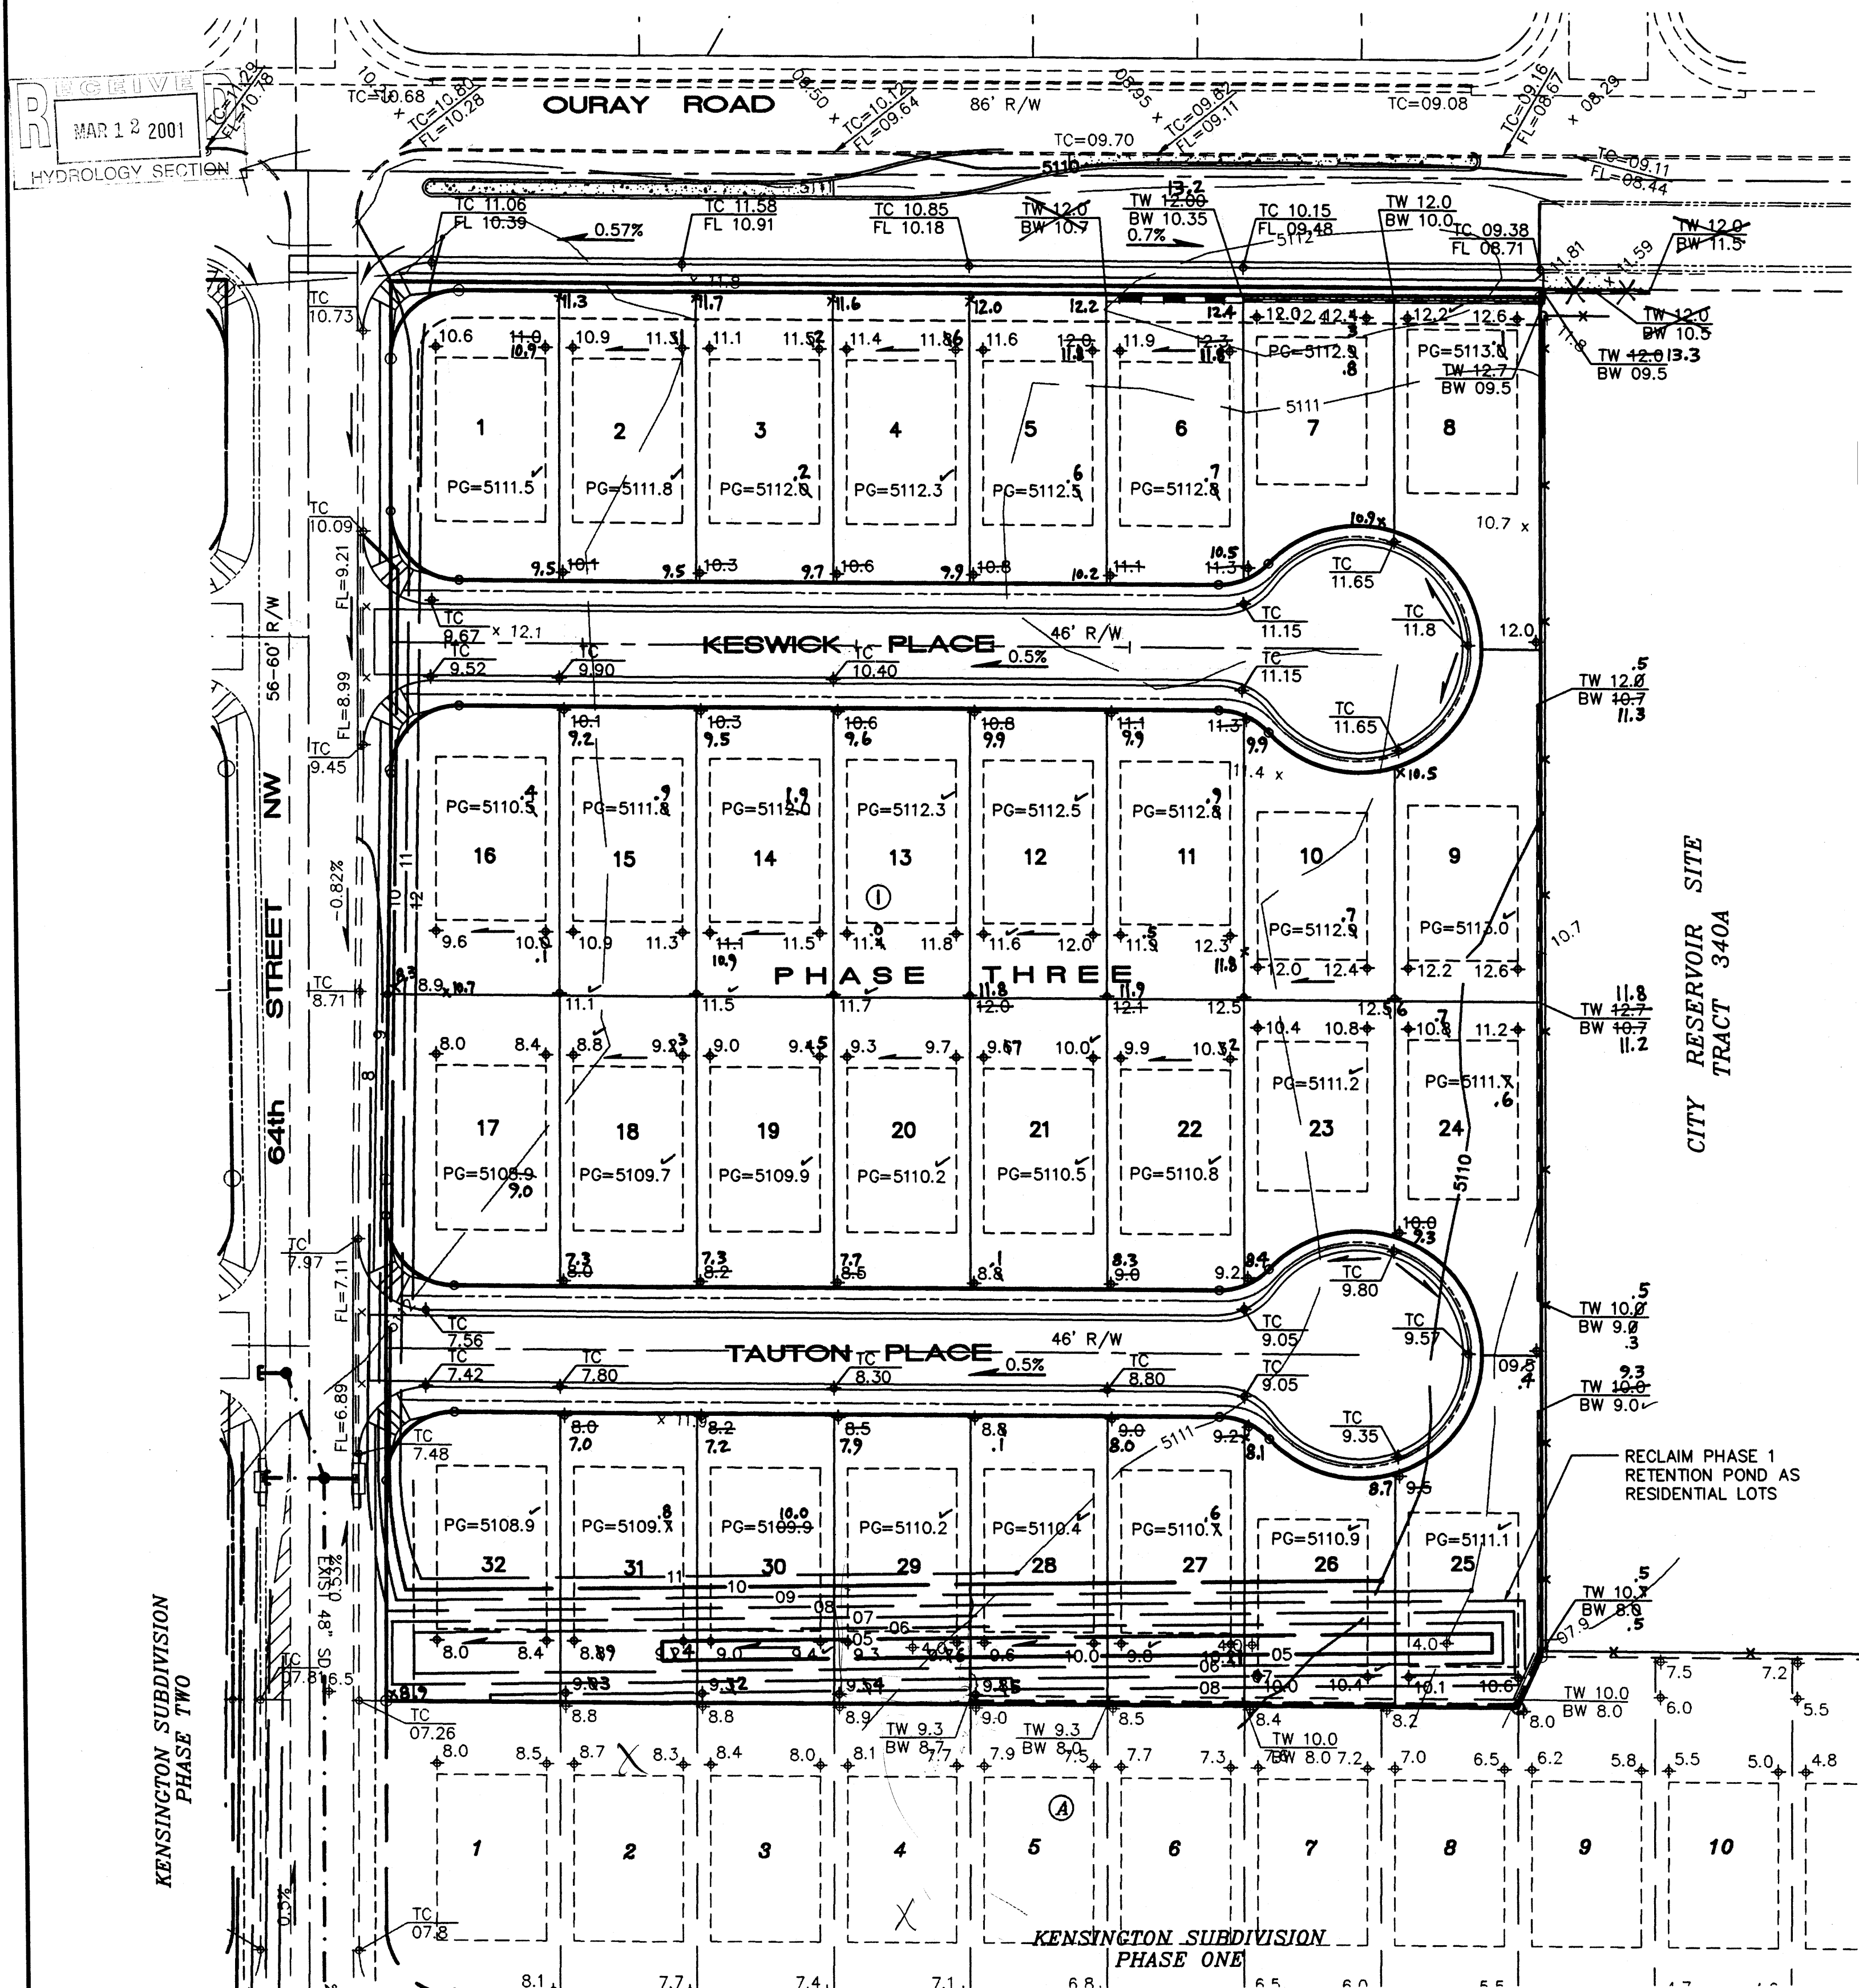


ENGINEER'S CERTIFICATION
I, SCOTT M. MCGEE, LICENSED UNDER THE LAWS OF THE STATE OF NEW MEXICO, DO HEREBY CERTIFY THAT THIS PROJECT WAS CONSTRUCTED IN SUBSTANTIAL COMPLIANCE WITH THE APPROVED PLAN DATED 05/06/99 (CITY APPROVAL LETTER DATED 06/04/99). AS-BUILT GRADES WERE FIELD VERIFIED BY ALDRICH LAND SURVEYING, INC., NMLS NO. 7719 ON 02/06/01 IN ACCORDANCE WITH THE "NEW MEXICO ENGINEERING AND SURVEYING ACT" SECTION 61-23-1 THROUGH 61-23-32 NMSD (1978).

Scott M. McGee
SCOTT M. MCGEE, NMPE NO. 10519

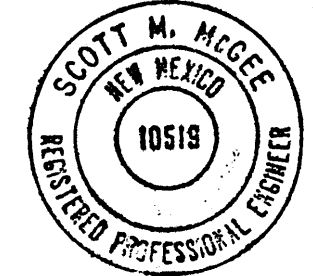

03/12/01
DATE

- LEGEND**
- 5111 EXISTING CONTOUR
 - ① BLOCK No.
 - 5110 EXISTING INDEX CONTOUR
 - X—X—X— EXISTING FENCE
 - PG= 5010.3 PAD GRADE ELEVATION
 - +2.2 PROPOSED SPOT ELEVATION
 - TC 2.02 TOP OF CURB
 - TW 3.0 TOP OF WALL
 - BW 1.0 BOTTOM OF WALL
 - PROPOSED FLOW ARROW
 - EXISTING RETAINING WALL
 - PROPOSED RETAINING WALL
 - == == == EXISTING CURB & GUTTER
 - == == == PROPOSED CURB & GUTTER
 - x—x—x— PROPOSED VALLEY GUTTER
 - x 11.8 AS-BUILT ELEVATION

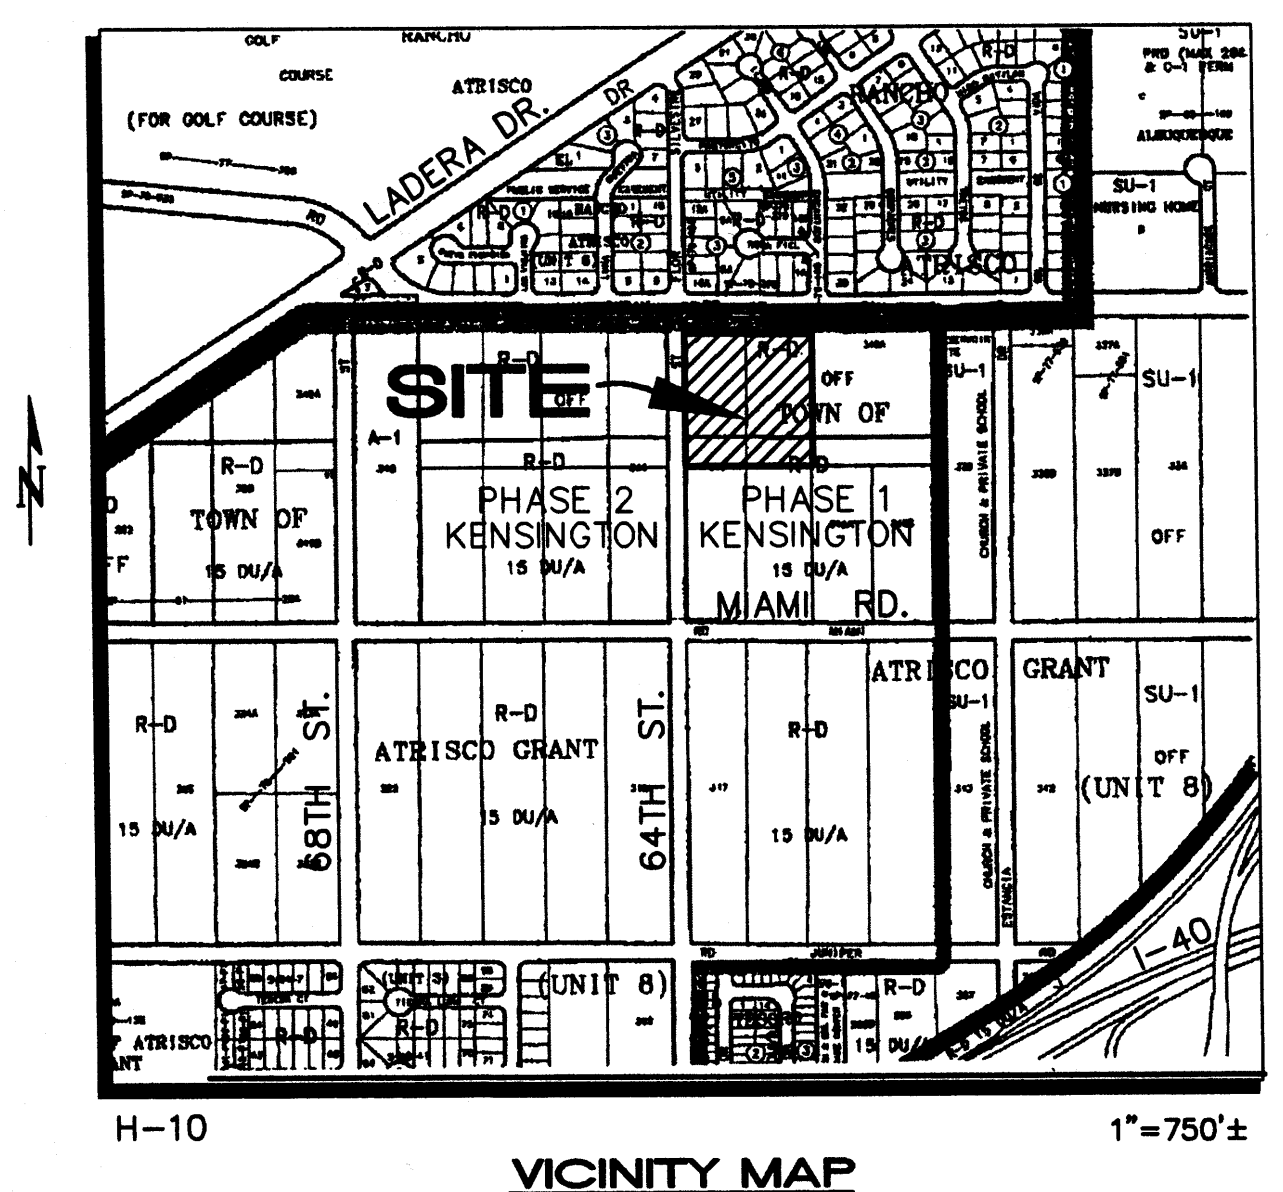

- NOTES**
- LEGAL DESCRIPTION: TRACT A, KENSINGTON SUBDIVISION PHASE ONE (5-14-98, V98C, PG 134)
 - BENCHMARK: ACS STA "2-H10" LOCATED AT THE NW QUADRANT OF 64TH STREET AND MIAMI RD NW ELEVATION: 5108.81
 - ENGINEER: ISAACSON & ARFMAN, P.A.
128 Monroe Street NE, Albuquerque, NM
Attn: Fred Arfman
 - SURVEYOR: ALDRICH LAND SURVEYING
P.O. BOX 30701, Albuquerque, NM

SHEET 1 OF 2

ISAACSON & ARFMAN, P.A.
Consulting Engineering Associates
128 Monroe Street N.E.
Albuquerque, New Mexico
064GRD1.DWG Div. 1 08/21/99

CITY OF ALBUQUERQUE
PUBLIC WORKS DEPARTMENT
ENGINEERING GROUP

TITLE: **KENSINGTON SUBDIVISION--PHASE THREE
GRADING & DRAINAGE PLAN**

Design Review Committee	City Engineer Approval	Mo./Day/Yr.	Mo./Day/Yr.
 MAR 12 2001 HYDROLOGY SECTION			
City Project No. 623181	Zone Map No. H 10/11	Sheet 4 Of 17	

AS-BUILT INFORMATION		BENCH MARKS		SURVEY INFORMATION		ENGINEER'S SEAL	
CONTRACTOR	DATE	CONTRACTOR	DATE	FIELD NOTES	DATE	SEAL	DATE
ACS STA "2-H10" LOCATED AT THE NW QUADRANT OF 64TH STREET AND MIAMI RD NW	1/1995	ALS	1/1995	1			
ELEVATION: 5108.81							
MICRO-FILM INFORMATION		MICRO-FILM INFORMATION		REVISIONS		REVISIONS	
RECORDED BY	DATE	RECORDED BY	DATE	NO.	DATE	DESIGNED BY MJC	DATE 6/99
						DRAWN BY RPH	DATE 6/99
						CHECKED BY SWM	DATE 6/99