





- Horizontal Contour Line
- Vertical Control & Bench Marks
- Analytically Derived Control
- Section Corner
- Projected Section Corner
- Section Line & Projected Section Line
- Township & Range Line & Projected Line
- Municipal Boundary Line
- Grant Line
- Index Contour
- Intermediate Contour
- Depression Contour
- Spot Elevation

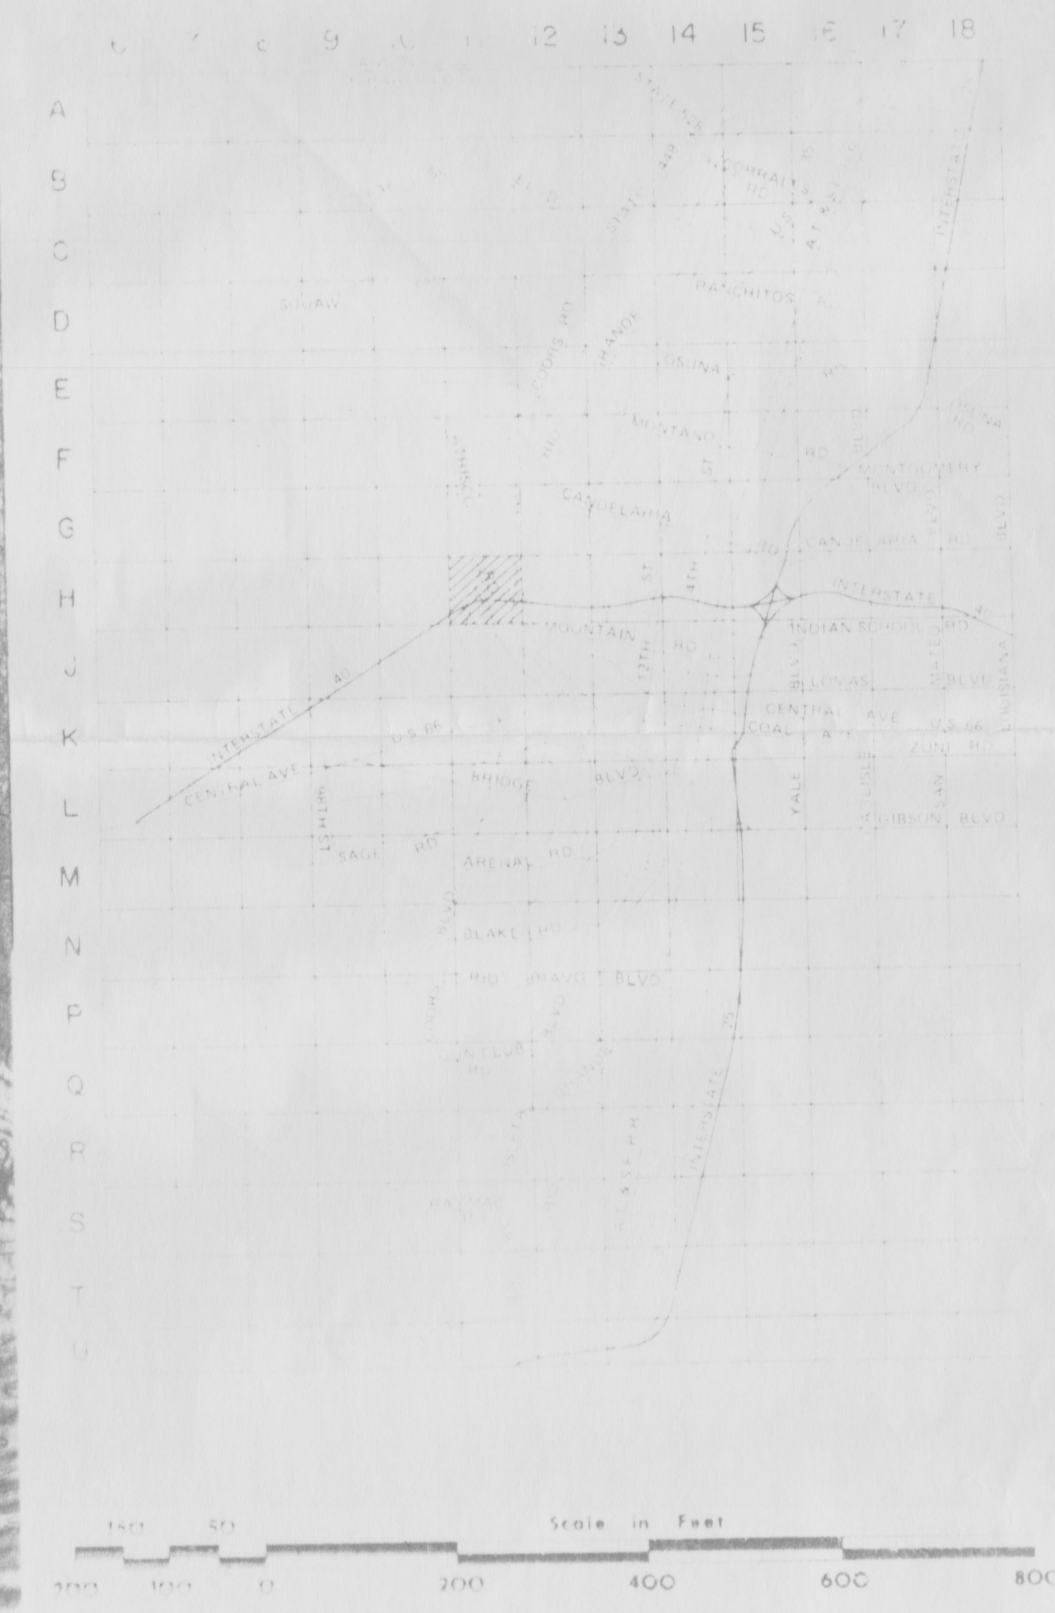

WORKS DIVISION
A PORTION OF
METROPOLITAN ALBUQUERQUE
PHOTOGRAPHIC
AERIAL PHOTO
MAP NO.

COMPILED BY PHOTOGRAMMETRIC METHODS
FROM AERIAL PHOTOGRAPHS TAKEN IN 1964
BY BOYD & ASSOCIATES, INCORPORATED
THIS MAP IS NOT A SURVEY AND IS NOT A SUBSTITUTE FOR A SURVEY

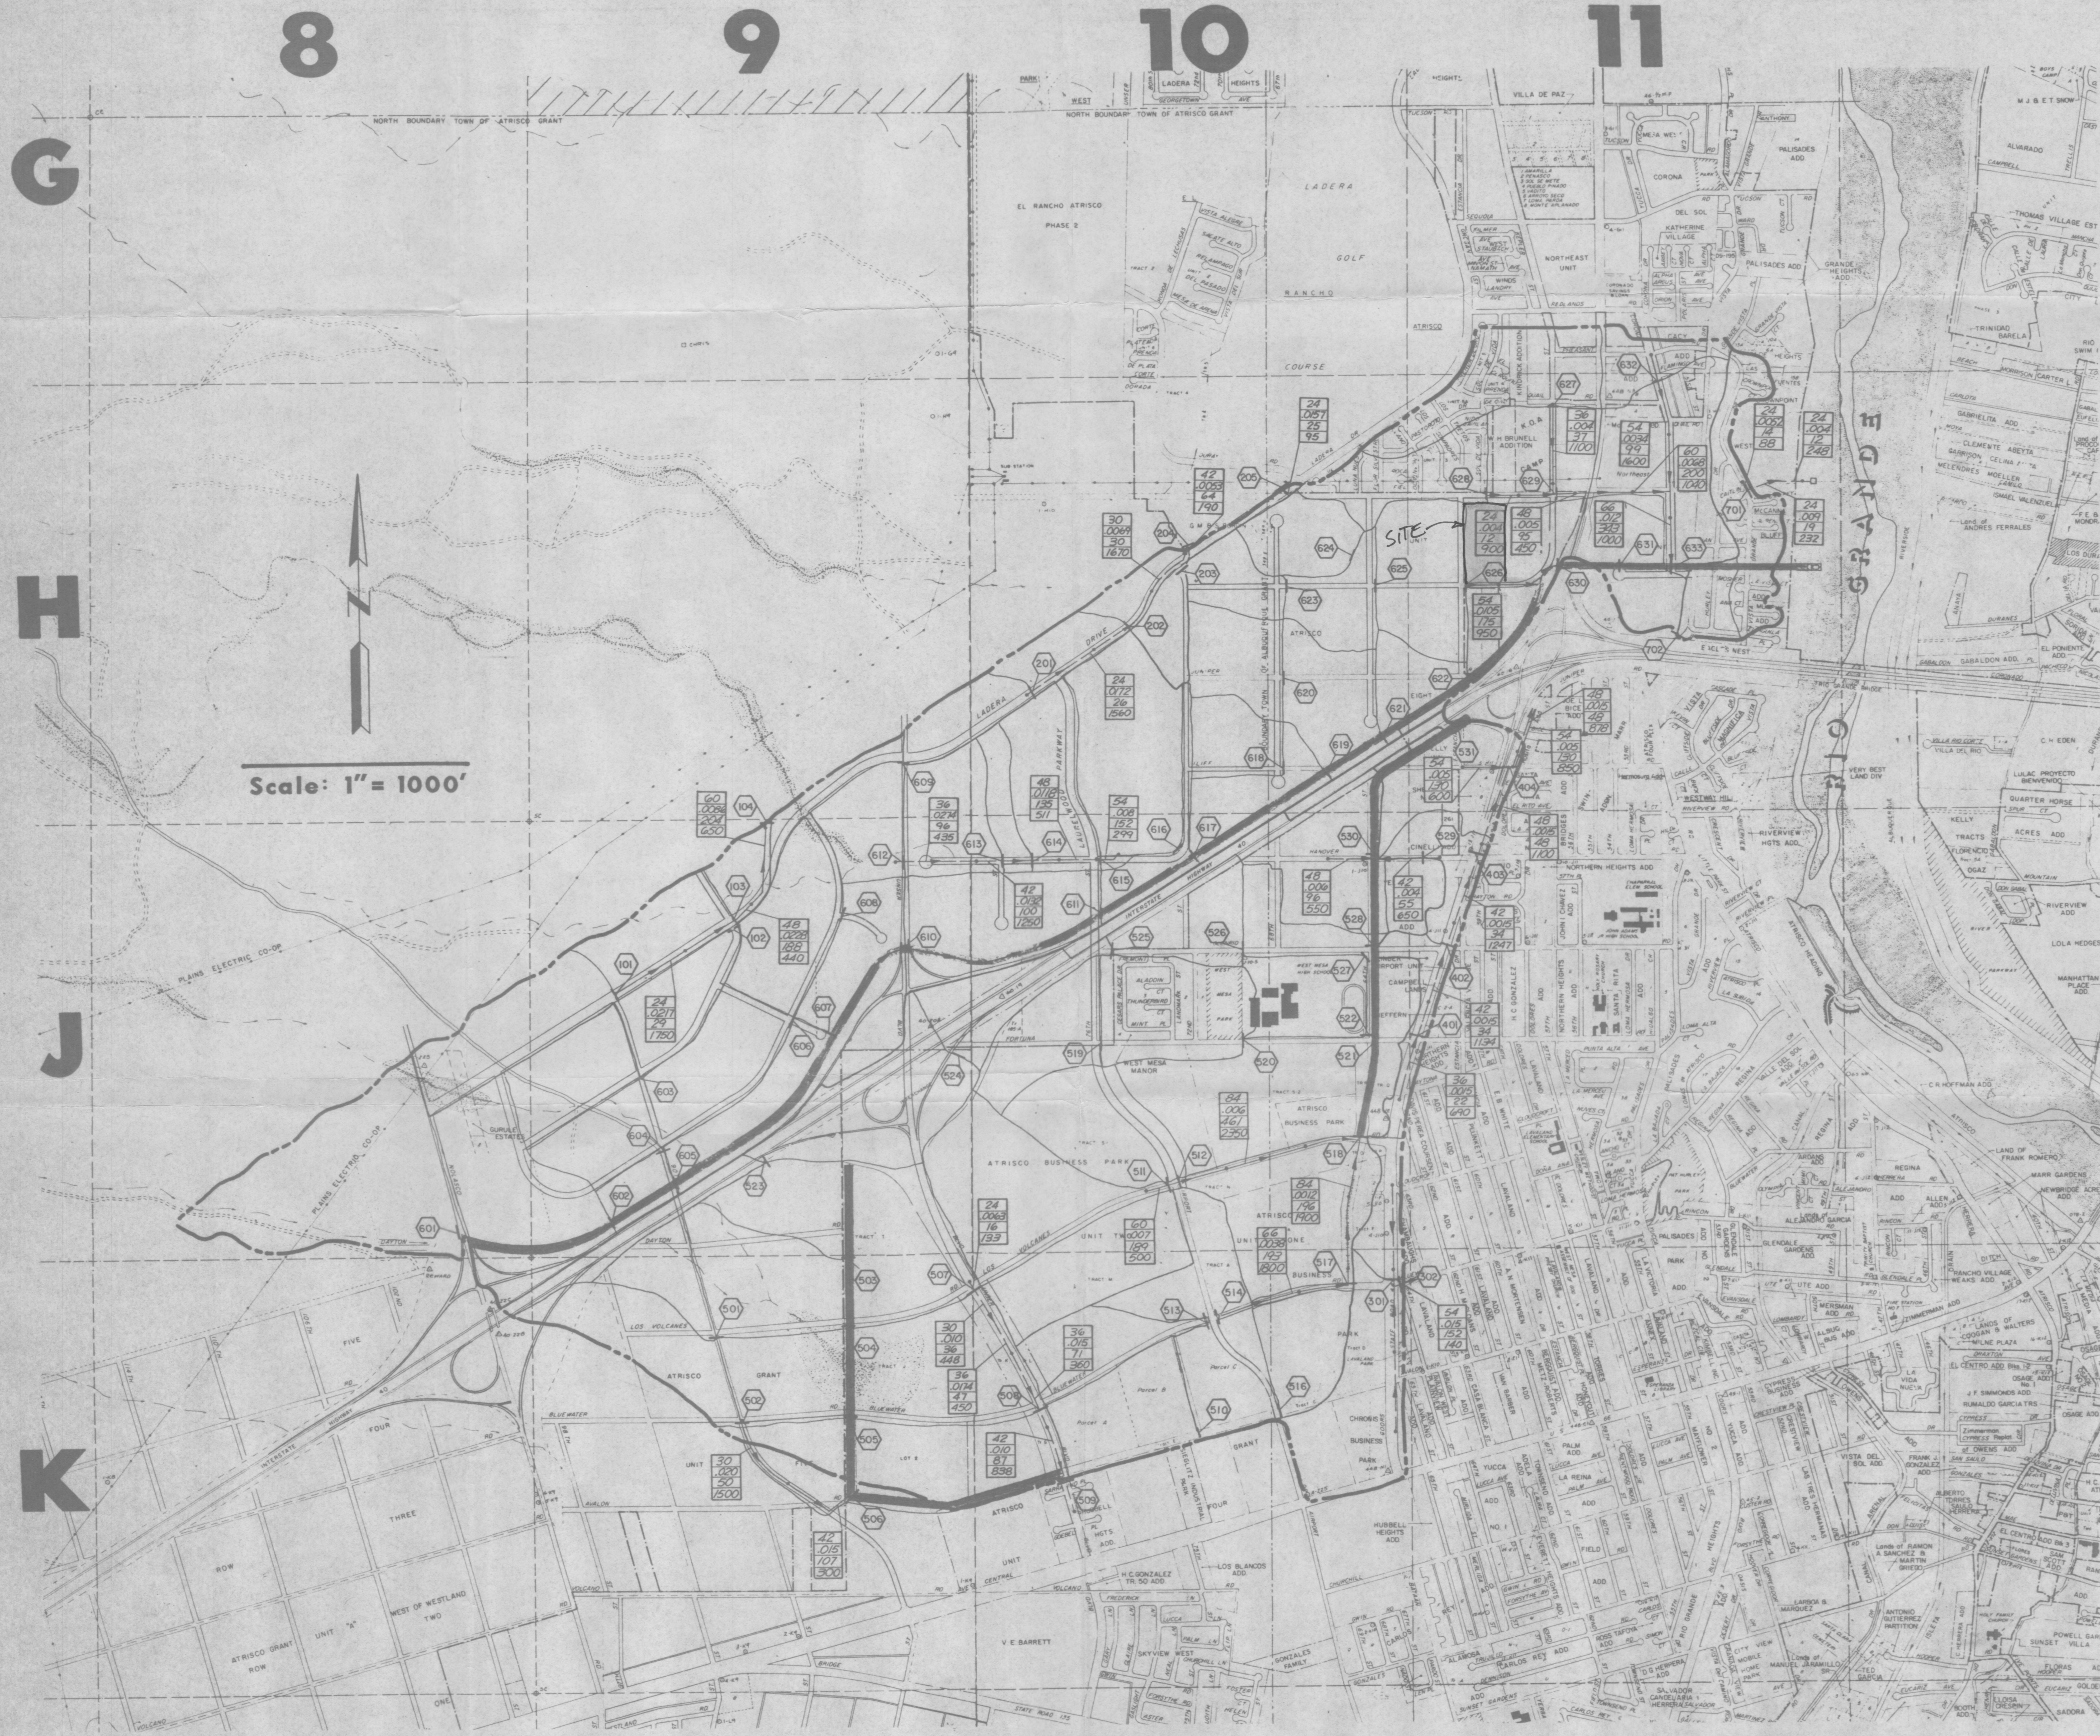


LEGEND

- ANALYSIS POINT
 - EXISTING STORM DRAIN
 - EXISTING CHANNEL
 - PROPOSED STORM DRAIN
 - PROPOSED CHANNEL
 - STUDY AREA BOUNDARY
 - DRAINAGE BASIN BOUNDARY
 - SUB BASIN BOUNDARY
- | DIAMETER OF STORM DRAIN (IN.) | SLOPE OF STORM DRAIN (FT./FT.) | CAPACITY OF STORM DRAIN FLOWING FULL (C.F.S.) | LENGTH (L.F.) |
|-------------------------------|--------------------------------|---|---------------|
| 24 | .009 | 19 | 232 |


WEST BLUFF DRAINAGE PLAN PHASE III MODELING MAP

EROSION CONTROL NOTES




1. CONTRACTOR IS RESPONSIBLE FOR OBTAINING A TOPSOIL DISTURBANCE PERMIT PRIOR TO WORK BEGINNING.
2. CONTRACTOR IS RESPONSIBLE FOR KEEPING ALL SEDIMENT OUT OF EXISTING RIGHT-OF-WAY.
3. CONTRACTOR IS RESPONSIBLE FOR CLEANING UP ANY SEDIMENT THAT GETS INTO EXISTING RIGHT-OF-WAY.
4. EROSION CONTROL BERMS ARE REQUIRED AROUND THE ENTIRE SITE.
5. ALL EROSION CONTROL BERMS MUST BE IN PLACE AND ENGINEER CERTIFIED PRIOR TO BUILDING PERMIT RELEASE.

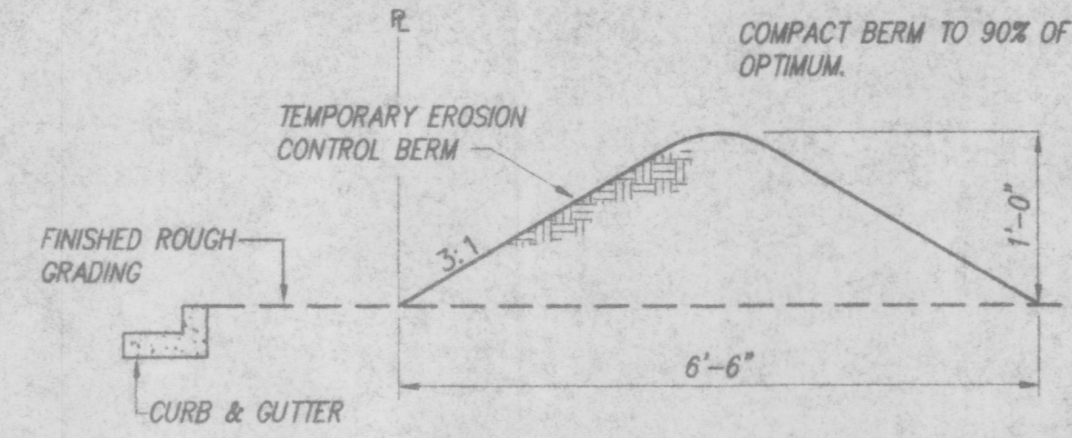

EROSION CONTROL BERM DETAIL
N.T.S.

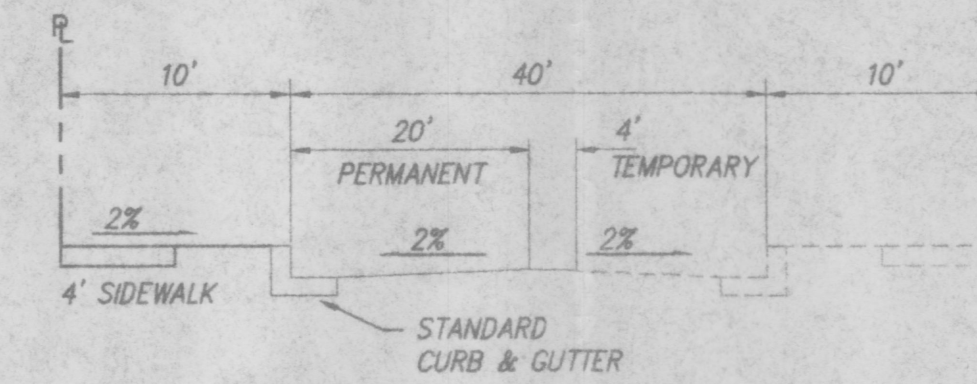

ROADWAY SECTION DETAIL
N.T.S.

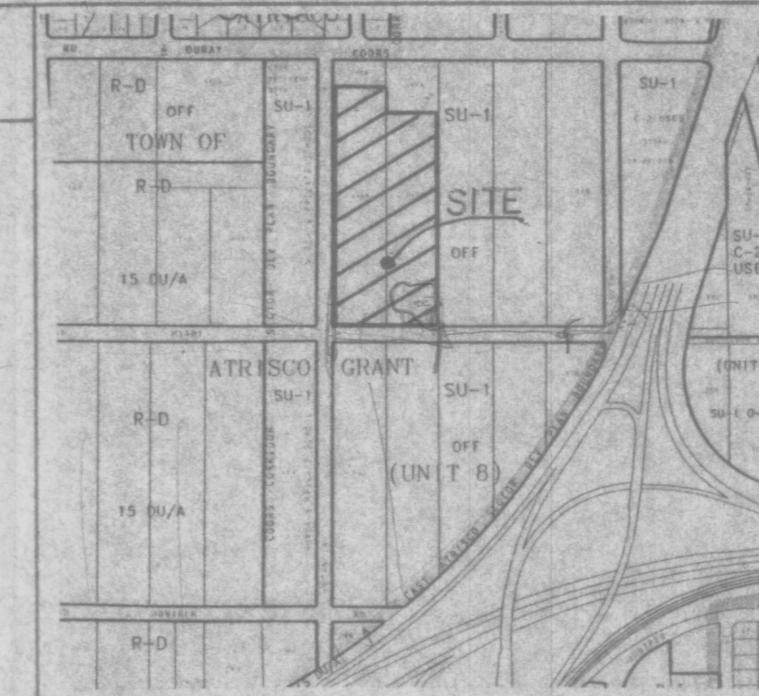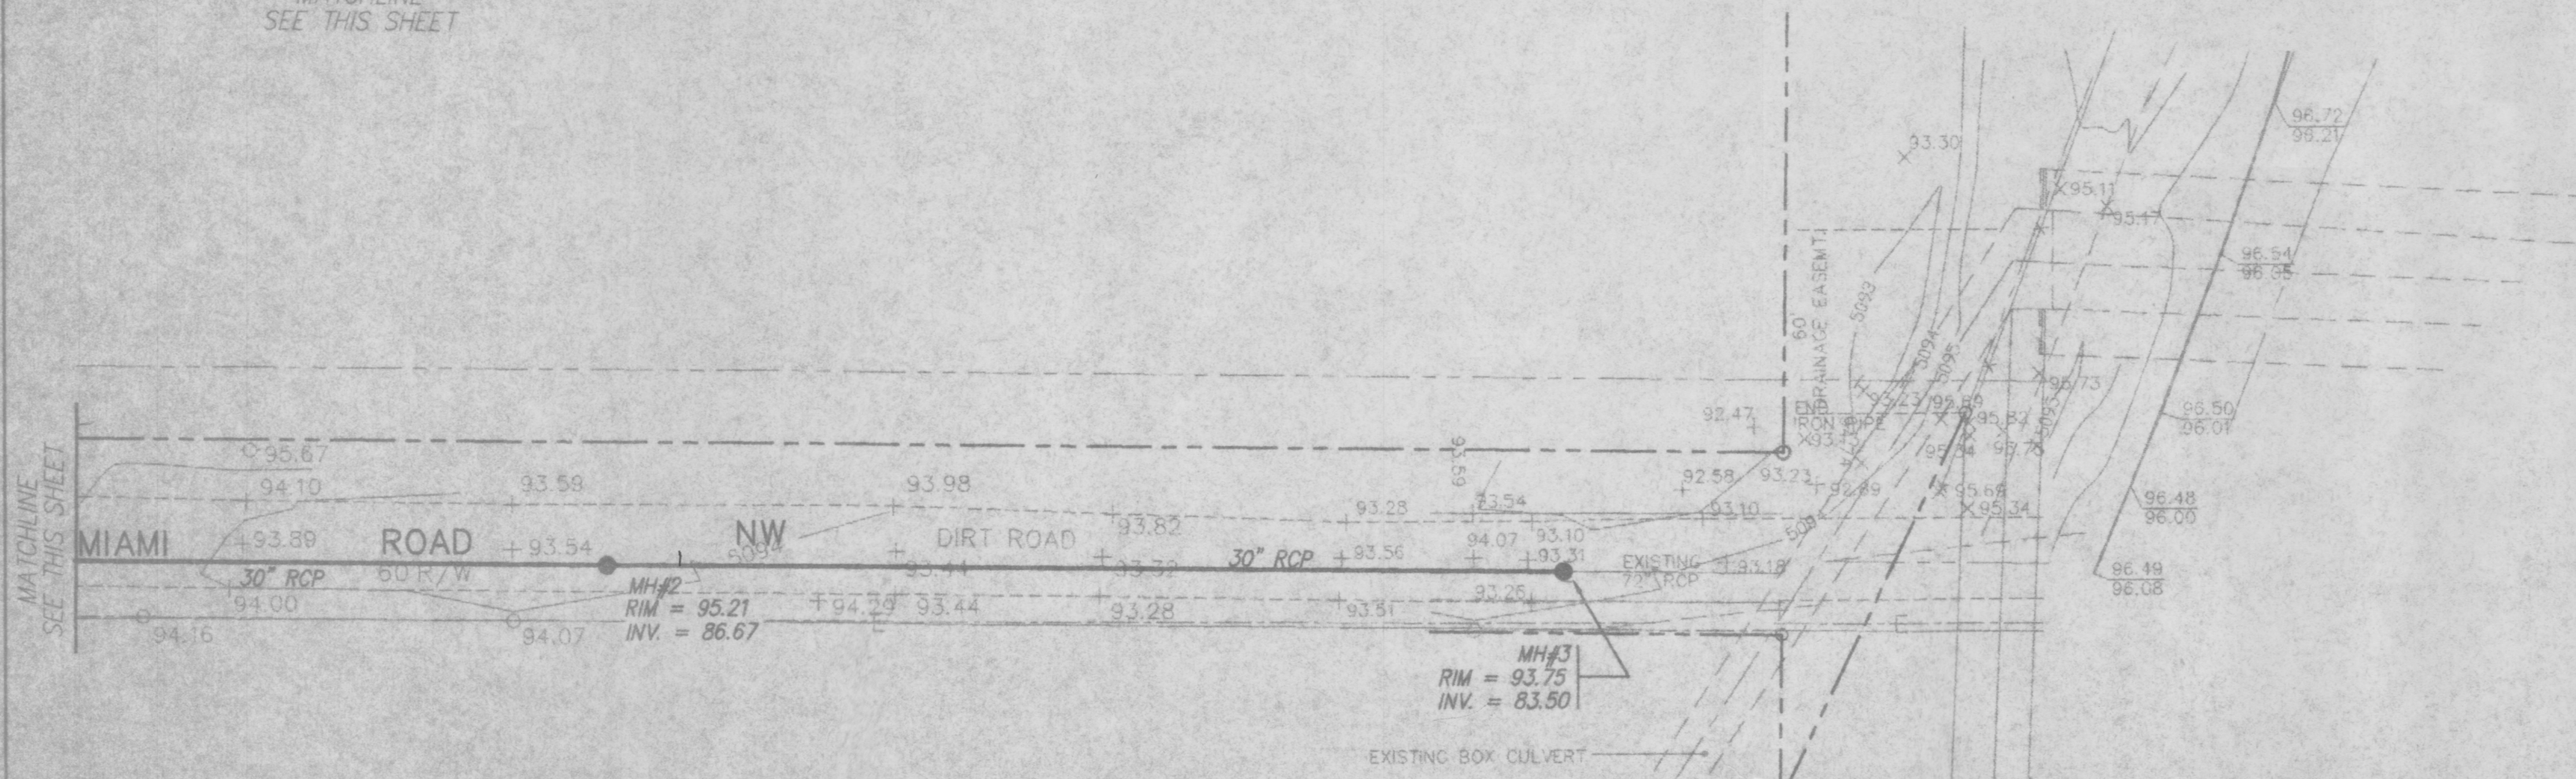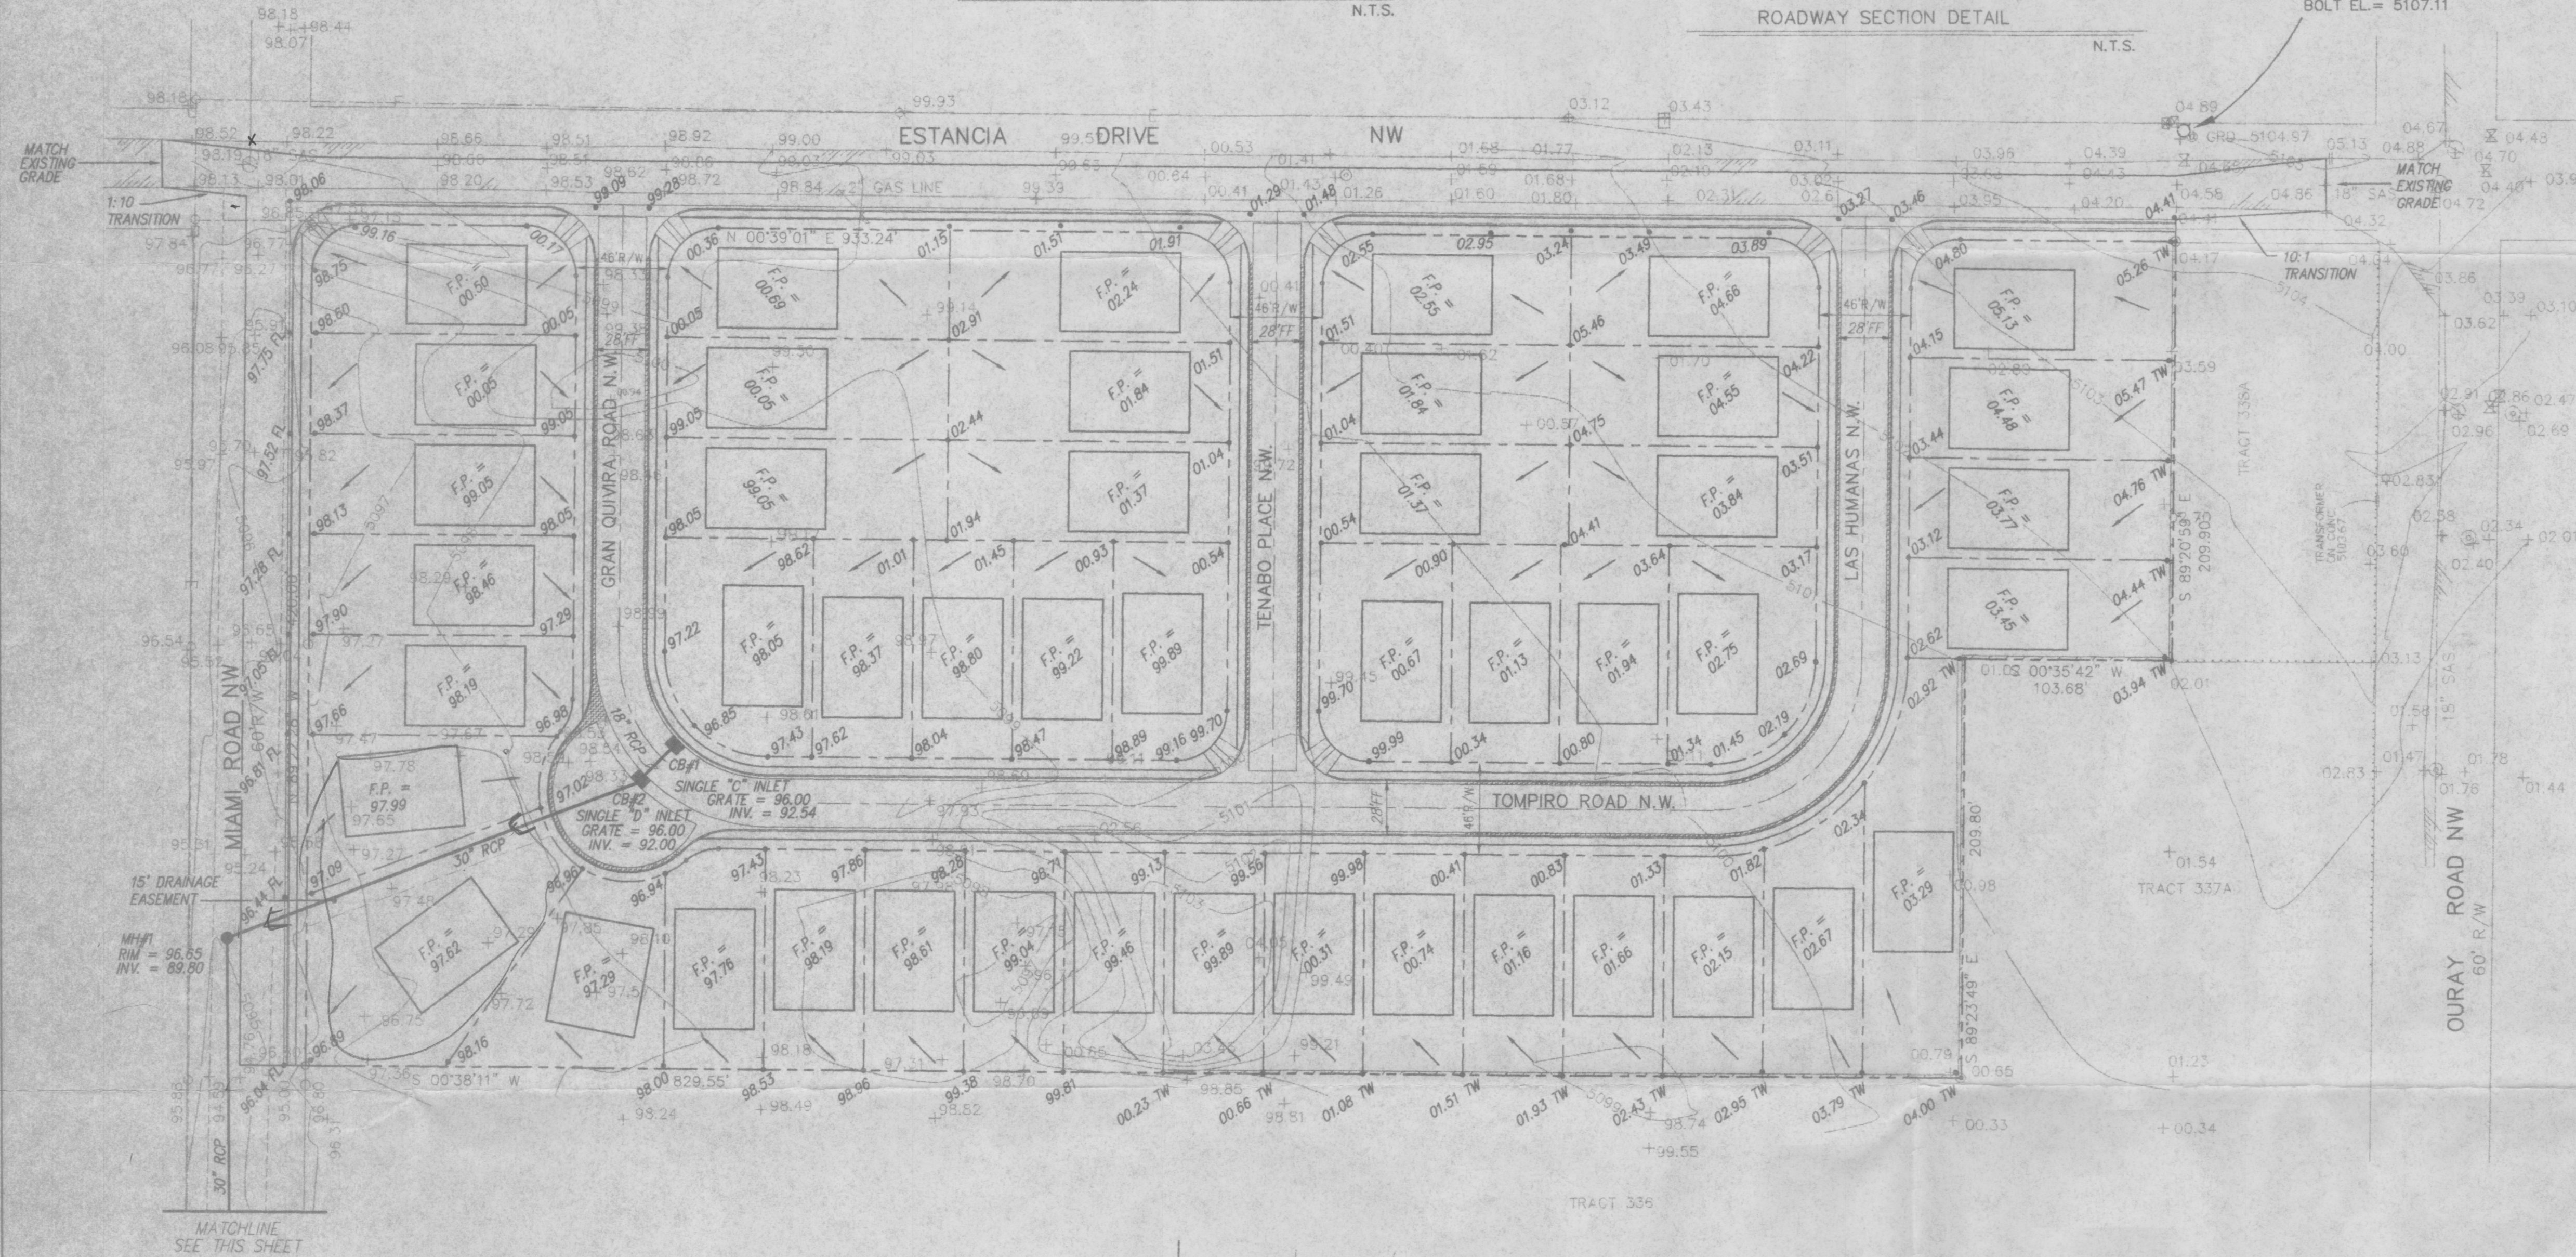

TBM (TEMPORARY BENCHMARK)

LOCATED AT TOP OF FIRE HYDRANT ON NORTH BONNET OF NORTHWEST CORNER OF PROPERTY. BOLT ELEVATION = 5107.11

LEGAL DESCRIPTION

TOWN OF ATRISCO GRANT, TRACTS 337B & 338B

NOTES

1. CONTRACTOR MUST OBTAIN A TOPSOIL DISTURBANCE PERMIT FROM THE ENVIRONMENTAL HEALTH DIVISION PRIOR TO CONSTRUCTION.
2. CITY OF ALBUQUERQUE STANDARD SPECIFICATIONS FOR PUBLIC WORKS CONSTRUCTION, LATEST EDITION SHALL GOVERN ALL WORK.
3. THE CONTRACTOR SHALL CONFORM TO ALL CITY, COUNTY, STATE AND FEDERAL DUST CONTROL MEASURES AND REQUIREMENTS AND WILL BE RESPONSIBLE FOR PREPARING AND OBTAINING ALL NECESSARY APPLICATIONS AND APPROVALS.
4. THE CONTRACTOR SHALL ENSURE THAT NO SOIL ERODES FROM THE LOTS INTO PUBLIC RIGHT-OF-WAY. THIS CAN BE ACHIEVED BY CONSTRUCTING TEMPORARY BERMS AS PER DTL THIS SHT. AND WETTING THE SOIL TO KEEP IT FROM BLOWING.
5. THE EARTHWORK CONTRACTOR SHALL STOCKPILE ENOUGH MATERIAL ADJACENT TO RETAINING WALL LOCATIONS TO BE UTILIZED FOR WALL BACKFILL.
6. ALL CONCRETE CURBING TO BE 4000 PSI @ 28 DAYS

LEGEND

- PROPERTY LINE
- +00.33 EXISTING SPOT ELEVATION
- 5094 EXISTING CONTOUR
- EDGE OF ASPHALT
- 90 PROPOSED CONTOUR
- +00.05 PROPOSED SPOT ELEVATION
- RETAINING WALL (DESIGN BY OTHERS)
- FP. = FINISHED PAD
- PROPOSED MOUNTABLE CURB & GUTTER
- FLOW ARROW

DMG D. MARK GOODWIN & ASSOCIATES, P.A.
CONSULTING ENGINEERS & SURVEYORS
P.O. BOX 90606
ALBUQUERQUE, NEW MEXICO 87199
(505) 345-2010

CITY OF ALBUQUERQUE
PUBLIC WORKS DEPARTMENT
ENGINEERING GROUP

TITLES



APPROVALS	ENGINEER	DATE	APPROVALS	ENGINEER	DATE
DRC CHAIRMAN			WATER		
TRANSPORTATION			WASTE WATER		
HYDROLOGY					

PROJECT NO.	MAP NO.	SHEET OF
	H11	1 1

SCALE: 1" = 50'




TOMPIRO/94073/05-08/8-22

AUG 22 1994

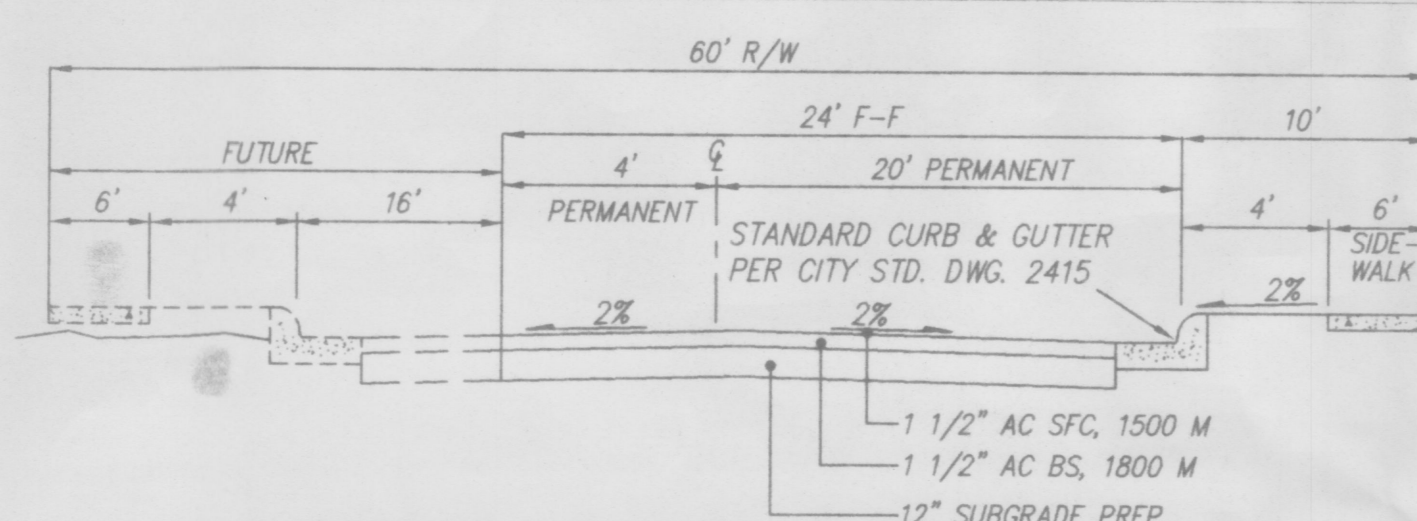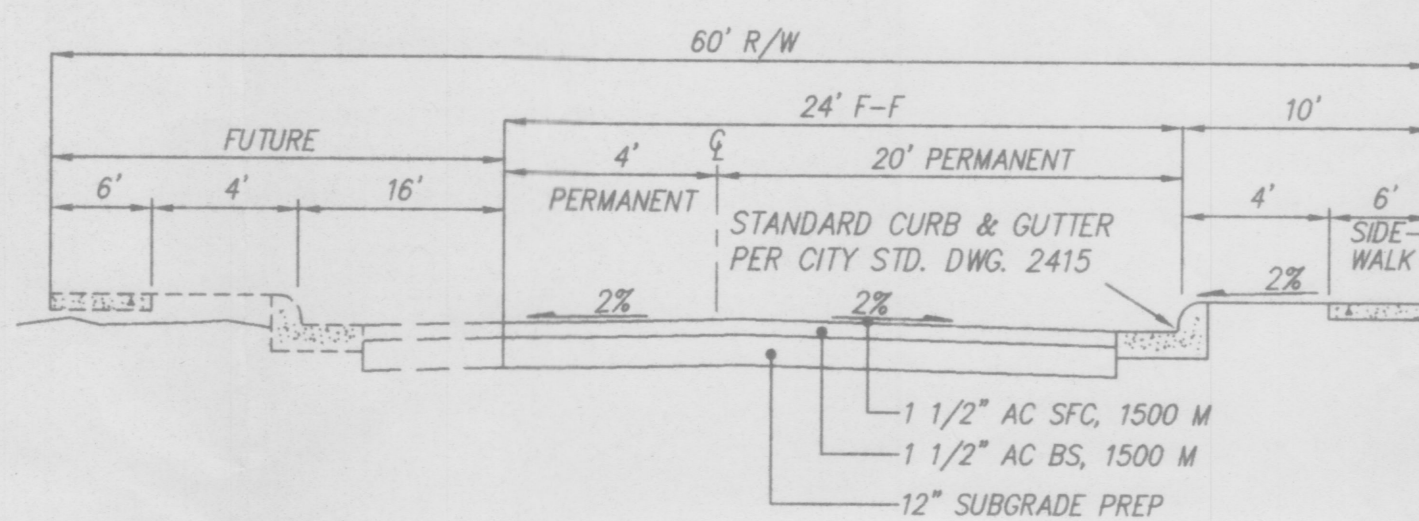

MIAMI ROAD N.W. SECTION


ESTANCIA DRIVE N.W. SECTION

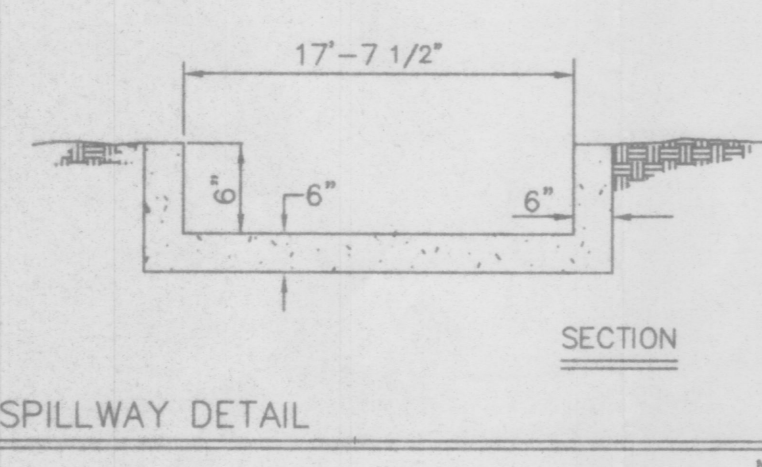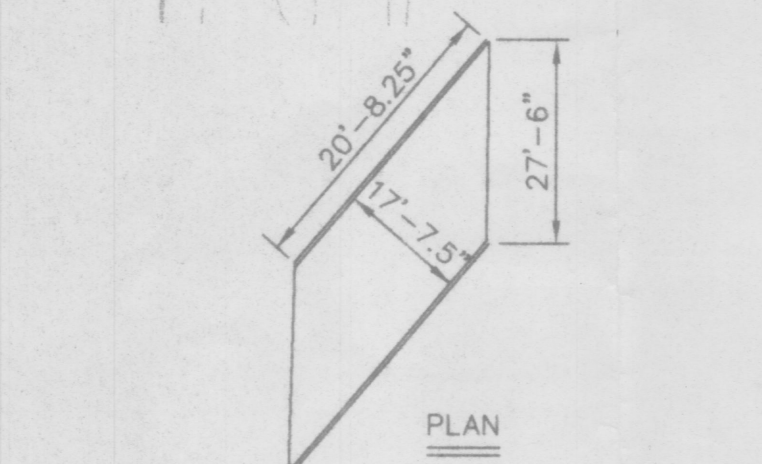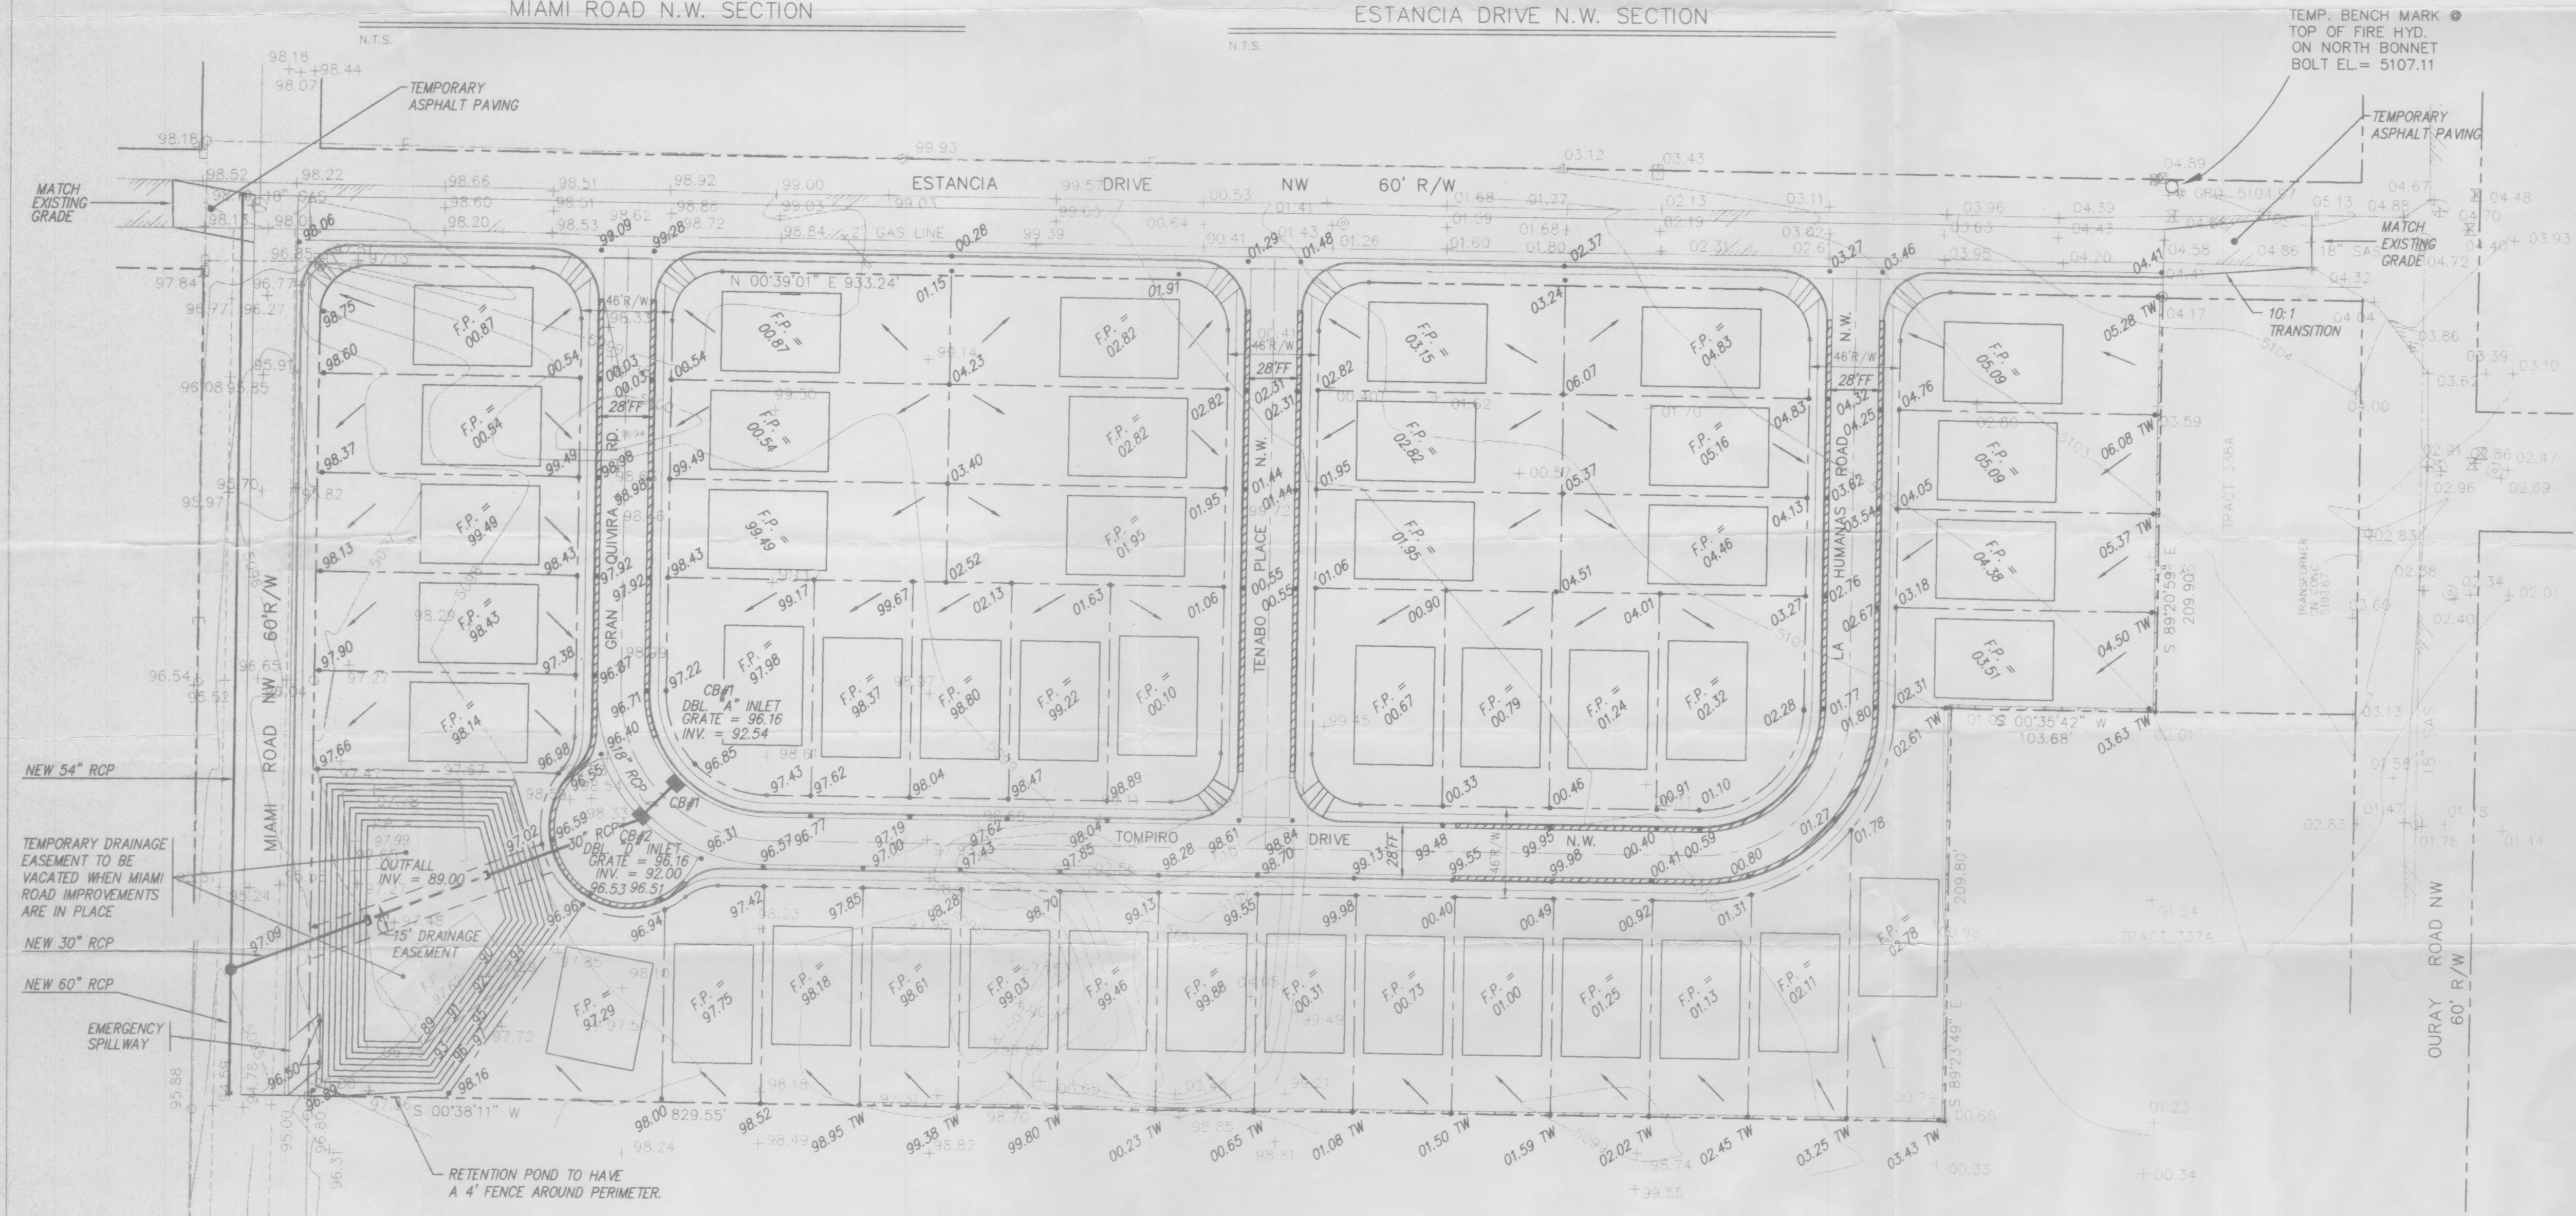


SPILLWAY DETAIL

EROSION CONTROL NOTES

1. CONTRACTOR IS RESPONSIBLE FOR OBTAINING A TOPSOIL DISTURBANCE PERMIT PRIOR TO BEGINNING WORK.
2. CONTRACTOR IS RESPONSIBLE FOR KEEPING ALL SEDIMENT OUT OF EXISTING RIGHT-OF-WAY.
3. CONTRACTOR IS RESPONSIBLE FOR CLEANING UP ANY SEDIMENT THAT GETS INTO EXISTING RIGHT-OF-WAY.
4. EROSION CONTROL BERMS ARE REQUIRED AROUND THE ENTIRE SITE.
5. ALL EROSION CONTROL BERMS MUST BE IN PLACE AND ENGINEER CERTIFIED PRIOR TO BUILDING PERMIT RELEASE.

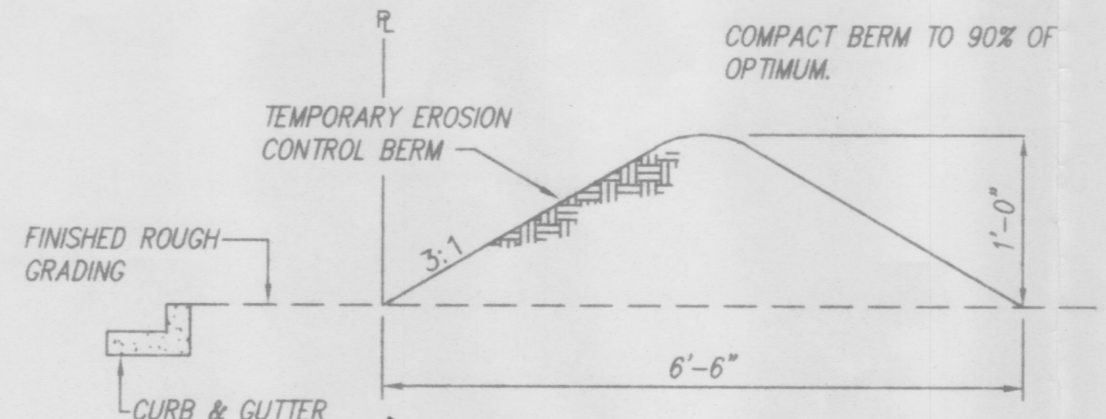


EROSION CONTROL BERM DETAIL

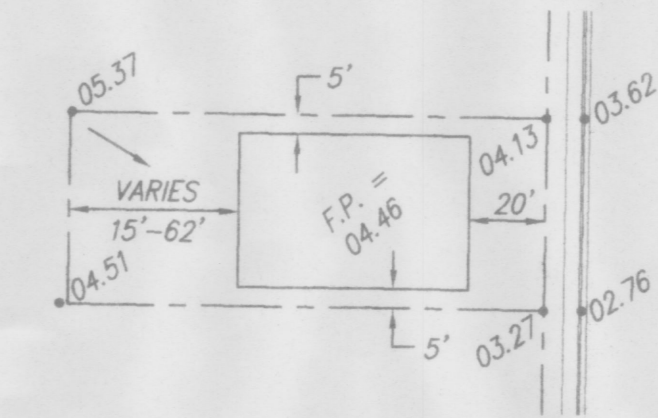

TYPICAL LOT GRADING DETAIL

SCALE: 1" = 50'

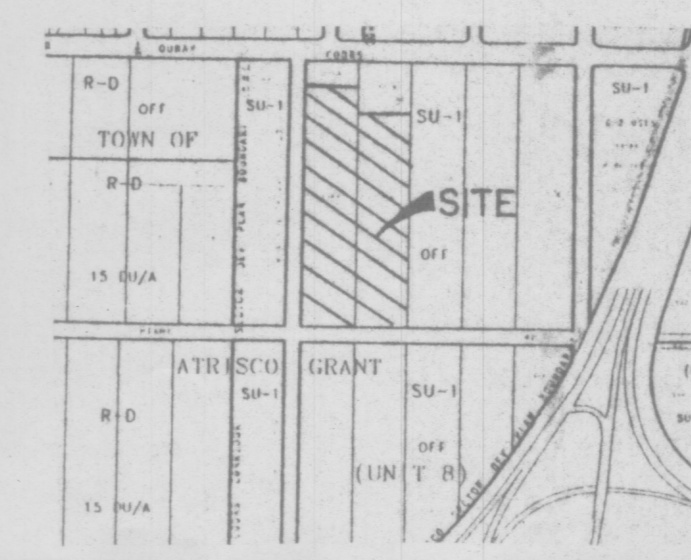

VICINITY MAP

TBM (TEMPORARY BENCHMARK)

LOCATED AT TOP OF FIRE HYDRANT ON NORTH BONNET BOLT ELEVATION = 5107.11

LEGAL DESCRIPTION

TOWN OF ATRISCO GRANT, TRACTS 337B & 338B

NOTES

1. CONTRACTOR MUST OBTAIN A TOPSOIL DISTURBANCE PERMIT FROM THE ENVIRONMENTAL HEALTH DIVISION PRIOR TO CONSTRUCTION.
2. CITY OF ALBUQUERQUE STANDARD SPECIFICATIONS FOR PUBLIC WORKS CONSTRUCTION, LATEST EDITION SHALL GOVERN ALL WORK.
3. THE CONTRACTOR SHALL CONFORM TO ALL CITY, COUNTY, STATE AND FEDERAL DUST CONTROL MEASURES AND REQUIREMENTS AND WILL BE RESPONSIBLE FOR PREPARING AND OBTAINING ALL NECESSARY APPLICATIONS AND APPROVALS.
4. THE CONTRACTOR SHALL ENSURE THAT NO SOIL ERODES FROM THE LOTS INTO PUBLIC RIGHT-OF-WAY. THIS CAN BE ACHIEVED BY CONSTRUCTING TEMPORARY BERMS AS PER DTL. THIS SHT. AND WETTING THE SOIL TO KEEP IT FROM BLOWING.
5. THE EARTHWORK CONTRACTOR SHALL STOCKPILE ENOUGH MATERIAL ADJACENT TO RETAINING WALL LOCATIONS TO BE UTILIZED FOR WALL BACKFILL.
6. ALL CONCRETE CURBING TO BE 4000 PSI @ 28 DAYS. REFER TO SECTION 101 OF CITY SPECIFICATIONS FOR FLYASH CONTENT.

PROPERTY LINE	EXISTING SPOT ELEVATION	EXISTING CONTOUR	EDGE OF ASPHALT	PROPOSED CONTOUR	PROPOSED SPOT ELEVATION	RETAINING WALL (DESIGN BY OTHERS)	FINISHED PAD	PROPOSED MOUNTABLE CURB & GUTTER	FLOW ARROW
---	+	-	---	-	+	---	F.P. =	---	---

dmg D. MARK GOODWIN & ASSOCIATES, P.A.
 CONSULTING ENGINEERS & SURVEYORS
 P.O. BOX 90606
 ALBUQUERQUE, NEW MEXICO 87199
 (505) 345-2010

CITY OF ALBUQUERQUE
 PUBLIC WORKS DEPARTMENT
 ENGINEERING GROUP

TOMPIRO SUBDIVISION
 GRADING AND DRAINAGE PLAN


APPROVALS	ENGINEER	DATE	APPROVALS	ENGINEER	DATE
DRC CHAIRMAN			WATER		
TRANSPORTATION			WASTE WATER		
HYDROLOGY					


PROJECT NO. 5096.90 MAP NO. 111 SHEET 4 OF 17




NO.	DATE	REMARKS	DESIGN	DATE	DATE
				12/94	12/94
				12/94	12/94
				12/94	12/94

VERTICAL 1"=10'
HORIZONTAL 1"=200'

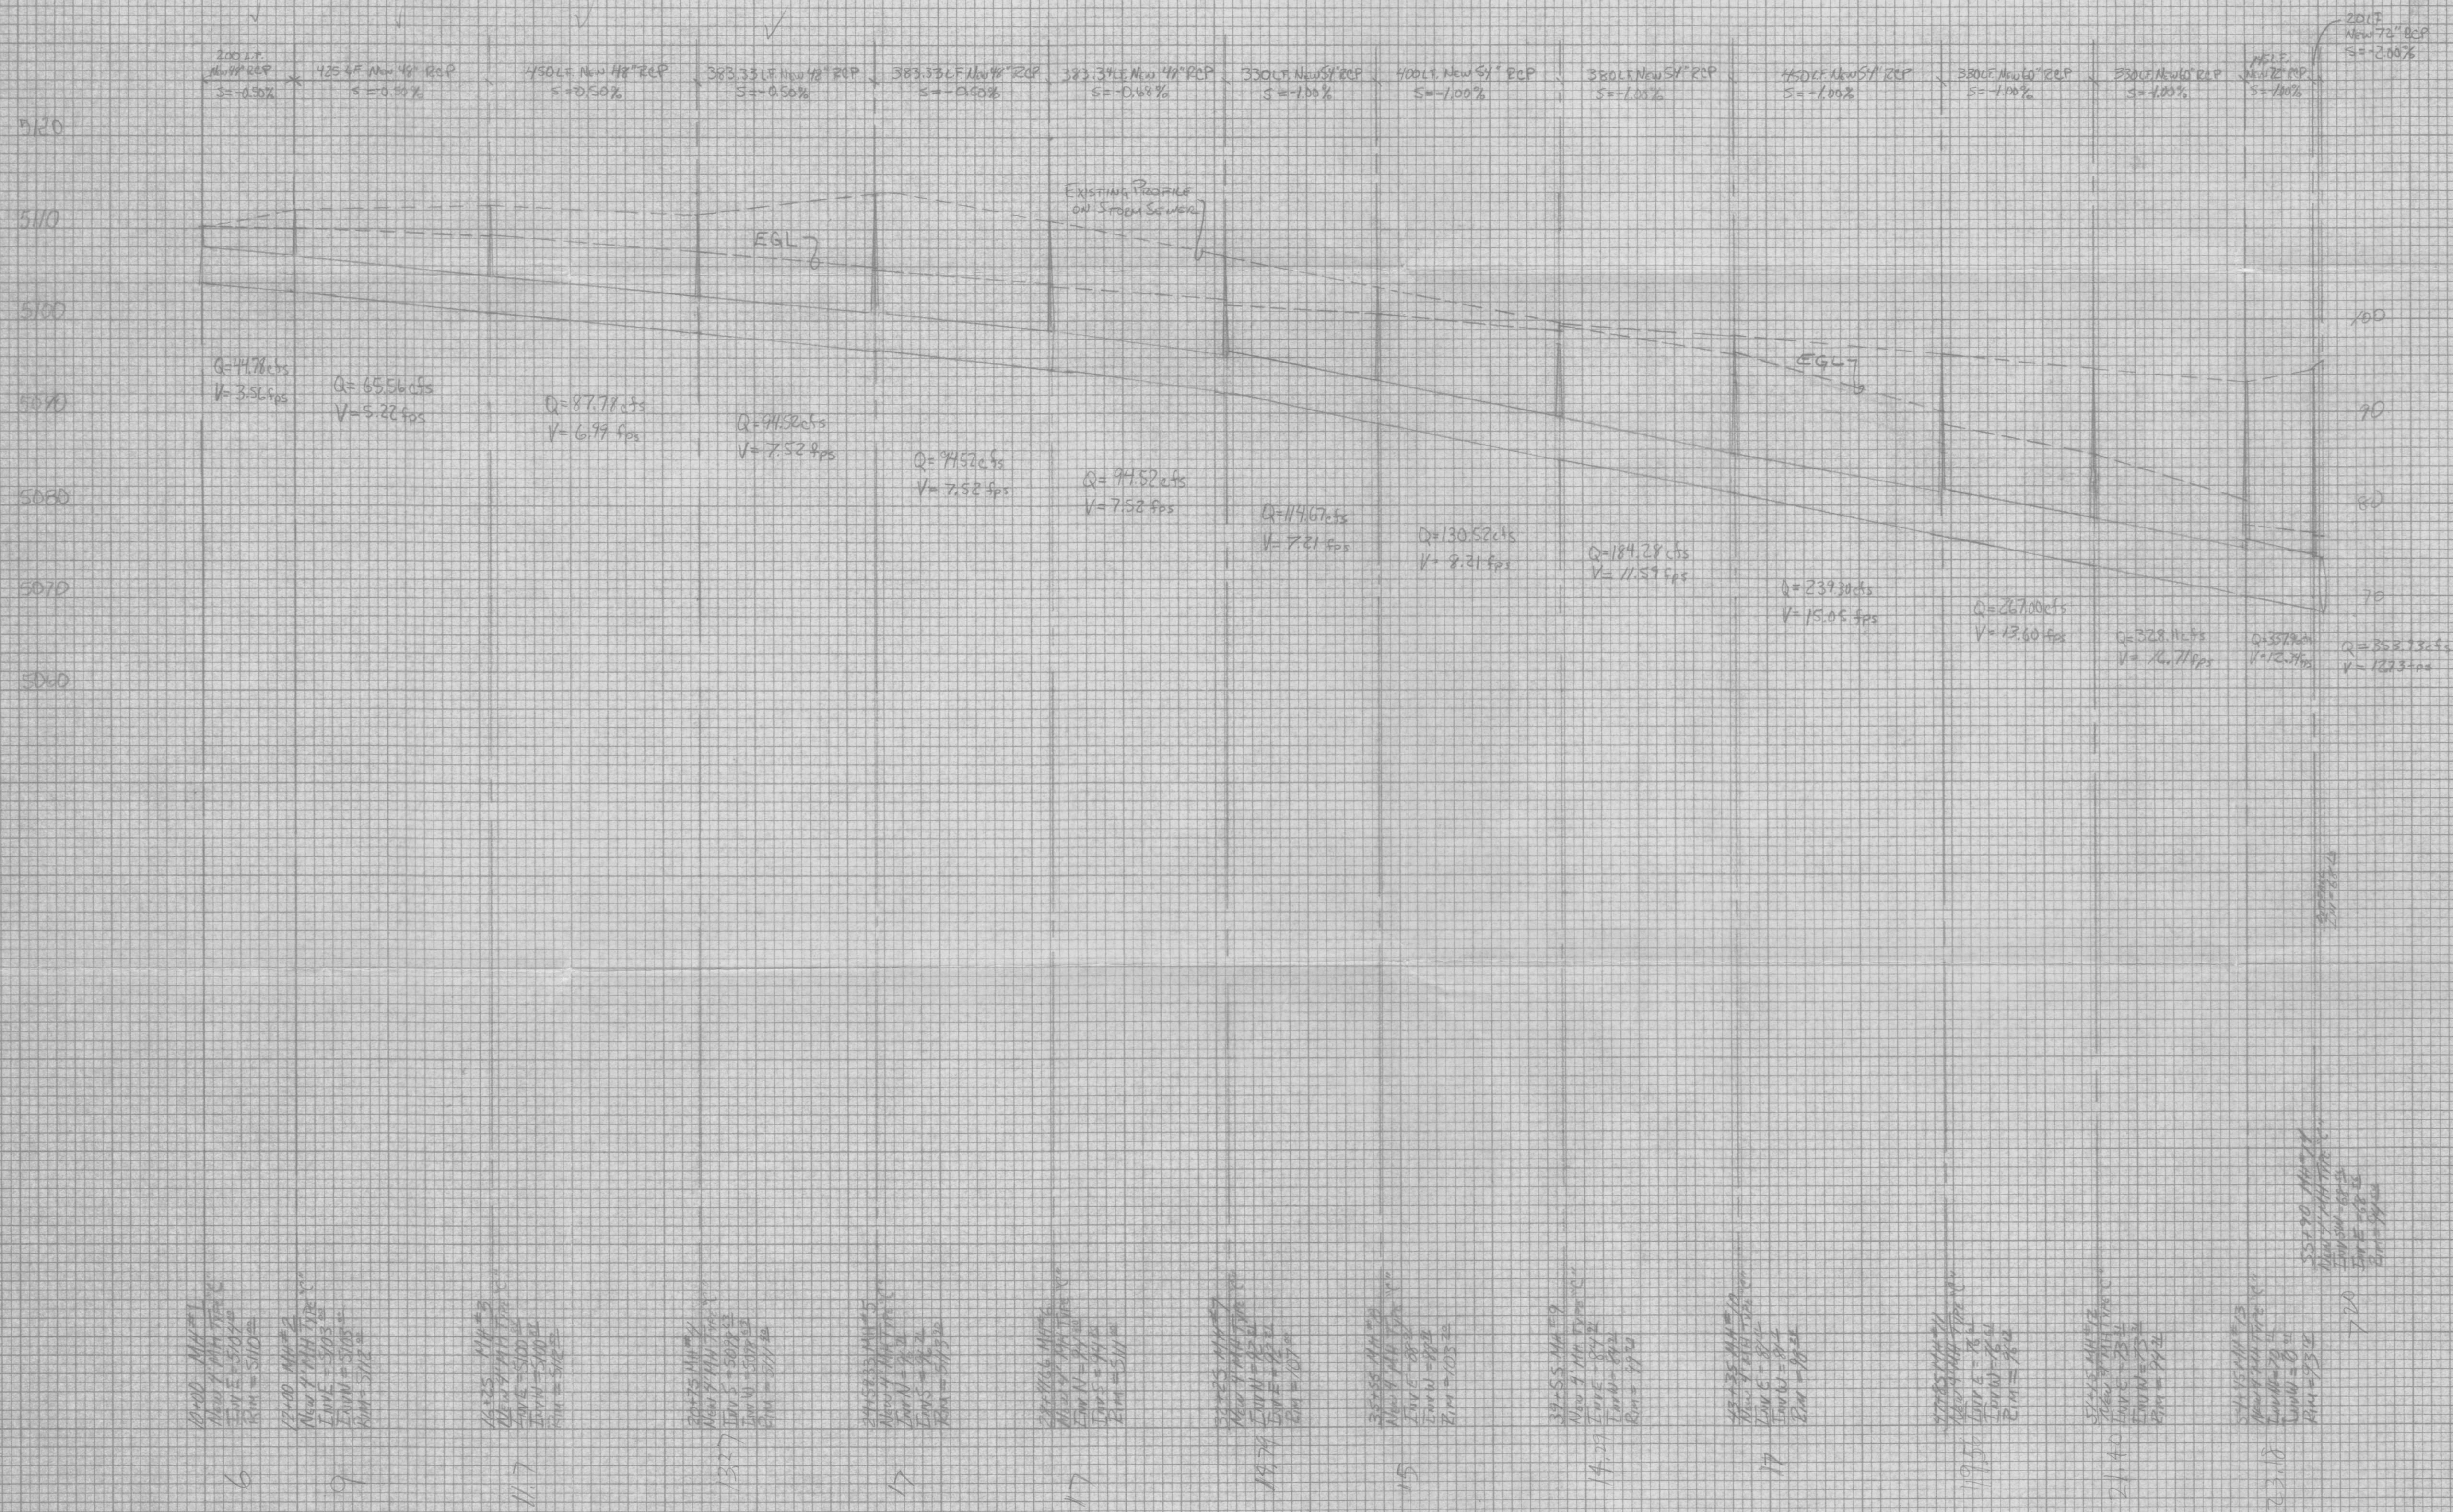

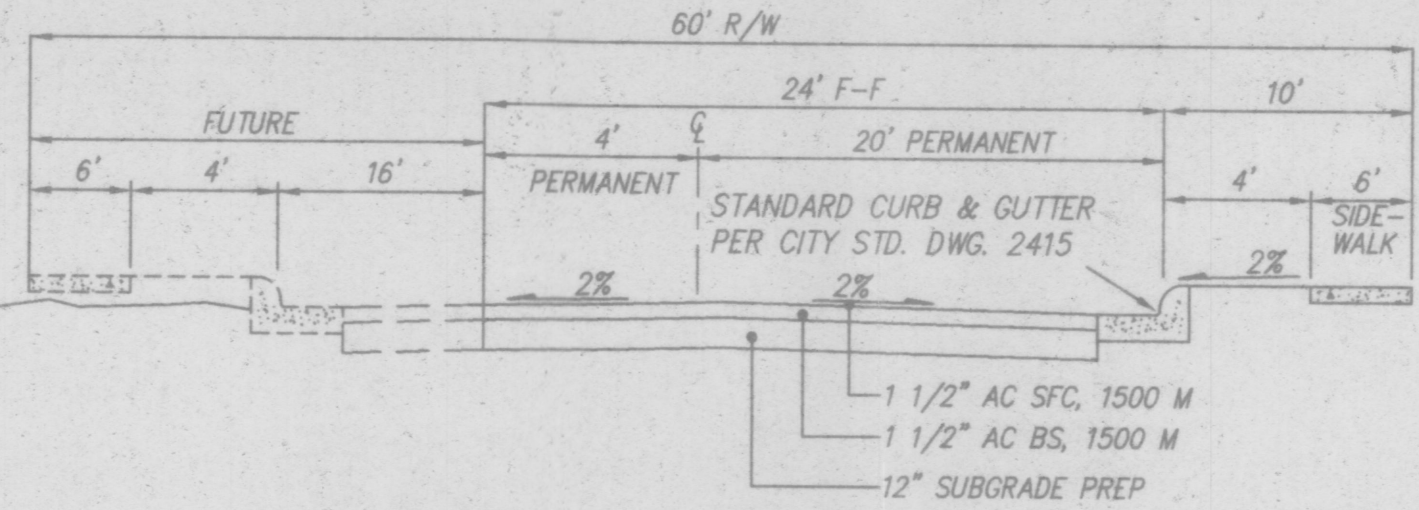

MIAMI ROAD N.W. SECTION

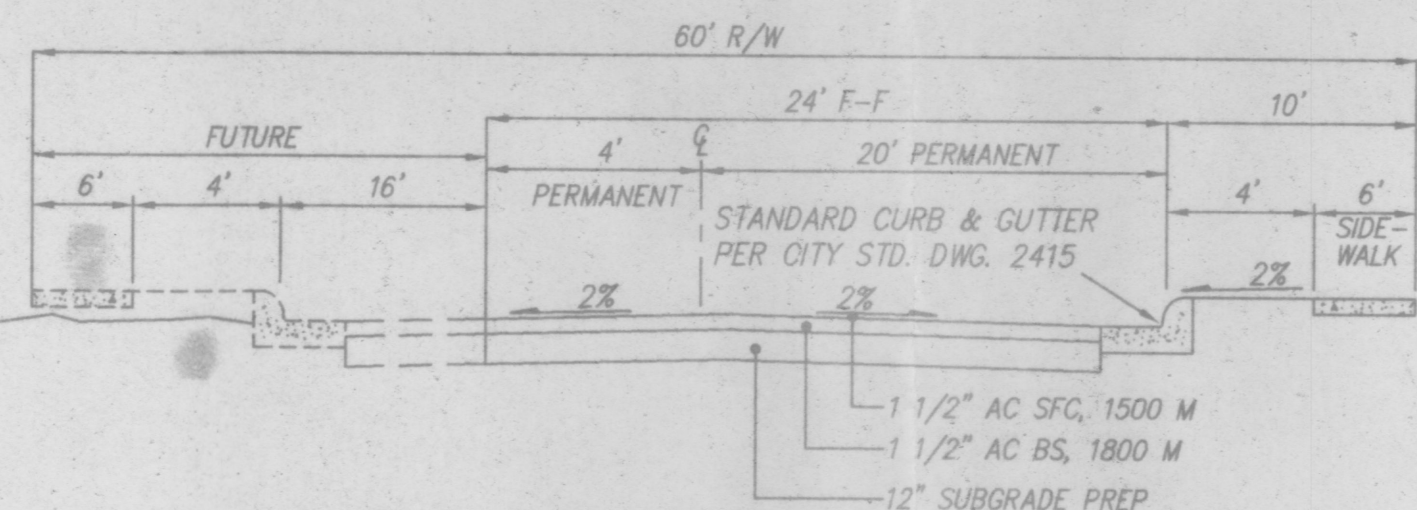

ESTANCIA DRIVE N.W. SECTION

RECORD DRAWING

I hereby certify that the information contained on this drawing has been revised in accordance with information furnished by the Contractor, Sundance Mechanical, and by the Surveyor, A.S. Inc., and reflects the construction as actually accomplished. This plan as constructed is in substantial compliance with the Approved Plan.

Gregory J. Krenik, NMPE 11929

11-16-95



VICINITY MAP

TBM (TEMPORARY BENCHMARK)

LOCATED AT TOP OF FIRE HYDRANT ON NORTH BONNET OF NORTHWEST CORNER OF PROPERTY. BOLT ELEVATION = 5107.11

LEGAL DESCRIPTION

TOWN OF ATRISCO GRANT, TRACTS 337B & 338B

NOTES

1. CONTRACTOR MUST OBTAIN A TOPSOIL DISTURBANCE PERMIT FROM THE ENVIRONMENTAL HEALTH DIVISION PRIOR TO CONSTRUCTION.
2. CITY OF ALBUQUERQUE STANDARD SPECIFICATIONS FOR PUBLIC WORKS CONSTRUCTION, LATEST EDITION SHALL GOVERN ALL WORK.
3. THE CONTRACTOR SHALL CONFORM TO ALL CITY, COUNTY, STATE AND FEDERAL DUST CONTROL MEASURES AND REQUIREMENTS AND WILL BE RESPONSIBLE FOR PREPARING AND OBTAINING ALL NECESSARY APPLICATIONS AND APPROVALS.
4. THE CONTRACTOR SHALL ENSURE THAT NO SOIL ERODES FROM THE LOTS INTO PUBLIC RIGHT-OF-WAY. THIS CAN BE ACHIEVED BY CONSTRUCTING TEMPORARY BERMS AS PER DTL. THIS SHD. AND WETTING THE SOIL TO KEEP IT FROM BLOWING.
5. THE EARTHWORK CONTRACTOR SHALL STOCKPILE ENOUGH MATERIAL ADJACENT TO RETAINING WALL LOCATIONS TO BE UTILIZED FOR WALL BACKFILL.
6. ALL CONCRETE CURBING TO BE 4000 PSI @ 28 DAYS. REFER TO SECTION 101 OF CITY SPECIFICATIONS FOR FLYASH CONTENT.

- LEGEND
- PROPERTY LINE
 - +00.33 EXISTING SPOT ELEVATION
 - 5094 EXISTING CONTOUR
 - EDGE OF ASPHALT
 - 90 PROPOSED CONTOUR
 - 00.05 PROPOSED SPOT ELEVATION
 - RETAINING WALL (DESIGN BY OTHERS)
 - F.P. FINISHED PAD
 - PROPOSED MOUNTABLE CURB & GUTTER
 - FLOW ARROW

dmg

D. MARK GOODWIN & ASSOCIATES, P.A.
CONSULTING ENGINEERS & SURVEYORS
P.O. BOX 90606
ALBUQUERQUE, NEW MEXICO 87199
(505) 345-2010

CITY OF ALBUQUERQUE
PUBLIC WORKS DEPARTMENT
ENGINEERING GROUP


TITLE: TOMPIRO SUBDIVISION GRADING AND DRAINAGE PLAN

APPROVALS	ENGINEER	DATE	APPROVALS	ENGINEER	DATE
DRC CHAIRMAN	3-28-95	3-28-95	WATER		
TRANSPORTATION	3-28-95	3-28-95	WASTE WATER		
HYDROLOGY	3-28-95	3-28-95			

PROJECT NO. 5096.90


MAP NO. H11

SHEET 4 OF 17

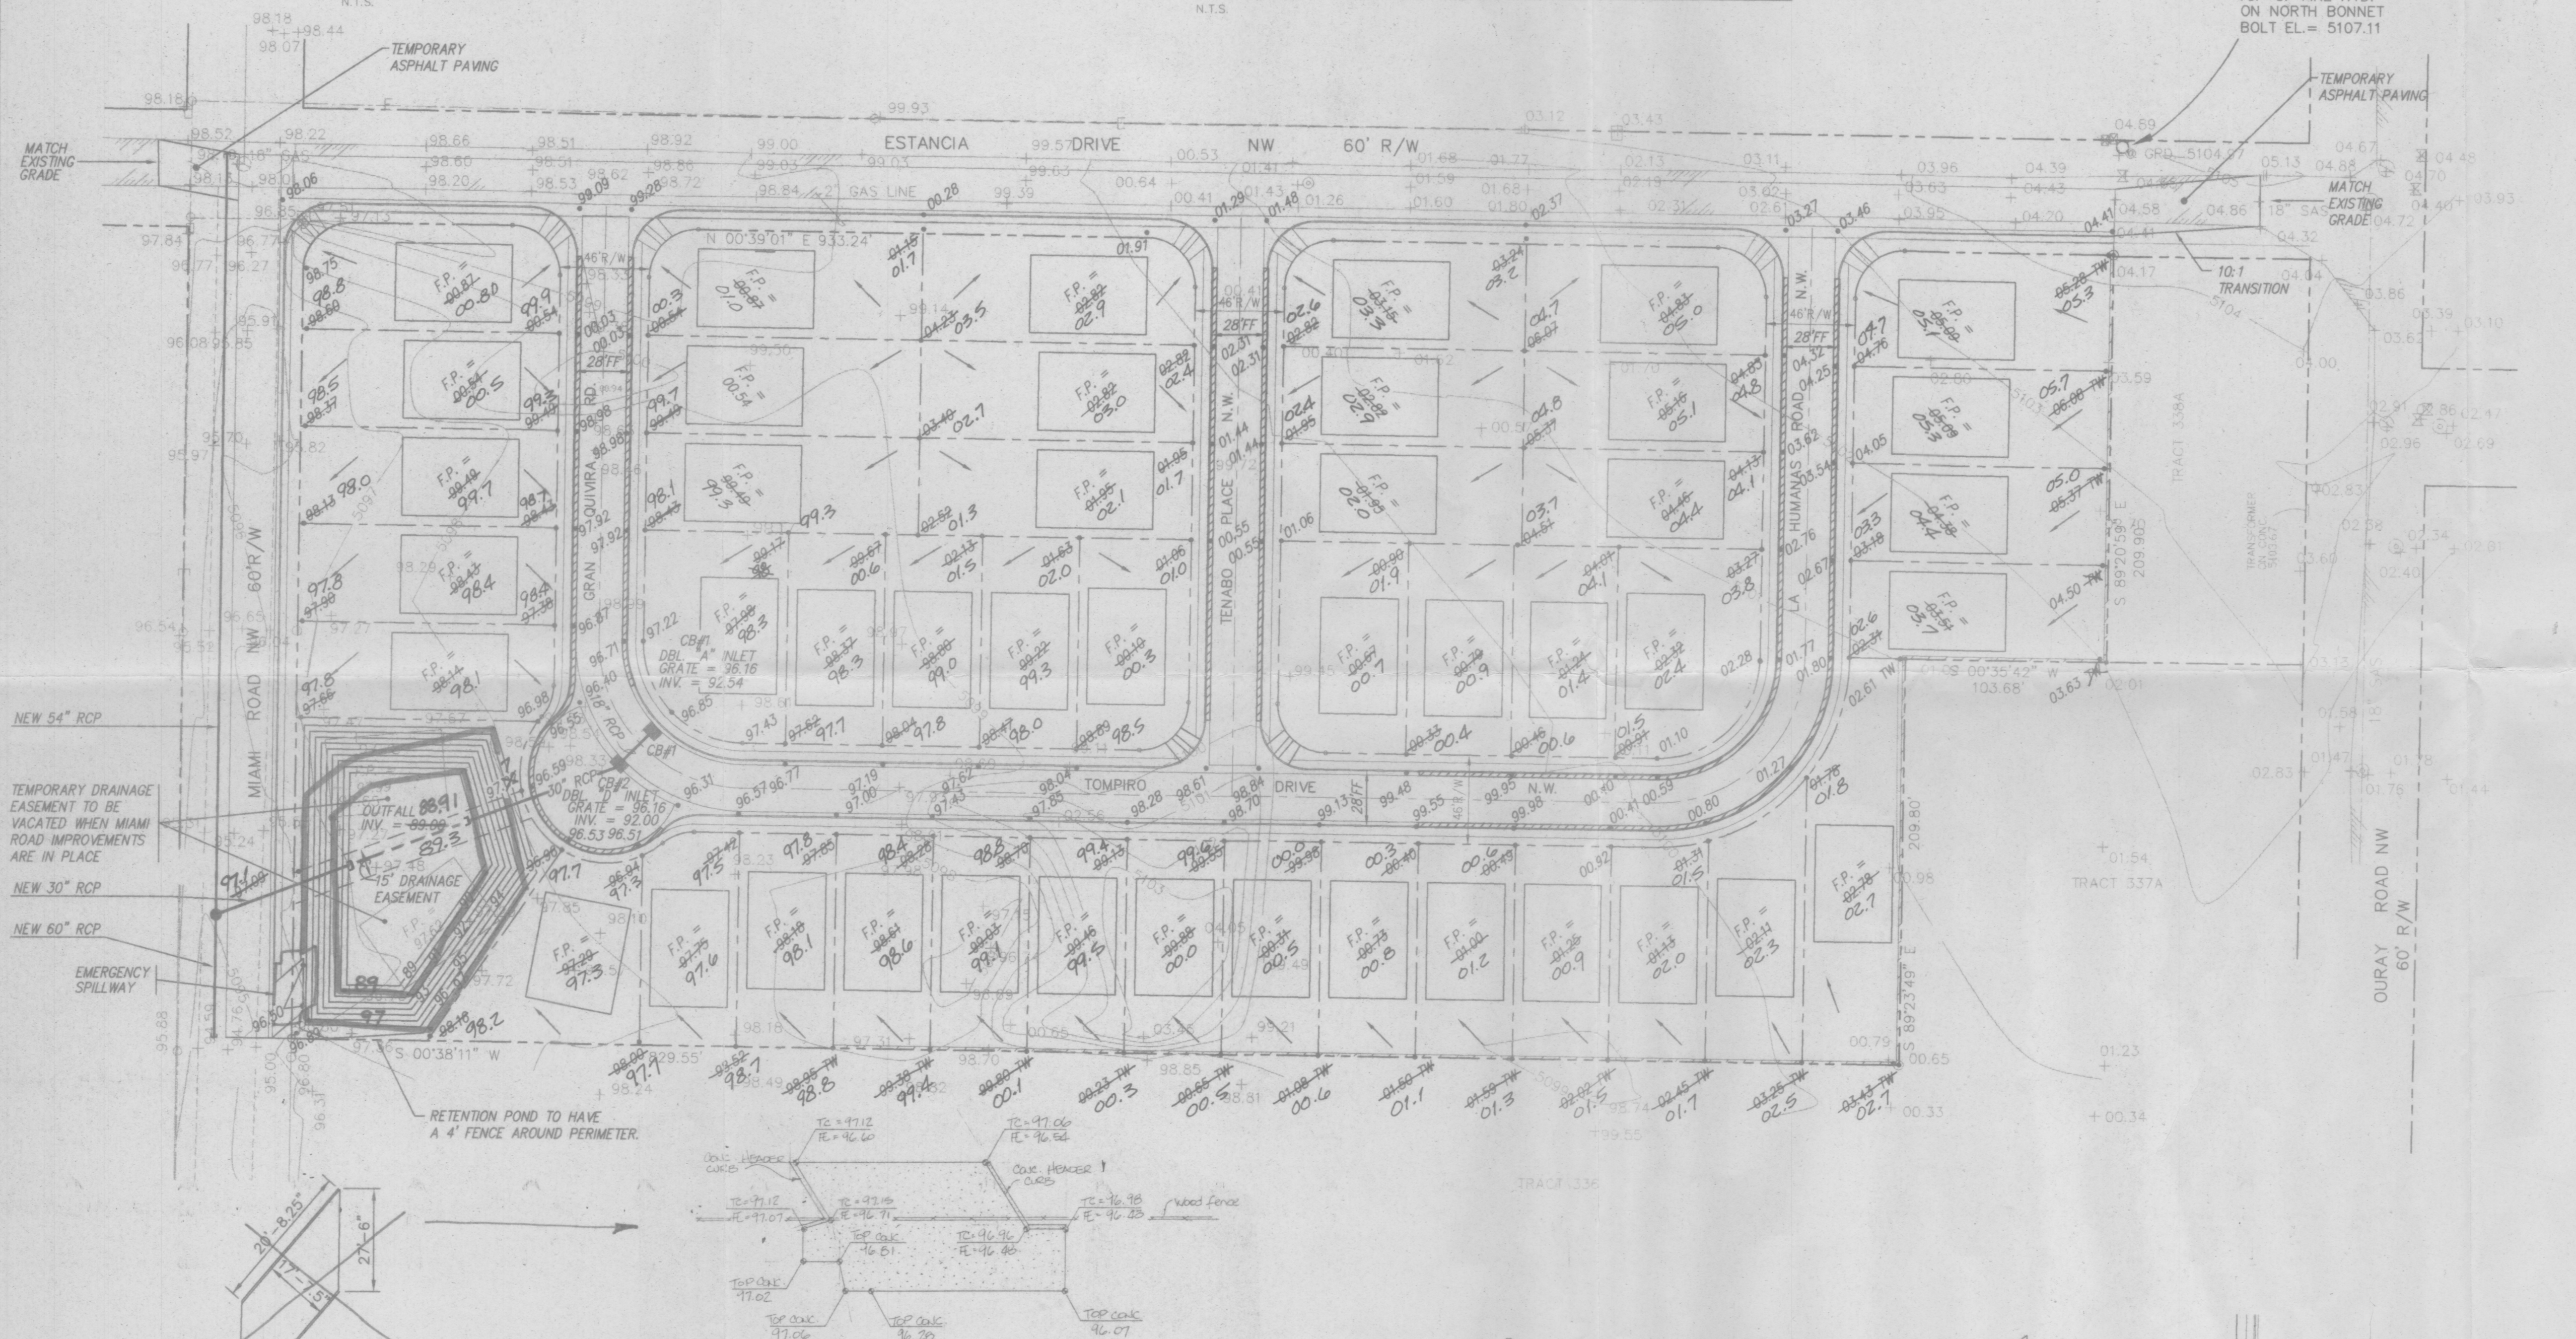


EROSION CONTROL NOTES

1. CONTRACTOR IS RESPONSIBLE FOR OBTAINING A TOPSOIL DISTURBANCE PERMIT PRIOR TO BEGINNING WORK.
2. CONTRACTOR IS RESPONSIBLE FOR KEEPING ALL SEDIMENT OUT OF EXISTING RIGHT-OF-WAY.
3. CONTRACTOR IS RESPONSIBLE FOR CLEANING UP ANY SEDIMENT THAT GETS INTO EXISTING RIGHT-OF-WAY.
4. EROSION CONTROL BERMS ARE REQUIRED AROUND THE ENTIRE SITE.
5. ALL EROSION CONTROL BERMS MUST BE IN PLACE AND ENGINEER CERTIFIED PRIOR TO BUILDING PERMIT RELEASE.

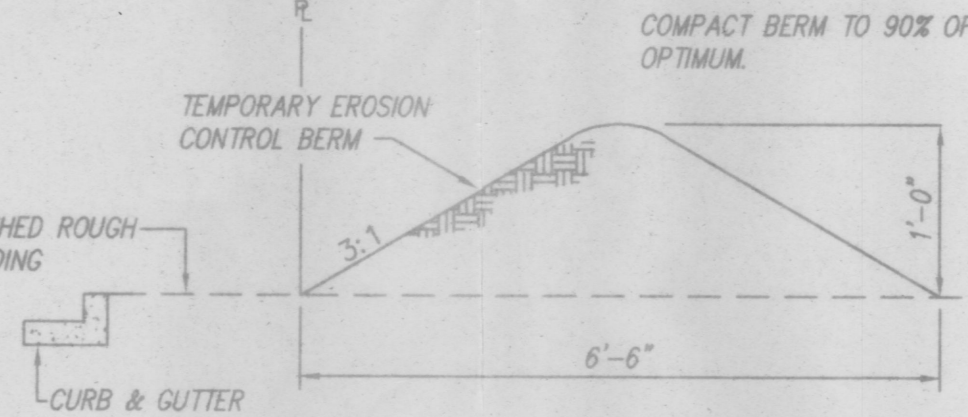

EROSION CONTROL BERM DETAIL

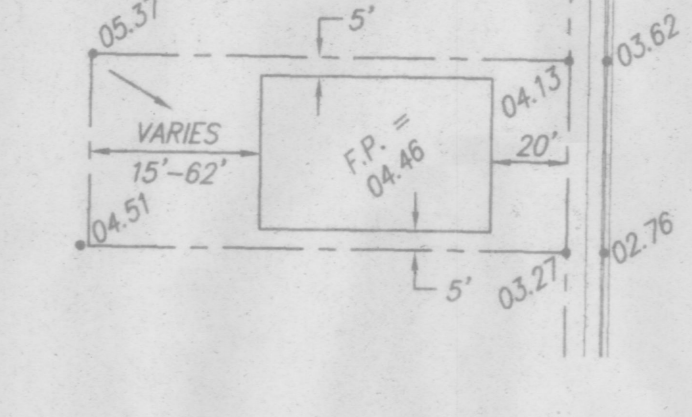

TYPICAL LOT GRADING DETAIL

SPILLWAY DETAIL

N.T.S.

SCALE: 1" = 50'