CITY OF ALBUQUERQUE



February 13, 2020

Jeremy Shell RESPEC 5971 Jefferson St. NE Suite 101 Albuquerque, NM 87109

Re: US Eagle FCU Juan Tabo 1955 Juan Tabo Blvd. NE

Traffic Circulation Layout

Engineer's/Architect's Stamp 11-21-2019 (H21D029)

Dear Mr. Shell,

Based upon the information provided in your submittal received 02-07-2020, the above referenced plan cannot be approved for Building Permit until the following comments are addressed:

- 1. List the number of parking spaces including bicycle and motorcycle parking required by the zoning code.
- The ADA accessible parking sign must have the required language per 66-7-352.4C NMSA 1978 "Violators Are Subject to a Fine and/or Towing." Please call out detail and location of signs. <u>Please include the detailed sheet.</u>
- The ADA access aisles shall have the words "NO PARKING" in capital letters, each of which shall be at least one foot high and at least two inches wide, placed at the rear of the parking space so as to be close to where an adjacent vehicle's rear tire would be placed. (66-1-4.1.B NMSA 1978)
- 4. ADA curb ramps must be updated to current standards and have truncated domes installed.
- 5. Motorcycle parking spaces shall be designated by its own conspicuously posted upright sign, either free-standing or wall mounted per the zoning code.
- 6. All bicycle racks shall be designed according to the following guidelines:
 - a. The rack shall be a minimum 30 inches tall and 18 inches wide.
 - b. The bicycle frame shall be supported horizontally at two or more places. Comb/toaster racks are not allowed.
 - c. The rack shall be designed to support the bicycle in an upright position. See the IDO for additional information.
 - d. The rack allows varying bicycle frame sizes and styles to be attached.
 - e. The user is not required to lift the bicycle onto the bicycle rack.
 - f. Each bicycle parking space is accessible without moving another bicycle.

PO Box 1293

Albuquerque

NM 87103

www.cabq.gov

- 7. Bicycle racks shall be sturdy and anchored to a concrete pad.
- 8. A 1-foot clear zone around the bicycle parking stall shall be provided.
- Bicycle parking spaces shall be at least 6 feet long and 2 feet wide.
- 10. The 9' drive-thru lane is too narrow.
- 11. Per the IDO, a 6 ft. wide ADA accessible pedestrian pathway is required from the public sidewalk to the building entrances. Please clearly show this pathway and provide details.
- **12.** Refuse vehicle maneuvering shall be contained on-site. The refuse vehicle shall not back into the public right of way.; **provide a copy of refuse approval**.
- 13. All one-way drives shall have "One Way" and "<u>Do Not Enter" signage</u> and pavement markings. Please show detail and location of posted signs and striping.
- 14. Shared Site acces: driveways that straddle property lines, or are entirely on one propertybut are to be used by another property, shall have an access easement. Please include a copy of your shared access agreement with the adjacent property owner.
- 15. The alley needs to be improved.
- 16. Work within the public right of way requires a work order with DRC approved plans.
- 17. Please add a note on the plan stating "All improvements located in the Right of Way must be included on the work order."
- 18. Add a note stating "All broken or cracked sidewalk must be replaced with sidewalk and curb & gutter." A build note must be provided referring to the appropriate City Standard drawing.

CITY OF ALBUQUERQUE



Once corrections are complete resubmit

- 1. The Traffic Circulation Layout
- 2. A Drainage Transportation Information Sheet (DTIS)
- 3. Send an electronic copy of your submittal to PLNDRS@cabq.gov.
- 4. The \$75 re-submittal fee.

for log in and evaluation by Transportation. If you have any questions, please contact me at (505) 924-3675.

Sincerely,

Mojgan Maadandar, E.I.

Associate Engineer, Planning Dept. Development Review Services

PO Box 1293

\MM via: email


C: CO Clerk, File

Albuquerque

NM 87103

www.cabq.gov

SITE INFORMATION **PROJECT NAME: US EAGLE FEDERAL CREDIT UNION** MUNICIPALITY: CITY OF ALBUQUERQUE PROJECT ADDRESS: 1955 JUAN TABO BLVD NE ALBUQUERQUE, NM 87112 ACRE / AREA: 0.70 ACRES ZONE: MX-L MX-L; R-1B ADJACENT ZONING: USES: LOW INTENSITY MIXED-USE; SINGLE-FAMILY (MEDIUM LOT) RESIDENTIAL SETBACKS: FRONT YARD: 5 FT. SIDE YARD: **REAR YARD:** 15 FT. 35 FT. **HEIGHT LIMIT:** REQUIRED 10 SPACES* *(3 PER 1,000 SQ FT GFA) Brentwood Hills Blvd. N.E. REQUIRED PROVIDED 15% NET LOT AREA 37% NET LOT AREA OPEN SPACE PROVIDED **LEGAL:** LOT 14-G, BLOCK 95-A, SNOW HEIGHTS BUFFER #S1EAGLE Lot 14-F, Block 95-A Snow Heights (1/30/1979, Bk. B15, Pg. 192)

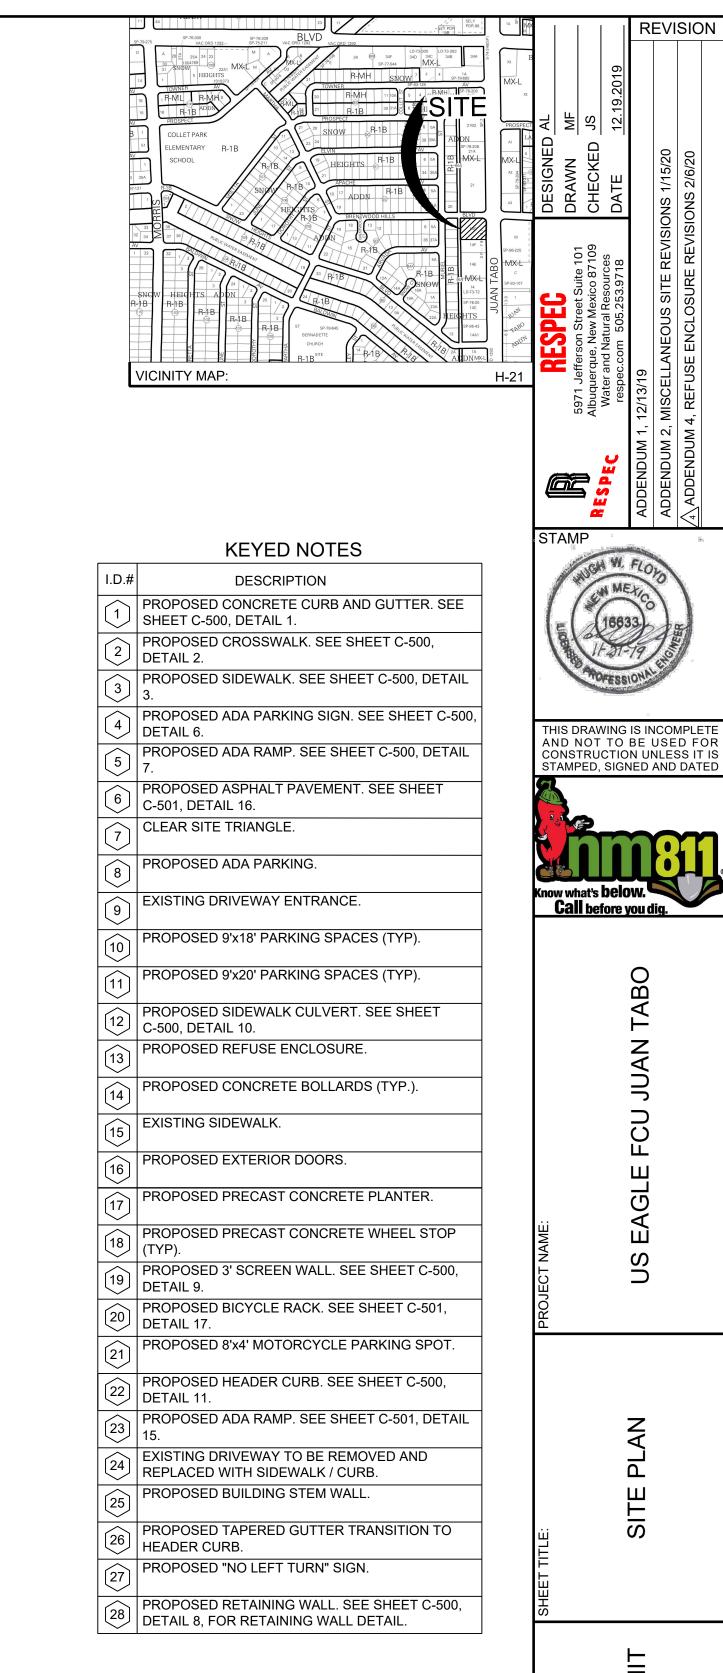

REVISION

Ш

Ш

NS

SITE


BUILDING

SHEET NUMBER:

<u>LEGEND</u> PROPERTY LINE ACCESSIBLE PARKING

SPACES



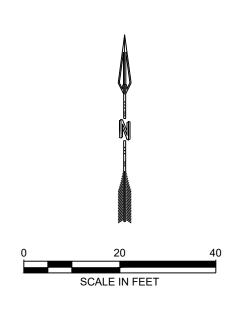

© Copyright 2020 RESPEC - All Rights Reserved