






(CE)

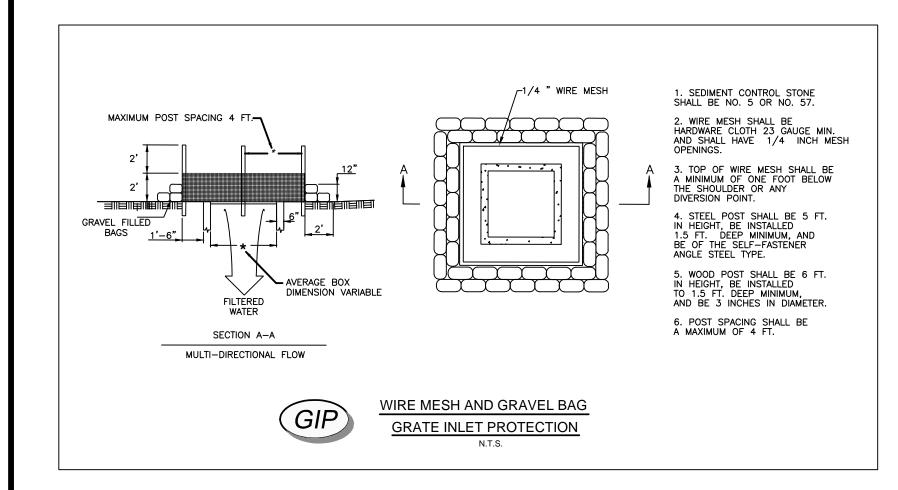

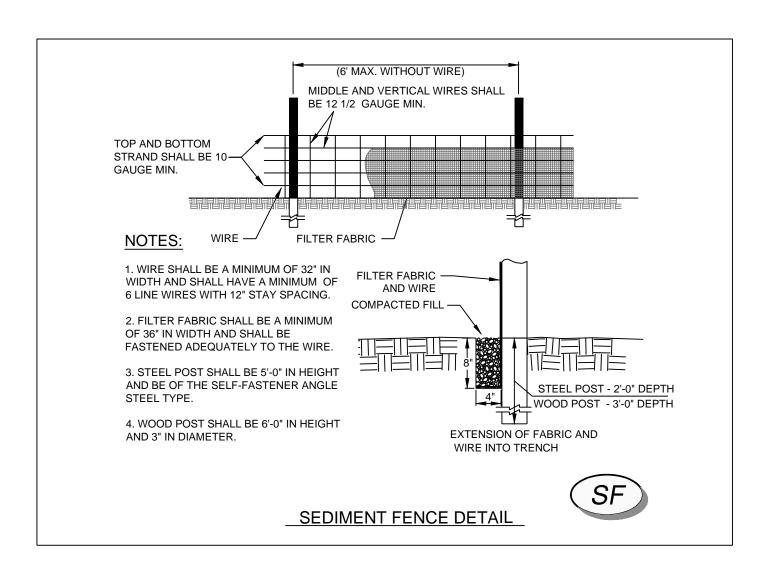

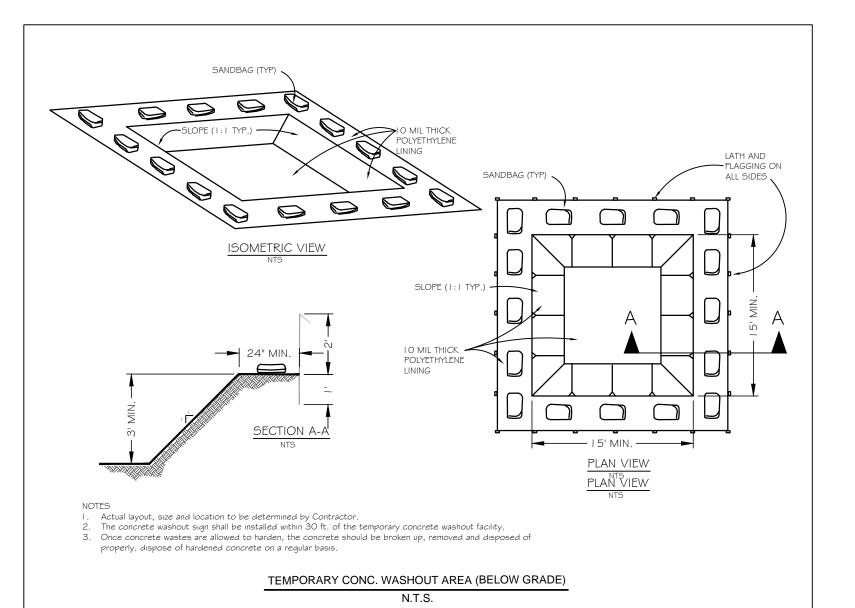

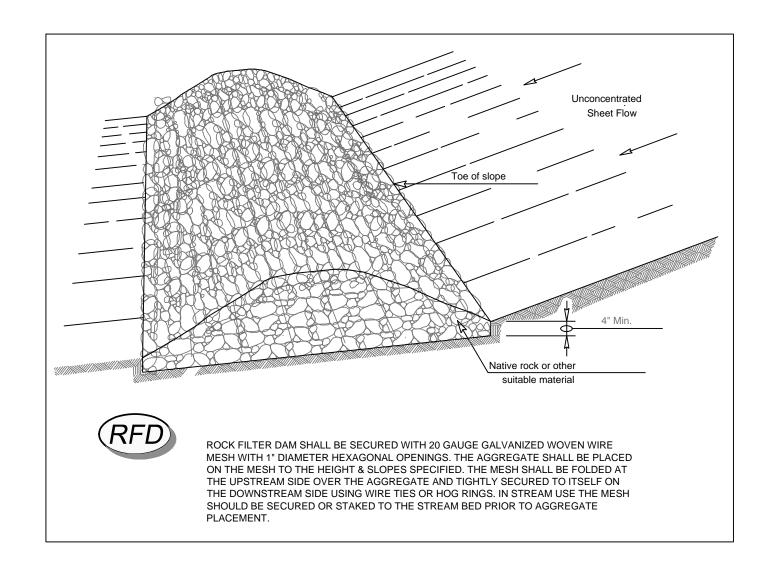

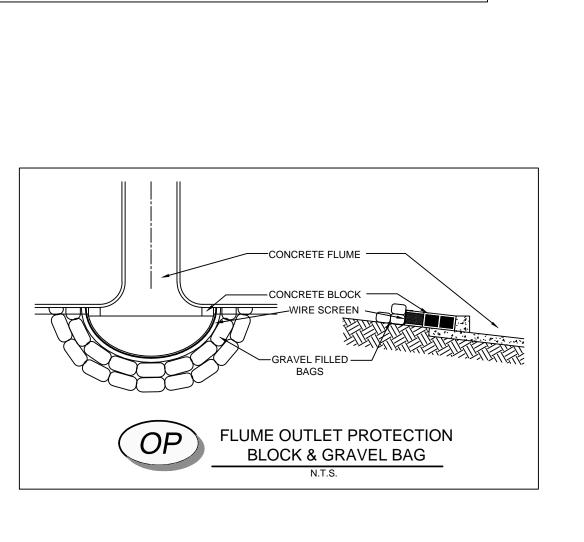

STABILIZED CONSTRUCTION ENTRANCE

CRUSHED PORTLAND CEMENT CONCRETE.

USING APPROVED METHODS.

BE REMOVED IMMEDIATELY.

DEPTH IN ALL OTHER CASES SHALL BE 50 FEET.

3. THE THICKNESS SHALL NOT BE LESS THAN 8 INCHES.

1. STONE SHALL BE 2 TO 3 INCH DIAMETER CRUSHED ROCK OR ACCEPTABLE

2. LENGTH SHALL BE SHOWN ON PLANS, WITH A MINIMUM LENGTH OF 30 FEET FOR LOTS WHICH ARE LESS THAN 150 FEET FROM EDGE OF PAVEMENT. THE MINIMUM

4. THE WIDTH SHALL BE NO LESS THAN THE FULL WIDTH OF ALL POINTS OF INGRESS

DONE ON AN AREA STABILIZED WITH CRUSHED STONE WITH DRAINAGE FLOWING

AWAY FROM BOTH THE STREET AND THE STABILIZED ENTRANCE. ALL SEDIMENT

6. THE ENTRANCE SHALL BE MAINTAINED IN A CONDITION WHICH WILL PREVENT


TO PREVENT RUNOFF FROM LEAVING THE CONSTRUCTION SITE.

TRACKING OR FLOWING OF SEDIMENT ONTO PAVED SURFACES. THIS MAY REQUIRE PERIODIC TOP DRESSING WITH ADDITIONAL STONE AS CONDITIONS DEMAND. ALL SEDIMENT SPILLED, DROPPED, WASHED OR TRACKED ONTO PAVED SURFACES, MUST

7. THE ENTRANCE MUST BE PROPERLY GRADED OR INCORPORATE DRAINAGE SWALE

5. WHEN NECESSARY, VEHICLES SHALL BE CLEANED TO REMOVE SEDIMENT PRIOR TO ENTRANCE ONTO A PUBLIC ROADWAY. WHEN FLASHING IS REQUIRED. IT SHALL BE

SHALL BE PREVENTED FROM ENTERING ANY STORM DRAIN, DITCH OR WATERCOURSE

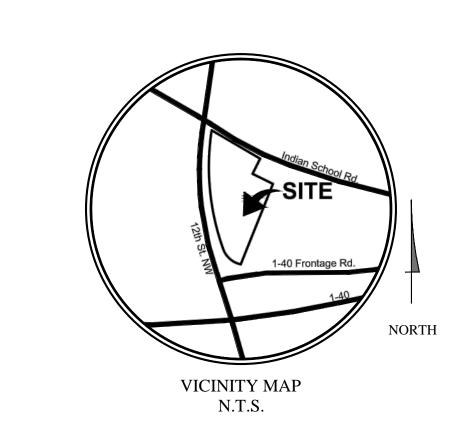

GENERAL NOTES

- Bases, anchor bolts, conduit, and wiring for all signs are by the General Contractor. 3/4" empty conduit to locations shown at the lot perimeter for lot lighting is by the General
- Contractor. Lighting fixtures, bases, poles, conduit, and wiring are by the General Contractor. Lot lighting concrete footings to conform with the soils report recommendations for this site. Bases for flagpoles are by the General Contractor. Anchor bolts are by the flagpole supplier.
- General contractor shall coordinate with flag pole supplier prior to construction. The Contractor shall coordinate with all utility companies to determine exact point of service connection at existing utility. Refer to the building electrical and plumbing drawings for utility service entrance locations, sizes, and circuiting.
- General Contractor <u>must</u> provide <u>exact</u> "as built" information upon completion. All elevations shown are in reference to the benchmark and must be verified by the General Contractor at groundbreak.
- Curb elevations shall be 6" above finish pavement unless noted otherwise. 9. All landscape areas shall be rough graded to 6" below top of all walks and curbs. Finished
- grading, landscaping and sprinkler systems are by the Owner / Operator.
- 10. It is strongly recommended that no contractual agreements of any kind be signed prior to receiving and thoroughly reviewing all approvals from all of the regulatory authorities having jurisdiction over this project.
- 1. Due to the nature of the work, all dimensions shown shall be considered approximate. Contractor shall field verify all dimensions prior to beginning construction. Shop drawings shall be submitted to the Architect and/or Engineer for approval prior to fabrication or installation of any item. Failure to adhere to this procedure shall place full responsibility for any errors directly upon the Contractor.
- 12. Contractor shall contact appropriate jurisdictional agencies prior to construction to confirm if independent testing or inspections will be required prior to their acceptance of work. Contractor shall make necessary arrangements to insure proper testing & inspections are documented such that work will be accepted at project completion. 13. Sidewalks around building shall have same subgrade preparation as building foundation.
- 14. All materials and construction within easements and R.O.W. shall conform to all governing authorities' jurisdictional standard construction details and specifications.
- 15. Topographic information taken from a Topographic Survey performed by Millman National Land Services. The Contractor shall notify the Engineer immediately, in writing, of any discrepancies or omissions to the topographic information. The Contractor(s) shall be responsible for confirming the location (horizontal/vertical) of any buried cables, conduits, pipes, and structures (storm sewer, sanitary sewer, water, gas, television, telephone, etc.) which impact the construction site. The Contractor(s) shall notify the Owner and Engineer if any discrepancies are found between the actual conditions versus the data contained in the construction plans. Any costs incurred as the result of not confirming the actual location (horizontal/vertical) of said cables, conduits, pipes, and structures shall be borne by the Contractor. Additionally, the Contractor(s) shall notify the Owner and Engineer if any errors or discrepancies are found on the construction documents (ps&e), which negatively impact the project. The Engineer and Owner shall be indemnified of problems and/or cost which may result from Contractor's failure to notify Engineer and Owner.
- 16. McDonald's reserves the right to request a compaction and/or a core sample. If tests prove correct, per the soils report, tests will be at the expense of McDonald's, otherwise G.C. will be
- Contractor shall comply to the fullest extent with the latest standards of OSHA directives or any other agency having jurisdiction for excavation and trenching procedure. Contractor shall use support systems, sloping, benching, or other means of protection, including but is not limited to, access and egress from all excavation and trenching. Contractor is responsible to comply with performance criteria for OSHA.

NOTE: ALL PAVING & SUBGRADE SPECIFICATIONS TO COMPLY WITH GEOTECHNICAL REPORT AS PREPARED BY:		TERRACON CO JANUARY 23, 2013 PROJECT NO. 661350		, INC.	
	ASPHALT PAVEMENT	RECOMMENDATION			
	PAVEMENT MATERIALS	LIGHT DUT	/ HEAVY	DUTY	
	Asphalt Surface Course	3" 4-	1/2" 4"	5-1/2"	
	Aggregate Base Course	6" OR —	6"	K —	
	CONCRETE PAVEM	ENT RECOMMENDATIONS - BASE BID			
	PAVEMENT MATERIALS	LIGHT DUTY	/ HEAVY	DUTY	
	Death of Occasion DVA	- FI		/O.II	

VERIFY W/MCDONALD'S: ASPHALT: CONCRETE: X

CONTRACTOR TO BID: ASPHALT: X CONCRETE: X

VEMENT NOTES:
PAVEMENT AND SUBGRADE SHALL BE PREPARED IN ACCORDANCE WITH THE

PAVING SPECIFICATION

- GEOTECHNICAL REPORT PREPARED BY TERRACON CONSULTANTS, INC. DATED JANUARY 23, 2013. [PROJECT NO. 66135002]
- SUBGRADE SHOULD BE SCARIFIED AND COMPACTED TO AT LEAST 98 PERCENT OF THE STANDARD PROCTOR (ASTM D 698) MAXIMUM DRY DENSITY FOR A DEPTH OF AT LEAST 10 INCHES BELOW THE SURFACE. SEE SECTION 4.2 OF GEOTECH REPORT PAVEMENT MAY BE PLACED AFTER THE SUBGRADE HAS BEEN PROPERLY COMPACTED,

FINE-GRADED AND PROOF ROLLED AS SPECIFIED IN THE SOILS REPORT.

- ALL WORK SHALL BE IN ACCORDANCE WITH THE NEW MEXICO STATE DEPARTMENT OF TRANSPORTATION SPECIFICATIONS AND THE CITY OF ALBUQUERQUE SPECIFICATIONS. 5 WATER SHOULD NOT BE ALLOWED TO POND BEHIND CURBS AND SATURATE THE BASE MATERIALS. GRANULAR BASE MATERIAL SHOULD EXTEND THROUGH THE SLOPE PROVIDING UNDERGROUND DRAINAGE AN EXIT PATH.
- 6. REFER TO C10.2 FOR CONCRETE JOINT SPECIFICATIONS UNLESS NOTED OTHERWISE IN THE SOILS REPORT.
- ALL CONCRETE PAVEMENT SHALL BE 4,000 PSI @ 28 DAYS AND REINFORCED WITH #3 BARS @ 18" O.C.E.W. 8. IT SHALL BE THE CONTRACTORS RESPONSIBILITY TO REFER TO GEOTECHNICAL
- REPORT FOR ADDITIONAL INFORMATION. THE INFORMATION ABOVE IS BEING PROVIDED FOR REFERENCE ONLY AND SHALL NOT BE RELIED ON AS ACCURATE. THE

		~	∣⊇		
SURVEY INFORMATION					
PREPARED BY: ILLMAN NATIONAL LAND SERVIC: 42 GEORGETOWN ROAD, SUITE H	LEGAL DESCRIPTION: ES TRACT "E", LAND OF ST. ANTHONY'S ORPHANAGE,	PLAN	SIGNATU		
JDSON, OH 44236 00) 520-1010 NTE: DECEMBER 29, 2012	PLAT BOOK D6, PAGE 158, RECORDS OF BERNALILLO COUNTY, NM				
PLAN SCALE: N.T.S.				. MGR	MGR.
ADDITIO	N			REGIONAL MGR.	CONST. M
STREET ADD	PRESS				
C OF 12TH ST. & INDIAN SCHOOL RD.			STAT	rus	
CITY STATE		DATE DRAWN			
I DITOTTEDOTTE					

ı	STREET ADDRESS				
	SEC OF 12TH ST. & IN	NDIAN SCHOO			
	CITY	STATE			
	ALDIMIEDALE				

II ALBUQUERQUE NEW MEXICO PLAN CHECKED COUNTY: ABSTRACT NO. BERNALILLO L/C NUMBER: CORPORATE DWG. NAME

EROSION CONTROL DETAILS

AS-BUILT

DATE

11/19/13

