CITY OF ALBUQUERQ



Planning Department Transportation Development Services

January 14, 2016

James Lewis 904 Princeton SE Albuquerque, NM

Re: Range Cafe

> 1050 Rio Grande NW **Traffic Circulation Layout**

Engineer's/Architect's Stamp dated 1-5-16 (H13-D029)

Dear Mr. Lewis,

Based upon the information provided in your submittal received 1-5-16-15, the above referenced plan cannot be approved for Building Permit until the following comments are addressed:

PO Box 1293

- Please show a vicinity map showing the location of the development in relation 1. to streets and well known landmarks.
- 2. Please detail and dimension all existing sidewalks, curb ramps and curb cuts on Rio Grande Blvd. to ensure compliance to ADA standards. Detail "S" on drawing refers to curb ramp on ADA access isle. Key Notes #2, 3 and 7 do not give dimension to existing northern entrance/exit, sidewalk and ramps.
- 3. Please dimension existing sidewalk along building. Detail "E" shows a dimension of 6 ft. for the sidewalk at the ADA access point. Please clarify width
- of entire sidewalk. Key Note #5 does not give a dimension.
- The handicap accessible spaces must include an 8-foot wide van access aisle; 4. all other aisles should be 5 feet in width. The ADA parking access isle along the building's south entrance is only shown to be 5 ft. wide, Key Note #17 calls out dimension of 8 Ft. Please clarify dimension of access isle. Also, Key Note #16 does not call out a dimension for the existing ADA parking space.
- 5. Please call out the distance between abutting parking spaces on the south side of building.
- 6. Per the DPM, a 6 ft. wide ADA accessible pedestrian pathway is required from the HC parking stall access aisles to the building entrances. Please clearly show and dimension side walk width. Key Note #5 does not give a dimension.
- Please provide a sight distance exhibit (see the Development Process Manual, 7. Chapter 23, Section 3, Part D.5 Intersection Sight Distance). Please show this detail for both entrances from Rio Grande Blvd. Detail "O" and "T" both detail the Clear Sight for the northern entrance.


Albuquerque

New Mexico 87103

www.cabq.gov

CITY OF ALBUQUERQUE



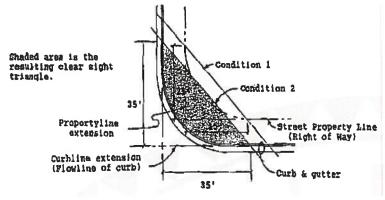

- 8. Please add the following note to the clear sight triangle: "Landscaping and signage will not interfere with clear sight requirements. Therefore, signs, walls, trees, and shrubbery between 3 and 8 feet tall (as measured from the gutter pan) will not be acceptable in this area." This note must be on the drawing.
- 9. Future Drive Cut Key (Note #52) will require an easement and access agreement with adjacent property owner. Parking space will not be allowed in this easement area and must be subtracted from parking space calculations.

PO Box 1293

 Please include a copy of your shared access agreement with the adjacent property owner.

Albuquerque

- 11. All broken or cracked sidewalk must be replaced with sidewalk and curb & gutter. A build note must be provided referring to the appropriate City Standard drawing.
- 12. Please include two copies of the traffic circulation layout at the next submittal.

New Mexico 87103

Resubmit acceptable package along with fully completed Drainage Transportation Information Sheet to front counter personnel for log in and evaluation by Transportation. If you have any questions, please contact Gary Sandoval (505) 924-3675 or me at 924-3991.

www.cabq.gov

Racquel M. Michel, P.E.

Traffic Engineer, Planning Dept. Development Review Services

\gs

Sincerely,

via: email

C:

CO Clerk, File



COA STAFF:

ELECTRONIC SUBMITTAL RECEIVED: ___


City of Albuquerque


Planning Department


Development & Building Services Division


DRAINAGE AND TRANSPORTATION INFORMATION SHEET (REV 09/2015)

roject Title: 1050 Rio Grande	NW	Building Permit #: City Draina	ge #: <u>HJ</u>
RB#:	131 € //.	WOIK ORGETH:	
		Rio Grande Conservancy District Property ma	p #35 cont 1.1273
ity Address: 1050 Rio Grande NW, A	Albuguergue, NM 87104		
ngincering Firm:		Contact:	
ddress:			
hone#:	Fa _N θ;	E-mail:	
wner: G3 Investors, LLC		Contact: Edward G	arcia
ddress: P.O.Box 26207, Albuquer	que, NM 87125		
hone#: 505-260-5188	Fax#:	E-mail: egarcia@g a	rciacars.com
Architect: James C Lewis		Contact: James C L	ewis.
Address: 904 Princeton SE		Connect	
hone#: 505-247-1529	Fax#:	E-mail: gdi@mac.c	om
Other Contact:			
Address:		Contact:	
	Fax#:	E-mail:	
TYPE OF SUBMITTAL: ENGINEER/ ARCHITECT CERTIFICATION CONCEPTUAL, G & D PLAN GRADING PLAN DRAINAGE MASTER PLAN DRAINAGE REPORT CLOMR/LOMR V TRAFFIC CIRCULATION LAYOUT (TCL) TRAFFIC IMPACT STUDY (TIS)		PRELIMINARY PLAT APPROVAL SITE PLAN FOR SUB'D APPROVAL SITE PLAN FOR BLDG. PERMIT APPR FINAL PLAT APPROVAL. SIA RELEASE OF FINANCIAL GUARA FOUNDATION PERMIT APPROVAL. GRADING PERMIT APPROVAL. SO-19 APPROVAL. PAVING PERMIT APPROVAL. GRADING/PAD CERTIFICATION	
EROSION & SEDIMENT CONTROL	PLAN (ESC)	WORK ORDER APPROVALCLOMR/LOMR	
OTHER (SPECIFY)		PRE-DESIGN MEETING OTHER (SPECIFY)	
THIS A RESTIRANT TALLS. V X	No		
S THIS A RESUBMITTAL?: Yes X	No		

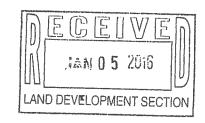

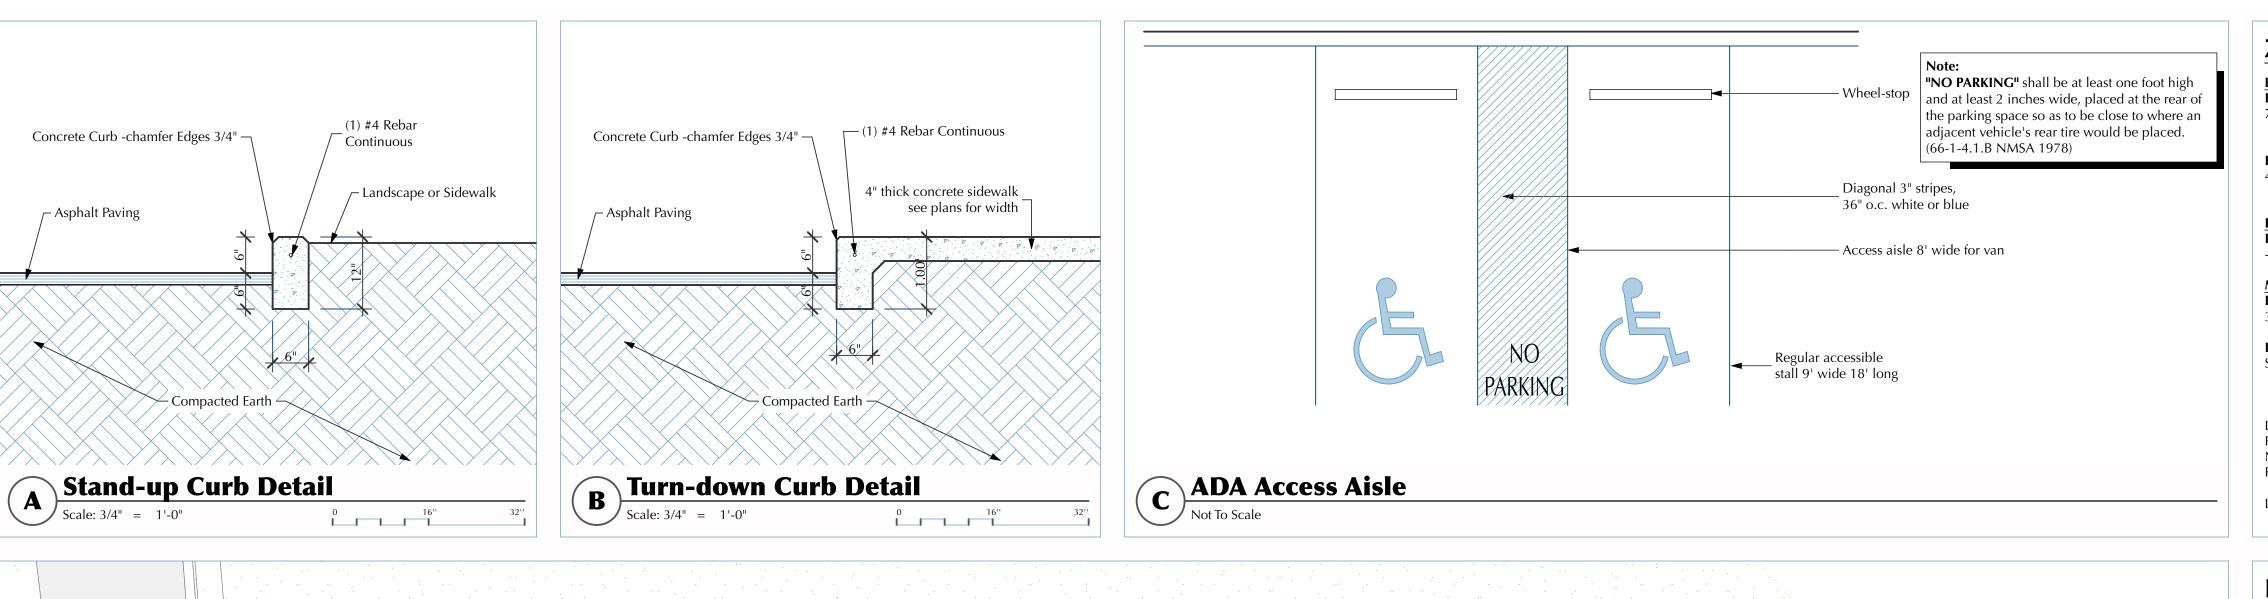

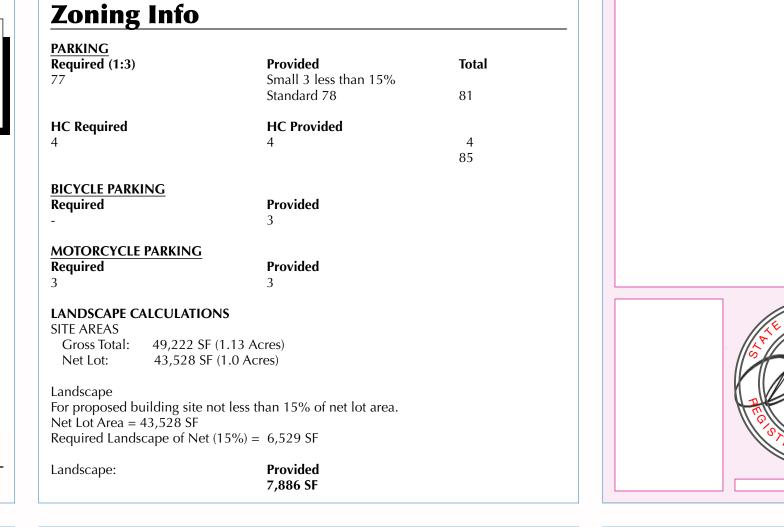

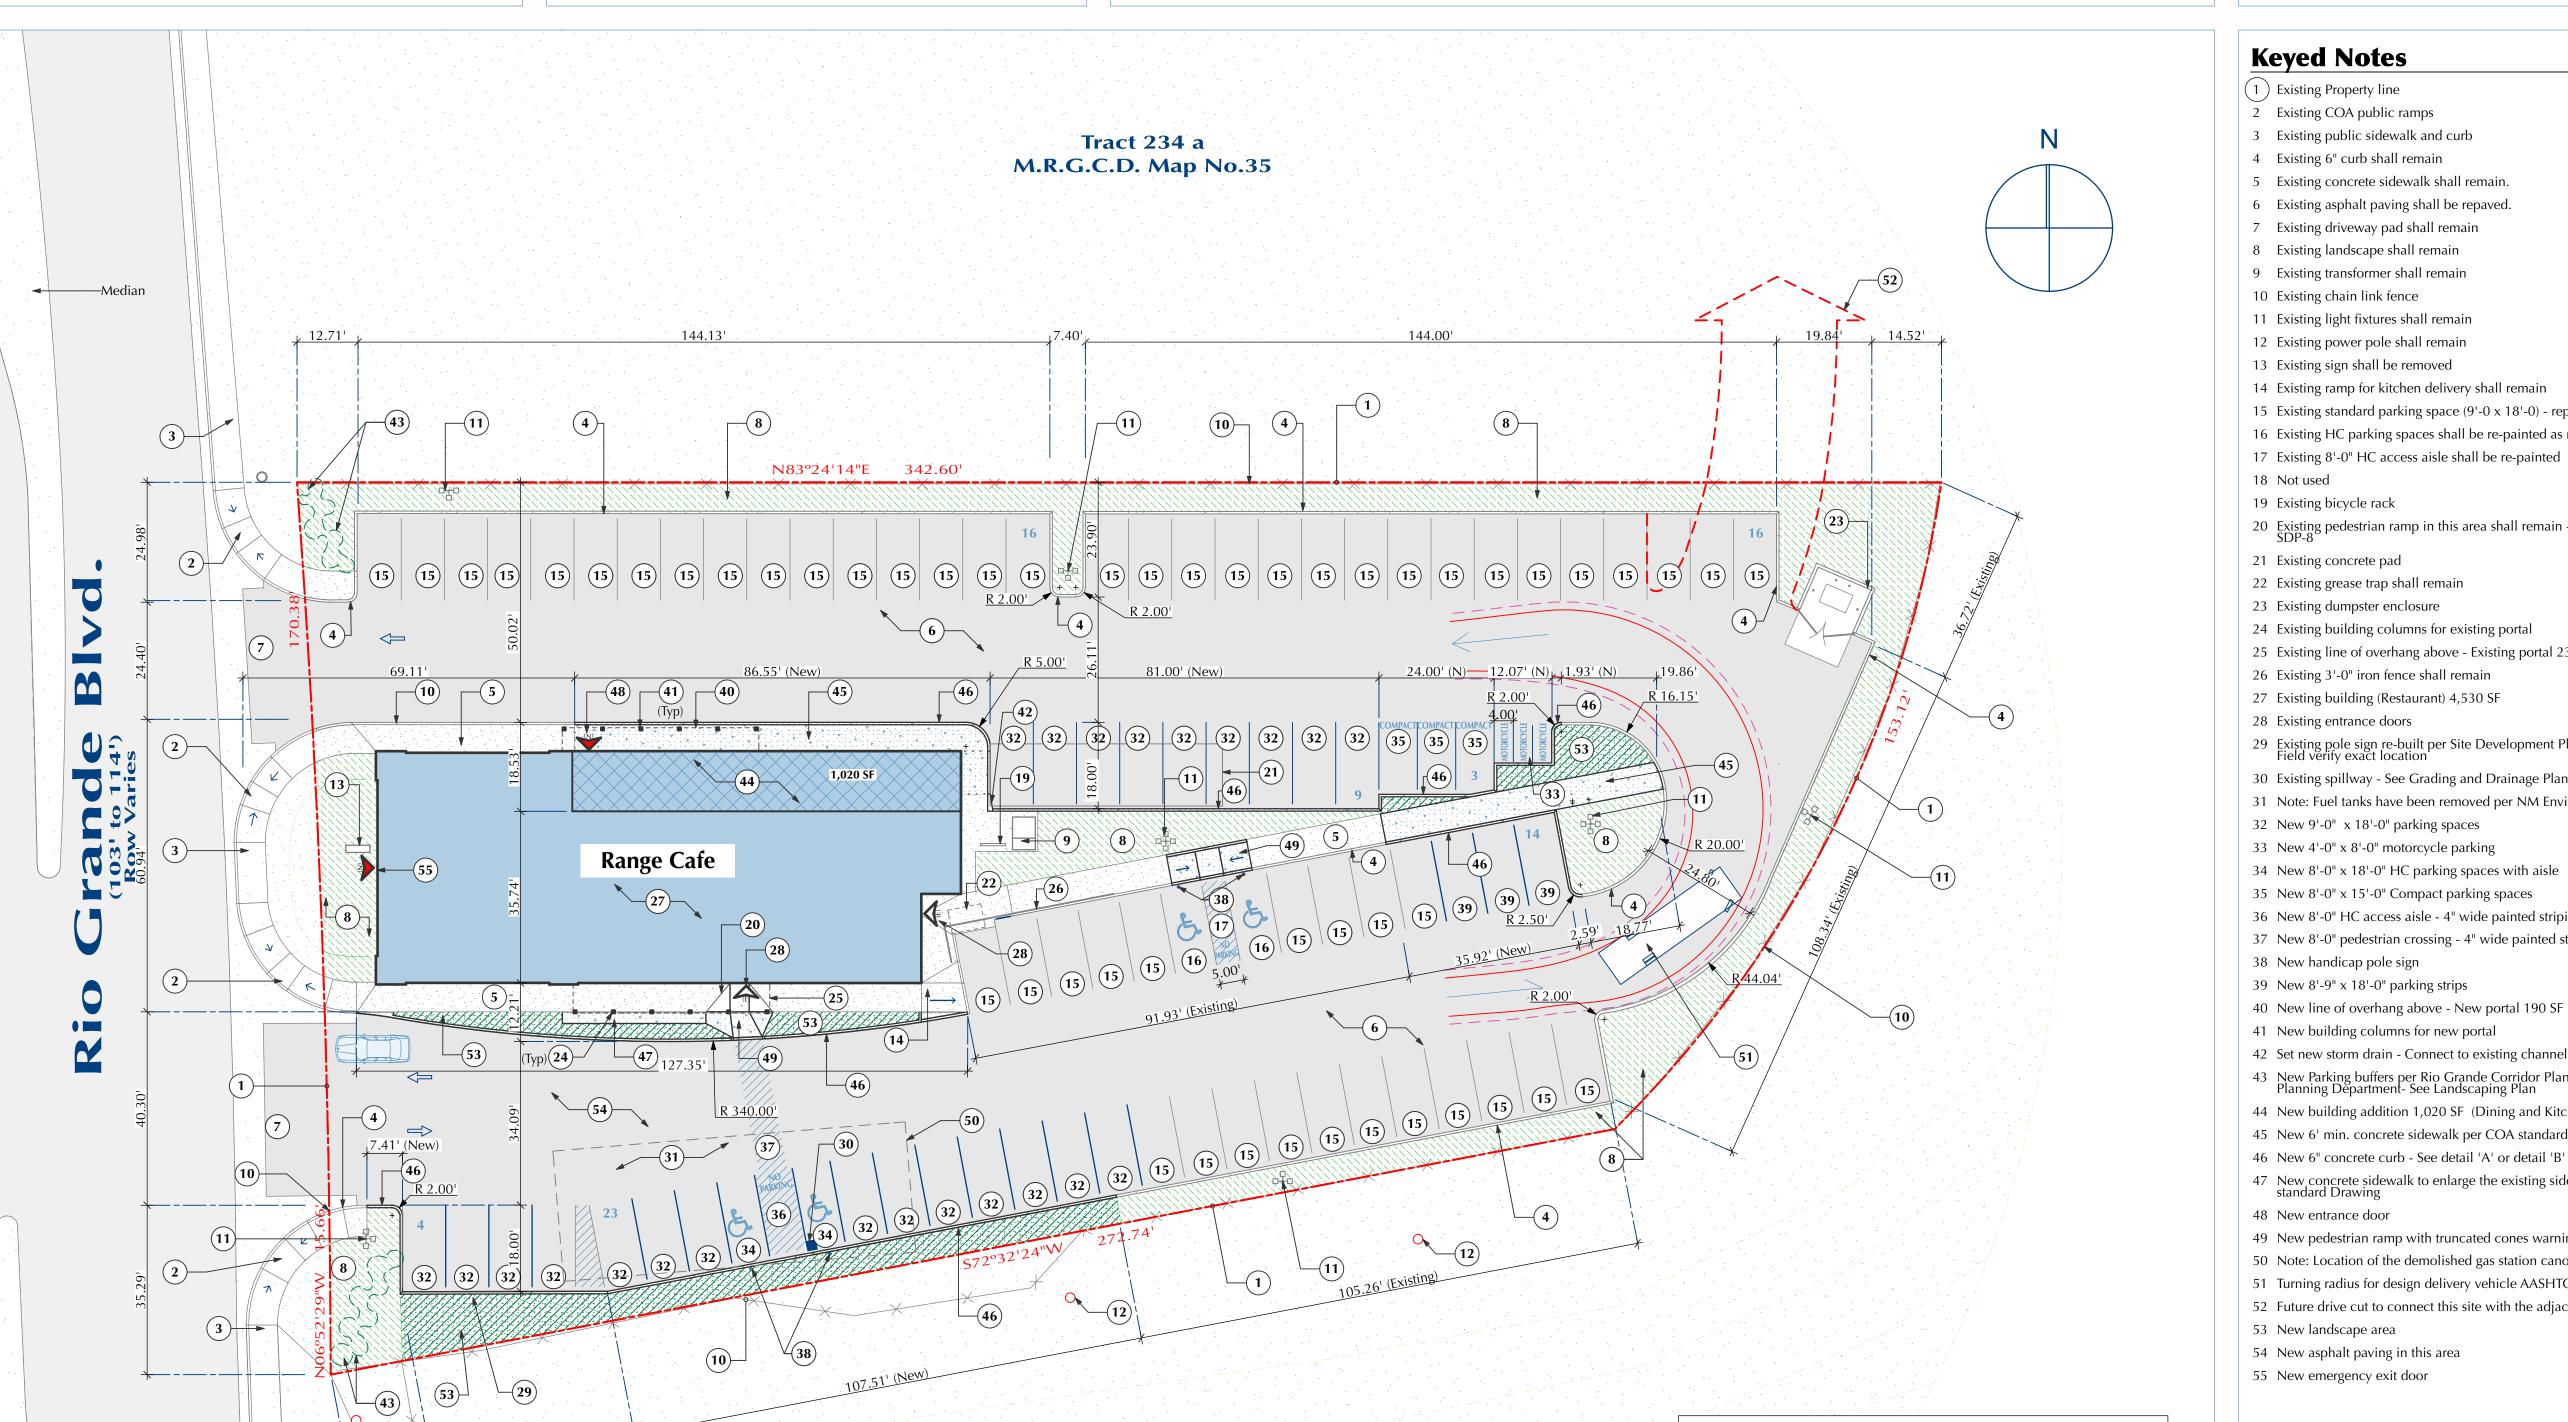


Alameda Drain

→ Median

TLC Plan


Scale: 1" = 20'

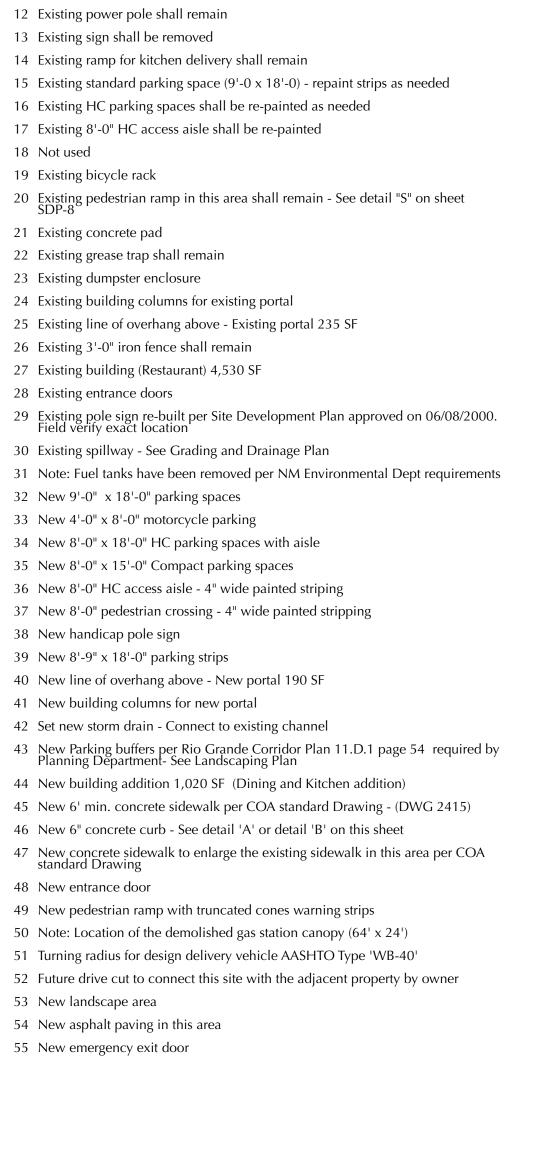


All broken or cracked sidewalk must be replaced with sidewalk and curb & gutter

0 20'

per COA standard drawing DWG 2415

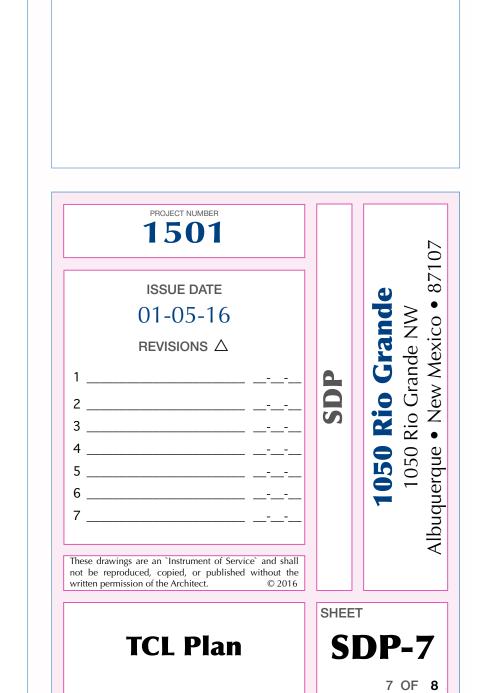

Of Albuquerque

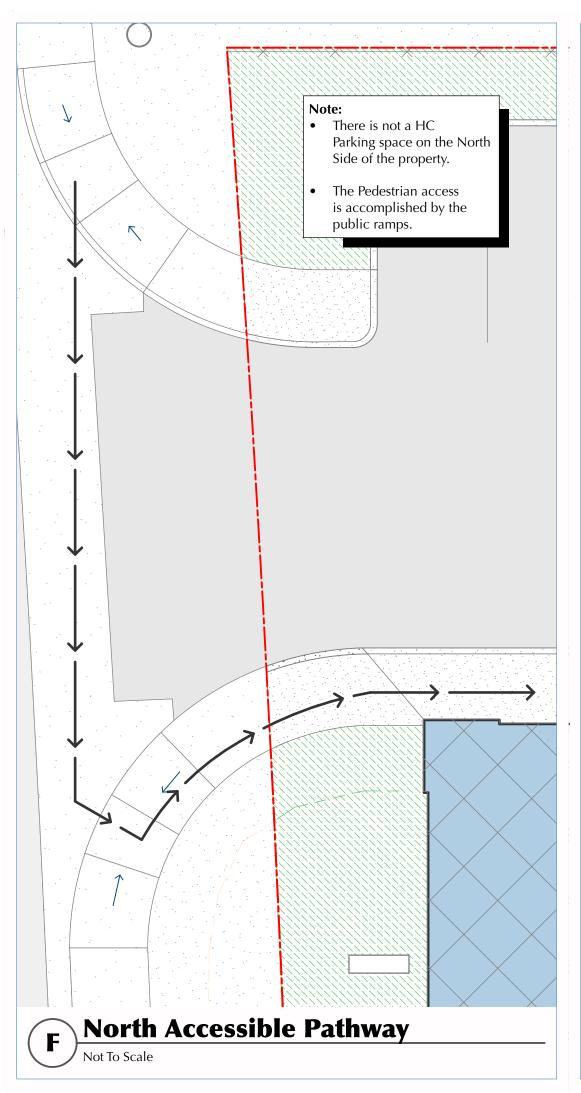

Note:
The ADA accessible parking sign must have the required language per 66-7-352.4C NMSA 1978
"Violators are Subject to a Fine and/or Towing"

accesability symbol (12"x18")

Galvanized metal sign post

— Top of walk or finished grade


Standard International


— Van sign as noted


Concrete


Handicap Pole Sign Detail


Not To Scale

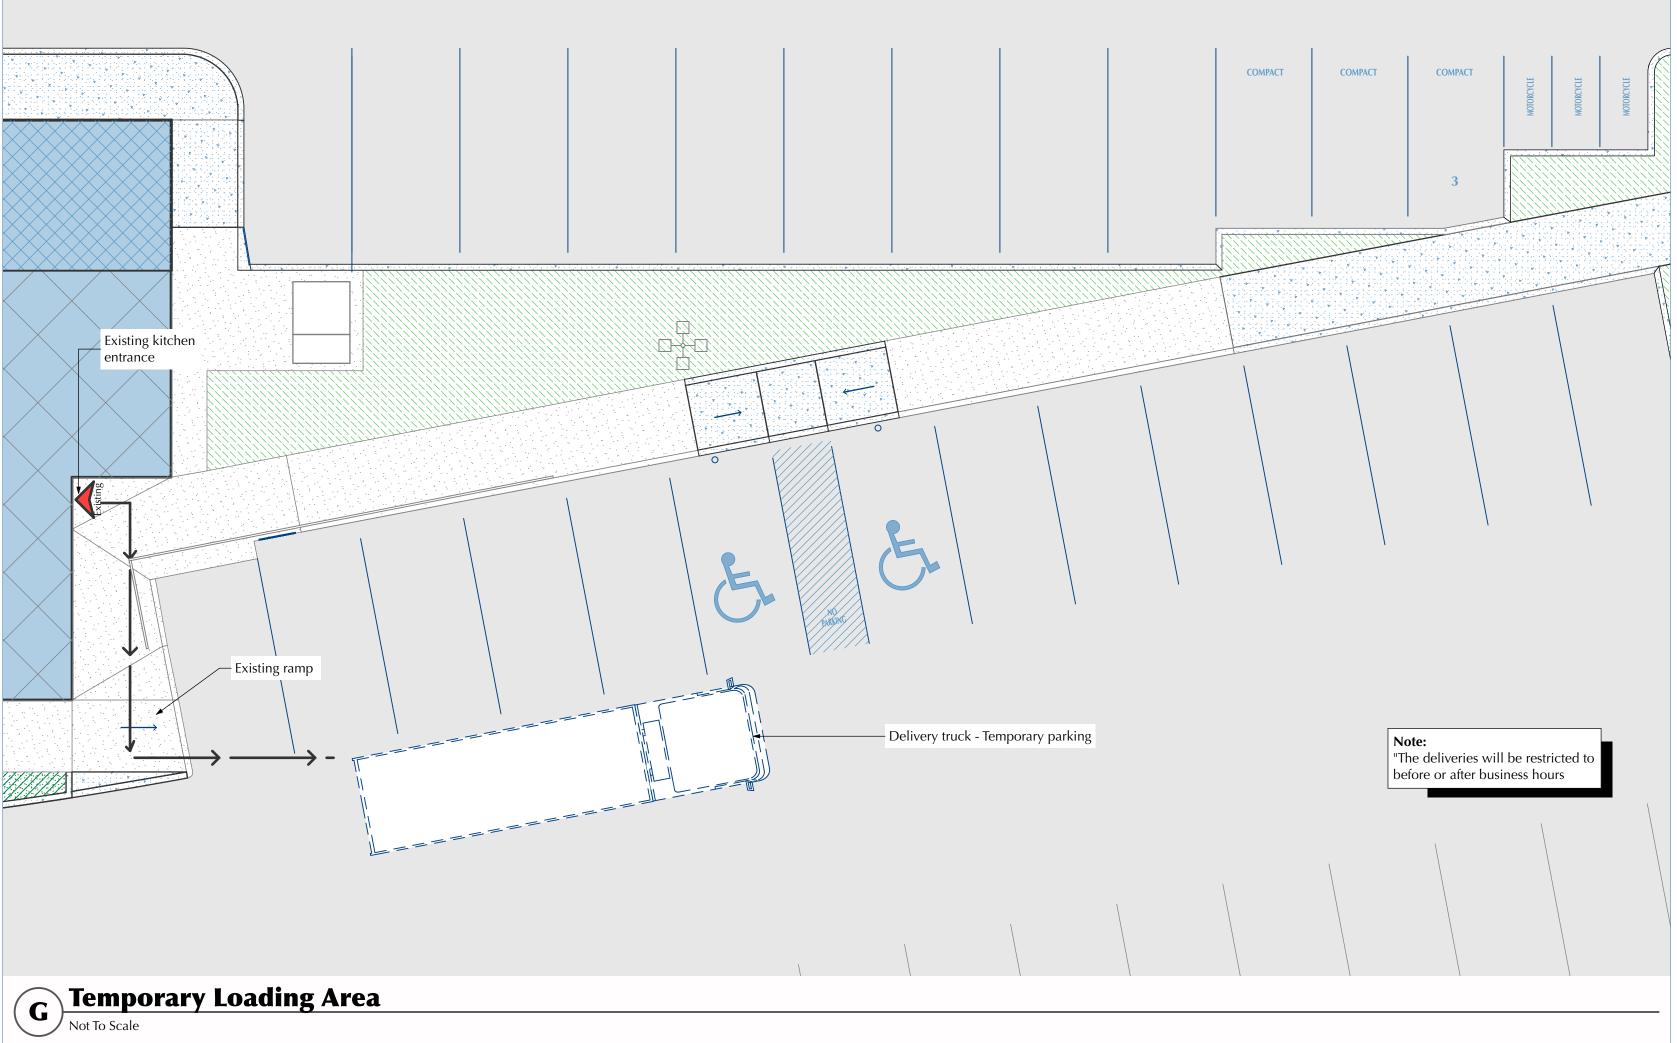

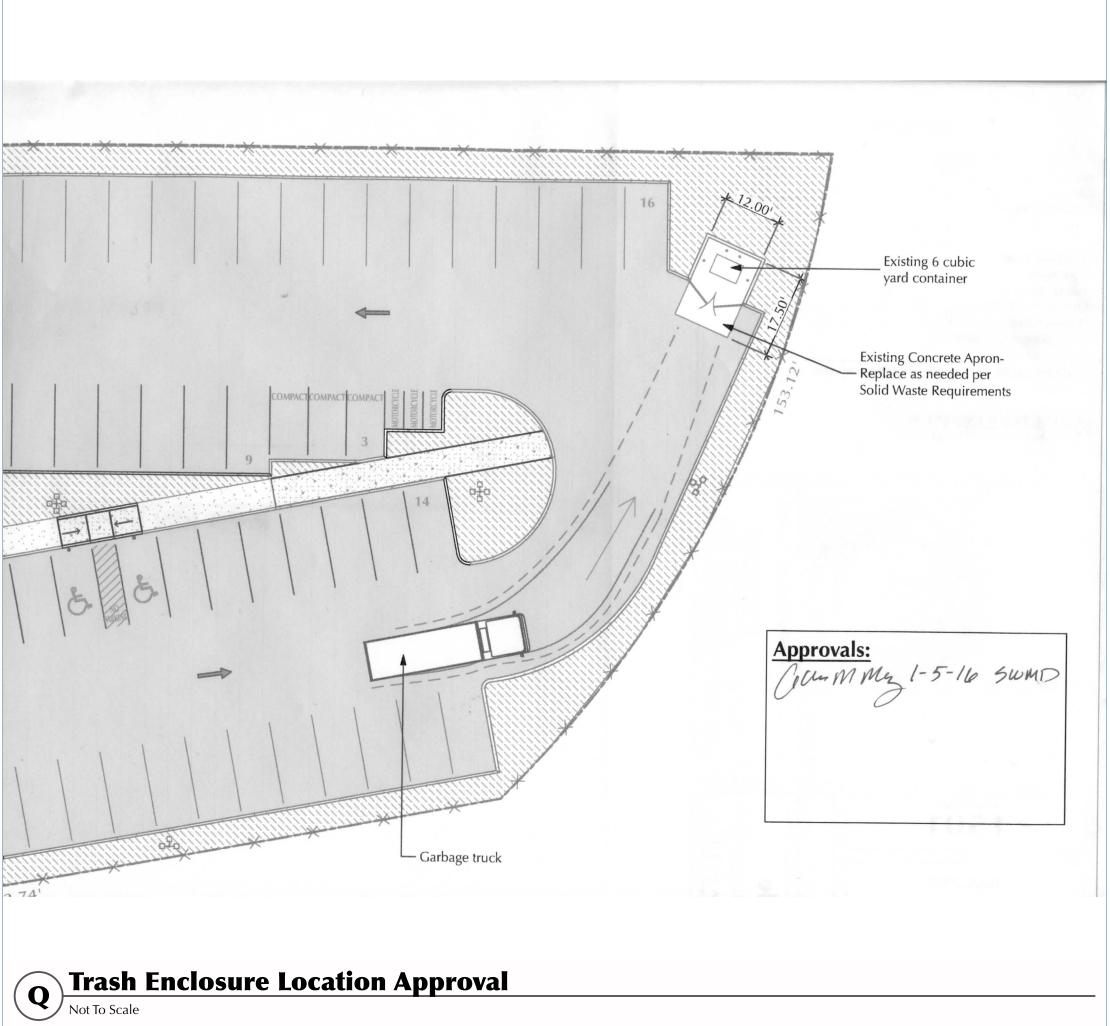


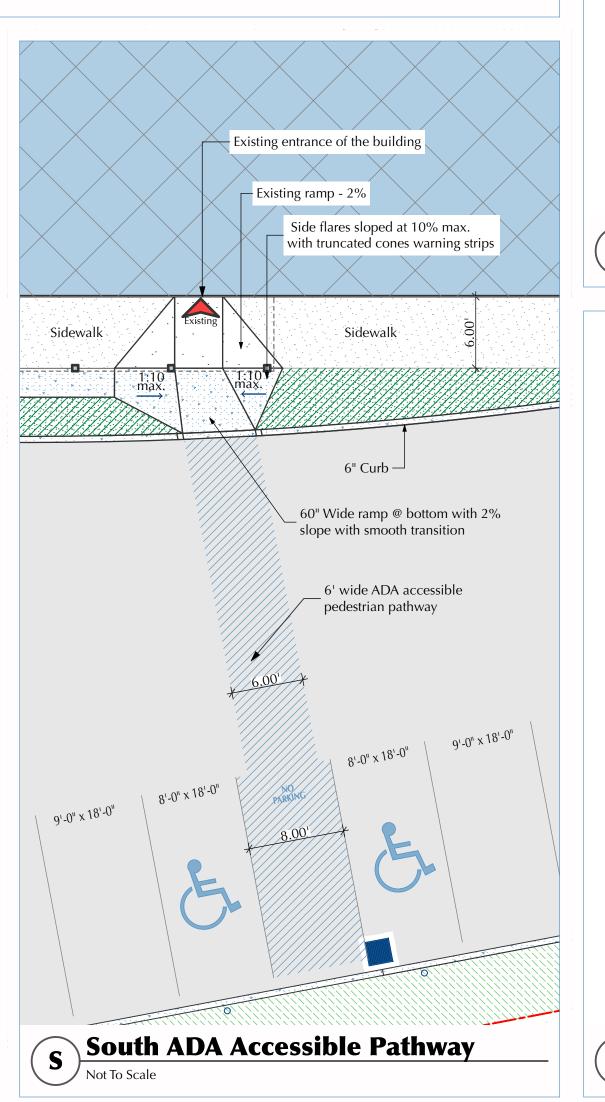


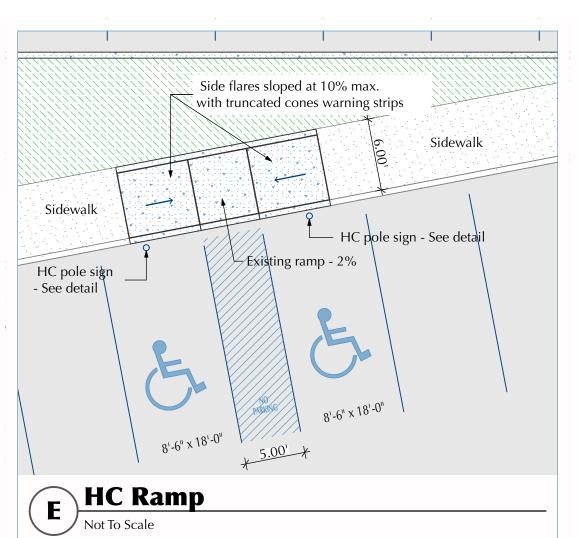

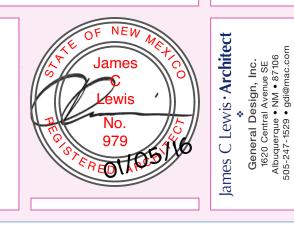


City Of Albuquerque

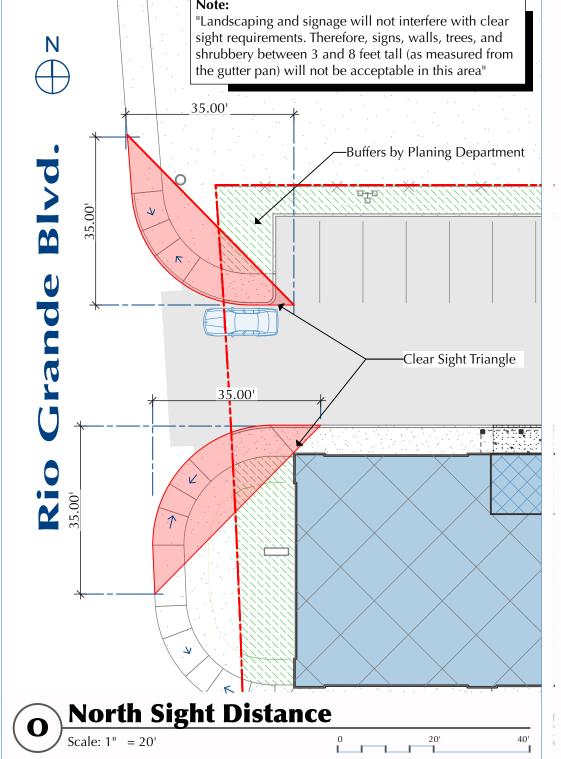

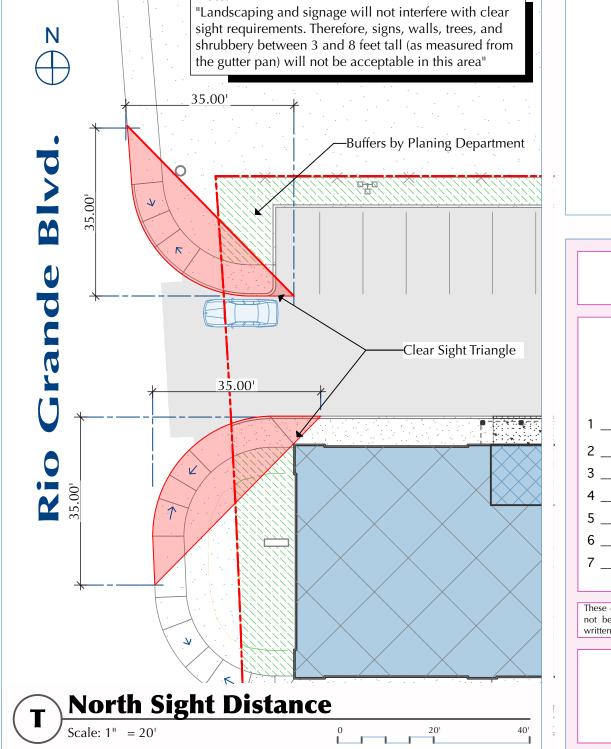

0 20'

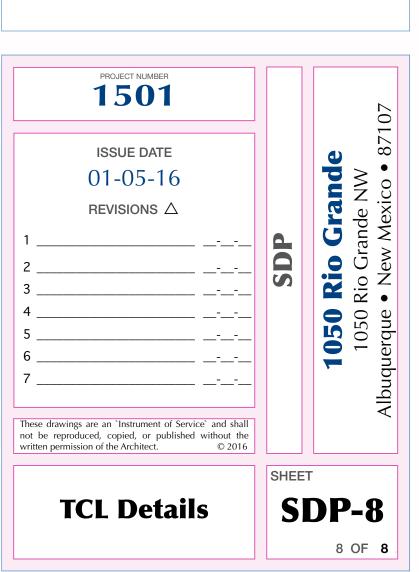

P Detail Not Used

84" min. When on accessible route 60" min. When not on accessible route

