


GRADING PLAN
SCALE: 1" = 20'

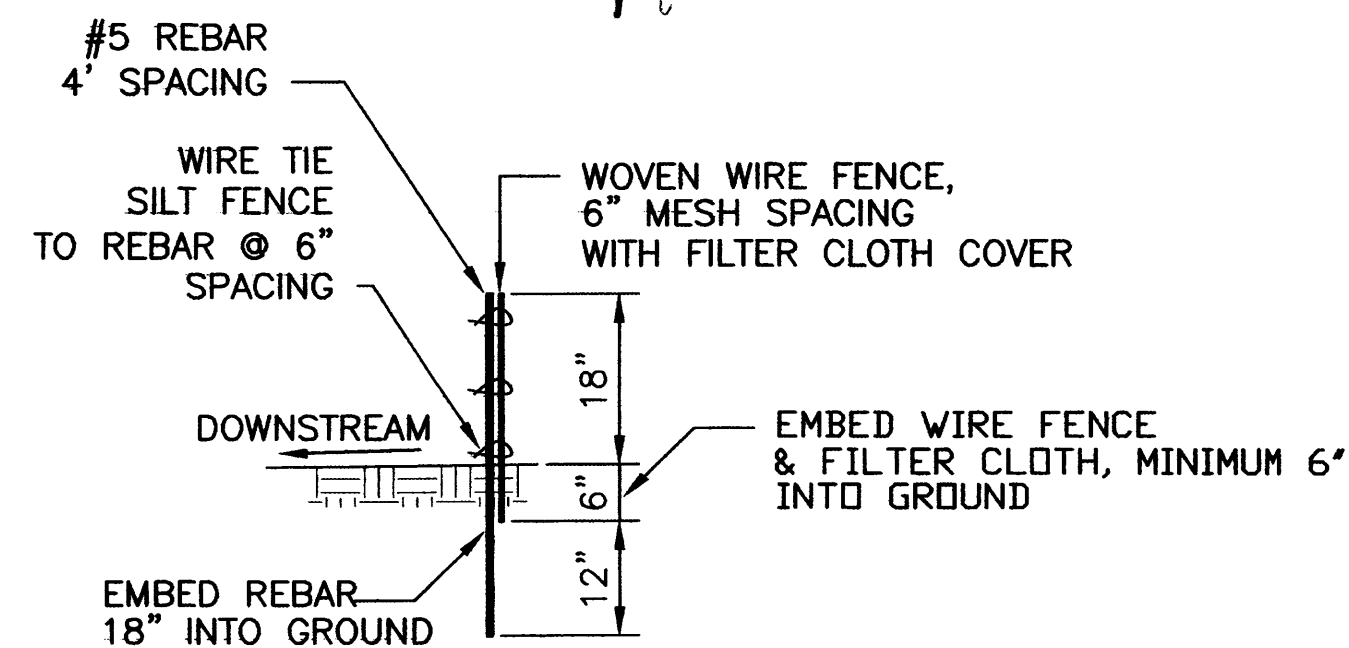

SILT FENCE DETAIL
SCALE: 1/2" = 1'-0"

CONSTRUCTION NOTES:

- 1 CONSTRUCT RETAINING WALL TO NEW GRADES SHOWN.
- 2 NOT USED
- 3 GRADE TO DRAIN FROM REAR YARD TO STREET.
- 4 INSTALL MOUNTABLE CURB, ROLL TYPE PER CITY STD. DWG. 2415A.
- 5 INSTALL 4' WIDE CONCRETE SIDEWALK PER CITY STD. DWG. 2430.
- 6 INSTALL (WHEELCHAIR) CURB ACCESS RAMP, CASE II - ADDEQUATE R.O.W. PER CITY STD. DWG. 2441.

LEGEND			
5360	NEW CONTOUR GRADE		NEW GRADE BREAK
5362	EXISTING CONTOUR GRADE		EXISTING GRADE ELEVATION
	DRAINAGE FLOW DIRECTION		GR56.0 NEW GRADE ELEVATION
TC62.50	NEW TOP OF CURB ELEVATION		FL55.3 FLOWLINE GRADE ELEVATION
FL62.00	NEW FLOWLINE OF CURB ELEVATION		TW95.1 NEW TOP OF WALL ELEVATION
TA60.11	NEW TOP OF ASPHALT ELEVATION		BW93.1 NEW BOTTOM OF WALL ELEVATION
TSW61.87	NEW TOP OF SIDEWALK ELEVATION		TOC93.1 NEW TOP OF CONCRETE ELEVATION
	DRAINAGE SWALE		


UTILITY PRECAUTIONS

THE CONTRACTOR SHALL INFORM ITSELF OF THE LOCATION OF ANY UTILITY LINE, PIPELINE, OR UNDERGROUND UTILITY LINE IN OR NEAR THE AREA OF THE WORK IN ADVANCE OF AND DURING EXCAVATION WORK. THE CONTRACTOR IS FULLY RESPONSIBLE FOR ANY AND ALL DAMAGE CAUSED BY ITS FAILURE TO LOCATE, IDENTIFY AND PRESERVE ANY AND ALL EXISTING UTILITIES, PIPELINES, AND UNDERGROUND UTILITY LINES. IN PLANNING AND CONDUCTING EXCAVATION, THE CONTRACTOR SHALL COMPLY WITH STATE STATUTES, MUNICIPAL AND LOCAL ORDINANCES, RULES AND REGULATIONS, IF ANY, PERTAINING TO THE LOCATION OF THESE LINES AND FACILITIES.

LOTS 1 THROUGH 6
VILLEGAS ESTATES

APPROVED FOR ROUGH GRADING:

NAME _____ DATE _____

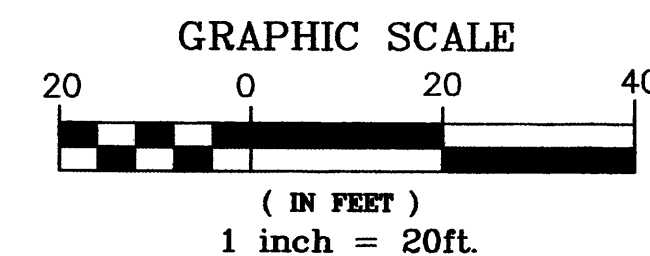

APPLIED ENGINEERING AND SURVEYING, INC.
ENGINEERS AND PLANNERS
3000 Blue Ridge Dr. NE
Albuquerque, NM 87112
Phone: (505) 271-1466

CITY OF ALBUQUERQUE
PUBLIC WORKS DEPARTMENT
ENGINEERING DEVELOPMENT GROUP

TITLE: GRADING PLAN
VILLEGAS ESTATES

Design Review Committee City Engineer Approval

FOR INFORMATION ONLY

City Project No.

TBD

Zone Map No.

H-13

Sheet

1

Of

2

77, 67

DRAINAGE PLAN

THE FOLLOWING ITEMS CONCERNING Tracts 12A1A & 12A1, M.R.G.C.D. MAP 35 on Rio Grande Boulevard NW, NEW MEXICO, GRADING AND DRAINAGE PLAN ARE CONTAINED HEREON:

1. GRADING AND DRAINAGE PLAN
2. VICINITY MAP (H-13)
3. FIRM MAP (35001C0331 D)
4. DRAINAGE CALCULATIONS

EXITING CONDITIONS

AS SHOWN BY THE VICINITY MAP, THE SITE CONTAINS APPROXIMATELY 1.21 ACRES AND IS LOCATED ON THE EAST SIDE OF RIO GRAND BOULEVARD NW, EAST OF LOS ANAYAS STREET NW. THIS SITE HAS CONTAINED AS MANY AS THREE STRUCTURES AT WITH ASSOCIATED DRIVEWAYS AND PAVING. ALL OF THESE STRUCTURES HAVE RECENTLY BEEN REMOVED FOR THIS PROPOSED DEVELOPMENT.

THE SITE TOPOGRAPHY IS FLAT AND IF THE EXISTING SITE EVER OVERFLOWED WITH DRAINAGE WATERS IT APPEARS THE FLOWS WOULD GO IN AN EASTERLY DIRECTION. THE SITE IS CURRENTLY DISTURBED WITH COMPACTION BY HUMAN ACTIVITY.

PROPOSED CONDITIONS

AS SHOWN BY THE PLAN, THE PROJECT CONSISTS OF DEVELOPING SIX NEW LOTS WITH HOMES THAT COULD CONTAIN AS MUCH AS 3000SF WITH ASSOCIATED SIDEWALKS, PARKING AND LANDSCAPING IMPROVEMENTS. A NEW CUL-DE-SAC STREET WILL ALSO BE CONSTRUCTED TO CITY STANDARDS AS PART OF THIS DEVELOPMENT.

PER A MEETING HELD WITH BRAD BINGHAM REGARDING THIS SITE IT IS THE INTENT TO RAISE THIS SITE AND DRAIN TOWARDS RIO GRANDE BOULEVARD. THIS WILL HELP INSURE THAT IF RIO GRANDE BOULEVARD NW SHOULD EXPERIENCE SIGNIFICANT FLOODING IT SHOULD NOT IMPACT THIS SITE. THIS PLAN ALSO SHOWS PROPOSED ELEVATIONS REQUIRED TO PROPERLY DRAIN AND GRADE THIS SITE ALONG WITH REQUIRED DRAINAGE SWALES AND ROOF DIRECTIONS TO INSURE MINIMAL IMPACTS TO ADJACENT NEIGHBORS. ALL DRIVEWAYS AND PARKING AREAS WILL BE CALCULATED AS IF THEY ARE PAVED, LANDSCAPING IS TO BE PROVIDED PER ZONING REQUIREMENTS.

THE CALCULATIONS WHICH APPEAR HEREON, ANALYZE BOTH THE EXISTING AND DEVELOPED CONDITIONS FOR THE 100-YEAR, 6 HOUR RAINFALL RUNOFF FOR PEAK FLOWS AND STORM DURATION FOR VOLUME REQUIREMENTS. THE PROCEDURE FOR 40 ACRE AND SMALLER BASINS AS SET FORTH IN THE REVISION OF SECTION 22.7 HYDROLOGY OF THE DEVELOPMENT PROCESS MANUAL, VOLUME 2, DESIGN CRITERIA, DATED JANUARY 1993. THIS D.P.M. PROCEDURE IS USED FOR ANALYZING ONSITE FLOWS.

DOWNSTREAM CAPACITY

PER A MEETING WITH BRAD BINGHAM THE STORM DRAIN IN RIO GRANDE BOULEVARD NW IS LARGE ENOUGH TO HANDLE ADDITIONAL OFFSITE FLOWS ALONG RIO GRANDE BOULEVARD NW AND IS DEEP ENOUGH THAT FREE DISCHARGE INTO THIS STORM DRAIN IS NOT AN ISSUE. ALSO REVIEW OF THE FIRM MAP IN THIS AREA INDICATES THERE ARE NO 100-YEAR FLOODPLAINS ALONG RIO GRANDE BOULEVARD ASSOCIATED WITH THIS EXISTING STORM DRAIN OR ANY FLOODPLAINS ADJACENT TO THIS SITE SO FREE DISCHARGE SHOULD NOT BE AN ISSUE.

SINCE THIS SITE HAS BEEN DEVELOPED IN THE PAST WITH RESIDENTIAL HOMES AND WITH THE SMALL INCREASE OF RUNOFF FROM THIS DEVELOPMENT THAT THIS DEVELOPMENT SHOULD NOT FURTHER AGGRAVATE THE EXISTING STORM DRAIN SYSTEMS BASED ON THE ATTACHED CALCULATIONS.

EROSION CONTROL

TEMPORARY EROSION CONTROL WILL BE REQUIRED DURING THE CONSTRUCTION PHASE TO PROTECT DOWNSTREAM PROPERTY AND IMPROVEMENTS FROM SEDIMENT AND UNCONTROLLED RUNOFF. THE CONTRACTOR SHALL INCLUDE TEMPORARY EARTH BERMING OR SILT FENCING ALONG THE SOUTH, NORTH, EAST AND WEST SIDE OF THE PROJECT BOUNDARIES TO HOLD RUNOFF DURING CONSTRUCTION. THE CONTRACTOR SHALL ALSO PREPARE A STORM WATER POLLUTION PREVENTION PLAN AS PART OF THE NOTICE OF INTENT TO EPA. IT IS THE CONTRACTOR'S RESPONSIBILITY TO PROPERLY MAINTAIN THESE FACILITIES DURING THE CONSTRUCTION PHASE OF THE PROJECT.

OFFSITE FLOWS

THERE ARE NO OFFSITE FLOWS THAT ENTER THIS PROPERTY.

DRAINAGE CALCULATIONS

1. PRECIPITATION ZONE = 2
2. DESIGN STORM = DEPTH (INCHES) AT 100-YEAR STORM
6-HOUR = 2.35 INCHES
10 DAY = 3.95 INCHES
3. PEAK DISCHARGE (CFS/ACRE) FIR 100-YEAR, ZONE 2, TABLE A-9:
 $Q = 1.56 \text{ CFS/ACRE SOIL UNCOMPACTED "A"}$
 $Q = 2.28 \text{ CFS/ACRE LANDSCAPED "B"}$
 $Q = 3.14 \text{ CFS/AC COMPACTED SOIL "C"}$
 $Q = 4.70 \text{ CFS/ACRE IMPERVIOUS AREA "D"}$
FOR WATERSHEDS LESS THAN OR EQUAL TO 40 ACRES
4. EXCESS PRECIPITATION, E (INCHES), 6 HOUR STORM, ZONE 2, TABLE A-8:
 $E = 0.53 \text{ INCHES SOIL UNCOMPACTED "A"}$
 $E = 0.78 \text{ INCHES LANDSCAPED "B"}$
 $E = 1.13 \text{ INCHES COMPACTED SOIL "C"}$
 $E = 2.12 \text{ INCHES IMPERVIOUS AREA "D"}$
5. EXISTING CONDITIONS ONSITE
DRAINAGE BASIN OFFSITE "OFF-1" = 1.21 ACRES
EXISTING AND PRE-EXISTING CONDITIONS

TREATMENT	AREA (ACRES)
A	0.53 (BACK YARD - UNDISTURBED)
B	0.06 (REARYARD - LANDSCAPED)
C	0.53 (DRIVEWAY AND FRONT YARD - COMPACTED BY HUMAN ACTIVITY)
D	0.09 (ROOFS, SIDEWALKS - IMPERVIOUS)


 $Q(\text{EXISTING}) = (1.56 \times 0.53) + (2.28 \times 0.06) + (3.14 \times 0.53) + (4.70 \times 0.09)$ $= 3.1 \text{ CFS EXISTING ONSITE FLOW}$ $V(\text{EXISTING-6HR}) = ((0.53 \times 0.53) + (1.13 \times 0.06) + (2.12 \times 0.09)) / 12 \times 43,560 = 4,056 \text{ CF}$ $= 0.09 \text{ AC-FT EXISTING ONSITE VOLUME}$

6. PROPOSED CONDITIONS ONSITE
DRAINAGE BASIN "A" = 1.21 ACRES TO RIO GRANDE BLVD NW
IMPERVIOUS BUILDING AREA "D" = 6 LOTS X 3,000SF/LOT
 $= 18,000 \text{ SF} = 0.41 \text{ ACRES}$
IMPERVIOUS DRIVEWAY AND SIDEWALK AREA "D" = 6 LOTS X 600SF/LOT
 $= 3,600 \text{ SF} = 0.08 \text{ ACRES}$
IMPERVIOUS CUL-DE-SAC AREA "D" = 16,211 SF = 0.37 ACRES
TOTAL IMPERVIOUS AREA = 0.41 + 0.08 + 0.37 ACRES = 0.86 ACRES
REMAINDER OF AREA IS 50% LANDSCAPED AREA "B" AND 50% COMPACTED "C"
 $= (1.21 - 0.86) / 2 = 0.18 \text{ ACRES FOR "B" AND "C"}$

TREATMENT	AREA (ACRES)
A	0
B	0.175
C	0.175
D	0.86


$$Q(\text{PROPOSED}) = (2.28 \times 0.175) + (3.14 \times 0.175) + (4.70 \times 0.86)$$
$$= 5.0 \text{ CFS PROPOSED ONSITE FLOW}$$
$$Q(\text{INCREASE}) = 5.0 \text{ CFS} - 3.1 \text{ CFS} = 1.89 \text{ CFS INCREASE FROM PRE-EXISTING CONDITIONS}$$

$$V(\text{PROPOSED}) = ((0.78 \times 0.175) + (1.13 \times 0.175) + (2.12 \times 0.86)) / 12$$
$$= 0.18 \text{ AC-FT} = 7,832 \text{ CF PROPOSED ONSITE VOLUME}$$
$$V(\text{INCREASE}) = 0.18 - 0.09 \text{ AC-FT} = 0.09 \text{ ACFT INCREASE FROM PRE-EXISTING CONDITIONS}$$

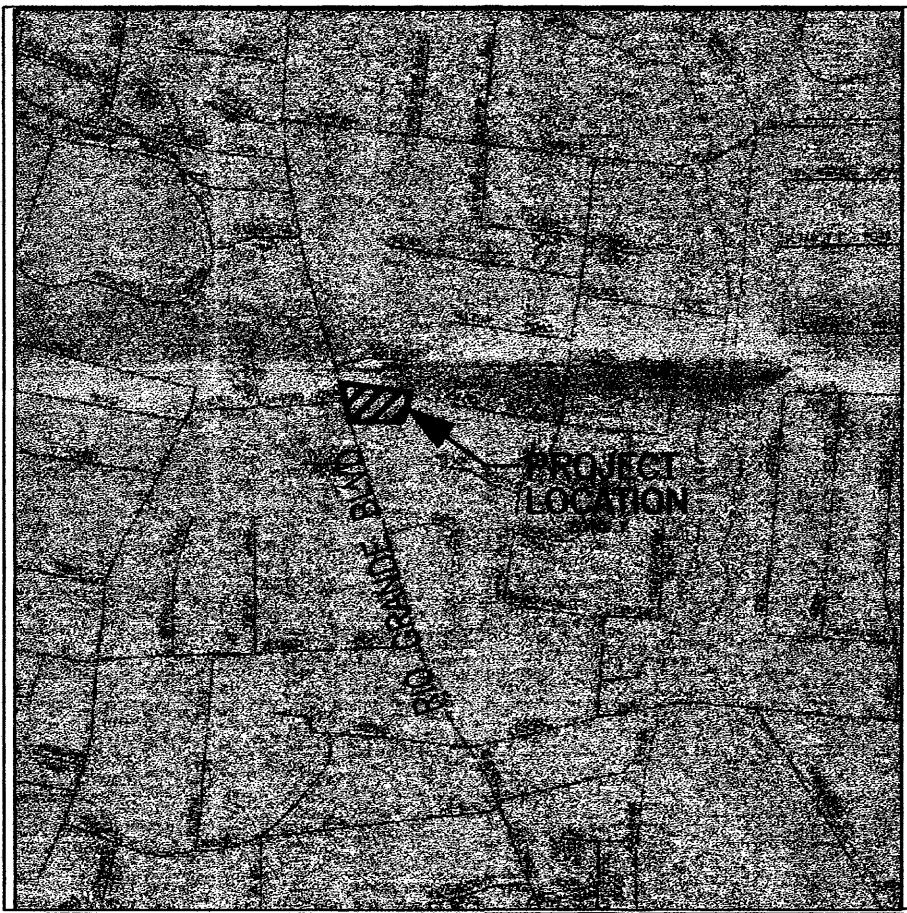



FIRM MAP 35001C0331D

SCALE: N.T.S.

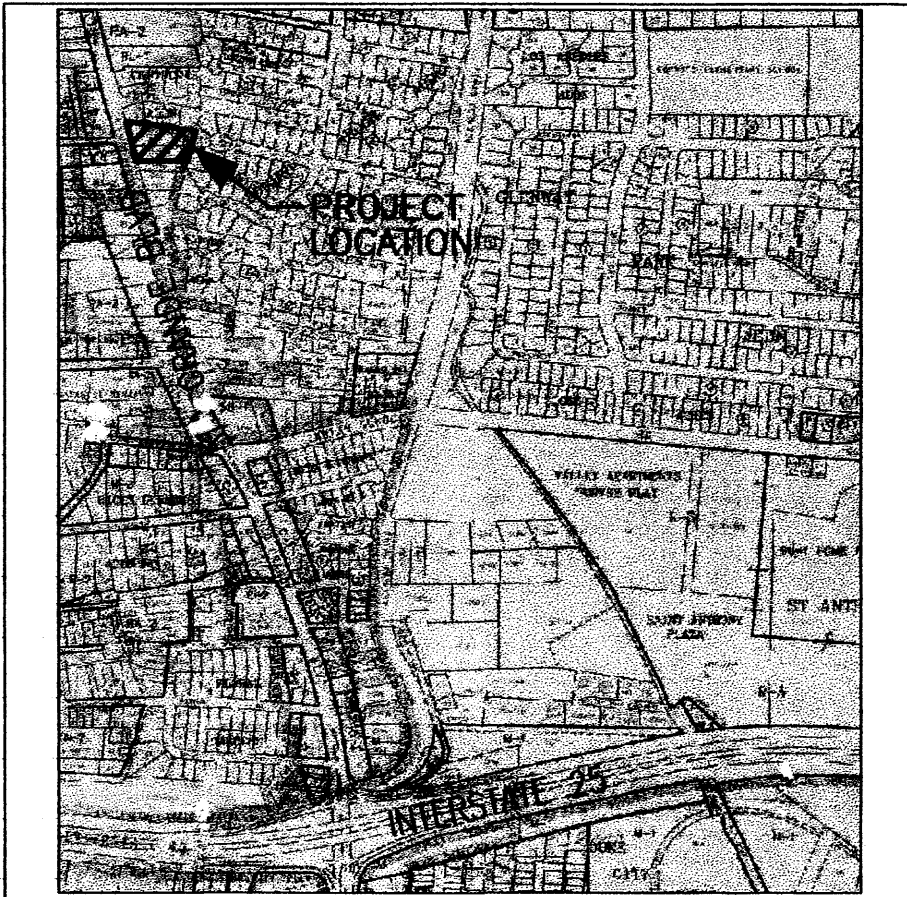

VICINITY MAP H-13

SCALE: N.T.S.

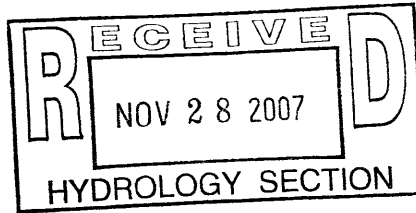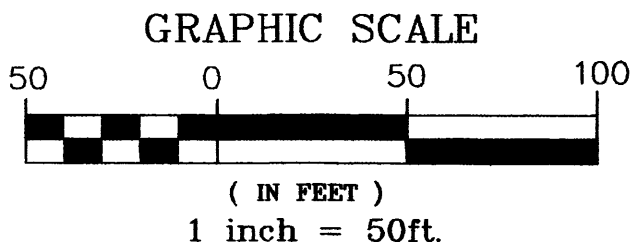

FILE:	VILLEGAS ESTATES DRAINAGE CALCULATIONS	DATE/REVISIONS:
		SHEET NUMBER: 2 of 2
APPLIED ENGINEERING AND SURVEYING, INC. ENGINEERS AND PLANNERS 1800 Elm Drive NE Albuquerque, New Mexico 87112 Phone: (505) 940-9125 Fax: (505) 940-9125 www.aesur.com		

DRAINAGE PLAN

THE FOLLOWING ITEMS CONCERNING Tracts 12A1A & 12A1, M.R.G.C.D. MAP 35 on Rio Grande Boulevard NW, NEW MEXICO, GRADING AND DRAINAGE PLAN ARE CONTAINED HEREON:

- 1. GRADING AND DRAINAGE PLAN
- 2. VICINITY MAP (H-13)
- 3. FIRM MAP (35001C0331 D)
- 4. DRAINAGE CALCULATIONS

EXITING CONDITIONS

AS SHOWN BY THE VICINITY MAP, THE SITE CONTAINS APPROXIMATELY 1.21 ACRES AND IS LOCATED ON THE EAST SIDE OF RIO GRANDE BOULEVARD NW, EAST OF LOS ANAYAS STREET NW. THIS SITE HAS CONTAINED AS MANY AS THREE STRUCTURES AT WITH ASSOCIATED DRIVEWAYS AND PAVING. ALL OF THESE STRUCTURES HAVE RECENTLY BEEN REMOVED FOR THIS PROPOSED DEVELOPMENT.

THE SITE TOPOGRAPHY IS FLAT AND IF THE EXISTING SITE EVER OVERFLOWED WITH DRAINAGE WATERS IT APPEARS THE FLOWS WOULD GO IN AN EASTERLY DIRECTION. THE SITE IS CURRENTLY DISTURBED WITH COMPACTION BY HUMAN ACTIVITY.

PROPOSED CONDITIONS

AS SHOWN BY THE PLAN, THE PROJECT CONSISTS OF DEVELOPING SIX NEW LOTS WITH HOMES THAT COULD CONTAIN AS MUCH AS 3000SF WITH ASSOCIATED SIDEWALKS, PARKING AND LANDSCAPING IMPROVEMENTS. A NEW CUL-DE-SAC STREET WILL ALSO BE CONSTRUCTED TO CITY STANDARDS AS PART OF THIS DEVELOPMENT.

PER A MEETING HELD WITH BRAD BINGHAM REGARDING THIS SITE IT IS THE INTENT TO RAISE THIS SITE AND DRAIN TOWARDS RIO GRANDE BOULEVARD. THIS WILL HELP INSURE THAT IF RIO GRANDE BOULEVARD NW SHOULD EXPERIENCE SIGNIFICANT FLOODING IT SHOULD NOT IMPACT THIS SITE. THIS PLAN ALSO SHOWS PROPOSED ELEVATIONS REQUIRED TO PROPERLY DRAIN AND GRADE THIS SITE ALONG WITH REQUIRED DRAINAGE SWALES AND ROOF DIRECTIONS TO INSURE MINIMAL IMPACTS TO ADJACENT NEIGHBORS. ALL DRIVEWAYS AND PARKING AREAS WILL BE CALCULATED AS IF THEY ARE PAVED, LANDSCAPING IS TO BE PROVIDED PER ZONING REQUIREMENTS.

THE CALCULATIONS WHICH APPEAR HEREON, ANALYZE BOTH THE EXISTING AND DEVELOPED CONDITIONS FOR THE 100-YEAR, 6 HOUR RAINFALL RUNOFF FOR PEAK FLOWS AND STORM DURATION FOR VOLUME REQUIREMENTS. THE PROCEDURE FOR 40 ACRE AND SMALLER BASINS AS SET FORTH IN THE REVISION OF SECTION 22.7 HYDROLOGY OF THE DEVELOPMENT PROCESS MANUAL, VOLUME 2, DESIGN CRITERIA, DATED JANUARY 1993. THIS D.P.M. PROCEDURE IS USED FOR ANALYZING ONSITE FLOWS.

DOWNSTREAM CAPACITY

PER A MEETING WITH BRAD BINGHAM THE STORM DRAIN IN RIO GRANDE BOULEVARD NW IS LARGE ENOUGH TO HANDLE ADDITIONAL OFFSITE FLOWS ALONG RIO GRANDE BOULVARD NW AND IS DEEP ENOUGH THAT FREE DISCHARGE INTO THIS STORM DRAIN IS NOT AN ISSUE. ALSO REVIEW OF THE FIRM MAP IN THIS AREA INDICATES THERE ARE NO 100-YEAR FLOODPLAINS ALONG RIO GRANDE BOULEVARD ASSOCIATED WITH THIS EXISTING STORM DRAIN OR ANY FLOODPLAINS ADJACENT TO THIS SITE SO FREE DISCHARGE SHOULD NOT BE AN ISSUE.

SINCE THIS SITE HAS BEEN DEVELOPED IN THE PAST WITH RESIDENTIAL HOMES AND WITH THE SMALL INCREASE OF RUNOFF FROM THIS DEVELOPMENT THAT THIS DEVELOPMENT SHOULD NOT FURTHER AGGRAVATE THE EXISTING STORM DRAIN SYSTEMS BASED ON THE ATTACHED CALCULATIONS.

EROSION CONTROL

TEMPORARY EROSION CONTROL WILL BE REQUIRED DURING THE CONSTRUCTION PHASE TO PROTECT DOWNSTREAM PROPERTY AND IMPROVEMENTS FROM SEDIMENT AND UNCONTROLLED RUNOFF. THE CONTRACTOR SHALL INCLUDE TEMPORARY EARTH BERMING OR SILT FENCING ALONG THE SOUTH, NORTH, EAST AND WEST SIDE OF THE PROJECT BOUNDARIES TO HOLD RUNOFF DURING CONSTRUCTION. THE CONTRACTOR SHALL ALSO PREPARE A STORM WATER POLLUTION PREVENTION PLAN AS PART OF THE NOTICE OF INTENT TO EPA. IT IS THE CONTRACTORS RESPONSIBILITY TO PROPERLY MAINTAIN THESE FACILITIES DURING THE CONSTRUCTION PHASE OF THE PROJECT.


OFFSITE FLOWS

THERE ARE NO OFFSITE FLOWS THAT ENTER THIS PROPERTY.

DRAINAGE CALCULATIONS


- 1. PRECIPITATION ZONE = 2
- 2. DESIGN STORM = DEPTH (INCHES) AT 100-YEAR STORM
6-HOUR = 2.35 INCHES
10 DAY = 3.95 INCHES
- 3. PEAK DISCHARGE (CFS/ACRE) FIR 100-YEAR, ZONE 2, TABLE A-9:
Q = 1.56 CFS/ACRE SOIL UNCOMPACTED "A"
Q = 2.28 CFS/ACRE LANDSCAPED "B"
Q = 3.14 CFS/AC. COMPACTED SOIL "C"
Q = 4.70 CFS/ACRE IMPERVIOUS AREA "D"
- 4. EXCESS PRECIPITATION, E (INCHES), 6 HOUR STORM, ZONE 2, TABLE A-8:
E = 0.53 INCHES SOIL UNCOMPACTED "A"
E = 0.78 INCHES LANDSCAPED "B"
E = 1.13 INCHES COMPACTED SOIL "C"
E = 2.12 INCHES IMPERVIOUS AREA "D"
- 5. EXISTING CONDITIONS ONSITE
DRAINAGE BASIN OFFSITE "OFF-1" = 1.21 ACRES
EXISTING AND PRE-EXISTING CONDITIONS
TREATMENT AREA(ACRES)
A 0.53(BACK YARD -UNDISTURBED)
B 0.06(REARYARD-LANDSCAPED)
C 0.53(DRIVEWAY AND FRONT YARD-
COMPAED BY HUMAN ACTIVITY)
D 0.09(ROOFS, SIDEWALKS-IMPERVIOUS)
Q(EXISTING) = (1.56 X 0.53) + (2.28 X 0.06) + (3.14 X 0.53) + (4.70 X 0.09)
= 3.1CFS EXISTING ONSITE FLOW
V(EXISTING-6HR) = ((0.53 X 0.53) + (0.78 X 0.06) + (1.13 X 0.53)
+ (2.12 X 0.09))/ 12) X 43.560 = 4.056CF
= 0.09AC-FT EXISTING ONSITE VOLUME

- 6. PROPOSED CONDITIONS ONSITE
DRAINAGE BASIN "A" = 1.21 ACRES TO RIO GRANDE BLVD NW
IMPERVIOUS BUILDING AREA "D" = 6LOTS X 3,000SF/LOT
= 18,000SF = 0.41ACRES
IMPERVIOUS DRIVEWAY AND SIDEWALK AREA "D"= 6LOTS X 600SF/LOT
=3600SF = 0.08ACRES
IMPERVIOUS CUL-DE-SAC AREA "D" = 16,211SF = 0.37ACRES
TOTAL IMPERVIOUS AREA = 0.41 + 0.08 + 0.37ACRES = 0.86ACRES
REMAINDER OF AREA IS 50% LANDSCAPED AREA "B" AND 50% COMPACTED "C"
= (1.21 - 0.86)/2 = 0.18ACRES FOR "B" AND "C"
TREATMENT AREA(ACRES)
A 0
B 0.175
C 0.175
D 0.86
Q(PROPOSED) = (2.28 X 0.175) + (3.14 X 0.175) + (4.70 X 0.86)
= 5.0CFS PROPOSED ONSITE FLOW
Q(INCREASE) = 5.0CFS - 3.1CFS = 1.89CFS INCREASE FROM PRE-EXISTING CONDITIONS
V(PROPOSED) = ((0.78 X 0.175) + (1.13 X 0.175) + (2.12 X 0.86))/ 12)
= 0.18AC-FT = 7,832CF PROPOSED ONSITE VOLUME
V(INCREASE) = 0.18 - 0.09AC-FT = 0.09ACFT INCREASE FROM PRE-EXISTING CONDITIONS
- 7. PROPOSED VOLUME TO RETAIN ROOF RUNOFF IN FRONT AND SIDEYARDS.
ASSUME MAXIMUM ROOF AREA = 2000SF FOR TYPICAL LOT
IMPERVIOUS AREA "D" = 2000SF = 0.0459ACRES
V(PROPOSED) = ((2.12 X 0.0459)/12) = 0.0081AC-FT = 353CF
V(EXISTING) = ((0.53 X 0.0459)/12) = 0.0020 AC-FT = 88CF
DETAIN DIFFERENCE BETWEEN DEVELOPED AND UNDEVELOPED CONDITIONS
V(DELTA) = 353CF - 88CF =265CF VOLUME REQUIRED
- 8. PROPOSED VOLUME PROVIDED
LOT 1: VOL=((372SF +813SF)/2) X 0.5FT = **296CF>265CF OK**
LOT 2: VOL=((353SF +859SF)/2) X 0.5FT = **303CF>265CF OK**
LOT 3: VOL=((307SF +1008SF)/2) X 0.5FT = **328CF>265CF OK**
LOT 4: VOL=((223SF +409SF)/2) X 0.5FT + ((140SF +294SF)/2) X 0.5FT = **267CF>265CF OK**
LOT 5: VOL=((272SF +831SF)/2) X 0.5FT = **290CF>265CF OK**
LOT 1: VOL=((311SF +846SF)/2) X 0.5FT = **290CF>265CF OK**

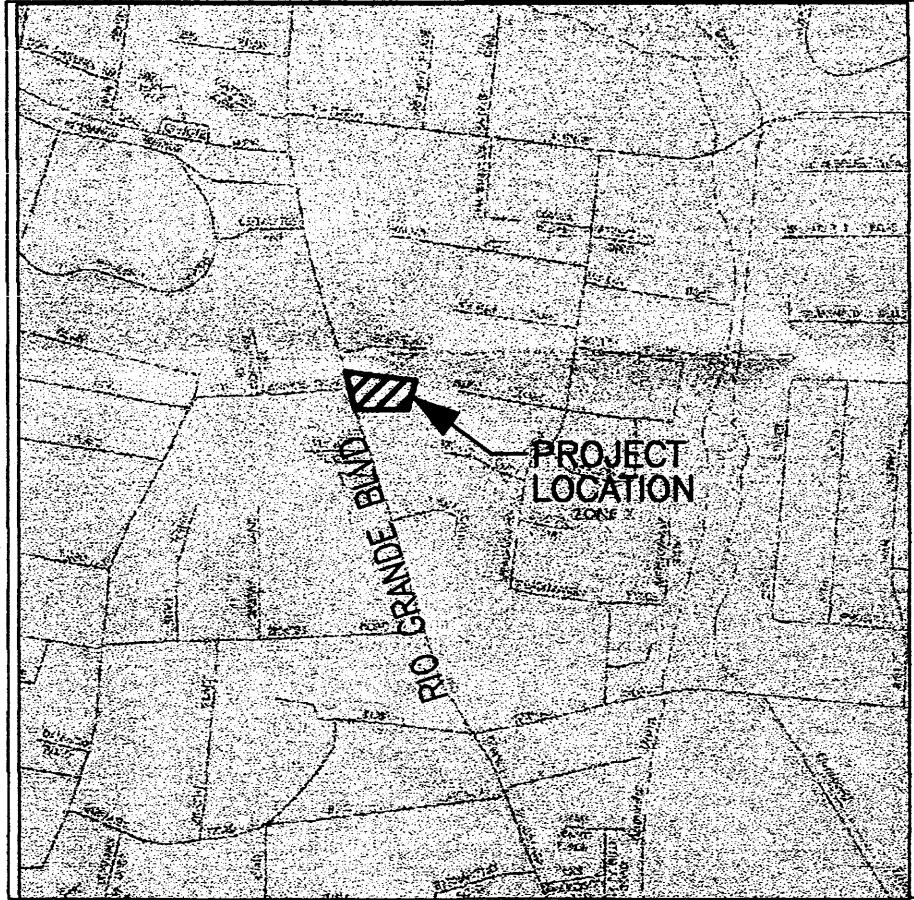


FIRM MAP 35001C0331D

SCALE: N.T.S.

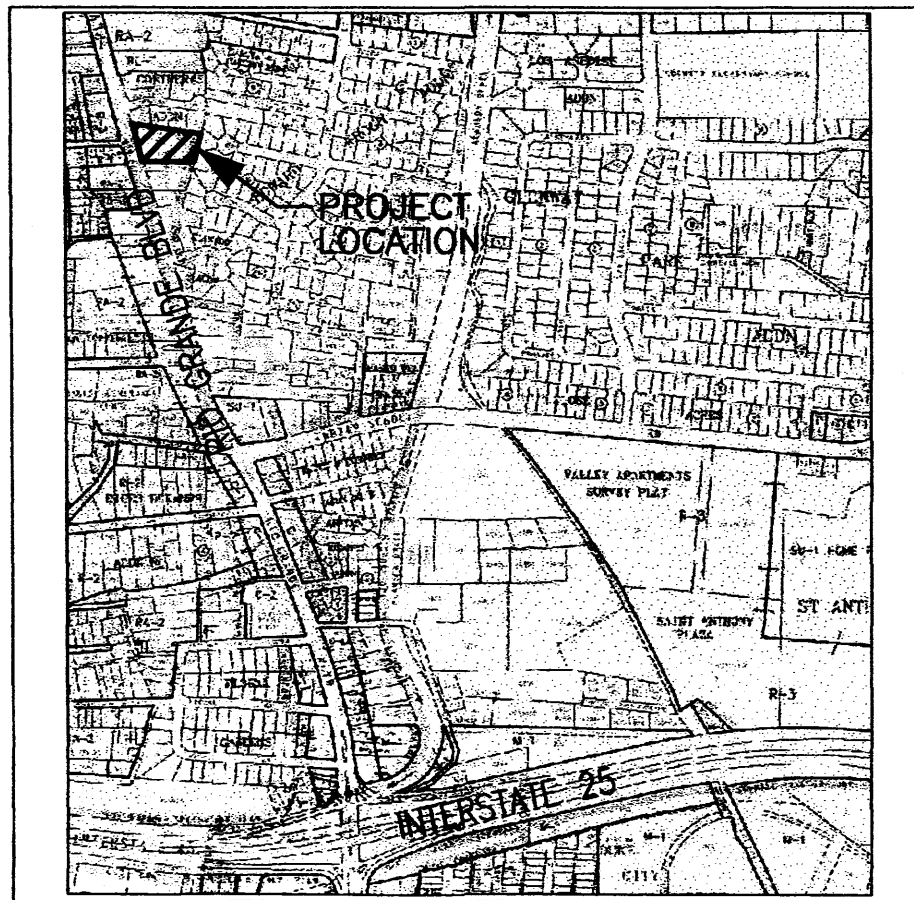


VICINITY MAP H-13

SCALE: N.T.S.

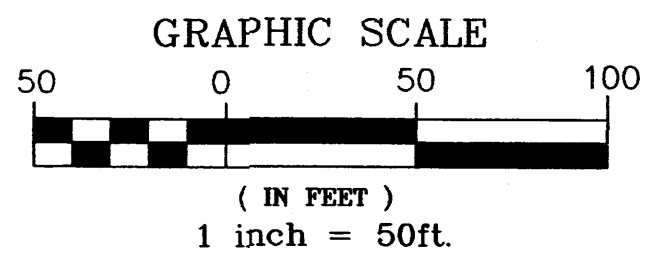

FILE:	HACIENDA DON VILLEGAS DRAINAGE CALCULATIONS	DATE/REVISIONS:
		SHEET NUMBER: 2 of 2
APPLIED ENGINEERING AND SURVEYING, INC. ENGINEERS AND PLANNERS 1600 Blvd. One NE Albuquerque, New Mexico 87112 Office: (505) 490-9125 Fax: (505) 237-8814 email: gadsden7@psdnet.com		

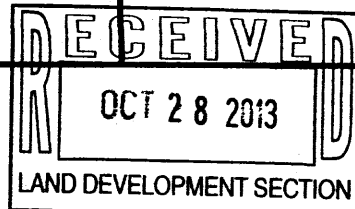

CONSTRUCTION NOTES:

- 1. CONSTRUCT RETAINING WALL TO NEW GRADES SHOWN.
- 2. NOT USED
- 3. GRADE TO DRAIN FROM REAR YARD TO STREET.
- 4. INSTALL MOUNTABLE CURB, ROLL TYPE PER CITY STD. DWG. 2415A.
- 5. INSTALL 4' WIDE CONCRETE SIDEWALK PER CITY STD. DWG. 2430.
- 6. INSTALL (WHEELCHAIR) CURB ACCESS RAMP, CASE II - ADEQUATE R.O.W. PER CITY STD. DWG. 2441.
- 7. CONSTRUCT RETENTION POND TO LIMITS SHOWN AND GRADES SHOWN FOR A MINIMUM VOLUME OF 265CF. CAPTURE ROOF DRAINAGE WITH CANALES AND DOWNSPOUTS AND DIRECT TO RETENTION POND.

LEGEND

5360	NEW CONTOUR GRADE	NEW GRADE BREAK	
5362	EXISTING CONTOUR GRADE	EXISTING GRADE ELEVATION	
TC62.50	AS-BUILT NEW TOP OF CURB ELEVATION	GR56.00	AS-BUILT NEW GRADE ELEVATION
FL62.00	AS-BUILT NEW FLOWLINE OF CURB ELEVATION	FL58.00	AS-BUILT FLOWLINE GRADE ELEVATION
TSW62.00	AS-BUILT NEW TOP OF SIDEWALK ELEVATION	TW58.00	AS-BUILT NEW TOP OF WALL ELEVATION
TSW62.00	AS-BUILT NEW TOP OF SIDEWALK ELEVATION	BW58.00	AS-BUILT NEW BOTTOM OF WALL ELEVATION
TSW62.00	AS-BUILT NEW TOP OF SIDEWALK ELEVATION	TOC62.00	AS-BUILT NEW TOP OF CONCRETE ELEVATION

FP = 65% Finish Pad Elevation


UTILITY PRECAUTIONS

THE CONTRACTOR SHALL INFORM ITSELF OF THE LOCATION OF ANY UTILITY LINE, PIPELINE, OR UNDERGROUND UTILITY LINE IN OR NEAR THE AREA OF THE WORK IN ADVANCE OF AND DURING EXCAVATION WORK. THE CONTRACTOR IS FULLY RESPONSIBLE FOR ANY AND ALL DAMAGE CAUSED BY ITS FAILURE TO LOCATE, IDENTIFY AND PRESERVE ANY AND ALL EXISTING UTILITIES, PIPELINES, AND UNDERGROUND UTILITY LINES. IN PLANNING AND CONDUCTING EXCAVATION, THE CONTRACTOR SHALL COMPLY WITH STATE STATUTES, MUNICIPAL AND LOCAL ORDINANCES, RULES AND REGULATIONS, IF ANY, PERTAINING TO THE LOCATION OF THESE LINES AND FACILITIES.

LOTS 1 THROUGH 6 VILLEGAS ESTATES

APPROVED FOR ROUGH GRADING:

NAME _____ DATE _____

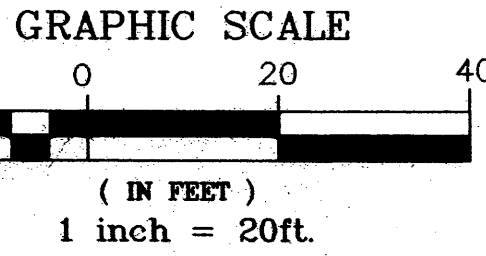


APPLIED ENGINEERING AND SURVEYING, INC.
ENGINEERS AND PLANNERS

CITY OF ALBUQUERQUE
PUBLIC WORKS DEPARTMENT
ENGINEERING DEVELOPMENT GROUP

TITLE: GRADING PLAN HACIENDA DON VILLEGAS

Design Review Committee	City Engineer Approval	Mo./Day/Yr.	Mo./Day/Yr.
FOR INFORMATION ONLY		Mo./Day/Yr.	Mo./Day/Yr.
City Project No.	Zone Map No.	Sheet	Of
764283	H-13	3	7

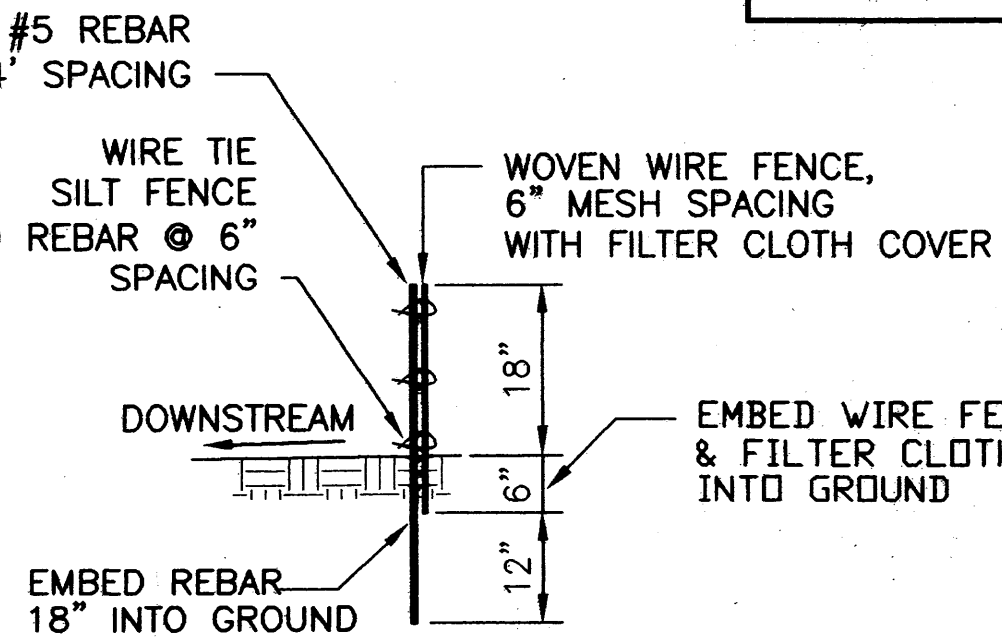

SILT FENCE DETAIL

- SCALE: 1/2" = 1'-0"
- * INSTALL SILT FENCE ALONG THE BACK OF SIDEWALK ALONG RIO GRANDE BLVD. TO KEEP SEDIMENT OUT OF THIS EXISTING STREET.
 - * THIS PROJECT REQUIRES THE CONTRACTOR TO OBTAIN A NATIONAL POLLUTANT DISCHARGE ELIMINATION SYSTEM (NPDES) PERMIT.

I, GILBERT ALDAZ, NMPE 10848, OF THE FIRM APPLIED ENGINEERING & SURVEYING, INC., HEREBY CERTIFY THAT THIS PROJECT HAS BEEN GRADED AND VAL DRAIN IN SUBSTANTIAL COMPLIANCE WITH AND IN ACCORDANCE WITH THE DESIGN INTENT OF THE APPROVED PLAN DATED OCTOBER 28, 2013. THE RECORD INFORMATION EDITED ONTO THE ORIGINAL DESIGN DOCUMENT HAS BEEN OBTAINED BY RUSS P. HUGG, NMPS 9750, OF THE FIRM SURV TEK, INC. I FURTHER CERTIFY THAT I HAVE PERSONALLY VISITED THE PROJECT SITE ON SEPTEMBER 8, 2015 AND HAVE DETERMINED BY VISUAL INSPECTION THAT THE SURVEY DATA PROVIDED IS REPRESENTATIVE OF ACTUAL SITE CONDITIONS AND IS TRUE AND CORRECT TO THE BEST OF MY KNOWLEDGE AND BELIEF. THIS CERTIFICATION IS SUBMITTED IN SUPPORT OF A REQUEST FOR CERTIFICATION OF WORK ORDER DRAWINGS.

(DESCRIBE ANY EXCEPTIONS AND/OR QUALIFICATIONS HERE IN A SEPARATE PARAGRAPH) NON NOTED.

(DESCRIBE ANY DEFICIENCIES AND/OR REQUIRED CORRECTIONS HERE IN A SEPARATE PARAGRAPH) NONE NOTED.


THE RECORD INFORMATION PRESENTED HEREON IS NOT NECESSARILY COMPLETE AND INTENDED ONLY TO VERIFY SUBSTANTIAL COMPLIANCE OF THE GRADING AND DRAINAGE ASPECTS OF THIS PROJECT. THOSE RELYING ON THIS RECORD DOCUMENT ARE ADVISED TO OBTAIN INDEPENDENT VERIFICATION OF ITS ACCURACY BEFORE USING IT FOR ANY OTHER PURPOSES.



09-08-15
DATE

GRADING PLAN

SCALE: 1" = 20'

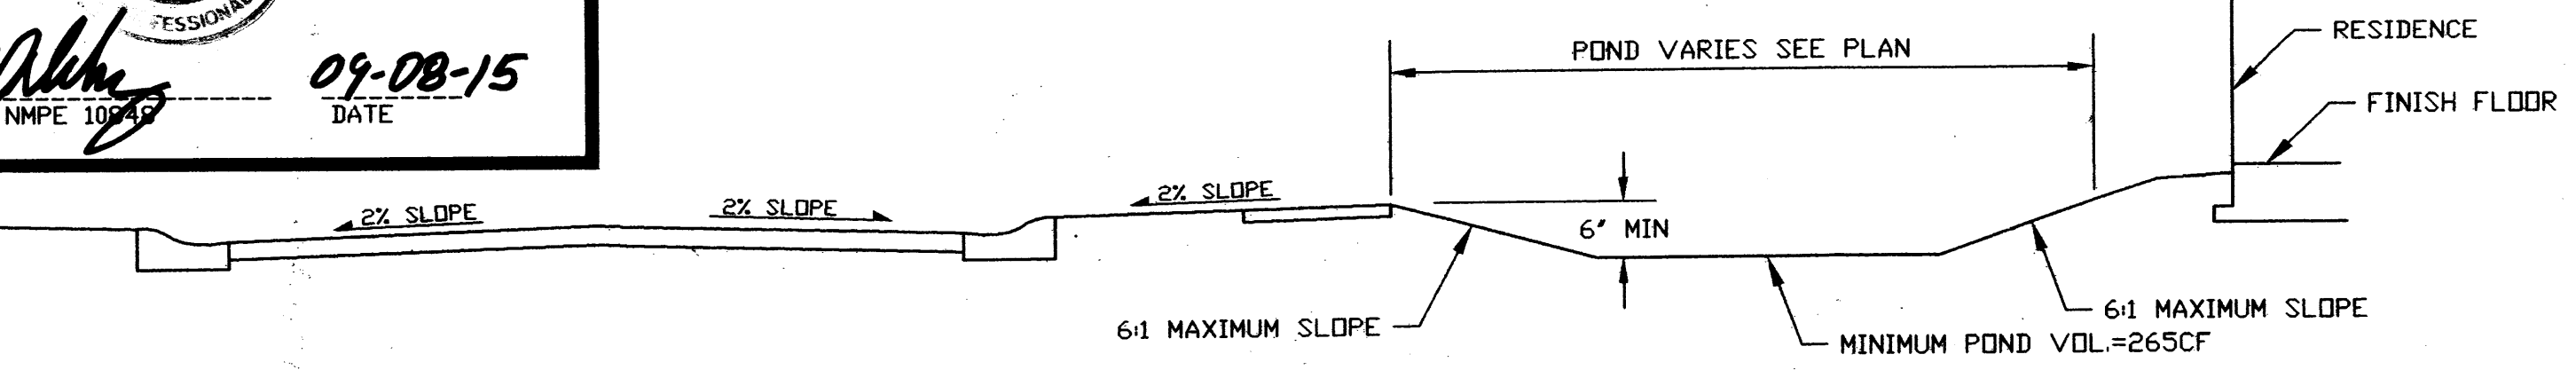

TYPICAL CROSS SECTION THROUGH POND

SCALE: N.T.S.

