

CONSTRUCTION PLANS
FOR
HACIENDAS DON VILLEGAS
SUBDIVISION ON RIO GRANDE BLVD.
ALBUQUERQUE, NEW MEXICO

INDEX

SHEET NO.	SHEET TITLE
1	TITLE SHEET
2	SURVEY PLAT
3	GRADING PLAN (FOR INFORMATION ONLY)
4	WATER AND SANITARY SEWER, RIO GRANDE BLVD NW
5	WATER AND SANITARY SEWER, VIA VILLEGAS COURT NW
6	PAVING PLAN AND PROFILE, VIA VILLEGAS COURT NW
7	DETAIL SHEET – WATER SHUTOFF AND CONCRETE PAVING

RECORD DRAWINGS

I, Gilbert Aldaz of the firm of Applied Engineering & Surveying, Inc., a Registered Professional Engineer in the State of New Mexico, and Project Engineer for the construction of: Hacienda Don Villegas Subdivision, Project No. 764283, Sheets 1-7 as constructed by RGS Construction, LLC do hereby certify, to the best of my knowledge and belief, that the infrastructure installed as part of this project noted above has been inspected by me or by a qualified person under my direct supervision and has been constructed in accordance with the plans and specifications approved by the City Engineer and that the original design intent of the approved plans has been met, except as noted by me on the as-built construction drawings. This certification is based on site inspections by me or personnel under my direction and survey information provided by Russ Hugg, NMPS 9750.



Gilbert Aldaz
GILBERT ALDAZ, NMPE 10848


09-08-15
DATE

CAUTION:
NOTE THAT ALL EXISTING UTILITIES MAY NOT BE SHOWN. ALL EXISTING SERVICE CONNECTIONS ARE NOT SHOWN. ANY EXISTING UTILITIES THAT ARE SHOWN ARE APPROXIMATE LOCATION ONLY. IT SHALL BE THE SOLE RESPONSIBILITY OF THE CONTRACTOR TO CONTACT ALL THE UTILITY OWNERS AND TO CONDUCT ALL NECESSARY FIELD INVESTIGATIONS PRIOR TO ANY EXCAVATIONS TO DETERMINE THE ACTUAL LOCATION OF UTILITIES AND OTHER IMPROVEMENTS.

DRB - 1005403

RECORD
DRAWING

APPROVED AS RECORD DRAWINGS
DESIGN REVIEW SECTIONS
CITY CONSTRUCTION ENGINEER
DATE: 4/7/2016

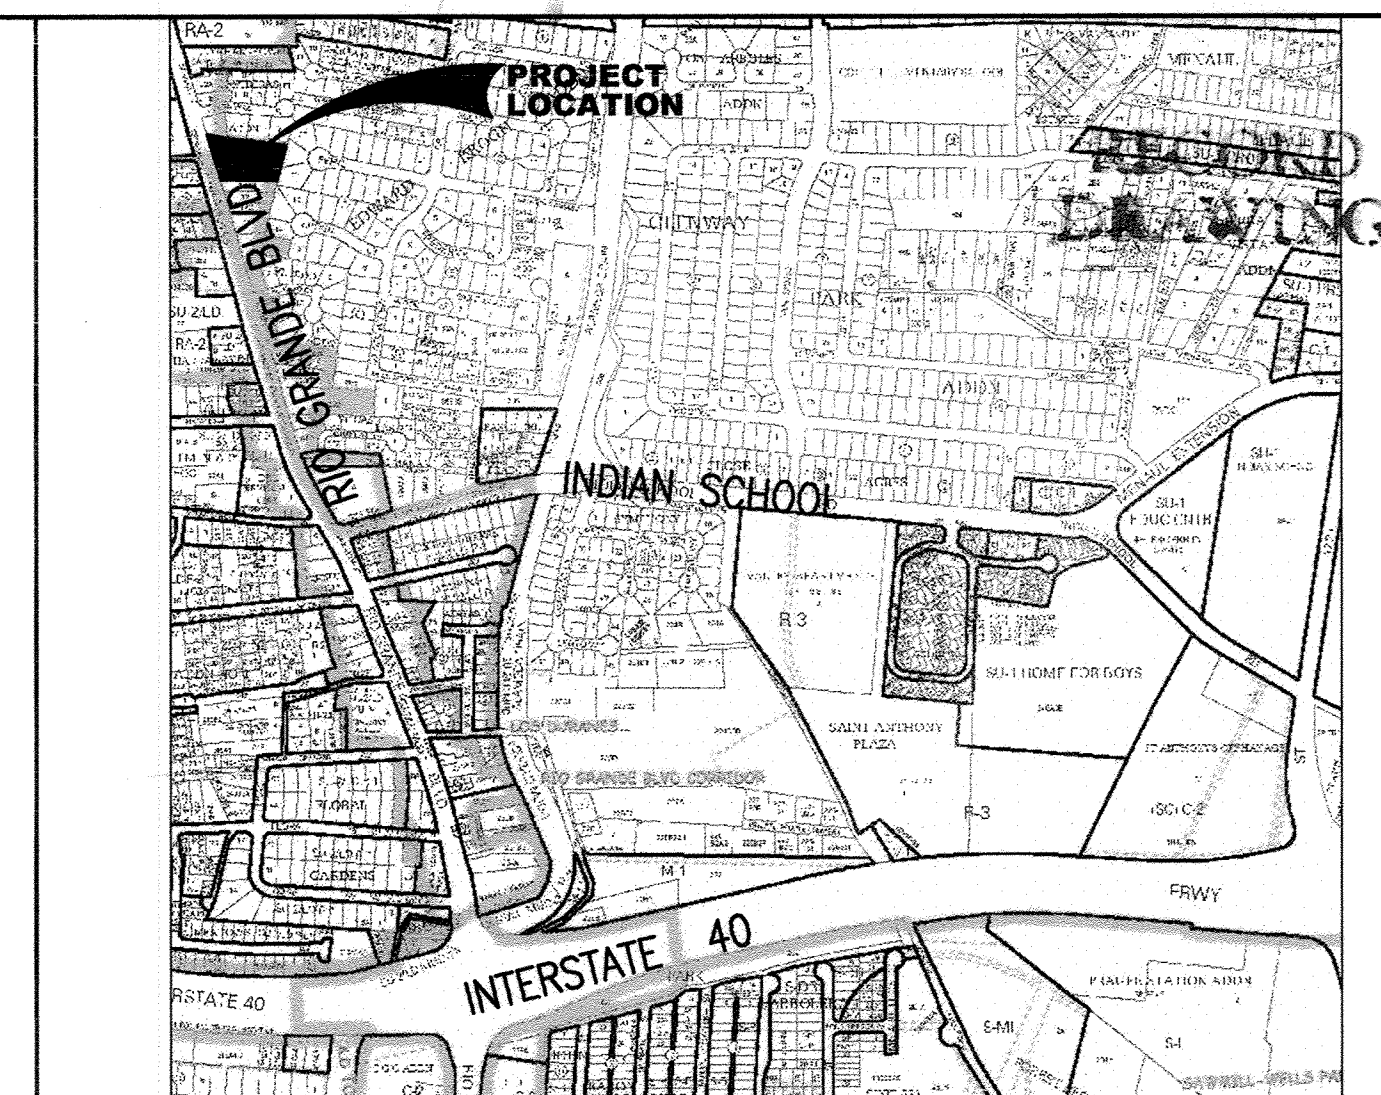


VICINITY MAP (H-13)

GENERAL NOTES
NOTICE TO CONTRACTORS

- ALL WORK DETAILED ON THESE PLANS TO BE PERFORMED UNDER CONTRACT SHALL, EXCEPT AS OTHERWISE STATED OR PROVIDED FOR HEREON, BE CONSTRUCTED IN ACCORDANCE WITH THE CITY OF ALBUQUERQUE STANDARD SPECIFICATIONS FOR PUBLIC WORKS CONSTRUCTION, 1986 EDITION AS REVISED THROUGH UPDATE #8, INCLUDING AMENDMENT No. 1.
- TWO WORKING DAYS PRIOR TO ANY EXCAVATION, CONTRACTOR MUST CONTACT NEW MEXICO ONE CALL SYSTEM (260-1990) AND DETERMINE LOCATION OF EXISTING UTILITIES.
- PRIOR TO ANY CONSTRUCTION, THE CONTRACTOR SHALL EXCAVATE AND VERIFY THE HORIZONTAL AND VERTICAL LOCATIONS OF ALL OBSTRUCTION. SHOULD A CONFLICT EXIST, THE CONTRACTOR SHALL NOTIFY THE ENGINEER OR THE SURVEYOR SO THAT THE CONFLICT CAN BE RESOLVED WITHOUT DELAY.
- ALL EXISTING SIGNS, MARKERS, DELINEATORS, STRIPING, BIKE SYMBOLS, ETC. WITHIN THE CONSTRUCTION LIMITS SHALL BE REMOVED, STORED AND RE-SET BY THE CONTRACTOR.
- THE CONTRACTOR SHALL NOTIFY THE ENGINEER NOT LESS THAN SEVEN (7) DAYS PRIOR TO STARTING WORK IN ORDER THAT THE ENGINEER MAY TAKE NECESSARY MEASURES TO INSURE THE PRESERVATION OF SURVEY MONUMENTS. CONTRACTOR SHALL NOT DISTURB PERMANENT SURVEY MONUMENTS WITHOUT THE CONSENT OF THE ENGINEER AND SHALL NOTIFY THE ENGINEER AND BEAR THE EXPENSE OF REPLACING ANY THAT MAY BE DISTURBED WITHOUT PERMISSION. REPLACEMENT SHALL BE DONE ONLY BY THE CITY SURVEYOR. WHEN A CHANGE IS MADE IN THE FINISHED ELEVATIONS OF THE PAVEMENT OF ANY ROADWAY IN WHICH A PERMANENT SURVEY MONUMENT IS LOCATED, CONTRACTOR SHALL, AT HIS OWN EXPENSE, ADJUST THE MONUMENT COVER TO THE NEW GRADE UNLESS OTHERWISE SPECIFIED. REFER TO SECTION 4.4 OF THE GENERAL CONDITIONS OF THE STANDARD SPECIFICATIONS.
- SEVEN (7) WORKING DAYS PRIOR TO BEGINNING CONSTRUCTION, THE CONTRACTOR SHALL SUBMIT TO CONSTRUCTION COORDINATION DIVISION A DETAILED CONSTRUCTION SCHEDULE. TWO (2) WORKING DAYS PRIOR TO THE START OF CONSTRUCTION, THE CONTRACTOR SHALL OBTAIN A BARRICADING PERMIT FROM THE CONSTRUCTION COORDINATION DIVISION; CONTRACTOR SHALL NOTIFY THE CONSTRUCTION COORDINATION ENGINEER (924-3400) PRIOR TO OCCUPYING AN INTERSECTION. REFER TO SECTION 19 OF THE GENERAL CONDITIONS OF THE STANDARD SPECIFICATIONS.
- THE CONTRACTOR SHALL COORDINATE WITH THE WATER AUTHORITY SEVEN (7) DAY IN ADVANCE OF PERFORMING WORK THAT WILL AFFECT THE PUBLIC WATER OR SANITARY SEWER INFRASTRUCTURE. WORK REQUIRING SHUTOFF OF FACILITIES DESIGNATED AS MASTER PLAN FACILITIES MUST BE COORDINATED WITH THE WATER AUTHORITY 14 DAYS IN ADVANCE OF PERFORMING SUCH WORK. ONLY WATER AUTHORITY CREWS ARE AUTHORIZED TO OPERATE PUBLIC VALVES. SHUTOFF REQUEST MUST BE MADE ONLINE AT <http://abcwua.org/content/view/463/729/>.
- ALL EXCAVATION, TRENCHING, AND SHORING ACTIVITIES MUST BE CARRIED-OUT IN ACCORDANCE WITH OSHA 29CFR 1926.650 SUBPART P.
- CONTRACTOR WILL BE RESPONSIBLE FOR PROVIDING AND MAINTAINING ALL CONSTRUCTION SIGNING UNTIL PROJECT HAS BEEN ACCEPTED BY COA.
- IF HUMAN REMAINS ARE ENCOUNTERED, CONSTRUCTION ACTIVITIES SHALL STOP AND CONTACT THE OFFICE OF MEDICAL EXAMINATIONS FOR FURTHER DIRECTION.

APPLIED Engineering & Surveying, Inc.
1605 BLAIR DRIVE NE
ALBUQUERQUE, NEW MEXICO 87112
PHONE (505)237-1456

REV.	7	DATE	2/6/15	USER DEPARTMENT	2/5/15	DATE	2/5/15
ENGINEERS STAMP & SIGNATURE	APPROVALS	ENGINEER	DATE	*****			
	DRC Chairman	<u>W. Woodall</u>	6-23-14	APPROVED FOR CONSTRUCTION			
	Transportation	<u>Russ Hugg</u>	4/29/14				
	ABCWUA	<u>MO</u>	4/24/14				
	Hydrology	<u>Russ Hugg</u>	4-24-14				
	Parks						
Constr. Mngmt.				City Engineer		11/6/14	Date
AEHD							
CITY PROJECT No.		764283	Sheet		1	Of	7

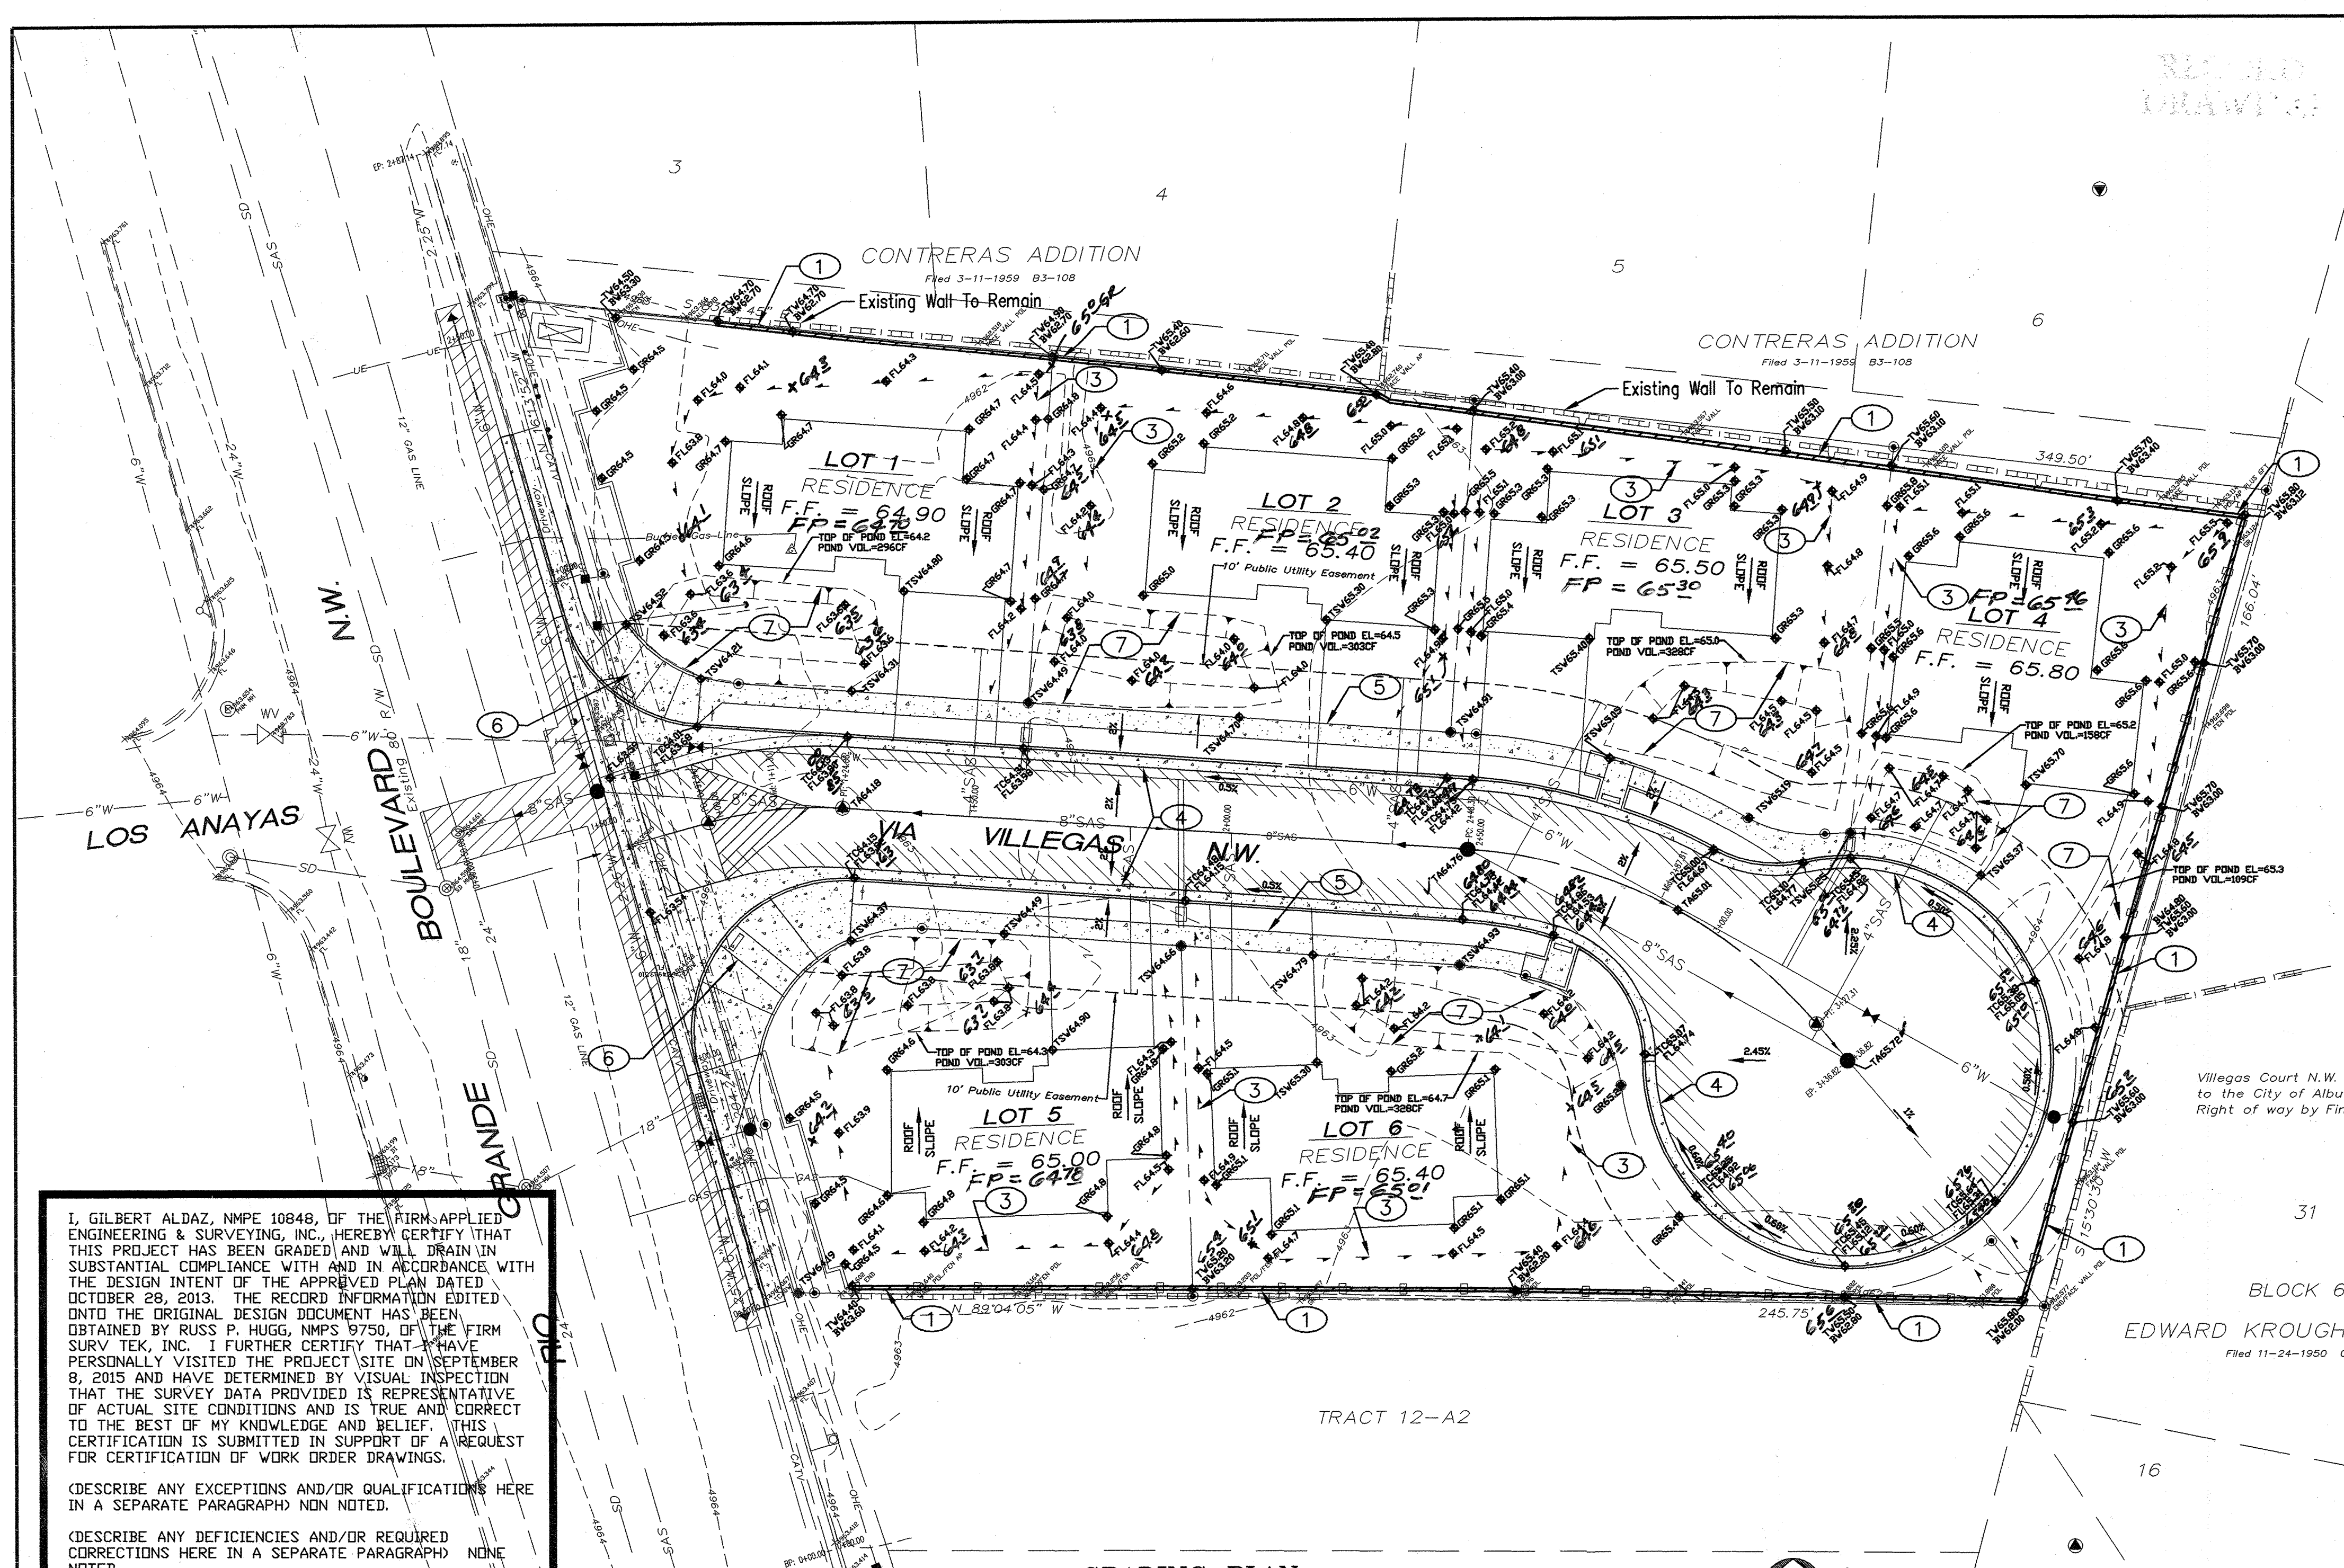

I, GILBERT ALDAZ, NMPE 10848, OF THE FIRM, APPLIED ENGINEERING & SURVEYING, INC., HEREBY CERTIFY THAT THIS PROJECT HAS BEEN GRADED AND WILL DRAIN IN SUBSTANTIAL COMPLIANCE WITH AND IN ACCORDANCE WITH THE DESIGN INTENT OF THE APPROVED PLAN DATED OCTOBER 28, 2013. THE RECORD INFORMATION EDITED ONTO THE ORIGINAL DESIGN DOCUMENT HAS BEEN OBTAINED BY RUSS P. HUGG, NMPS 9750, OF THE FIRM SURV TEK, INC. I FURTHER CERTIFY THAT I HAVE PERSONALLY VISITED THE PROJECT SITE ON SEPTEMBER 9, 2015 AND HAVE DETERMINED BY VISUAL INSPECTION THAT THE SURVEY DATA PROVIDED IS REPRESENTATIVE OF ACTUAL SITE CONDITIONS AND IS TRUE AND CORRECT TO THE BEST OF MY KNOWLEDGE AND BELIEF. THIS CERTIFICATION IS SUBMITTED IN SUPPORT OF A REQUEST FOR CERTIFICATION OF WORK ORDER DRAWINGS.

(DESCRIBE ANY EXCEPTIONS AND/OR QUALIFICATIONS HERE IN A SEPARATE PARAGRAPH) NONE NOTED.



(DESCRIBE ANY DEFICIENCIES AND/OR REQUIRED CORRECTIONS HERE IN A SEPARATE PARAGRAPH) NONE NOTED.

THE RECORD INFORMATION PRESENTED HEREON IS NOT NECESSARILY COMPLETE AND INTENDED ONLY TO VERIFY SUBSTANTIAL COMPLIANCE OF THE GRADING AND DRAINAGE ASPECTS OF THIS PROJECT. THOSE RELYING ON THIS RECORD DOCUMENT ARE ADVISED TO OBTAIN INDEPENDENT VERIFICATION OF ITS ACCURACY BEFORE USING IT FOR ANY OTHER PURPOSES.

GILBERT ALDAZ, NMPE 10848
09-08-15
DATE

GRADING PLAN
SCALE: 1" = 20'

TYPICAL CROSS SECTION THROUGH POND
SCALE: N.T.S.

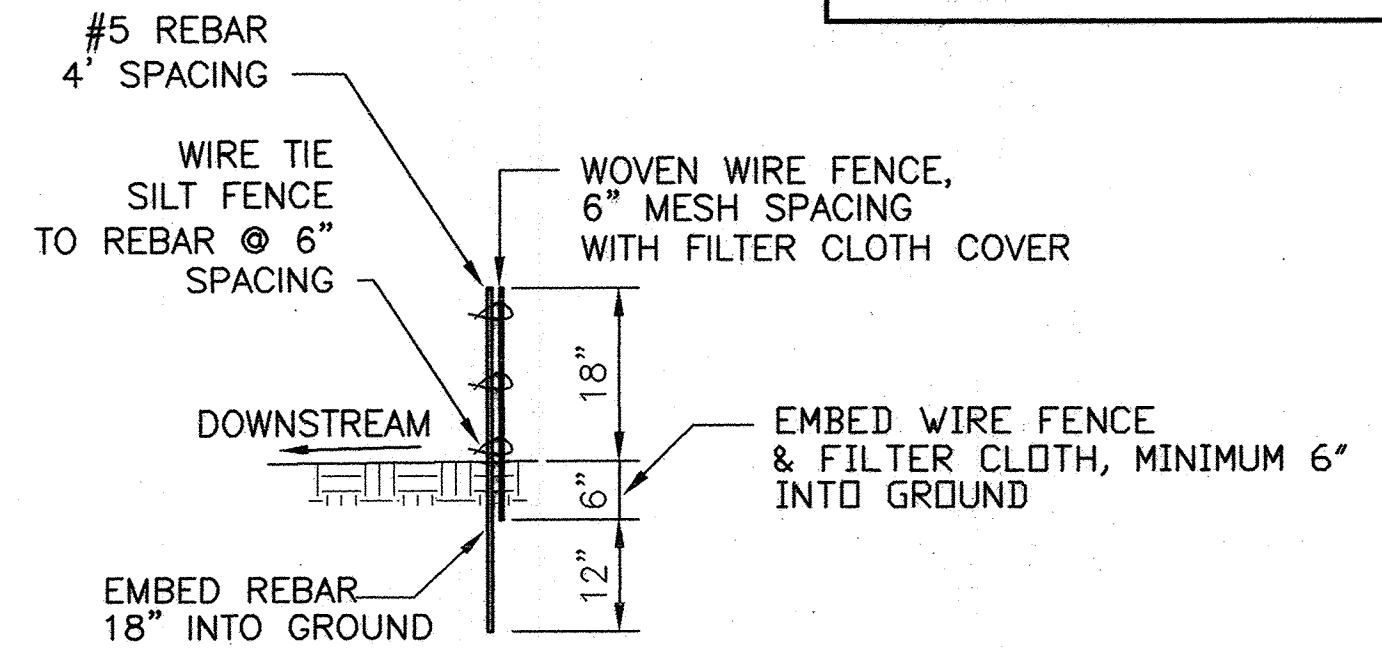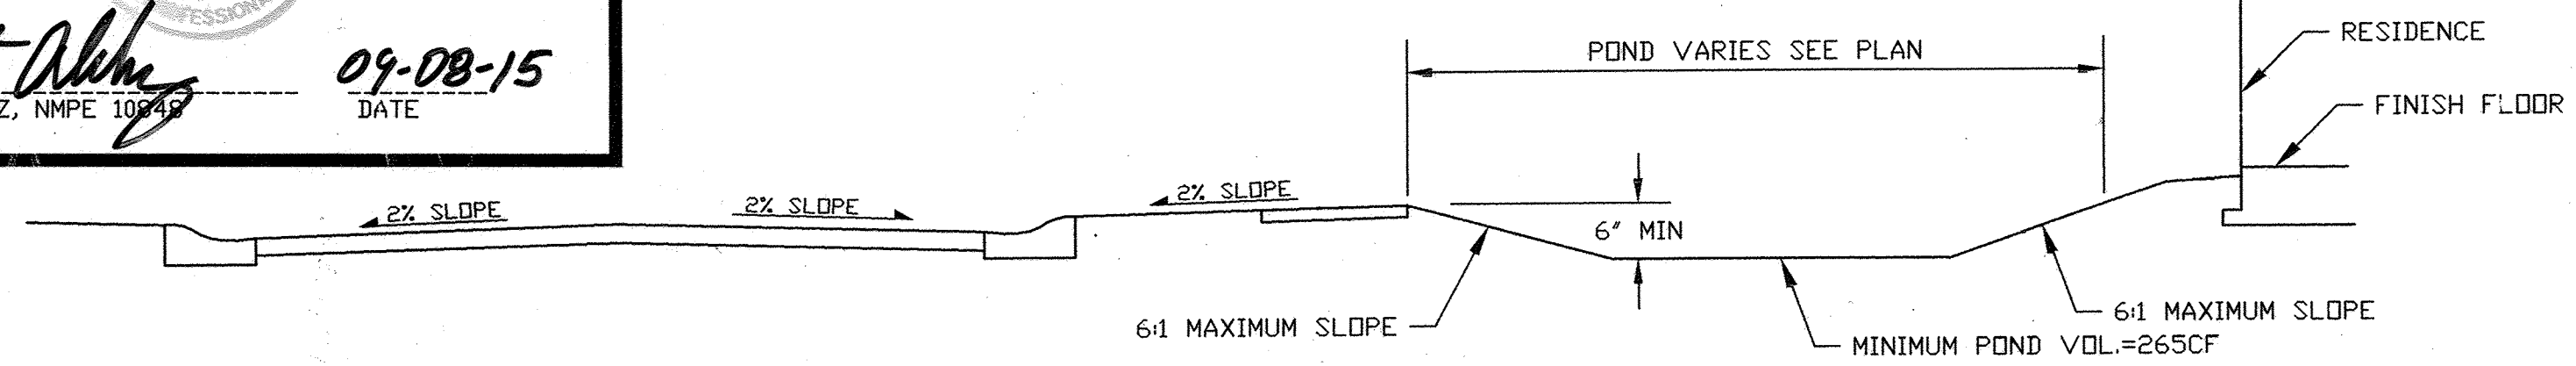

SILT FENCE DETAIL

- SCALE: 1/2" = 1'-0"
- * INSTALL SILT FENCE ALONG THE BACK OF SIDEWALK ALONG RIO GRANDE BLVD. TO KEEP SEDIMENT OUT OF THIS EXISTING STREET.
 - * THIS PROJECT REQUIRES THE CONTRACTOR TO OBTAIN A NATIONAL POLLUTANT DISCHARGE ELIMINATION SYSTEM (NPDES) PERMIT.

- CONSTRUCTION NOTES:**
1. CONSTRUCT RETAINING WALL TO NEW GRADES SHOWN.
 2. NOT USED
 3. GRADE TO DRAIN FROM REAR YARD TO STREET.
 4. INSTALL MOUNTABLE CURB, ROLL TYPE PER CITY STD. DWG. 2415A.
 5. INSTALL 4' WIDE CONCRETE SIDEWALK PER CITY STD. DWG. 2430.
 6. INSTALL (WHEELCHAIR) CURB ACCESS RAMP, CASE II - ADEQUATE R.O.W. PER CITY STD. DWG. 2441.
 7. CONSTRUCT RETENTION POND TO LIMITS SHOWN AND GRADES SHOWN FOR A MINIMUM VOLUME OF 265CF. CAPTURE ROOF DRAINAGE WITH CANALES AND DOWNSPOUTS AND DIRECT TO RETENTION POND.

LEGEND

5360

NEW CONTOUR GRADE

5362

EXISTING CONTOUR GRADE

62.50

AS-BUILT DRAINAGE FLOW DIRECTION

TC62.50

NEW TOP OF CURB ELEVATION

61.00

AS-BUILT NEW FLOWLINE OF CURB ELEVATION

FL61.00

AS-BUILT NEW TOP OF ASPHALT ELEVATION

66.00

AS-BUILT NEW TOP OF SIDEWALK ELEVATION

TSW66.00

AS-BUILT NEW TOP OF CONCRETE ELEVATION

62.50

BRAINAGE SWALE

NEW GRADE BREAK

X 5362

GR66.00

FL66.00

TW66.00

BW66.00

TOC62.50

AS-BUILT NEW GRADE ELEVATION

AS-BUILT FLOWLINE GRADE ELEVATION

AS-BUILT NEW TOP OF WALL ELEVATION

AS-BUILT NEW BOTTOM OF WALL ELEVATION

AS-BUILT NEW TOP OF CONCRETE ELEVATION

FP= 65.40 Finish Pad Elevation


UTILITY PRECAUTIONS

THE CONTRACTOR SHALL INFORM ITSELF OF THE LOCATION OF ANY UTILITY LINE, PIPELINE, OR UNDERGROUND UTILITY LINE IN OR NEAR THE AREA OF THE WORK IN ADVANCE OF AND DURING EXCAVATION WORK. THE CONTRACTOR IS FULLY RESPONSIBLE FOR ANY AND ALL DAMAGE CAUSED BY ITS FAILURE TO LOCATE, IDENTIFY AND PRESERVE ANY AND ALL EXISTING UTILITIES, PIPELINES, AND UNDERGROUND UTILITY LINES. IN PLANNING AND CONDUCTING EXCAVATION, THE CONTRACTOR SHALL COMPLY WITH STATE STATUTES, MUNICIPAL AND LOCAL ORDINANCES, RULES AND REGULATIONS, IF ANY, PERTAINING TO THE LOCATION OF THESE LINES AND FACILITIES.

**LOTS 1 THROUGH 6
VILLEGAS ESTATES**

APPROVED FOR ROUGH GRADING:

NAME _____ DATE _____

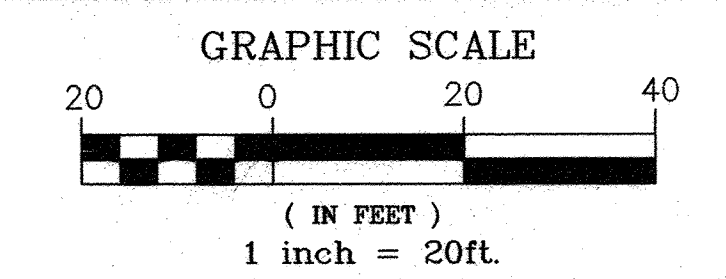


APPLIED ENGINEERING AND SURVEYING, INC.
ENGINEERS AND PLANNERS
1605 8th Street NE
Albuquerque, New Mexico 87112
Office: (505) 231-1400 Fax: (505) 231-1401

CITY OF ALBUQUERQUE
PUBLIC WORKS DEPARTMENT
ENGINEERING DEVELOPMENT GROUP



TITLE: **GRADING PLAN
HACIENDA DON VILLEGAS**

Design Review Committee	City Engineer Approval	Mo./Day/Yr.	Mo./Day/Yr.
FOR INFORMATION ONLY			
City Project No.	Zone Map No.	Sheet	Of
764283	H-13	3	7

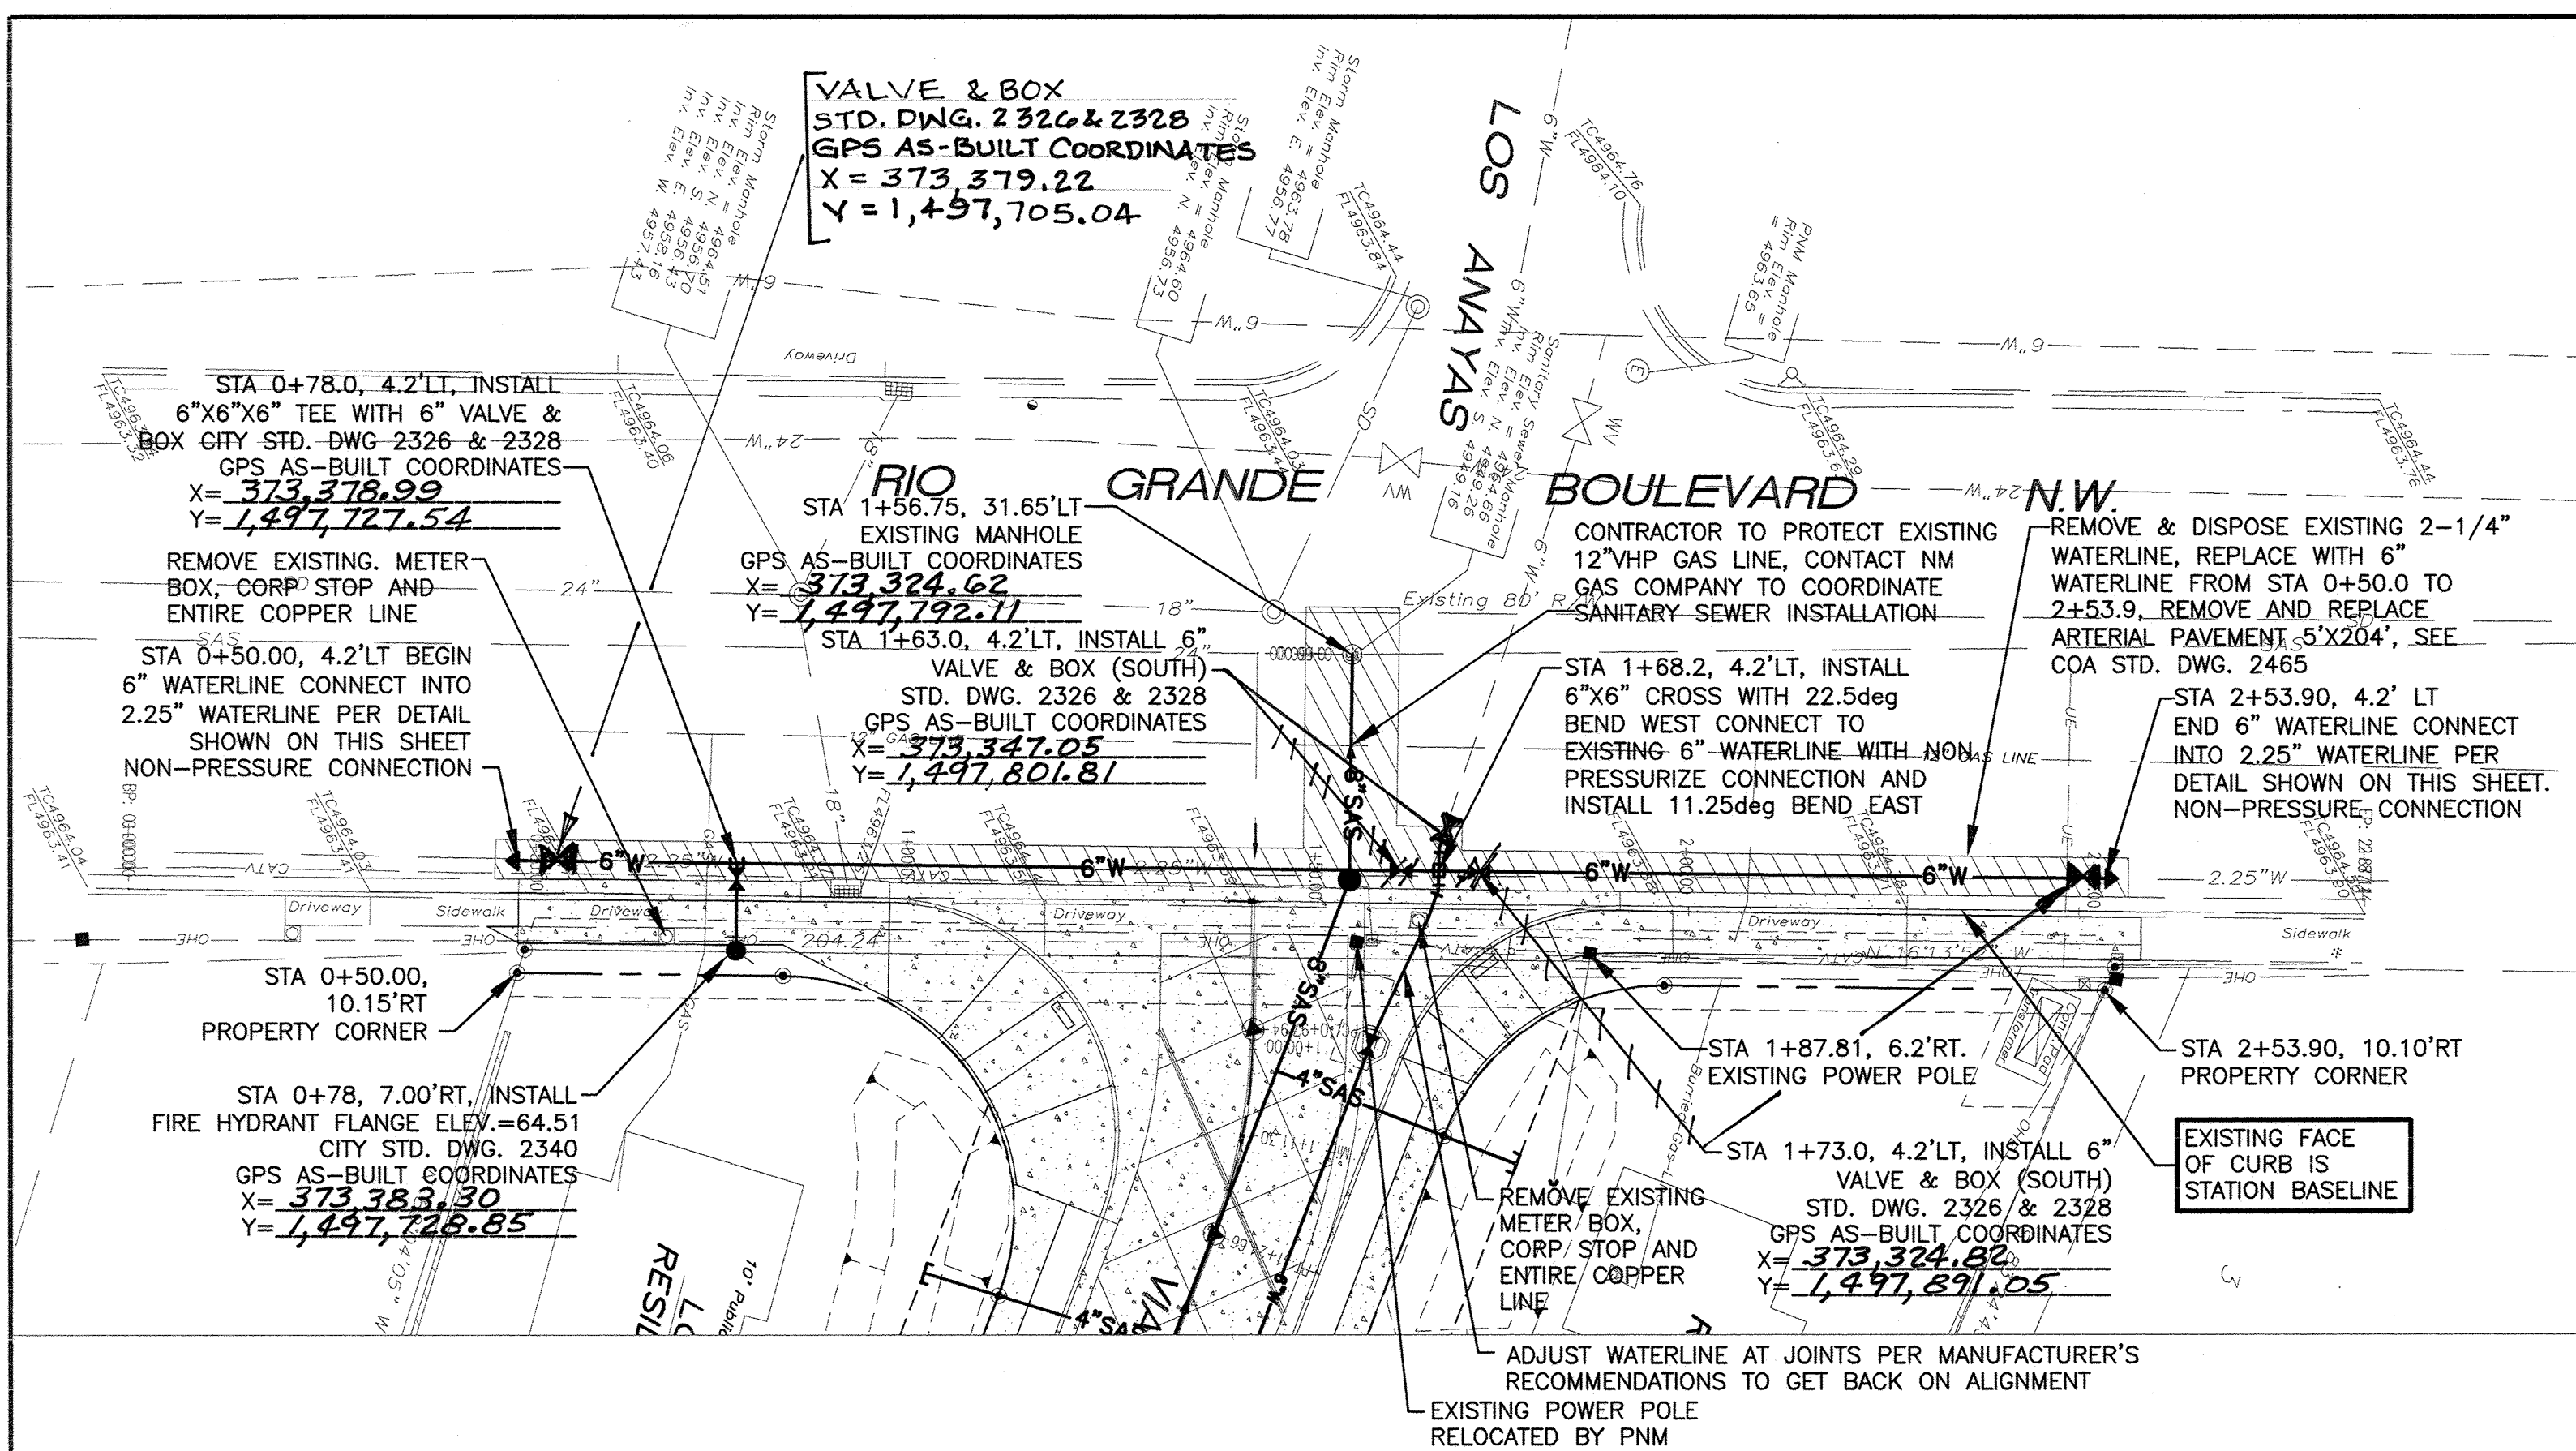

NOTE: THE STATIONING CENTERLINE IS ALONG THE EXISTING FACE OF CURB, SEE PROPERTY CORNERS FOR OFFSET AND STATIONS


SAS & WATER PLAN - VIA VILLEGAS COURT NW
SCALE: 1" = 20'

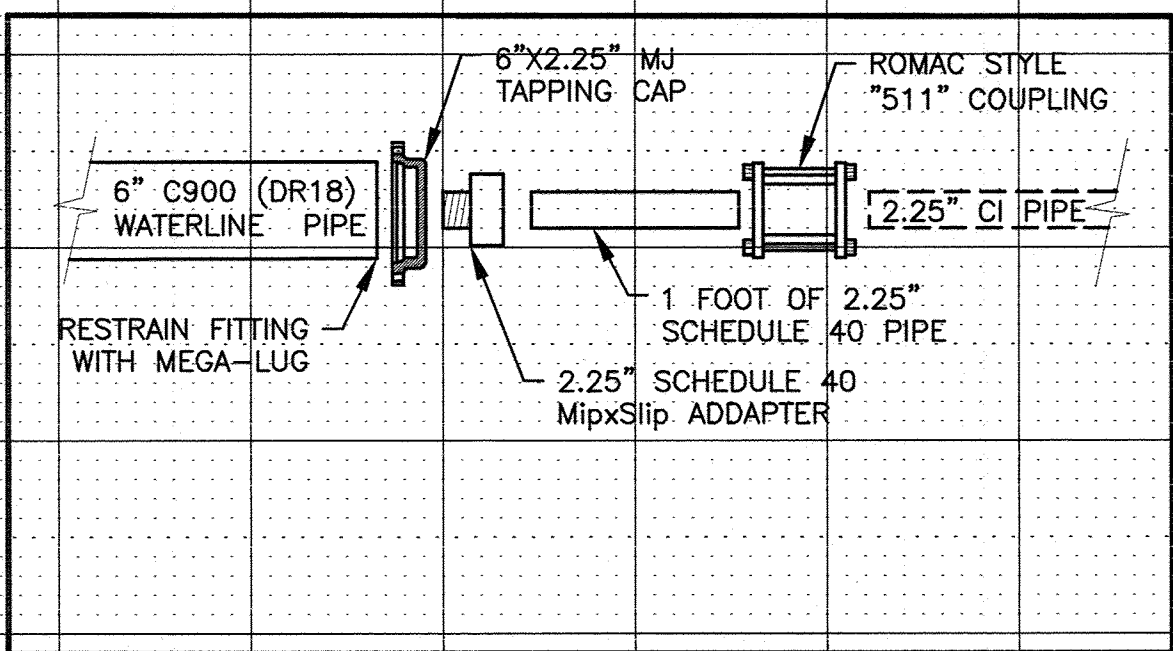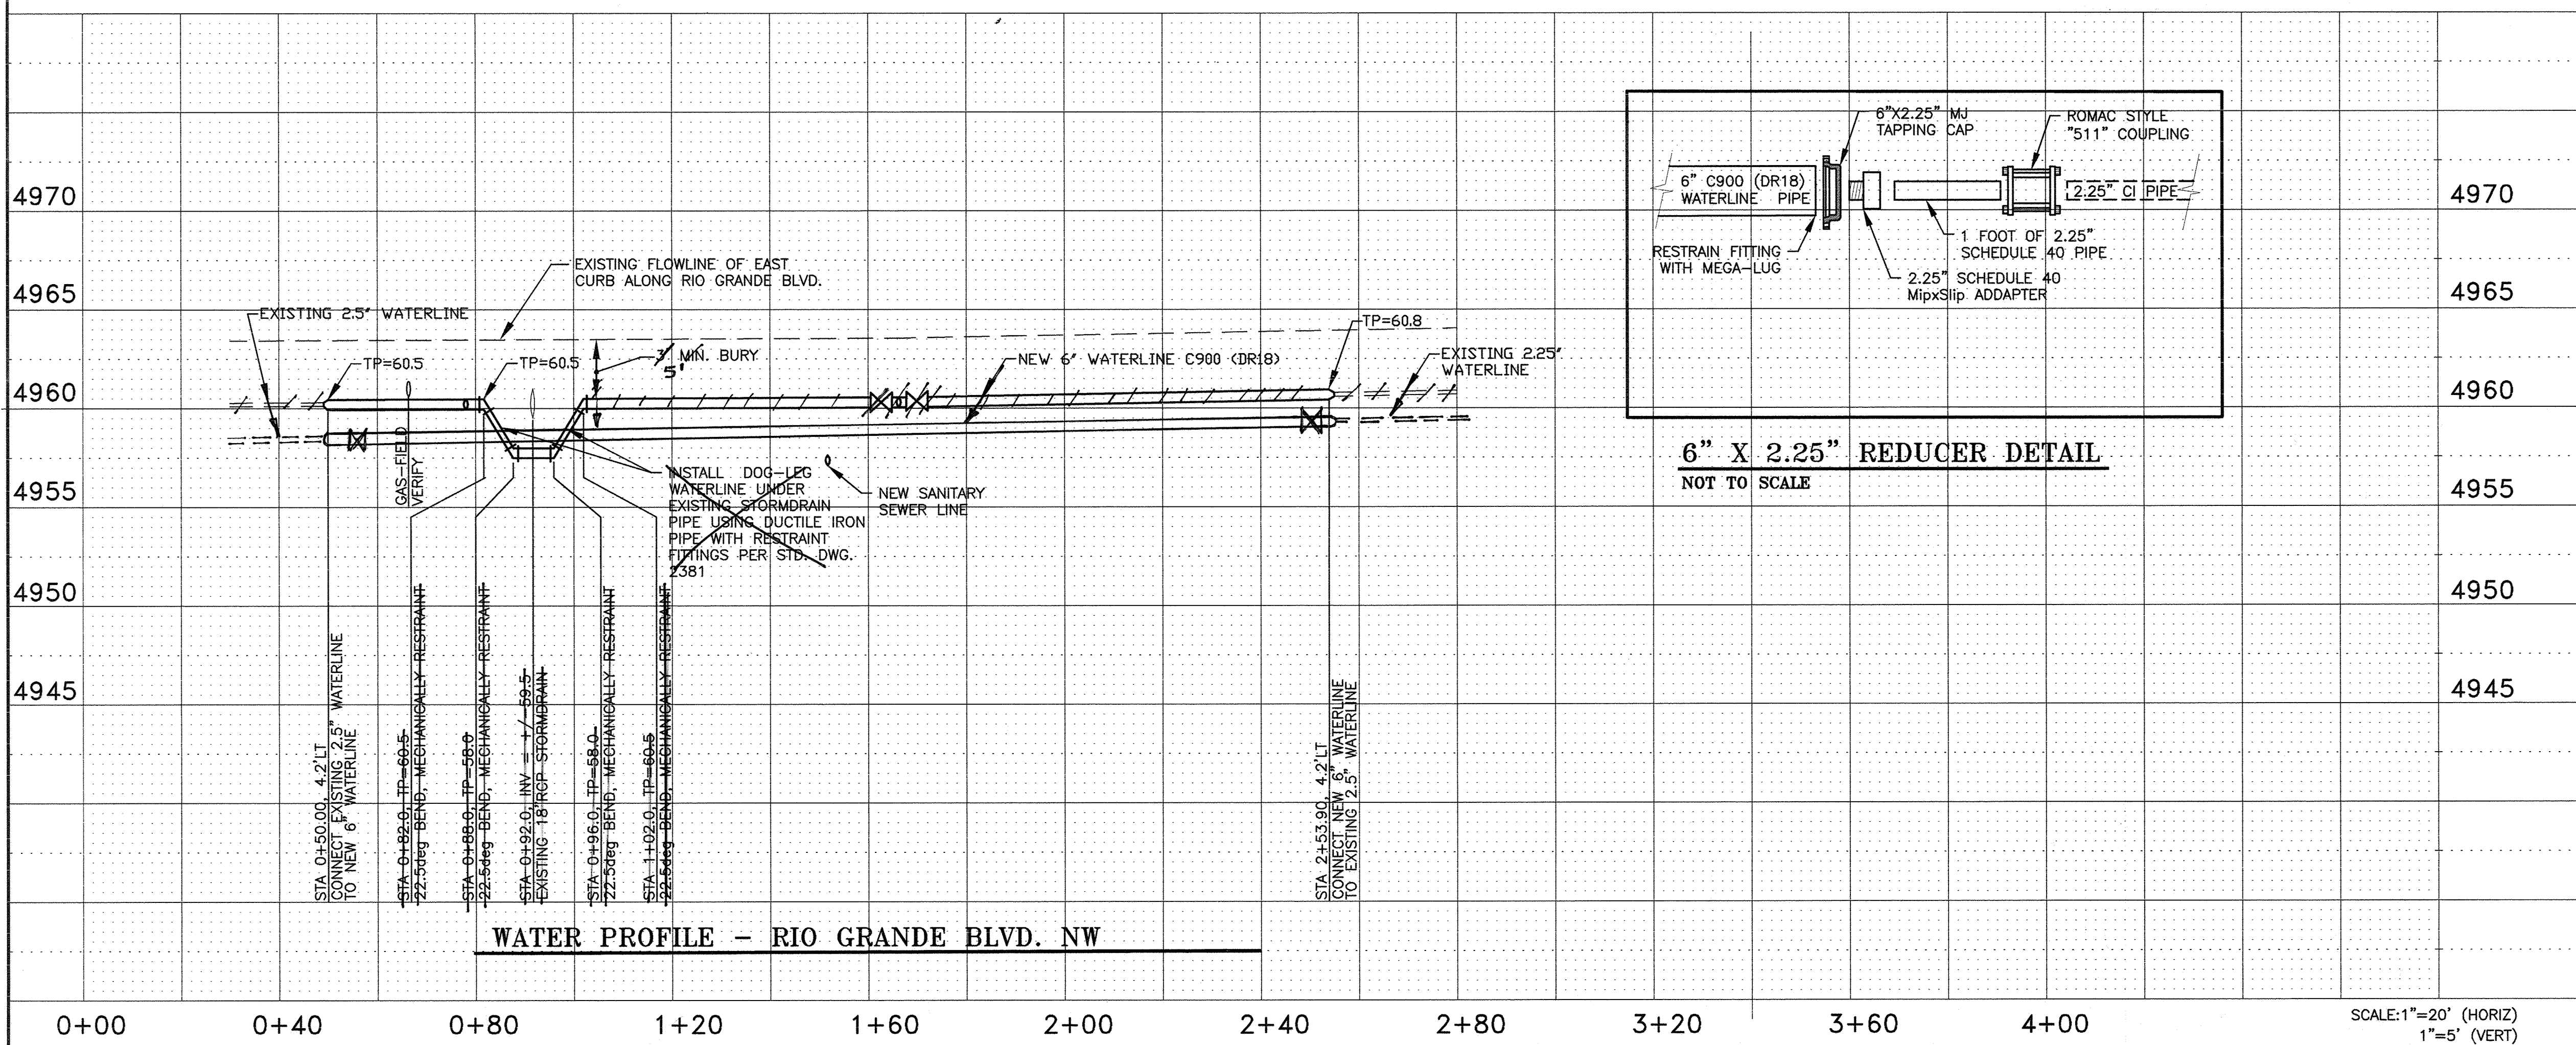

6" X 2.25" REDUCER DETAIL
NOT TO SCALE

CONSTRUCTION NOTES:

1. INSTALL 3/4" WATER METER SERVICES, WITH HEAVY DUTY WATER METER BOXES.
2. INSTALL 4" SANITARY SEWER SERVICE LINE.
3. ELECTRONIC MARKER SPHERES (EMS'S) SHALL BE INSTALLED ON ALL WATERLINE BENDS AND AT A MAXIMUM DISTANCE OF 100' FOR BOTH WATERLINES AND SEWERLINES.

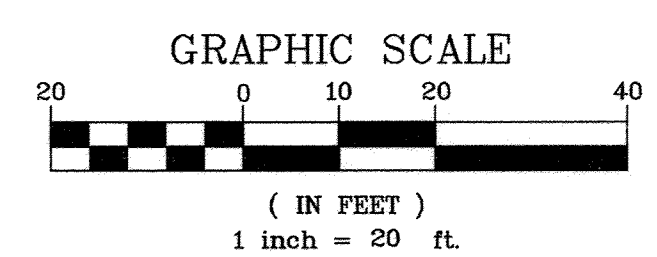

APPLIED ENGINEERING AND SURVEYING, INC.
ENGINEERS AND PLANNERS
1600 Blvd. Santa Fe, NE Albuquerque, New Mexico 87112
Office: (505) 257-1456 Fax: (505) 257-1456

CITY OF ALBUQUERQUE
PUBLIC WORKS DEPARTMENT
ENGINEERING DEVELOPMENT GROUP

TITLE: **HACIENDA DON VILLEGAS WATER & SEWER, VIA VILLEGAS COURT NW**

Design Review Committee: **APPROVED JUN 23 2014**
City Engineer Approval: **APPROVED NOV 06 2014**
Last Design Update: _____

City Project No. **764283** Zone Map No. **H-13** Sheet **4** Of **7**

NO.	DATE	REVISIONS
		DESIGN

DESIGNED BY: _____ DATE: _____
DRAWN BY: _____ DATE: _____
CHECKED BY: _____ DATE: _____

RECORD DRAWING

MECHANICAL RESTRAINT NOTES:

HORIZONTAL BENDS - PVC PIPE				
Nom. Pipe Size	Bend Angle			
	11.25 deg	22.5 deg	45 deg	90 deg
6"	3'	5'	11'	26'

VERTICAL BENDS - DI PIPE				
Nom. Pipe Size	Bend Angle			
	11.25 deg	22.5 deg	45 deg	90 deg
6"	5/3	9/6	20/12	NA

MINIMUM RESTRAINT LENGTH: A MINIMUM RESTRAINT LENGTH OF 5 FT FROM THE FITTING JOINT IS RECOMMENDED. VERTICAL OFFSETS SHALL BE COMPLETELY RESTRAINT BETWEEN THE TOP VERTICAL BEND AND THE BOTTOM VERTICAL FITTING

TEES/CROSSES - PVC PIPE			
Nom. Pipe Size	Branch Size 6"		
	L _r =5'	L _r =10'	L _r =15'
6"	43'	21'	FJO

FJO: RESTRAINT REQUIRED AT FITTING JOINT ONLY
L_r = LENGTH OF PIPE ALONG THE RUN THAT IS FREE OF JOINTS.

DEAD ENDS GATE VALVES OR END CAPS PVC PIPE	
Nom. Pipe Size	Restrained Length L
4"	46'
6"	65'

REDUCER PVC PIPE		
Nominal Pipe Size	Unobstructed Straight Run Length, Feet Restrained	
	(L _s) Small Pipe Side	(L _t) Large Pipe Side
6" X 2.25"	OPTIONAL	33'


NOTE: THE UTILITY WORK MAY REQUIRE THAT THE CONTRACTOR DEWATER THE TRENCH PRIOR TO UTILITY INSTALLATION.

AS-BUILT INFORMATION		BENCH MARKS		SURVEY INFORMATION		ENGINEER'S SEAL	
CONTRACTOR	DATE	BENCHMARK	ELEVATION	NO.	DATE	NO.	DATE
RGGS Const, LLC	06/15/15	"3-G12"	4963.294				
WORK STARTED BY	DATE						
FIELD ACCEPTANCE BY	DATE						
DESIGNED BY	DATE						
CHECKED BY	DATE						
RECORDED BY	DATE						


REMARKS: **DESIGN**

NO. DATE

DESIGNED BY: _____ DATE: _____
DRAWN BY: _____ DATE: _____
CHECKED BY: _____ DATE: _____

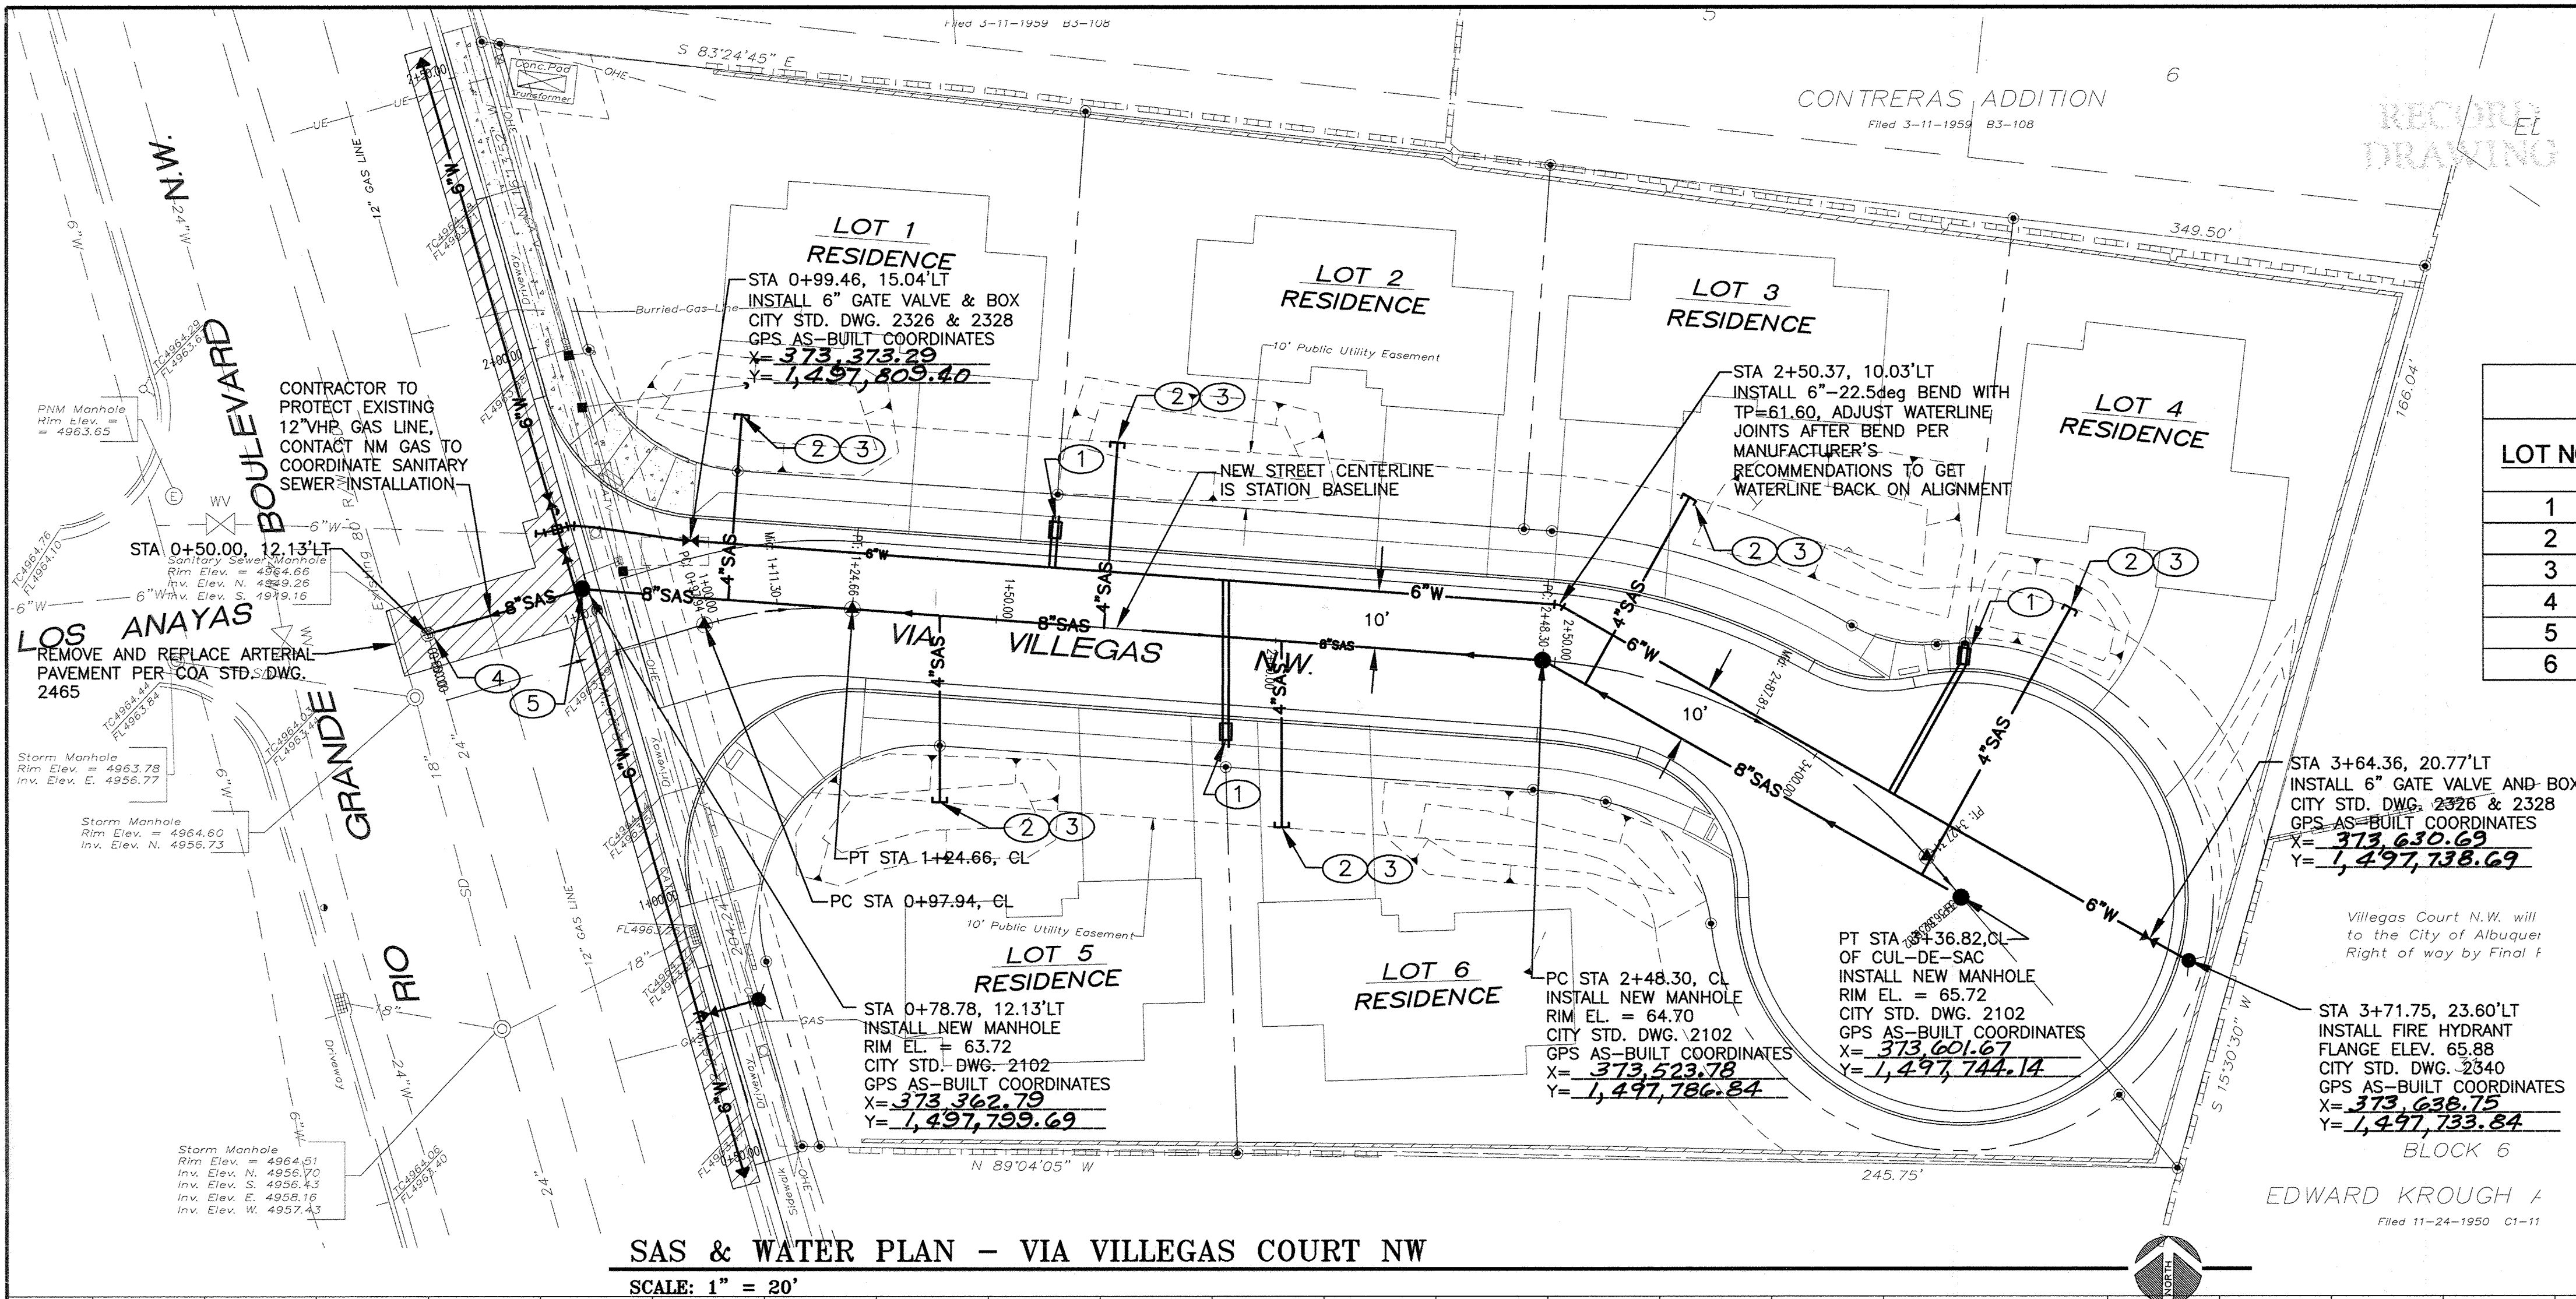

SAS & WATER PLAN - VIA VILLEGAS COURT NW
SCALE: 1" = 20'

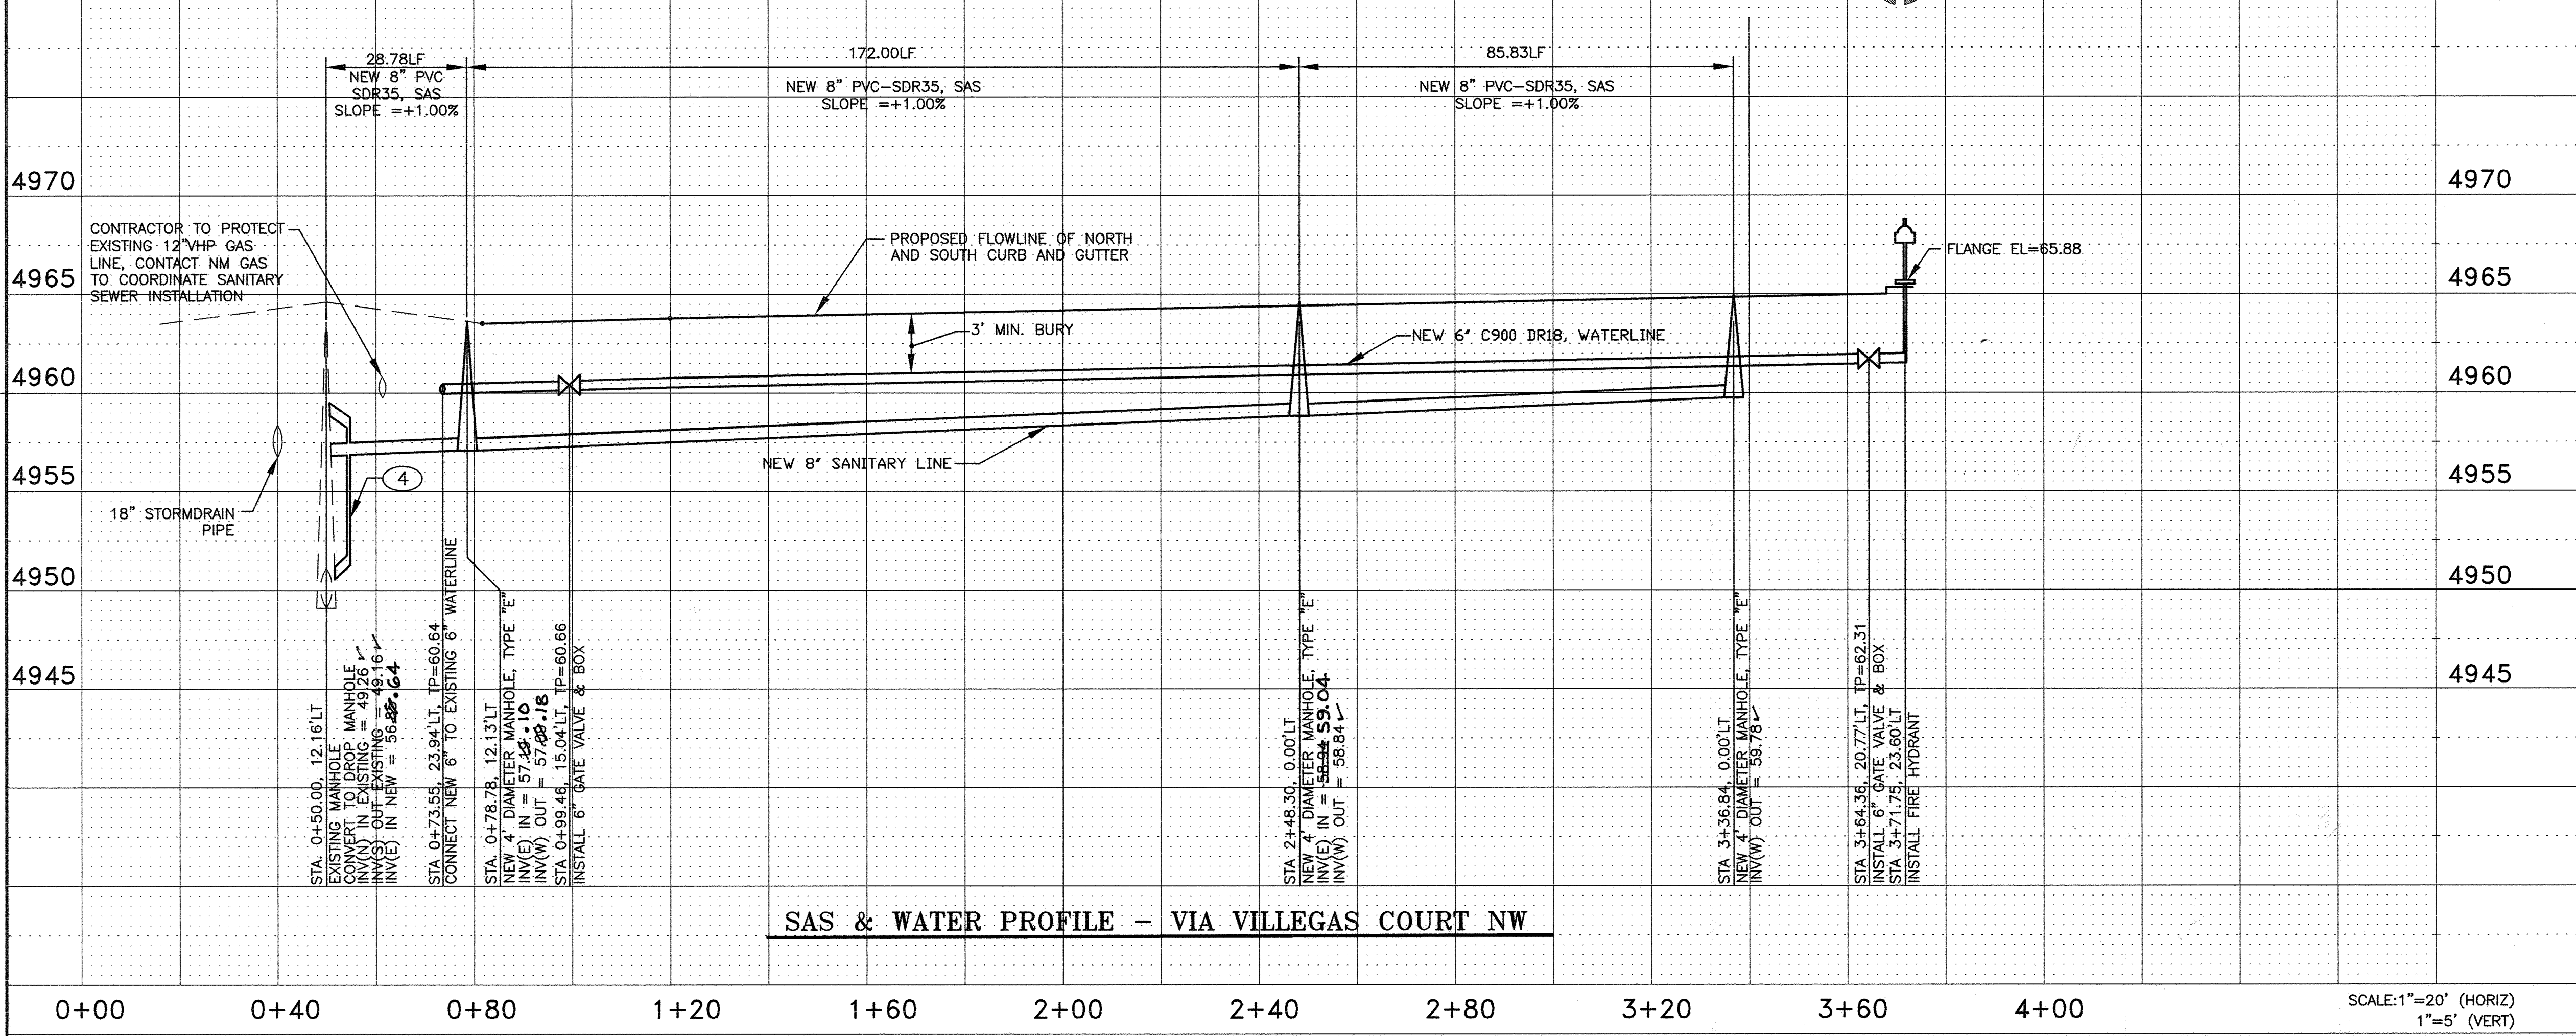

SAS & WATER PROFILE - VIA VILLEGAS COURT NW

3/4" WATER METER SERVICES		
LOT NO.	STATION AT METER BOX	OFFSET TO CENTER OF METER BOX
1	1+59.75	16.7'LT
2	1+59.75	16.7'LT
3	3+09.76	30.2'LT
4	3+09.76	30.2'LT
5	1+92.77	16.7'RT
6	1+92.77	16.7'RT


4" SANITARY SEWER SERVICES				
LOT NO.	STATION AT CAP	OFFSET	LENGTH OF SERVICE TO STUB FROM MAIN	INVERT AT STUB
1	1+09.41	33.0'LT	33.0'	59.12
2	1+69.74	33.0'LT	33.0'	59.72
3	2+66.51	33.0'LT	38.0'	60.73
4	3+16.03	49.0'LT	54.2'	61.06
5	1+42.74	33.0'RT	33.0'	59.46
6	2+03.98	33.0'RT	33.0'	60.08

RECORD
DRAWING

NOTE: SEE PREVIOUS SHEET
FOR MECHANICAL RESTRAINT
JOINT REQUIREMENTS FOR
WATERLINE CONSTRUCTION

CONSTRUCTION NOTES:

1. INSTALL 3/4" WATER METER DOUBLE SERVICES, WITH HEAVY DUTY WATER METER BOXES.
2. INSTALL 4" SANITARY SEWER SERVICE LINE.
3. ELECTRONIC MARKER SPHERES (EMS'S) SHALL BE INSTALLED ON WATERLINE AND SEWERLINE APPURTENANCES.
4. CONVERT EXISTING MANHOLE TO VERTICAL DROP AT MANHOLE PER CITY STD. 2116.
5. MAINTAIN 18" MINIMUM CLEARANCE BETWEEN EDGE OF MANHOLE AND EDGE OF WATERLINE.

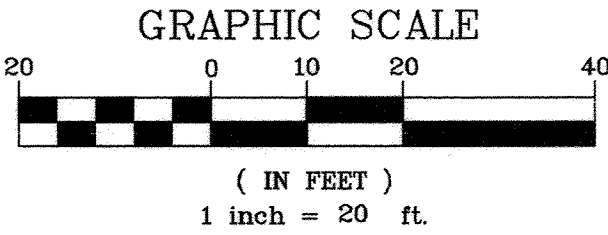



APPLIED ENGINEERING AND SURVEYING, INC.
ENGINEERS AND PLANNERS
1000 Blvd. Drive NE
Albuquerque, New Mexico 87112
Office: (505) 253-1456


CITY OF ALBUQUERQUE
PUBLIC WORKS DEPARTMENT
ENGINEERING DEVELOPMENT GROUP

TITLE: **HACIENDA DON VILLEGAS
WATER & SEWER, VIA VILLEGAS COURT NW**

Design Review Committee	City Engineer Approval	Mo./Day/Yr.	Mo./Day/Yr.
APPROVED JUN 23 2014 DESIGN REVIEW COMMITTEE	APPROVED NOV 06 2014 CITY ENGINEER		
City Project No.	Zone Map No.	Sheet	Of
764283	H-13	5	7

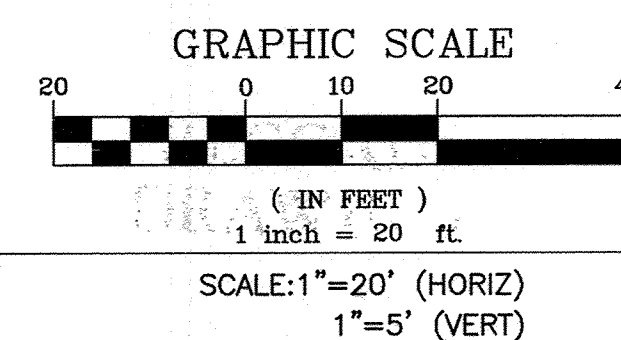

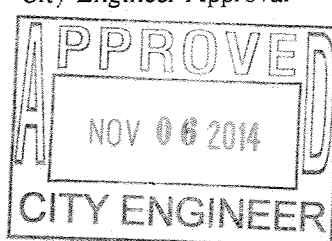
APPLIED ENGINEERING AND SURVEYING, INC. ENGINEERS AND PLANNERS 1802 East Drive NE Office: (405) 237-1406 Albuquerque, New Mexico 87112 Fax: (405) 237-1406		NO.		DESIGNED BY	DRAWN BY	CHECKED BY
CITY OF ALBUQUERQUE PUBLIC WORKS DEPARTMENT ENGINEERING DEVELOPMENT GROUP						
TITLE: HACIENDA DON VILLEGAS PAVING PLAN, VIA VILLEGAS COURT NW						
Design Review Committee 		City Engineer Approval 		Last Design Update:	Mo./Day/Yr.	Mo./Day/Yr.
City Project No. 764283		Zone Map No. H-13		Sheet 6 Of 7		

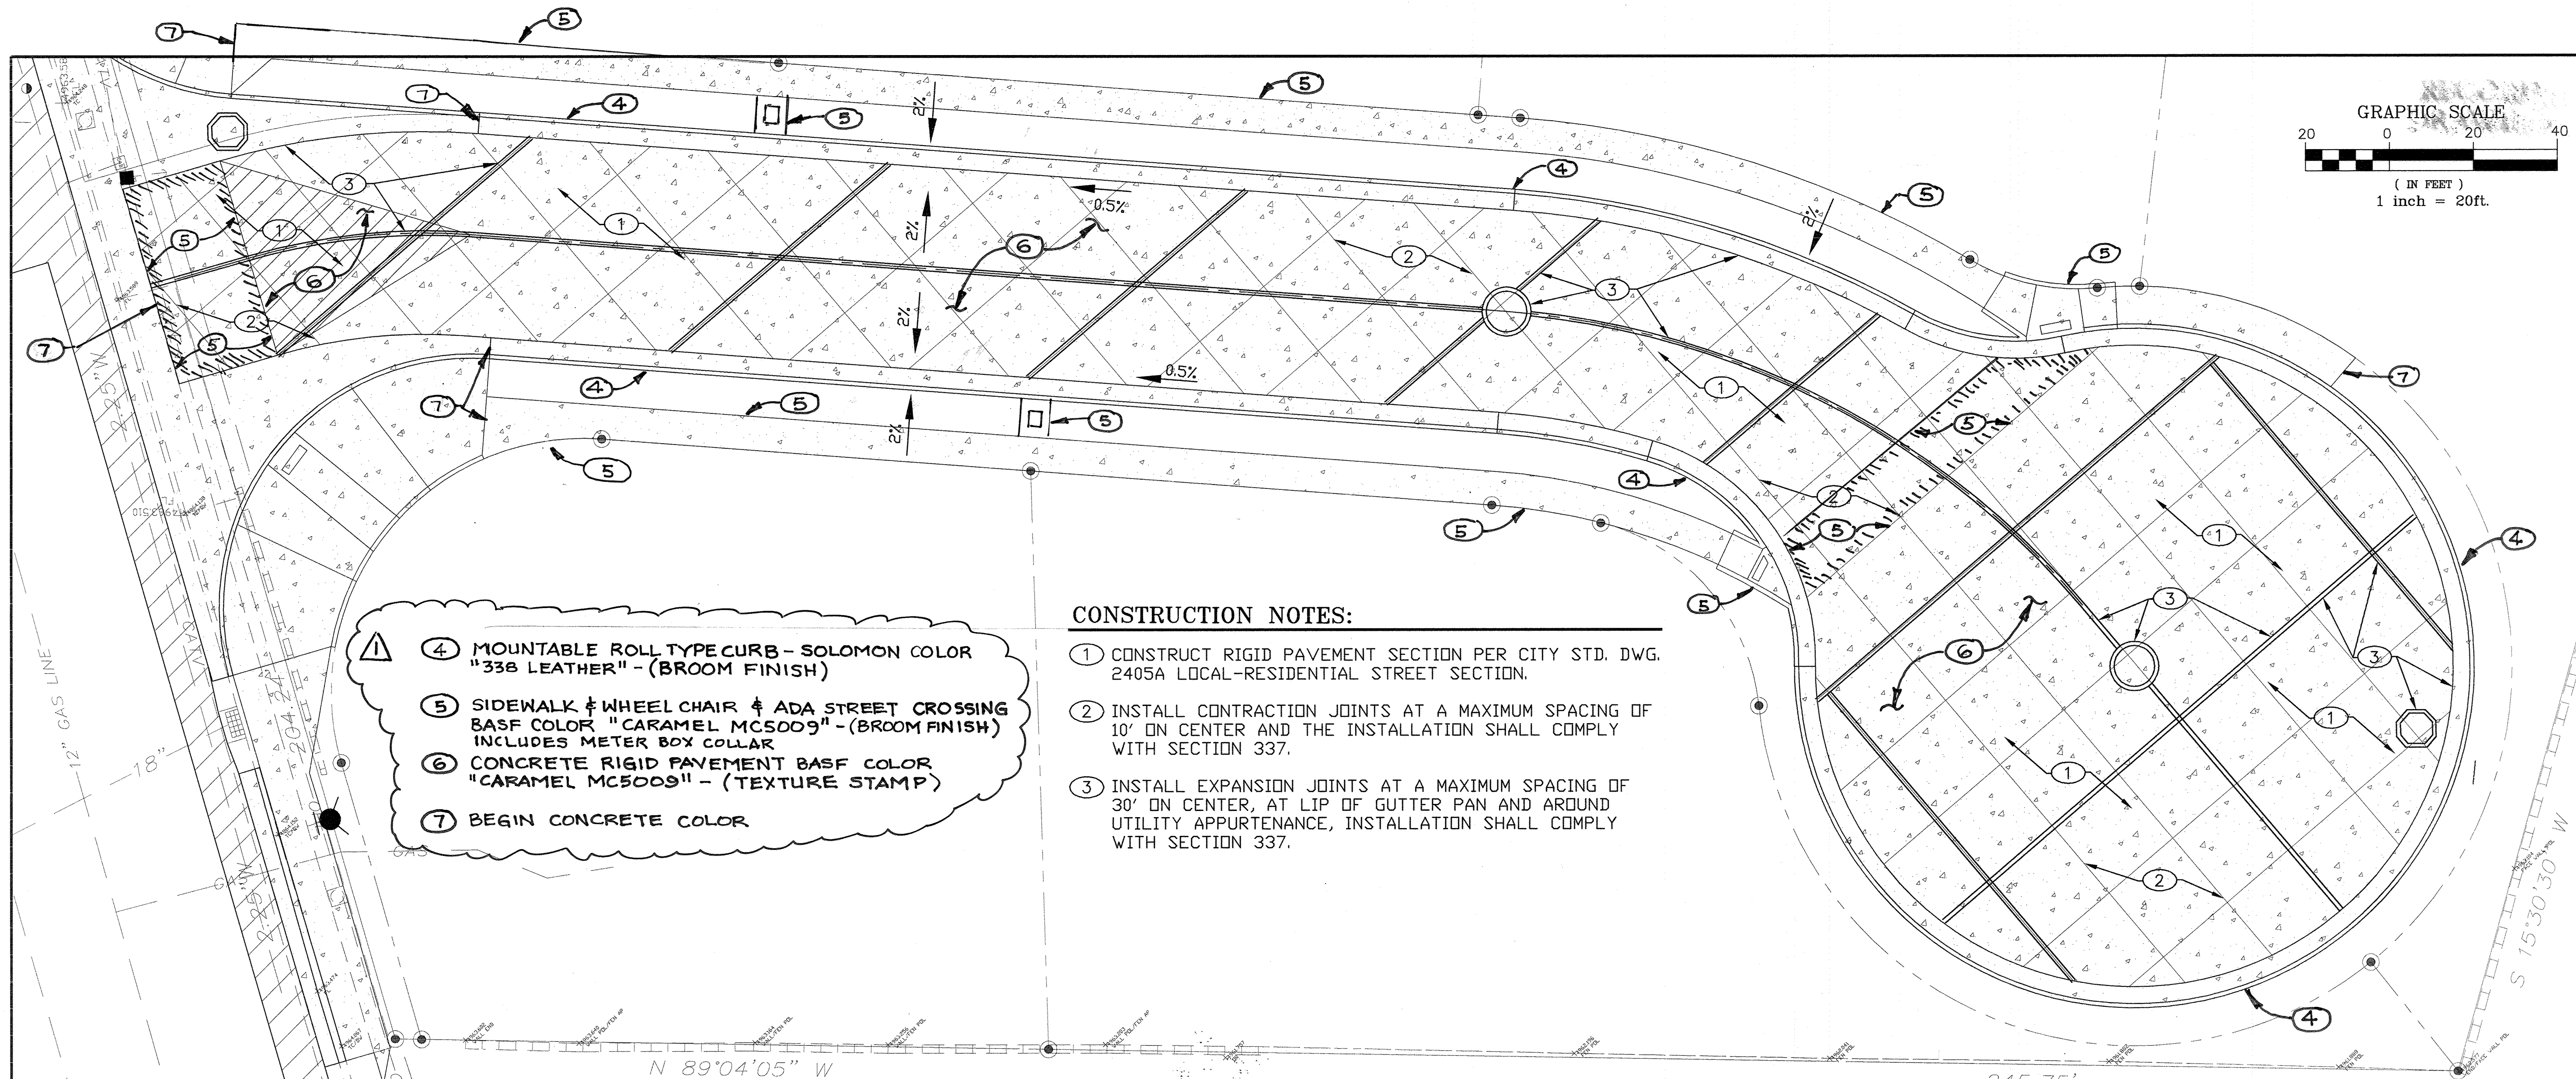

- CONSTRUCTION NOTES:**
- 1. MOUNTABLE ROLL TYPE CURB - SOLOMON COLOR "338 LEATHER" - (BROOM FINISH)
 - 2. SIDEWALK & WHEEL CHAIR & ADA STREET CROSSING BASF COLOR "CARAMEL MC5009" - (BROOM FINISH) INCLUDES METER BOX COLLAR
 - 3. CONCRETE RIGID PAVEMENT BASF COLOR "CARAMEL MC5009" - (TEXTURE STAMP)
 - 4. BEGIN CONCRETE COLOR

- CONSTRUCTION NOTES:**
- 1. CONSTRUCT RIGID PAVEMENT SECTION PER CITY STD. DWG. 2405A LOCAL-RESIDENTIAL STREET SECTION.
 - 2. INSTALL CONTRACTION JOINTS AT A MAXIMUM SPACING OF 10' ON CENTER AND THE INSTALLATION SHALL COMPLY WITH SECTION 337.
 - 3. INSTALL EXPANSION JOINTS AT A MAXIMUM SPACING OF 30' ON CENTER, AT LIP OF GUTTER PAN AND AROUND UTILITY APPURTENANCE, INSTALLATION SHALL COMPLY WITH SECTION 337.

CONCRETE PAVING PLAN
1" = 20'

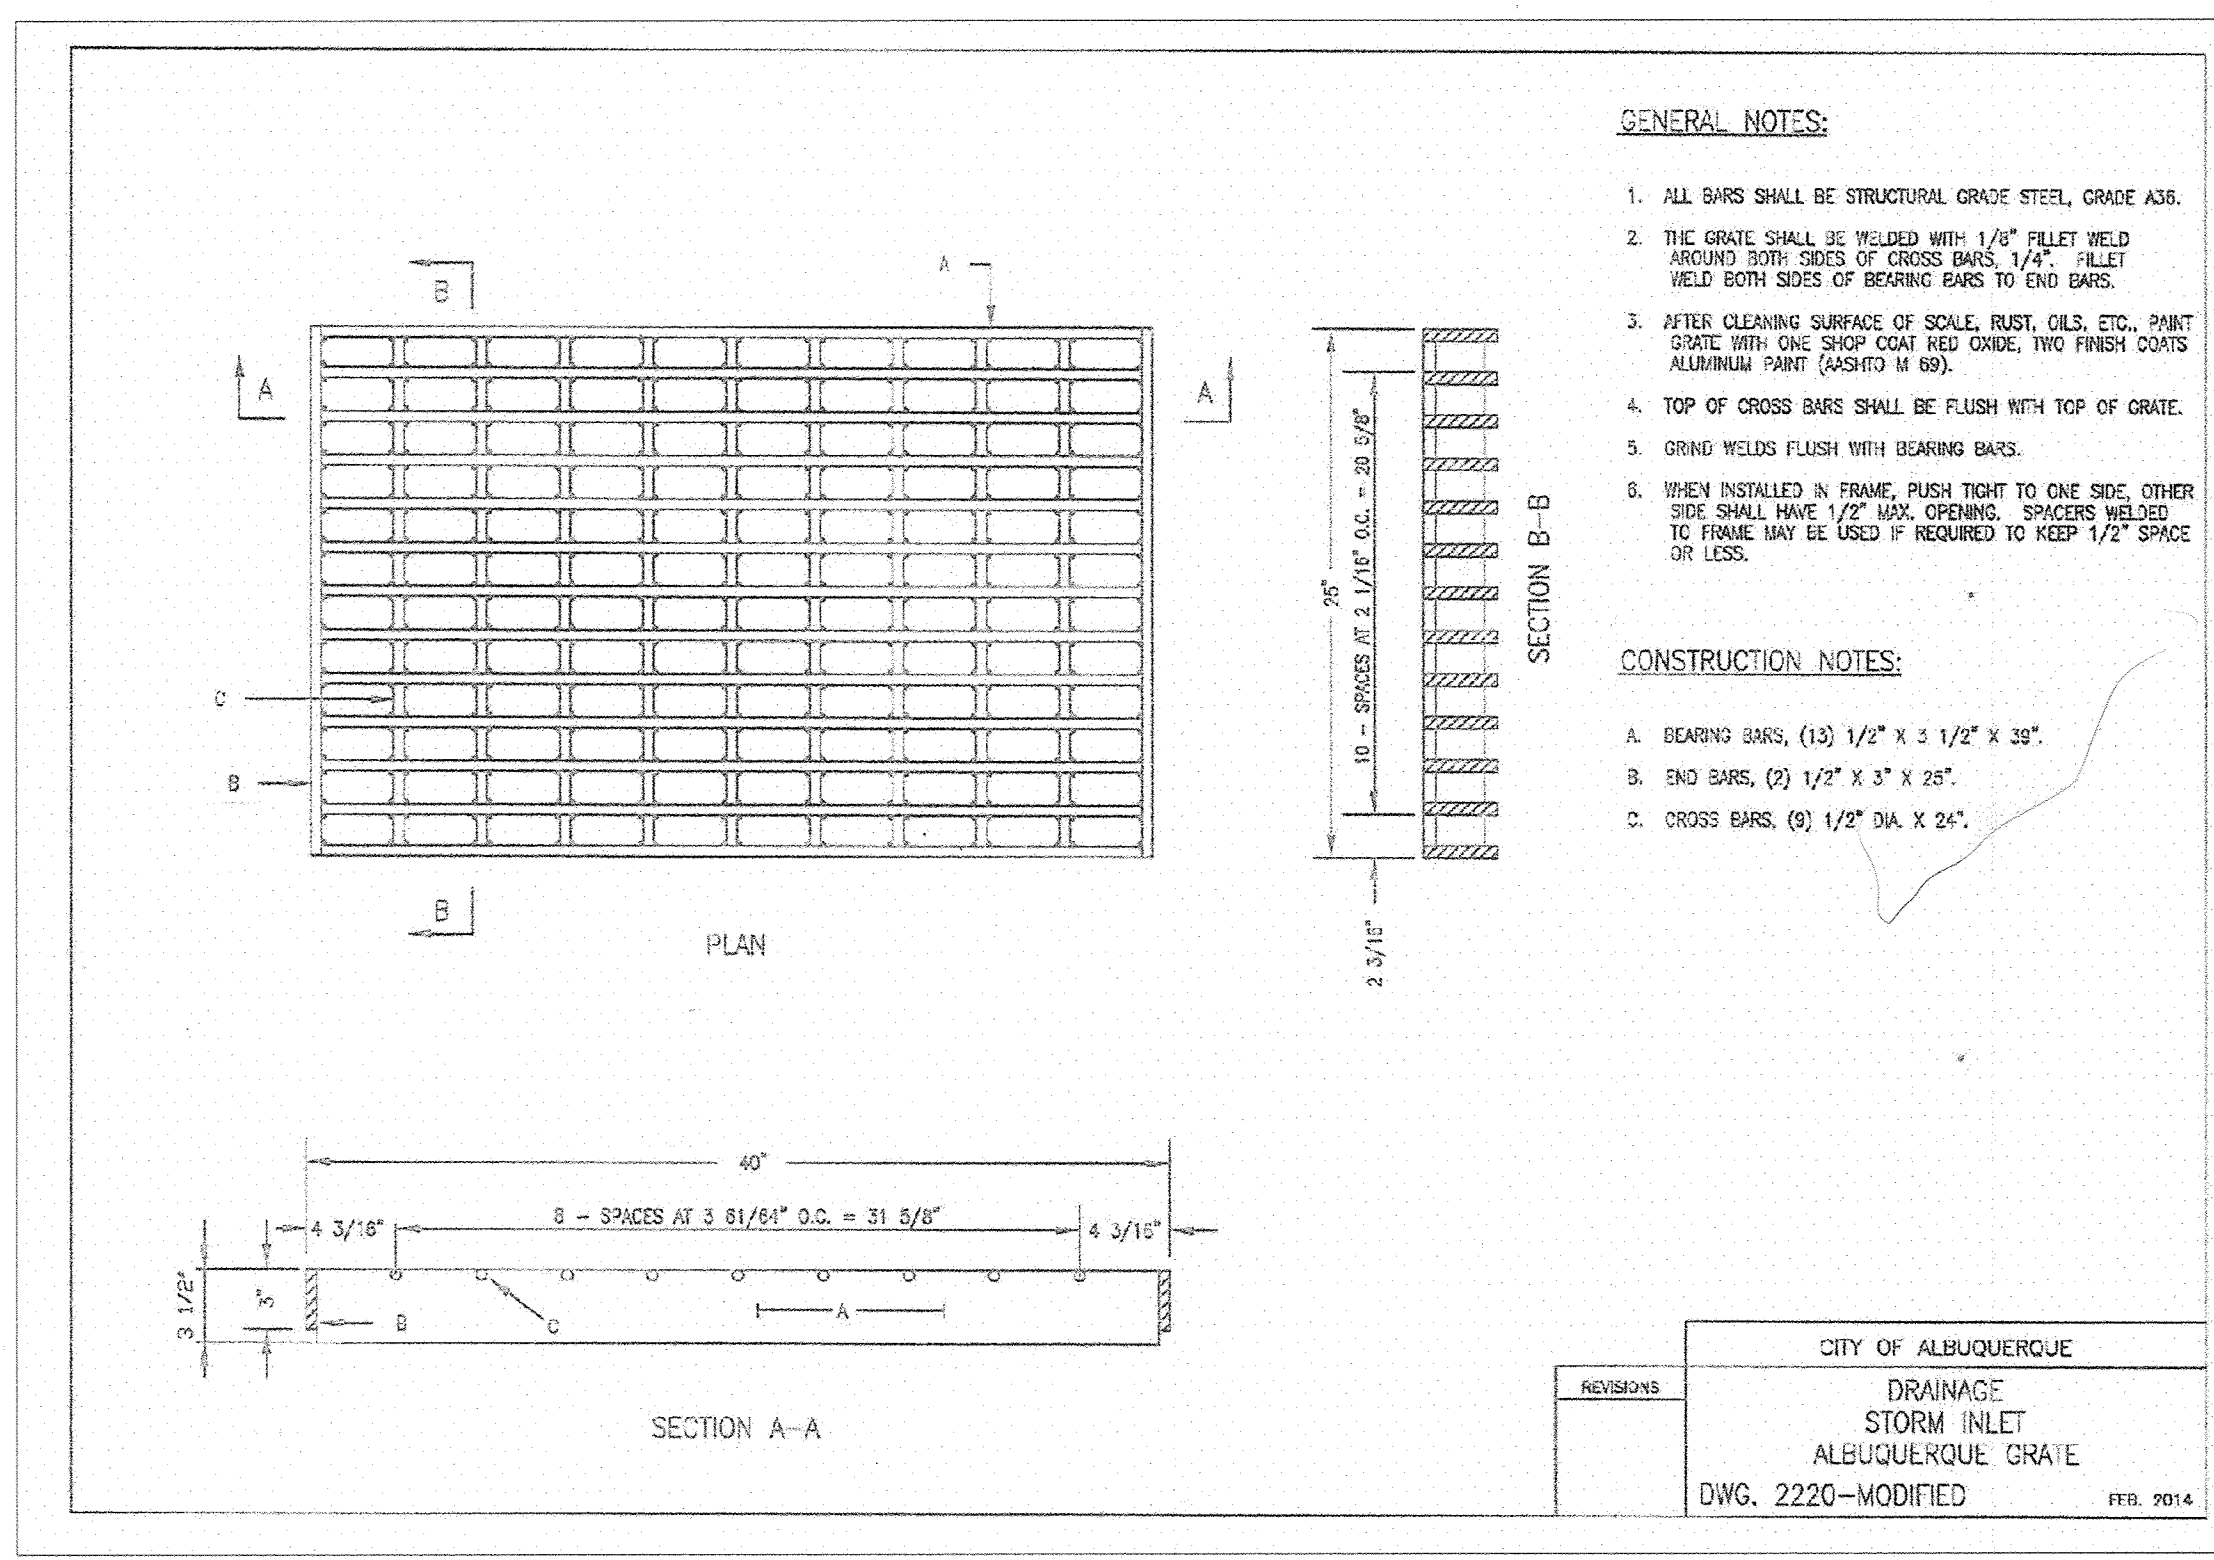

5' PLAIN, PORTLAND CEMENT CONCRETE (PCC) PAVEMENT SHALL COMPLY WITH SECTION 101 AND SECTION 337.

12" SUBGRADE PREP R-VALUE > 50, 95% MIN COMPACTION PER SECTION 301


FINISH SURFACE OR SUBGRADE SHALL BE MOISTURE CONTROLLED AT COMPACTION MOISTURE RANGE, AND/OR PRIME COAT APPLIED AS REQUIRED BY THE ENGINEER

SEE SECTIONS 202, 204, AND 301 FOR CUT, FILL, AND SUBGRADE CONSTRUCTION REQUIREMENTS

RIGID PAVEMENT SECTION
NOT TO SCALE

APPLIED ENGINEERING AND SURVEYING, INC. ENGINEERS AND PLANNERS 1505 Blvd. Drive NE, Albuquerque, NM 87112 Office: (505) 237-1459 Fax: (505) 237-1458	
CITY OF ALBUQUERQUE PUBLIC WORKS DEPARTMENT ENGINEERING DEVELOPMENT GROUP	
TITLE: DETAIL SHEET HACIENDAS DON VILLEGAS	
Design Review Committee APPROVE JUN 23 2014 DESIGN REVIEW COMMITTEE	City Engineer Approval APPROVE NOV 06 2014 CITY ENGINEER
City Project No. 764283	Zone Map No. H-13
Sheet 7	Of 7

RECORD DRAWING

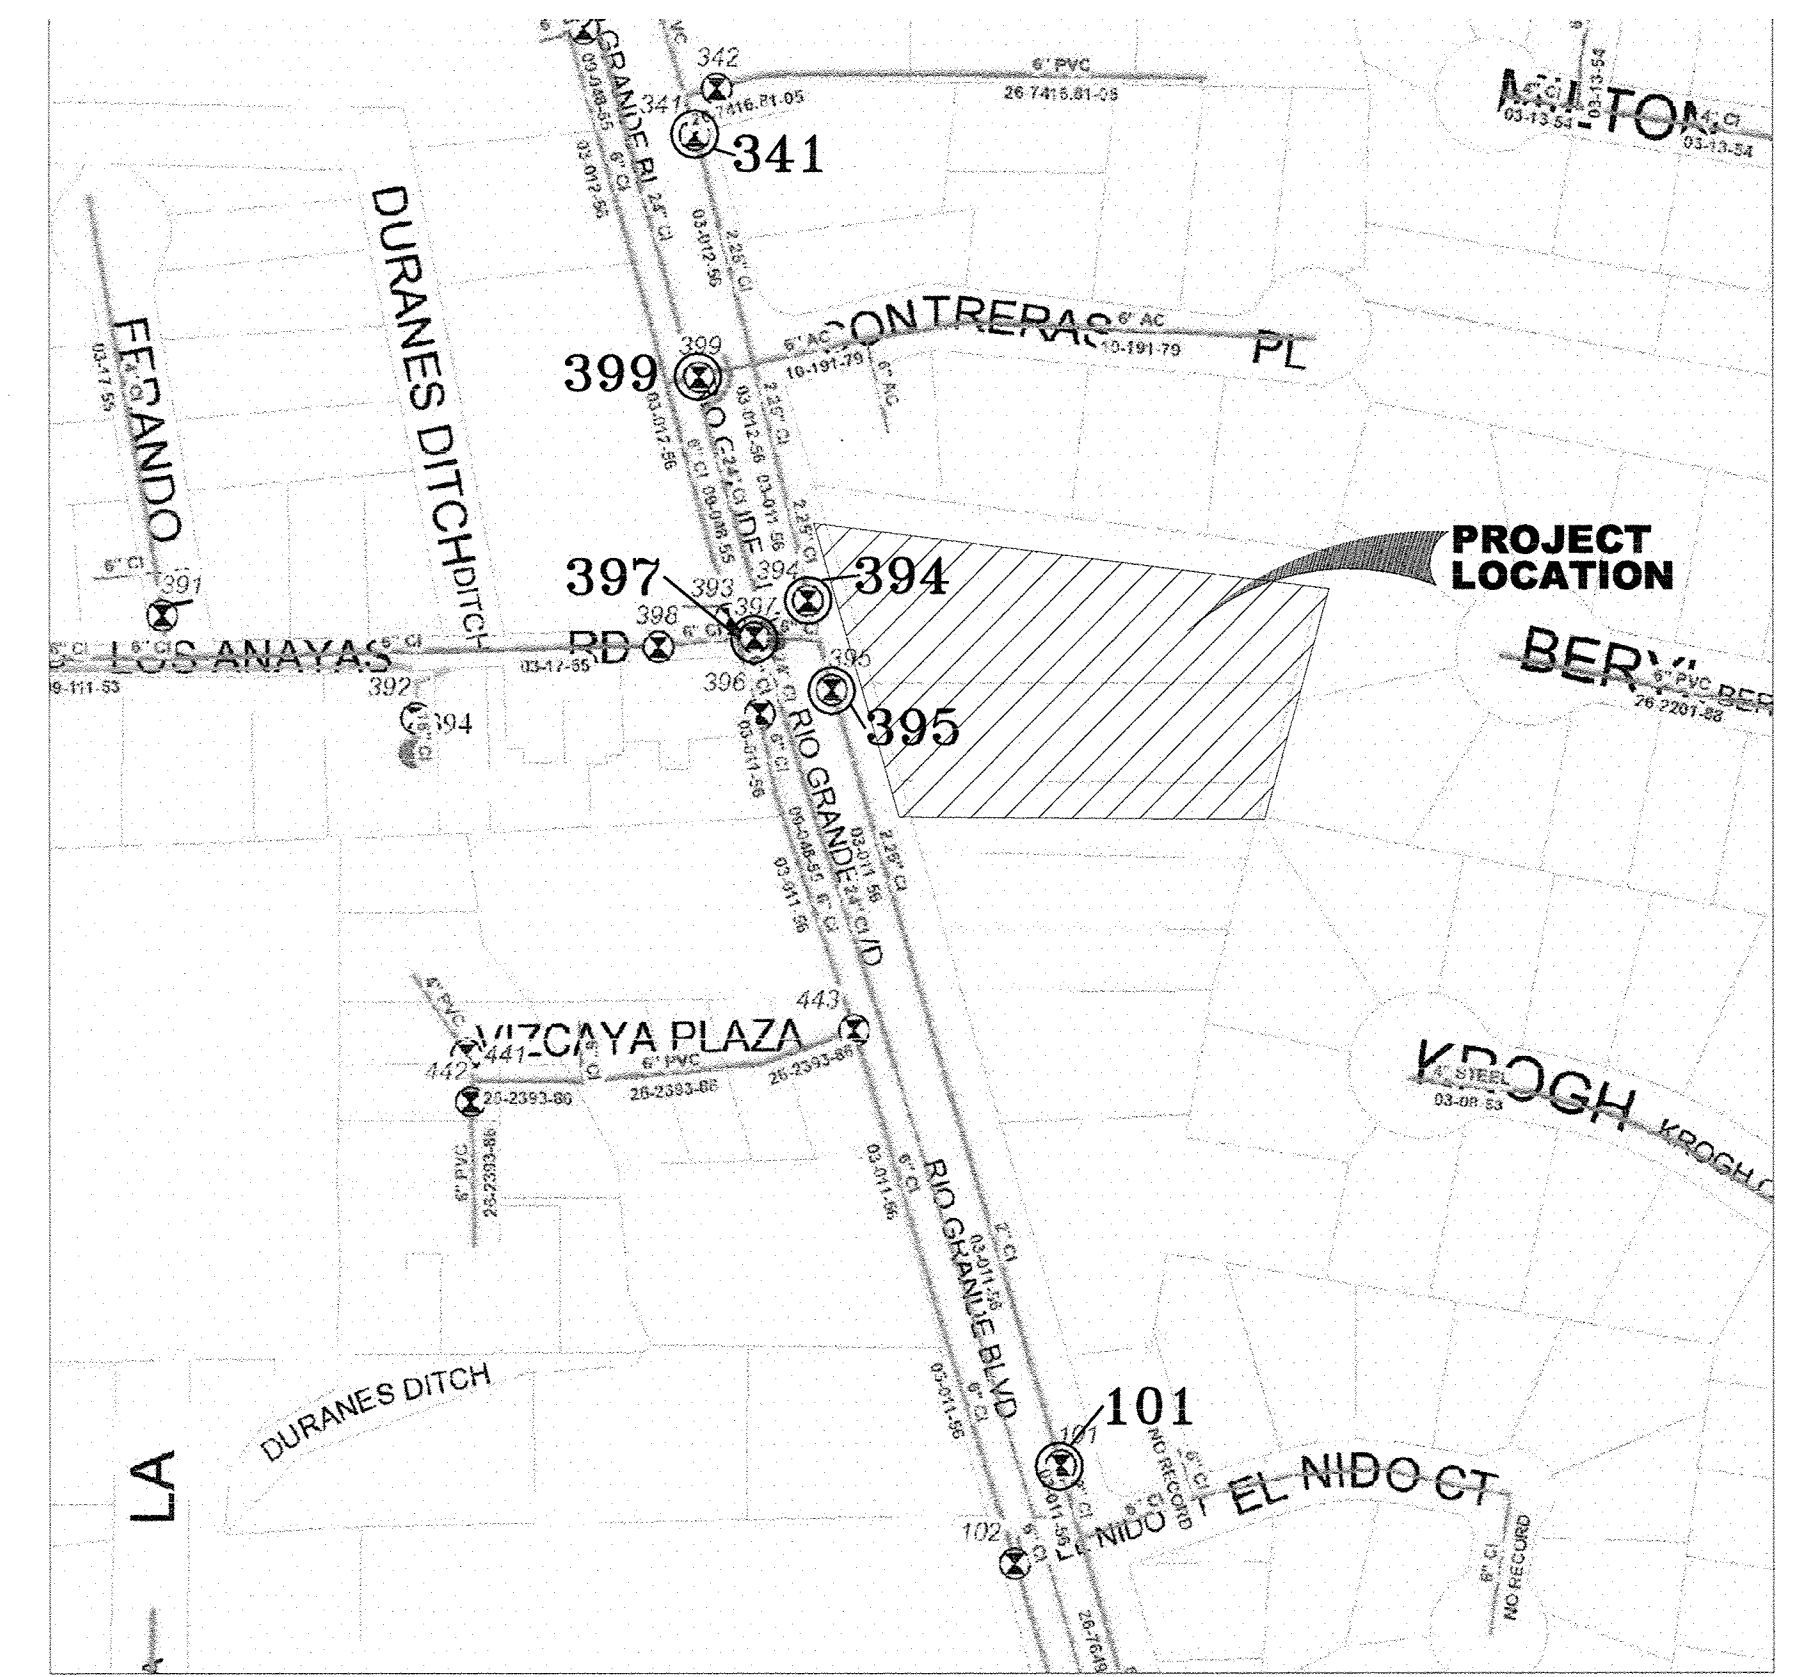

WATER SHUTOFF PLAN
NOT TO SCALE